

2000-1 Addison Circle
Cut Sheets - 1996

Smead

HUITT-ZOLLARS

Engineering / Architecture

Dallas • Fort Worth • Houston • El Paso • Phoenix • Tustin • Ontario • San Clemente

FACSIMILE TRANSMITTAL

Date: 6-25-96

Fax No.: 931-6643

H-Z Proj. No. 01-1932-03

No. of Pages: 10
(Including Cover Sheet)

TO: BRUCE Ellis
TOWN OF Addison - Public Works

- URGENT
 For Your Review
 Please Call Upon Receipt
 Orig. To Follow By Mail

Addison Circle Project - Cut sheets

cc: DAVID MEYER - Huitt Zollars

FROM: Eric Yaboudey CW

SENT BY: _____ TIME: _____ DATE: _____

If you had any problems receiving the Facsimile Transmittal, please contact Ms. Janet Willis or the individual listed above at (214) 871-3311. Thank you.

HUITT-ZOLLARS

210
RPLS 4862

SURVEY NOTES

LOCATION VERIFY 1712 ROAD PARTY PILLAN DATE 6/25/96
Sub Goal TURKISH WEATHER 73° Sunny
VERIFY BUTLER SHEET 1 OF 2

14" sub

CHK RW 6/25/96

STATION	+	H.I.	-	ELEV.	GRADE	CUT	FILL	DESCRIPTION
B.M. 1				21.89				
		32.14						
11+10.25 LT		3.61	3.60	28.54	28.53	0.01		
11+12.35 LT		3.73	3.75	28.35	28.41		0.02	
11+18 RT		3.81	3.82	28.32	28.23		0.01	
11+24.45 LT		3.95	3.96	28.18	28.26		0.08	
11+27 RT		4.29	4.29	27.85	28.18		0.33	WIDE
11+57 RT		4.37	4.37	27.77	27.88		0.11	WIDE
11+46 RT		4.70	4.70	27.96	27.64		0.32	CRACK
11+54.25 E		4.24	4.50	27.64	27.83		0.06	
" RT Mid		4.51	4.68	27.46	27.65		0.19	0.05 / 27.43
" RT		4.76	4.90	27.24	27.43		0.19	0.06 / 27.18
11+75 E		4.54	4.75	27.15	27.20		0.01	
" RT Mid		5.19	5.48	26.97	26.95	0.02		
" RT		5.24	5.48	26.66	26.70		0.04	
12+00 E		5.51	5.53	26.61	26.63		0.02	
" RT Mid		5.74	5.74	26.00	26.30	0.02		
" RT		5.97	5.97	26.15	26.13	0.02		
12+08.25 LT		5.97	5.97	26.15	26.10	0.01		
12+13.25 LT		6.12	6.26	26.04	26.02	0.02		
12+22.25 LT		6.43	6.50	25.64	25.91		0.17	
12+25 LHM		6.34	6.35	25.79	25.81		0.01	
" E		6.57	6.12	26.02	26.05		0.03	
" RT Mid		6.34	6.35	25.79	25.80		0.01	
" RT		6.57	6.64	25.50	25.55		0.05	
12+46.25 LT		6.71	7.00	25.14	25.31		0.23	
12+50 LHM		6.71	6.74	25.20	25.23		0.02	
" E		6.66	6.75	25.30	25.48		0.05	
" RT Mid		6.71	6.90	25.24	25.23	0.01		
" RT		7.16	7.17	24.95	24.98		0.03	

HUITT-ZOLLARS

S. J. Johnson
RPLS 4862

SURVEY NOTES

LOCATION Verity Michael PARTY Filler DATE 6/25/26
Subgrade TURKOP WEATHER _____
_____ _____ SHEET 2 OF 2

STATION	+	H.I.	-	ELEV.	GRADE	CUT	FILL	DESCRIPTION
		72.14						
12+55.3	LA	7.0	7.10	25.04	25.05		0.01	/
12+73.2	RT	7.0	7.62	24.52	24.53		0.01	/
12+82.2	RT	7.1	7.65	24.45	24.43		0.02	/
12+05.2	L	8.1	8.20	23.52	23.52		0.02	/
"	E	7.52	7.90	24.24	24.22		0.02	/
"	RT	8.1	8.22	23.52	23.52		0.02	GRADE
12+30.1	L	8.0	8.25	23.44	23.45		0.01	/
"	E	8.92	8.40	23.74	23.72		0.02	/
"	RT	8.72	8.76	23.30	23.32		0.02	/
12+55.2	L	8.55	8.97	23.17	23.15		0.02	/
"	E	8.73	8.79	23.35	23.41		0.06	/
"	RT	9.03	9.23	22.91	23.11		0.20	/
12+75.1	L	7.8	7.53	24.61	24.65		0.04	/
"	E	7.24	7.90	24.84	24.50		0.34	/
"	RT	7.93	7.47	24.67	24.65		0.02	/
			8.87	23.27				
	11.18	34.45						RT
0+7.1			12.57	21.88	21.85			/

HUITT-ZOLLARS

2/2 Johnson
RPLS 4862

SURVEY NOTES

LOCATION PASCAL STW. S PARTY PICAD DATE 6/22/96
EP LEFT TOP TRAP WEATHER 75° SWIND
PAV. VERTICAL SHEET 1 OF 1

TD

CHK RW 6/25/96

STATION	+	H.I.	-	ELEV.	GRADE	CUT	FILL	DESCRIPTION
17+24.2				38.83				
	1.21	40.04						2 1/2 E.P.
17+28.27 Lt			13.13	26.91	27.10		0.49	
18+50 Lt			12.28	27.26	27.76	GRAV		
18+88.41 Lt			11.55	28.05	28.34		0.27	
19+00 Lt			11.68	28.26	28.51		0.15	
19+50 Lt			11.35	28.65	29.26		2.61	
19+87.2 Lt			10.64	29.40	29.82		0.42	
20+11.2 Lt			10.47	29.61	30.18		0.57	
0			13.13	26.91				
	12.86	39.77						
317			0.95	38.82	38.89			

HUITT-ZOLLARS

Sy Jellison
RPLS 4862

SURVEY NOTES

LOCATION PASCHAL INTERIS PARTY PILLAR DATE 6/20/96
TURNER WEATHER _____
13-2000 SHEET 1 OF 2

CHK RW 6/25/96

STATION	+	H.I.	-	ELEV.	GRADE	CUT	FILL	DESCRIPTION
WHTWTL				38.83				
	1.09	39.72	/					
17+28.2 ¹ LT			13.02	26.90				27.40 / 6"
" LT Mid				26.78				27.28 ✓
" INV			13.27	26.65				27.15 ✓
" RT Mid				26.78				27.28 ✓
" RT			13.02	26.90				27.40 ✓
18+25 LT				27.08				27.58 ✓ "
" LT Mid				26.90				27.46 ✓
" INV				26.83				27.33 ✓
" RT Mid				26.90				27.46 ✓
" RT				27.08				27.58 ✓
18+50 LT			12.66	27.26				27.76 ✓ "
" LT Mid				27.14				27.64 ✓
" INV			12.91	27.01				27.51 ✓
" RT Mid				27.14				27.64 ✓
" RT			12.66	27.26				27.76 ✓
18+75 LT				27.64				28.14 ✓ "
" LT Mid				27.52				28.02 ✓
" INV				27.37				27.83 ✓
" RT Mid				27.52				28.02 ✓
" RT				27.64				28.14 ✓
18+88.5 ¹ LT			12.25	27.67				28.34 ✓ "Full C, 1-2"
" LT Mid				27.55				28.22 ✓ "
" INV			12.50	27.42				28.07 ✓
" RT Mid				27.55				28.22 ✓
" RT			12.25	27.67				28.34 ✓
19+00 LT			12.08	27.84				28.51 ✓ "
" LT Mid				27.72				28.39 ✓
" INV			12.33	27.59				28.26 ✓
" RT Mid				27.72				28.39 ✓
" RT			12.08	27.84				28.51 ✓

28.51
28.39
28.26

HUITT-ZOLLARS

E. J. Johnson
RPLS 4862

SURVEY NOTES

LOCATION Paschal Meadows PARTY _____ DATE 6/20/96
 _____ WEATHER _____
 _____ SHEET 2 OF 2

STATION	+	H.I.	-	ELEV.	GRADE	CUT	FILL	DESCRIPTION
		30.92						
19+25L+				28.22				28.85 /
" LTMd	X			28.10				28.77 /
" INV				27.97				28.64 /
" RTM.d				28.10				28.77 /
" RT				28.22				28.85 /
19+50L+			11.33	28.57				29.26 / B"
" LTMd				28.47				29.14 /
" INV			11.50	28.24				29.01 /
" RTM.d				28.47				29.14 /
" RT			11.33	28.57				29.26 /
19+75L+				28.97				29.64 /
" LTMd	X			28.85				29.52 /
" INV				28.72				29.39 /
" RTM.d				28.85				29.52 /
" RT				28.97				29.64 /
19+87.5L+			10.77	29.15				29.82 / End B' Bcu, 6
" LTMd				29.03				29.70 / B"
" INV			11.02	28.90				29.57 /
" RTM.d				29.03				29.70 /
" RT			10.77	29.15				29.82 /
20+00L+				29.51				30.01 /
" LTMd	X			29.46				29.89 /
" INV				29.26				29.76 /
" RTM.d				29.46				29.89 /
" RT				29.51				30.01 /
20+11.5L+			10.24	29.68				30.18 / C"
" LTMd				29.56				30.06 /
" INV			10.47	29.43				29.93 /
" RTM.d				29.56				30.06 /
" RT			10.24	29.68				30.18 /
○			10.25	29.67				
	10.63	28.91						

01. 1972-04

HUITT-ZOLLARS

E. J. Johnson
RPLS 4862

SURVEY NOTES

LOCATION ADDISON CIRCLE PARTY PICLAS DATE 6/21/96

80-7

MILDERED FENCE ZEPHRA WEATHER _____

PROVINCIAL FRUTLER SHEET 1 OF 1

TL

✓ E3-1 6.24-96

STATION	+	H.I.	-	ELEV.	GRADE	CUT	FILL	DESCRIPTION
B+7 th 1				21.85				3' 0.15 & C
	11.01	32.50	/					
11+10.25 L+			3.71	29.15	29.70	✓	0.51	✓
11+18 RT			6.50	28.40	29.50	✓	1.10	✓
11+19.25 L+			4.57	28.31	29.58	✓	1.27	✓
CR-11+24.25 L+			4.76	28.20	29.43	✓	1.23	✓
11+27 RT			4.92	27.98	29.35	✓	1.37	✓
11+37 RT			5.22	27.68	29.05	✓	1.37	✓
11+46 RT			4.78	28.12	28.61	✓	0.49	✓
11+54.75 RT			4.90	27.92	28.35 28.55	✓	0.43	✓
12+00 RT								
12+00 RT			5.45	27.45	27.30	✓	0.15	✓
12+08.25 L+			6.71	26.19	27.31	✓	1.12	✓
12+13.25 L+			6.84	26.04	27.13	✓	1.13	✓
12+22.25 L+			6.07	26.83	26.50	✓	0.15	✓
12+25.25 L+			6.23	26.67	26.65	✓	0.02	Fo.47
" RT			6.79	26.11	26.05	✓	0.06	Fo.38
12+46.25 L+			6.28	26.62	26.54	✓	0.08	✓
12+50 RT			9.49	23.11	26.15	✓	2.74	✓
12+55.25 L+			7.70	25.20	26.22	✓	1.02	✓
12+73.25 RT			8.79	24.51	25.70	✓	1.19	✓
12+82.25 RT			8.43	24.47	25.60	✓	1.13	✓
13+05 L+			8.82	24.08	25.09	✓	1.01	✓
" RT			9.02	23.88	25.09	✓	1.21	✓
13+29.25 L+			9.24	23.66	24.62	✓	0.96	✓
13+30 L+			9.29	23.61	24.62	✓	1.01	✓
" RT			5.62	24.28	24.50	✓	1.31	✓
13+55 L+			9.62	23.28	24.32	✓	1.04	✓
" RT			8.44	24.44	24.28	✓	0.16	✓
Q			9.62	23.78	RT			

01.1932.04

HUITT-ZOLLARS

Elj Johnson
RPLS 4862

SURVEY NOTES

LOCATION MILDEED BLUE TOPS PARTY PILLAR DATE 6/20/06
Address CIRCLE TURNER WEATHER 50-100"
SUBGRADE BUTLER SHEET 1 OF 3

11' sub = 1.11' @ 100% T.C.

✓ EST 6-25-16

STATION	+	H.I.	-	ELEV.	GRADE	CUT	FILL	DESCRIPTION
B7*1				21.85				
	10.17	32.06						
								TOP C.S.B
11+10.20 LT			3.53	28.53				76 = 29.70 ✓
11+19.20 LT			3.65	28.41				76 = 29.58 ✓
11+17 RT			3.73	28.33				76 = 29.50 ✓
11+26 RT			3.88	28.18				76 = 29.35 ✓
								R.G.L
11+25 LT (Mid)			3.77	28.25				29.86 ✓ 29.11
" Q			3.52	28.54				29.71 ✓
" RT (Mid)			3.77	28.25				29.46 ✓ 29.41
11+36 RT 13.5'			4.18	27.98				76 = 29.05
11+45 RT 13.5'			4.62	27.44				76 = 28.61
								1.26
11+50 LT			4.76	27.30				28.47 ✓ 28.67
" LT (Mid)			4.51	27.55				28.72 ✓
" Q			4.26	27.80				28.57 ✓
" RT (Mid)			4.51	27.55				28.72 ✓
" RT			4.76	27.30				28.47 ✓
11+75 LT			5.36	26.70				27.87 ✓ 29.07
" LT (Mid)			5.11	26.95				28.12 ✓
" Q			4.86	27.20				28.27 ✓
" RT (Mid)			5.11	26.95				28.12 ✓
" RT			5.36	26.70				27.87 ✓
12+00 LT			5.93	26.13				27.30 ✓ 27.50
" LT (Mid)			5.68	26.38				27.65 ✓
" Q			5.43	26.63				27.80 ✓
" RT (Mid)			5.68	26.38				27.55 ✓
" RT			5.93	26.13				27.30 ✓

01-1932-04

HUITT-ZOLLARS

E. J. Johnson
RPLS 4862

SURVEY NOTES

LOCATION Address Circle PARTY _____ DATE 6/20/96
M. Idred _____ WEATHER _____
Blue top substrate _____ SHEET 2 OF 3

14' sub

STATION	+	H.I.	-	ELEV.	GRADE	CUT	FILL	DESCRIPTION
		32.06						
12+13.25 ²⁴			6.04	26.02				76.27.15 ✓
12+22.25 ²⁴			6.25	25.81				76.26.58 ✓
12+25 L+			6.51	25.35				76.93 26.72 ✓ PGL 26.72
" L+AD			6.26	25.80				26.77 ✓
" E			6.01	26.05				27.22 ✓
" RT AD			6.26	25.80				26.77 ✓
" RT			6.51	25.35				26.72 ✓
12+46.25 ²⁴			6.69	26.31				76.26.34 ✓ PGL view
12+50 L+			7.08	24.82				76.15 ✓ PGL 26.15
" L+AD			6.83	25.23				26.40 ✓
" E			6.58	25.48				26.65 ✓
" RT AD			6.83	25.23				26.20 ✓
" RT			7.08	24.82				26.15 ✓
12+55.25 ²⁴			7.01	25.05				76.26.22 ✓
12+75 L+AD			7.41	24.65				76.26.22 ✓ PGL 25.77
" E			7.16	24.90				26.07 ✓
" RT AD			7.41	24.65				25.72 ✓
12+77.25 ²⁴ RT			7.53	24.53				76.25.70 ✓
12+82.25 ²⁴ RT			7.63	24.43				76.25.60 ✓
13+00 L+AD			7.98	24.08				25.25 ✓ PGL 25.21
" E			7.73	24.33				25.50 ✓ 25.21 T
" RT			7.98	24.08				25.25 ✓ 25.21 T

HUITT-ZOLLARS

ZH Johnson
RPLS 4862

SURVEY NOTES

LOCATION Addison Circle PARTY _____ DATE 6/20/96
M. Idred Street WEATHER _____
Blue tops SHEET 3 OF 3

14 sub

STATION	+	H.I.	-	ELEV.	GRADE	CUT	FILL	DESCRIPTION
		32.06						
								PCL
13+25 LHM		8.49		23.57				24.74 ✓
" C		8.24		23.82				24.55 ✓
" PTM		8.49		23.57				24.36 ✓
		8.65		23.41				
								PCL
13+50 LHM		8.82		23.24				24.41
" C		8.57		23.49				24.66
" PT		8.82		23.24				24.41
0			8.81	23.25				
	8.77	32.02						
B741			10.13	21.07	21.65			

HUITT-ZOLLARS

Engineering | Architecture

Dallas • Fort Worth • Houston • El Paso • Phoenix • Tustin • Ontario • San Clemente

FACSIMILE TRANSMITTAL

Date: 6-14-96

Fax No.: 931-6643

H-Z Proj. No. 01-1932-03

No. of Pages: 2
(Including Cover Sheet)

TO: BRUCE ELLIS

TOWN OF ADDISON - PUBLIC WORKS

URGENT For Your Review Please Call Upon Receipt Orig. To Follow By Mail

Addison Circle Project

Milbred Street - Rough Grading Cut sheet

CC: DAVID MEYERS - HUITT ZOLLARS, INC.

FROM: ERIC YAKOUDY (RW)

SENT BY: _____ TIME: _____ DATE: _____

If you had any problems receiving the Facsimile Transmittal, please contact Ms. Janet Willis or the individual listed above at (214) 871-3311. Thank you.

HUITT-ZOLLARS

E. J. Johnson
RPLS 4862

SURVEY NOTES

LOCATION ADDISON CIRCLE PARTY PILLAM DATE 6/13/96
MILPITAS STREET TURNER WEATHER B5° Sunny
Rough grading 30.00 to B.C. SHEET 1 OF 1
TC (225' From E) ✓ RW 6/14/96

STATION	+	H.I.	-	ELEV.	GRADE	CUT	FILL	DESCRIPTION
B7#1				21.87				
	10.04	31.93						
11+00 L+			1.98	27.25	29.25	GRADE		File - 0.20 30.15' EXIST
" RT			1.88	30.05	27.25	0.40		30.15' "
11+54.25 L+			4.18	27.75	28.35		0.60	28.55'
" RT			3.61	28.32	28.35		0.03	28.55'
12+00 L+			4.99	27.54	27.30	0.24		27.50'
" RT			3.30	28.95	27.30	1.05		27.50
			4.57	27.30		0.06		
12+35.25 L+			5.25	26.68	26.47	0.19		26.69'
" RT			5.45	26.48	26.47		0.01	26.69'
12+50 L+			5.62	26.31	26.15	0.16		26.35'
" RT					26.15			26.35'
13+05 L+			7.24	24.69	24.89		0.20	25.09'
" RT			6.58	24.75	24.89		0.06	25.09'
13+30 L+			8.60	23.93	24.42		1.07	24.62'
" RT			7.53	24.40	24.39		0.01	24.59'
13+55 L+			8.79	23.14	24.12		0.78	24.32'
" RT			7.65	24.28	24.08		0.20	24.28'
13+97.25 L+			8.12	23.81	24.30		0.47	24.50 ⁴⁵ '
" RT			7.60	24.33	24.28		0.05	24.48'
0			7.53	24.40				
	5.08	29.48						
B7#1			7.59	21.89	21.87			

**ADDISON CIRCLE PHASE I PUBLIC INFRASTRUCTURE
PROJECT DIRECTORY**

OWNER: Columbus Realty Trust

OWNER REPRESENTATIVE: Huitt-Zollars, Inc.
David Meyers/Bill Brown

CONTRACTOR: Gibson & Associates, Inc.

SUBCONTRACTOR: Utilities - Llano Construction Co.
Earthwork - Davis Excavation

DOCUMENT CONTROL

- A. All documents to be processed through David Meyers, Huitt-Zollars, Inc., for dissemination.
- B. All submittals, change orders, RFI's, etc. will have an identification number and require a response date.
- C. Pay Application Schedule - Draft of Monthly Pay Schedule will be sent to David Meyers, Huitt-Zollars, Inc., for approval prior to Final Pay Schedule. Final Pay Schedule due for Columbus Realty's signature on the 25th of each month. Revised and/or updated Construction Schedule is required with Pay Schedule submittal.

attachment: Contact List

HUITT-ZOLLARS

Engineers / Architects

Dallas • Fort Worth • Houston • El Paso • Phoenix • Orange County

FACSIMILE TRANSMITTAL

Date: 5/17/96

Fax No.: 931-6643

H-Z Proj. No. 01201301

No. of Pages: 16
(Including Cover Sheet)

TO: ADDISON PUBLIC WORKS
ATTN: JOHN BAUMGARTNER / BRUCE GILIS

- URGENT
- For Your Review
- Please Call Upon Receipt
- Orig. To Follow By Mail

RE: ADDISON CIRCLE UNIT MOWS
STARTING SINCE 4/12/96

FROM: David Meyer

SENT BY: _____ TIME: _____ DATE: _____
If you had any problems receiving the Facsimile Transmittal, please contact Ms. Janet Willis or the individual listed above at (214) 871-3311. Thank you.

HUITT-ZOLLARS

SURVEY NOTES

LOCATION ADDISON CIRCLE PARTY PCLAR DATE 4/12/96
with new subgr. TURNER WEATHER 70° CLOUDY
PUTER SHEET 1 OF

✓ D&C 4-16-96

STATION	+	H.I.	-	ELEV.	GRADE	CUT	FILL	DESCRIPTION
B7+2				621.68				11" OUT CENTER OF CURB INLET 1" INLET NORTH OF MILDRED (200' ± FROM CENTERLINE) WEST SIDE OF QUADRA DR. - 1, 2L
13+40.2L	10.83	632.51	3.22	627.29	626.77	2.52		CR 2.5' 36" + B UNDERCUT
" RT			5.67	626.84	626.99	0.45		CR
13+50L			3.03	627.40	626.75	2.65		
" RT			5.27	627.24	626.50	0.74		
14+00L			3.87	628.62	628.35	1.47		
" RT			5.16	627.35	626.80	0.55		
14+25 RT			3.75	628.56	626.95	1.61		
14+50L			3.77	628.58	626.77	1.81		
" RT			4.68	627.83	626.77	1.06		
15+00L			3.66	628.85	626.41	2.44		
" RT			3.66	628.85	626.41	2.44		
15+50L			3.71	628.77	626.05	2.72		
" RT			3.61	628.90	626.05	2.85		
16+00L			3.51	629.00	625.69	3.31		
" RT			4.25	627.56	625.69	1.87		
4+00 RPL			5.63	626.88	626.90			4/2/96 SMT 1" F 2
								RPLS 4862

HUITT-ZOLLARS

E. J. Johnson
RAS 4862

SURVEY NOTES

LOCATION ADDISON CIRCLE PARTY PILLAR DATE 5/9/96
W/IT MENS PAVIL TURNER WEATHER 80° F CL
BUTLER, FINCH SHEET 1 OF 2
 T.P. ✓ RW 5-13-96

STATION	+	H.I.	-	ELEV.	GRADE	CUT	FILL	DESCRIPTION
37 ²				621.68				
	10.62	632.30						
40 ² Lt			3.79	628.51	628.23	0.28		
" INV			5.48	628.82	627.60		0.78	3" INV FROM LOW SIDE
" RT			"	"	627.85		1.03	3" INV FROM LOW SIDE
45 ² Lt			3.33	628.97	628.29	0.68		
" INV			5.12	627.18	627.71		0.53	" "
" RT			"	"	627.94		0.78	
40 ² Lt			3.68	628.62	628.59	0.03		
" INV			4.87	627.43	628.01		0.58	" "
" RT			"	"	628.26		0.83	
25 RT			4.46	627.84	628.41		0.57	
" INV			"	"	628.16		0.32	3" INV
45 ² Lt			3.72	628.58	628.23	0.35		
" INV			4.37	627.93	627.98		0.05	" "
" RT			"	"	628.23		0.30	
50 ² Lt			3.74	628.34	627.87	0.49		
" INV			4.52	627.78	627.62	0.16		" "
" RT			"	"	627.87		0.09	
55 ² Lt			4.12	628.18	627.51	0.67		
" INV			4.57	627.73	627.26	0.47		" "
" RT			"	"	627.51	0.22		
40 ² Lt			3.55	628.35	627.15	1.20		
" INV			4.61	627.67	628.50	0.79		" "
" RT			"	"	627.15	0.54		

HUITT-ZOLLARS • *E. J. Johnson*
RPLD 4862

3

SURVEY NOTES

LOCATION Adkins Circle PARTY _____ DATE 5/9/96
Witt Mass Paving WEATHER _____
(CONT.) SHEET 2 OF 2

STATION	+	H.I.	-	ELEV.	GRADE	CUT	FILL	DESCRIPTION
		692.30						
16+50 LT			5.02	627.28	626.75	0.45		
" INV			4.13	628.17	626.54	1.63		3" INV
" RT			"	"	626.75	1.38		
17+00 LT			5.42	626.80	626.43	0.45		
" INV			4.06	628.24	626.18	2.06		"
" RT			"	"	626.43	1.81		
17+15.37 LT			5.06	626.64	626.32	0.32		
" INV			4.18	628.12	626.07	2.05		"
" RT			"	"	626.32	1.80		
BM #3	2.33	690.95	4.18	628.12				
			5.05	624.50	624.50			

HUITT-ZOLLARS

EJ Johnson
RPLS #4862

SURVEY NOTES

LOCATION ADDISON CIRCLE PARTY PILLER DATE 5/10/96
 WITH MEWS Sub GRD VEGETY TLKNER WEATHER _____
_____ BUTLER SHEET 1 OF 2

STATION	+	H.I.	-	ELEV.	GRADE	CUT	FILL	DESCRIPTION
722V				621.89				
	11.40	633.29	/					
140.22L			5.61	27.68	27.73			
" E			6.15	27.14	27.10			
" 2+			5.80	27.42	27.35			
2150L			5.51	27.78	27.79			
" E			6.16	27.13	27.21			
" RT			5.86	27.43	27.46			
100L			5.34	27.25	28.03			
" E			5.80	27.45	27.51			
" RL			5.64	27.65	27.76			
25RT			5.54	27.75	27.91			
" E			5.66	27.63	27.66			
50L			5.57	27.72	27.73			
" E			5.78	27.51	27.48			
" RT			5.59	27.70	27.73			
20L			5.90	27.37	27.37			
" E			6.15	27.14	27.12			
" RT			5.91	27.38	27.37			
50L			6.33	26.74	27.01			
" E			6.55	26.74	26.76			
" RT			6.32	26.27	27.01			
20L			6.58	26.71	26.65			
" E			6.56	26.37	26.40			
" RT			6.53	26.76	26.65			

HUITT-ZOLLARS

E. J. Johnson
RPLS # 4862

SURVEY NOTES

LOCATION _____ PARTY _____ DATE _____
 _____ WEATHER _____
 _____ SHEET 2 OF 2

STATION	+	H.I.	-	ELEV.	GRADE	CUT	FILL	DESCRIPTION
		3325						
1+50 LT			6.89	26.40	26.22			
" C			7.22	26.07	26.04			
" RT			7.03	26.26	26.29			
1+00 LT			7.38	25.91	25.93			
" C			7.62	25.67	25.68			
" RT			7.35	25.94	25.93			
7+15.27 LT			7.47	25.82	25.82			
" C			7.68	25.61	25.57			
" RT			7.39	25.90	25.82			
13+50 RT			6.13	27.14	27.18			5/2/96 SHT 1/2 WIT MEWS

HUITT-ZOLLARS

EJ Johnson
RPLS # 4862

SURVEY NOTES

LOCATION ADDISON CIRCLE PARTY PILLAR DATE 5/10/96
BLUF TOPS TURF WEATHER _____
EXTRA SHEET 1 OF 2

6" sub
 6ed. Rod

STATION	+	H.I.	-	ELEV.	GRADE	CUT	FILL	DESCRIPTION
1#2				621.68		1.96		
10.58	32.24							
4.83				27.43	627.43			
40.23			4.53		27.73			
INV			5.16		27.10			
RT			4.91		27.35			
50 LT			4.47		27.72			
INV			5.05		27.21			
RT			4.80		27.46			
00 LT			4.17		28.09			
INV			4.75		27.51			
RT			4.50		27.76			
25 RT			4.35		27.91			
INV			4.60		27.66			
50 LT			4.53		27.73			
INV			4.78		27.48			
RT			4.53		27.73			
00 LT			4.89		27.37			
INV			5.14		27.12			
RT			4.89		27.37			
00 LT			5.25		27.01			
INV			5.50		26.76			
RT			5.25		27.01			
00 LT			5.61		26.65			
INV			5.86		26.40			
RT			5.61		26.65			

435
115

HUITT ZOLLARS

EJ Johnson
RPLS #4862

SURVEY NOTES

LOCATION _____ PARTY _____ DATE 5/10/96
 _____ WEATHER _____
 _____ SHEET 2 OF 2

Grid
Rec

6" Sub

STATION	+	H.I.	-	ELEV.	GRADE	CUT	FILL	DESCRIPTION
		32.26						
6+50.4	/		5.97		26.25			
" INV	/		6.22		26.04			
" RT	/		5.97		26.25			
7+00.4	/		6.33		25.93			
" INV	/		6.58		25.68			
" RT	/		6.33		25.93			
7+15.3	/		6.44		25.82			
" INV	/		6.69		25.57			
" RT	/		6.44		25.82			

8

HUIITT-ZOLLARS

SURVEY NOTES

LOCATION Advisory Circle PARTY Plaza DATE 5/9/96
61st Street, Plaza SURVEYOR [Signature] WEATHER Partly Cloudy
[Signature] SHEET 1 OF 2
 T.P. ✓ RW 5-13-96

STATION	+	H.I.	-	ELEV.	GRADE	CUT	FILL	DESCRIPTION
2+7 ³ 2				621.60				
	10.62	622.30						
13+30 ³ L+			3.79	628.51	628.23	0.28		
" INV			5.48	628.62	627.68		0.94	3" INV
" RT			"	"	627.85		1.03	3" INV
13+30 L+			3.33	628.97	628.29	0.68		
" INV			5.12	627.18	627.11		2.53	" "
" RT			"	"	627.26		0.78	" "
14+00 L+			3.68	628.62	628.55	0.07		
" INV			4.87	627.43	628.01		0.58	" "
" RT			"	"	628.26		0.83	" "
14+35 RT			4.46	627.84	628.41		0.57	
" INV			"	"	628.16		0.32	
14+40 L+			3.72	628.58	628.27	0.31		
" INV			4.37	627.93	627.98		0.05	" "
" RT			"	"	628.23		0.30	" "
15+00 L+			3.24	628.36	627.87	0.49		
" INV			4.52	627.78	627.62		0.16	" "
" RT			"	"	627.87		0.09	" "
15+10 L+			4.12	628.18	627.51	0.67		
" INV			4.57	627.73	627.26		0.47	" "
" RT			"	"	627.51		0.22	" "
16+00 L+			3.95	628.35	627.15	1.20		
" INV			4.61	627.65	627.05		0.70	" "
" RT			"	"	627.15		0.54	" "

HUITT-ZOLLARS

SURVEY NOTES

LOCATION Advison Circle PARTY Public DATE 5/10/96
with 1/2" scale 5.00' (incl. 1/2" scale) 718100 WEATHER _____
 _____ 718100 SHEET 1 OF 2

STATION	+	H.I.	-	ELEV.	GRADE	CUT	FILL	DESCRIPTION
11+40		639.25		621.85				
13+40	LT		5.61	27.68	27.73			
"	C		6.15	27.14	27.10			
"	RT		5.80	27.40	27.35			
13+50	LT		5.51	27.78	27.79			
"	C		6.16	27.13	27.21			
"	RT		5.86	27.13	27.46			
14+00	LT		5.34	27.55	28.00			
"	C		5.80	27.69	27.51			
"	RT		5.64	27.65	27.76			
14+25	RT		5.54	27.75	27.91			
"	C		5.66	27.103	27.66			
14+50	LT		5.57	27.72	27.73			
"	C		5.78	27.51	27.48			
"	RT		5.59	27.70	27.73			
15+00	LT		5.90	27.30	27.37			
"	C		6.15	27.14	27.12			
"	RT		5.91	27.38	27.37			
15+50	LT		6.32	26.54	27.01			
"	C		6.55	26.74	26.76			
"	RT		6.32	26.57	27.01			
16+00	LT		6.58	26.71	26.65			
"	C		6.52	26.37	26.40			
"	RT		6.53	26.76	26.65			

HUITT-ZOLLARS

9

SURVEY NOTES

LOCATION _____ PARTY _____ DATE 5/9/96
 _____ WEATHER _____
 _____ SHEET 2 OF 2

STATION	+	H.I.	-	ELEV.	GRADE	CUT	FILL	DESCRIPTION
		651.30						
16+50.1			5.02	627.28	626.79	0.49		
" 111			4.13	628.17	626.59	1.68		3" 1111
" 112			"	"	626.79	1.38		
17+00.4			5.12	626.88	626.43	0.45		
" 111			4.06	628.24	626.18	2.06		
" 112			"	"	626.43	1.81		
17+15.3			5.16	626.64	626.32	0.32		
" 111			4.18	628.12	626.07	2.05		
" 112			"	"	626.32	1.80		
0			4.18	628.12				
	2.33	630.45						
B17+3			5.55	624.50	624.50			

U

HUITT-ZOLLARS

SURVEY NOTES

LOCATION _____ PARTY _____ DATE _____
 _____ WEATHER _____
 _____ SHEET 2 OF 2

STATION	+	H.I.	-	ELEV.	GRADE	CUT	FILL	DESCRIPTION
		33.27						
16+50 L+			6.80	26.40	26.29			
" C			7.22	26.07	26.04			
" RT			7.03	26.26	26.29			
17+00 L+			7.38	25.91	25.93			
" C			7.62	25.67	25.68			
" RT			7.35	25.92	25.92			
17+15.27 L+			7.47	25.82	25.82			
" C			7.68	25.61	25.57			
" RT			7.39	25.90	25.92			
18+50 RT			6.13	27.16	27.18			2 1/2" dia SHT 1/2" WITH NAILS

HUITT-ZOLLARS

SURVEY NOTES

LOCATION ADDISON CIRCLE PARTY P.L.L. DATE 5/2/79

1/4" RT BLUR TAPE TURKEY WEATHER _____

_____ 5.0250 SHEET 1 OF 2

Geod. Rod 6" sub

STATION	+	H.I.	-	ELEV.	GRADE	CUT	FILL	DESCRIPTION
BM #2				621.68 ✓		1"		
CHK 13+50 RI	12.58	32.24 ✓	4.83	27.43	627.43			
13+40.25 Lt	-		4.53		27.73 ✓			
" INV	1		5.16 ✓		27.10 ✓			
" RT	-		4.91 ✓		27.35 ✓			
13+10 Lt	-		4.47 ✓		27.73 ✓			
" INV	✓		5.05 ✓		27.21 ✓			
" RT	-		4.80 ✓		27.36 ✓			
14+00 Lt	-		4.17 ✓		28.07 ✓			
" INV	-		4.75 ✓		27.51 ✓			
" RT	-		4.50 ✓		27.16 ✓			
14+25 RT	-		4.35 ✓		27.91 ✓			
" INV	✓		4.61 ✓		27.66 ✓			
13+50 Lt	-		4.53 ✓		27.73 ✓			
" INV	-		4.78 ✓		27.48 ✓			
" RT	-		4.53 ✓		27.73 ✓			
15+00 Lt	-		4.81 ✓		27.27 ✓			
" INV	-		5.14 ✓		27.12 ✓			
" RT	-		4.89 ✓		27.37 ✓			
15+20 Lt	-		5.25 ✓		27.01 ✓			
" INV	-		5.50 ✓		26.76 ✓			
" RT	-		5.25 ✓		27.01 ✓			
16+00 Lt	-		5.61 ✓		26.65 ✓			
" INV	-		5.86 ✓		26.40 ✓			
" RT	-		5.61 ✓		26.65 ✓			

HUITT-ZOLLARS

SURVEY NOTES

LOCATION _____ PARTY _____ DATE 5/10/96

WEATHER _____

SHEET 2 OF 2

6" sub

6" sub

STATION	+	H.I.	-	ELEV.	GRADE	CUT	FILL	DESCRIPTION
		32.26						
16+50.1	/		5.97	26.29				
" INV	/		6.22	26.04				
" RT	/		5.97	26.29				
17+00.1			6.33	25.96				
" INV			6.58	25.68				
" RT	/		6.33	25.96				
17+15.5	/		6.41	25.82				
" INV			6.69	25.57				
" RT	/		6.41	25.82				

#1-1822-08

HUITT-ZOLLARS

EJ Yehandy
RPLS 4862

SURVEY NOTES

LOCATION ADDISON CIRCLE PARTY PILLAR DATE 5-15-96
DROP SLAP VERIFY 7 LINE WEATHER _____
W/IT MEAS, 13+52.17- SHEET 1 OF 2
16+77.31. ✓ D/E 5-10-96
 WASTEWATER LN "8" PARTIAL

STATION	+	H.I.	-	ELEV.	GRADE	CUT	FILL	DESCRIPTION
1093		632.82 ✓		626.89 ✓				FIELD CHANGE OF METERED (2" I.P.E.) ON WEST SIDE OF QUARRY DR. AS PER BILL BROWN
WASTEWATER +36.8'								TOP MH 626.64
3' BUDG		9.59	622.56	622.56				WE. SIDE (SLIP TOP OF PIPE SUBTRACTED 0.67' TO FLOWLINE)
5' STUR		9.69	622.16	622.16				5' FROM BUDG CALL 60' @ MH 23' FROM BUDG -0.46
24 2476			5.34	627.48	622.10	5.93		1.6' @ MH (EXISTING LINE) TOP 626.64 (SEE ATTACHED)
			"	"	626.64	0.84		
								(1 1/2")
3152.24		5.45	27.97	27.91		0.14		TP 28.30 ✓
" INV		5.77	27.05	26.93		0.12		27.72 ✓
" PT		5.74	27.08	27.18		0.10		TP 27.97 ✓
4175.13		5.25	27.54	27.77		0.23		TP = 28.56 ✓
" INV		5.60	27.22	27.19		0.03		27.98 ✓
" PT		5.41	27.41	27.44		0.03		TP = 28.23 ✓
4142.21		5.31	27.51	27.50		0.01		TP 28.29 ✓
" INV		5.59	27.23	27.25		0.02		28.04 ✓
" PT		5.44	27.38	27.50		0.12		TP 28.27 ✓
4100.21		5.55	27.27	27.15		0.12		TP 27.94 ✓
" INV		5.84	26.98	26.90		0.08		TP 27.82 ✓
" PT		5.66	27.16	27.15		0.01		TP 27.76 ✓

HUITT-ZOLLARS

E J Johnson
RPLJ 4862

SURVEY NOTES

LOCATION Witt Mevils PARTY Pillar DATE 5/15/94
Sub God Valley TURNER WEATHER _____
Addison Circle SHEET 2 OF 2

STATION	+	H.I.	-	ELEV.	GRADE	CUT	FILL	DESCRIPTION
					(7 1/2")			
		632.82						
15+38.3 ^{1/2} LT			6.01	26.81	26.80	0.01		TP 27.52 ✓
" INV			6.32	26.50	26.55	0.05		TP 27.30 ✓
" RT			6.12	26.70	26.80	0.10		TP 27.52 ✓
16+29.8 ^{1/2} LT			6.49	26.33	26.19	0.14		26.98 TP ✓
" INV			6.73	26.09	25.94	0.15		TP 26.73 ✓
" RT			6.60	26.22	26.19	0.03		TP 26.98 ✓
16+79.2 ^{1/2} LT			7.06	25.76	25.79	0.03		TP 26.58 ✓
" INV			7.33	25.47	25.54	0.05		TP 26.33 ✓
" RT			7.12	25.70	25.79	0.09		TP 26.58 ✓
TP			4.54	28.28				
	4.73	33.01						
BM #1			11.12	21.80	21.85			
BM #1	10.54	32.43			21.89			FR. CUT ST. 12
13+52.2 ^{1/2} INV			5.24		27.19			
13+95.3 ^{1/2} LT			4.66		27.77			
14+70.3 ^{1/2} LT			5.28		27.15			
" INV			5.53		26.90			
16+29.8 ^{1/2} LT			6.24		26.19			
" INV			6.49		25.94			
3+40.7 ^{1/2} RT			5.08		27.35			

HUIT. ZOLLARS

SURVEY NOTES

LOCATION ADDISON CIRCLE PARTY Fillan DATE 4/9/96
ELEC. DUCT A-B, A-1 TURNER WEATHER 60°-75° SUNNY
Plan Sheet 105/107 (2-28-96) BUTLER SHEET 1 OF 2

Contractor: Gibson & Assoc., Inc. ^{Bid} Contract No. 9628 ✓ D&E 4-10-96

STATION	+	H.I.	-	ELEV.	PROFILE GRADE	CUT	FILL	DESCRIPTION
BM #1		7.69	627.58	621.89				1" CUT ON 1" INLET SOUTH OF MILDRED (190' ± FROM E) ON WEST SIDE OF ADDISON DR. * OFFSET MEAS. to CENTER line of elec. duct
0+00 A"			7.84	621.74	610.00	11.74		BTM 15 1/2 LT HUB
0+88 A" = MH			1.93	627.65	627.27	0.38		RIM 15 1/2 LT HUB
0+00 A-1			"	"	609.00	10.65		BTM
			"	"	607.83	19.82		FF MH
0+88 A" = MH			4.30	625.28	627.27		1.99	RIM 15 1/2 WEST HUB
0+00 A-1			"	"	609.00	16.28		BTM
			"	"	607.83	17.45		FF MH
0+18 A-1			4.99	624.59	609.50	15.09		BTM 15 1/2 WEST HUB
PC 1+51 A			4.37	625.21	609.27	15.94		15 1/2 LT HUB
2+00			4.80	624.78	609.49	15.29		"
2+50			5.32	624.26	609.72	14.54		"
3+00			5.97	623.61	609.95	13.66		"
PT 3+36 70			6.04	623.54	610.12	13.42		"
3+43 A" = MH			6.07	623.51	621.97	1.54		RIM 15 1/2 LT HUB
4+71 B"			"	"	610.12	13.39		BTM
			"	"	608.85	14.66		FF MH
3+43 A" =			7.70	621.80	621.97	0.17		RIM 15 1/2 RT " "
4+71 B"			"	"	610.12	11.68		BTM
			"	"	608.85	12.95		FF MH
LINE "B"								
PI 4+64.02			6.09	623.55	610.12	13.43		15 1/2 RT HUB
PI 4+25.02			6.45	623.13	610.20	12.85		"
4+00					610.38			"

E. J. Johnson R.P.L.S # 4862

HUITT-ZOLLARS

SURVEY NOTES

LOCATION ADRIAN CIRCLE PARTY PILLAR DATE 4/5/96

ELC DECT LINE B, "D" & "E" TURNER WEATHER 60° - 75° SUNNY

Plan Sht. 106/137, (3-28-96) BUTLER SHEET 2 OF 2
108/137, III/137

STATION	+	H.I.	-	ELEV.	PROFILE GRADE	CUT	FILL	DESCRIPTION
		620.58						
7PC 3+27.31			6.52	623.06	610.67	12.39		15 1/2% RT HUB
3+00	4.42	627.48	4.34	623.14	610.78	12.36		PVI. "
2+50			3.54	623.54	611.53	12.41		"
2+00			3.43	624.05	612.28	11.77		"
PL 1+58.1			2.79	624.67	612.91	11.78		"
1+00			1.34	626.14	613.78	12.36		"
Bm #2			5.79	621.62	621.68	(0.01)		" CUT @ CENTER OF 1 ST INLET NORTH OF MILDRED (200 ± FROM E) ON THE WEST SIDE OF QUORUM DR.
Bm #3				624.50				" CUT @ CENTER OF 2 ND INLET NORTH OF MILDRED (200 ± FROM E) ON THE WEST SIDE OF QUORUM DR.
	3.82	628.32						
LINE "D"								
0+00			6.63	621.67	607.60	14.07		RIM 15 1/2% LT HUB
0+50			3.79	624.53	623.15	1.38		RIM 15 1/2% LT HUB
			"	"	607.30	17.23		BTM
			"	"	606.13	18.40		FF MH
0+50			3.59	624.73	623.15	1.58		RIM 15 1/2% RT HUB
			"	"	607.30	17.43		BTM
			"	"	606.13	18.60		FF MH
LINE "E"								
4+75			0.91	627.41	626.51	0.90		Rim 15 1/2% LT HUB
			"	"	610.50	16.91		BTM
			"	"	609.93	18.08		FF MH
4+75 @			0.75	627.57	626.51	1.06		Rim 15 1/2% RT HUB
	1.77	629.34	"	"	610.50	17.07		BTM
			"	"	609.33	18.24		FF MH
PC 5+17.98			4.24	625.05	610.72	14.33		BTM 15 1/2% RT HUB
PL 5+52.24			3.91	625.43	611.22	14.21		"
END 5+64			3.78	625.56	611.30	14.26		"
Bm #3			4.82	624.50	624.51	(0.01)		(SAME AS ABOVE)

EL Mahon RPLS # 4862

HUITT-ZOLLARS

SURVEY NOTES

LOCATION ADDISON CIRCLE PARTY PILLAR DATE 4/9/96

ELEC DUCT 'C', 'C-1' TURNER WEATHER 60°-75° Sunny

Plan Sit. 107/137 (3-28-96) ENTER SHEET 1 OF 2

Contr: Gibson & Assoc., Inc. Contract No. 9628 ✓ DATE 4-10-96

STATION	+	H.I.	-	ELEV.	PROFILE GRADE	CUT	FILL	DESCRIPTION
BTM #2		11.25	632.93	621.68				CUT @ CENTER OF 14" INLET NORTH OF MILDRED (TOP 2 FEET) ON THE WEST SIDE OF QUORUM DRIVE. * OFFSET Measured to center line of elec. duct.
0+00 MH			4.43	628.50	627.64	2.86		RIM 15' 9/8 SOUTH HUB
			"	"	615.20	13.30		BTM
			"	"	614.03	14.47		FF MH
0+00 MH			5.34	627.59	627.64	0.05		RIM 15' 9/8 RT X ON CONC
			"	"	615.20	12.39		BTM
			"	"	614.03	13.56		FF MH
1+00			5.23	627.54	615.93	11.61		BTM 15' 9/8 FT LUG
2+00			4.20	628.73	616.70	12.03		" " "
3+00			5.54	627.39	617.47	9.92		" " "
3+23.0' = MH			5.60	627.33	626.76	0.57		RIM 15' 9/8 RT LUG
3+23.0' C-1			"	"	617.60	9.73		BTM
			"	"	620.60	6.73		BTM C-1
			"	"	616.43	10.90		FF MH
3+23.0' = MH			6.72	626.21	626.76	0.55		RIM 15' 9/8 LT HUB
3+23.0' C-1			"	"	617.60	8.61		BTM
			"	"	620.60	5.61		BTM C-1
			"	"	616.43	9.78		FF MH
PT 3+00.0' C-1			6.54	626.99	620.64	5.75		15' 9/8 LT HUB
PC 3+01.0' C-1			6.36	626.57	620.67	5.90		15' 9/8 LT HUB
2+89.0' C-1			5.38	627.55	620.74	6.81		15' 9/8 EAST HUB
4+00 'C'			6.03	626.90	613.60	13.30		

E. J. Johnson

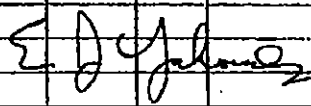
RPLS # 4862

↓ -5.58%

HUITT-ZOLLARS

SURVEY NOTES

LOCATION ADDISON CIRCLE PARTY PILLAR DATE 4/5/96
EGRE DIRT C" TURNER WEATHER _____
Plan Sht. 107/137(3-28-96) EUTAW SHEET 2 OF 2

STATION	+	H.I.	-	ELEV.	PROFILE GRADE	CUT	FILL	DESCRIPTION
		632.93						
4+80.23 RM			7.84	625.09	626.20	1.11		RIM 15' 9" BT HUB
			"	"	609.40	15.62		BTM
			"	"	608.23	16.86		MHFF
								5.15
0 4+80.23 RM			7.59	625.34	626.20	0.86		RIM 15' 9" BT HUB
	5.32	630.66	"	"	609.40	15.94		BTM
			"	"	608.23	17.11		MHFF
BTM #3			6.14	624.52	624.50	(0.02)		" 2" CUT @ CENTER OF 3" INLET NORTH OF MILDEED (620' FROM E) ON THE WEST SIDE OF QUORUM DRIVE.
								RPLS # 4862

ADDISON CIRCLE PHASE I
PUBLIC INFRASTRUCTURE
CONTACT LIST
01-2013-01

TOWN OF ADDISON
16801 Westgrove Drive
P.O. Box 144
Addison, Texas 75001
(214) 450-2871
Fax: 931-6643

- * John Baumgartner
- * Bruce Ellis 450-2847
- * Slade Strickland
- * Barbara Kovacevick (Special Events)
450-2868

BASHARKHAH FLOWER, INC.
Consulting Engineers
6500 Greenville Avenue, Suite 525
Dallas, Texas 75206
(214) 692-5186
Fax: 692-5189
* Scott Guice

BUILDING SCIENCES
8222 Douglas Avenue, Suite 509
Dallas, Texas 75225
(214) 369-7474
Fax: 891-1717
* Jerry Morgan

COLUMBUS REALTY TRUST
15851 Dallas Parkway, Suite 855
Dallas, Texas 75248
(214) 770-5148
Fax: 770-5129
* Mark Brandenburg

JOB TRAILER
COLUMBUS REALTY TRUST
Fax: 726-0562
* Mark Brandenburg (214) 726-~~9347~~⁰⁴³⁷
* Fernand Hollier (214) 726-0560

DAVIS EXCAVATION

, Texas
(903) 482-6076
Beeper: (903) 415-4877
Fax:
* Drew Davis

FUGRO-MCCLELLAND
2880 Virgo Lane
Dallas, Texas 75229
(214) 484-8301
Fax: 620-7328
* Saad Hineidi
* Skip Martin
* Pat Nichols

GIBSON & ASSOCIATES INC.
11210 Rylie Crest Drive
Balch Springs, Texas 75180
(214) 557-1199
Fax: 557-1552
* Tony Johnston
* Mark Person (532-9684 Mobile)
204-4110 (Pager)

HUITT-ZOLLARS, INC.
3131 McKinney Avenue, Suite 600
Dallas, Texas 75204
(214) 871-3311
Fax: 871-0757
* David Meyers
* Bill Brown

LLANO CONSTRUCTION
1475 Richardson Drive, Suite 245
Richardson, Texas 75080
(214) 690-6681
Fax: 690-6371
Mobile: 725-6960
* Jeff Hicks

LONE STAR GAS
2095 N. Collins, Suite 101
Richardson, Texas 75080
(214) 235-4554
Fax: 235-4690
Pager: 359-0131
* Jeanne Hooker

MEL'S ELECTRIC SERVICE

() 565-1074
Fax: 565-1081
* Johnny Heine

MORRISON DESIGN & CONSULTING
P.O. Box 506
Euless, Texas 76039-0506
(817) 267-9889
Fax: 267-1742
Pager: 942-2756
* Jerry Morrison, P.E.

MTS
1201 North Richardson Drive, Suite 200
Richardson, Texas 75080
(214) 783-3000
Fax: 783-3099
* John Hannah

NEWMAN JACKSON BIEBERSTEIN INC.
Banner Place North
12770 Coit Road, Suite 210
Dallas, Texas 75251
(214) 233-2033
Fax: 233-2022
* Paul Shaw
* Gene Newman

PALM INC.

, Texas
() 931-1554
Fax: 931-7544
* Brendan O'Driscoll

RTKL ASSOCIATES, INC.
2828 Routh Street
Dallas, Texas 75201
(214) 871-8877
Fax: 871-7023
* Jeffrey M. Nigh

TU ELECTRIC
14400 Josey Lane
Farmers Branch, Texas 75234
(214) 888-1343
Fax: 888-1304
* George Esqueda