


2000-3 Arapaho Road

Phase III Construction (Archer Western) - 2005

✓
Wester



Archer Western
Contractors

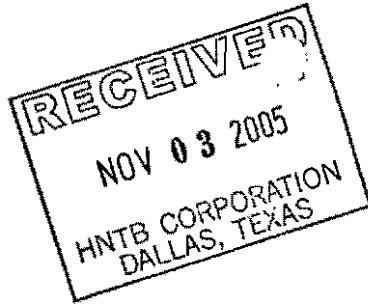

file: Arapaho Rd

November 3, 2005

HNTB
5910 W Plano Parkway
Plano, Texas 75093
Attn: Guy Van-Baulen

RE: Midway Road Signing

Dear Guy:


Per your request, a copy of the T.C.P for shutting Midway Road for pavement replacement.

Sincerely,

A handwritten signature in black ink, appearing to read 'Don Good'.

Don Good
Project Superintendent

* Nancy Cline

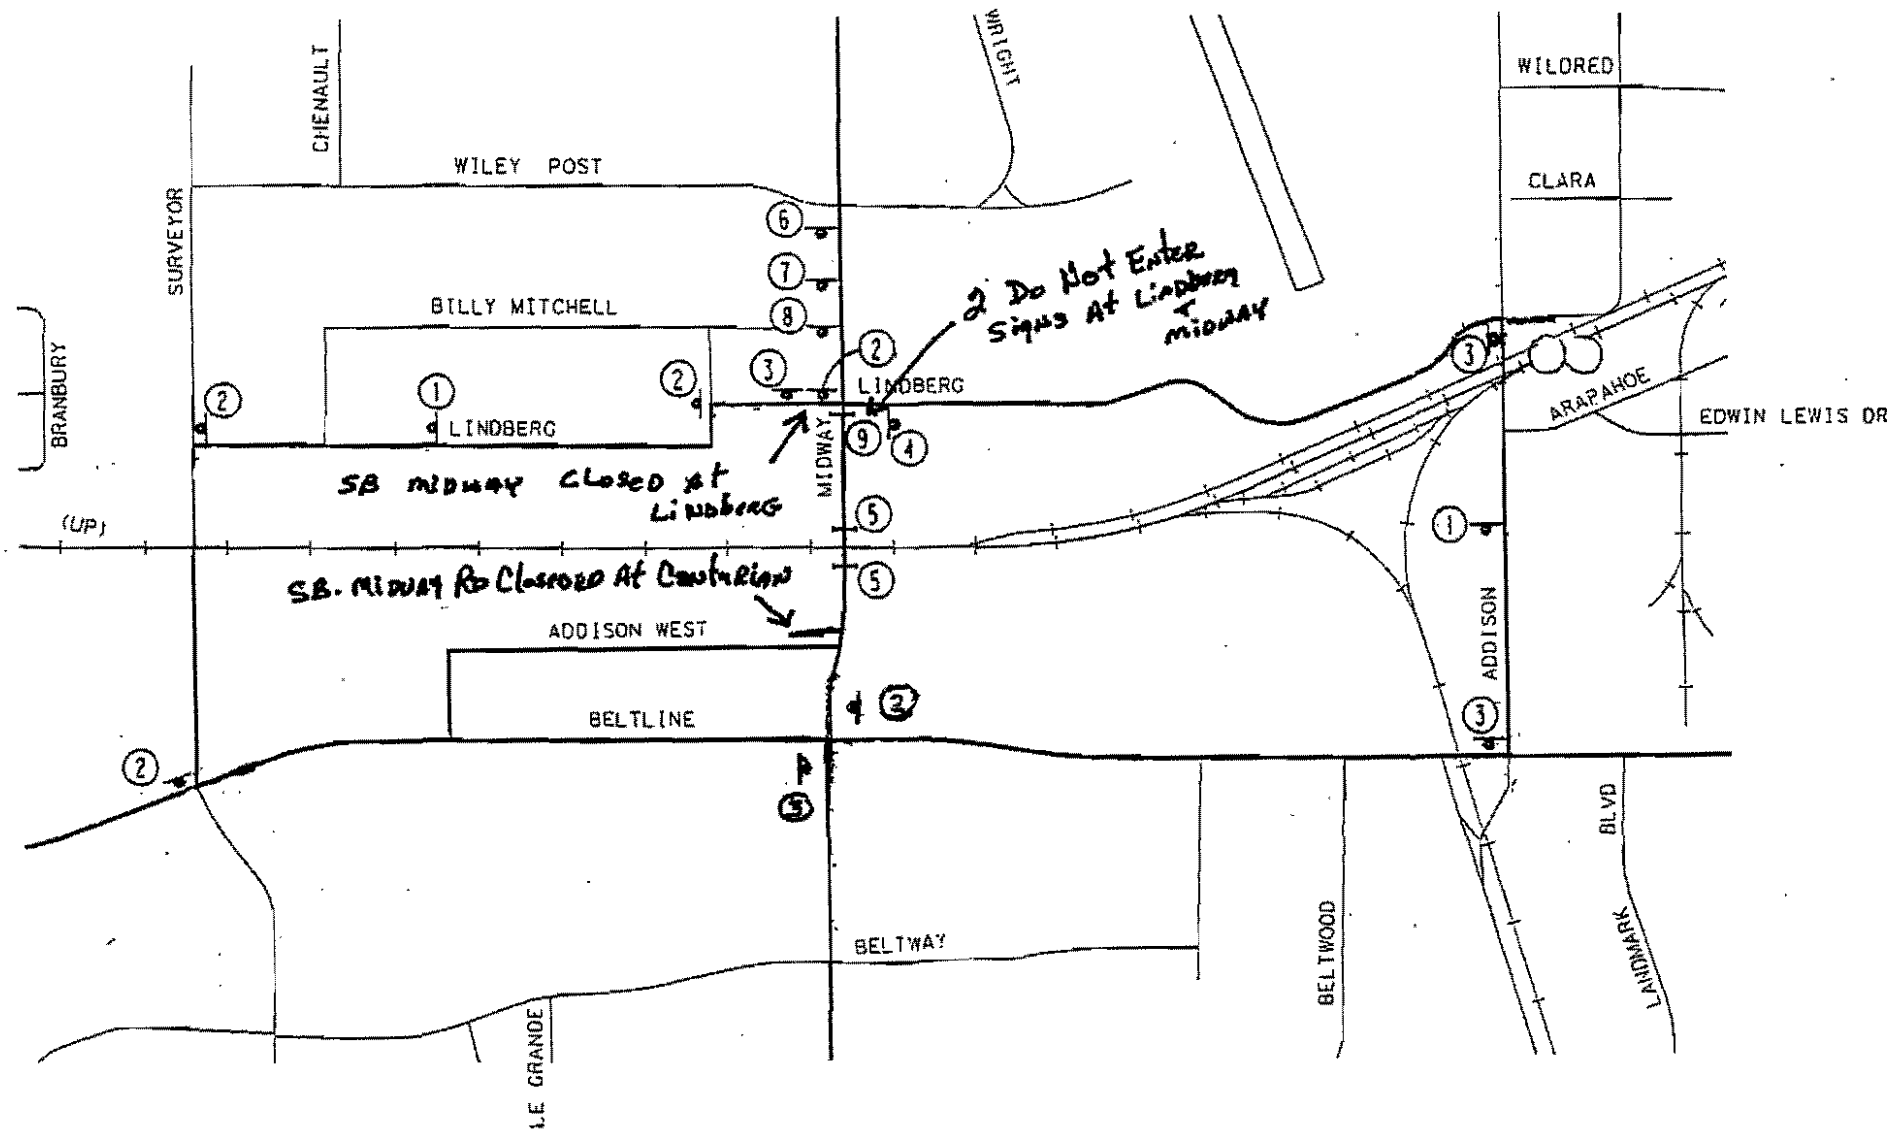

- LEGEND**
- [] TYPE III BARRICADE
 - + CONSTRUCTION SIGN



GENERAL NOTES:

1. CONTRACTOR SHALL UTILIZE THE DETOUR ONLY DURING NIGHTTIME BRIDGE OPERATIONS APPROVED BY THE TOWN OF ADDISON.
2. CONTRACTOR SHALL ADVERTISE 7 DAYS IN ADVANCE OF ROAD CLOSURE UTILIZING MESSAGE BOARDS AND LOCAL MEDIA.
3. CONTRACTOR IS ALLOWED TO LEAVE THE DETOUR IN PLACE WHEN NOT USED AS LONG AS SIGNS ARE COVERED AND NOT READABLE.
4. ALL TRAFFIC CONTROL ELEMENTS INCLUDING THE RETURN OF MIDWAY ROAD MEDIAN TO ITS ORIGINAL CONDITION IS THE RESPONSIBILITY OF THE CONTRACTOR AND SHALL BE INCLUDED IN THE UNIT BID PRICE FOR TRAFFIC CONTROL.


PLAN VIEW

South Bound Midway Closure


*Fri 11/4/05
 Close SB ONLY At 10:00 PM
 Place New Concrete At 10 AM 11/5/05
 Open Roadway No Later Than 6 AM MON 11/7/05*

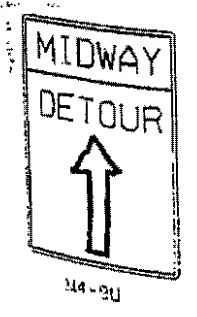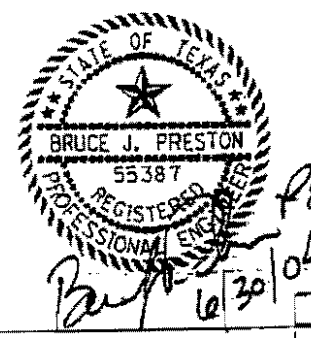


①

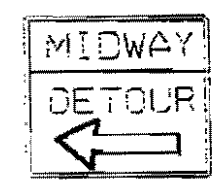


②

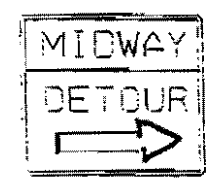


③

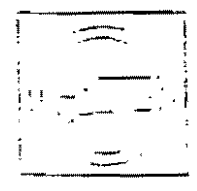

④

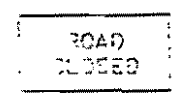


⑤

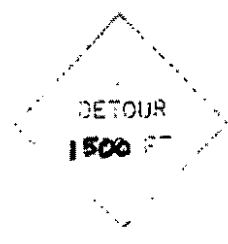


⑥



⑦

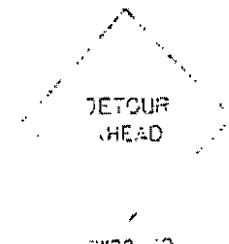

⑧

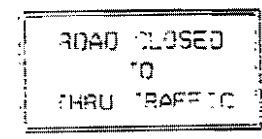


⑨

30A	
DESIGNED BY	PROV.
DATE	REVISION
URS	
ARAPAHO ROAD - PHASE III	
SURVEYOR BOULEVARD TO ADDISON ROAD	
MIDWAY DETOUR	
TOWN OF ADDISON TEXAS	

STATE OF TEXAS PROFESSIONAL ENGINEER BRUCE J. PRESTON 55387

LEGEND

- | TYPE III BARRICADE
- + CONSTRUCTION SIGN

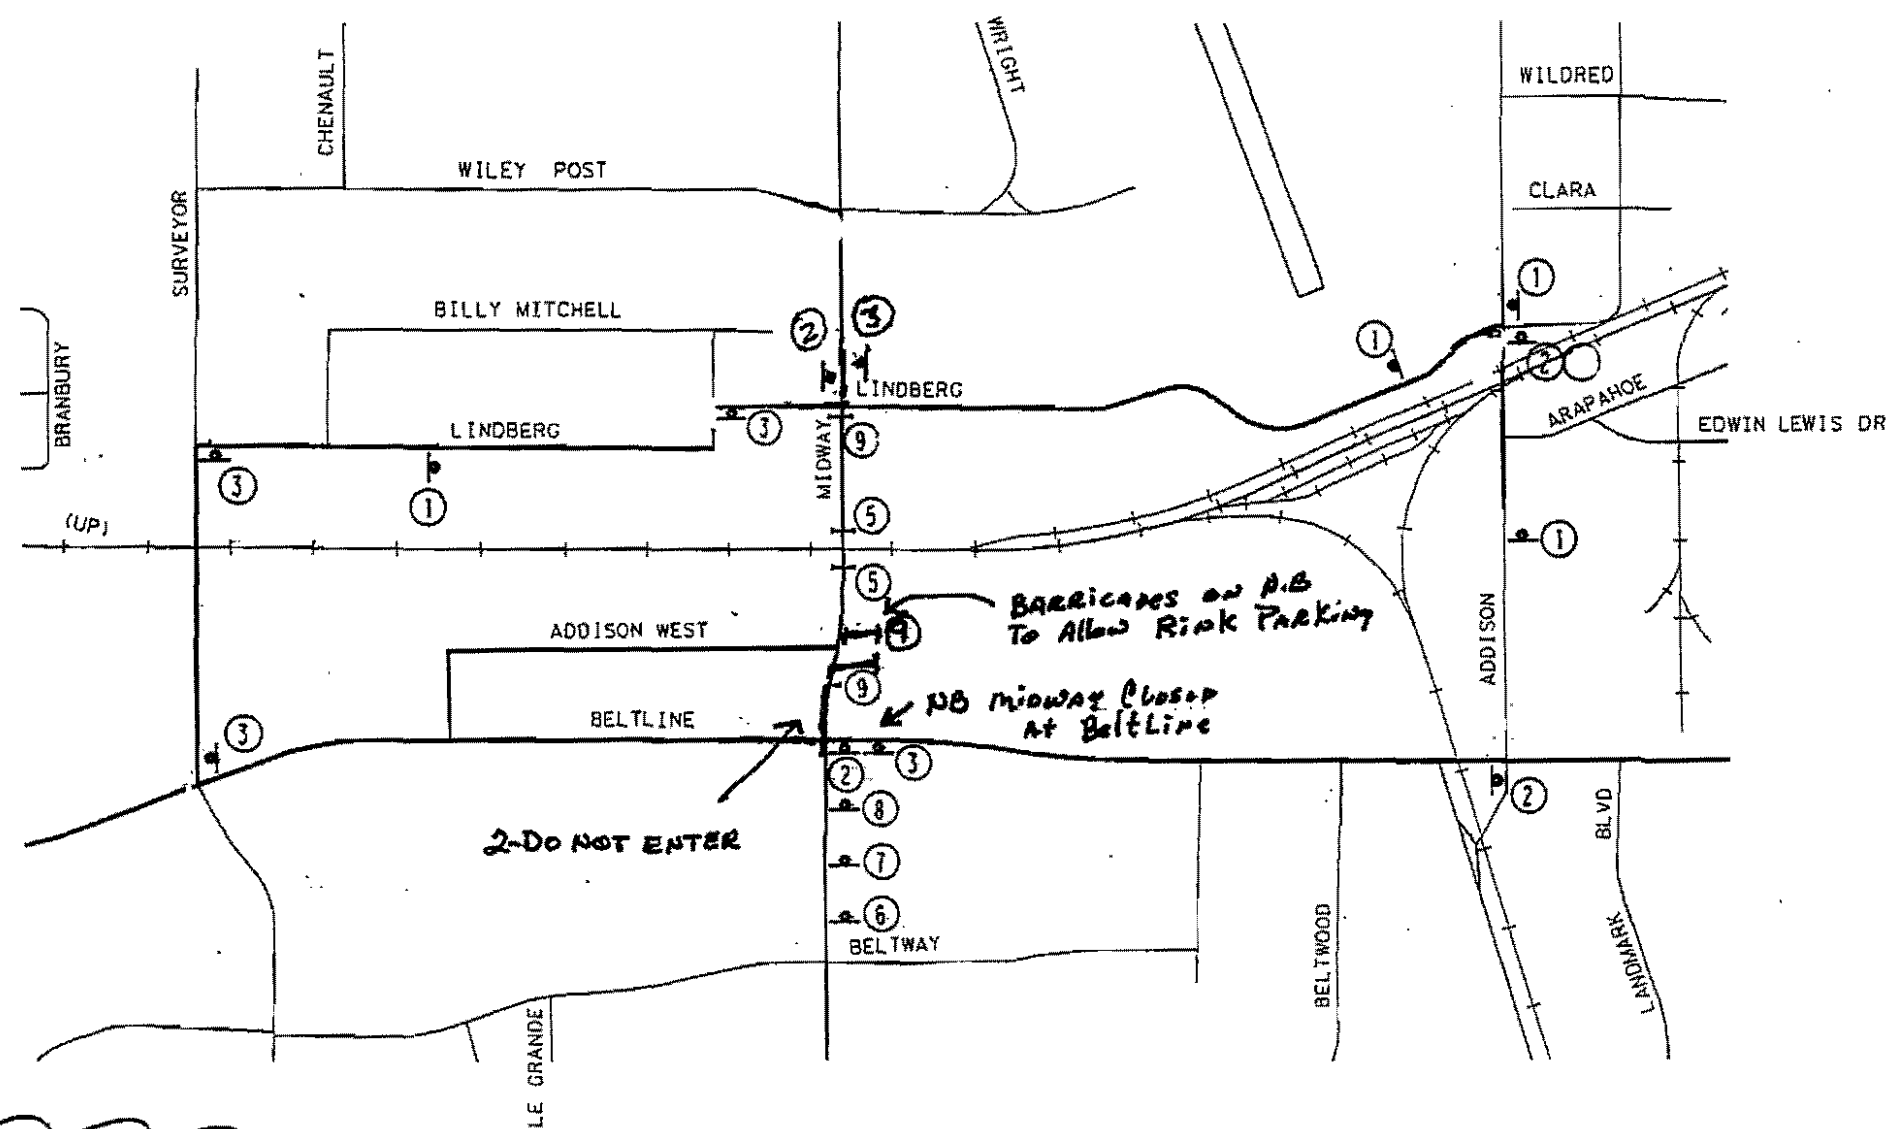


GENERAL NOTES:

1. CONTRACTOR SHALL UTILIZE THE DETOUR ONLY DURING NIGHTTIME BRIDGE OPERATIONS APPROVED BY THE TOWN OF ADDISON.
2. CONTRACTOR SHALL ADVERTISE 7 DAYS IN ADVANCE OF ROAD CLOSURE UTILIZING MESSAGE BOARDS AND LOCAL MEDIA.
3. CONTRACTOR IS ALLOWED TO LEAVE THE DETOUR IN PLACE WHEN NOT USED AS LONG AS SIGNS ARE COVERED AND NOT READABLE.
4. ALL TRAFFIC CONTROL ELEMENTS INCLUDING THE RETURN OF MIDWAY ROAD MEDIAN TO IT'S ORIGINAL CONDITION IS THE RESPONSIBILITY OF THE CONTRACTOR AND SHALL BE INCLUDED IN THE UNIT BID PRICE FOR TRAFFIC CONTROL.


North Bound Midway Closure

PLAN VIEW

*Fri 11/11/05
 Close North Bound ONLY at 10:00PM
 Place New Concrete at 8:00AM 11/12/05
 Open Roadway no later than 6AM MON 11/14/05*

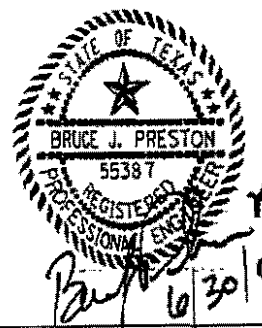


Paul 6/30/04

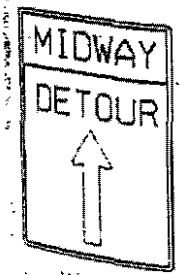


M4-9U

①

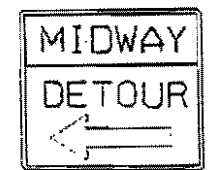

M4-9R

②

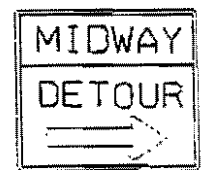

M4-9L

③




R5-2

④




R11-2
ON TYPE III BARRICADE!

⑤

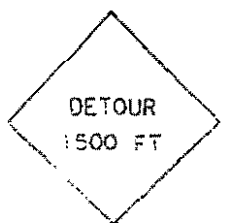


DW20-2A

⑥

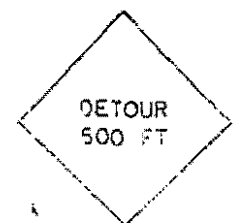


DW20-2C

⑦

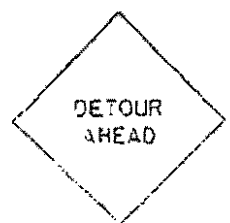

DW20-2D

⑧

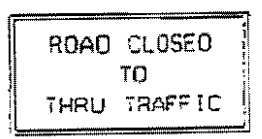


R11-4
ON TYPE III BARRICADES

⑨

30A	
NO. DATE	REVISED
URS	
ARAPAHO ROAD - PHASE III	
SURVEYOR BOULEVARD TO ADDISON ROAD	
MIDWAY DETOUR	
TOWN OF ADDISON, TEXAS	
Drawn	Checked
Scale	Project
Sheet No.	FC-5

LEGEND

- [TYPE III BARRICADE
- + CONSTRUCTION SIGN

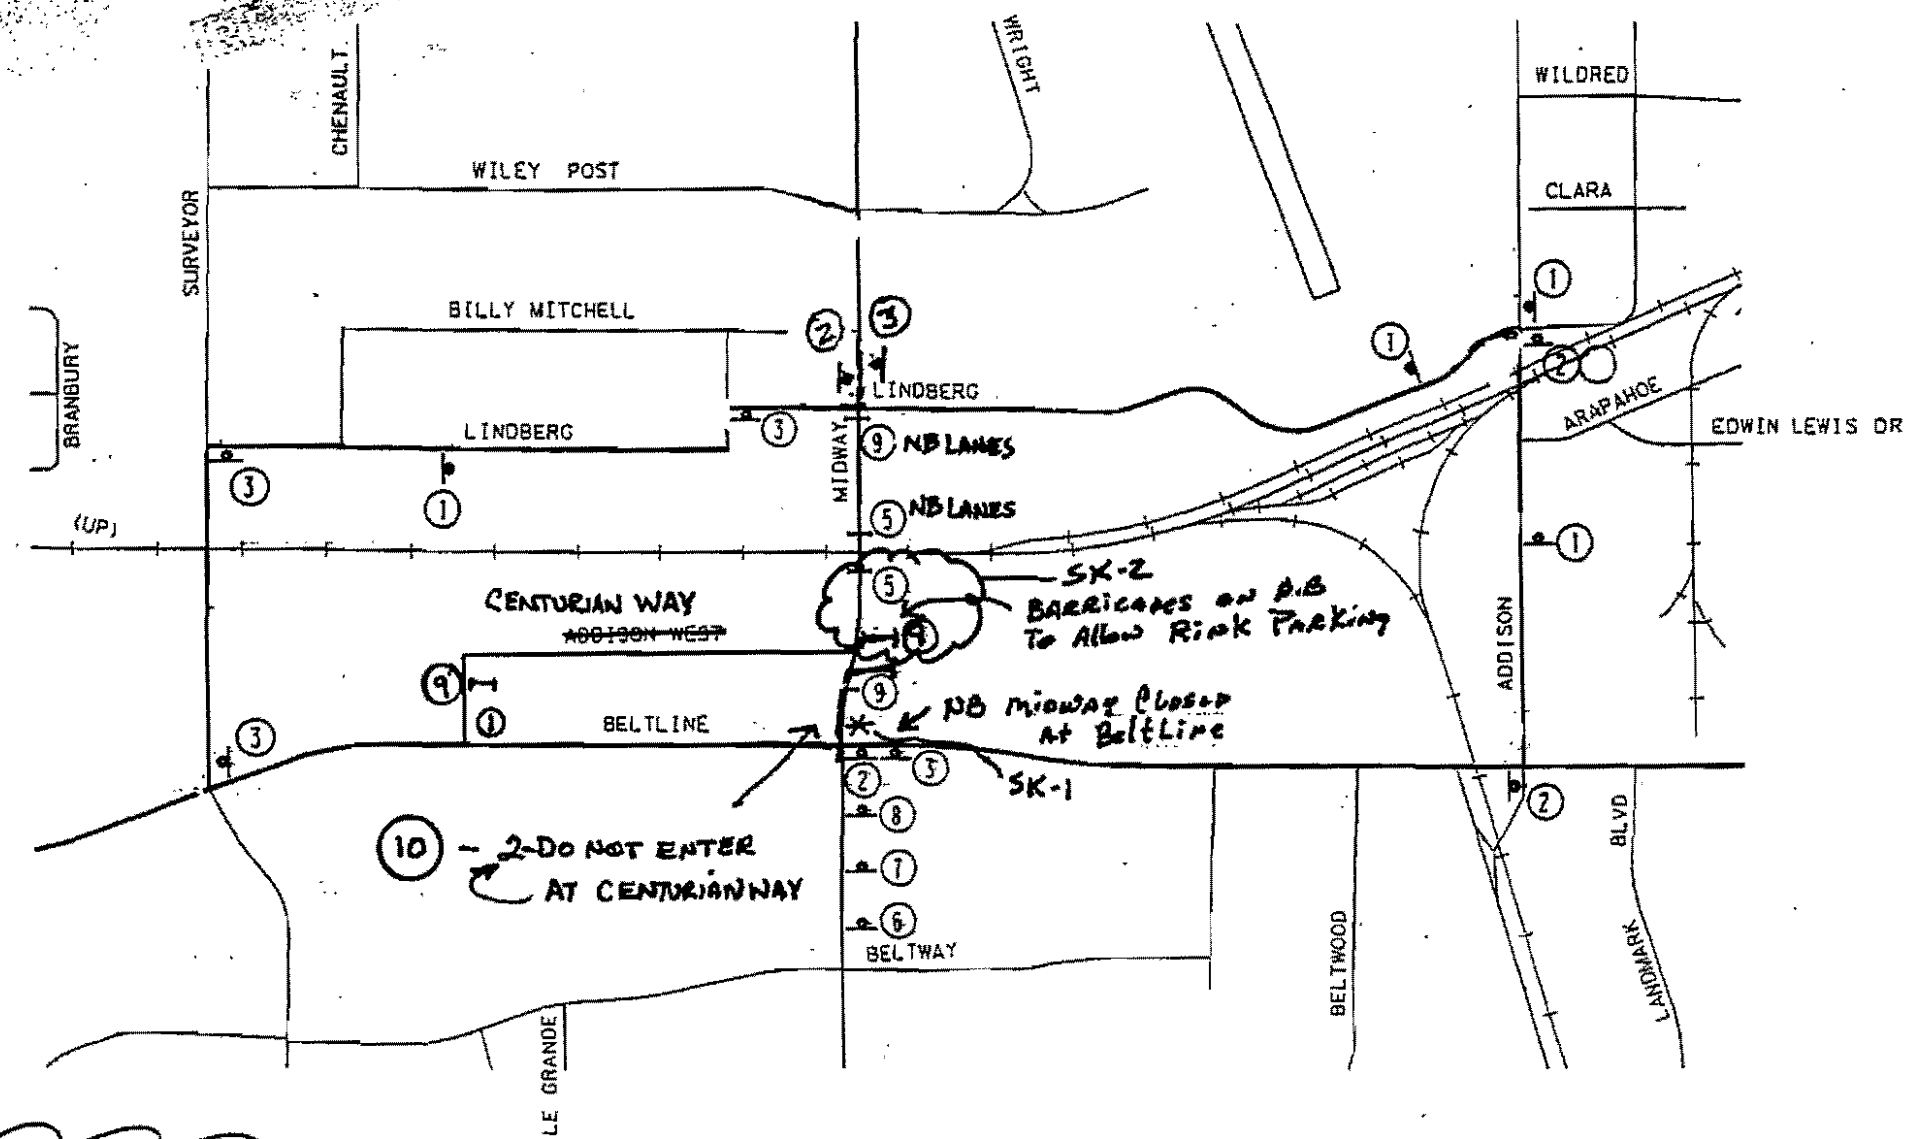

GENERAL NOTES:


1. CONTRACTOR SHALL UTILIZE THE DETOUR ONLY DURING NIGHTTIME BRIDGE OPERATIONS APPROVED BY THE TOWN OF ADDISON.
2. CONTRACTOR SHALL ADVERTISE 7 DAYS IN ADVANCE OF ROAD CLOSURE UTILIZING MESSAGE BOARDS AND LOCAL MEDIA.
3. CONTRACTOR IS ALLOWED TO LEAVE THE DETOUR IN PLACE WHEN NOT USED AS LONG AS SIGNS ARE COVERED AND NOT READABLE.
4. ALL TRAFFIC CONTROL ELEMENTS INCLUDING THE RETURN OF MIDWAY ROAD-MEDIAN TO IT'S ORIGINAL CONDITION IS THE RESPONSIBILITY OF THE CONTRACTOR AND SHALL BE INCLUDED IN THE UNIT BID PRICE FOR TRAFFIC CONTROL.

North Bound Midway Closure


PLAN VIEW

Fri 11/11/05

*Close North Bound ONLY at 10:00 PM
Place New Concrete at 8:00 AM 11/12/05
Open Roadway No Later Than 6 AM Mon 11/14/05*

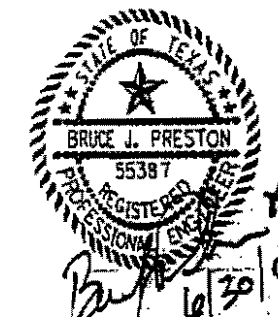


Signature and date: 10/30/04

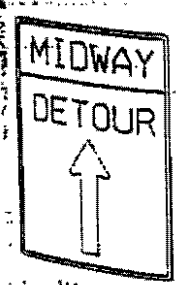


M4-9U

①

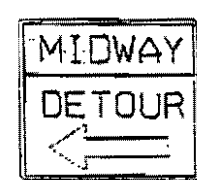

M4-9R

②

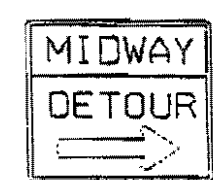


M4-9L

③




R5-2

④

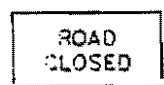


R11-2
ON TYPE III
BARRICADE

⑤

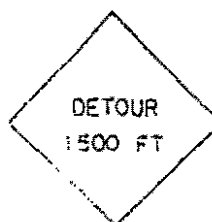


DW20-2A

⑥

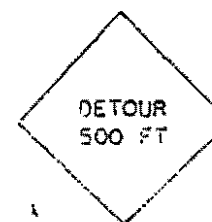


DW20-2C

⑦

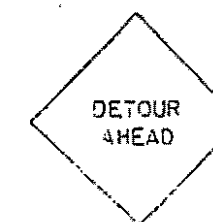

DW20-2D

⑧

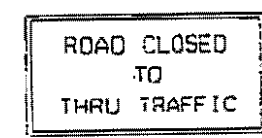


R11-4
ON TYPE III BARRICADE


⑨



30A	
DATE	APPROV.
URS	
ARAPAHO ROAD - PHASE III	
SURVEYOR BOULEVARD TO ADDISON ROAD	
MIDWAY DETOUR	
TOWN OF ADDISON, TEXAS	

*

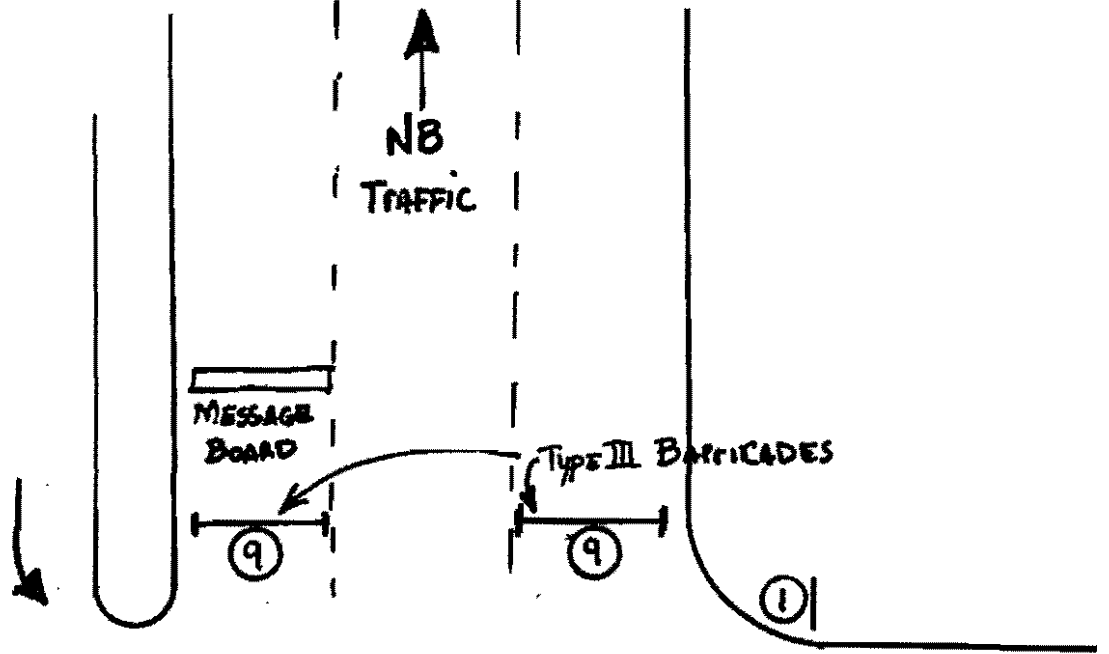

Belt Line Rd / Midway Rd

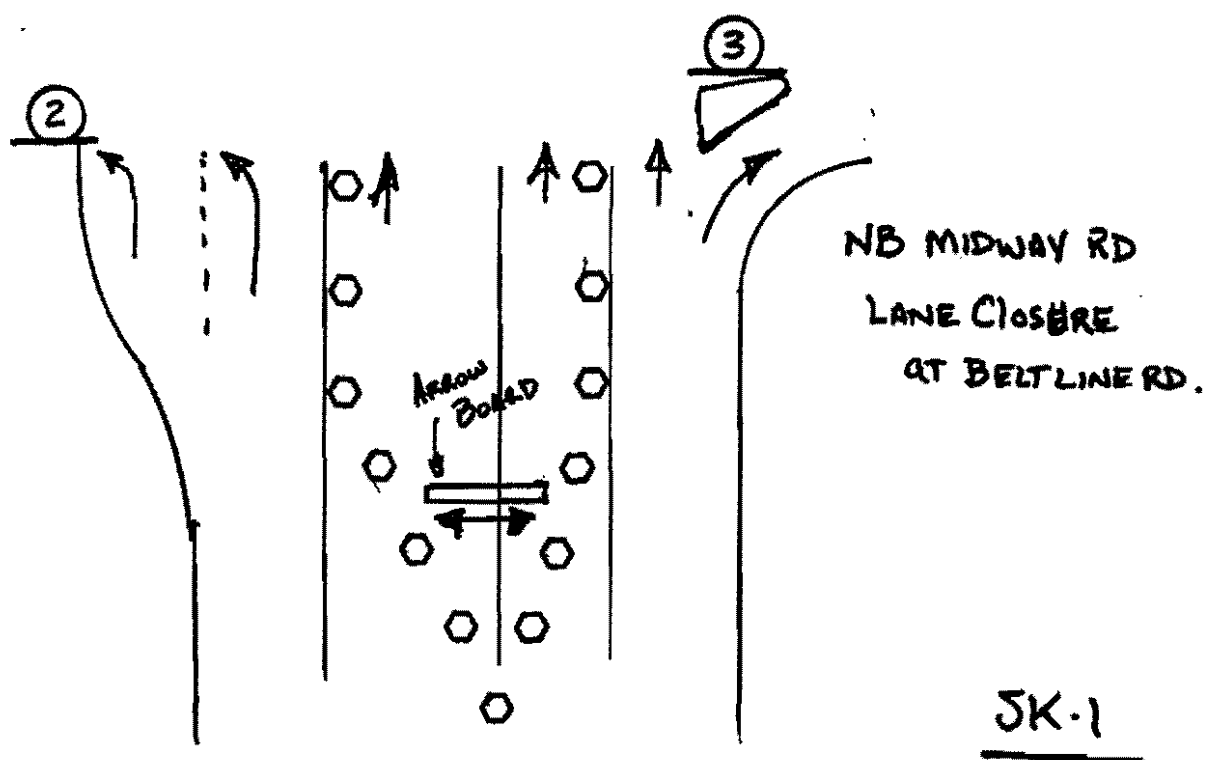

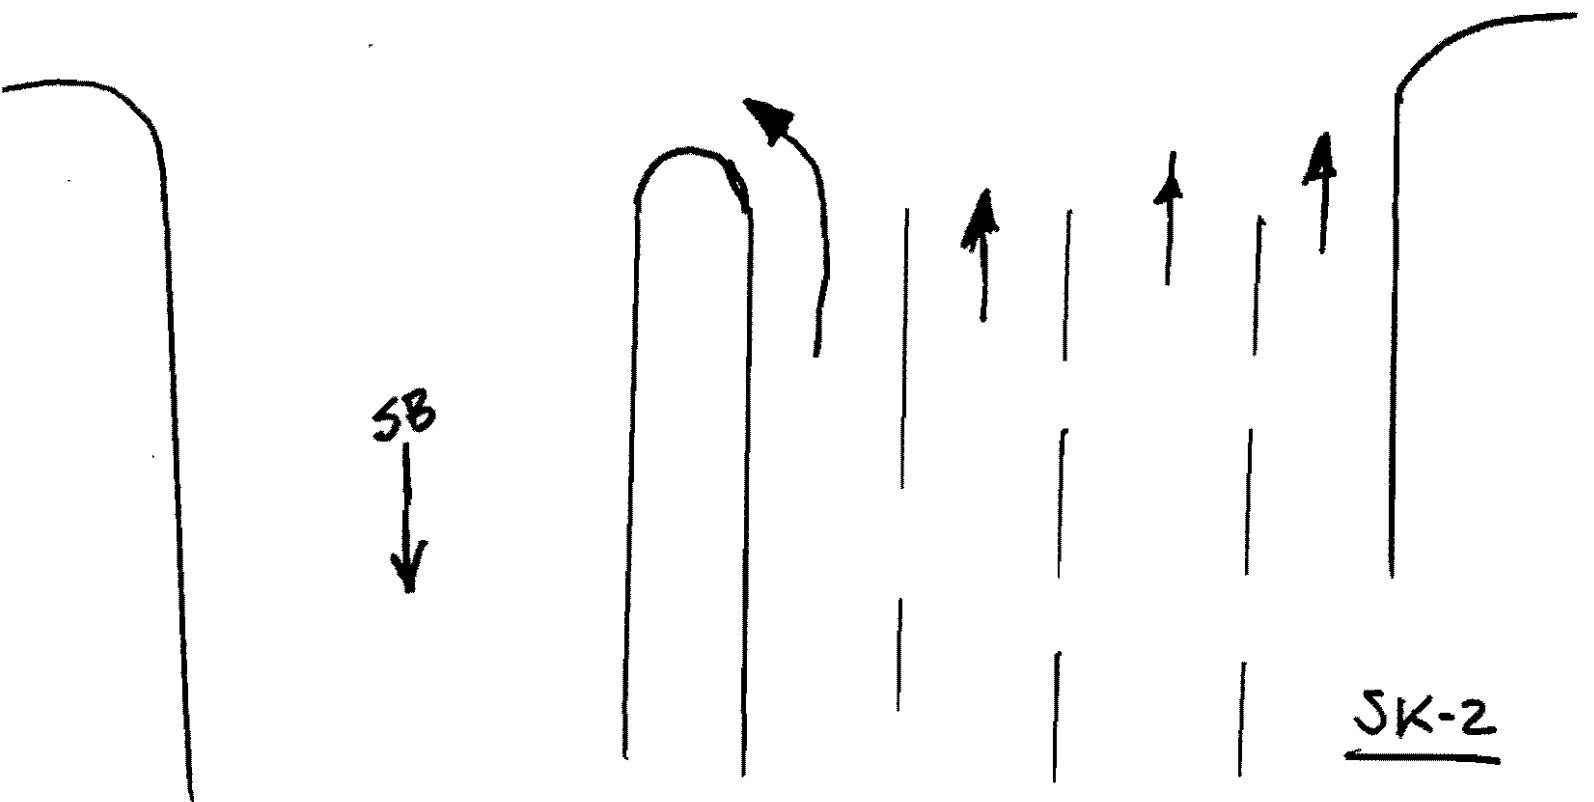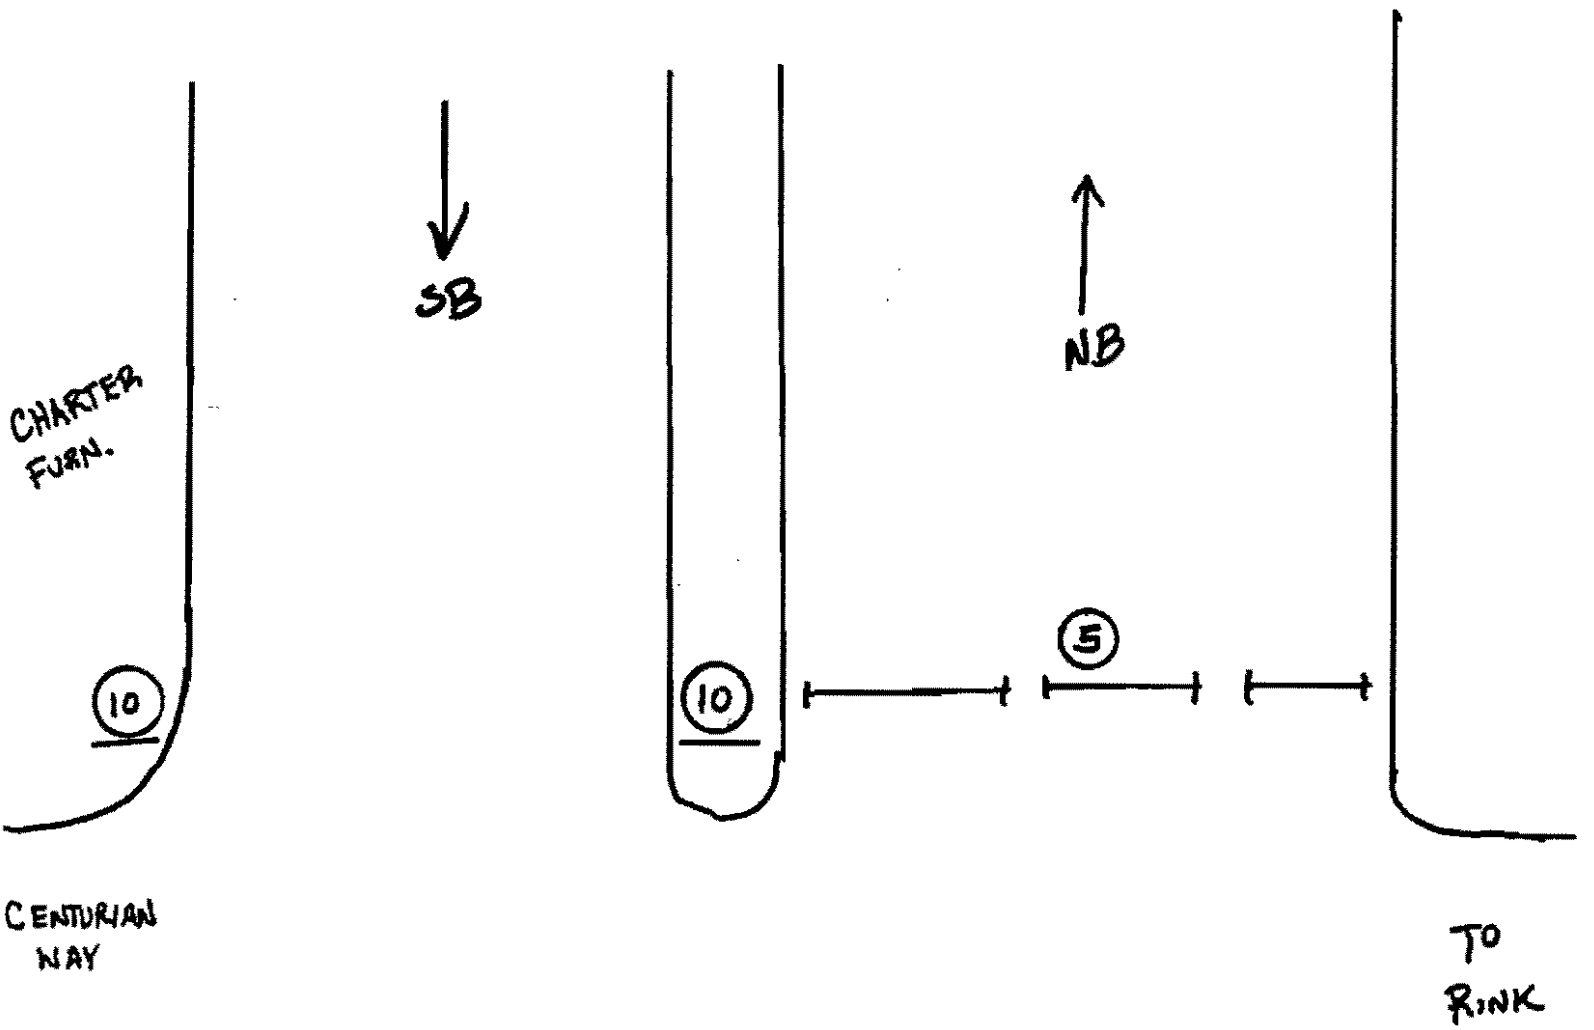

SUMMARY

JIM

11-18-04

Summary of Soil Analytical
Arapaho Road
Town of Addison

COC	PCL mg/K	East Pit mg/K	West Pit mg/K	West Pit Fill mg/K
SVOC				
Bis (2-ethyl-hexyl) phthalate	43.15708	0.140	0.072	0.210
Benz-a-anthracene	5.653404	<0.0042	<0.0041	0.030
Benzo-a-pyrene	0.564016	<0.0042	<0.0041	0.020
Benzo-b-fluoranthene	5.713332	<0.0042	<0.0041	0.040
Chrysene	2369.959	<0.0042	<0.0041	0.020
Fluoranthene	1917.259	<0.0042	<0.0041	0.048
Phenanthrene	415.7173	<0.0042	<0.0041	0.040
Pyrene	1116.515	<0.0042	<0.0041	0.040
SVOCs (not listed above)		ND	ND	ND

RCRA 8					TX Background
Arsenic	5.019162	5.400	14.000	18.000	5.9
Barium	443.8323	95.000	220.000	450.000	300
Cadmium	1.509581	0.900	<0.69	<0.69	
Chromium	2400.192	11.000	15.000	17.000	
Lead	3.028743	12.000	14.000	17.000	15
Mercury	0.007816	<0.028	0.043	<0.028	
Selenium	2.295808	<0.070	<0.69	<0.69	
Silver	0.478594	<0.017	<0.17	<0.17	

VOC			
VOCs (not listed above)		ND	ND

TPH			
C6-C12	<7.0	<6.9	9
C12-C28	<7.0	<6.9	19
C28-C35	<13.9	<13.8	28

Summary of Groundwater Analytical
Arapaho Road
Town of Addison

11-18-04

COC	PCL mg/L	East Pit mg/L	West Pit mg/L
SVOC			
Methylnaphthalene, 2-	0.097768	<0.0001	0.0009
Acenaphthene	1.466518	0.0039	0.0100
Anthracene	7.332589	<0.0001	0.0010
Benz-a-anthracene	0.00125	<0.0001	0.0009
Benzo-a-pyrene	0.0002	<0.0001	0.0005
Benzo-b-fluoranthene	0.00125	<0.0001	0.0009
Bis (2-ethyl-hexyl) phtalate	0.006	0.0006	0.0020
Chrysene	0.125	<0.0001	0.0009
Dibenzofuran	0.097768	<0.0001	0.0020
Fluoranthene	0.977679	0.0012	0.0033
Fluorene	0.977679	0.0008	0.0034
Naphthalene	0.488839	<0.0001	0.0040
Phenanthrene	0.733259	<0.0001	0.0041
Pyrene	0.733259	0.0007	0.0023
SVOCs (not listed above)		ND	ND
METALS			
Arsenic	0.01	0.014	0.017
Barium	2	0.150	0.360
Cadmium	0.005	<0.0010	<0.001
Chromium	0.1	0.004	0.012
Lead	0.015	<0.006	0.051
Mercury	0.002	<0.0002	<0.0002
Selenium	0.05	0.008	0.009
Silver	0.12221	<0.001	0.002
VOC			
Cumene (isopropylbenzene)	2.444196	0.0005	0.0007
Butylbenzene, n-	0.977679	<0.0005	0.0015
VOCs (not listed above)		ND	ND
TPH			
C6-C12		<0.5	<0.5
C12-C28		<0.5	<0.5
C28-C35		<1.0	<1.0

ARAPAHO ROAD, MARSH LANE TO ADDISON ROAD

Project Budget Description	Project # Amount
Bond Funds	\$20,500,000
County funds (have received)	\$1,432,812
Dart Lap	\$2,363,878
Addison Road/Excel	\$230,000
Midway Road	\$2,650,000
Transfer from Dart Lap Quiet Zone fund	\$373,000
Addison Road Dart Lap	\$1,177,000
total available funds	\$28,726,690
Phase II, Marsh to Surveyor	
Sub Total	\$4,233,889
Phase III, Surveyor to Addison Road	
ROW analysis	\$44,977
HNTB Design Fee	\$1,046,679
Evaluation Associates	\$39,000
HNTB Urban Design (streetscape)	\$51,000
HNTB Landscape Architecture	\$87,291
Gensler lighting	\$13,000
Metro Brick Parcel #1	\$95,150
Joe's Auto Body Parcel #2	\$173,202
Union Pacific Railway Company Parcel #3	\$1,204,217
The City of Dallas Parcel #4	\$13,018
Heritage Inn Parcel #5	\$60,869
Motel 6 Parcel #6	\$332,795
Charter Furniture Parcel #7	\$166,446
Gary Crouch/MBNA Parcel #8	\$225,000
John Wilson Parcel #9	\$58,921
Harbour Group Parcel #10	\$29,768
Dale Bullough/Metrocrest 1 Parcel #11	\$29,357
Public Storage of Dallas, Ltd. Parcel #12	\$1,583,210
Public Storage of Dallas, Ltd. Parcel #13	Included in #12
Audit and Legal Fees	\$125,000
Bridge Design	\$550,965
roadway improvements	\$4,947,345
Utility improvements	\$3,741,304
Lighting and Signalization Improvements	\$614,221
ONCOR Utility Relocation	\$282,000
SBC Utility Relocation	\$39,000
Streetscape Improvements	\$1,129,911
Bridge Construction	\$5,255,580
Bridge Lighting	\$709,872
Bridge Design Stipend	\$30,000
URS bridge concept meeting	\$19,570
Wye Track Crossing Fee	\$2,500
Environmental reports	\$7,210
Hipes & Associates	\$40,365
Pat Haggerty	\$2,805
Evaluation Associates	\$21,750
Bridge Pre-Submittal meeting @ Stone Cottage	\$706
Alternate #1 - Addition of Pocket Park improvements	\$343,446
Alternate #2 - difference in aluminium and steel light poles	\$31,100
Total, Phase III	\$23,086,349
Total Expenses	\$27,320,238
Total over/under budget	\$1,406,452

10-5-04



Archer Western
Contractors

dep

June 29, 2004

Steve Chutchian
Town of Addison
Department of Public Works
16801 Westgrove
Addison, TX. 75001

Dear Mr. Chutchian,

Per Item N of the special Provisions, the tentative work to be performed by Archer Western will be as follows:

- General Site Preparation
- Excavation
- Embankment
- Removals and Disposals
- Reinforced Concrete Pavement
- Retaining Walls
- Bridge Construction
- Sanitary Sewer
- Storm Sewer
- Water Line

We are currently evaluating proposals from subcontractors for storm sewer and concrete pavement construction. We will notify the town of Addison if we choose to subcontract this work.

Attached is a list of subcontractors and suppliers which will be used on this project.

If you have any questions do not hesitate to contact me at 817-503-0298.

Thank You


Ben Withered
Project Manager

No.	Subcontractors	Item of Work	Address	Phone	Fax	Contact
2	American Landscape Systems	Landscaping/ Irrigation	2314 Glenda Lane, Dallas, TX. 75229	972-484-5858	972-484-7470	
3	ATS Drilling	Drill Shafts	PO Box 48353, Ft Worth, TX. 76148	817-498-0040	817-831-2938	
5	Dallas Light and Barricade	Traffic Control	1607 Ft. Worth Avenue, Dallas, TX. 75208	214-748-5791	214-748-3586	
7	Haukos	Trenching	16352 Dallas Pkwy Suite 136-313, Dallas, TX. 75287	972-386-4220	972-480-5059	
9	Longhorn Road Boring Co.	Jack and Bore	PO Box 810001, Dallas, TX. 75381	972-241-8686	972-241-5557	
10	North Texas Erosion	Erosion Control	2426 Westwood Avenue, Mesquite, TX. 75150	214-664-9700	214-664-9701	
11	Paver Construction	Brick Pavers	PO Box 660, Cedar Hill, TX. 75106	972-299-2246	972-299-2258	
12	Primate Construction	Saw and Seal	PO Box 1509, Humble, TX. 77347	281-441-3355	281-441-3414	
13	Renolds Asphalt & Construction	Asphalt	PO Box 370, Euless, TX. 76039	817-267-3131	817-267-1878	
14	BTA	Striping	PO Box 850 Rockwall, TX. 75087	972-771-3832	972-771-8525	
15	S&J Electric	Electrical	PO Box 121616, Fort Worth, TX. 76121	817-443-3591	817-443-3692	
16	Scott Derr Painting	Paint	PO Box 1848 Friendswood Tx 77549	281-480-0158	281-480-0157	
17	Lone Star Railroad Contractors	Rail Crossings	PO Box 1150, Ennis, TX. 75120	972-878-9500	972-878-9503	
	Suppliers					
25	CBSI	Strand	245 McCarty Dr., Houston, TX. 77029	713-675-1180	713-675-1140	
27	Gordon Specialties Inc.	SEJ 4"	720 W. Wintergreen Hutchins, Texas 75141	972-225-1660	972-225-6662	
28	Hanson Pipe Products	RCP/RCB	1003 N MacArthur Blvd, Grand Prairie, TX. 75050	972-262-3600	972-266-7456	
29	Hardrock Products	River Cobble	PO Box 1007, Azle, TX. 76020	817-237-9100	817-238-7272	
30	King Fabrication	Steel Arch	19300 West Hardy Road, Houston, TX. 77073	281-209-0811	281-209-1774	
31	Lofland	Rebar	4100 North I-35E, Waxahachie, TX. 75165	972-299-5106	972-938-9419	
32	Martin Marietta	Aggregates	PO Box 2466, Denton, TX. 76202	940-243-8520	940-323-1270	
33	North Texas Trucking	Select Fill	PO Box 542842, Dallas, TX 75354	214-904-8263	214-904-8089	
35	Southern Star Concrete	Concrete	8505 Freeport Pkwy, Irving, TX. 75063	972-621-0345	469-417-1387	
36	Structural & Steel Products	Metal Deck	1320 S University # 701 Ft Worth Tx 76107	817-332-7417	817-332-2992	
37	Texas Welded Wire	Precast Wall Panels	645 West Hurst Blvd. Hurst, TX. 76053	817-282-4560	817-285-9608	