


Jim

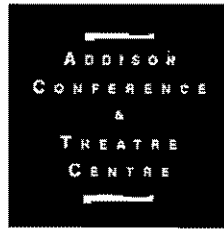

GIVE: TO STEVE OR
BOBBI TO INVESTIGATE

JP
2-12-01

Drainage Problem:

HOWARD JONES
14950 TREFALGAR COURT
972-385-1630

BACK YARD GETS FLOODED FROM UPSTREAM PROPERTIES. HE THINKS ~~IT~~ THAT DRAINAGE PIPE MAY BE BLOCKED OR THAT NEIGHBOR MAY BE DRAINING POOL IMPROPERLY.

PLEASE GET WITH HOME OWNER TO DETERMINE PROBLEM HE IS HAVING. SEE IF THERE IS A WORKABLE SOLUTION.

HOME OWNER IS AVAILABLE TO SHOW GUYS PROBLEM.
WJ

POSSIBLE SOLUTION IS TO USE JET RODDER TO CLEAN DRAIN LINES.

FIELD INVESTIGATION BY JIM WILSON

DATE: 02/19/01

TIME: 4:30 P.M.

WEATHER/TEMP: 63° — DRY/SUN

RESIDENTIAL ADDRESS: 14950 TRAFELOR COURT
ADDISON, TX

NAME: HOWARD JONES

PHONE: 972-385-1630

DISCUSSED PRIVATE PROPERTY DRAINAGE ISSUES WITH MR. JONES. TALKED ABOUT DIFFERENT METHODS TO DRAIN SURFACE WATER — AND GETTING TOGETHER WITH NEIGHBORS TO SOLVE SURFACE WATER. ADVISED HOME OWNER THAT NO TOWN EASEMENT OR RIGHT-OF-WAY EXISTS AROUND PROPERTY. HOME OWNER, MR. JONES, UNDERSTOOD THAT THE SURFACE DRAINAGE ISSUES WERE A "PRIVATE PROPERTY" ISSUE AND NOT THE TOWN OF ADDISON.


D. R. Winsmore

F. L. Crowder

J. L. Shirley

C. D. Bell, Sr.

50°14'28"E ~ 1940.07'

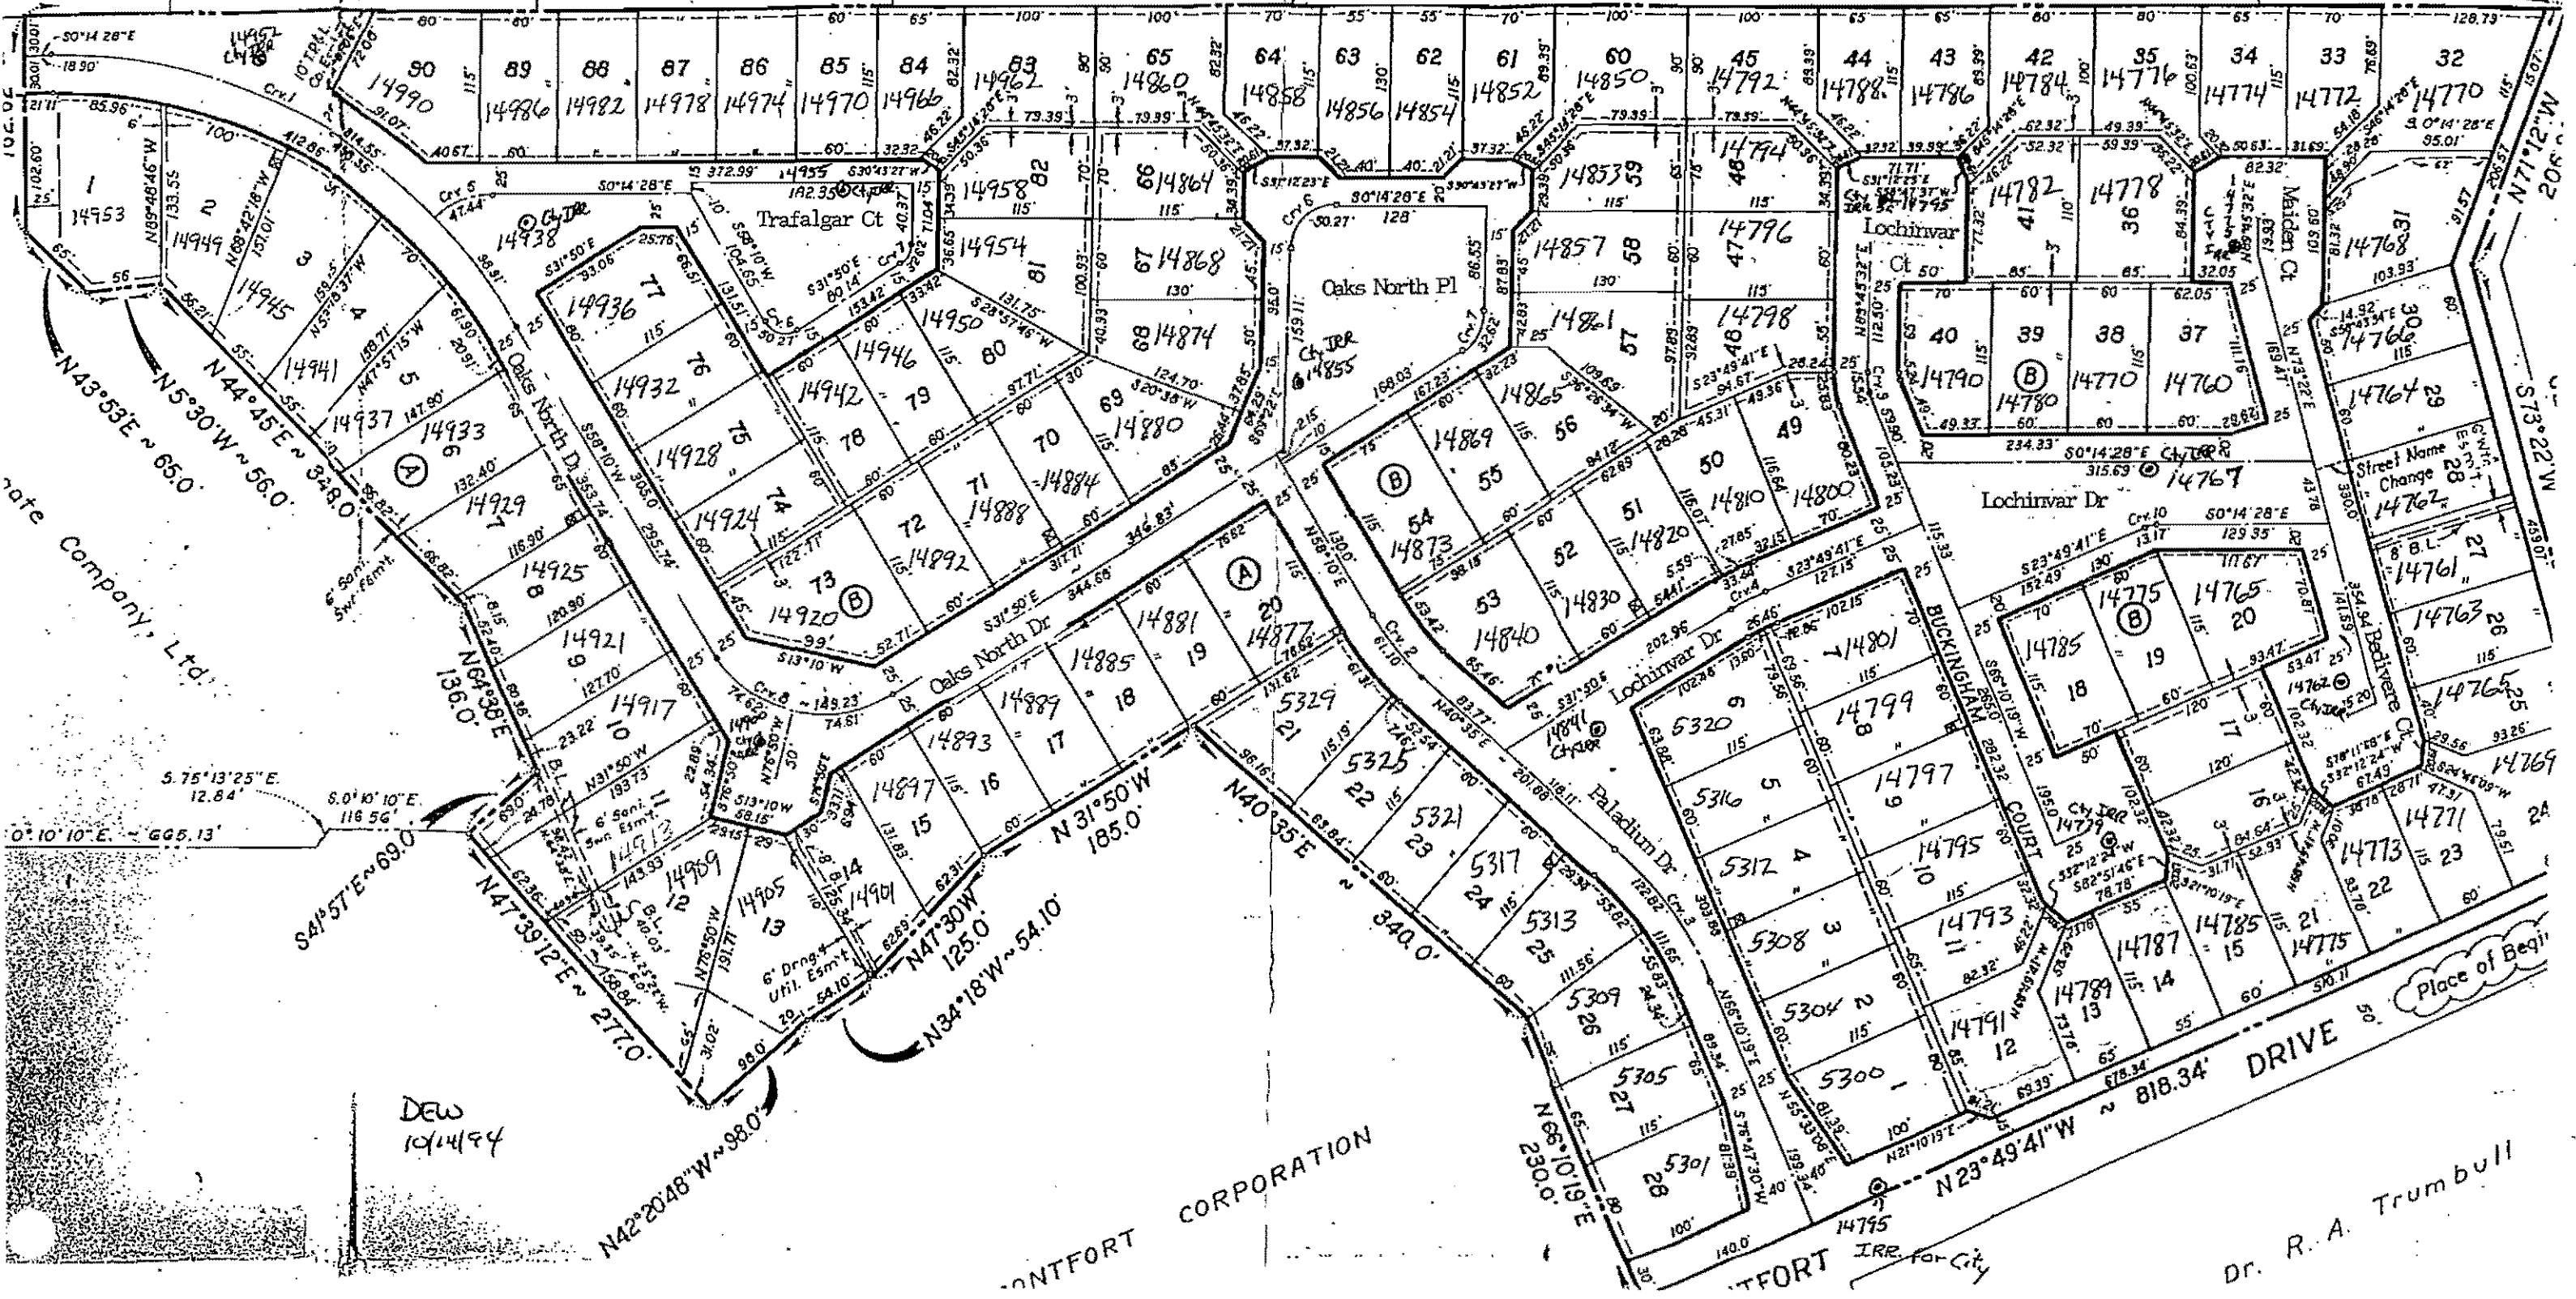

note Company, Ltd.

DEW
10/14/84

ONTFORT CORPORATION

NTFORT IRR. FOR CITY

Dr. R. A. Trumbull