

Index of Drawings

Sheet No.	Description of Drawing
VOLUME I	
C1	COVER SHEET
C2-C6D	ESTIMATE & QUANTITY SHEET
C7-C8	GEOMETRIC LAYOUT
C9-C13	TYPICAL SECTIONS
C14-C15	DEMOLITION PLAN
C16-C17	TRAFFIC CONTROL PLAN
C18-C25	ROADWAY - PLAN AND PROFILE
C26	INTERSECTION LAYOUT/GRADING - MIDWAY ROAD
C27	INTERSECTION LAYOUT/GRADING - ADDISON ROAD
C27A-C27B	CONTINUOUS REINFORCED CONCRETE PAVEMENT DETAILS
C28	CONNECTION ROAD - DOOLEY ROAD
C29-C31	RIGHT OF WAY PLAN
C32-C35	UTILITY COMPOSITE
C35A-C38B	UTILITY RELOCATION PLANS
C39	DRAINAGE AREA MAP/DRAINAGE CALCULATIONS
C40-C49	STORM SEWER PLANS
C50-C50A	EAST ENTRANCE JUNCTION BOX DETAILS
C51-C60	CROSS SECTIONS
C61-C63	TEMPORARY EROSION SEDIMENT AND WATER POLLUTION CONTROL PLAN
VOLUME II	
S64	COVER SHEET
S65	ABBREVIATIONS, SYMBOLS AND GENERAL NOTES
S66-S79	STRUCTURAL PLAN AND PROFILE
S80	RETAINING WALL PANEL DIAGRAMS & JOINT SCHEDULE
S81-S92	RETAINING WALL DETAILS
S93	RETAINING WALL BACKFILL AND DRAINAGE DETAILS
S94-S96	RETAINING WALL ARCHITECTURAL ELEVATIONS
S97-S103	PORTAL DRAINAGE SUMPS SECTIONS AND DETAILS
T104	TYPICAL TUNNEL SECTIONS
T105-T108	TEMPORARY TUNNEL SUPPORT
T108A	SUPPLEMENTARY SUPPORT 60" DIA. STORM SEWER
T109-T119	CUT AND COVER SECTIONS AND DETAILS
T120-T124	TUNNEL DRAINAGE SUMP SECTION AND DETAILS
T125	NICHE DETAILS
T126-T127A	WATERPROOFING DRAINAGE
T128	HANDRAIL DETAILS
T129-T131	PORTAL STRUCTURES SECTIONS AND DETAILS
T132-T134	SURFACE AND GEOTECHNICAL INSTRUMENTATION
VOLUME III	
M135	COVER SHEET
M136	ABBREVIATIONS, SYMBOLS AND GENERAL NOTES
M137-M143	TUNNEL VENTILATION PLANS
P144-P146	TUNNEL FIRE PROTECTION AND PLUMBING PLANS
P147-P148	ENLARGED SUMP PIT PLANS
P149	PUMP DISCHARGE PIPING EAST ENTRANCE
P150	TUNNEL FIRE PROTECTION & PLUMBING SECTIONS
P151	TUNNEL GENERATOR & FIRE PROTECTION
P152	TUNNEL FIRE PROTECTION AND PLUMBING SCHEDULE
E153	ABBREVIATIONS, SYMBOLS AND GENERAL NOTES
E154-E156	TUNNEL LIGHTING PLANS
E157-E159	TUNNEL POWER AND COMMUNICATIONS PLANS
E160	PARTIAL PLANS
E161	ONE-LINE DIAGRAM & SCHEDULES
E162-E163	PANELBOARD SCHEDULES
E164-E166A	PARTIAL PLANS/DETAILS

# TEXAS TURNPIKE AUTHORITY

## CONTRACT No. DNT-260

# MECHANICAL, ELECTRICAL AND PLUMBING PLANS


SECTION X III  
VOLUME III

# ADDISON AIRPORT TUNNEL

Standard Drawings


DNT Dwg. No.	Description of Standard
VOLUME I	
2	CURB AND GUTTER INLET - TYPE I (2 SHEETS)
5	INLET DETAILS - TYPE F
6	INLET DETAILS - TYPE G
8	MANHOLE DETAILS - TYPE I AND TYPE II
10	TOLLWAY PAVEMENT DETAILS (2 SHEETS)
11	MISCELLANEOUS DETAILS - TOLLWAY
12	MISCELLANEOUS PAVING DETAILS (3 SHEETS)
13	MISCELLANEOUS DRAINAGE DETAILS
14	METAL BEAM GUARD FENCE (2 SHEETS)
15	PRECAST CONC. BOX CULVERTS FOR NORMAL FILL SECTIONS
20-26	BARRICADE AND CONSTRUCTION STANDARDS (7 SHEETS)
27	CONCRETE BARRIER RAIL - PORTABLE AND PRECAST
28	BARREL MOUNTED GUARD FENCE
30	CHAIN - LINK BARRIER FENCE 4 AND 6 FOOT GATE DETAILS
30A	STANDARD FENCE DETAILS
31	METAL BEAM GUARD FENCE FIXED OBJECT ATTACHMENT
95	TECHWALL STANDARD DETAILS (2 SHEETS)

TxDOT Dwg. No.	Description of Standard
CPCR(1)-94	CONCRETE PAVEMENT DETAILS CONTINUOUSLY REINFORCED.
CH-11	CONCRETE HEADWALLS FOR PIPE CULVERTS 12"-72" DIA.
CH-11-B-30 DEG.	CONCRETE HEADWALLS FOR PIPE CULVERTS 12"-72" DIA.
CH-11-B-45 DEG.	CONCRETE HEADWALLS FOR PIPE CULVERTS 12"-72" DIA.
MC5-1	MULTIPLE BOX CULVERTS SIZES 5'x2', 5'x3', 5'x4', 5'x5' DIRECT TRAFFIC TO 4'-0" FILL

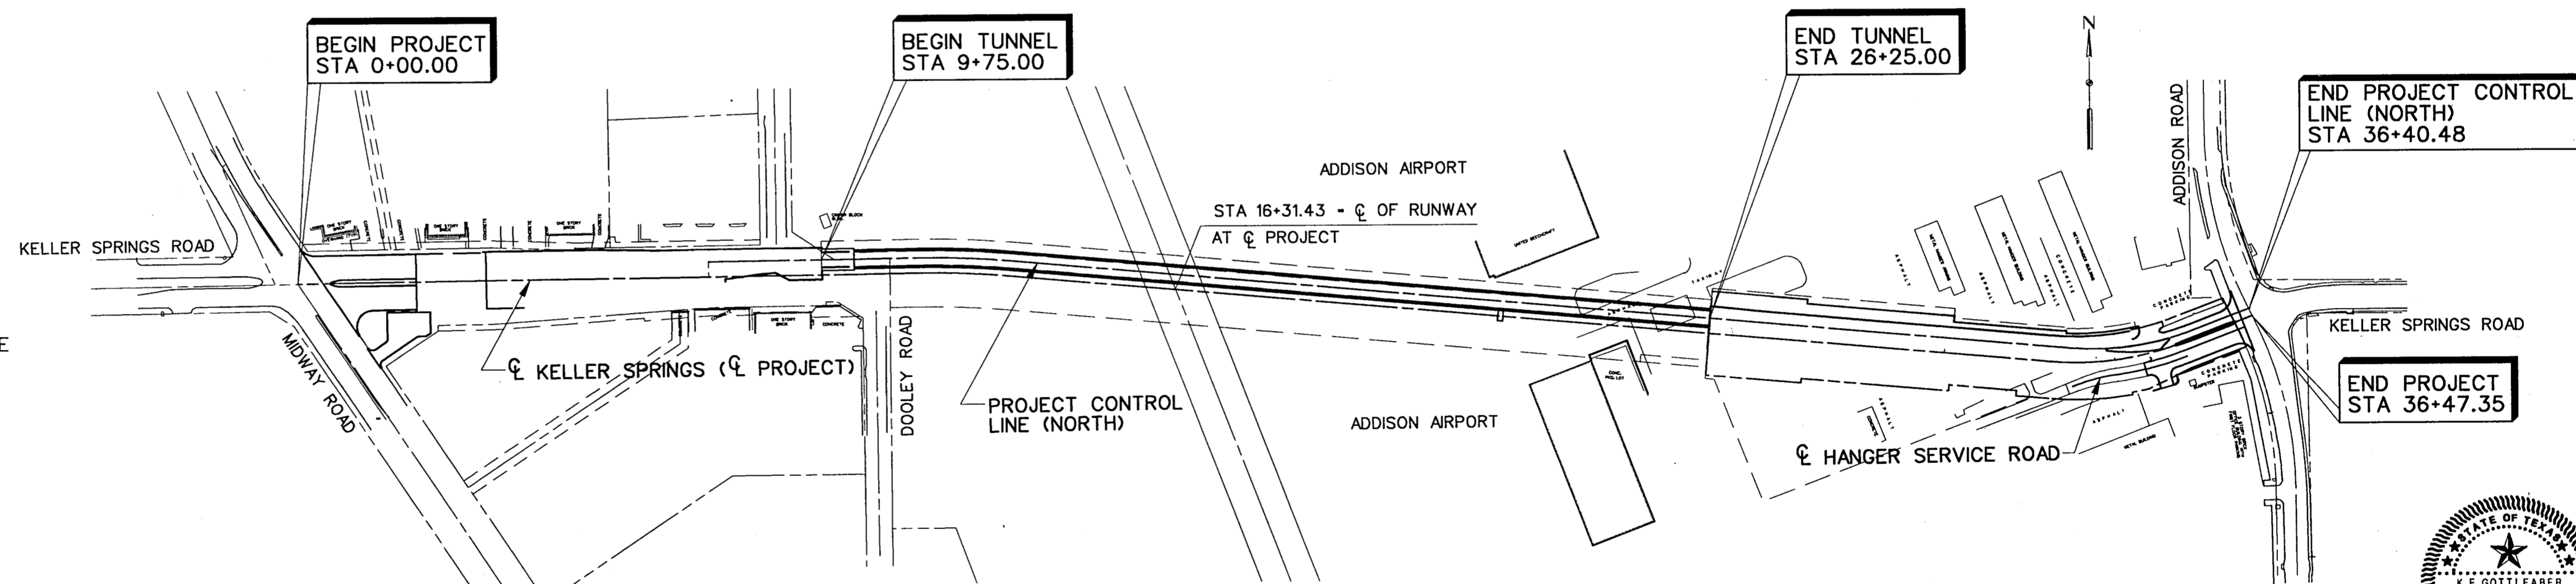

PROJECT LAYOUT  
SCALE: 1" = 200'

FINAL RECORD DRAWING  
Date: 12/25/99

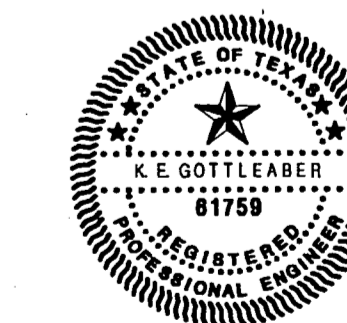

THE SEAL APPEARING ON THIS DOCUMENT WAS AUTHORIZED BY K. E. GOTTLERBER, P.E. 61759 ON SEPTEMBER 9, 1996.

Prepared by:  
HDR ENGINEERING, INC.

*William R. Maguire, P.E.*  
Design Engineer

Date: January 19, 1997

Recommended by:  
HNTB CORPORATION

*[Signature]*  
Consulting Engineer

Date: 01/10/97

Recommended by:  
THE GINN CORPORATION

*[Signature]*  
Project Engineer

Date: 1/10/97

Approved by:  
TOWN OF ADDISON

City Manager

Date: \_\_\_\_\_

Approved by:  
COUNTY OF DALLAS, TEXAS

Director of Public Works

Date: \_\_\_\_\_

Recommended by:  
TEXAS TURNPIKE AUTHORITY

Director of Engineering

Date: \_\_\_\_\_

Approved by:  
TEXAS TURNPIKE AUTHORITY

Executive Director

Date: Jan. 16, 1997

**GENERAL NOTES:**

- A. ALL LOCATION OF EXISTING PIPING, DUCT AND EQUIPMENT ARE APPROXIMATE AND SHALL BE FIELD VERIFIED BY THE CONTRACTOR PRIOR TO COMMENCEMENT OF WORK. CONTRACTOR SHALL NOTIFY OWNERS REPRESENTATIVE IN WRITING IF CONDITIONS ARE FOUND TO BE DIFFERENT THAN SHOWN ON THE DRAWING BEFORE PROCEEDING.
- B. BEFORE ENERGIZING NEW EQUIPMENT OR CONNECTING TO EXISTING POWER SOURCES, THE CONTRACTOR SHALL COORDINATE WITH THE OWNER'S REPRESENTATIVE.
- C. ALL WORK IS NEW UNLESS OTHERWISE INDICATED TO BE EXISTING, REMOVED OR RELOCATED.
- D. COMPLY WITH APPLICABLE CODES AND STANDARDS AS INDICATED IN SPECIFICATION SECTION 15011.
- E. PROVIDE ALL NEW PIPING WITH NEW NAME LABELS AND COLOR CODING TO CORRELATE TO THE DESIGNATION USED ON THE DRAWINGS.
- F. ALL STATIONING AND DIMENSIONAL INFORMATION IS APPROXIMATE AND SHALL BE FIELD VERIFIED AND COORDINATED WITH ALL OTHER TRADES PRIOR TO CONSTRUCTION.

MECHANICAL SYMBOLS			
NOT ALL SYMBOLS ARE NECESSARILY USED ON THIS PROJECT			
	AIR DEVICE DESIGNATION		DUCT (SIZE IN INCHES, FIRST FIG. SIDE SHOWN)
	THERMOSTAT		90 DEGREE RECTANGULAR ELBOW UP
	PIPE CAP OR BLIND FLANGE		90 DEGREE RECTANGULAR ELBOW DOWN
	RISER DOWN (ELBOW)		DUCT SECTION - SUPPLY
	RISER UP (ELBOW)		CONDENSATE DRAIN LINE
	INDICATING LIGHT (R-RED; Y-YELLOW; G-GREEN)		POINT OF CONNECTION - NEW TO EXISTING
	FIRE LINE		FLOW DIRECTION
	PUMP DISCHARGE LINE		DUCT SECTION - EXHAUST, RETURN, OUTSIDE OR RELIEF
	DRAIN LINE		CARBON MONOXIDE SENSOR
	FIRE HOSE VALVE		ROADWAY DRAIN

**ABBREVIATIONS AND SERVICE DESIGNATIONS**


AC	ABOVE CEILING	DIA	DIAMETER	FEC	FIRE EXTINGUISHER CABINET	PSI	POUNDS PER SQUARE INCH
ACFM	ACTUAL CUBIC FEET PER MINUTE	DISCH	DISCHARGE	G	GAS LOW PRESSURE	PW	POTABLE (DOMESTIC) WATER
AD	AIR DRYER	DN	DOWN	GA	GAGE	R	RETURN, RED
AMB	AMBIENT	DWG	DRAWING	GAL	GALLON	RA	RETURN AIR
AMP	AMPERE	DS	DOWNSPOUT (STORM SEWER)	GCO	GRADE CLEANOUT	RD	ROOF DRAIN
ARCH	ARCHITECTURE	D	DRAIN	GPM	GALLONS PER MINUTE	RECIRC.	RECIRCULATING
ASR	AUTOMATIC SPRINKLER RISER	E	EXISTING	GPH	GALLONS PER HOUR	RH	RELATIVE HUMIDITY
AUX	AUXILIARY	EA	EACH	HAD	HEAT ACTUATING DEVICE	RM	ROOM
AVG	AVERAGE	EAT	ENTERING AIR TEMPERATURE	HD	HUB DRAIN	RPM	REVOLUTIONS PER MINUTE
AFF	ABOVE FINISHED FLOOR	EDH	ELECTRIC DUCT HEATER	HGT	HEIGHT	RRT	REMOTE RESET THERMOSTAT
BE	BOTTOM ELEVATION	EF	EXHAUST FAN	HORI	HORIZONTAL	RT	RAINTIGHT
BF	BELOW FLOOR, BOILER FEEDWATER	EFF	EFFICIENCY	HP	HORSEPOWER	RTU	ROOF TOP UNIT
BFC	BELOW FINISHED CEILING	ELEC	ELECTRICAL	HZ	HERTZ	S	SUPPLY
BFF	BELOW FINISHED FLOOR	IE	EXPLOSION PROOF	IE	INVERT ELEVATION	SS	SANITARY SEWER
BG	BELOW GRADE	EP	ENTERING	IN	INCH	SC	SCALE
BLDG	BUILDING	ENT	ELECTRIC UNIT HEATER	KW	KILOWATT	SD	STORM SEWER
BOD	BOTTOM OF DUCT	EUH	EXPANSION	LAT	LEAVING AIR TEMPERATURE	SECT	SECTION
BOP	BOTTOM OF PIPE	EXP	EXTERNAL	LG	LENGTH	SENS	SENSIBLE
BOT	BOTTOM	EXT	ELEVATION	LVG	LEAVING	SF	SUPPLY FAN
BTUH	BRITISH THERMAL UNITS PER HOUR	ELEV	ELECTRICAL WATER COOLER	MAN	MANUAL	SOL	SOLENOID
BYP	BYPASS	EWC	FAN COIL UNIT	MAX	MAXIMUM	SP	STATIC PRESSURE
C/B	CIRCUIT BREAKER	FCU	FAHRENHEIT	MECH	MECH	SA	SUPPLY AIR
CAP	CAPACITY	F	FLOOR CLEANOUT	MIN	MINIMUM, MINUTE	TEMP	TEMPERATURE
CFH	CUBIC FEET PER HOUR	FCO	FIRE DAMPER	MVD	MANUAL VOLUME DAMPER	TYP	TYPICAL
CFM	CUBIC FEET PER MINUTE	FD	FLOOR DRAIN, TYPE 1	NO	NORMALLY OPEN, NUMBER	UH	UNIT HEATER
CIP	CAST IRON PIPE	FD-1	FIRE DEPARTMENT CONNECTION	NTS	NOT TO SCALE	UL	UNDERWRITERS LAB
CKT	CIRCUIT	FDC	FIRE EXTINGUISHER	NC	NORMALLY CLOSED, NOISE CRITERIA	V	VENT, VOLT
CL	CENTER LINE	FEXT	FLEXIBLE	OA	OUTSIDE AIR	VA	VALVE
CLG	CEILING	FLEX	FAN POWER BOX	OBD	OPPOSED BLADE DAMPER	VEL	VELOCITY
CO	CLEAN OUT	FPB	FINS PER INCH	OD	OVERFLOW DRAIN	VERT	VERTICAL
COL	COLUMN	FPI	FEET PER MINUTE	PC	PUMPED CONDENSATE	VF	VENT FAN
COND'S	CONDITIONS	FPM	FEET PER SECOND	PH	PHASE	VTR	VENT THRU ROOF
CONN	CONNECTION	FPS	FOOT, FEET	3PH	THREE PHASE	WB	WET BULB
CU	CONDENSING UNIT	FT	SQUARE FEET	PL	PLACES	WCO	WALL CLEANOUT
DET	DETAIL	FT2	FULL LOAD AMPERES	PRESS	PRESSURE	WG	WATER GAUGE
DF	DRINKING FOUNTAIN	FLA	FREEZE STAT	PRV	PRESSURE REDUCING VALVE		



THE SEAL APPEARING ON THIS DOCUMENT WAS AUTHORIZED BY MIKE L. ASHCRAFT, P.E., 56598 ON SEPTEMBER 9, 1996

**FINAL RECORD DRAWING**  
Date: 12/25/99

No.	REVISION	BY	DATE
TEXAS TURNPIKE AUTHORITY <b>ADDISON AIRPORT TUNNEL</b>			
SYMBOLS, ABBREVIATIONS & GENERAL NOTES			
<b>HDR</b> HDR Engineering, Inc.			SECTION <u>  XIII  </u>
DRAWN: WTD	DATE: 12/05/96	DESIGNED: M.L.A.	DATE: 08/28/96
CHECKED: BL	DATE: 08/28/96	SCALE: NONE	
CONTRACT No. <u>DNT-260</u> SHEET <b>M136</b> OF <u>166</u>			

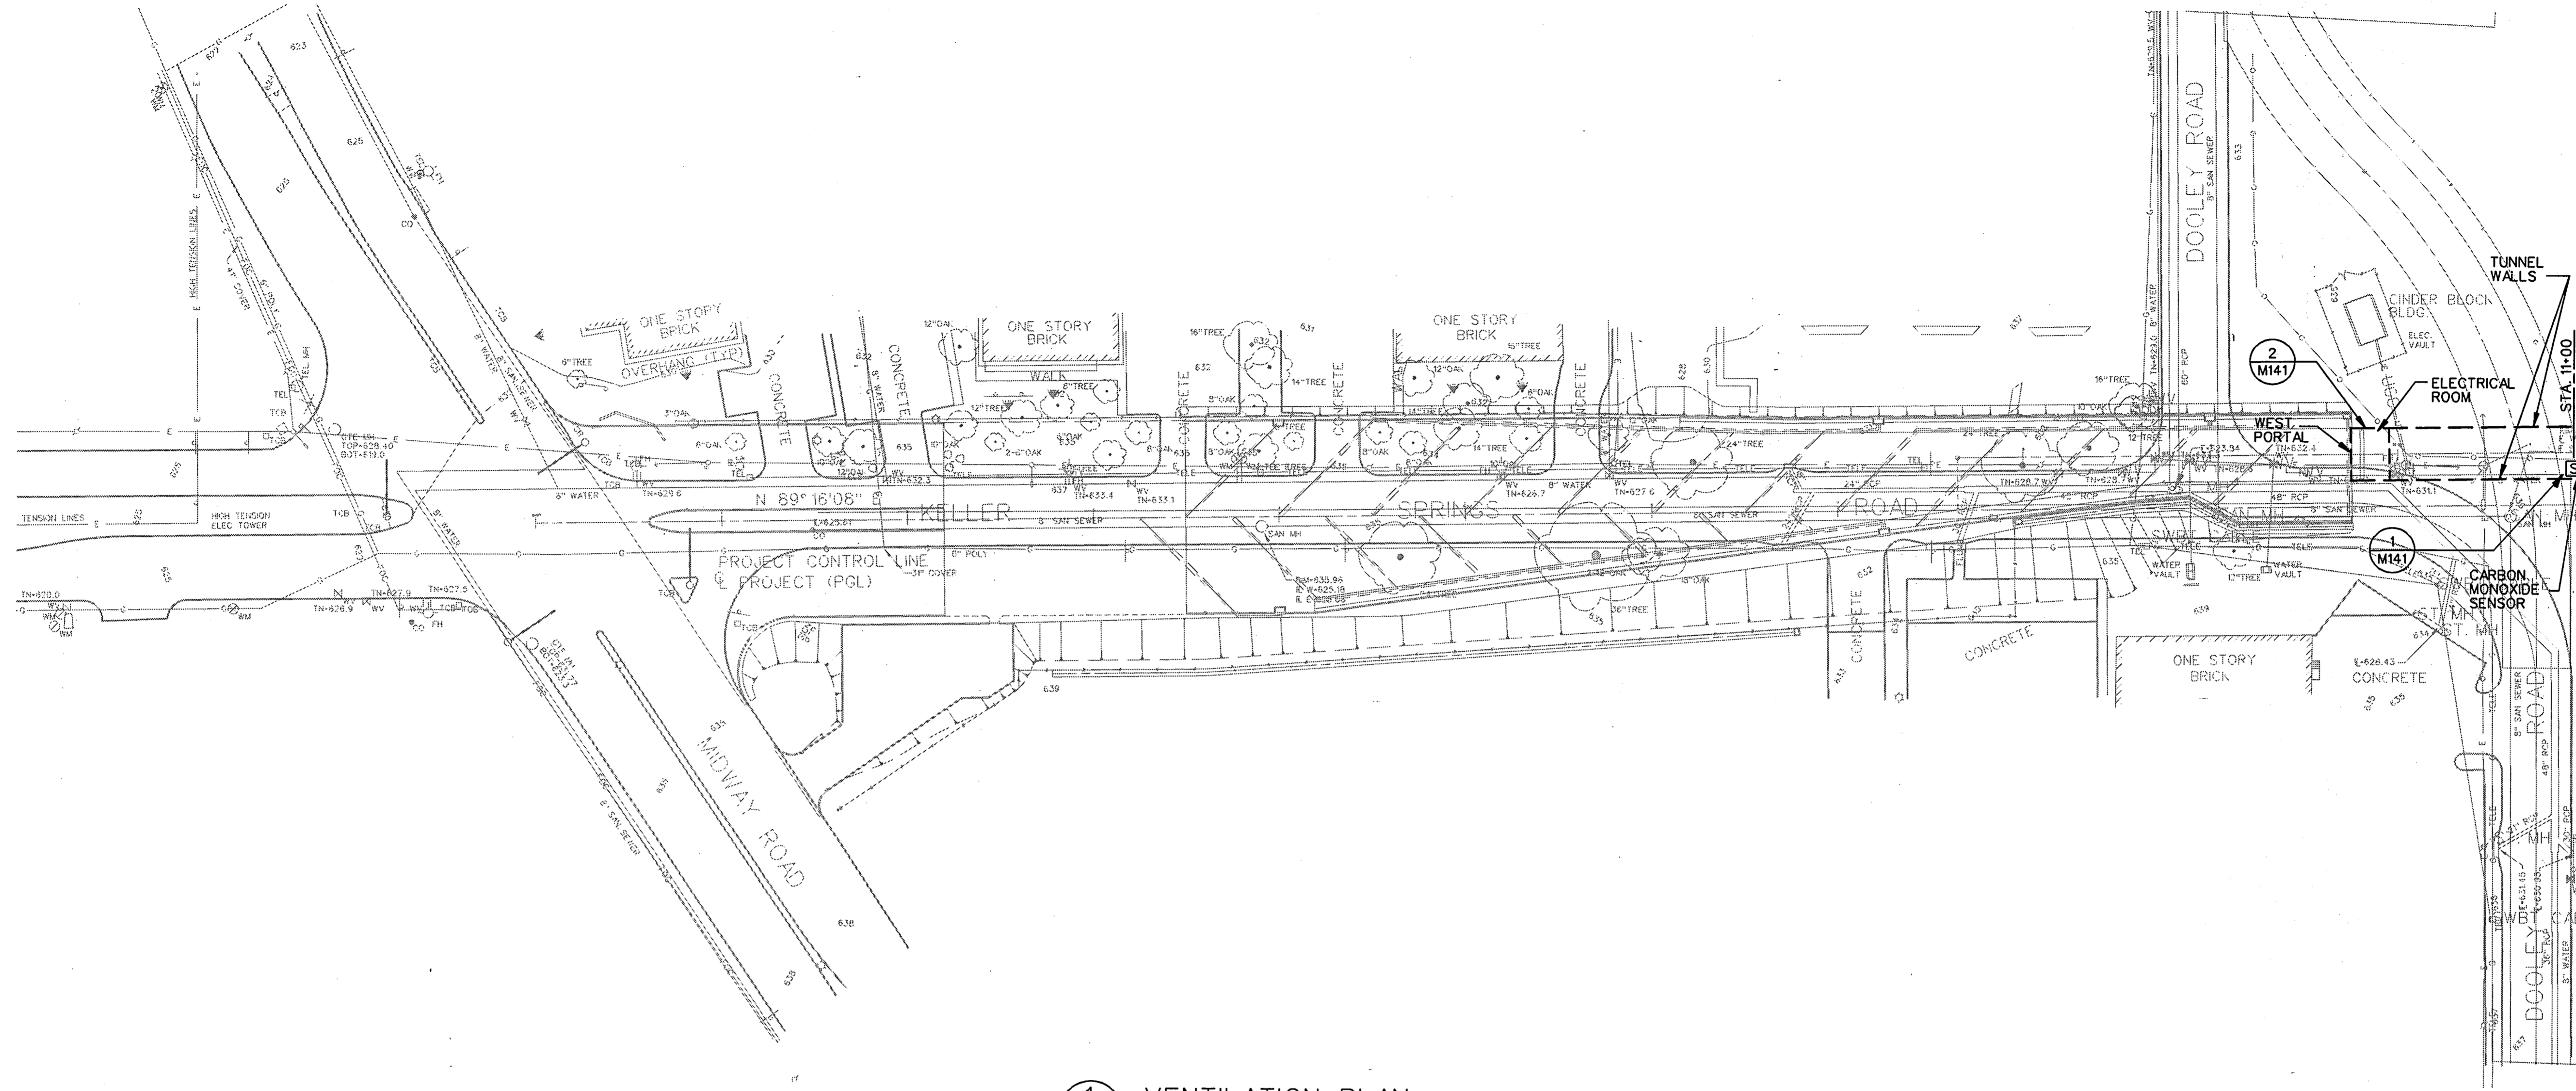

1 VENTILATION PLAN  
SCALE: 1" = 50'



MATCH LINE STA. 11+00



THE SEAL APPEARING ON THIS DOCUMENT WAS AUTHORIZED BY MIKE L. ASHCRAFT, P.E., 56598 ON SEPTEMBER 9, 1996

FINAL RECORD  
DRAWING  
Date: 12/25/99

No.	REVISION	BY	DATE
TEXAS TURNPIKE AUTHORITY ADDISON AIRPORT TUNNEL			
TUNNEL VENTILATION PLANS			
HDR Engineering, Inc.			SECTION XIII
DRAWN: WTD	DATE: 12/05/96	DESIGNED: MLA	DATE: 08/28/96
CHECKED: KG	DATE: 08/28/96	SCALE: 1" = 50'	
CONTRACT No. DNT-260 SHEET M137 OF 166			

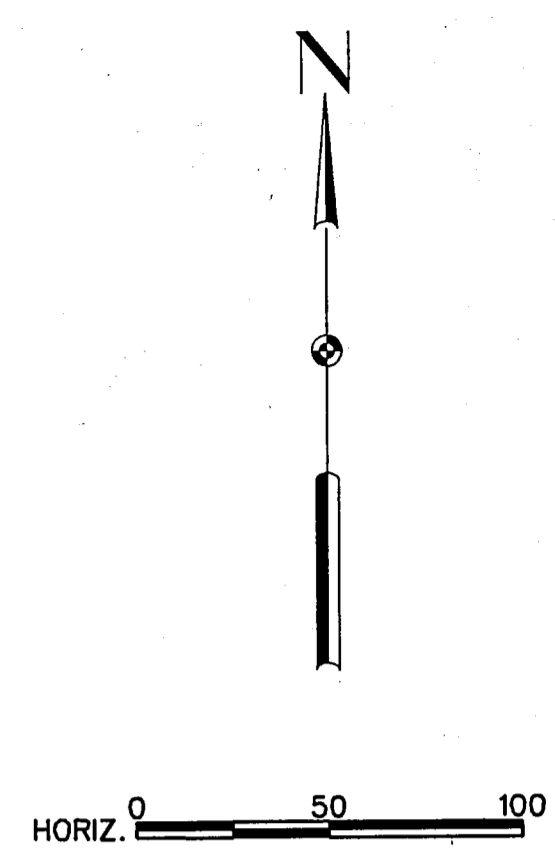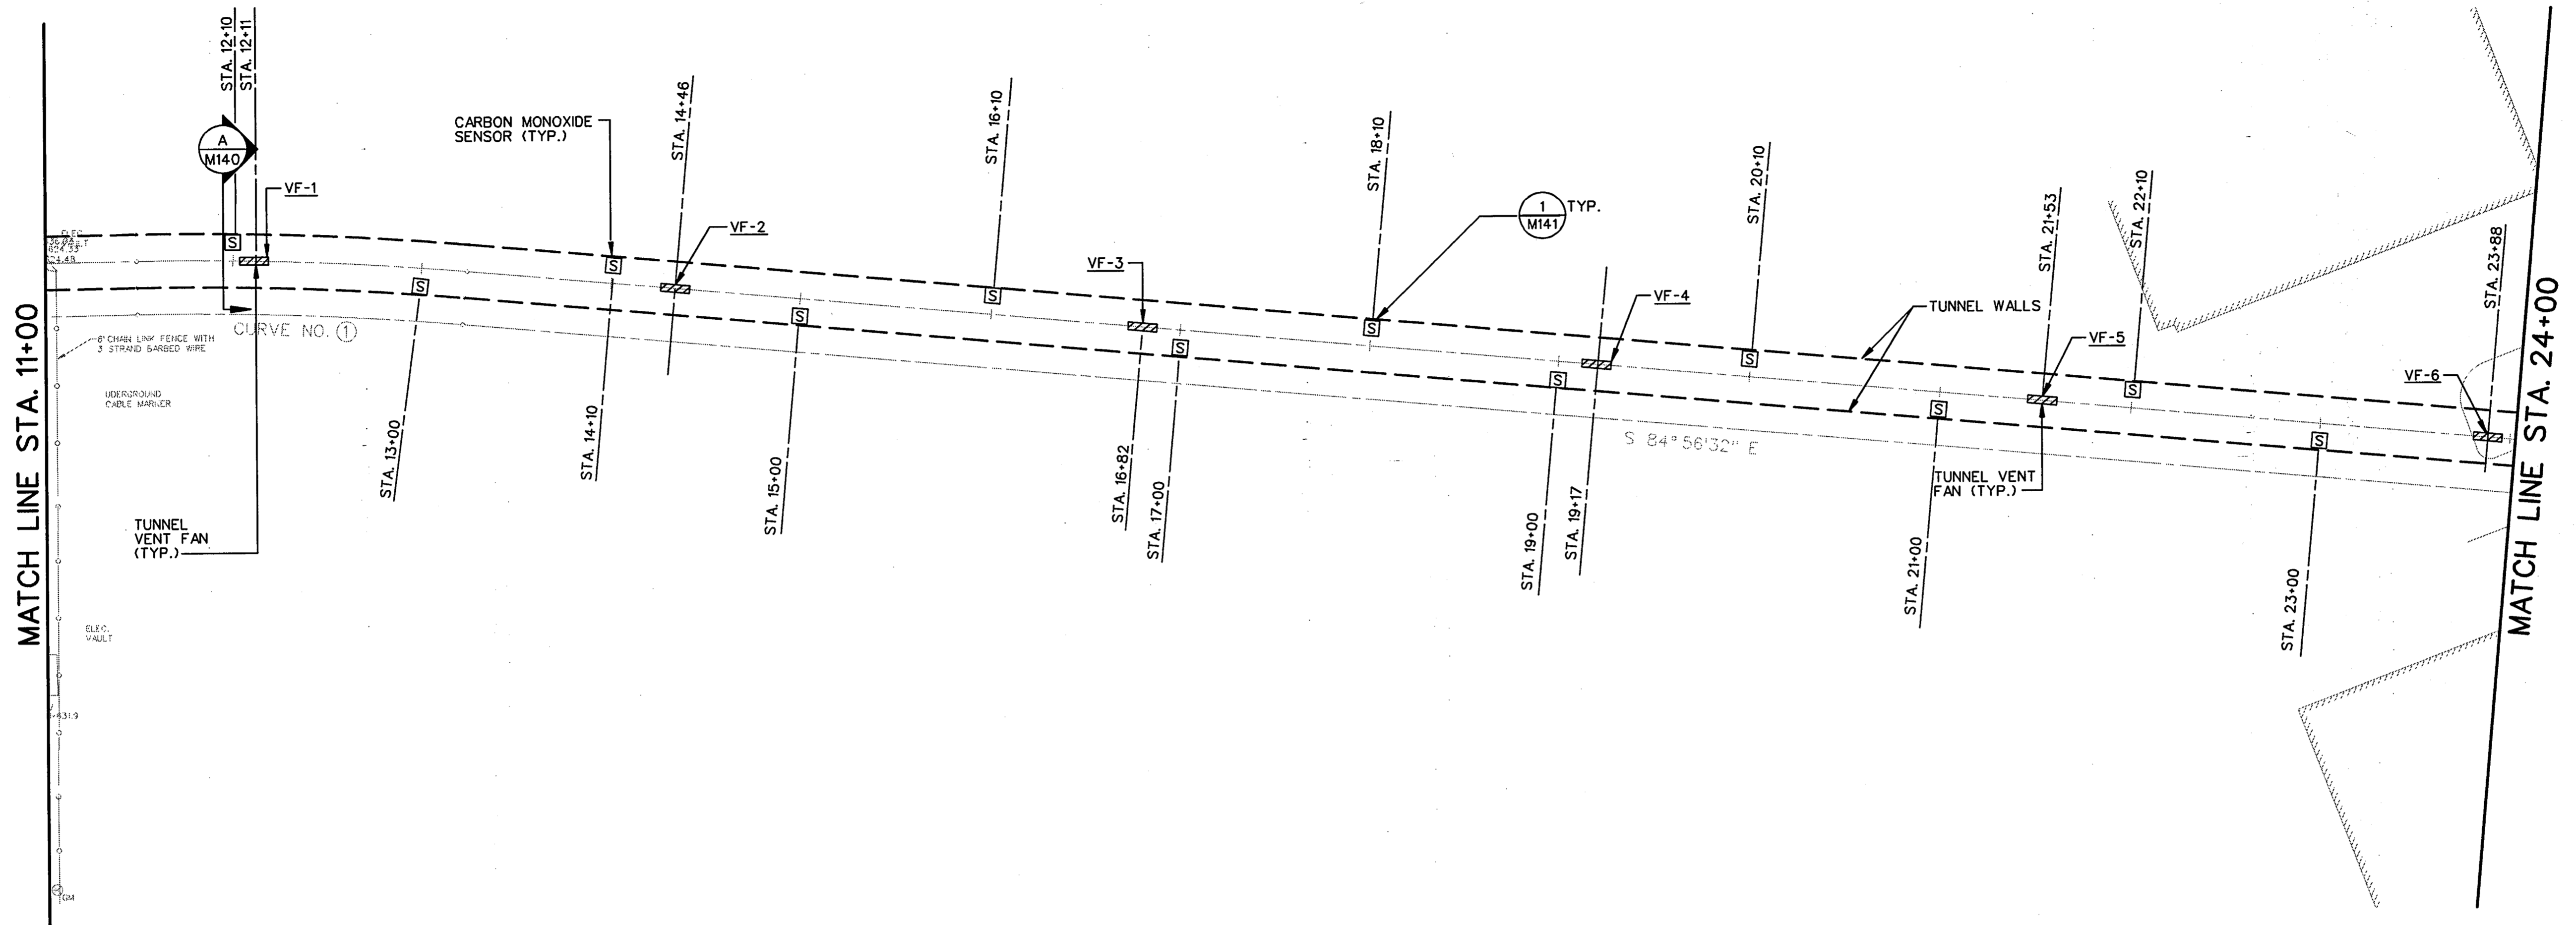

1 VENTILATION PLAN  
SCALE: 1" = 50'



THE SEAL APPEARING ON THIS DOCUMENT WAS AUTHORIZED BY MIKE L. ASHCRAFT, P.E., 56590 ON SEPTEMBER 9, 1996

FINAL RECORD  
DRAWING  
Date: 12/25/99

No.	REVISION	BY	DATE
TEXAS TURNPIKE AUTHORITY ADDISON AIRPORT TUNNEL			
TUNNEL VENTILATION PLANS			
HDR Engineering, Inc.			SECTION XIII
DRAWN: WTD	DATE: 12/05/96	DESIGNED: MLA	DATE: 08/28/96
CHECKED: KG	DATE: 08/28/96	SCALE: 1" = 50'	
CONTRACT No. DNT-260 SHEET M138 OF 166			


MATCH LINE STA. 24+00

STA. 24+10  
STA. 25+00

CARBON MONOXIDE SENSOR (TYP.)

(TYP.)  
M141

WM. LOMAX SURVEY A - 792  
E. COOK SURVEY A - 326

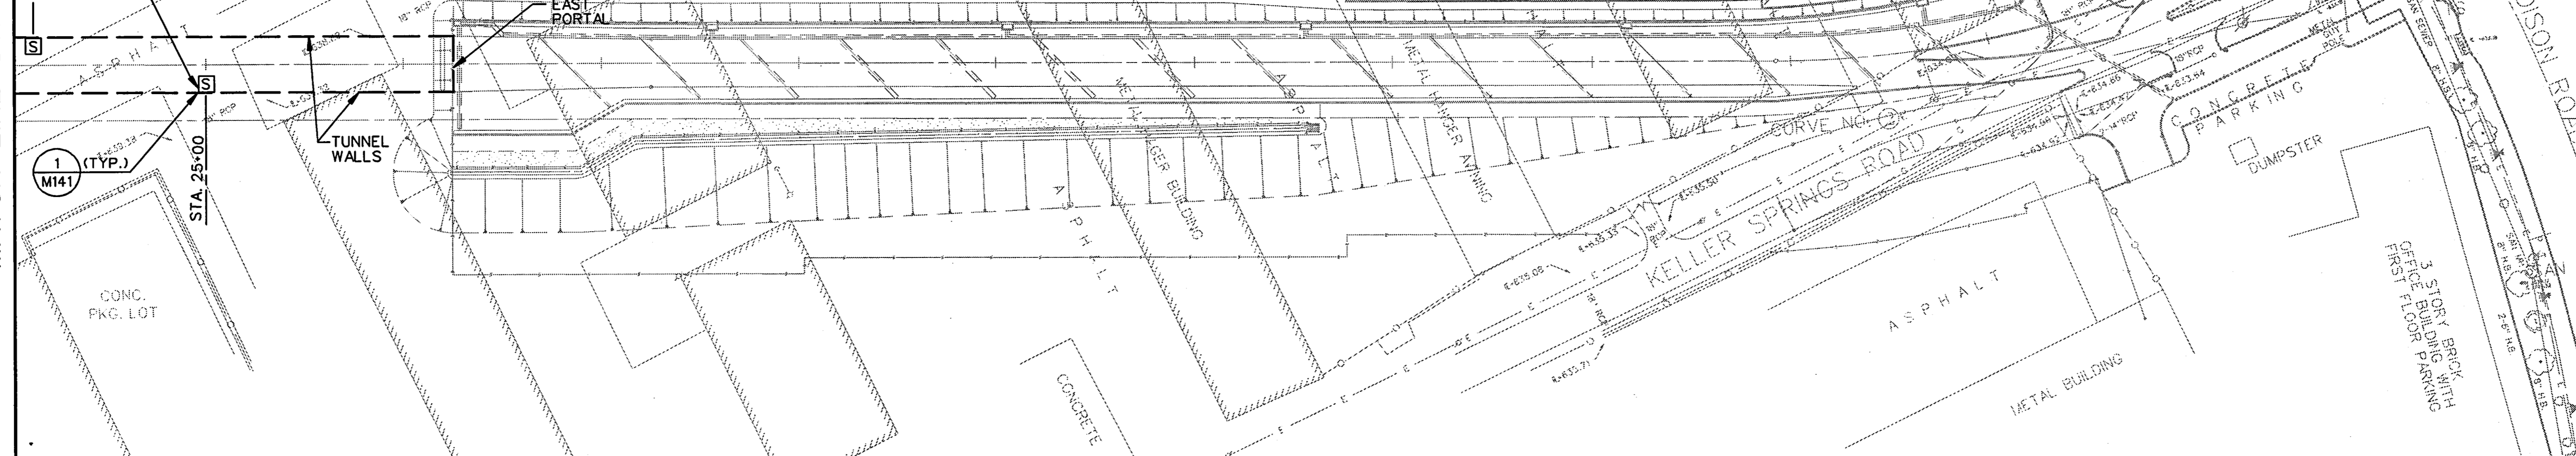


1 VENTILATION PLAN  
SCALE: 1" = 50'




THE SEAL APPEARING ON THIS DOCUMENT WAS AUTHORIZED BY MIKE L. ASHCRAFT, P.E., 56590 ON SEPTEMBER 9, 1996

FINAL RECORD  
DRAWING  
Date: 12/25/99


No.	REVISION	BY	DATE
TEXAS TURNPIKE AUTHORITY ADDISON AIRPORT TUNNEL			
TUNNEL VENTILATION PLANS			
HDR Engineering, Inc.			SECTION XIII
DRAWN: WTD	DATE: 12/05/96	DESIGNED: M.L.A.	DATE: 08/28/96
CHECKED: KG	DATE: 08/28/96	SCALE: 1" = 50'	
CONTRACT No. DNT-260 SHEET M139 OF 166			

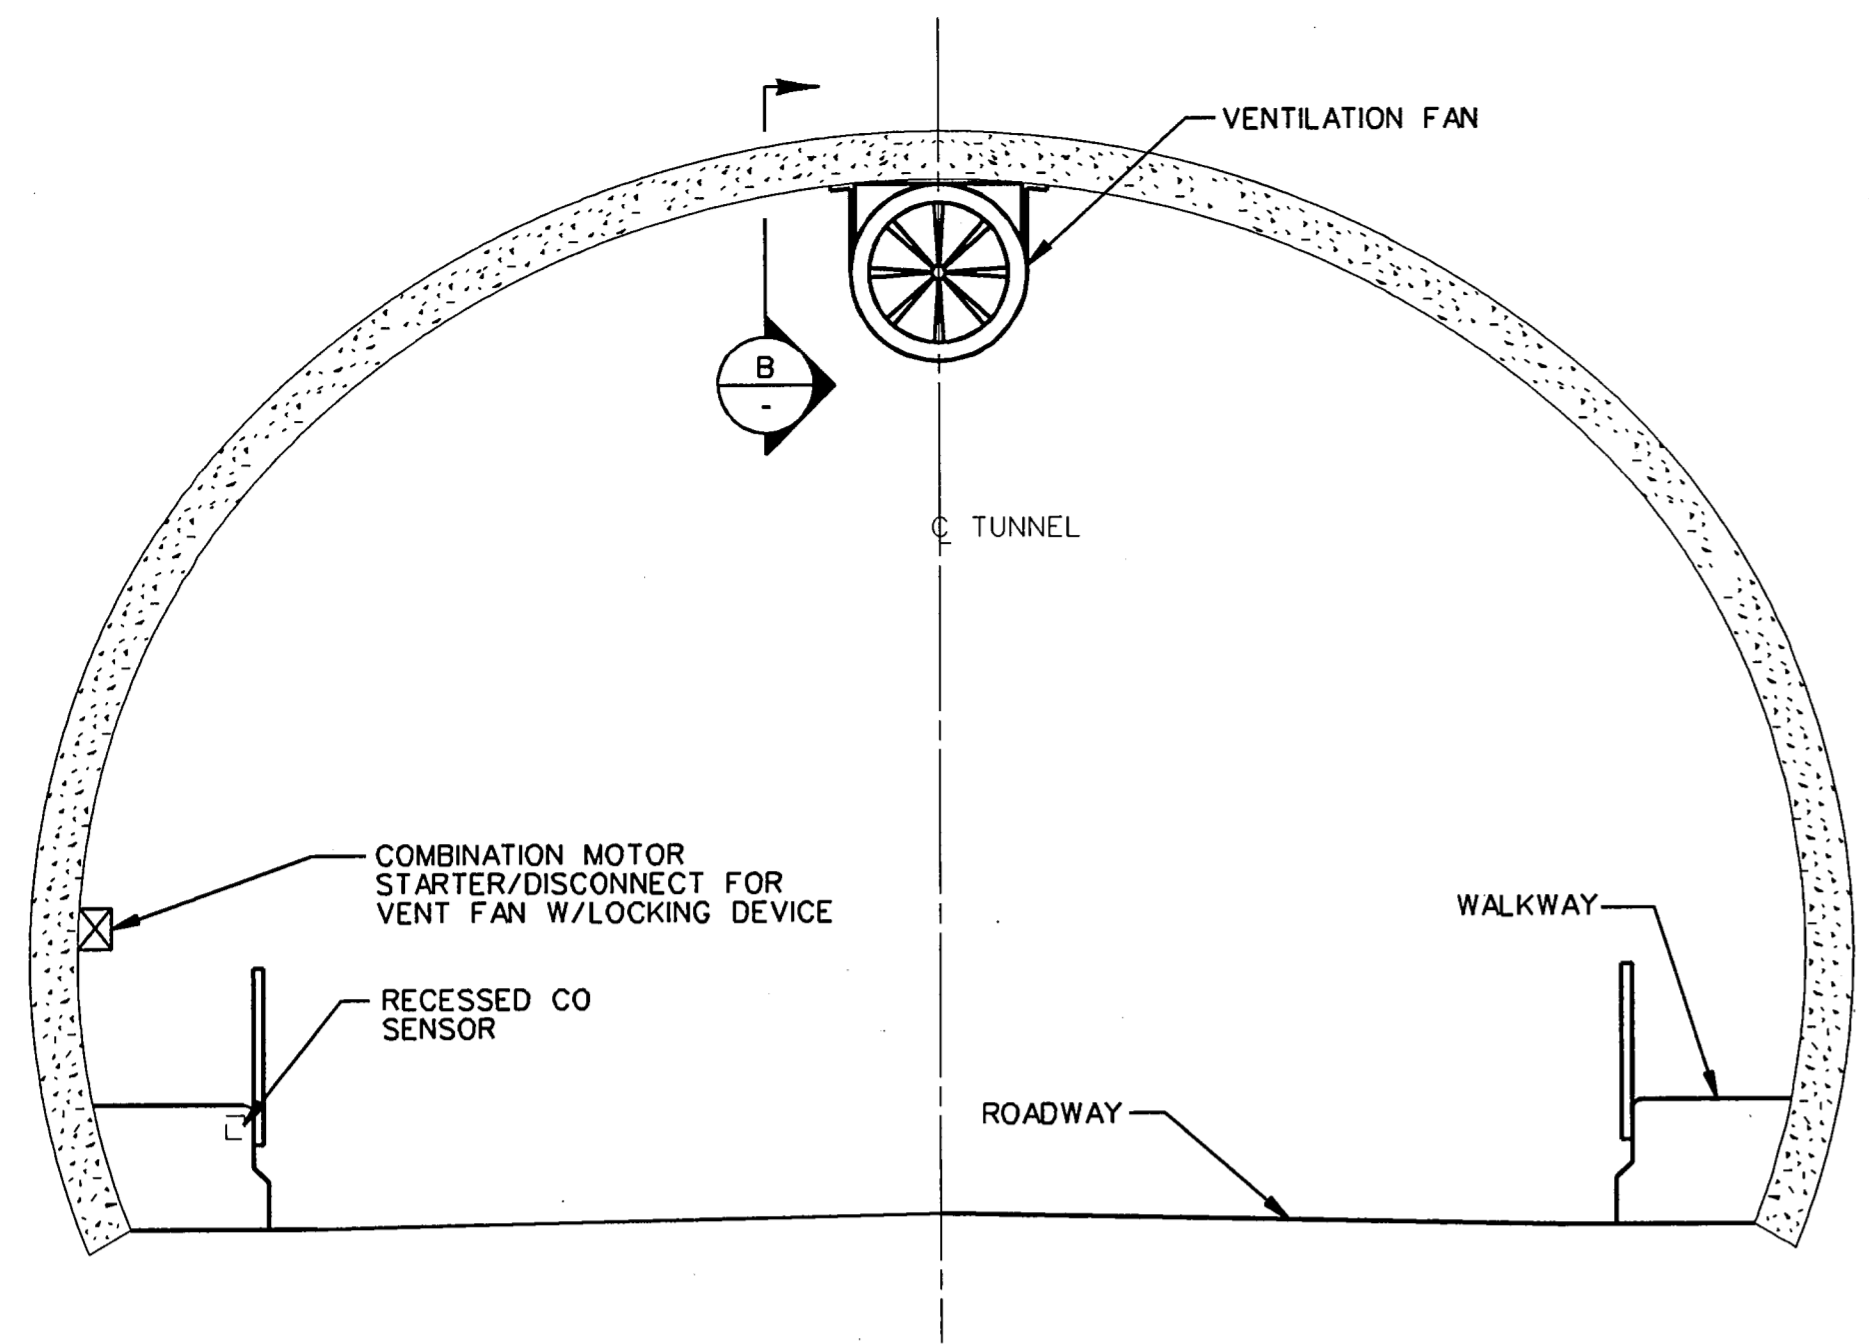


**A TUNNEL SECTION**  
M138 SCALE: 1/4" = 1'-0"

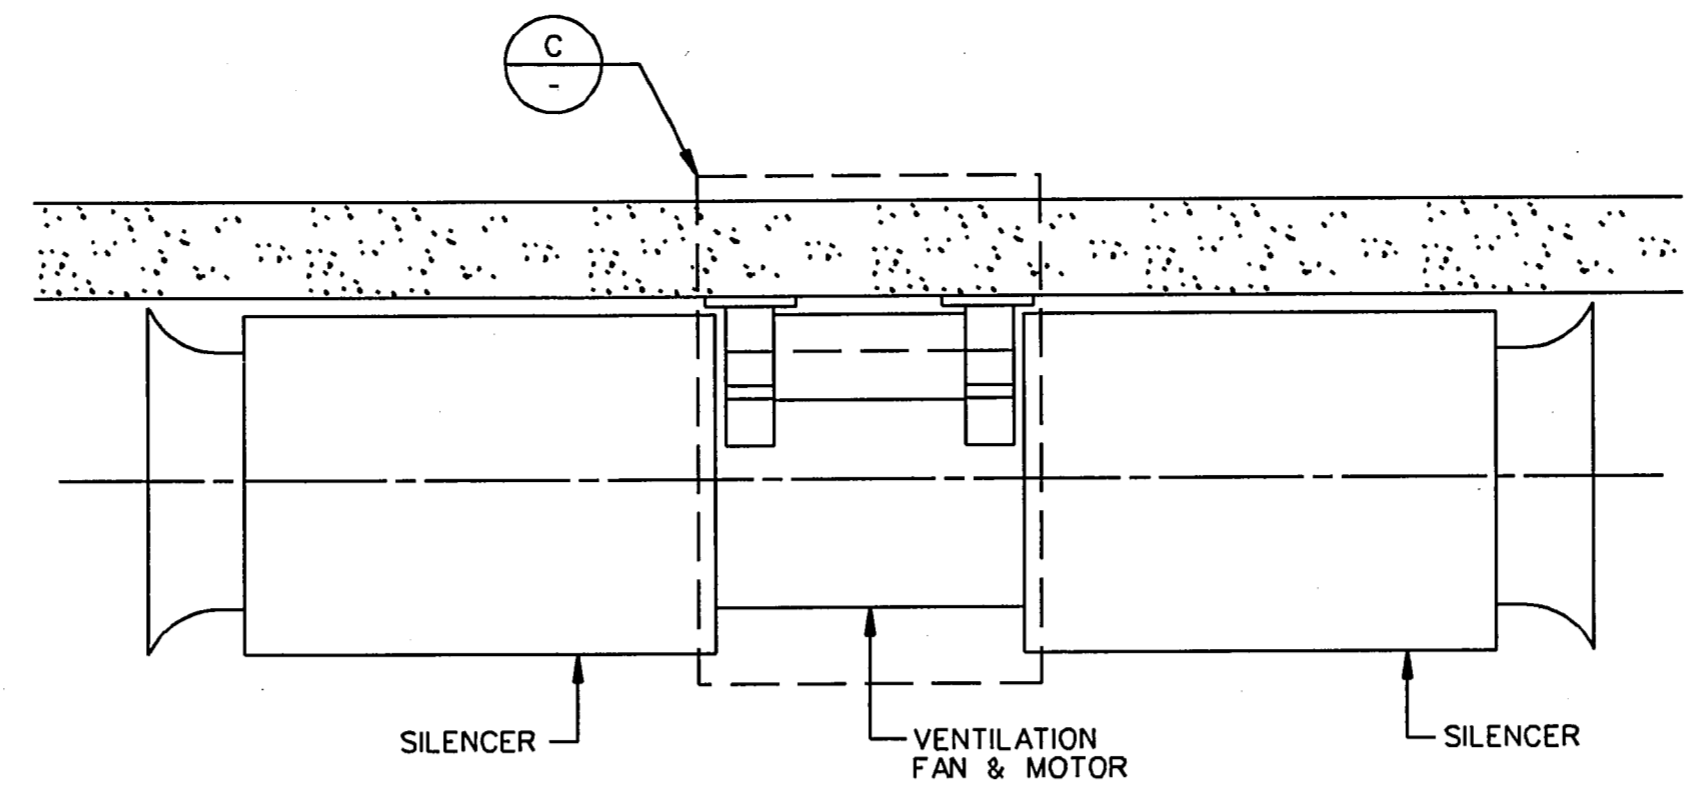

**B FAN ELEVATION**  
SCALE: 1/2" = 1'-0"

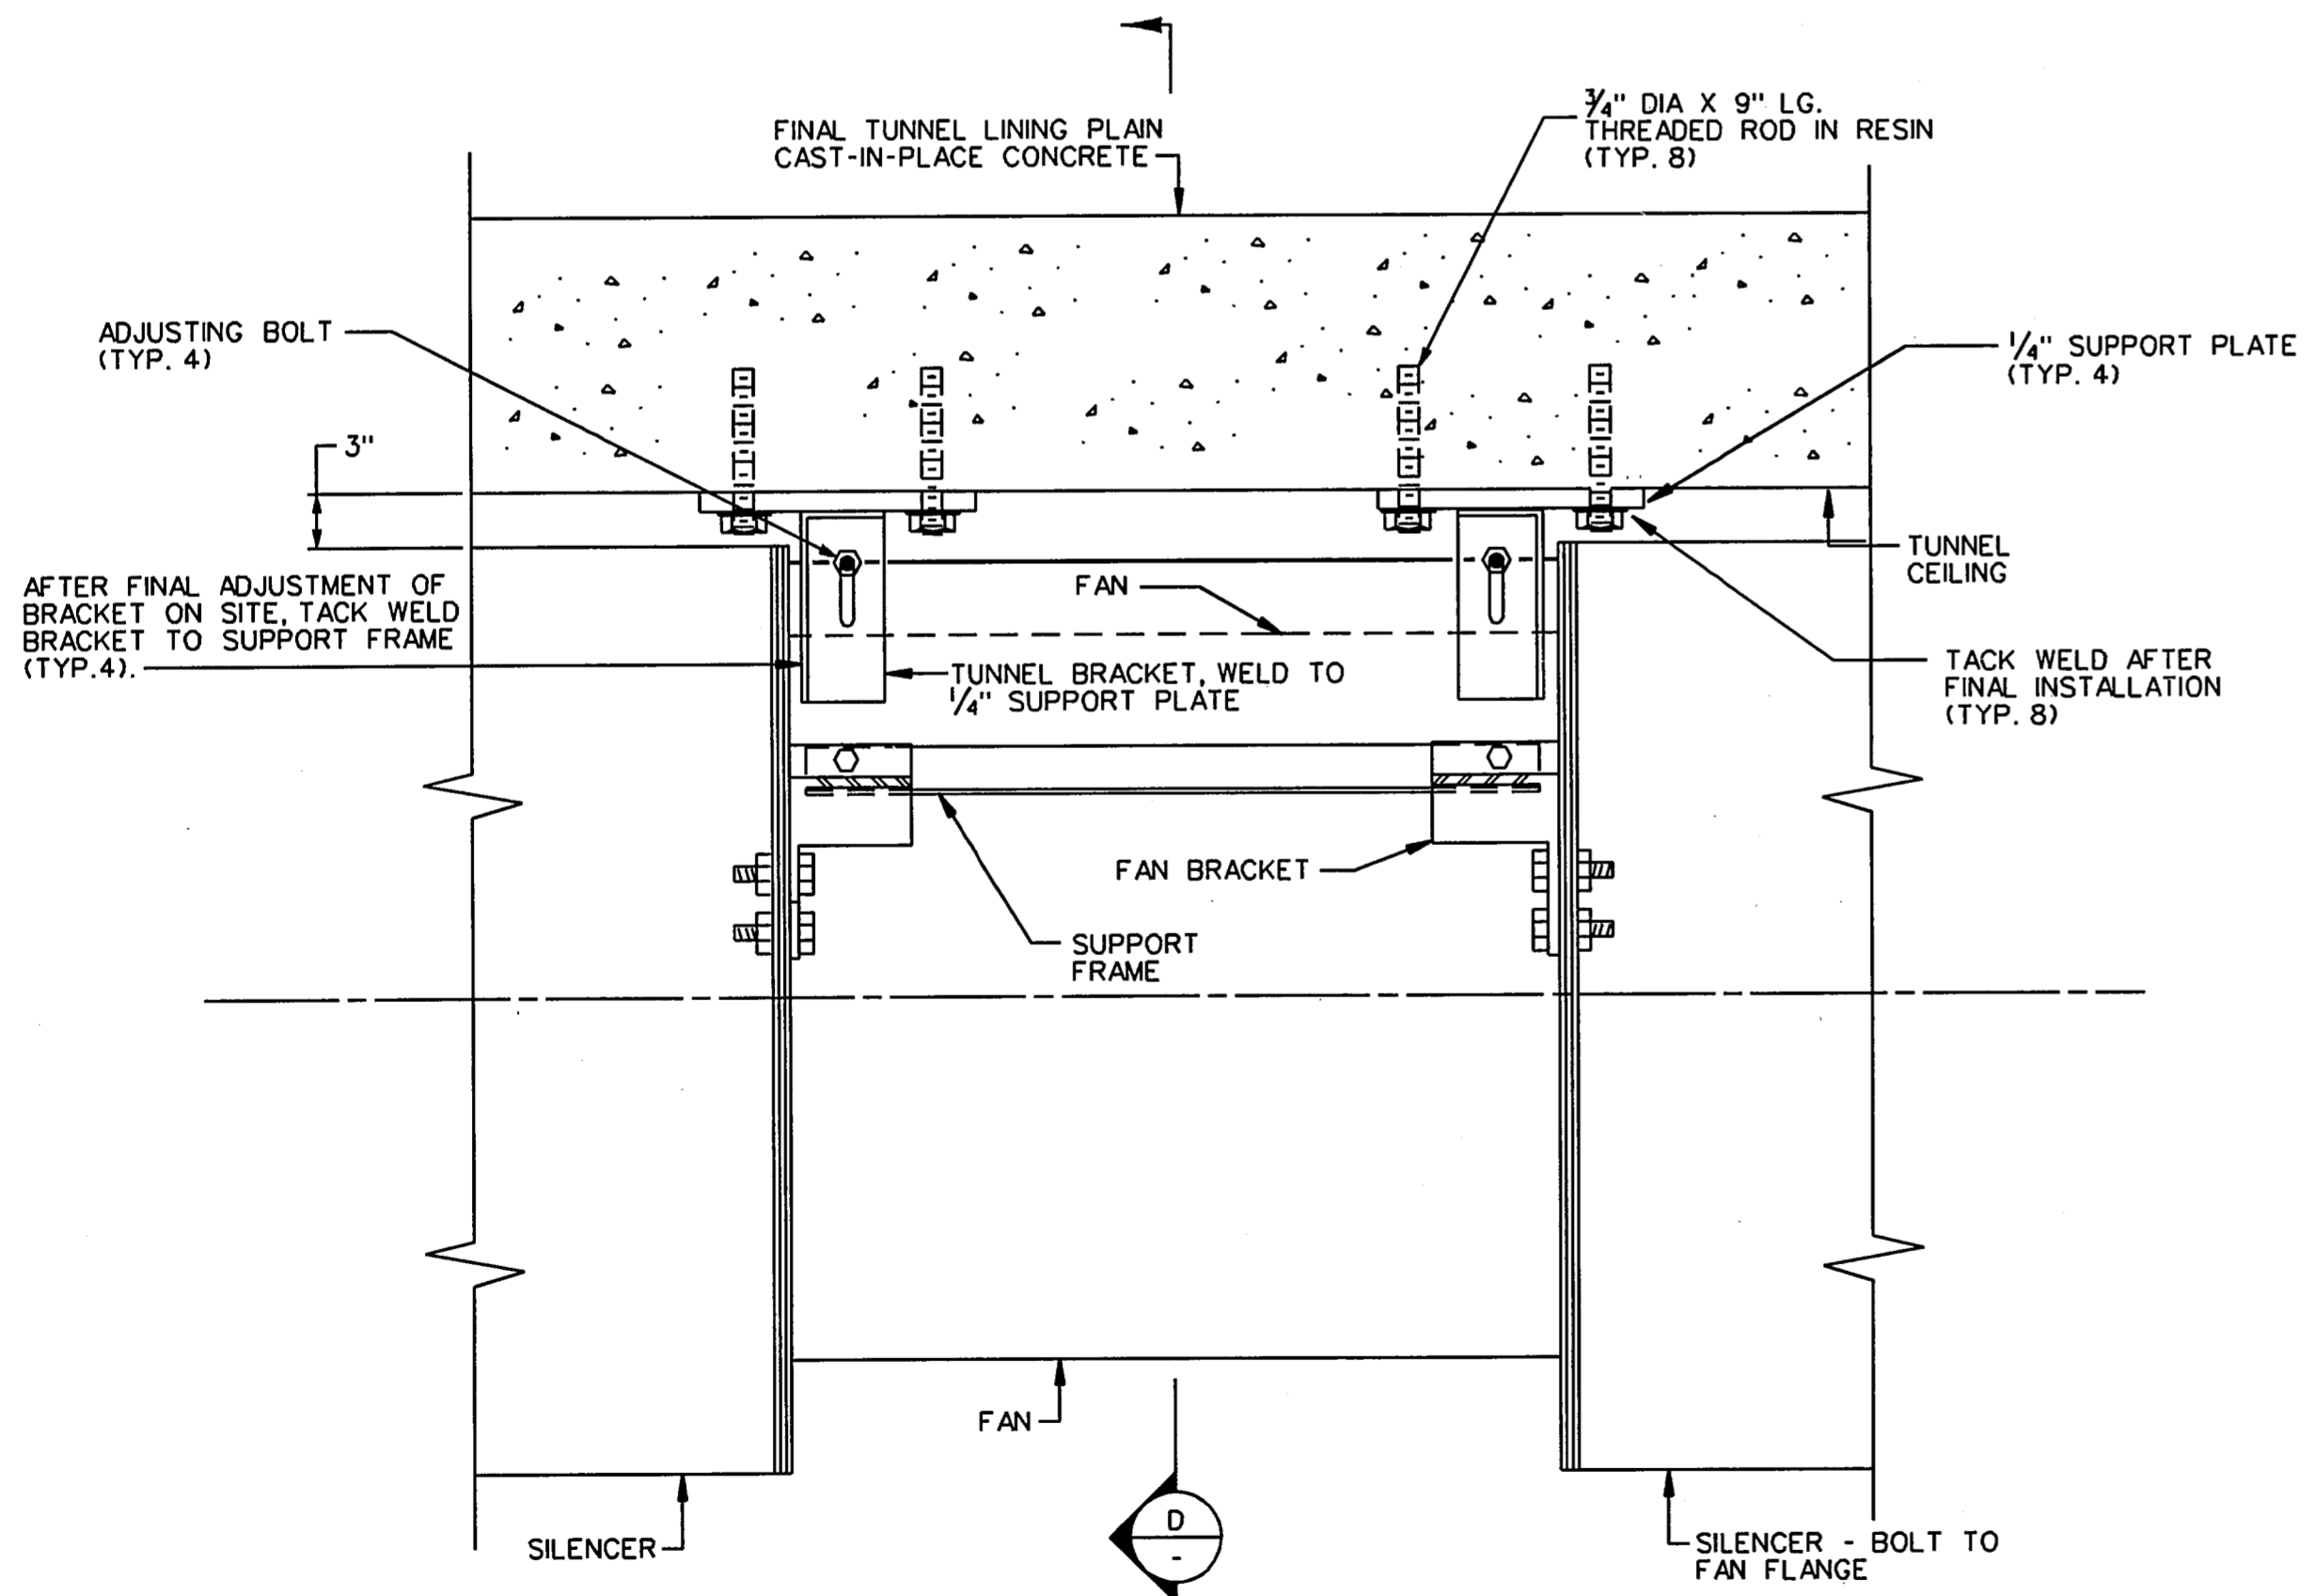

**C FAN MOUNTING DETAIL**  
NO SCALE

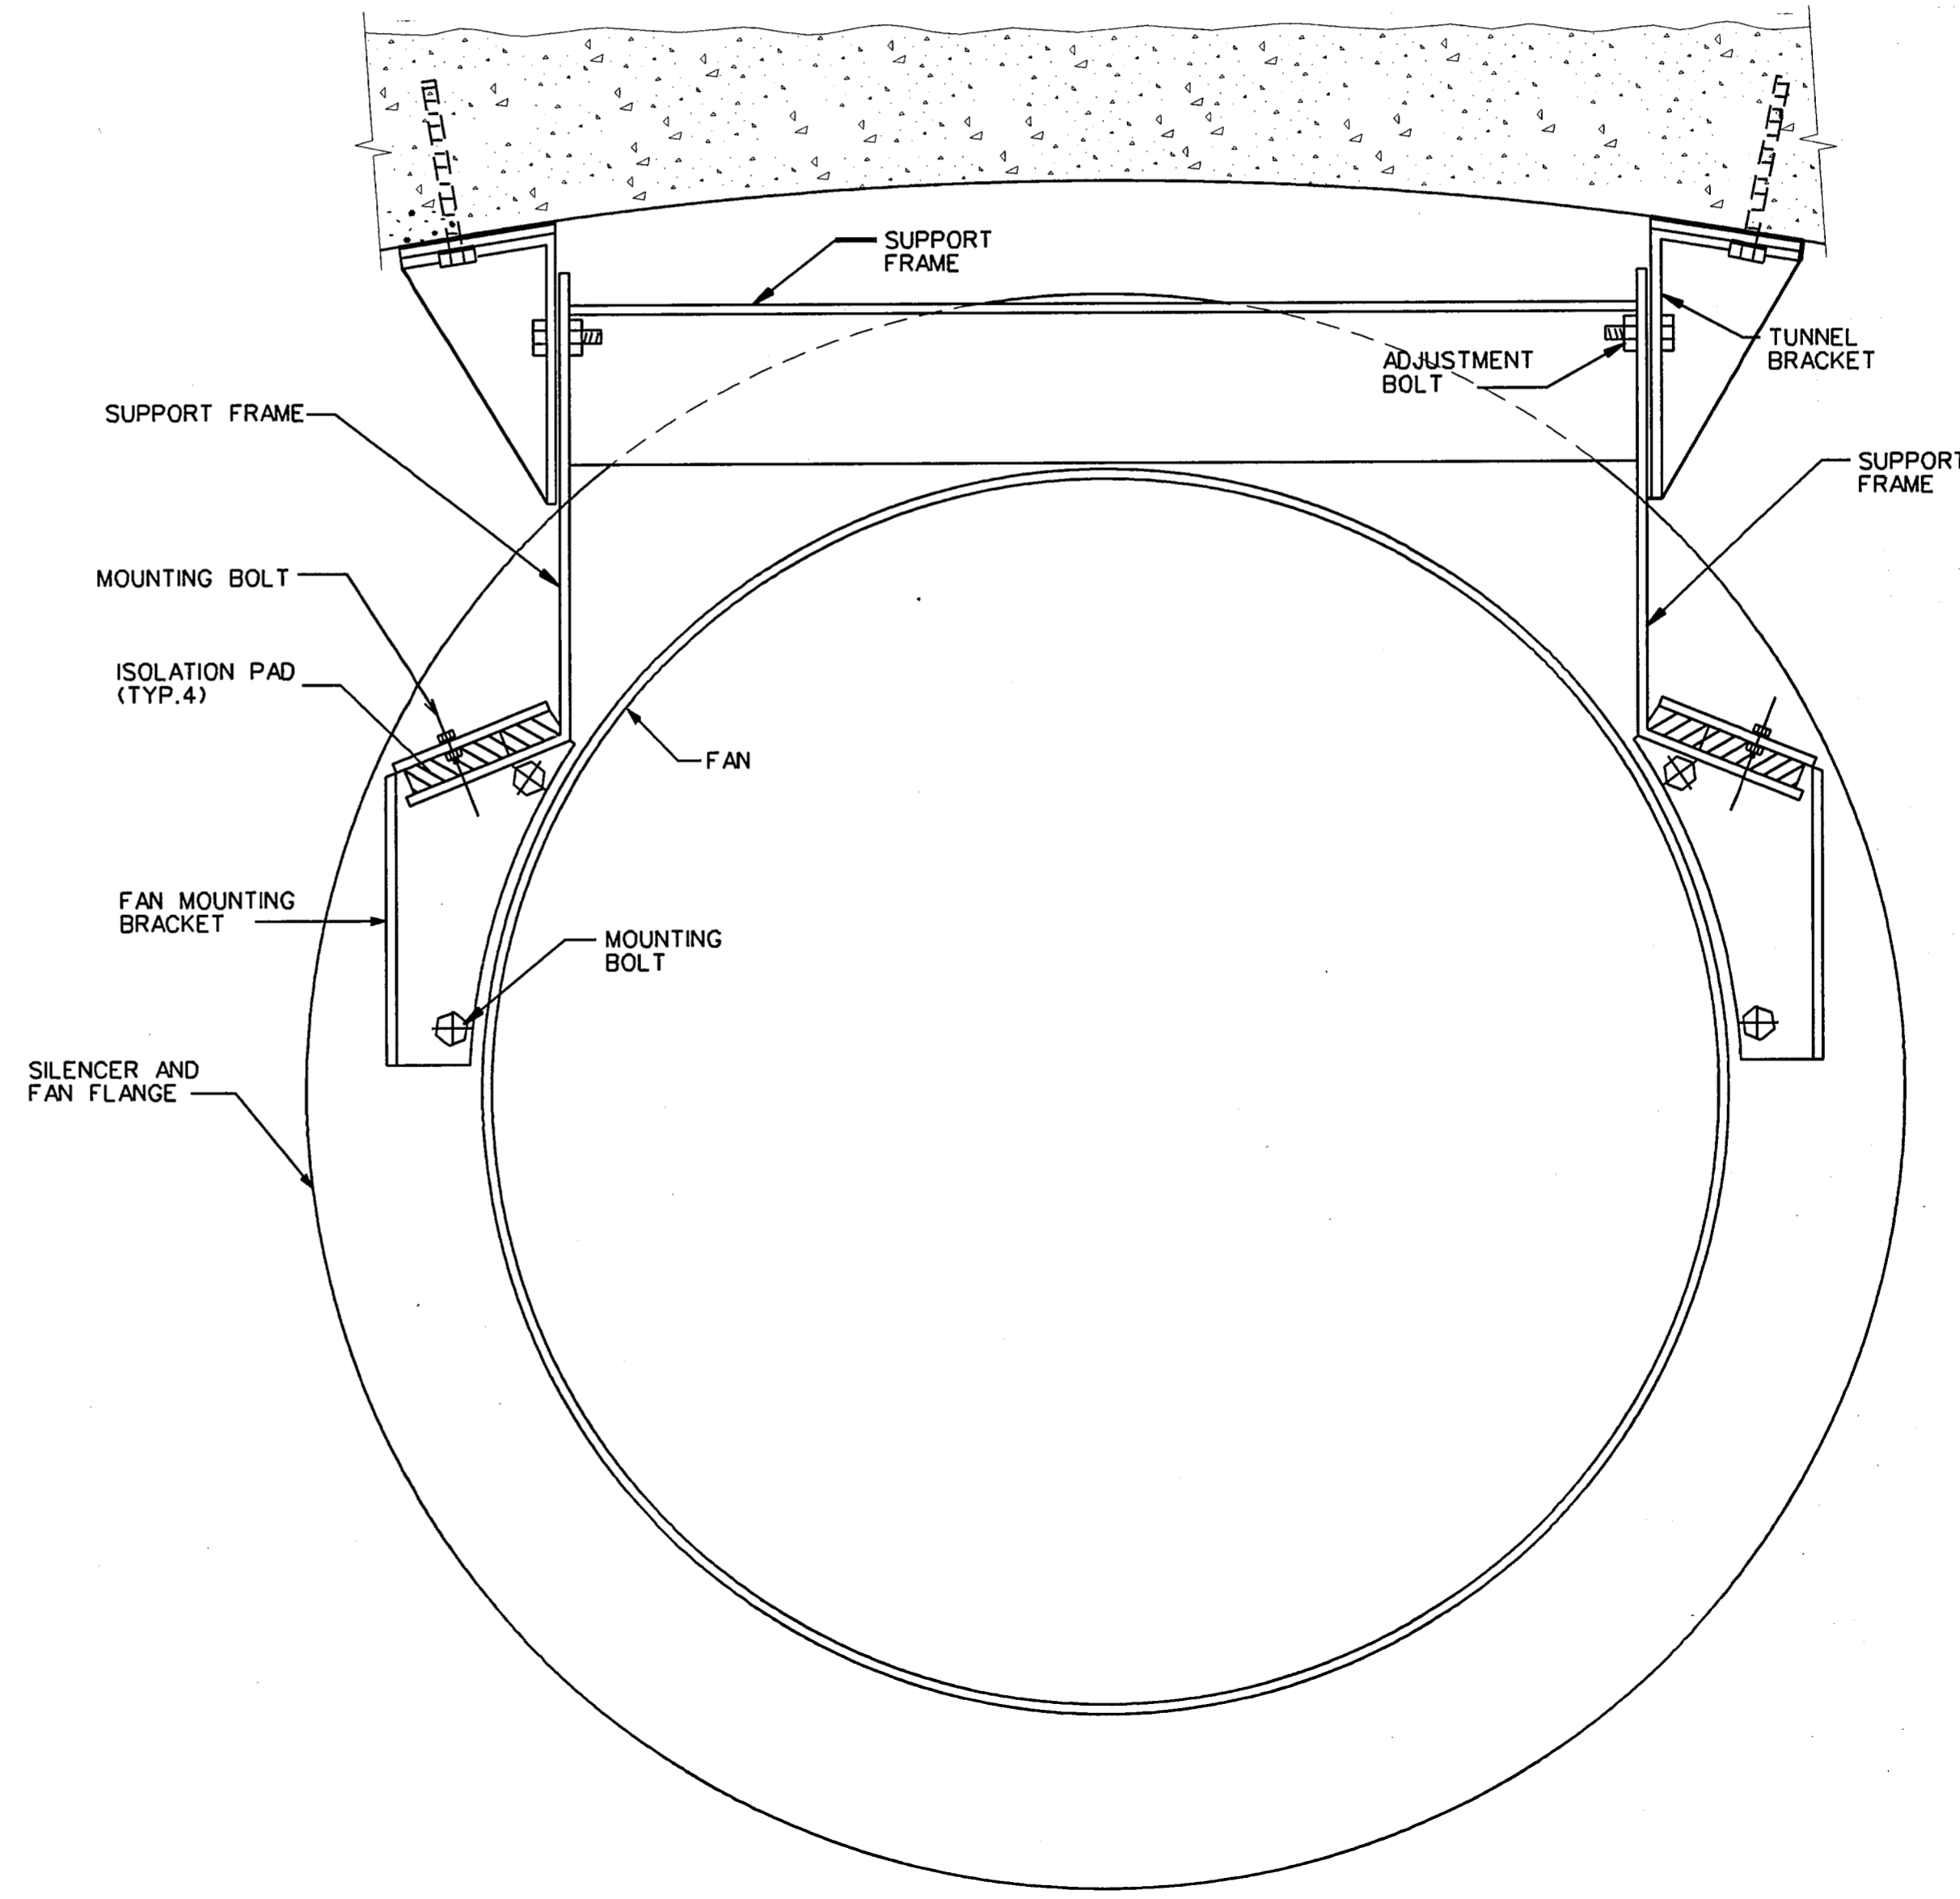

**D FAN MOUNTING BRACKET DETAIL**  
NO SCALE

- GENERAL NOTES:**
- A. SUPPORT FANS AND SILENCERS IN ACCORDANCE WITH THE REQUIREMENTS OF THIS DRAWING AND THE MANUFACTURER'S RECOMMENDATIONS.
  - B. FAN SUPPORTS SHALL BE PROVIDED BY FAN MANUFACTURER.


C. RFI # 161  
VENT FANS - TUNNEL  
VENTILATION SYSTEM




THE SEAL APPEARING ON THIS DOCUMENT WAS AUTHORIZED BY MIKE L. ASHCRAFT, P.E., 56590 ON SEPTEMBER 9, 1996

**FINAL RECORD DRAWING**  
Date: 12/25/99



No.	REVISION	BY	DATE
TEXAS TURNPIKE AUTHORITY ADDISON AIRPORT TUNNEL			
TUNNEL VENTILATION SECTIONS			
HDR Engineering, Inc.			SECTION XIII
DRAWN: WTD	DATE: 12/05/96	DESIGNED: MLA	DATE: 08/28/96
CHECKED: BL	DATE: 08/28/96	SCALE: AS SHOWN	
CONTRACT No. DNT-260 SHEET M140 OF 166			

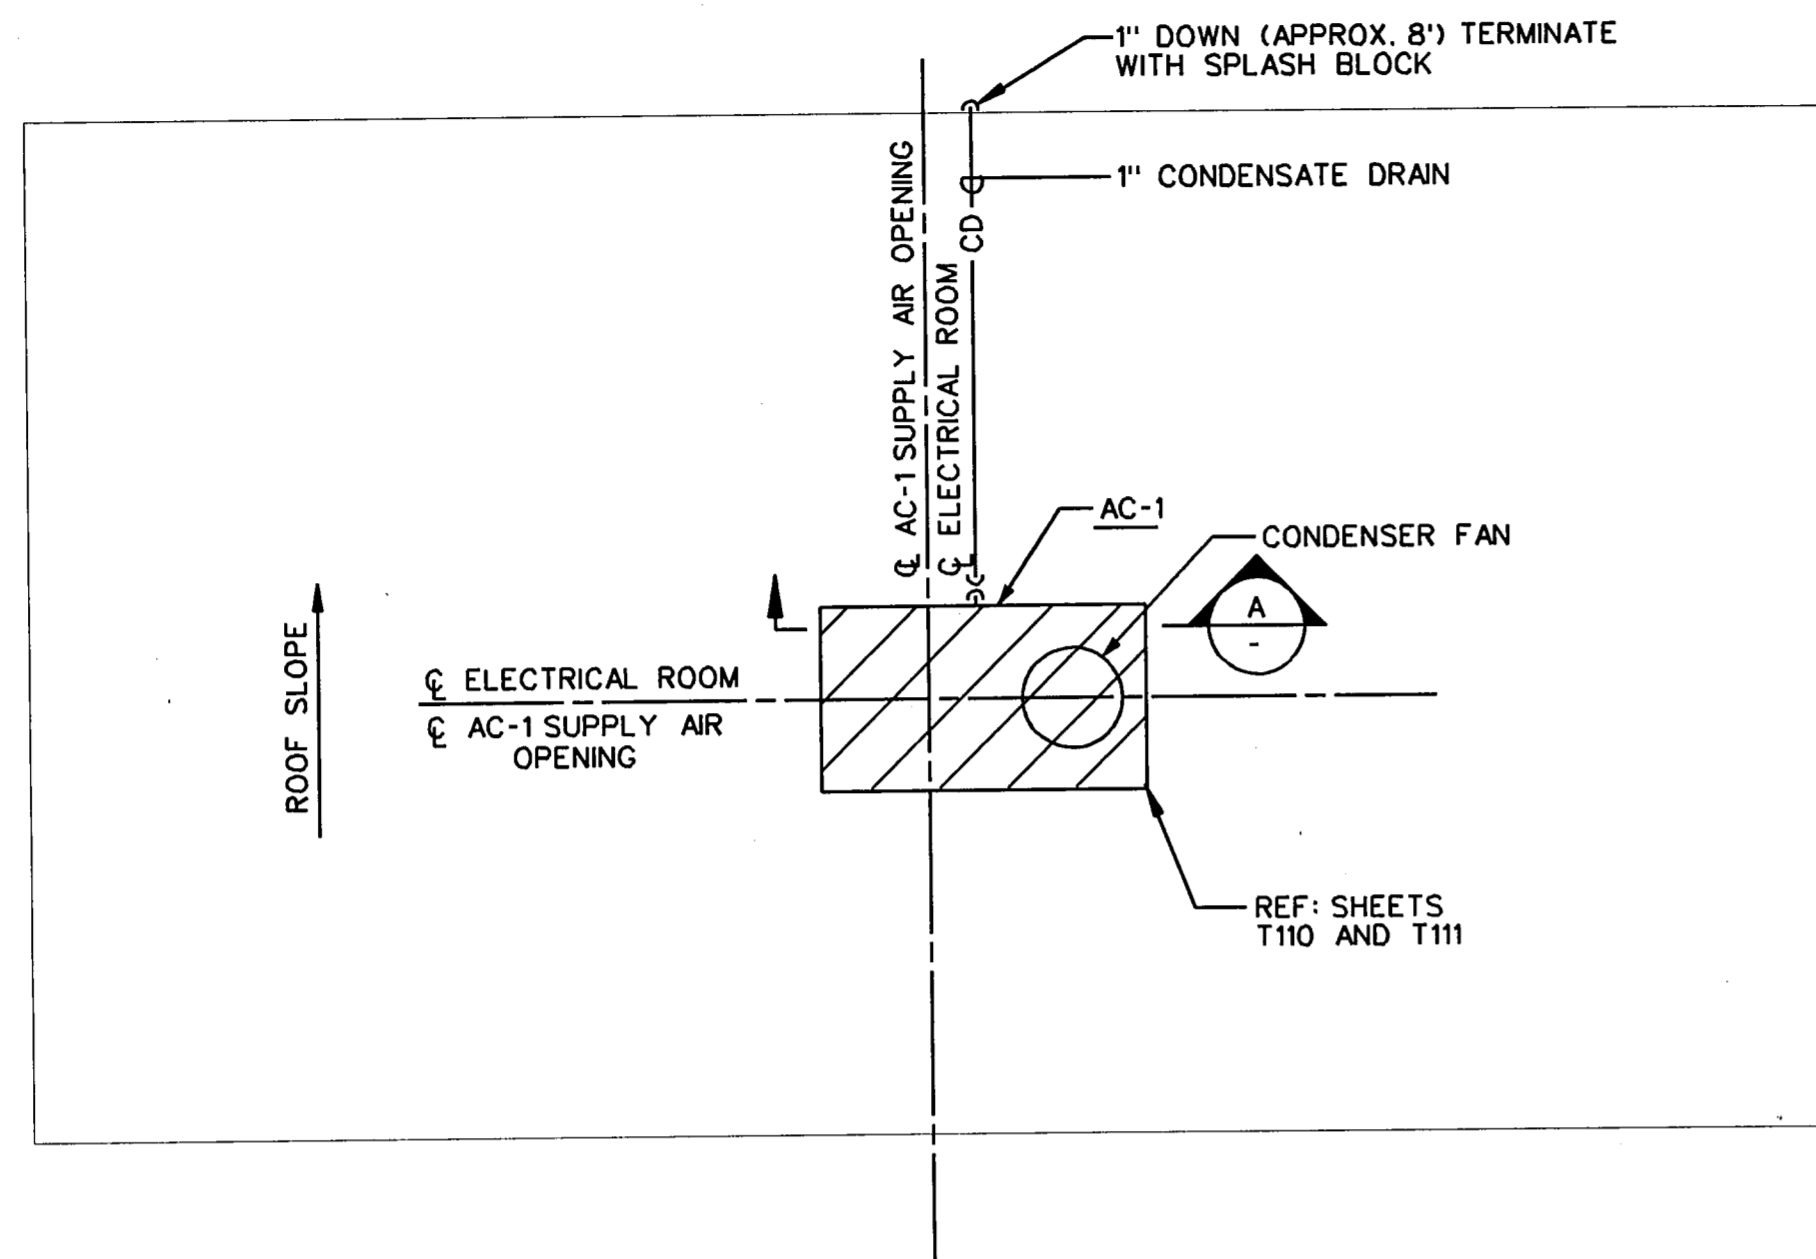


2 ELECTRICAL ROOM - HVAC ROOF PLAN  
SCALE: 1/4" = 1'-0"

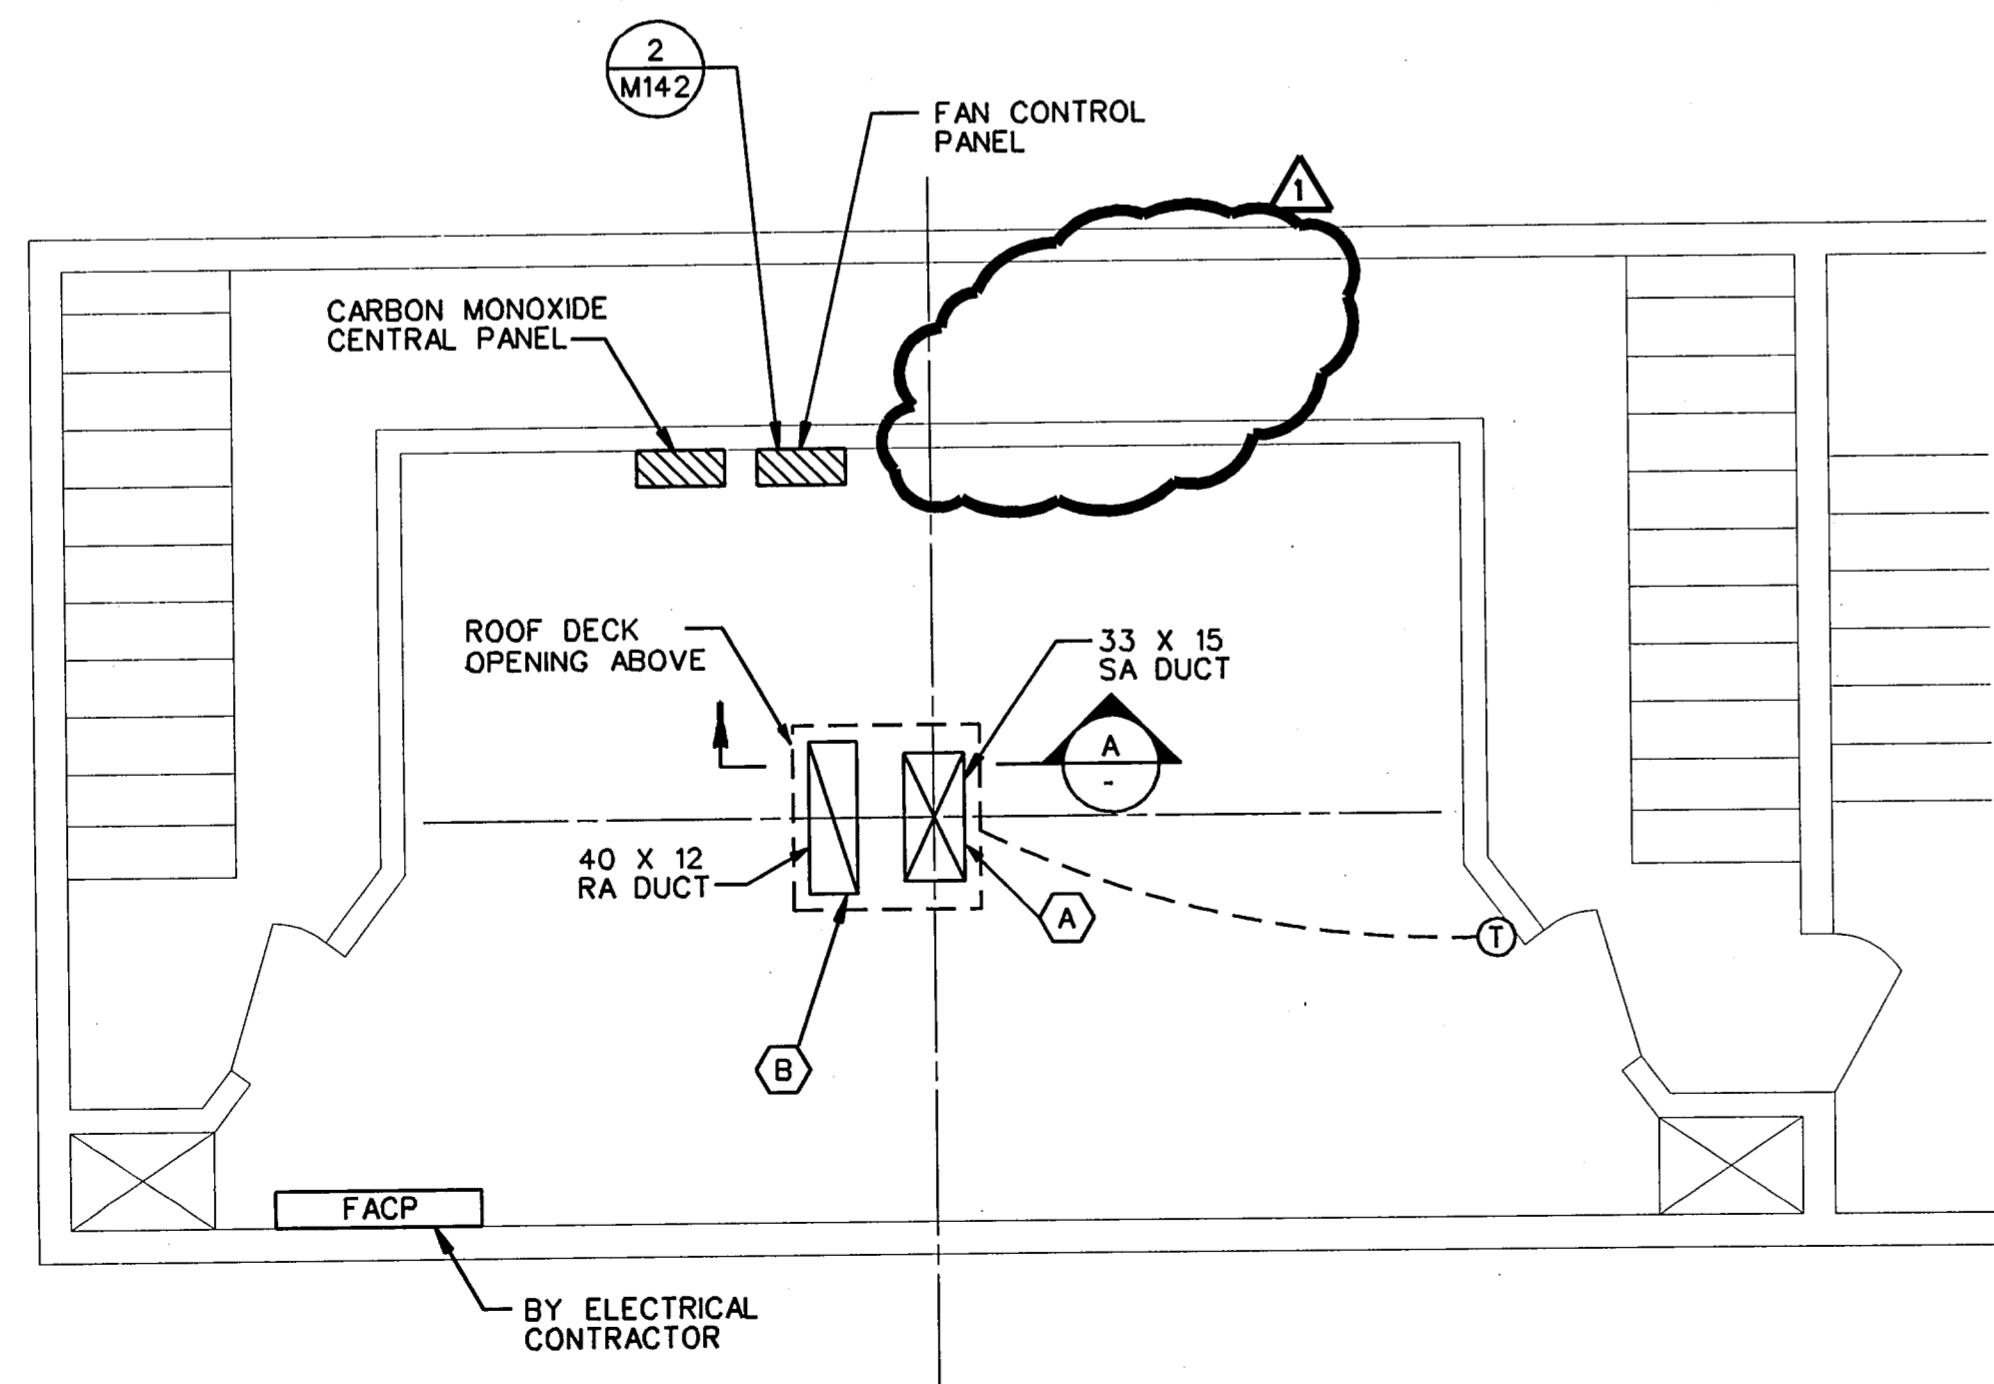

3 ELECTRICAL ROOM - HVAC FLOOR PLAN  
SCALE: 1/4" = 1'-0"

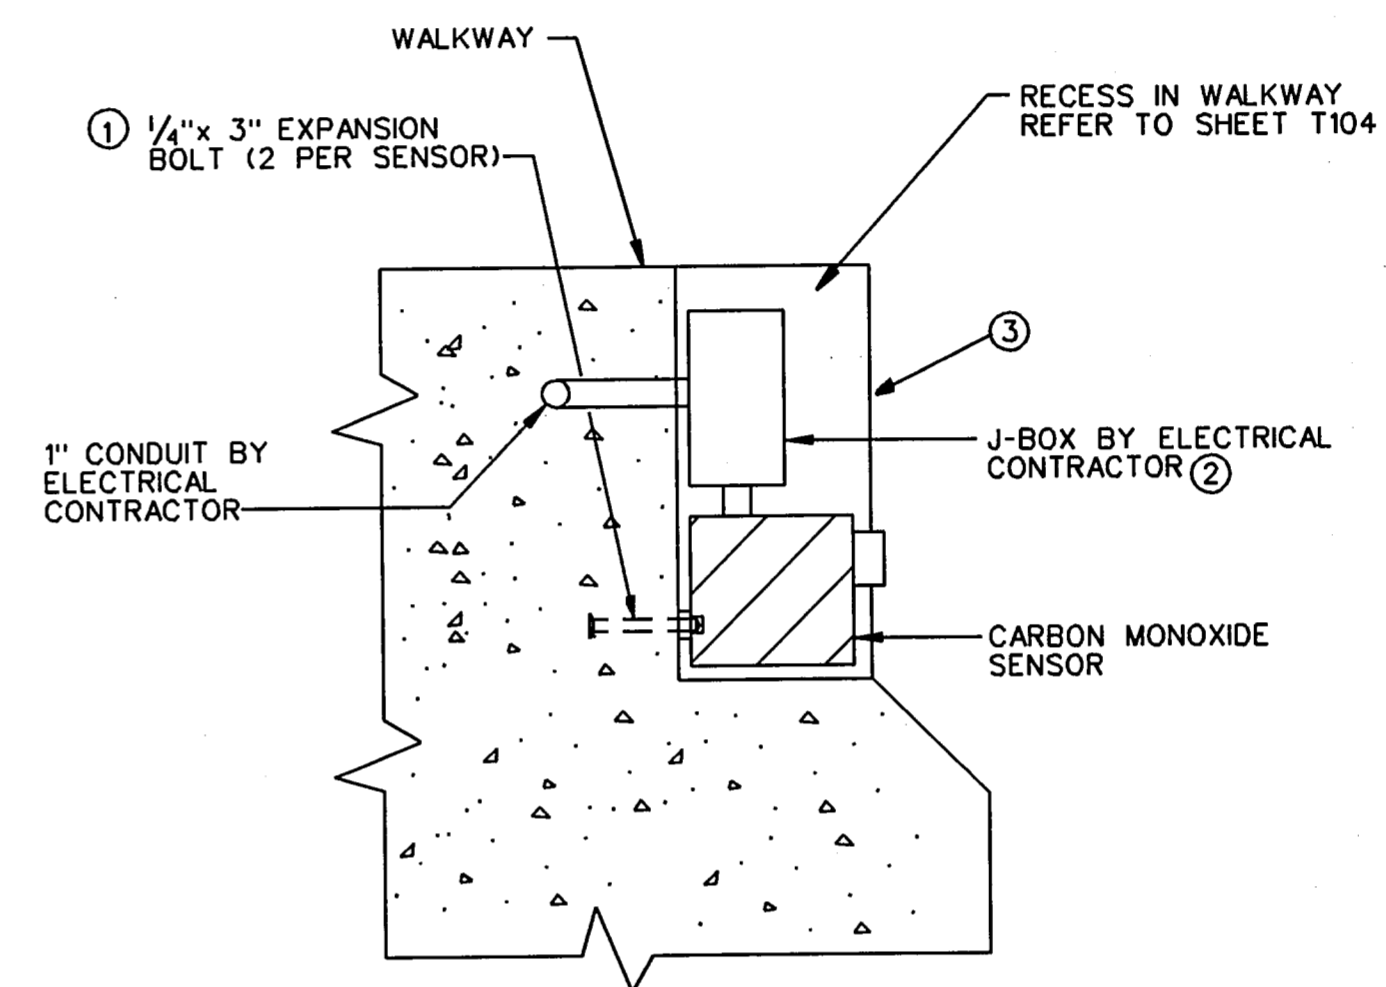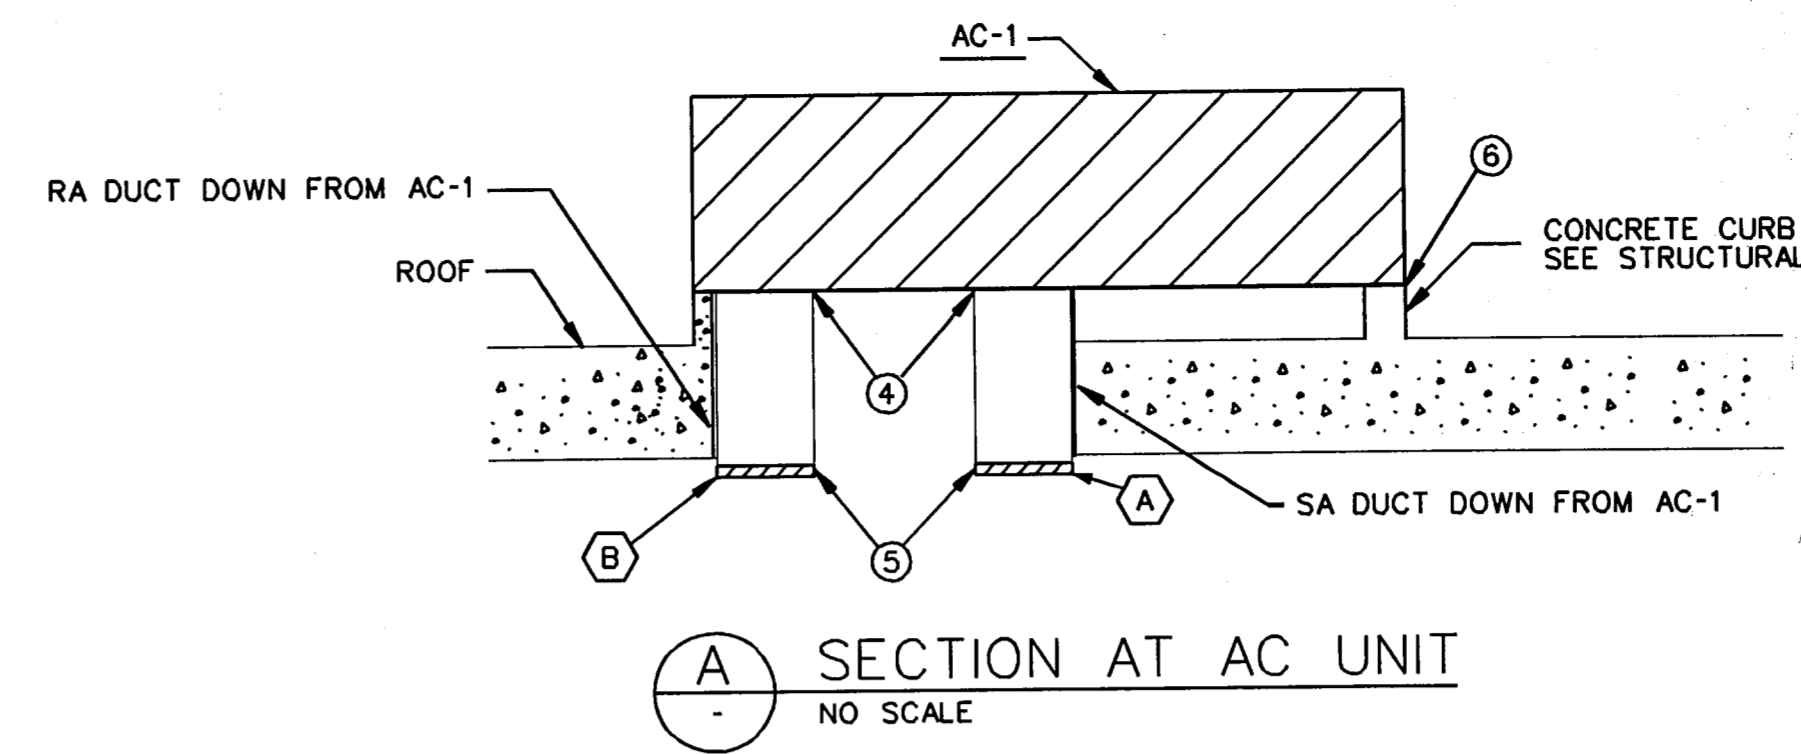

B SECTION AT CO SENSOR  
NO SCALE

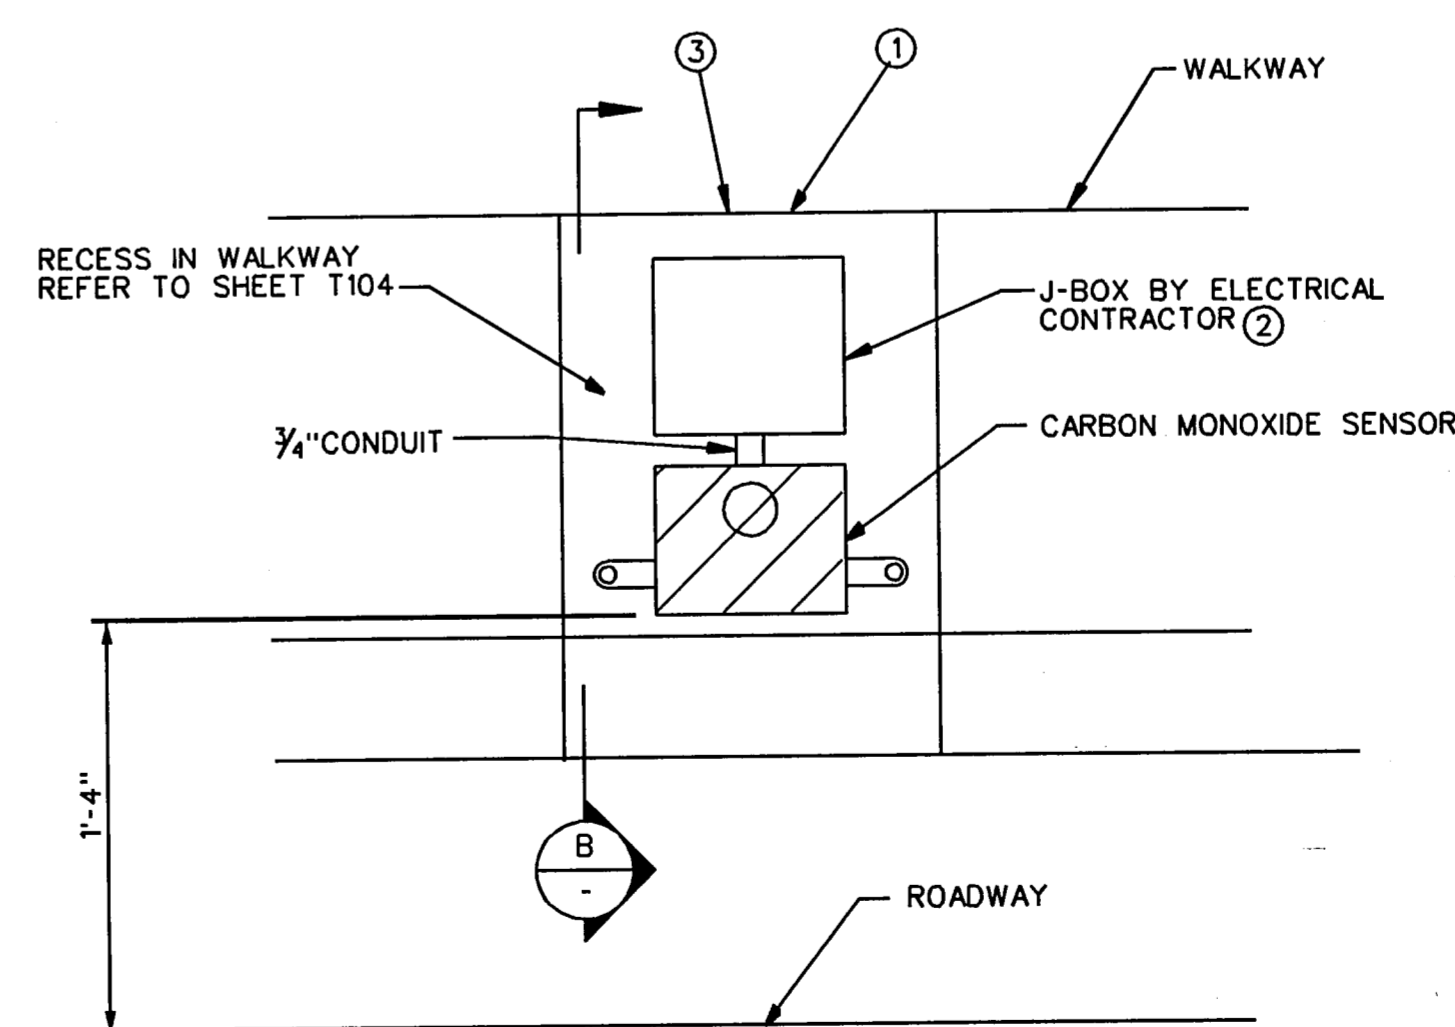

1 ELEVATION AT CO SENSOR  
NO SCALE

- KEY NOTES:
- FASTEN THE CARBON MONOXIDE SENSOR ACCORDING TO THE MANUFACTURER'S RECOMMENDATIONS.
  - COORDINATE WITH THE ELECTRICAL CONTRACTOR. PULL CONTROL WIRING IN CONDUIT AND J-BOXES PROVIDED BY ELECTRICAL CONTRACTOR.
  - THE RECESS IS SIZED FOR THE SENSOR SPECIFIED. IF AN ALTERNATE MANUFACTURER IS USED, COORDINATE SIZE OF RECESS WITH GENERAL CONTRACTOR PRIOR TO CONSTRUCTION OF WALKWAY. RECESS SHALL BE OF SUFFICIENT SIZE TO ALLOW REMOVAL AND REPLACEMENT OF SENSOR.
  - PROVIDE AND INSTALL 1X1X3/8" ANGLE INSIDE THE CURB OPENING TO SUPPORT THE DUCT. LOCATE AND SEAL ACCORDING TO THE MANUFACTURER'S CURB DETAIL.
  - PROVIDE AND INSTALL 1X1X3/8" ANGLE TO SPAN THE BOTTOM OF THE ROOF DECK OPENING FOR DUCT AND AIR DEVICE SUPPORT. MATCH THE SUPPORT PATTERN USED AT THE TOP OF THE DUCTS.
  - SEAL CURB ACCORDING TO MANUFACTURER'S RECOMMENDATIONS. PROVIDE SPACER ALONG TOP OF CURB IF NECESSARY TO MAINTAIN 1/4" GAP BETWEEN THE CURB AND CABINET PERIMETER FLANGE.




THE SEAL APPEARING ON THIS DOCUMENT WAS AUTHORIZED BY MIKE L. ASHCRAFT, P.E., 56590 ON SEPTEMBER 9, 1996

FINAL RECORD DRAWING  
Date: 12/25/99

GEN. SETS		MLA	2/7/97
No.	REVISION	BY	DATE
TEXAS TURNPIKE AUTHORITY ADDISON AIRPORT TUNNEL			
TUNNEL VENTILATION SECTIONS & ELECTRIC ROOM AIR CONDITIONING			
HDR Engineering, Inc.			SECTION XIII
DRAWN: WTD	DATE: 12/05/96	DESIGNED: MLA	DATE: 08/28/96
CHECKED: BL	DATE: 08/28/96	SCALE: AS SHOWN	
CONTRACT No. DNT-260 SHEET M141 OF 166			

**GENERAL NOTES:**

- A. MOUNT FAN STARTERS ON NORTH WALL OF TUNNEL.
- B. VENTILATION FAN CONTROL PANEL IN ELECTRICAL ROOM AT WEST PORTAL OVERRIDES ALL OTHER CONTROLS.
- C. INPUT FROM FIRE ALARM SYSTEM INCLUDES PULL STATIONS AND HEAT DETECTORS.
- D. PROVIDE AN EMPTY 2" CONDUIT FROM THE TOLL PLAZA AREA TO THE VENTILATION CONTROL PANEL IN ELECTRICAL ROOM AT WEST PORTAL FOR FUTURE INPUT FROM REMOTE MONITORING STATION.
- E. A SIGNAL FROM A PULL STATION OR HEAT DETECTOR EAST OF STA 18+00 SHALL START ALL TUNNEL VENTILATION FANS IN THE "DISCHARGE EAST" MODE. A SIGNAL FROM A PULL STATION OR HEAT DETECTOR WEST OF STA 18+00 SHALL START ALL TUNNEL VENTILATION FANS IN THE "DISCHARGE WEST" MODE. IF SIGNALS ARE RECEIVED FROM HEAT DETECTORS OR PULL STATIONS ON BOTH SIDES OF STATION 18+00, ALL TUNNEL VENTILATION FANS SHALL GO TO THE "DISCHARGE WEST" MODE.
- F. A SIGNAL FROM ANY CARBON MONOXIDE SENSOR SHALL START ALL TUNNEL VENTILATION FANS IN THE DISCHARGE WEST MODE.
- G. PROVIDE ALL CONDUIT, WIRING, TRANSFORMERS, RELAYS AND DEVICES NECESSARY FOR A COMPLETE AND OPERATING FAN CONTROL SYSTEM WITH OPERATING SEQUENCE AS INDICATED ABOVE.
- H. PROVIDE A 30 SECOND DELAY BETWEEN ANY FAN REVERSAL, WHETHER FROM THE FIRE ALARM SYSTEM INPUT OR MAIN CONTROL PANEL INPUT.

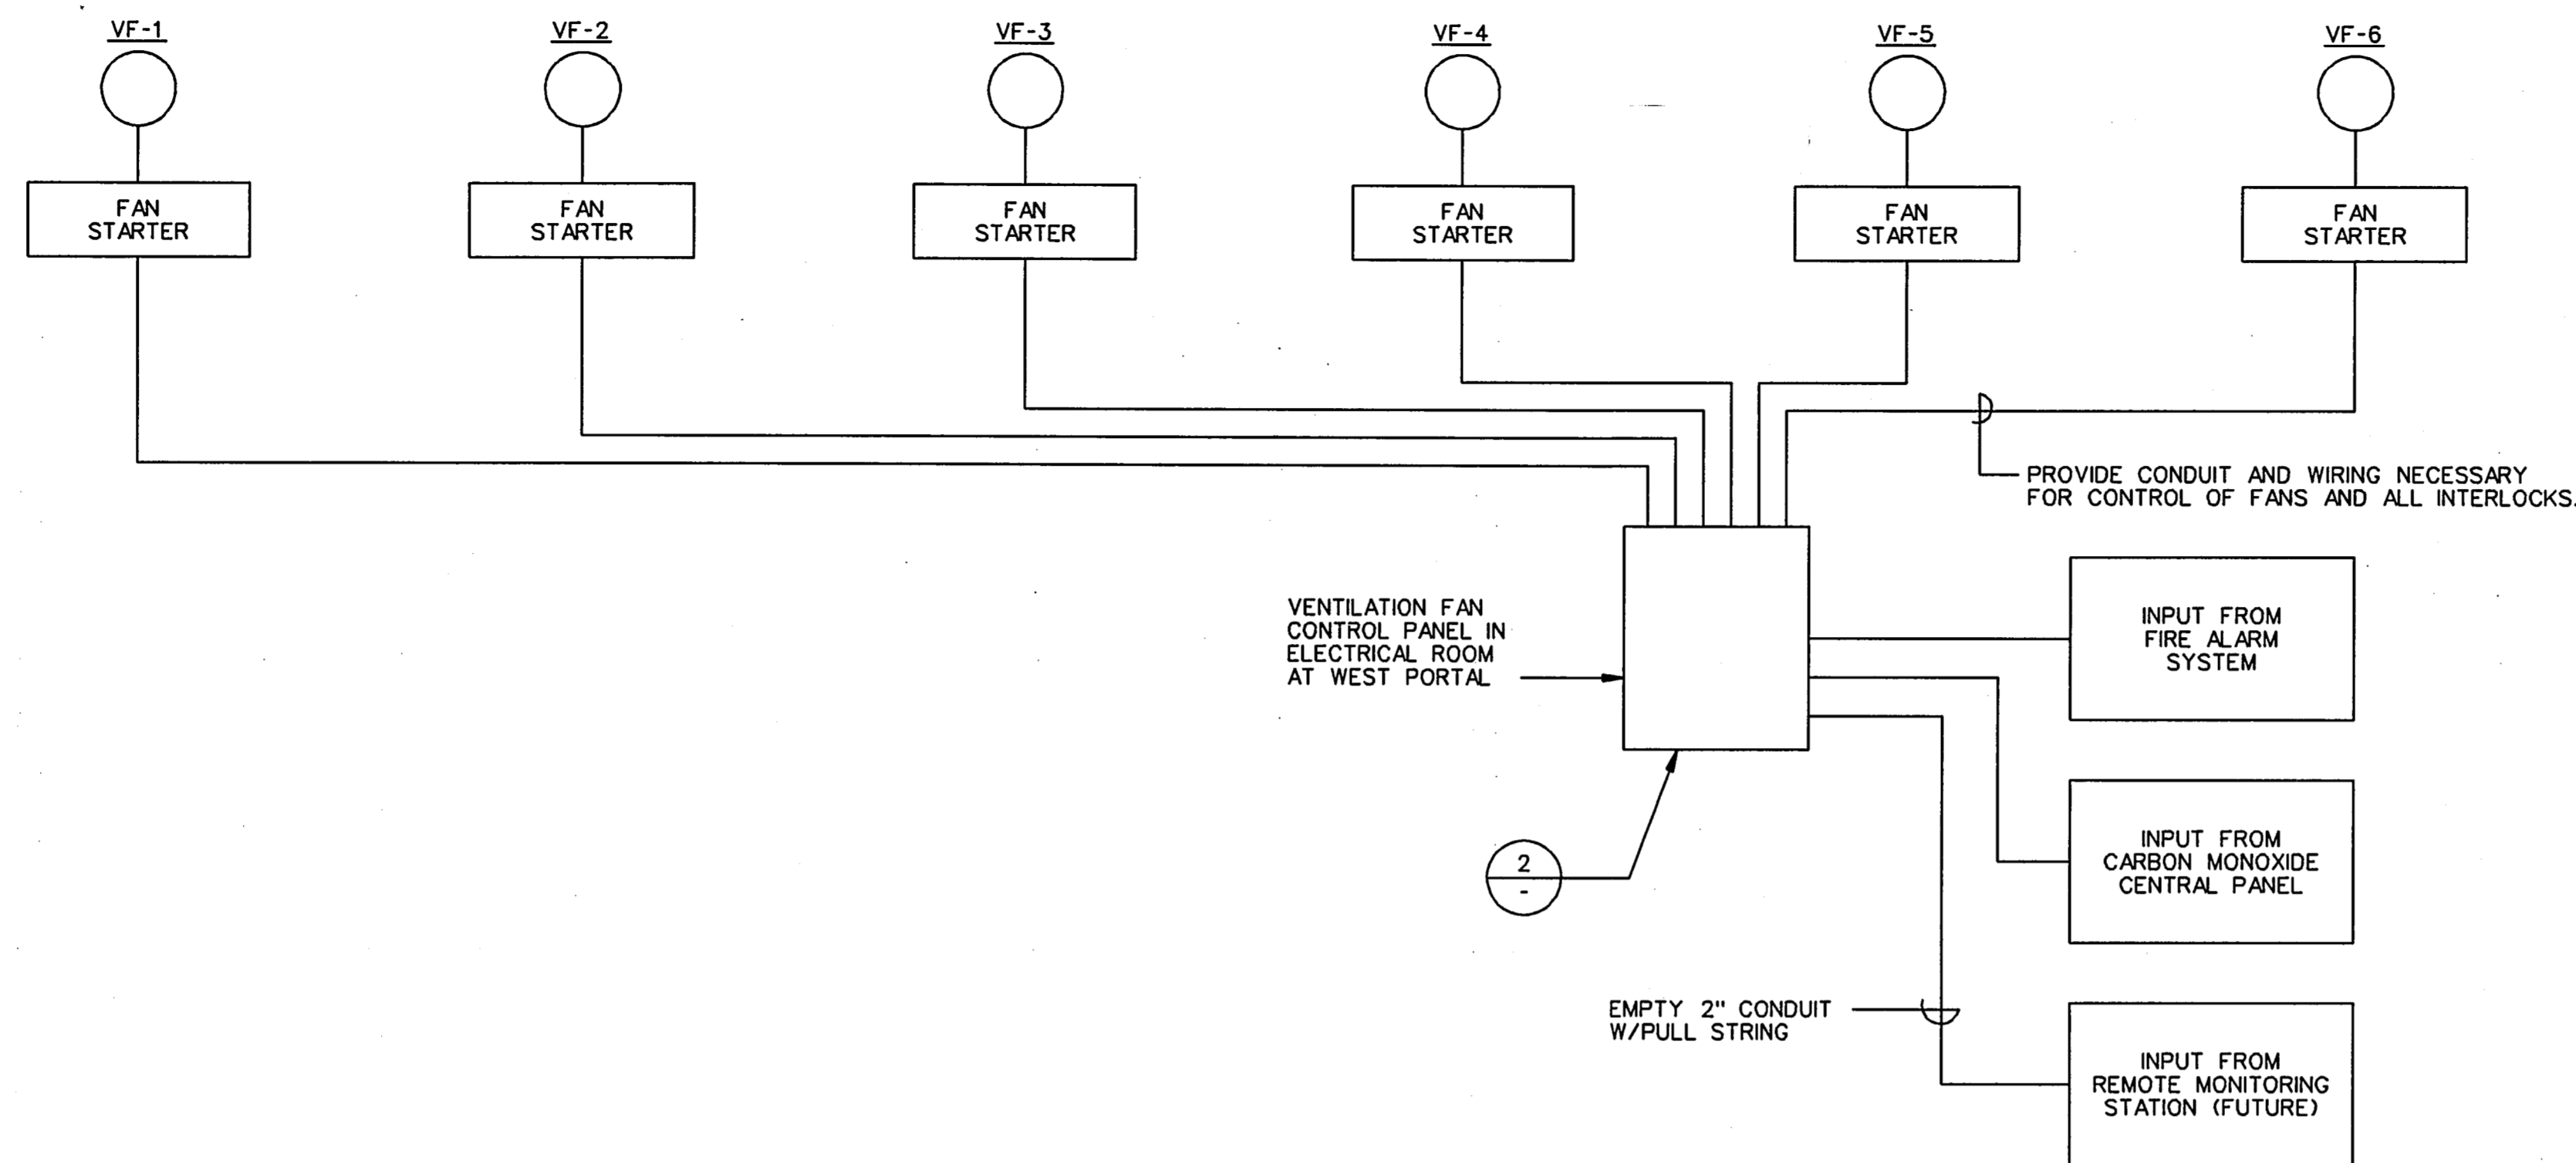

1 VENTILATION FAN CONTROL SCHEMATIC  
NO SCALE

FAN No.	FAN CONTROL			AIR FLOW INDICATOR		VIBRATION INDICATOR	
	OFF	DISCHARGE WEST	DISCHARGE EAST	AIR FLOW WEST	AIR FLOW EAST	VIBRATION ALERT	VIBRATION ALARM
VF-1	(C) (⊙)	(R) (⊙)	(R) (⊙)	(R) (⊙)	(R) (⊙)	(Y) (⊙)	(R) (⊙)
VF-2	(C) (⊙)	(R) (⊙)	(R) (⊙)	(R) (⊙)	(R) (⊙)	(Y) (⊙)	(R) (⊙)
VF-3	(C) (⊙)	(R) (⊙)	(R) (⊙)	(R) (⊙)	(R) (⊙)	(Y) (⊙)	(R) (⊙)
VF-4	(C) (⊙)	(R) (⊙)	(R) (⊙)	(R) (⊙)	(R) (⊙)	(Y) (⊙)	(R) (⊙)
VF-5	(C) (⊙)	(R) (⊙)	(R) (⊙)	(R) (⊙)	(R) (⊙)	(Y) (⊙)	(R) (⊙)
VF-6	(C) (⊙)	(R) (⊙)	(R) (⊙)	(R) (⊙)	(R) (⊙)	(Y) (⊙)	(R) (⊙)

MOMENTARY CONTACT PUSH BUTTON (TYP.)

INDICATING LIGHT (TYP.)

PROVIDE CONTROL PANEL IN STAINLESS STEEL WEATHERPROOF CABINET WITH LOCKING COVER. LOCATE IN THE ELECTRIC ROOM AT THE WEST PORTAL.

⊙ PUSH TO TEST INDICATING LIGHTS

VF-1 VF-2 VF-3 VF-4 VF-5 VF-6

WEST PORTAL TUNNEL FAN LAYOUT EAST PORTAL

2 VENTILATION FAN CONTROL PANEL  
PI41 NO SCALE



THE SEAL APPEARING ON THIS DOCUMENT WAS AUTHORIZED BY MIKE L. ASHCRAFT, P.E., 56590 ON SEPTEMBER 9, 1996

**FINAL RECORD DRAWING**  
Date: 12/25/99

No.	REVISION	BY	DATE
TEXAS TURNPIKE AUTHORITY ADDISON AIRPORT TUNNEL			
TUNNEL VENTILATION CONTROL SCHEMATICS			
HDR HDR Engineering, Inc.			SECTION XIII
DRAWN: WTD	DATE: 12/05/96	DESIGNED: MLA	DATE: 08/28/96
CHECKED: KG	DATE: 08/28/96	SCALE: AS SHOWN	
CONTRACT No. DNT-260 SHEET M142 OF 166			




**NOTES:**

1. INLET AND OUTLET SILENCERS.
2. REVERSIBLE THRUST BY REVERSING FAN ROTATION. THRUST IS THE SAME IN BOTH DIRECTIONS.
3. ALUMINUM
4. DOUBLE DEFLECTION
5. PROVIDE W/FILTER.
6. COOLING CAPACITY IS BY A.R.I. STANDARD 210/240.
7. DOWN DISCHARGE SUPPLY AIR.
8. MAXIMUM EXTERNAL STATIC PRESSURE DOES NOT INCLUDE ECONOMIZER.

VENTILATION FAN SCHEDULE											
MARK	NOISE SOUND PRESSURE (db)	OUTLET VELOCITY (FPM)	THRUST (LB)	RPM	DRIVE	HP	VOLT	PH	HZ	MANUFACTURER AND MOD. NO.	NOTES / LOCATION
VF-1	62	104	126	1750	DIRECT	30	460	3	60	ABB FRDA-080-1-44-70	1,2 / STA. 12+11
VF-2	62	104	126	1750	DIRECT	30	460	3	60	ABB FRDA-080-1-44-70	1,2 / STA. 14+46
VF-3	62	104	126	1750	DIRECT	30	460	3	60	ABB FRDA-080-1-44-70	1,2 / STA. 16+82
VF-4	62	104	126	1750	DIRECT	30	460	3	60	ABB FRDA-080-1-44-70	1,2 / STA. 19+17
VF-5	62	104	126	1750	DIRECT	30	460	3	60	ABB FRDA-080-1-44-70	1,2 / STA. 21+53
VF-6	62	104	126	1750	DIRECT	30	460	3	60	ABB FRDA-080-1-44-70	1,2 / STA. 23+88

PACKAGE AIR CONDITIONER SCHEDULE										
MARK	COOLING (BTUH)	HEATING	MIN. O.A. (CFM)	FAN					UNIT MODEL	NOTES
				CFM	MAX. ESP (IN. W.C.)	VOLT	PHASE	HP		
AC-1	60,000	6KW	200	2000	0.75	460	3	3/4	TRANE TCD060	5,6,7,8



AIR DEVICE SCHEDULE							
MARK	TYPE	TTL PRES (IN. W.C.)	NC	DAMPER	MODEL	CFM	NOTES
(A)	LOUVERED SUPPLY	0.125	30	NO	PRICE 620	2000	3,4
(B)	EGG CRATE RETURN	0.125	30	NO	PRICE 80FF	2000	3,5

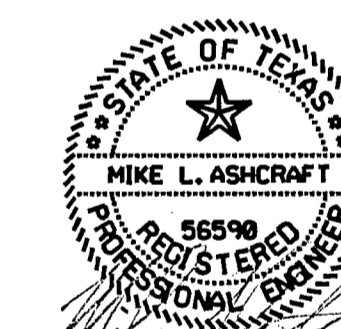

THE SEAL APPEARING ON THIS DOCUMENT WAS AUTHORIZED BY MIKE L. ASHCRAFT, P.E., 56590 ON SEPTEMBER 9, 1996

**FINAL RECORD DRAWING**  
Date: 12/25/99


No.	REVISION	BY	DATE
TEXAS TURNPIKE AUTHORITY ADDISON AIRPORT TUNNEL			
TUNNEL VENTILATION SCHEDULES			
			SECTION XIII
DRAWN: WTD	DATE: 12/05/96	DESIGNED: MLA	DATE: 08/28/96
CHECKED: BL	DATE: 08/28/96	SCALE: AS SHOWN	
CONTRACT No. DNT-260 SHEET M143 OF 166			

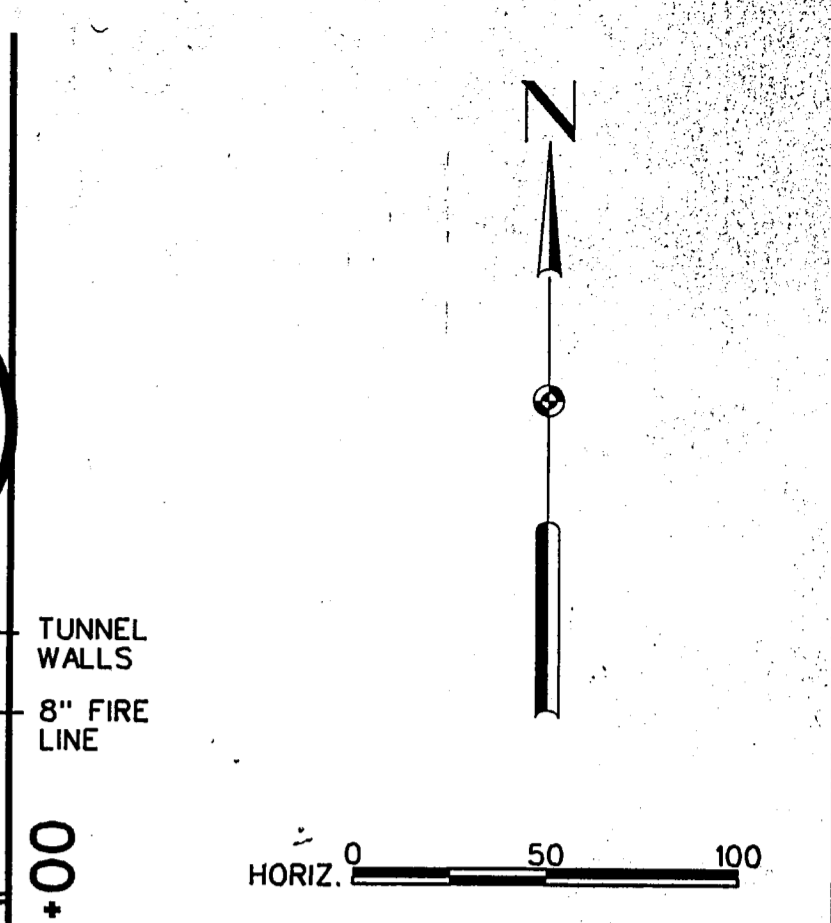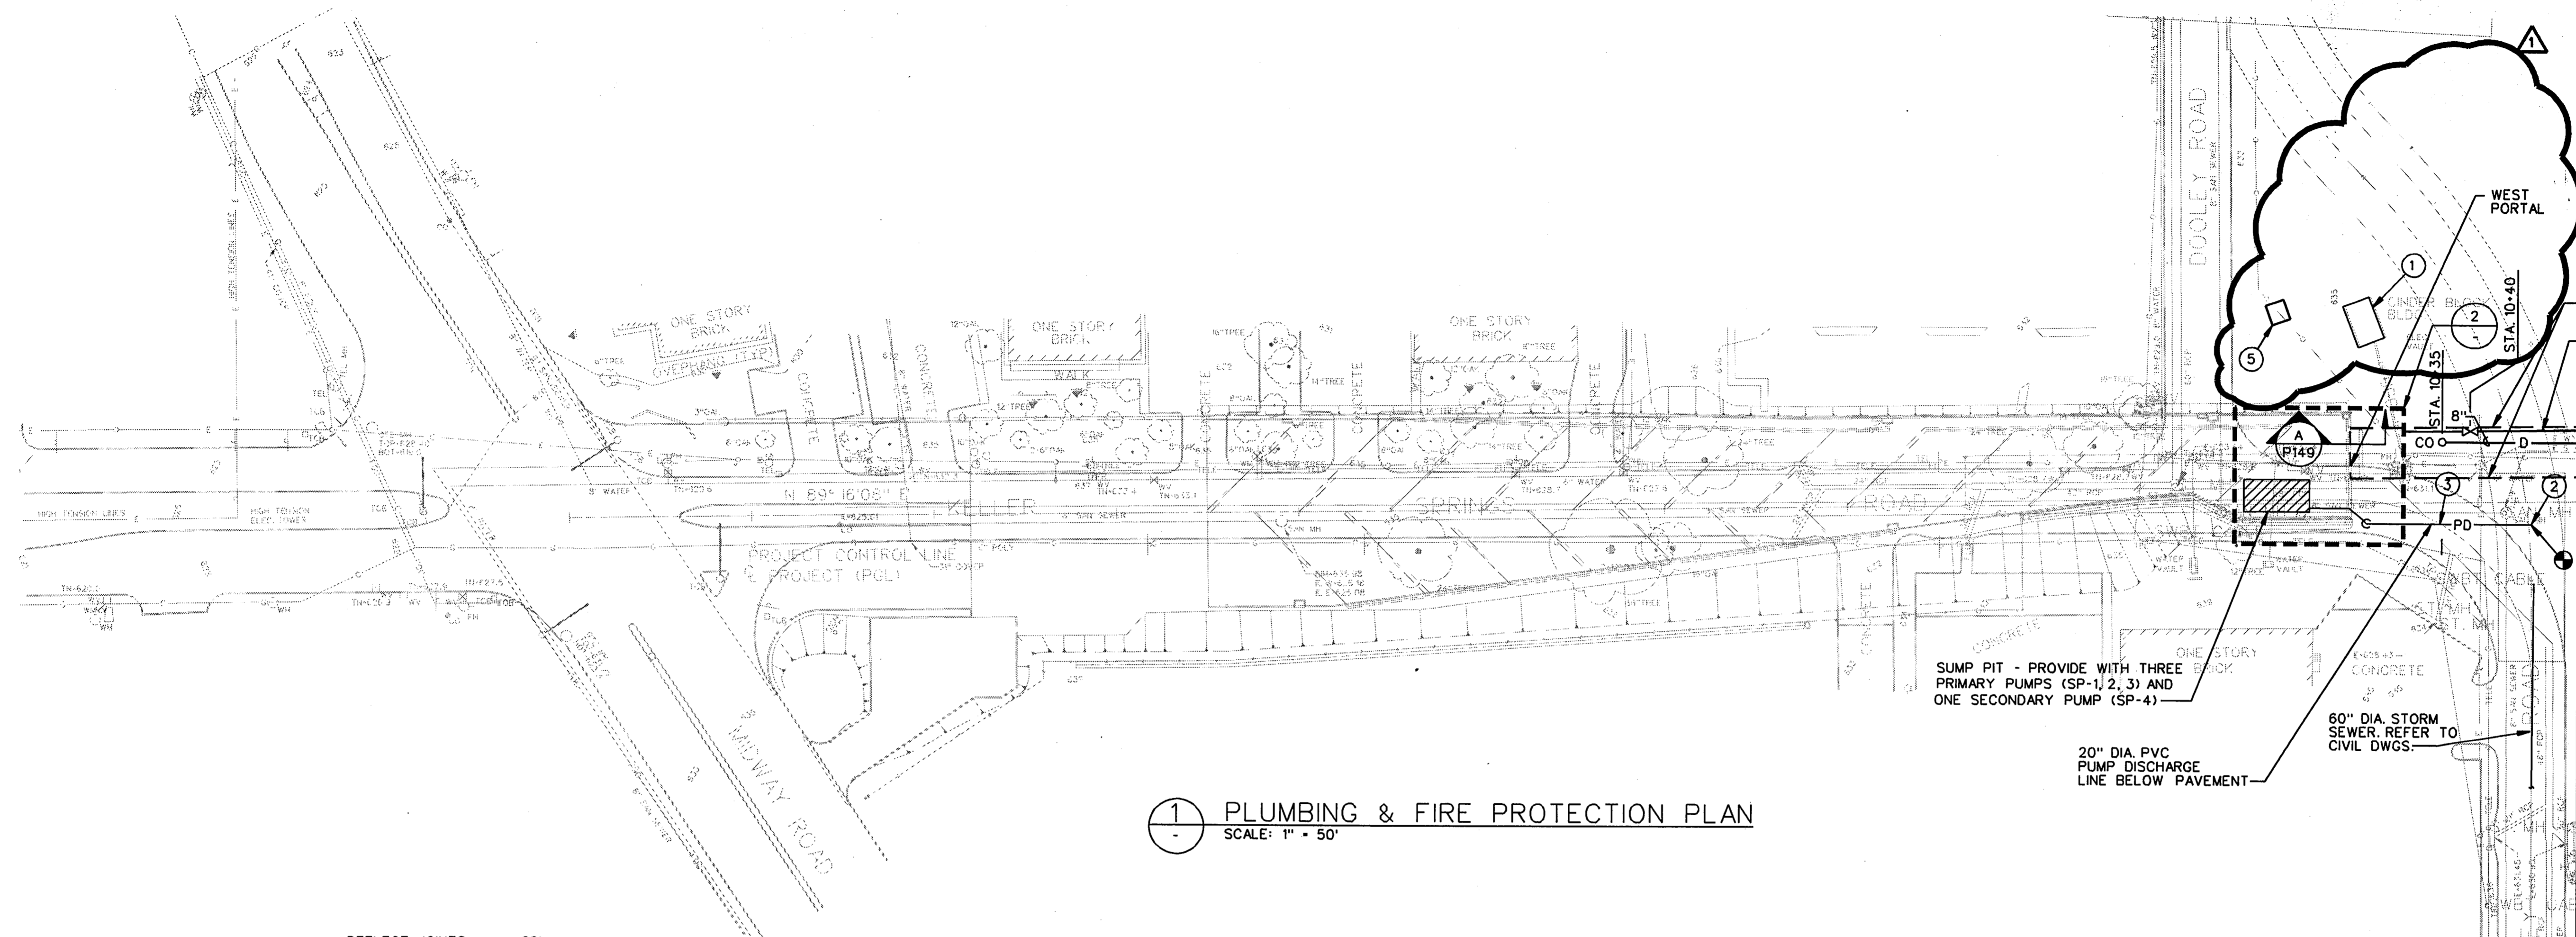

REFER TO RFI # 919  
TUNNEL MAIN 8" UNDERDRAIN PERFORATIONS

1 PLUMBING & FIRE PROTECTION PLAN  
SCALE: 1" = 50'

- KEY NOTES:
- 1 EXISTING ELECTRICAL VAULT TO REMAIN.
  - 2 CONNECT 20" PD TO 60"x2" WYE FITTING REFER TO SHEET C40. SEAL CONNECTION WATERTIGHT. I.E. = 627.44'. APPROXIMATE GROUND ELEVATION = 836'. COORDINATE LOCATION OF 20" PD WITH ALL NEW AND EXISTING UTILITIES IN THE AREA PRIOR TO CONSTRUCTION.
  - 3 INCLUDE A #12 COPPER WIRE ALONG ENTIRE LENGTH OF PVC PIPE APPROX. 12" ABOVE TOP OF PIPE AS A LOCATOR.
  - 4 NOT USED.
  - 5 TRANSFORMER BY ELECTRICAL CONTRACTOR.
  - 6 IMBED CONTROL CONDUIT IN CONCRETE ADJACENT TO POWER CONDUITS. REF: SHEET E164 FOR POWER CONDUITS.

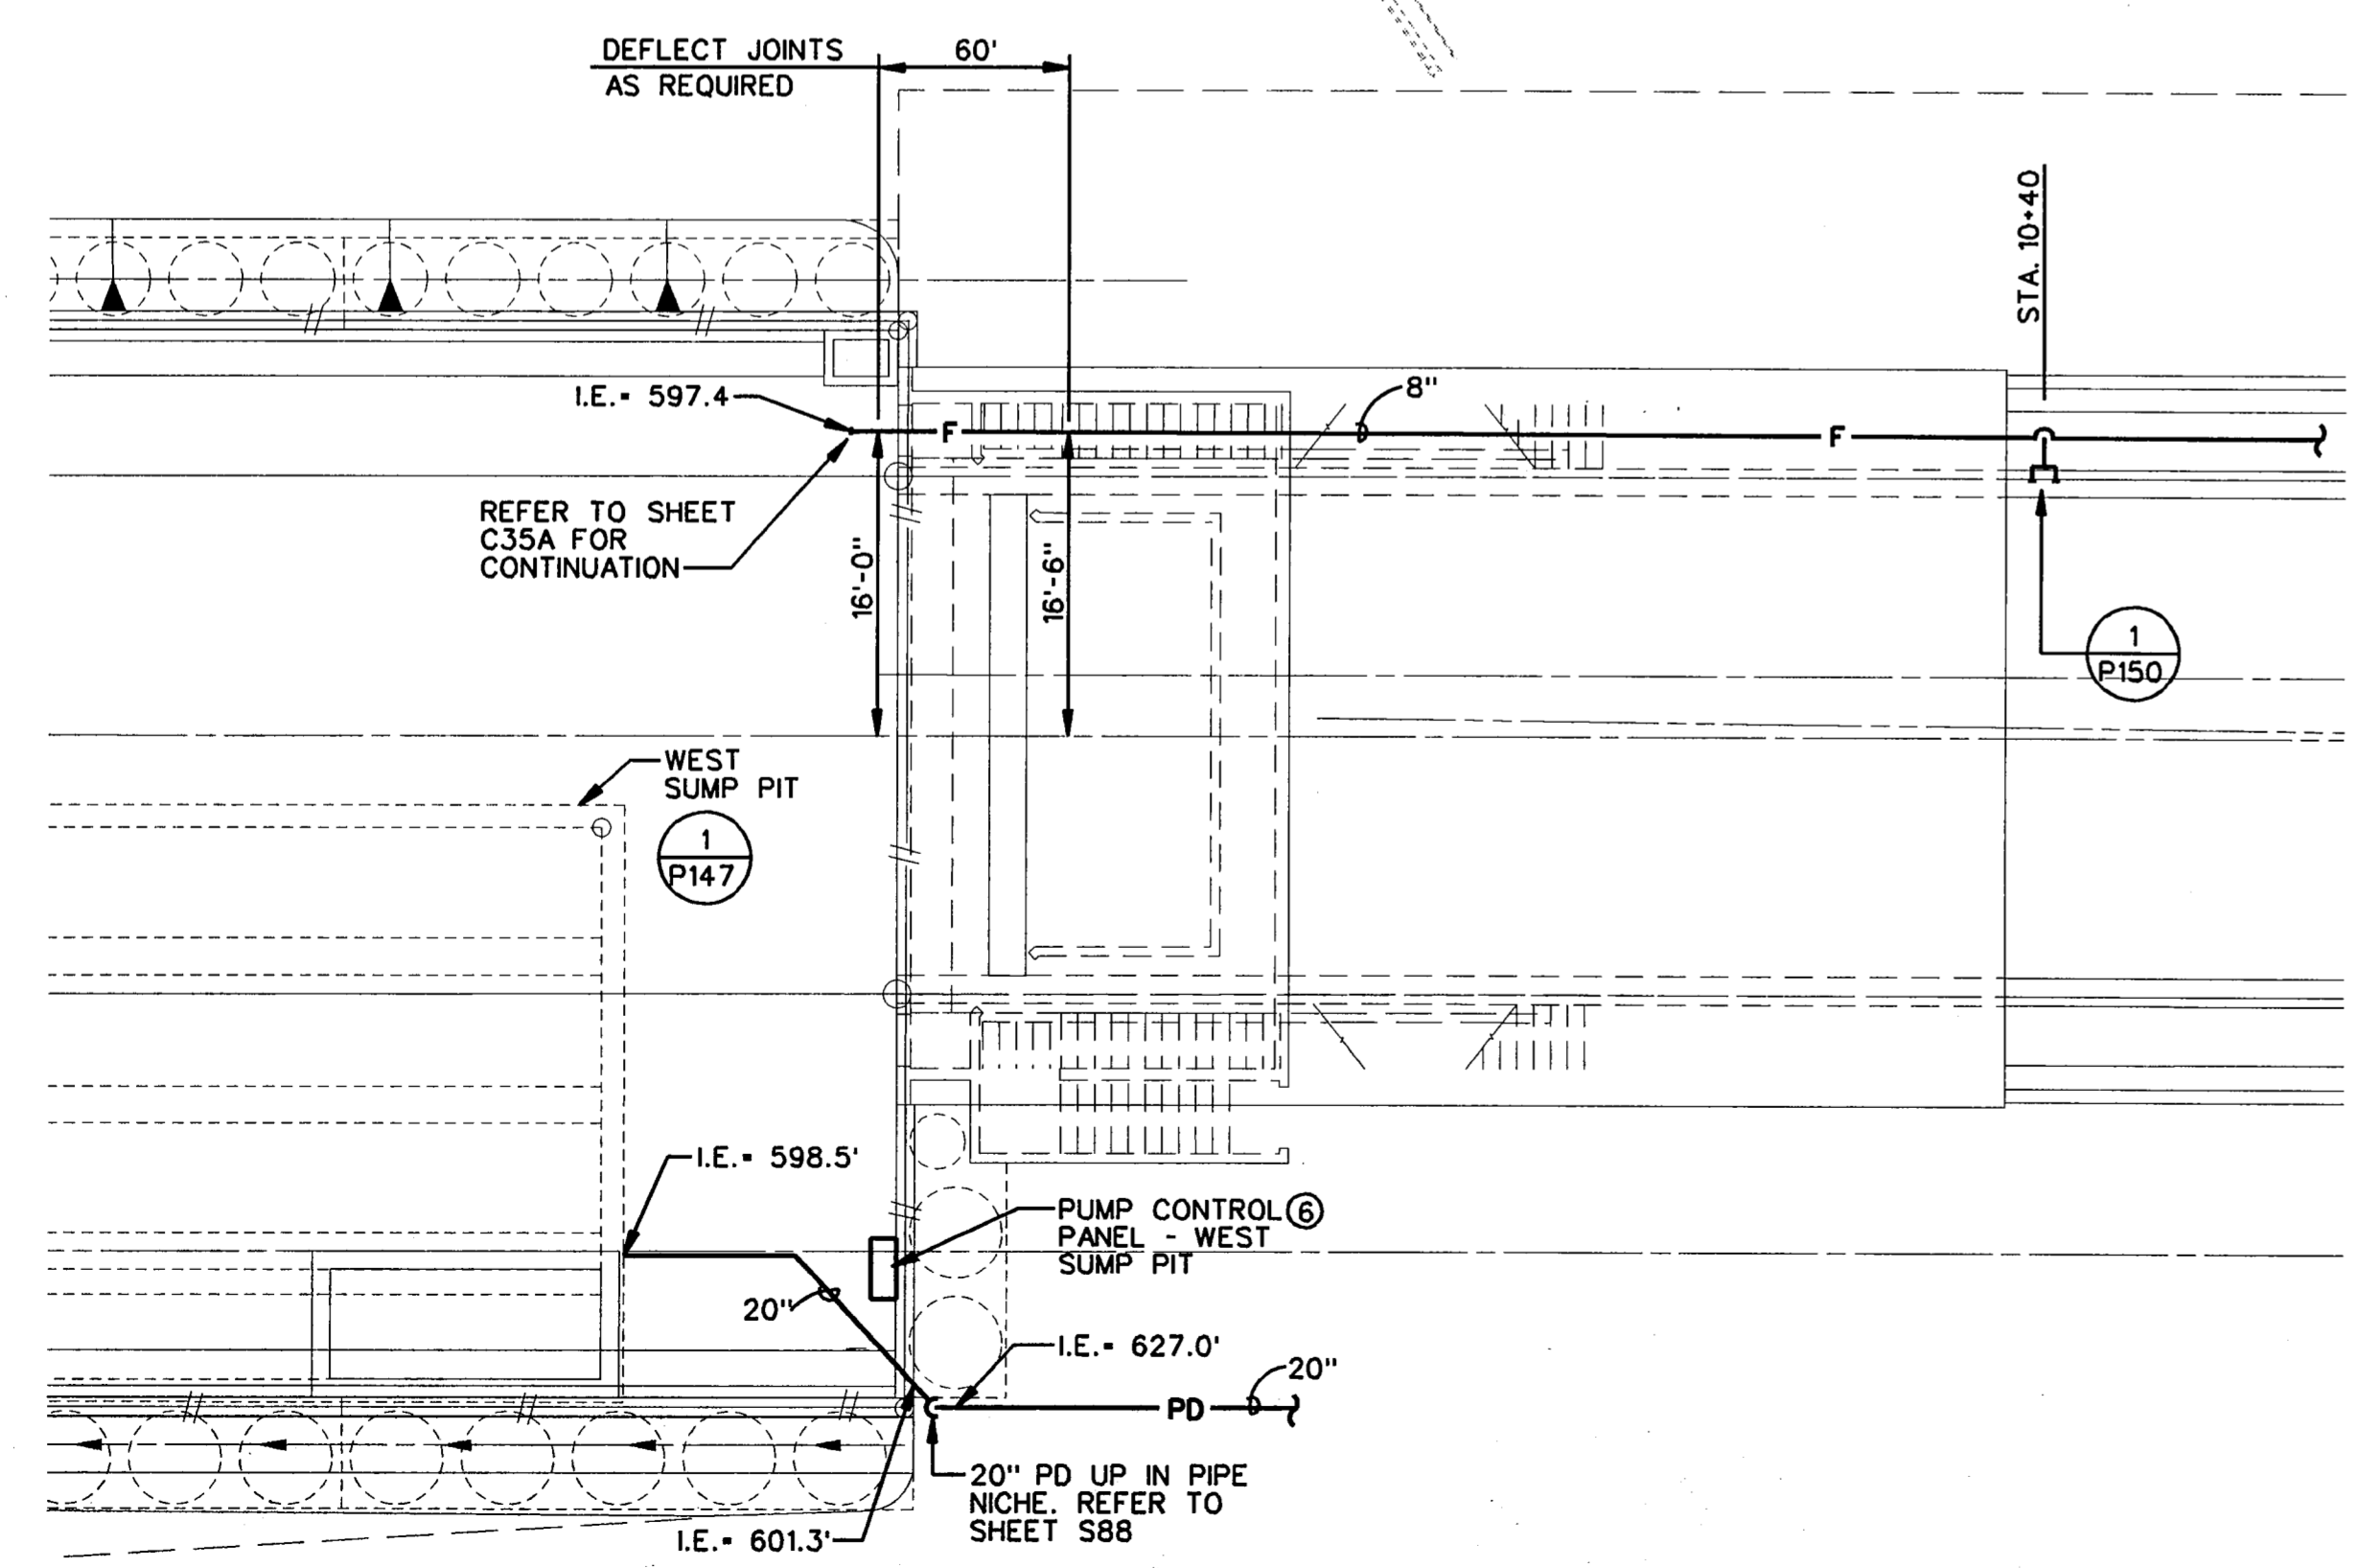

2 ENLARGED PLAN AT WEST PORTAL  
SCALE: 1" = 10'

FINAL RECORD  
DRAWING  
Date: 12/25/99




THE SEAL APPEARING ON THIS DOCUMENT WAS AUTHORIZED BY MIKE L. ASHCRAFT, P.E., 56590 ON SEPTEMBER 9, 1996

2 REVISION PER RFI # 919

No.	REVISION	BY	DATE
ADDENDUM No.1 HDR 2-12-97 <b>TEXAS TURNPIKE AUTHORITY</b> <b>ADDISON AIRPORT TUNNEL</b>  <b>TUNNEL</b> <b>FIRE PROTECTION &amp; PLUMBING PLANS</b>			
<b>HDR</b> HDR Engineering, Inc.			SECTION <b>XIII</b>
DRAWN: WTD	DATE: 12/05/96	DESIGNED: M.L.A.	DATE: 08/28/96
CHECKED: BL	DATE: 08/28/96	SCALE: 1" = 50'	
CONTRACT No. DNT-260 SHEET <b>P144</b> OF 166			

FILE: p:\addtun\dgm\cdtup101.dgn  
 DATE: 23-Apr-96 20:01

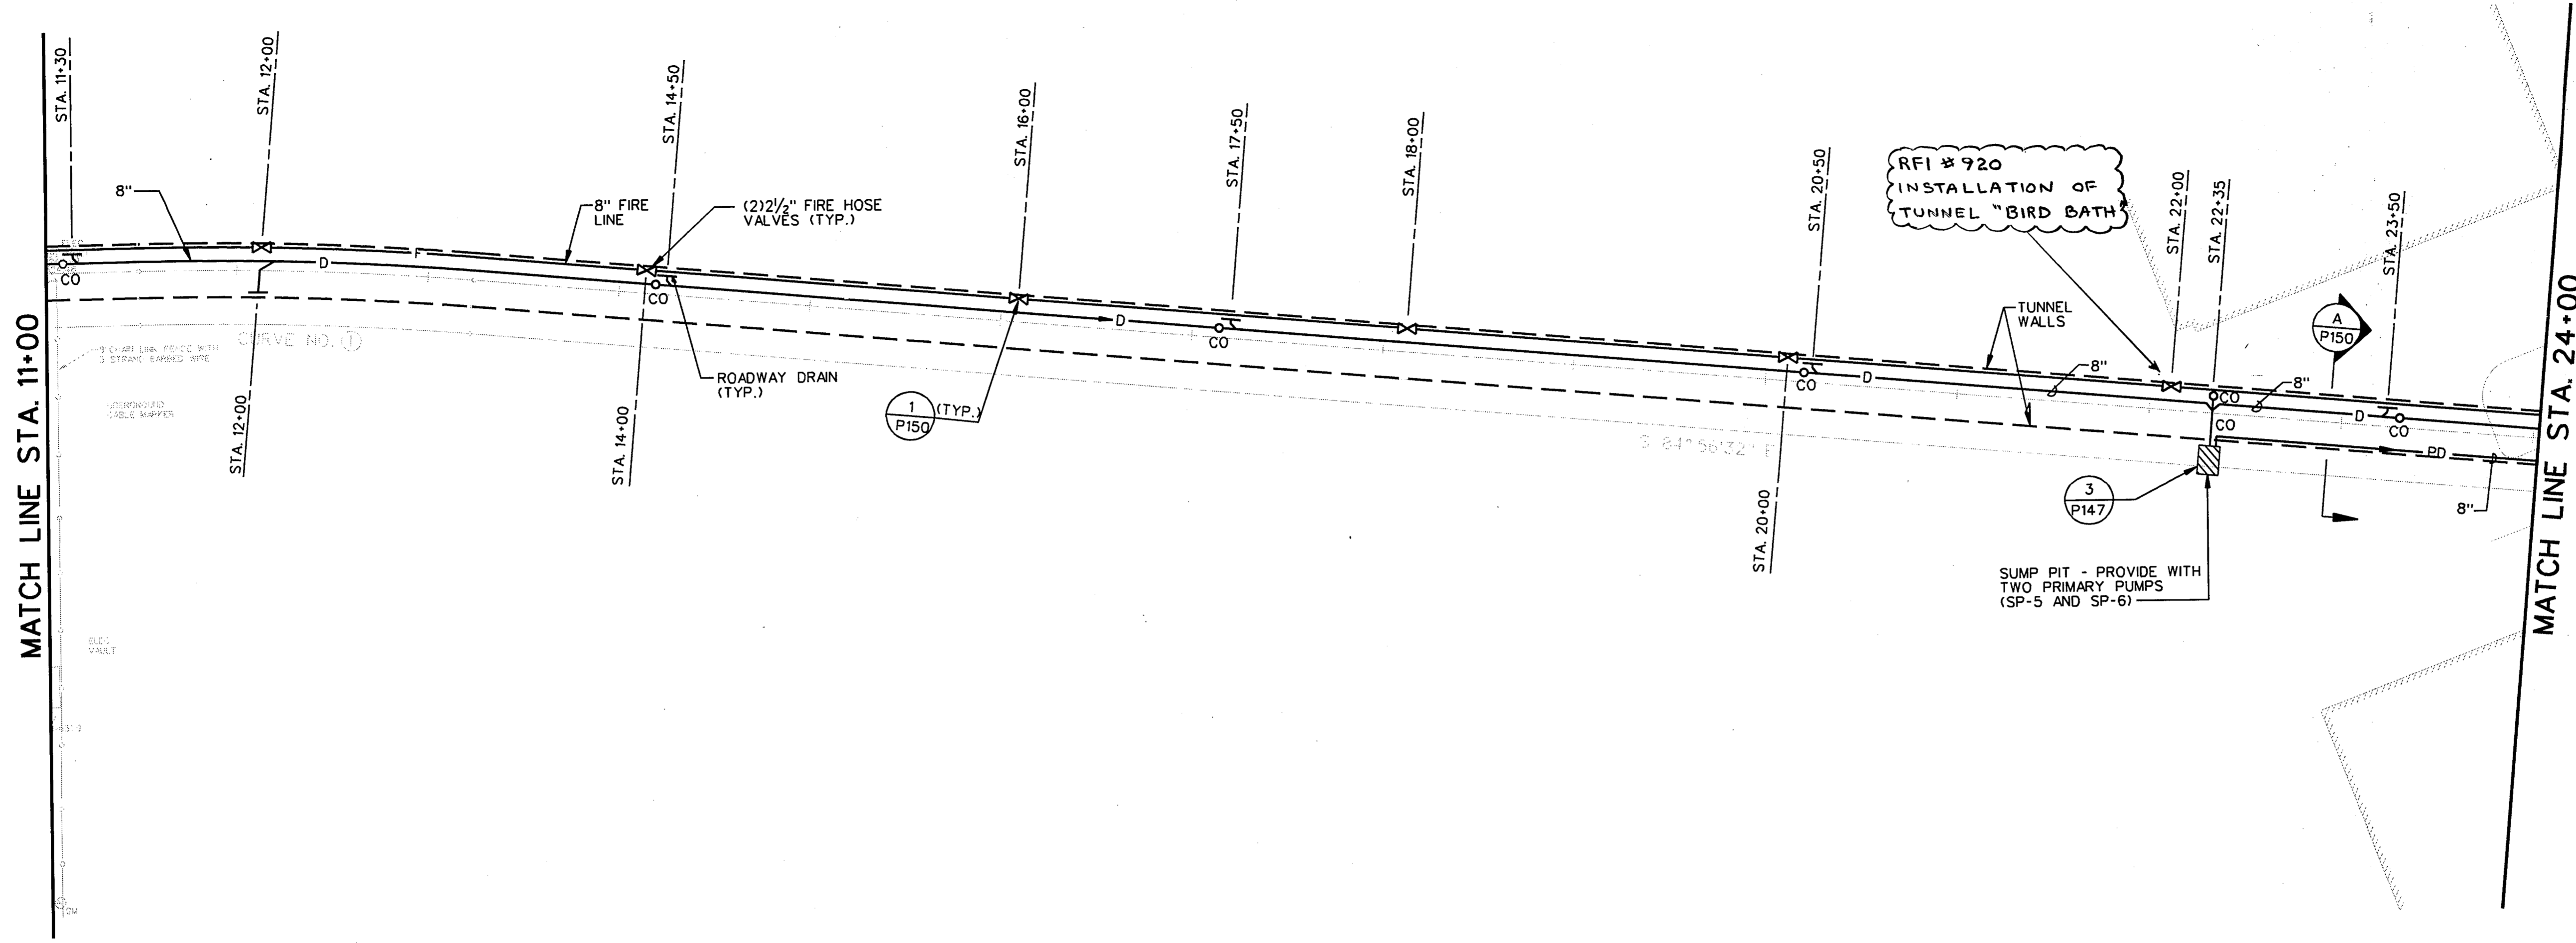

1 PLUMBING & FIRE PROTECTION PLAN  
SCALE: 1" = 50'





THE SEAL APPEARING ON THIS DOCUMENT WAS AUTHORIZED BY MIKE L. ASHCRAFT, P.E., 56590 ON SEPTEMBER 9, 1996

**FINAL RECORD DRAWING**  
Date: 12/25/99


REVISION PER RFI # 920

No.	REVISION	BY	DATE
TEXAS TURNPIKE AUTHORITY ADDISON AIRPORT TUNNEL			
TUNNEL FIRE PROTECTION & PLUMBING PLANS			
HDR Engineering, Inc.			SECTION XIII
DRAWN: WTD	DATE: 12/05/96	DESIGNED: MLA	DATE: 08/28/96
CHECKED: BL	DATE: 08/28/96	SCALE: 1" = 50'	
CONTRACT No. DNT-260 SHEET P145 OF 166			

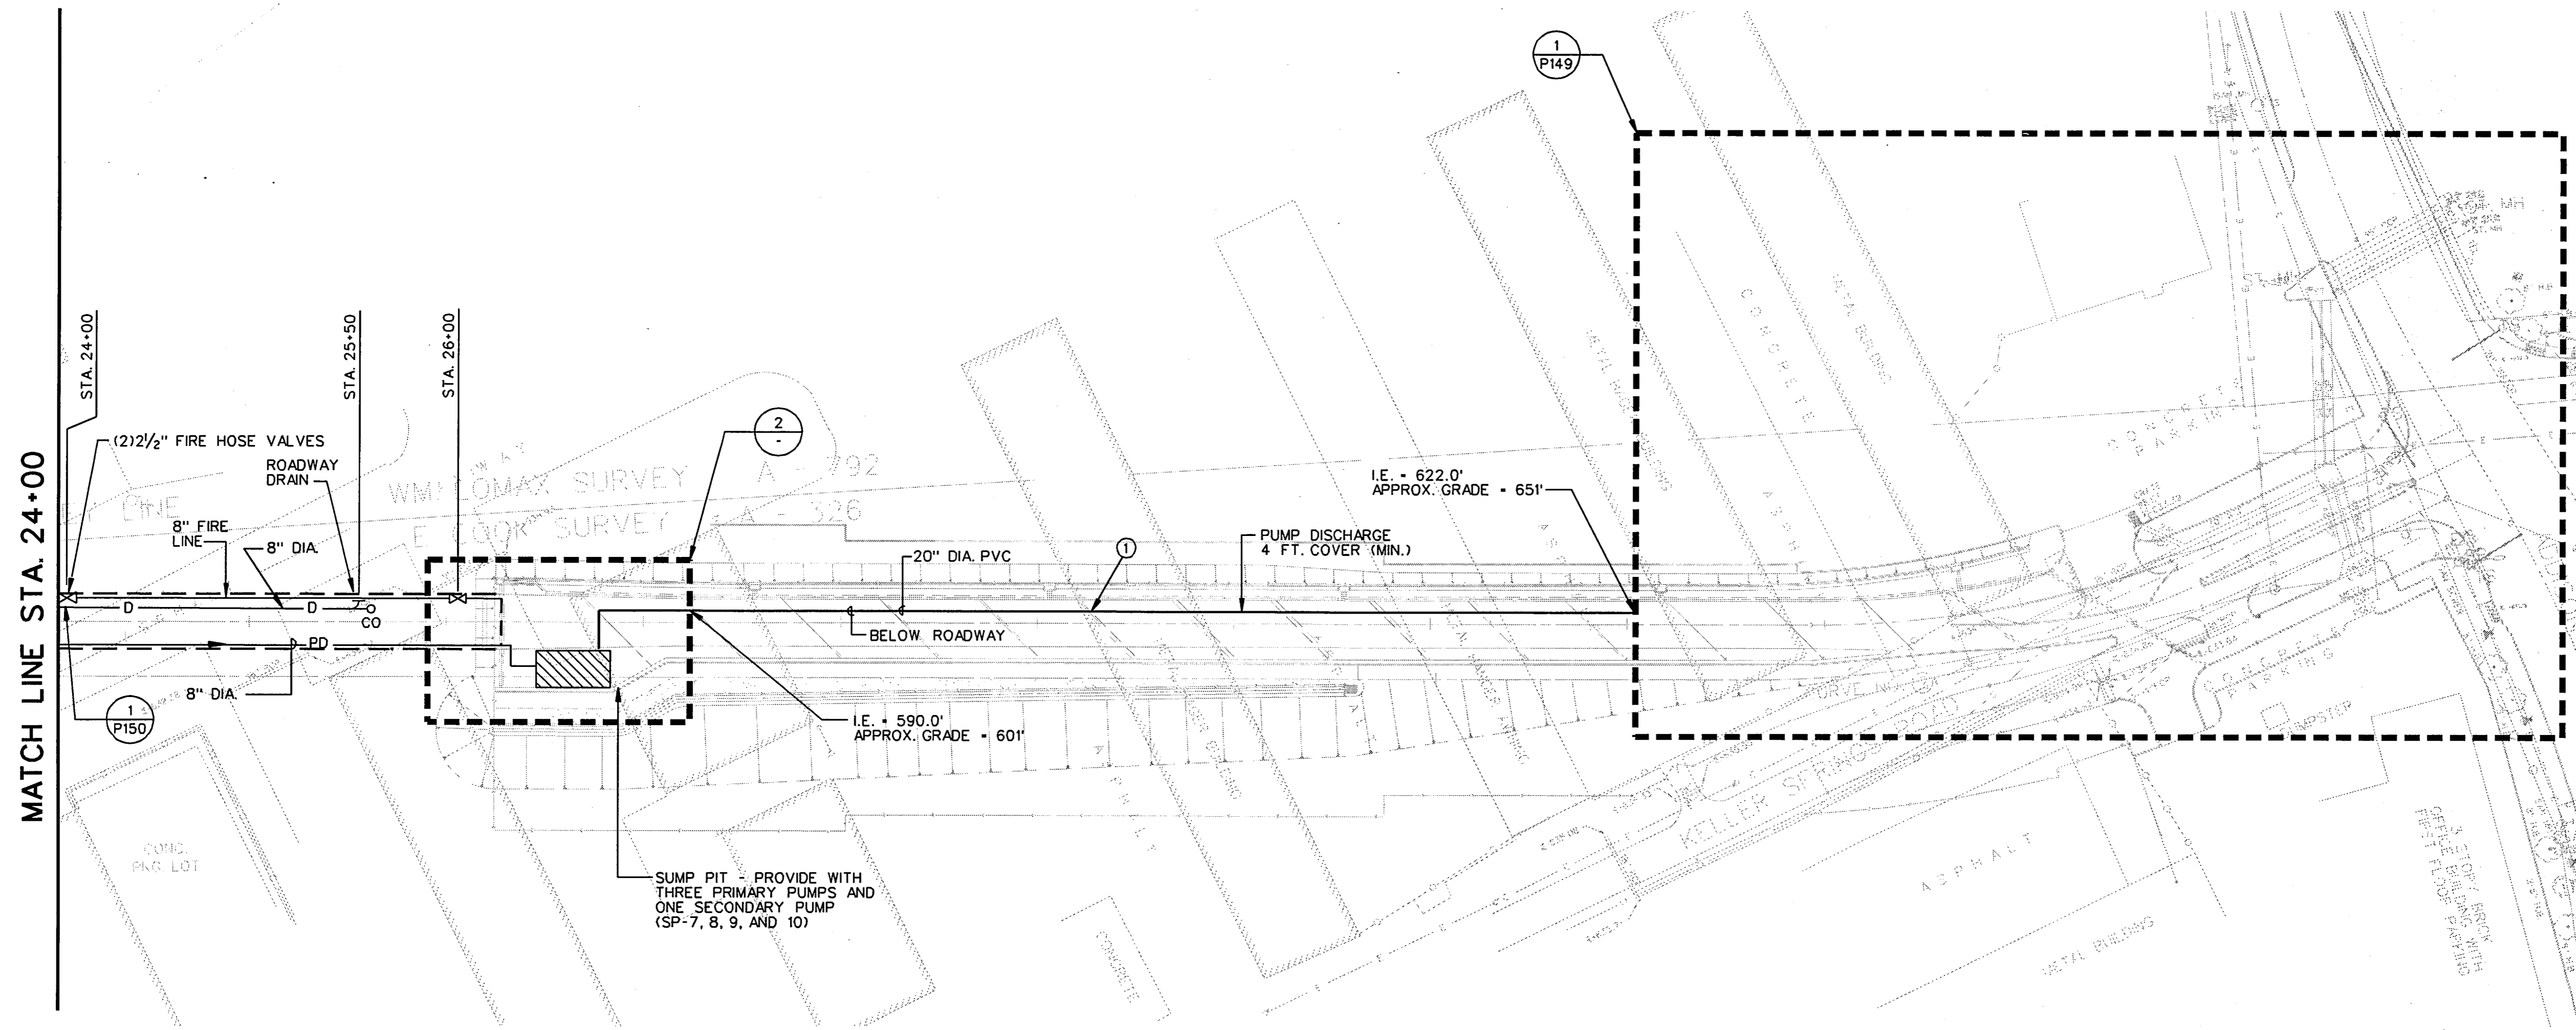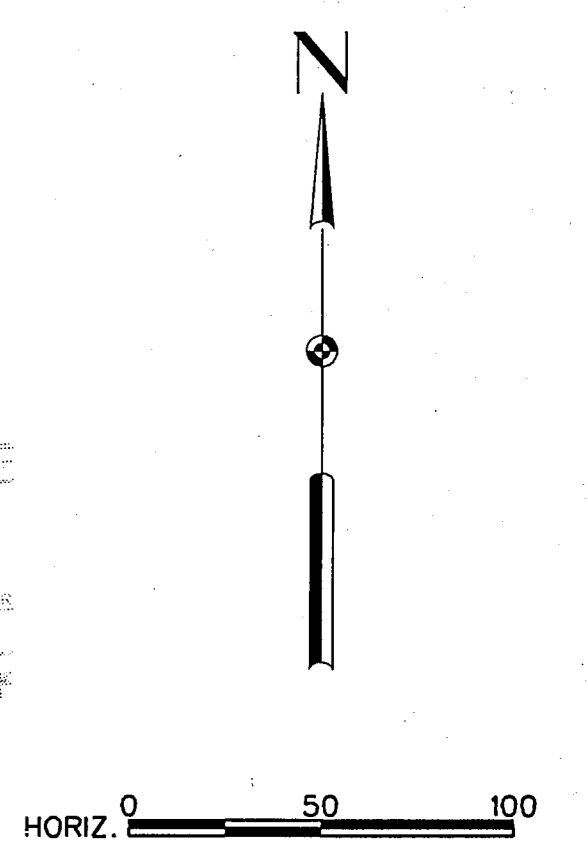

① PLUMBING & FIRE PROTECTION PLAN  
SCALE: 1" = 50'

- KEY NOTES:
- ① INCLUDE A #12 COPPER WIRE IN THE LENGTH OF TRENCH WITH THE PVC PIPE.
  - ② IMBED CONTROL CONDUIT IN CONCRETE ADJACENT TO POWER CONDUITS. REF: SHEET E164 FOR POWER CONDUITS.

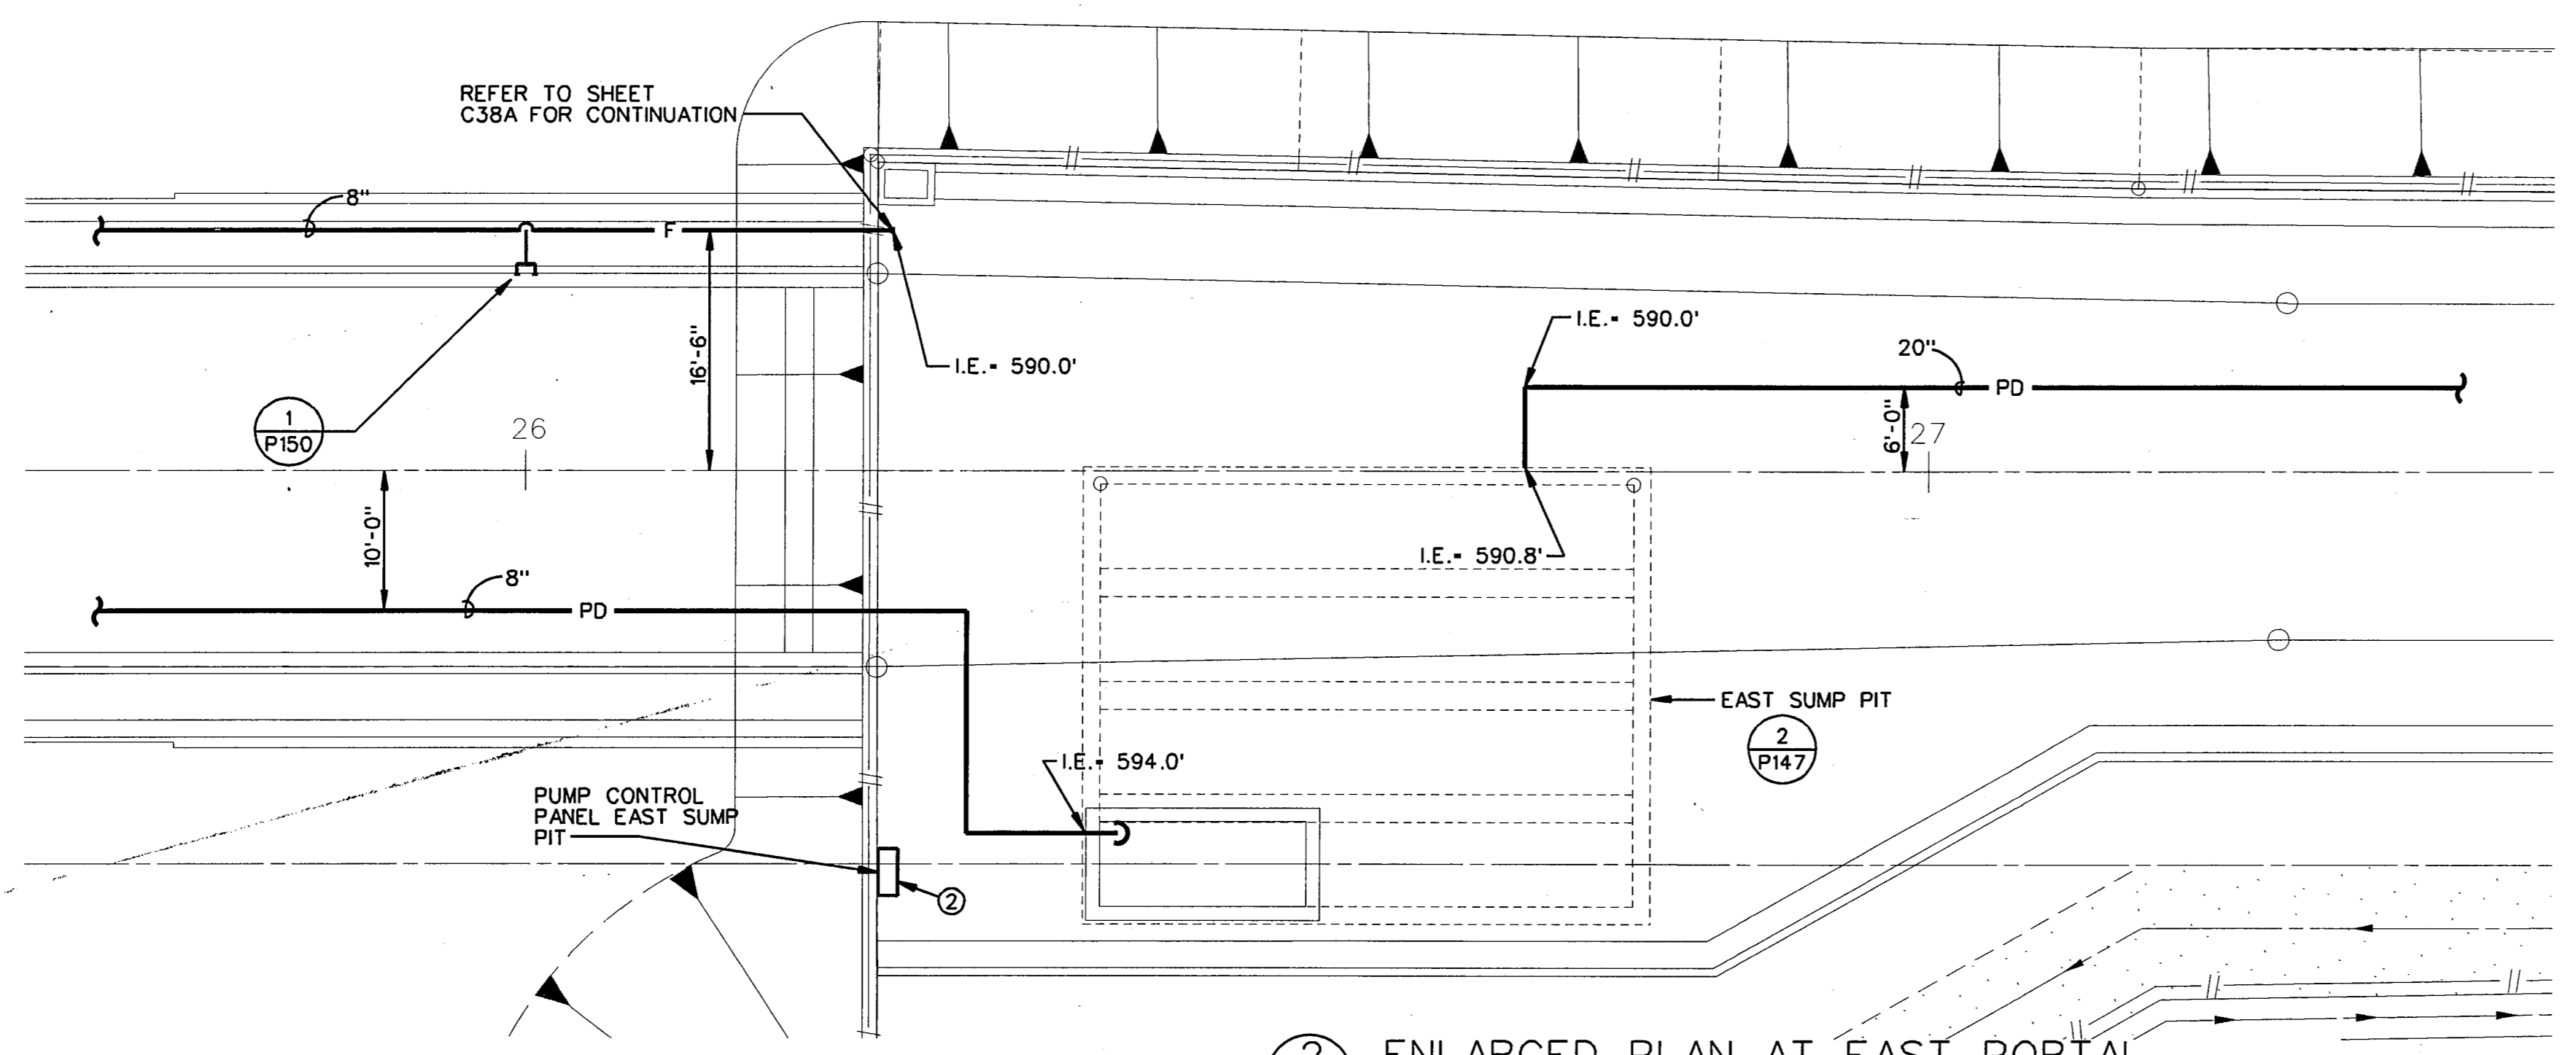

② ENLARGED PLAN AT EAST PORTAL  
SCALE: 1" = 10'

FINAL RECORD  
DRAWING  
Date: 12/25/99




THE SEAL APPEARING ON THIS DOCUMENT WAS AUTHORIZED BY MIKE L. ASHCRAFT, P.E., 56598 ON SEPTEMBER 9, 1996

No.	REVISION	BY	DATE
TEXAS TURNPIKE AUTHORITY ADDISON AIRPORT TUNNEL			
TUNNEL FIRE PROTECTION & PLUMBING PLAN			
HDR Engineering, Inc.			SECTION XIII
DRAWN: WTD	DATE: 12/05/96	DESIGNED: MLA	DATE: 08/28/96
CHECKED: BL	DATE: 08/28/96	SCALE: 1" = 50'	
CONTRACT No. DNT-260 SHEET P146 OF 166			


FILE: p:\additun\adn\adup103.dgn  
DATE: 23-Apr-96 20:01

**KEY NOTES:**

- ① LOCATE THE END PUMP TO MAINTAIN THE MANUFACTURER'S MINIMUM ACCEPTABLE DISTANCE FROM THE SIDE OF THE COLLECTION BOX. LOCATE OTHER PUMPS AT 30" (MAX.) ON-CENTER.
- ② LINK SEAL OR EQUAL.

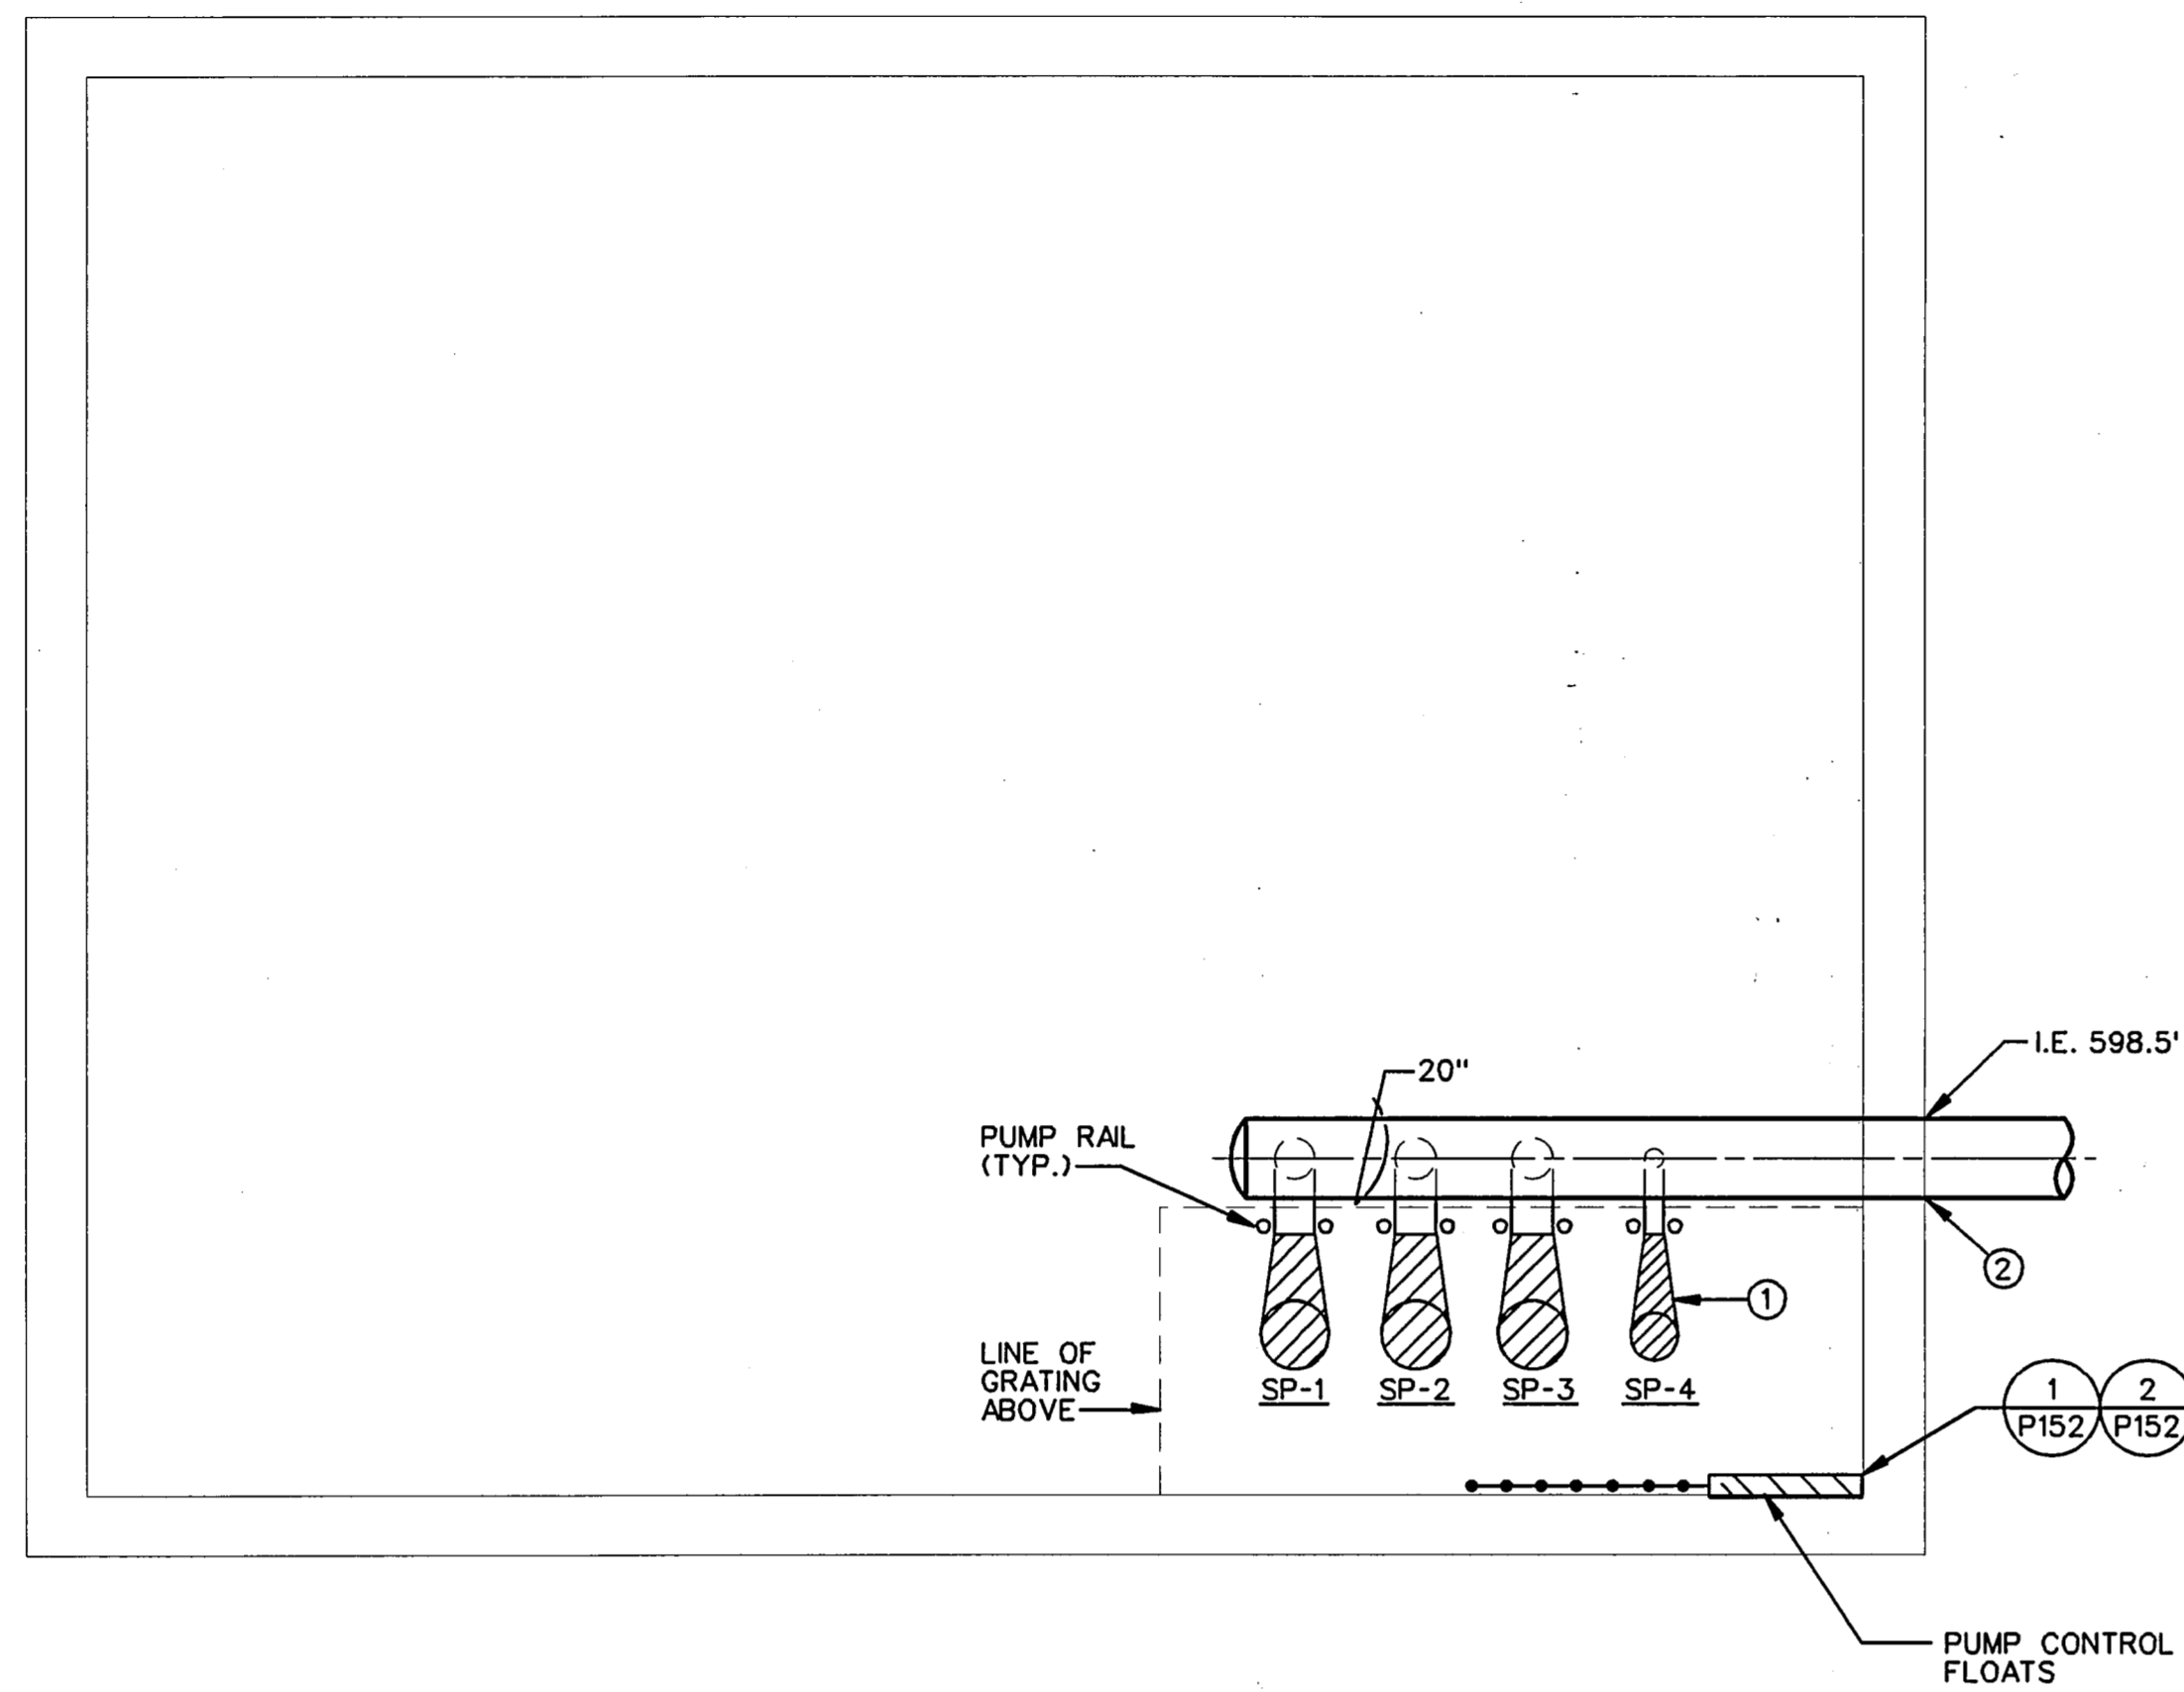


① ENLARGED WEST SUMP PIT - STA. 9+40  
 P144 SCALE: 1/4" = 1'-0"

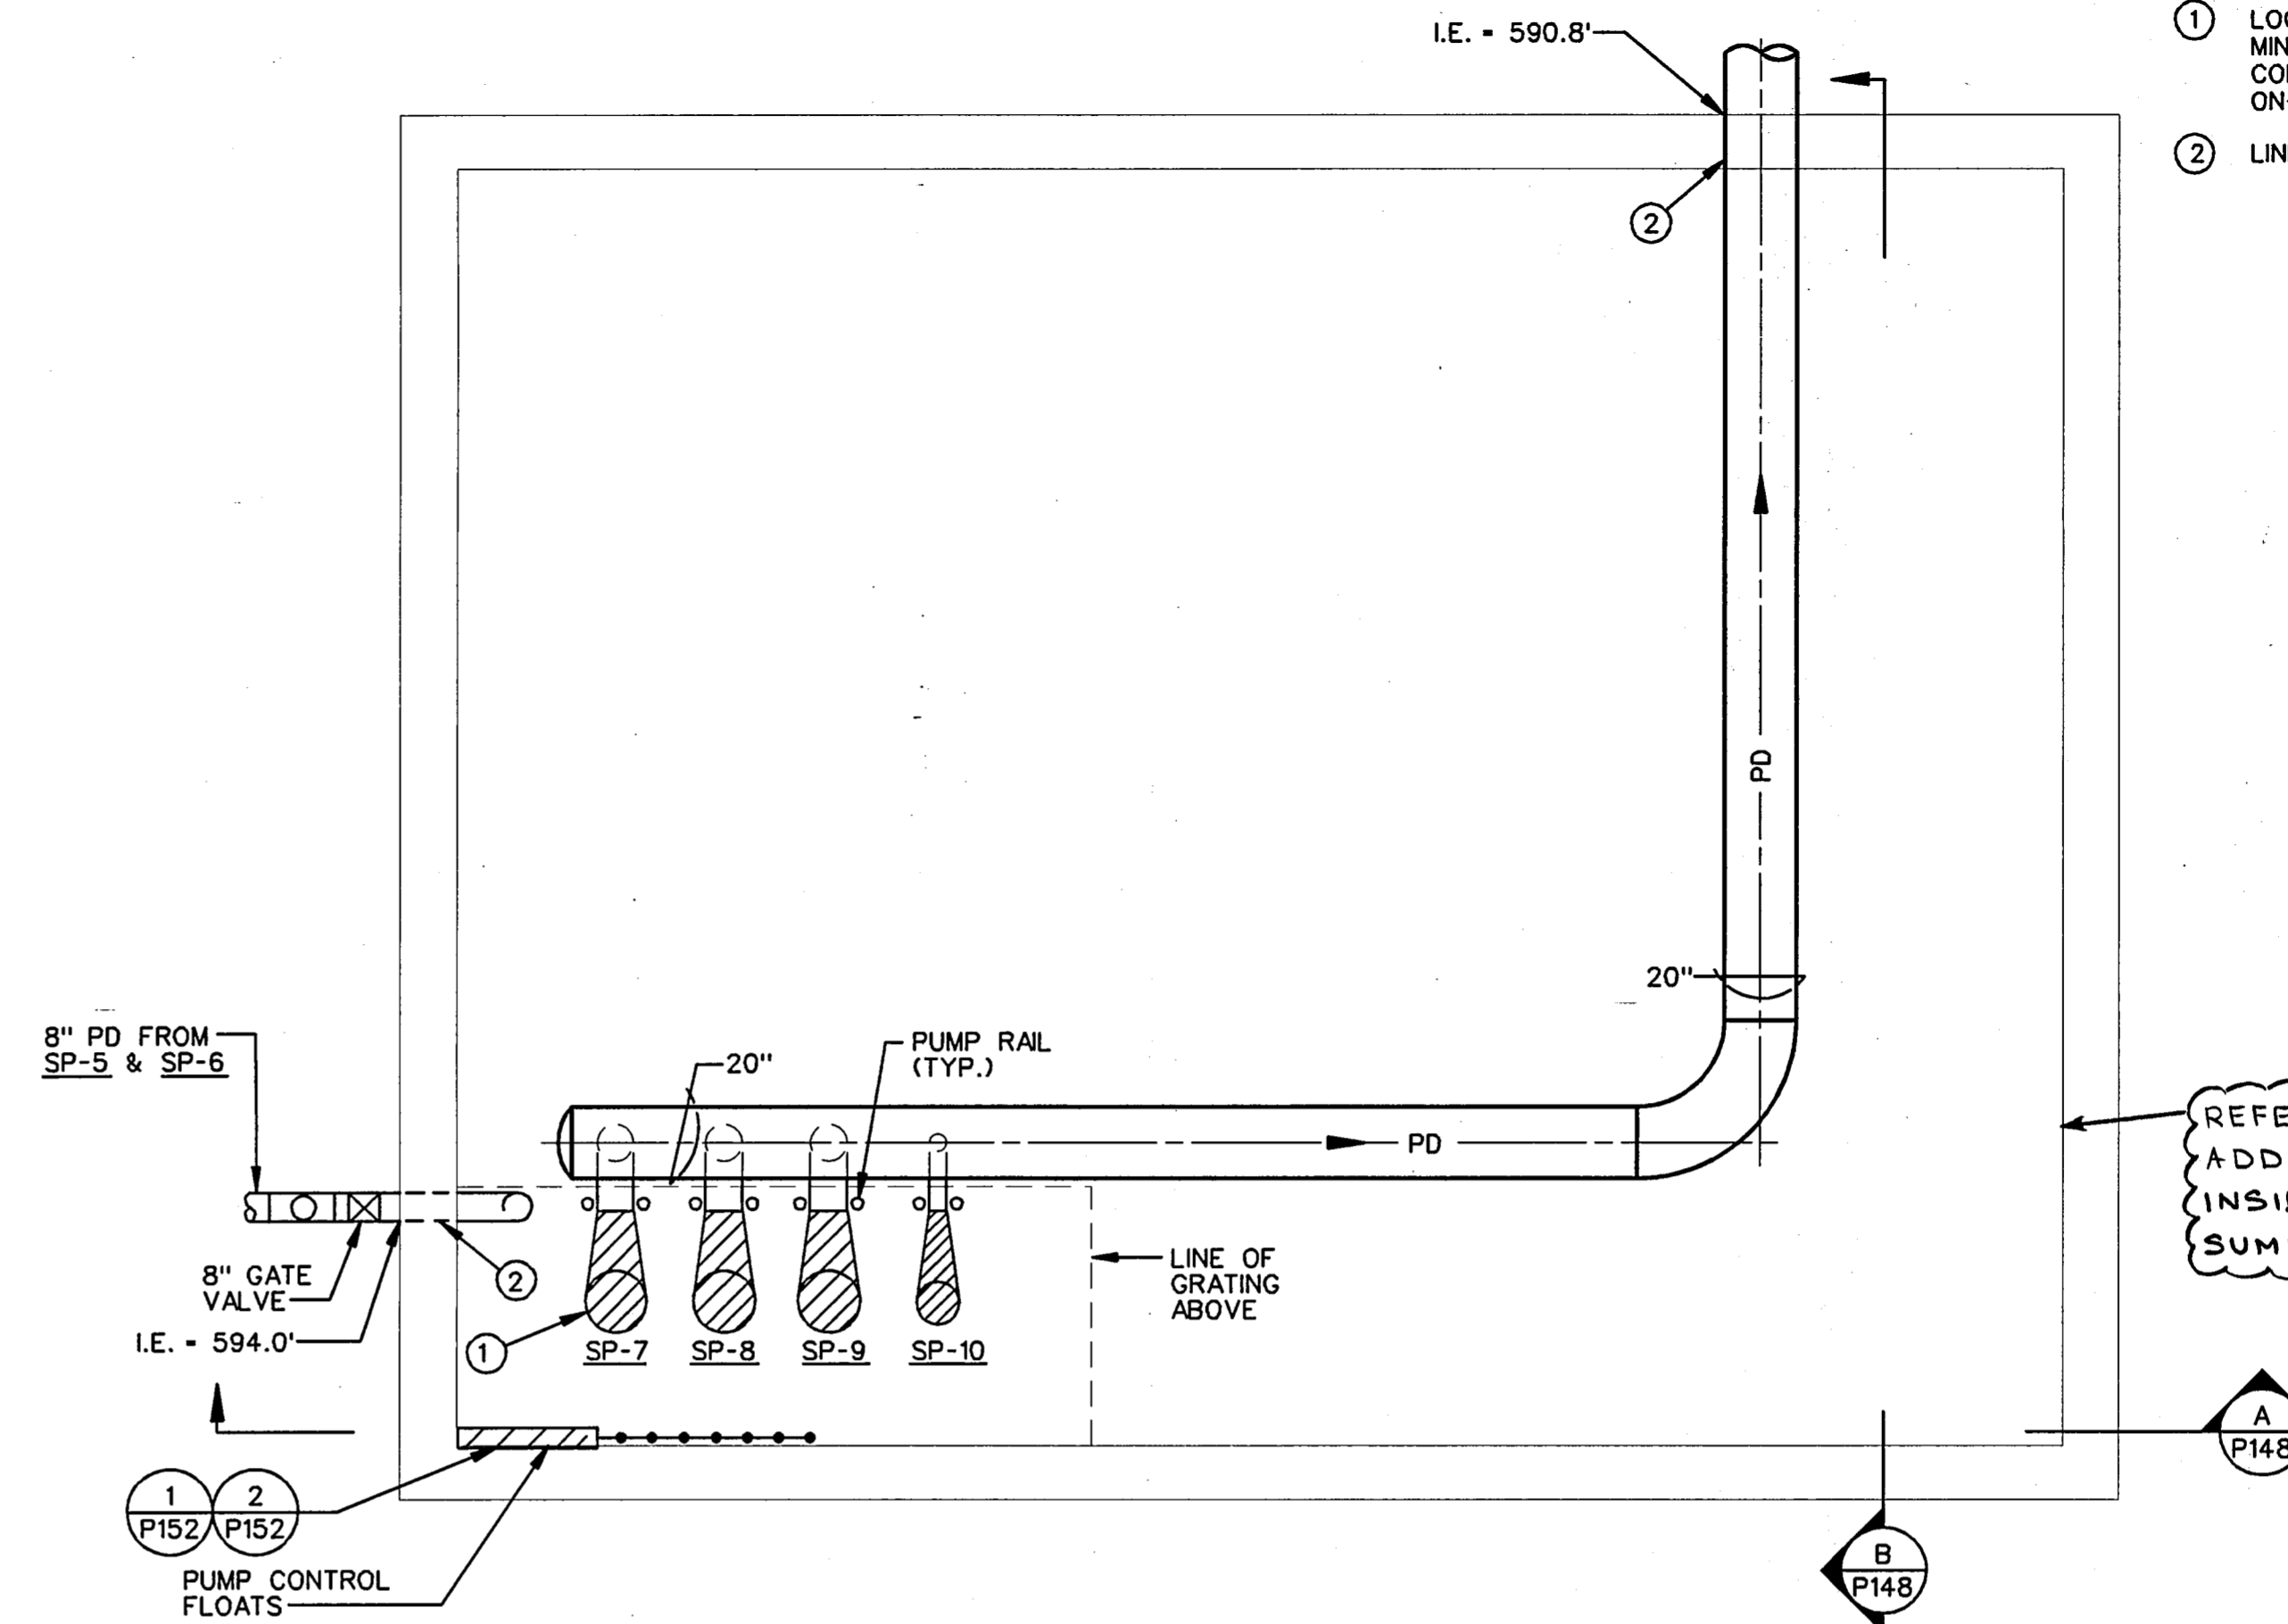

② ENLARGED EAST SUMP PIT - STA. 26+50  
 P146 SCALE: 1/4" = 1'-0"

REFER TO RFI # 196  
 ADDITIONAL BRACING  
 INSIDE PORTAL PUMP  
 SUMPS NOT REQUIRED

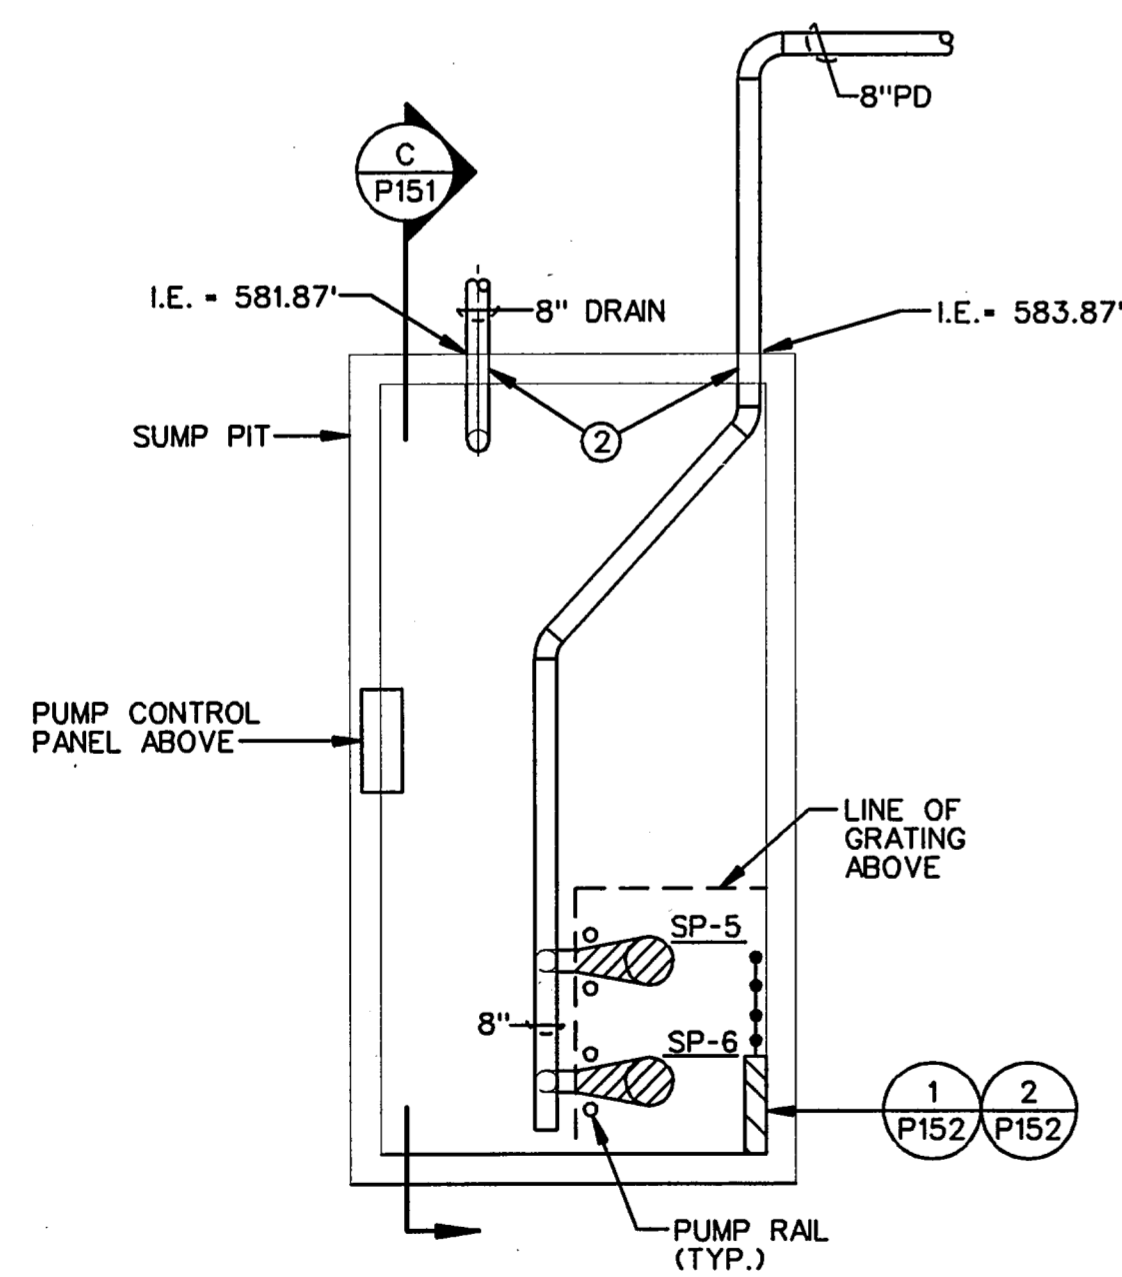

③ ENLARGED TUNNEL SUMP PIT NICHE  
 P145 SCALE: 1/4" = 1'-0"




THE SEAL APPEARING ON THIS DOCUMENT WAS AUTHORIZED BY MIKE L. ASHCRAFT, P.E., 56590 ON SEPTEMBER 9, 1996


**FINAL RECORD DRAWING**  
 Date: 12/25/99

1 REVISION PER RFI # 196

No.	REVISION	BY	DATE
TEXAS TURNPIKE AUTHORITY ADDISON AIRPORT TUNNEL			
ENLARGED SUMP PIT PLANS			
HDR Engineering, Inc.			SECTION XIII
DRAWN: WTD	DATE: 12/05/96	DESIGNED: M.L.A.	DATE: 08/28/96
CHECKED: KG	DATE: 08/28/96	SCALE: AS SHOWN	
CONTRACT No. DNT-260 SHEET P147 OF 166			

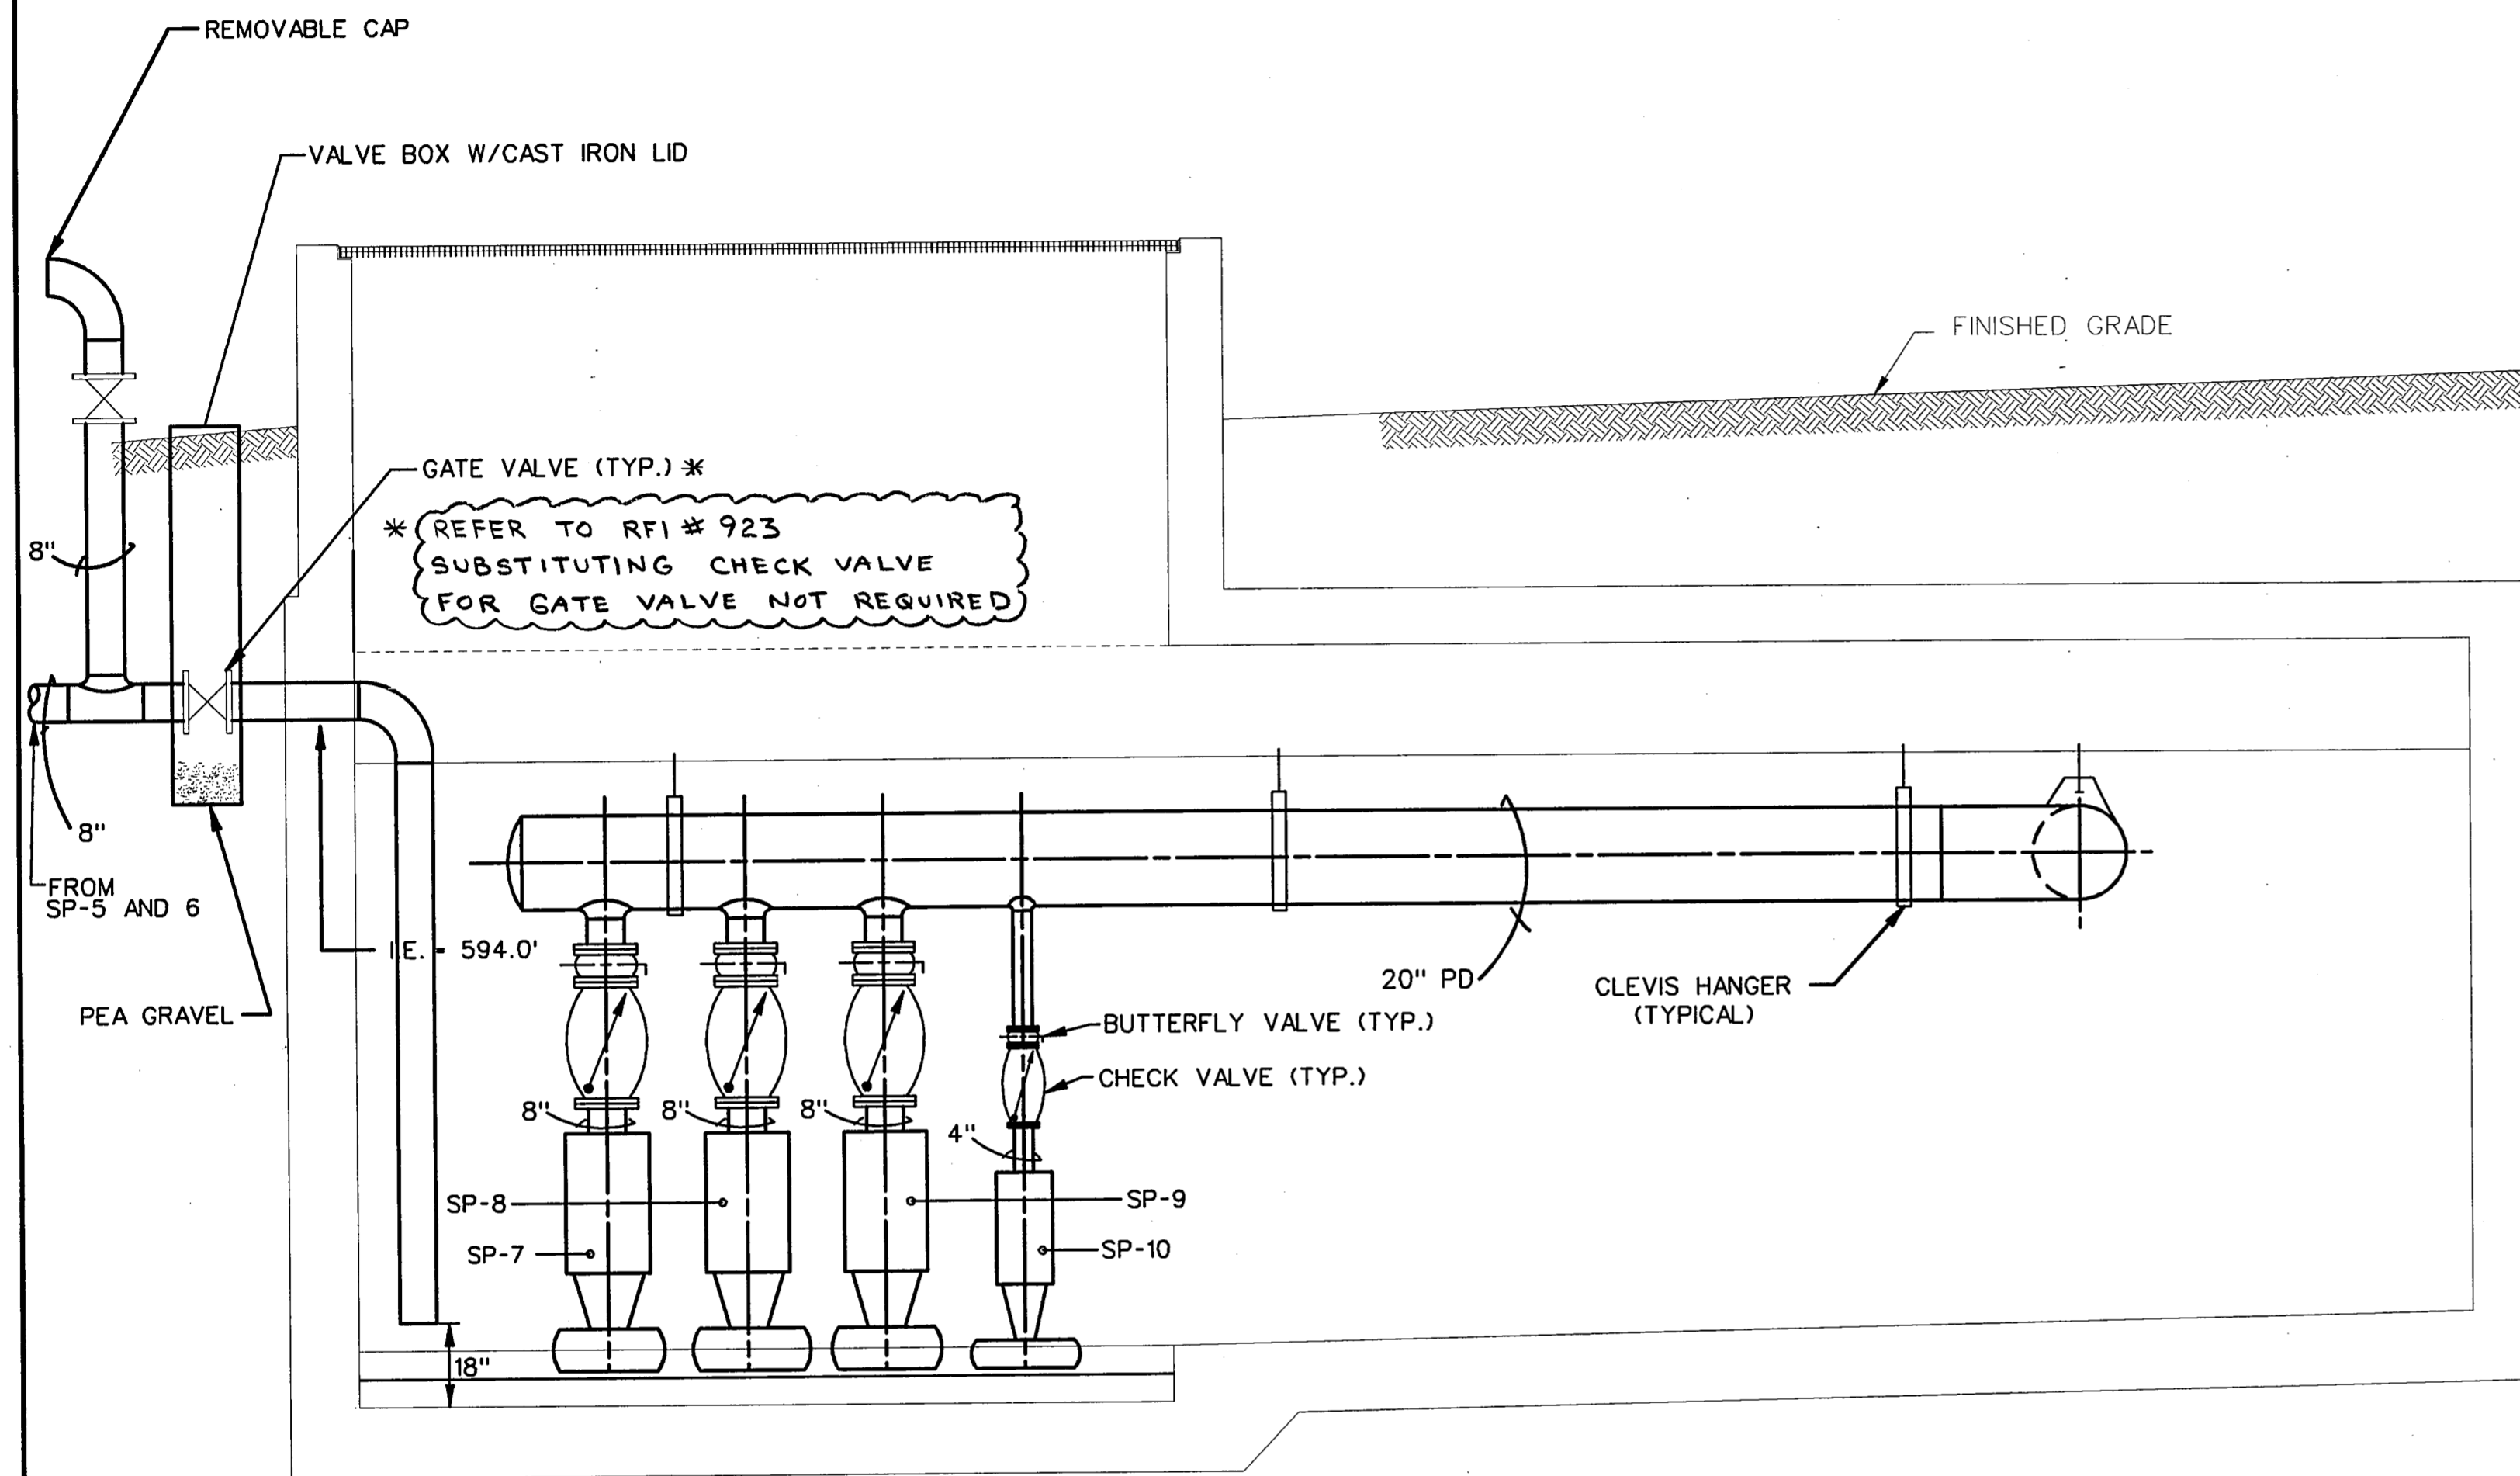

**A** SECTION AT EAST SUMP PIT (WEST SIMILAR)  
P148 SCALE: 3/8" = 1'-0"

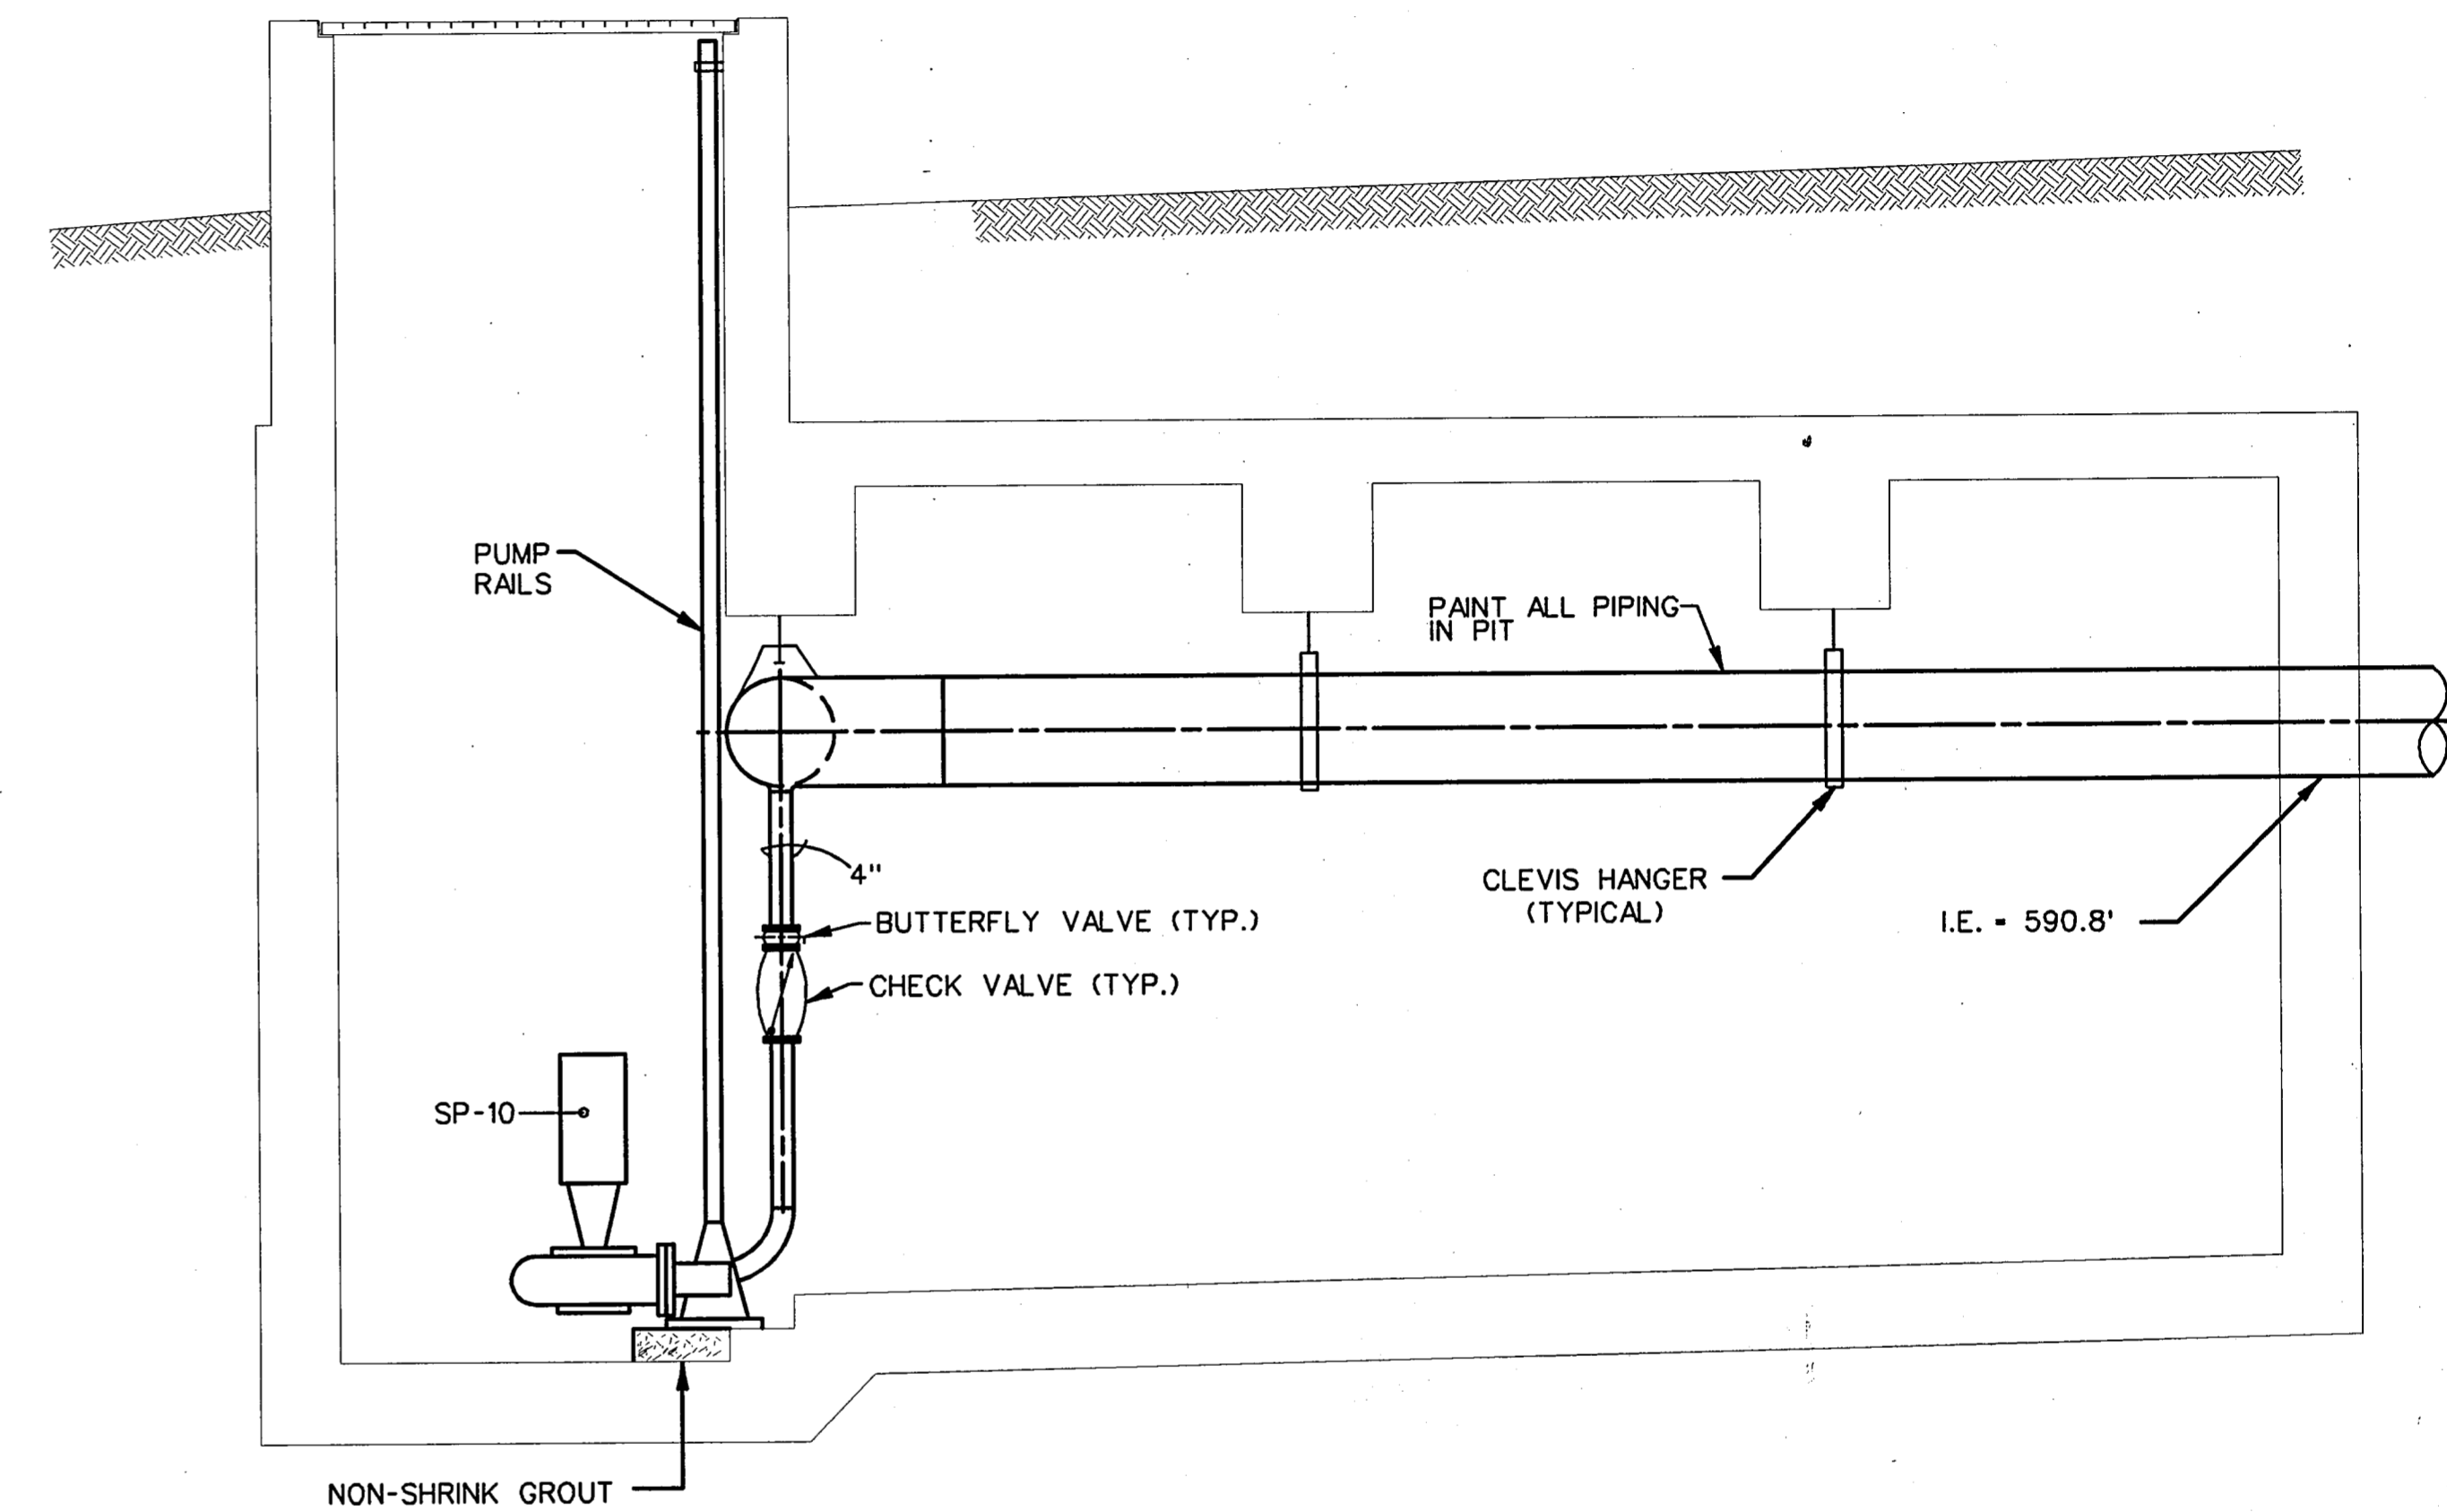

**B** SECTION AT EAST SUMP PIT (WEST SIMILAR)  
P148 SCALE: 3/8" = 1'-0"

FILE: p:\addttun\dgn\cdtupl05.dgn  
DATE: 3-Jul-96 14:49

**FINAL RECORD  
DRAWING**  
Date: 12/25/99




THE SEAL APPEARING ON THIS  
DOCUMENT WAS AUTHORIZED BY  
MIKE L. ASHCRAFT, P.E., 56590  
ON SEPTEMBER 9, 1996

1 REVISION PER RFI # 923

No.	REVISION	BY	DATE
TEXAS TURNPIKE AUTHORITY ADDISON AIRPORT TUNNEL			
ENLARGED SUMP PIT PLANS			
<b>HDR</b> HDR Engineering, Inc.			SECTION XIII
DRAWN: WTD	DATE: 12/05/96	DESIGNED: M.L.A.	DATE: 08/28/96
CHECKED: KG	DATE: 08/28/96	SCALE: AS SHOWN	
CONTRACT No. DNT-260 SHEET P148 OF 166			

FILE: p:\oddtun\oddtun\dtdup106.dgn  
DATE: 23-Apr-96 20:01

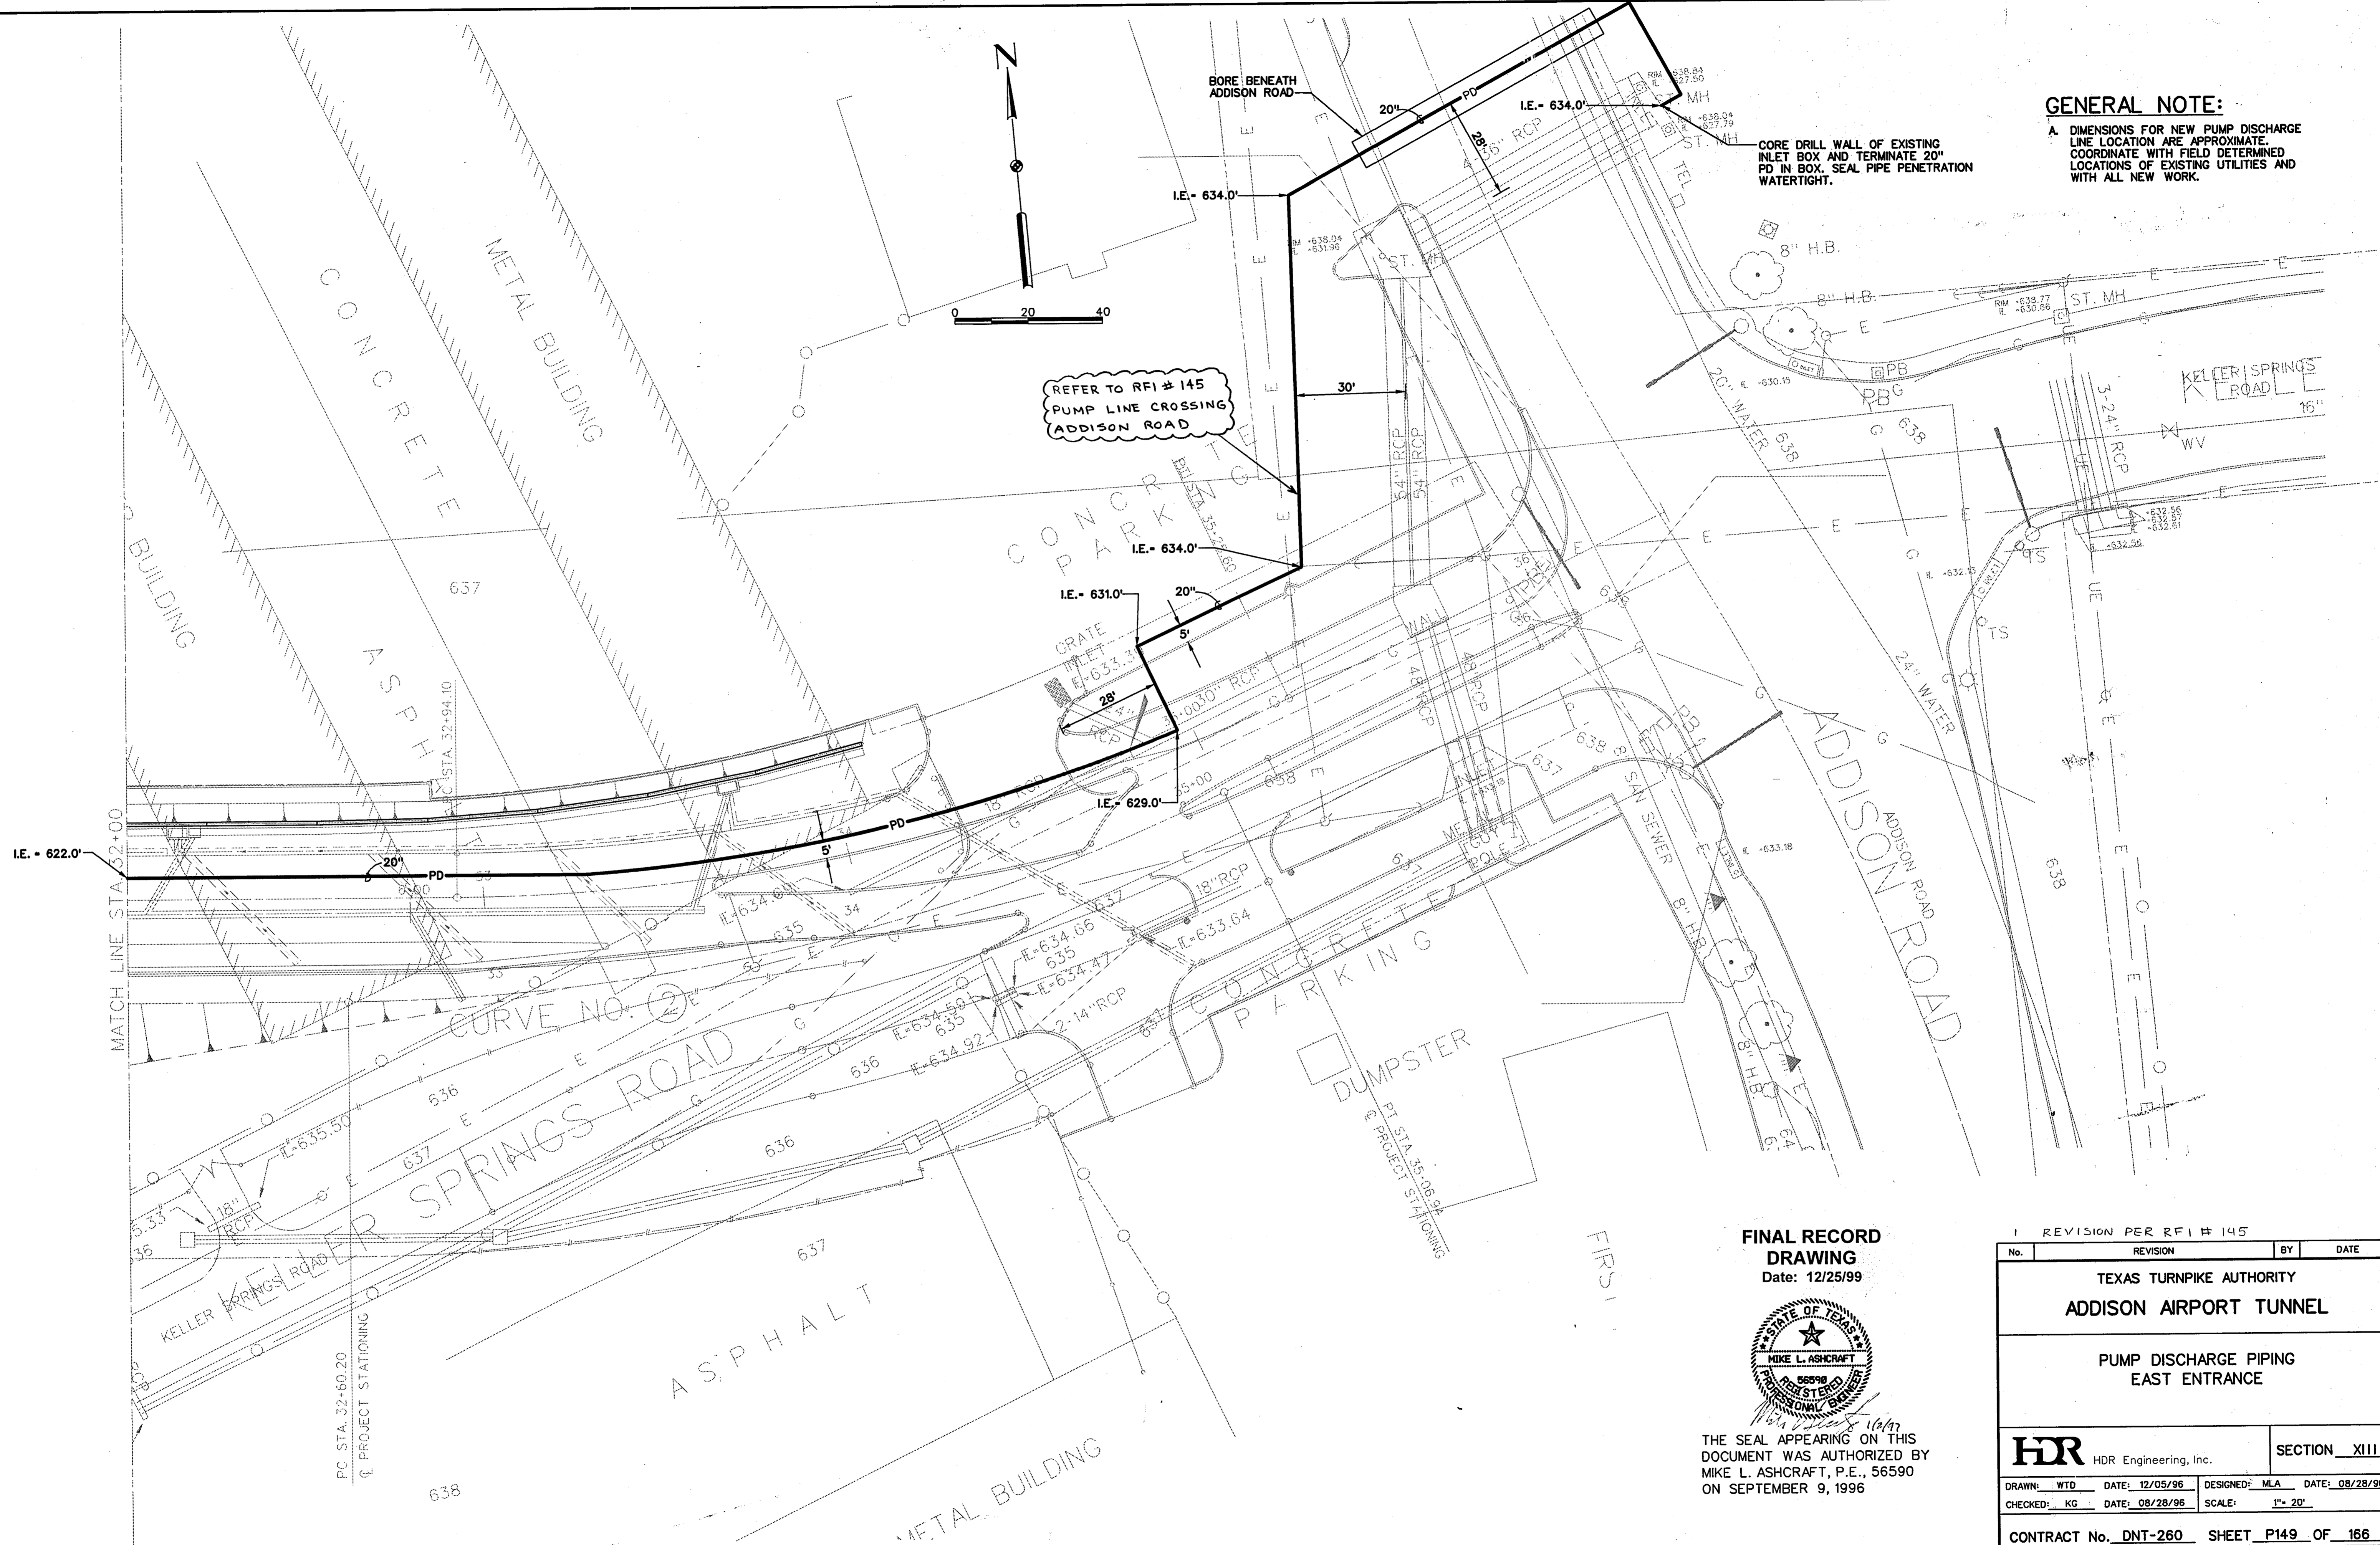

REFER TO RFI # 145  
PUMP LINE CROSSING  
ADDISON ROAD


**GENERAL NOTE:**  
A. DIMENSIONS FOR NEW PUMP DISCHARGE LINE LOCATION ARE APPROXIMATE. COORDINATE WITH FIELD DETERMINED LOCATIONS OF EXISTING UTILITIES AND WITH ALL NEW WORK.

**FINAL RECORD  
DRAWING**  
Date: 12/25/99




THE SEAL APPEARING ON THIS DOCUMENT WAS AUTHORIZED BY MIKE L. ASHCRAFT, P.E., 56590 ON SEPTEMBER 9, 1996


1 REVISION PER RFI # 145			
No.	REVISION	BY	DATE
TEXAS TURNPIKE AUTHORITY ADDISON AIRPORT TUNNEL			
PUMP DISCHARGE PIPING EAST ENTRANCE			
<b>HDR</b> HDR Engineering, Inc.			SECTION <u>XIII</u>
DRAWN: WTD	DATE: 12/05/96	DESIGNED: MLA	DATE: 08/28/96
CHECKED: KG	DATE: 08/28/96	SCALE:	1" = 20'
CONTRACT No. <u>DNT-260</u> SHEET <u>P149</u> OF <u>166</u>			

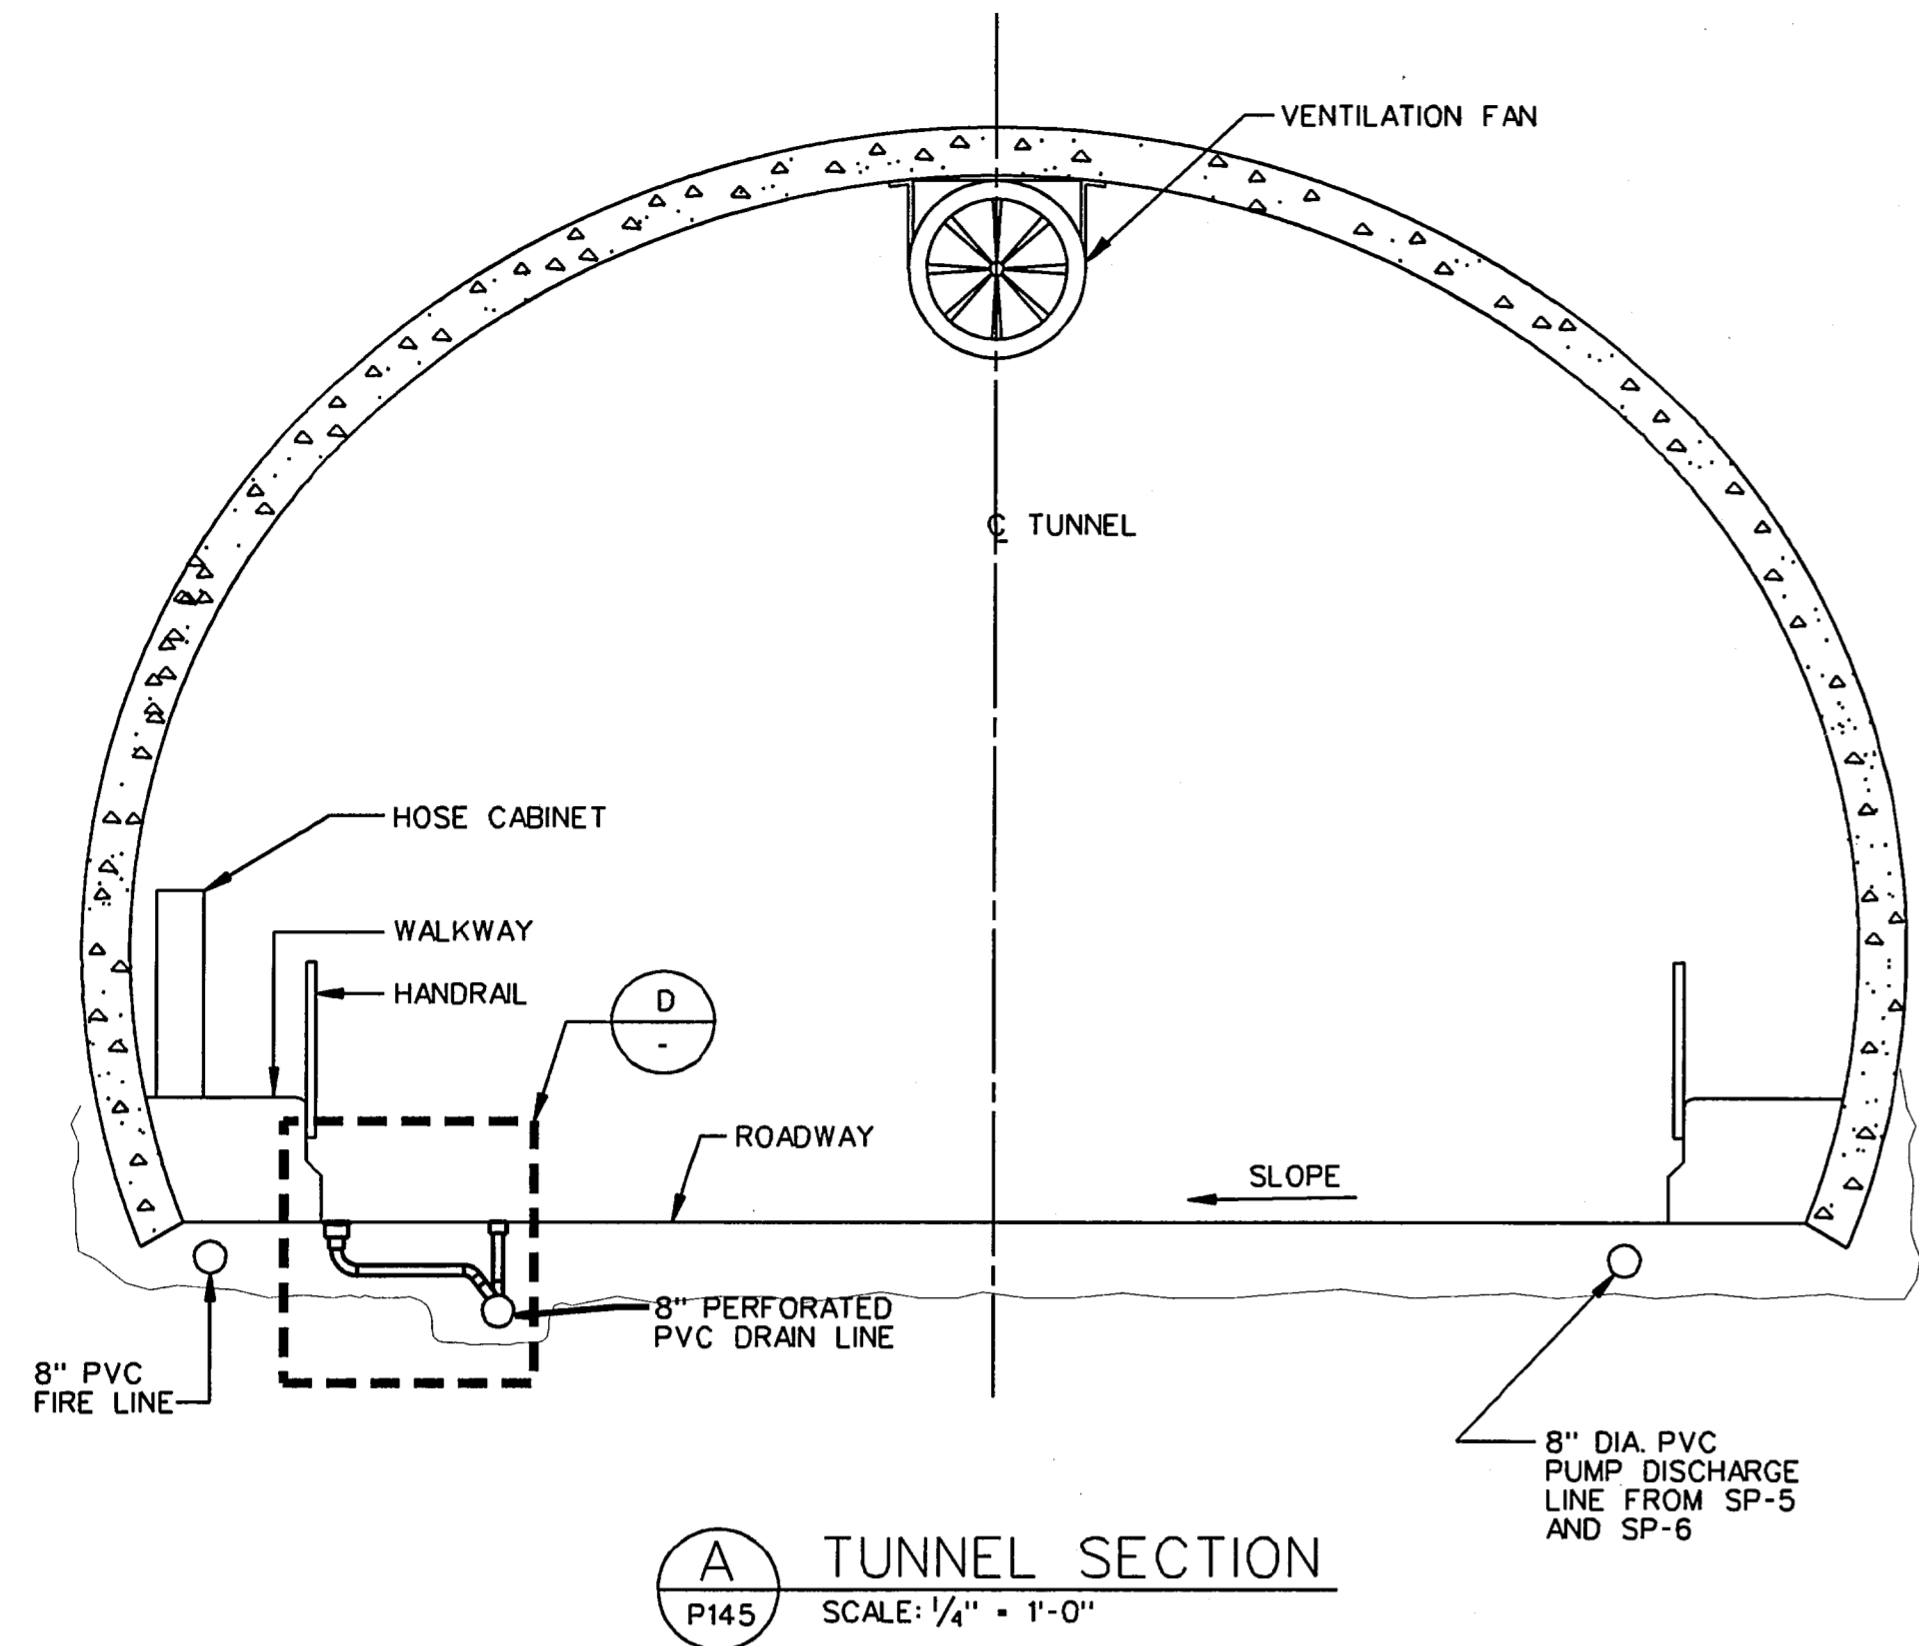


**A TUNNEL SECTION**  
SCALE: 1/4" = 1'-0"

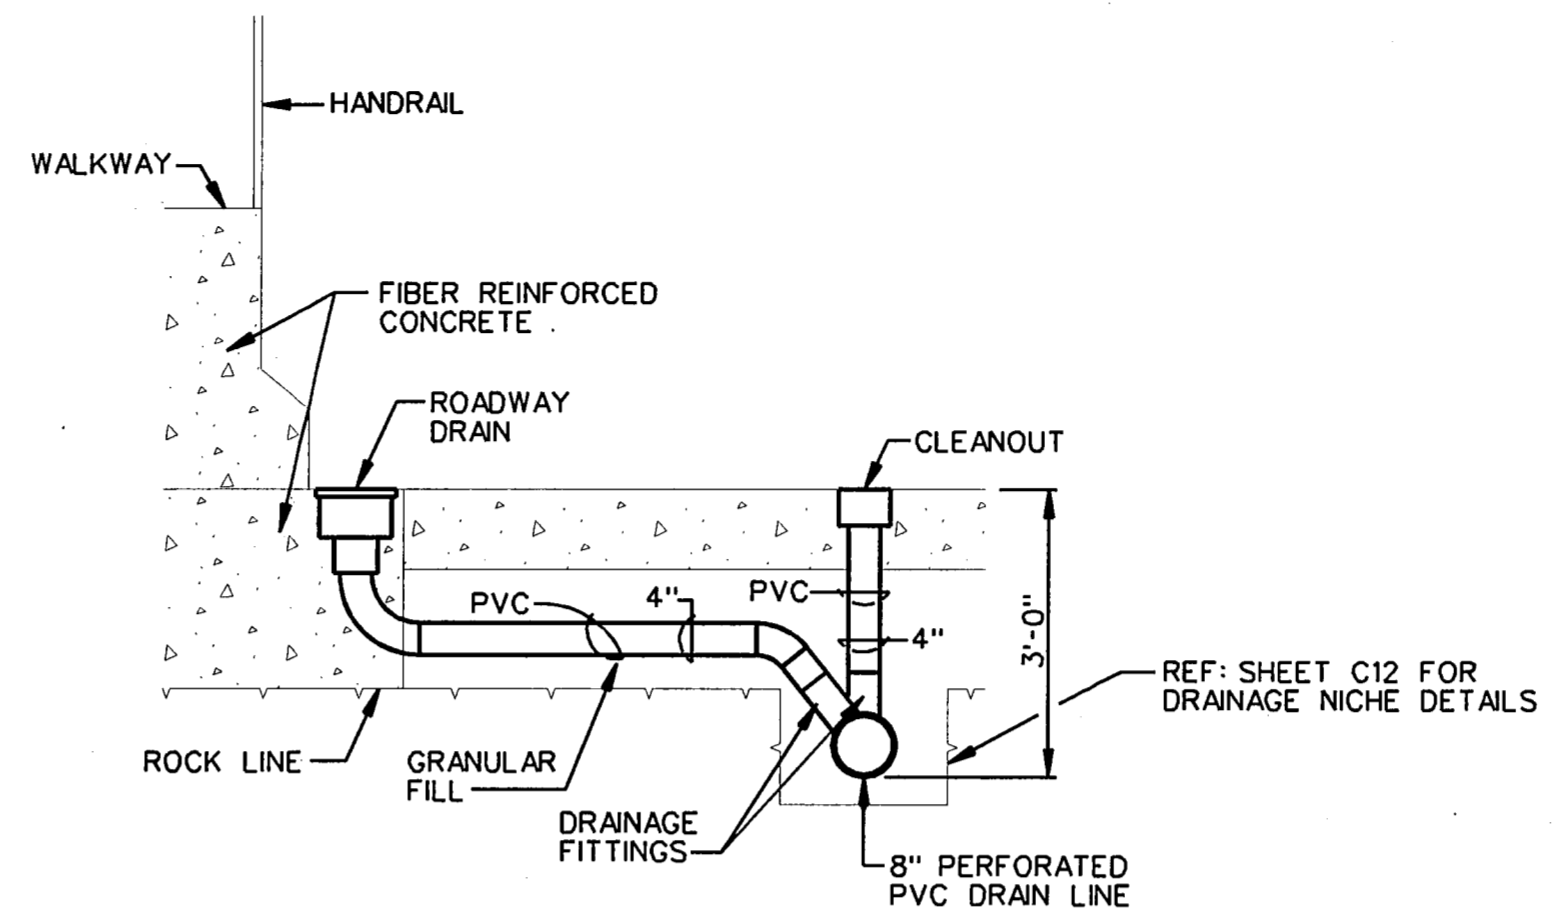


**D SECTION AT ROADWAY DRAIN**  
SCALE: 1" = 1'-0"

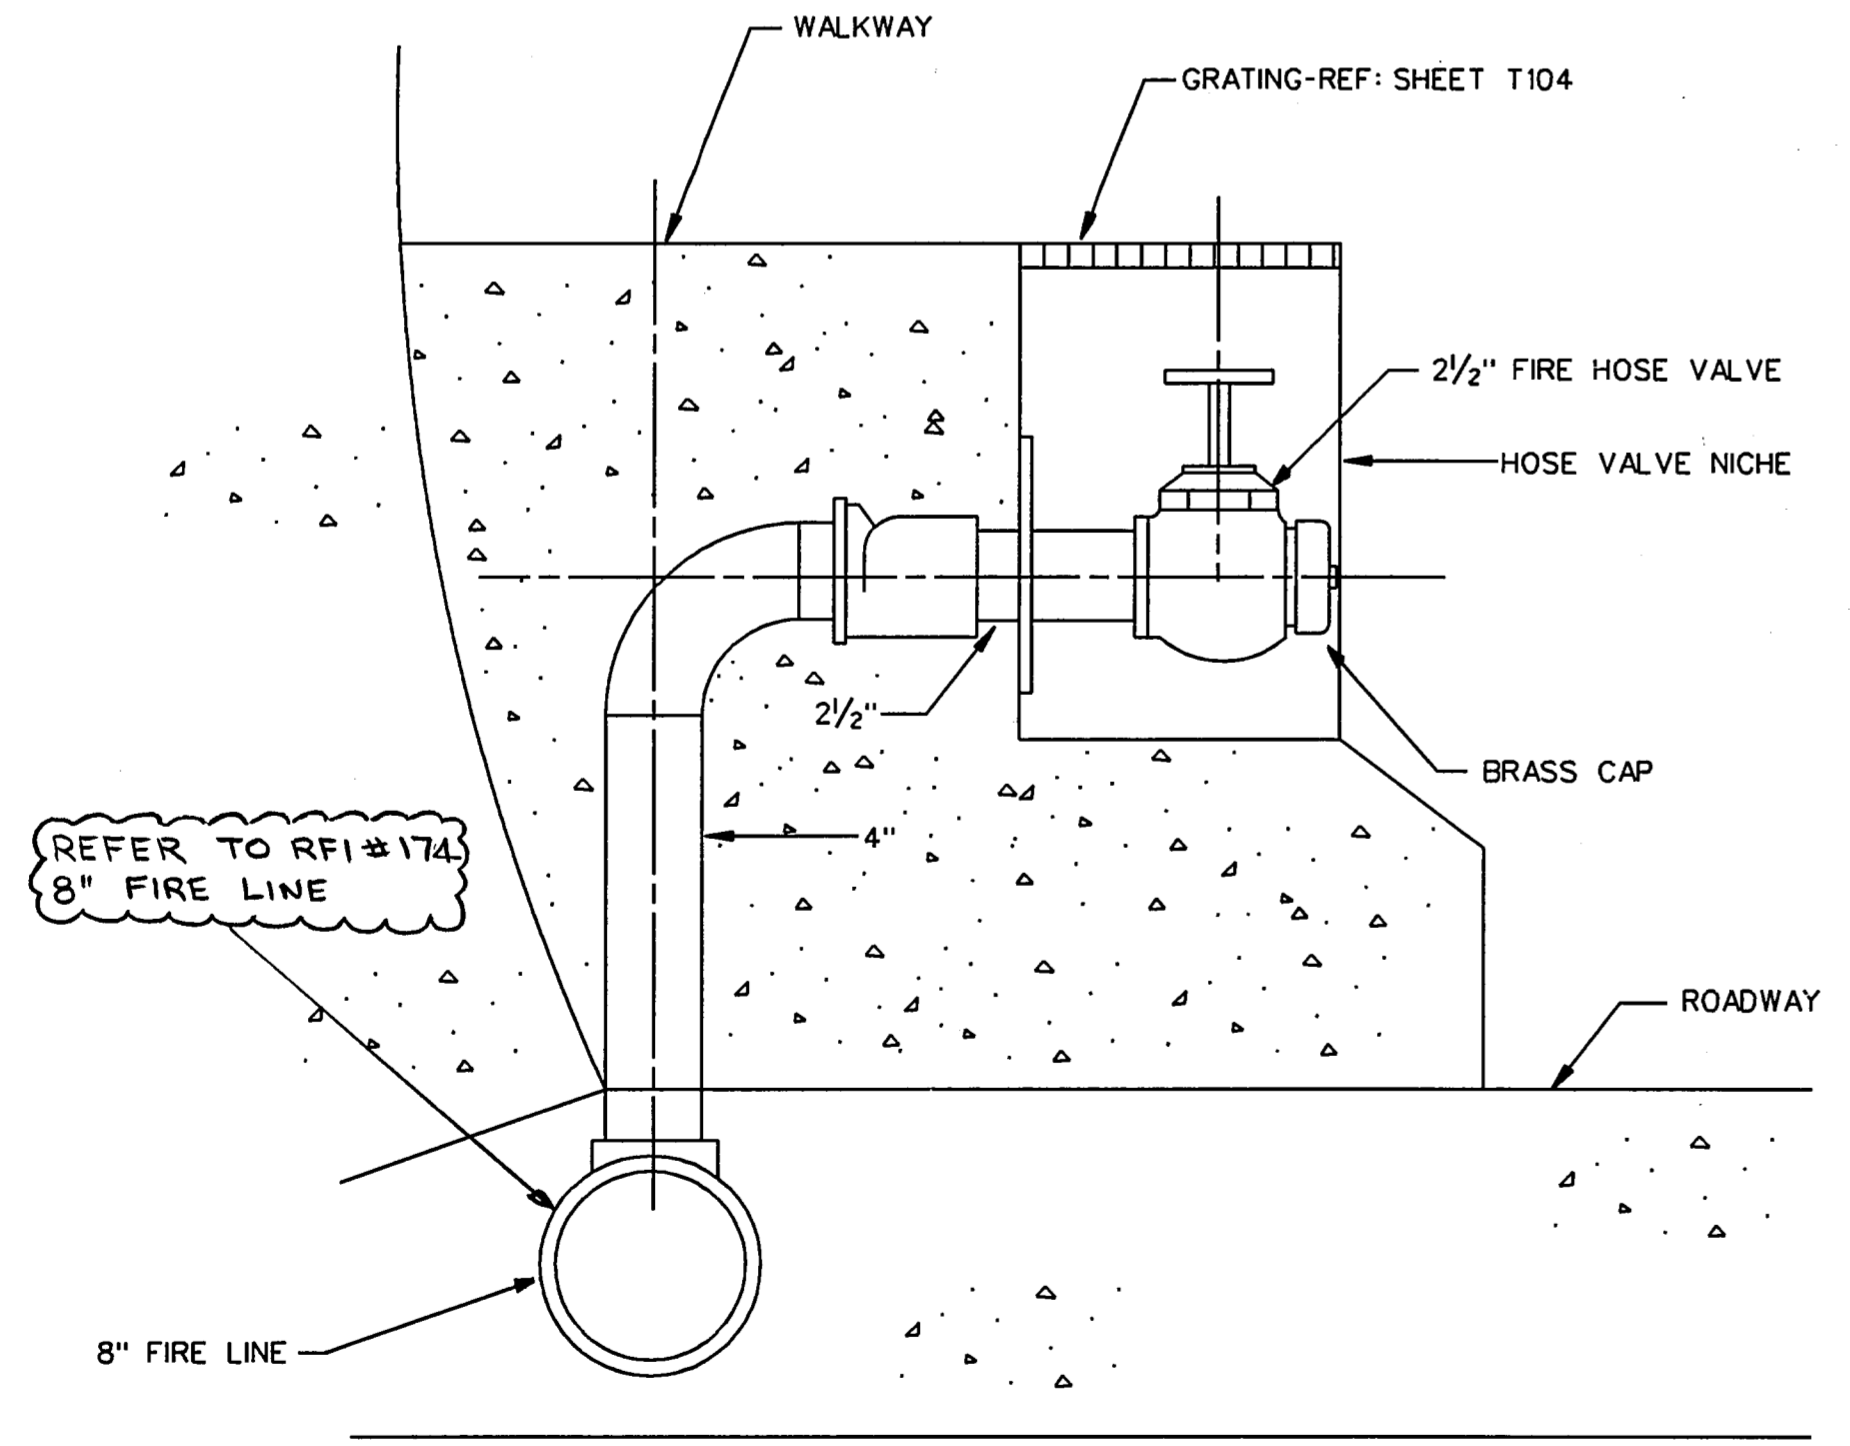

**B SECTION AT FIRE HOSE VALVE**  
SCALE: 1/2" = 1'-0"

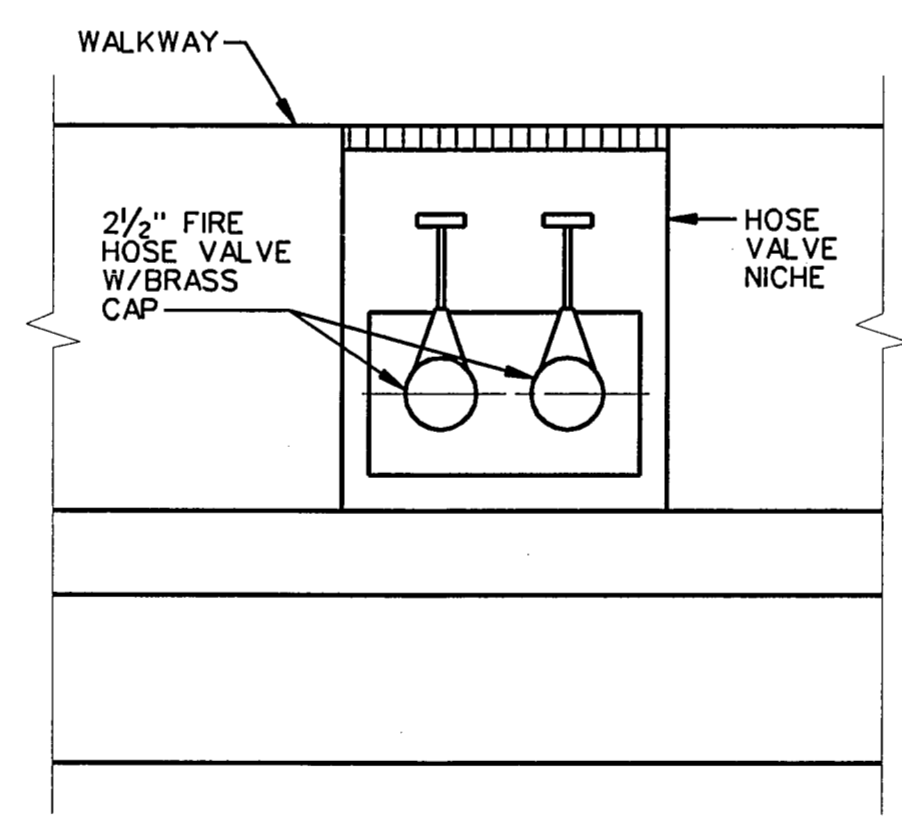

**C ELEVATION AT FIRE HOSE VALVE**  
SCALE: 1/2" = 1'-0"

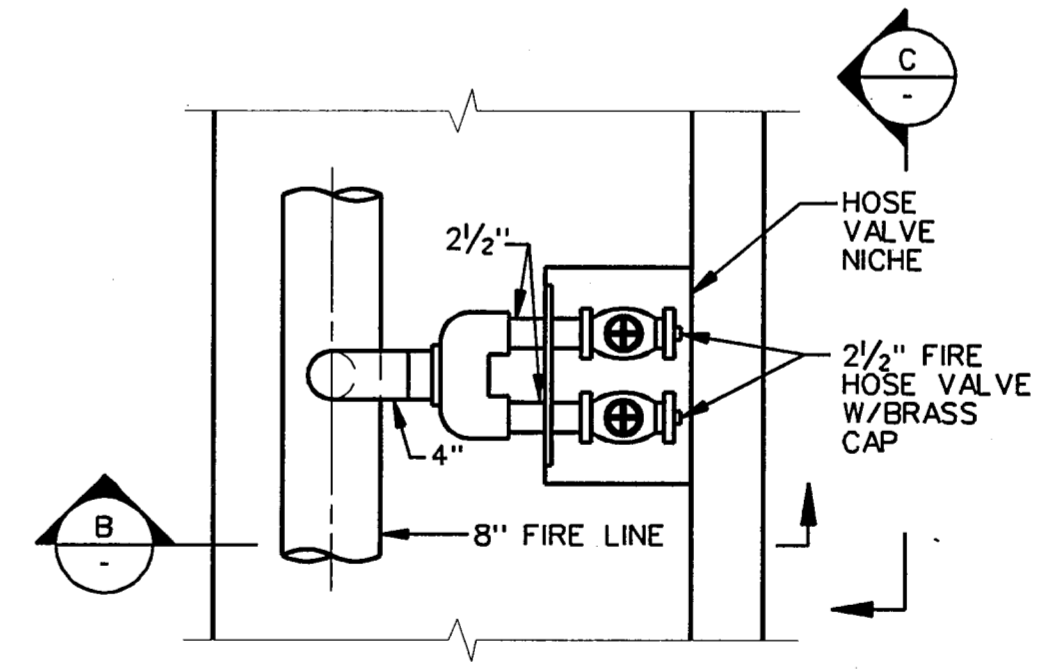

**1 PLAN AT FIRE HOSE VALVE**  
SCALE: 1/2" = 1'-0"





THE SEAL APPEARING ON THIS DOCUMENT WAS AUTHORIZED BY MIKE L. ASHCRAFT, P.E., 56590 ON SEPTEMBER 9, 1996

**FINAL RECORD DRAWING**  
Date: 12/25/99

No.	REVISION	BY	DATE
TEXAS TURNPIKE AUTHORITY <b>ADDISON AIRPORT TUNNEL</b>			
TUNNEL FIRE PROTECTION & PLUMBING SECTIONS			
HDR HDR Engineering, Inc.			SECTION XIII
DRAWN: WTD	DATE: 12/05/96	DESIGNED: MLA	DATE: 08/28/96
CHECKED: BL	DATE: 08/28/96	SCALE: AS SHOWN	
CONTRACT No. DNT-260 SHEET P150 OF 166			

FILE: p:\additun\dgn\aditup07.dgn  
DATE: 23-Apr-96 20:01




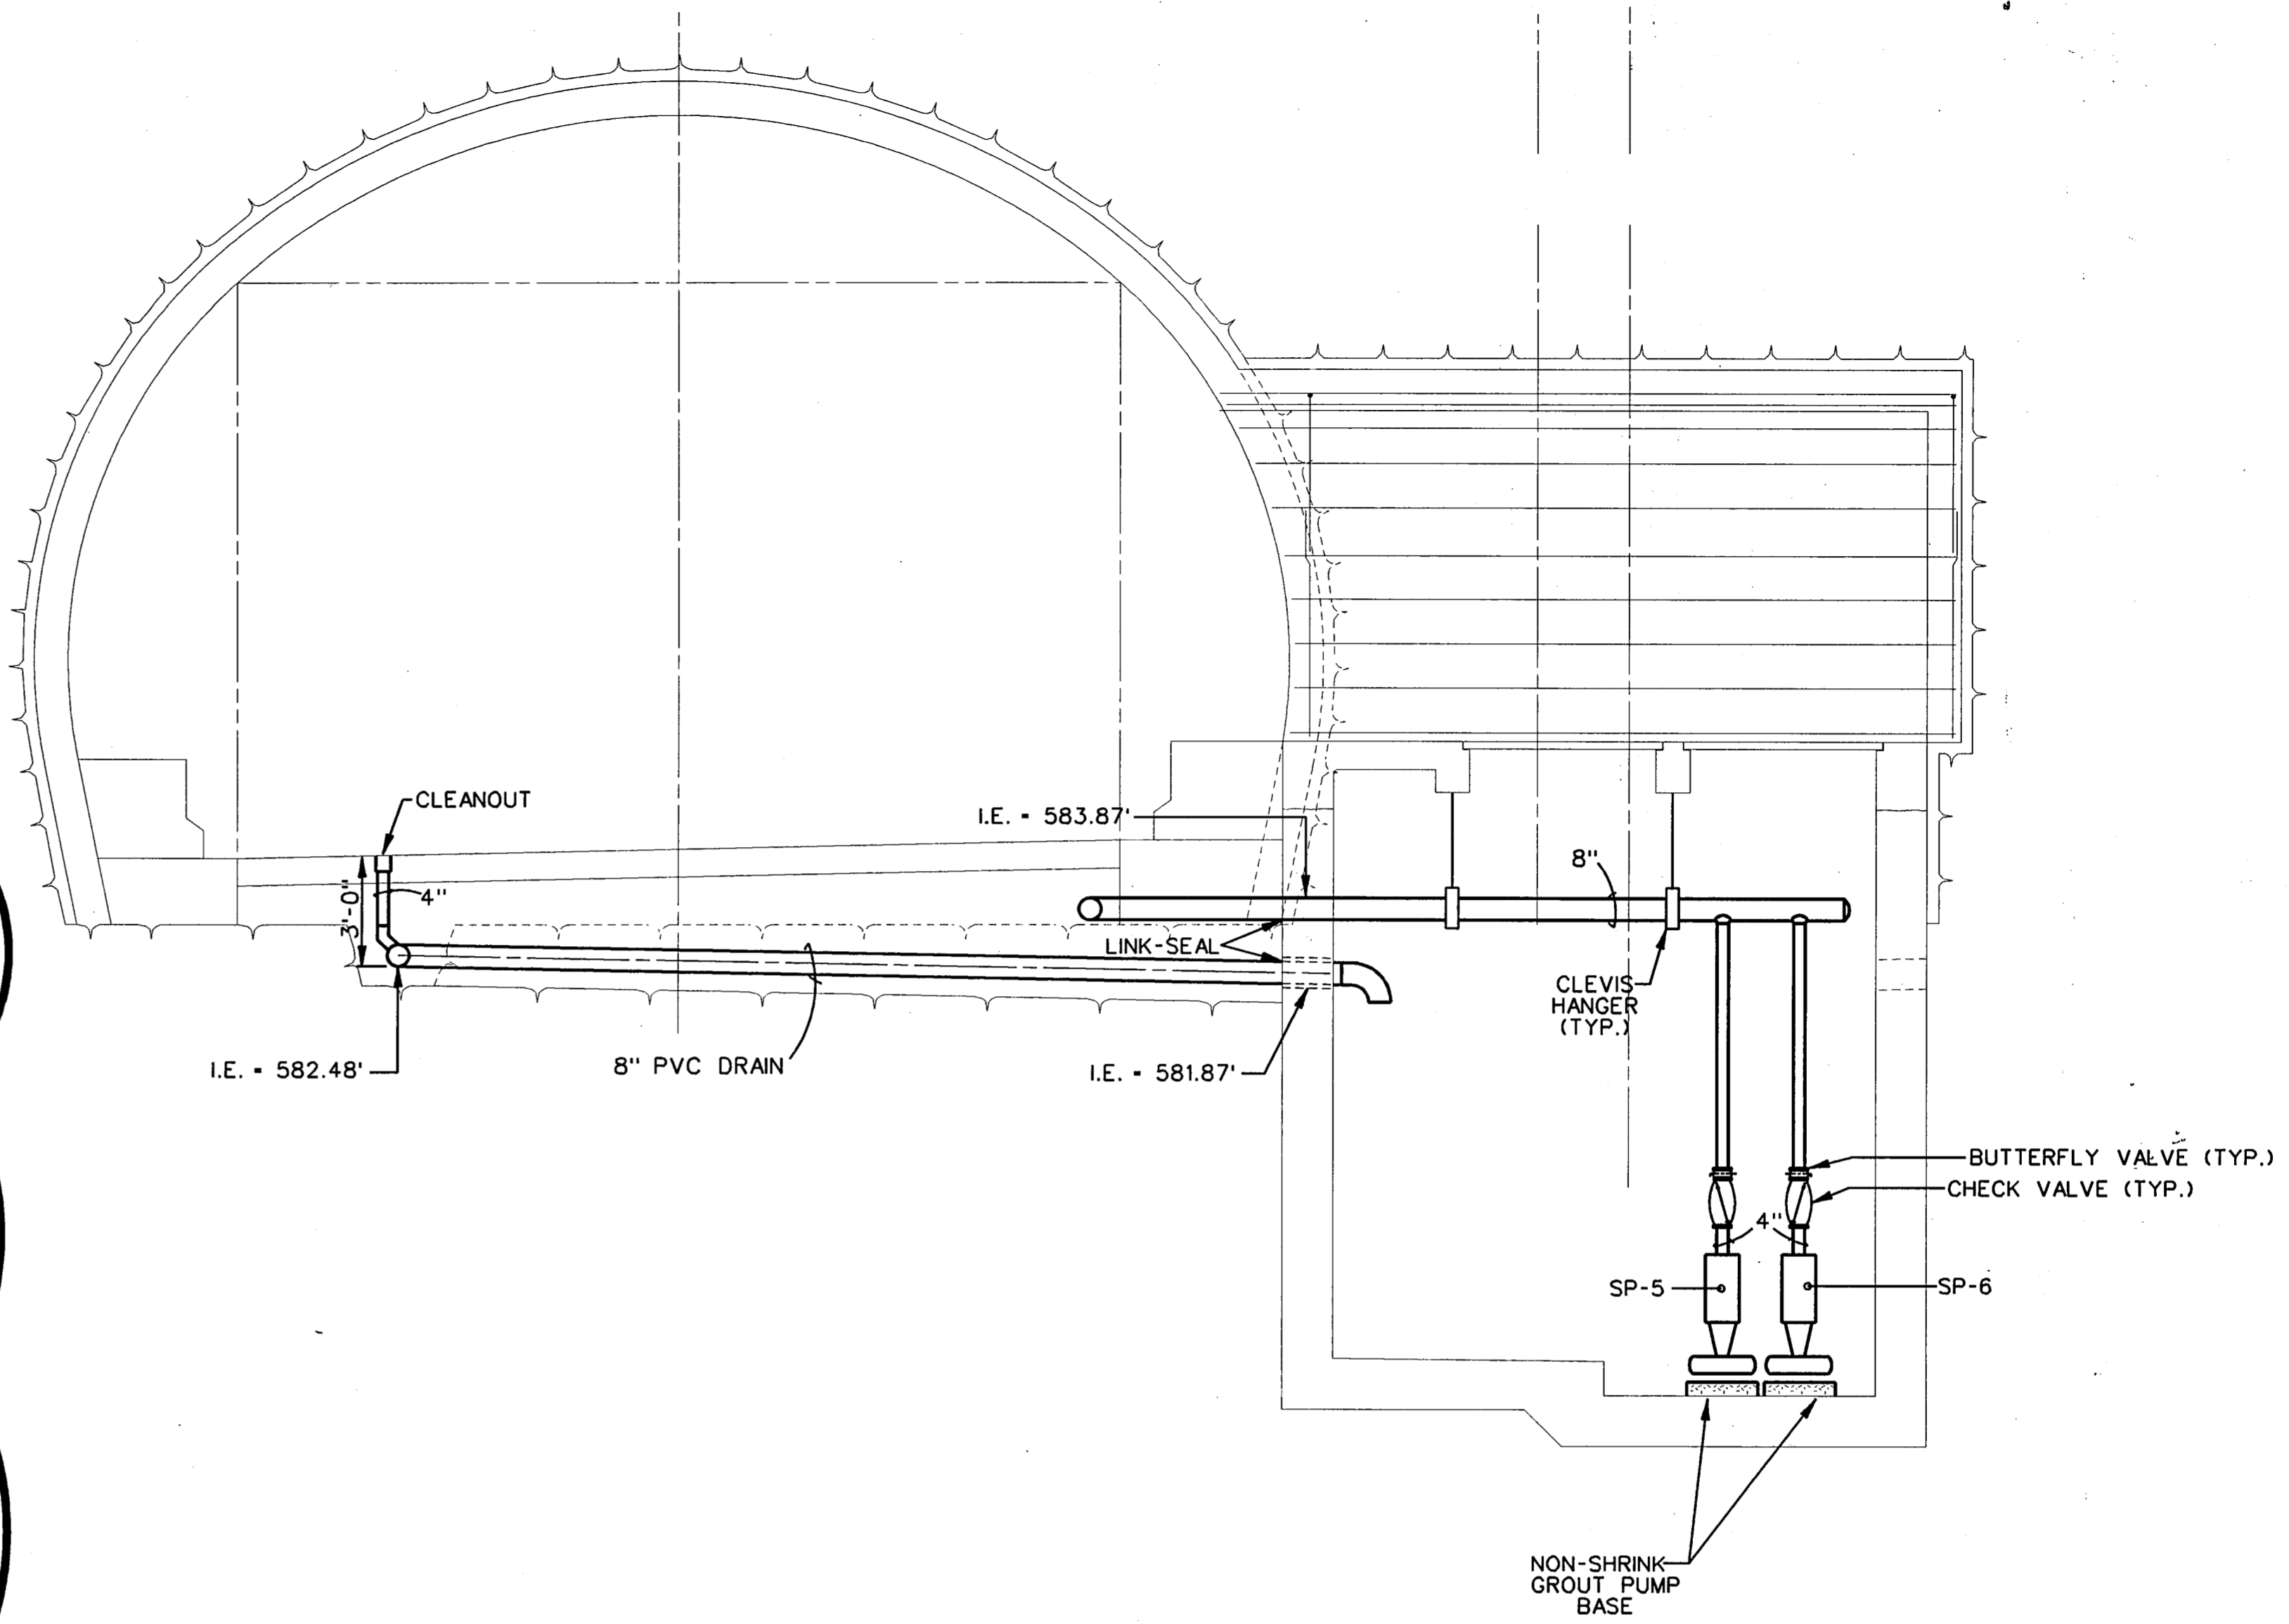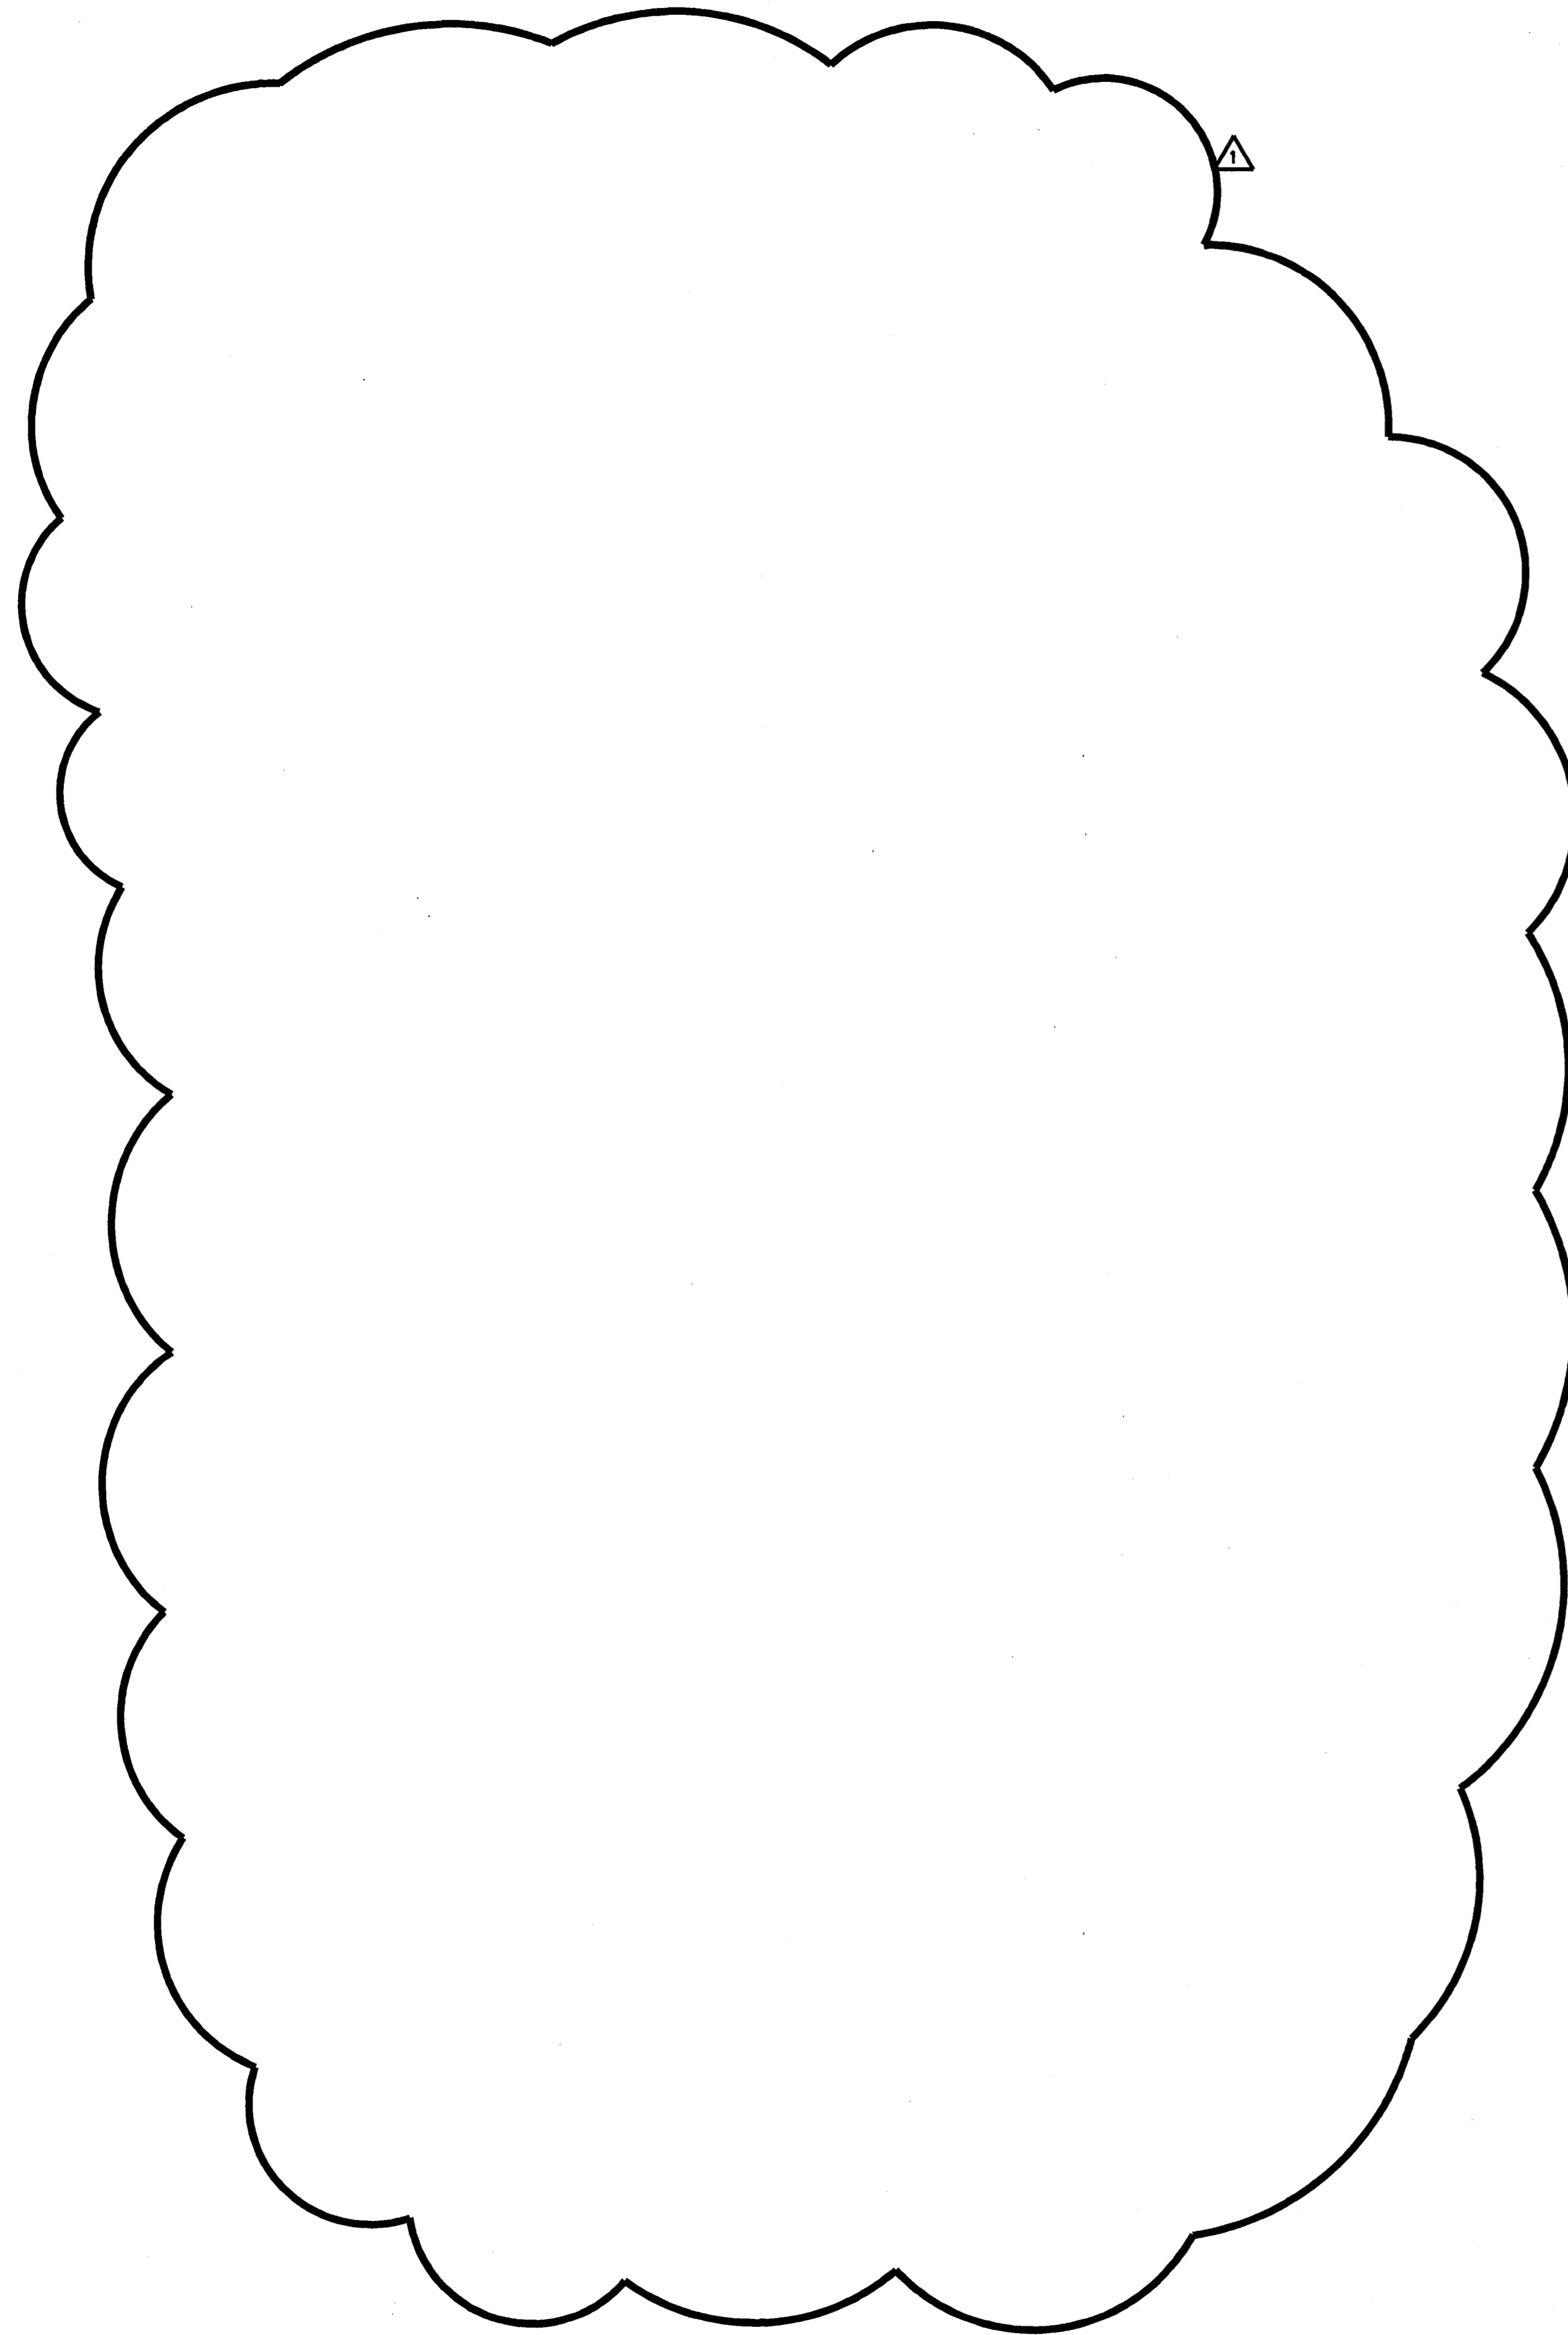

**B** SECTION AT TUNNEL SUMP PIT  
 P147 1/4" = 1'-0"

FILE: p:\adddtun\adgn\adftup108.dgn  
 DATE: 23-Apr-96 20:01

**FINAL RECORD  
 DRAWING**  
 Date: 12/25/99

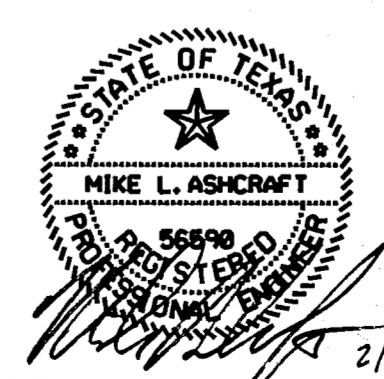

THE SEAL APPEARING ON THIS DOCUMENT WAS AUTHORIZED BY MIKE L. ASHCRAFT, P.E., 56590 ON SEPTEMBER 9, 1996

GEN. SETS		MLA	2/7/97
No.	REVISION	BY	DATE
TEXAS TURNPIKE AUTHORITY ADDISON AIRPORT TUNNEL			
TUNNEL GENERATOR & FIRE PROTECTION			
<b>HDR</b> HDR Engineering, Inc.			SECTION XIII
DRAWN: WTD	DATE: 12/05/96	DESIGNED: MLA	DATE: 08/28/96
CHECKED: BL	DATE: 08/28/96	SCALE:	NONE
CONTRACT No. DNT-260 SHEET P151 OF 166			

STORM WATER SEWAGE PUMP SCHEDULE									
MARK	LOCATION	TYPE	GPM	TDH (FT.)	ELECTRICAL			MANUFACTURER & MODEL	REMARKS
					HP	RPM	VOLT/PH		
SP-1	WEST PORTAL	SUBMERSIBLE NON-CLOG	3000	55	70	1750	460/3	ABS AFP 2001	SEE NOTE 1
SP-2	WEST PORTAL	SUBMERSIBLE NON-CLOG	3000	55	70	1750	460/3	ABS AFP 2001	
SP-3	WEST PORTAL	SUBMERSIBLE NON-CLOG	3000	55	70	1750	460/3	ABS AFP 2001	
SP-4	WEST PORTAL	SUBMERSIBLE NON-CLOG	300	55	10	1750	460/3	ABS AFP 1046	
SP-5	TUNNEL	SUBMERSIBLE NON-CLOG	500	40	10	1750	460/3	ABS AFP 1046	
SP-6	TUNNEL	SUBMERSIBLE NON-CLOG	500	40	10	1750	460/3	ABS AFP 1046	
SP-7	EAST PORTAL	SUBMERSIBLE NON-CLOG	3000	75	84	1750	460/3	ABS AFP 2001	
SP-8	EAST PORTAL	SUBMERSIBLE NON-CLOG	3000	75	84	1750	460/3	ABS AFP 2001	
SP-9	EAST PORTAL	SUBMERSIBLE NON-CLOG	3000	75	84	1750	460/3	ABS AFP 2001	
SP-10	EAST PORTAL	SUBMERSIBLE NON-CLOG	300	75	20	1750	460/3	ABS AFP 1044	

NOTES:  
1. MANUFACTURERS STANDARD PACKAGED SUMP CONTROLLER SHALL BE COMPLETE WITH NEMA TYPE 4X CONTROL PANEL, NEMA TYPE 6 INDIVIDUAL COMBINATION MOTOR STARTERS/DISCONNECTS AND WIRING/CONDUIT.

GENERATOR FUEL PUMP SCHEDULE					
MARK	TYPE	SIZE & TYPE	IMPELLER	RPM	BHP
FP-1	SUBMERSIBLE	1/2X 1X 6 ESP	1129A10X06YA	1750	1/2

### SEQUENCE OF OPERATION:

PROVIDE EACH PUMP WITH AN H-O-A SWITCH AT THE PUMP CONTROL PANEL. THE FOLLOWING SEQUENCE OCCURS FOR EACH SWITCH POSITION.

### AUTO POSITION


- AS THE SUMP PIT WATER LEVEL RISES ABOVE 6IN. THE "ALL PUMPS OFF" BULB SWITCH CLOSSES.
- AS THE SUMP PIT WATER LEVEL RISES ABOVE 2 FT. THE "SP-D" BULB SWITCH CLOSSES AND THE RELATED PUMP STARTS.
- OPERATION 2 IS REPEATED FOR "SP-C", "SP-B" AND "SP-A" BULB SWITCHES AS WATER LEVEL REACHES TABLE LEVELS RESPECTIVELY.
- AS WATER LEVEL REACHES 18 FT. THE HIGH WATER ALARM IS ACTIVATED.
- ALL PUMPS STARTED WILL REMAIN ON UNTIL THE SUMP PIT WATER LEVEL IS LOWERED TO 1FT. OR UNTIL OVERLOAD CONTACTS ARE OPENED, OR UNTIL MANUALLY DISCONNECTED.

### OFF POSITION


- PUMPS ARE OFF REGARDLESS OF WATER LEVEL WHEN ALL PUMP CONTROLS ARE IN THE OFF POSITION.
- EACH PUMP MAY BE INDIVIDUALLY PLACED IN THE OFF POSITION, DISABLING THE PUMP.

### HAND POSITION

- PUMPS ARE ON REGARDLESS OF WATER LEVEL WHEN PUMP CONTROLS ARE IN THE HAND POSITION.
- EACH PUMP MAY BE INDIVIDUALLY PLACED IN THE HAND POSITION, ENABLING THE PUMP.

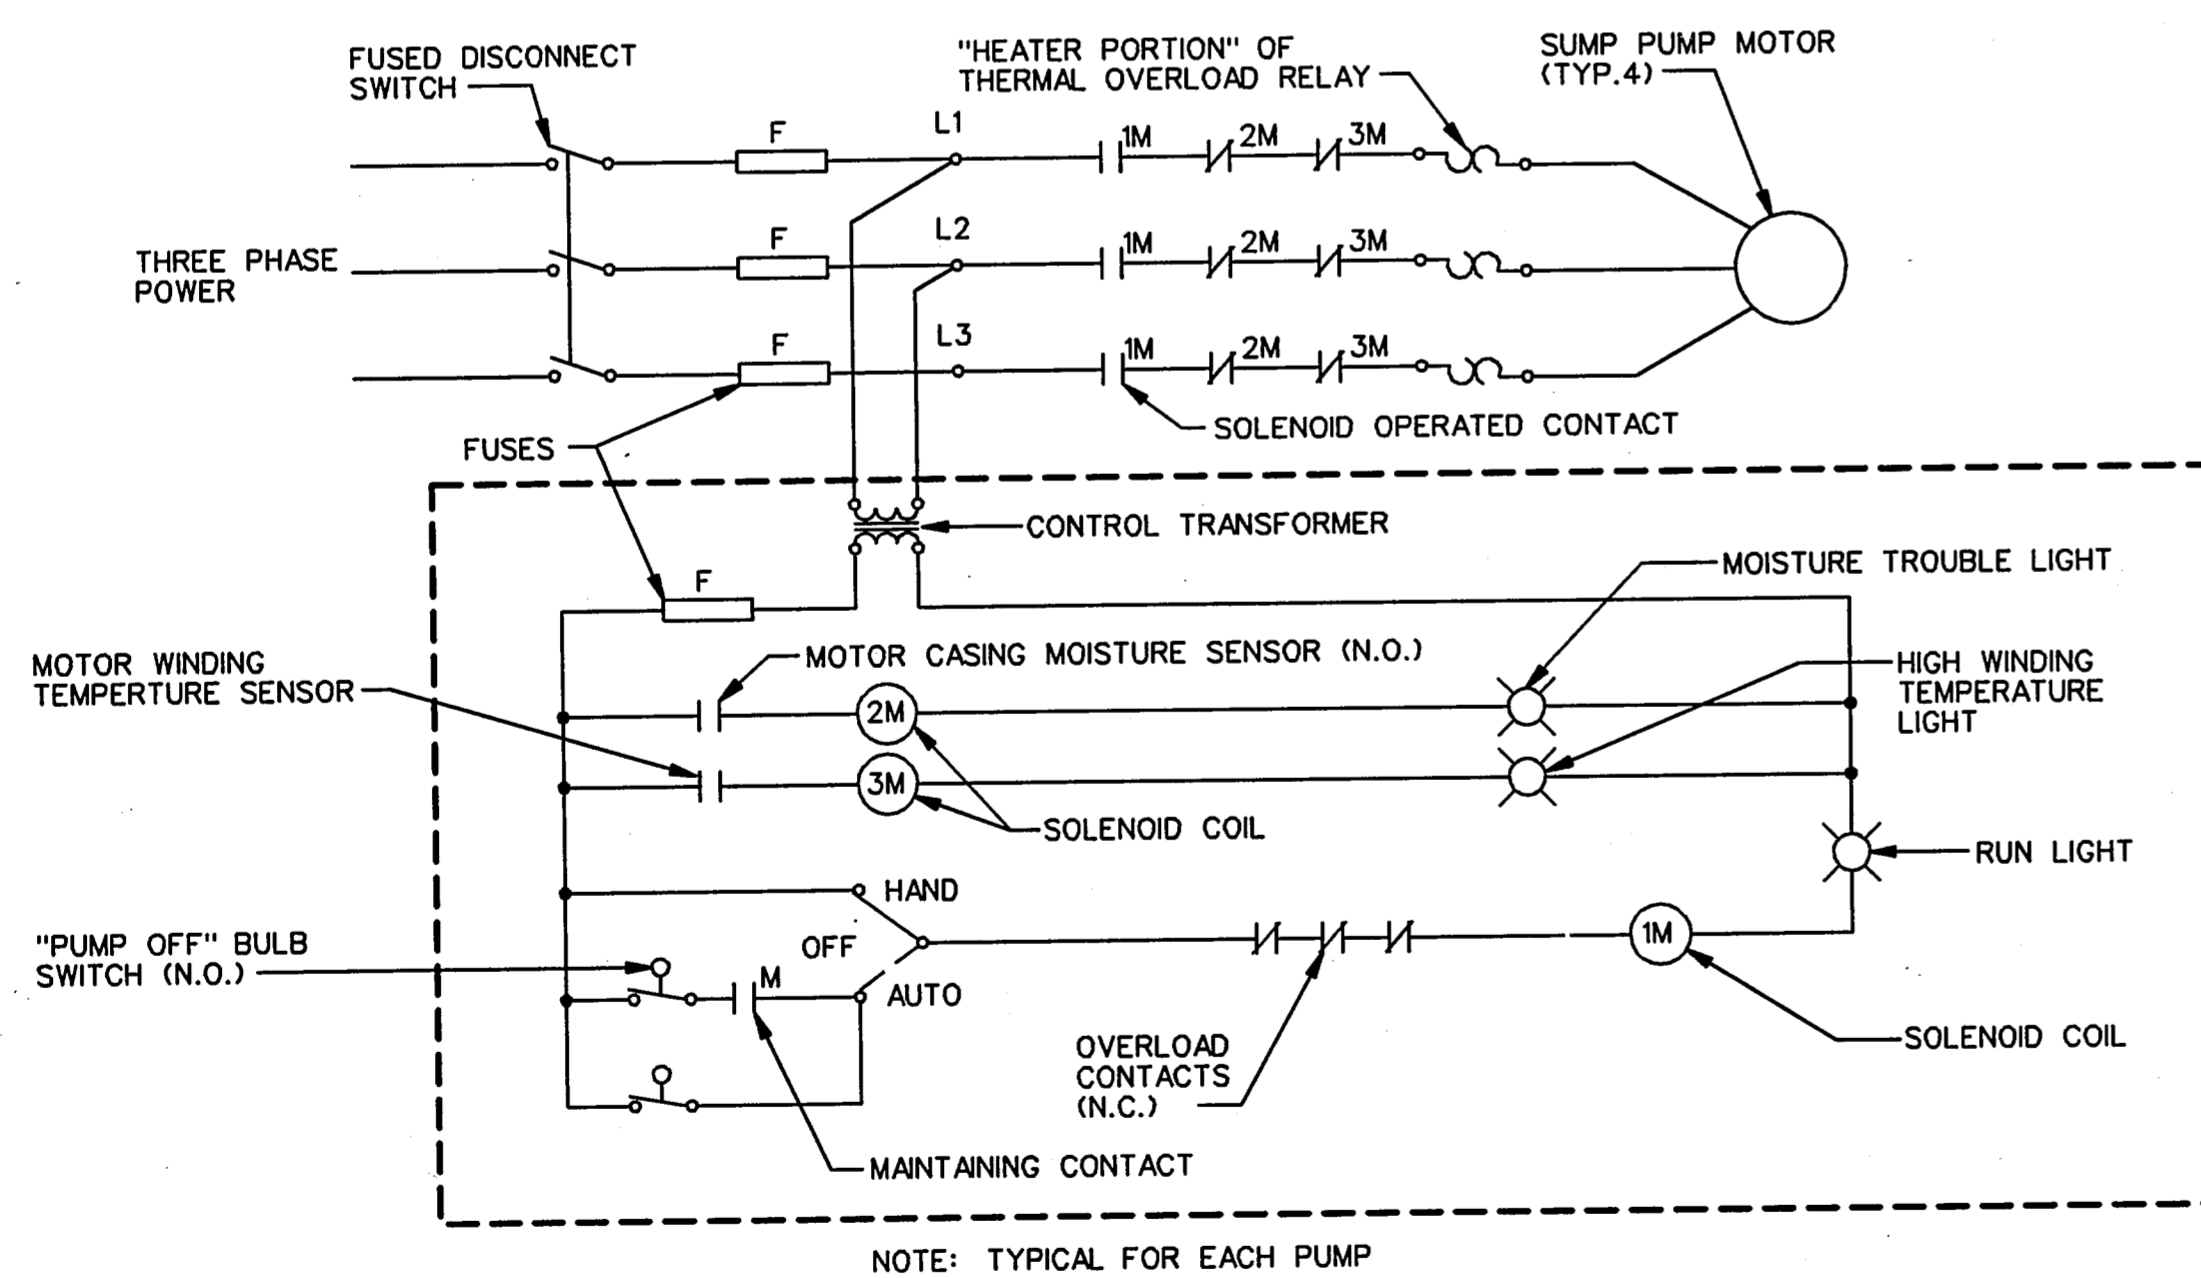

1 SUMP PUMP CONTROL SCHEMATIC  
P147 NO SCALE

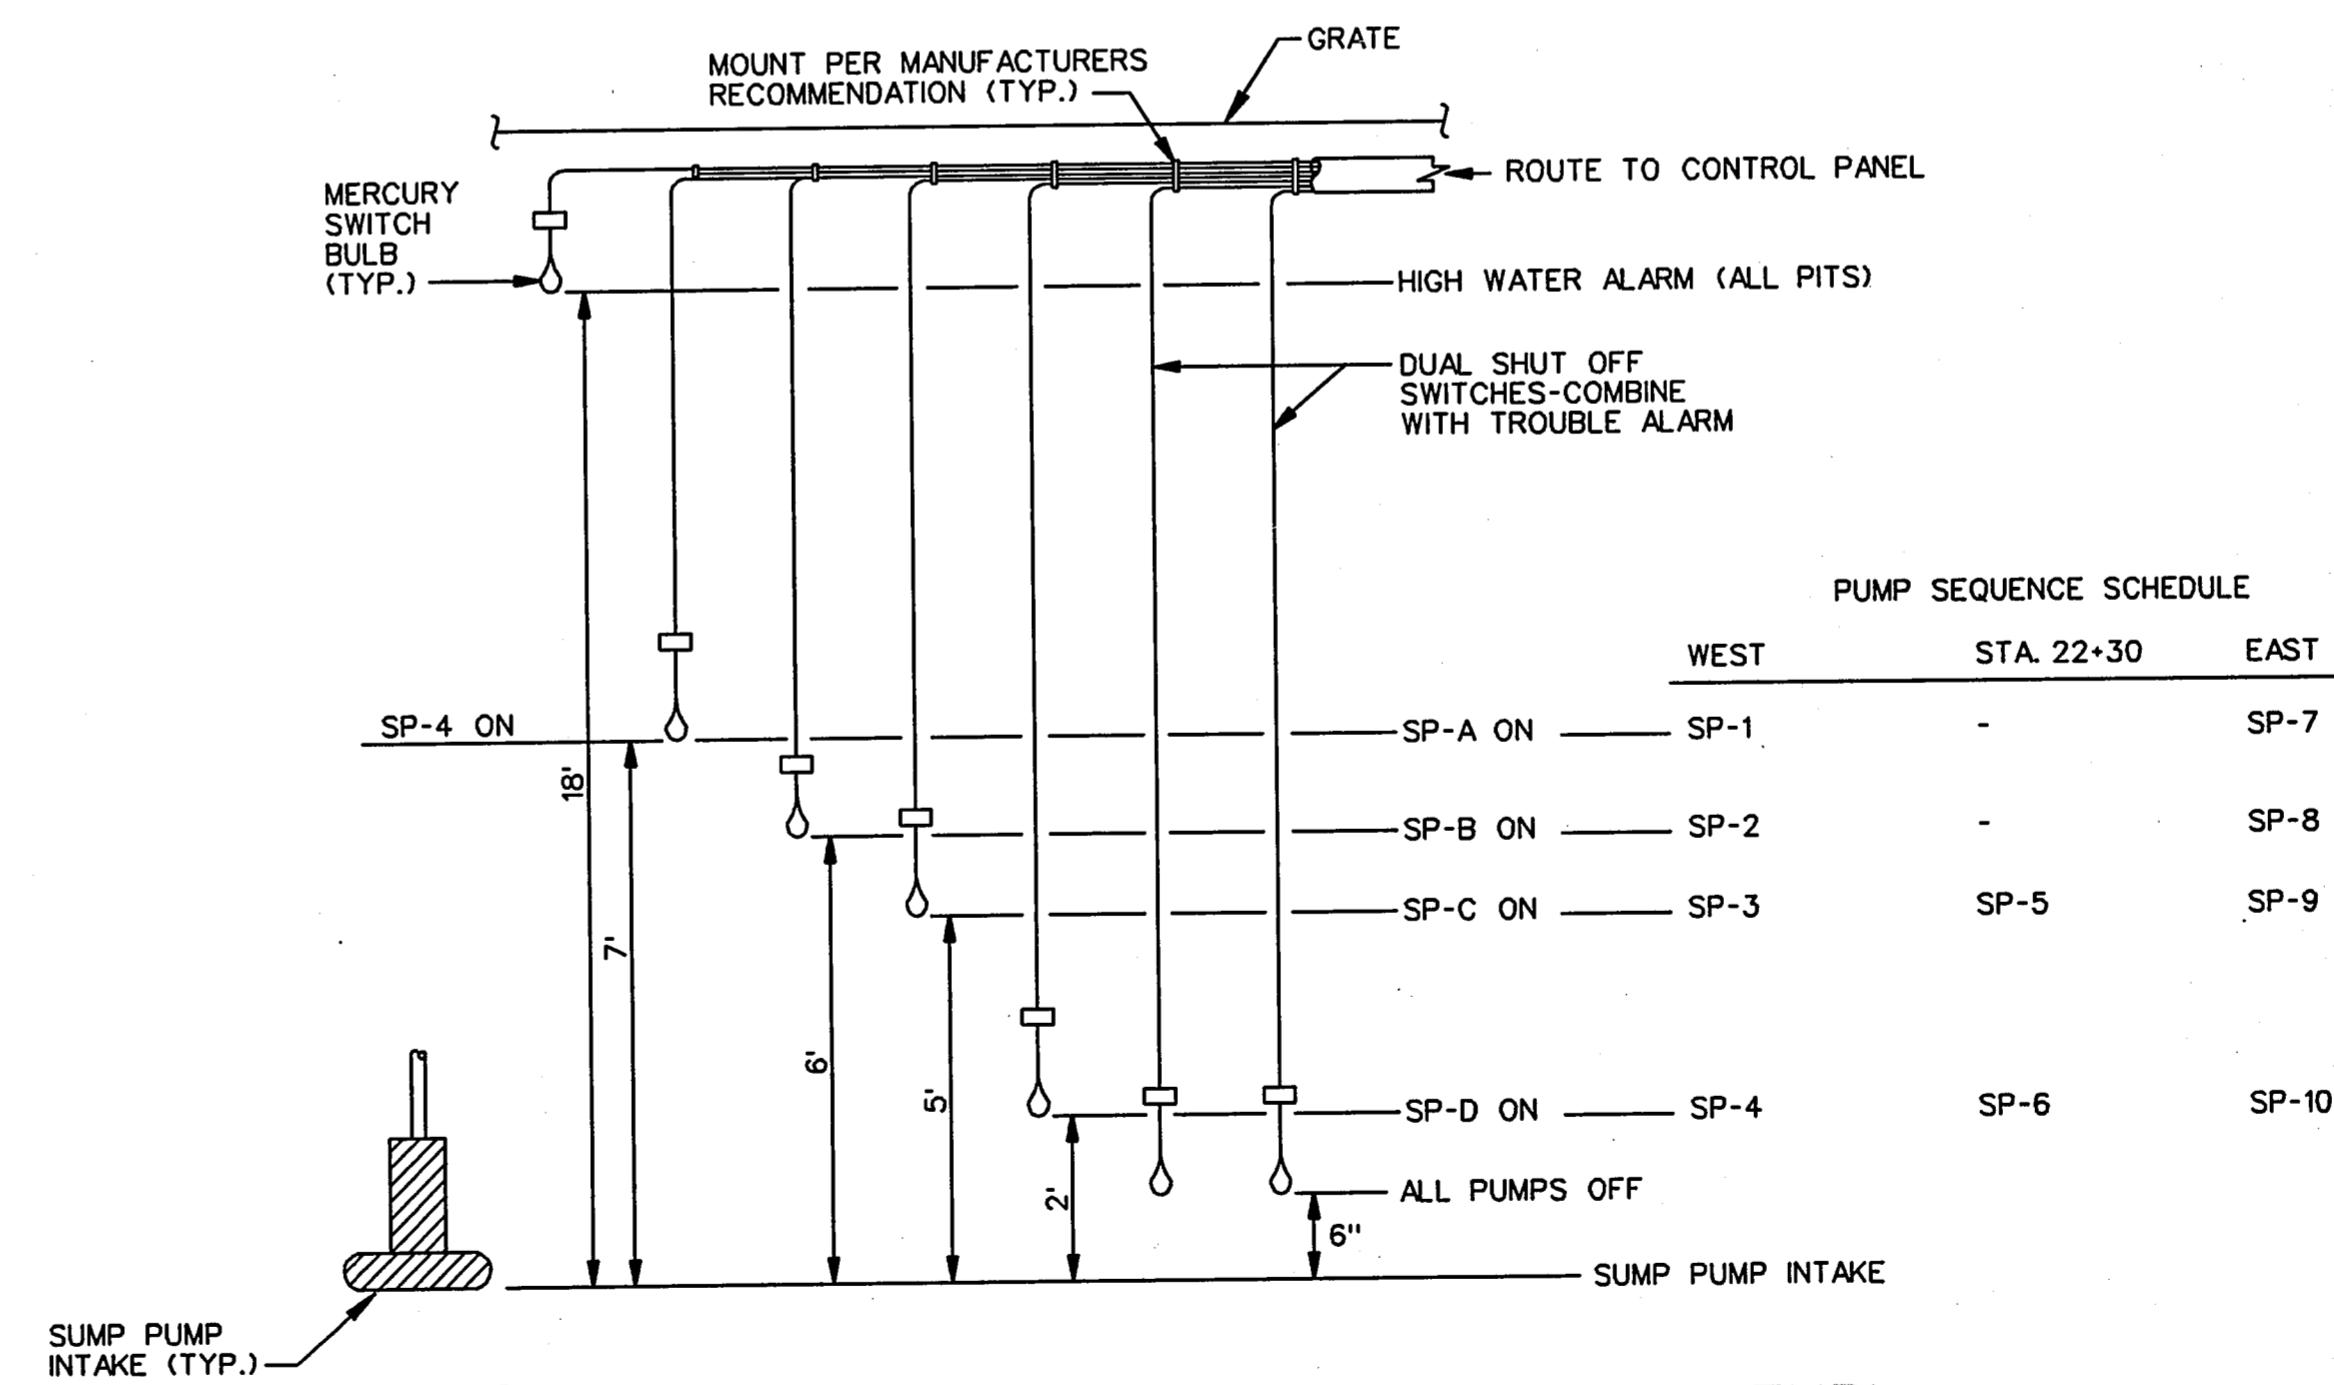

2 SUMP PUMP LEVEL CONTROL DETAIL (TYP.)  
P147 NO SCALE

PUMP SEQUENCE SCHEDULE		
WEST	STA. 22+30	EAST
SP-A ON	SP-1	SP-7
SP-B ON	SP-2	SP-8
SP-C ON	SP-3	SP-9
SP-D ON	SP-4	SP-10
ALL PUMPS OFF	SP-6	




THE SEAL APPEARING ON THIS DOCUMENT WAS AUTHORIZED BY MIKE L. ASHCRAFT, P.E., 56590 ON SEPTEMBER 9, 1996

FINAL RECORD  
DRAWING  
Date: 12/25/99

No.	REVISION	BY	DATE
TEXAS TURNPIKE AUTHORITY ADDISON AIRPORT TUNNEL			
TUNNEL FIRE PROTECTION, PLUMBING SCHEDULES & CONTROL DIAGRAMS			
HDR Engineering, Inc.			SECTION XIII
DRAWN: WTD	DATE: 12/05/96	DESIGNED: MLA	DATE: 08/28/96
CHECKED: KG	DATE: 08/28/96	SCALE: NONE	
CONTRACT No. DNT-260 SHEET P152 OF 166			



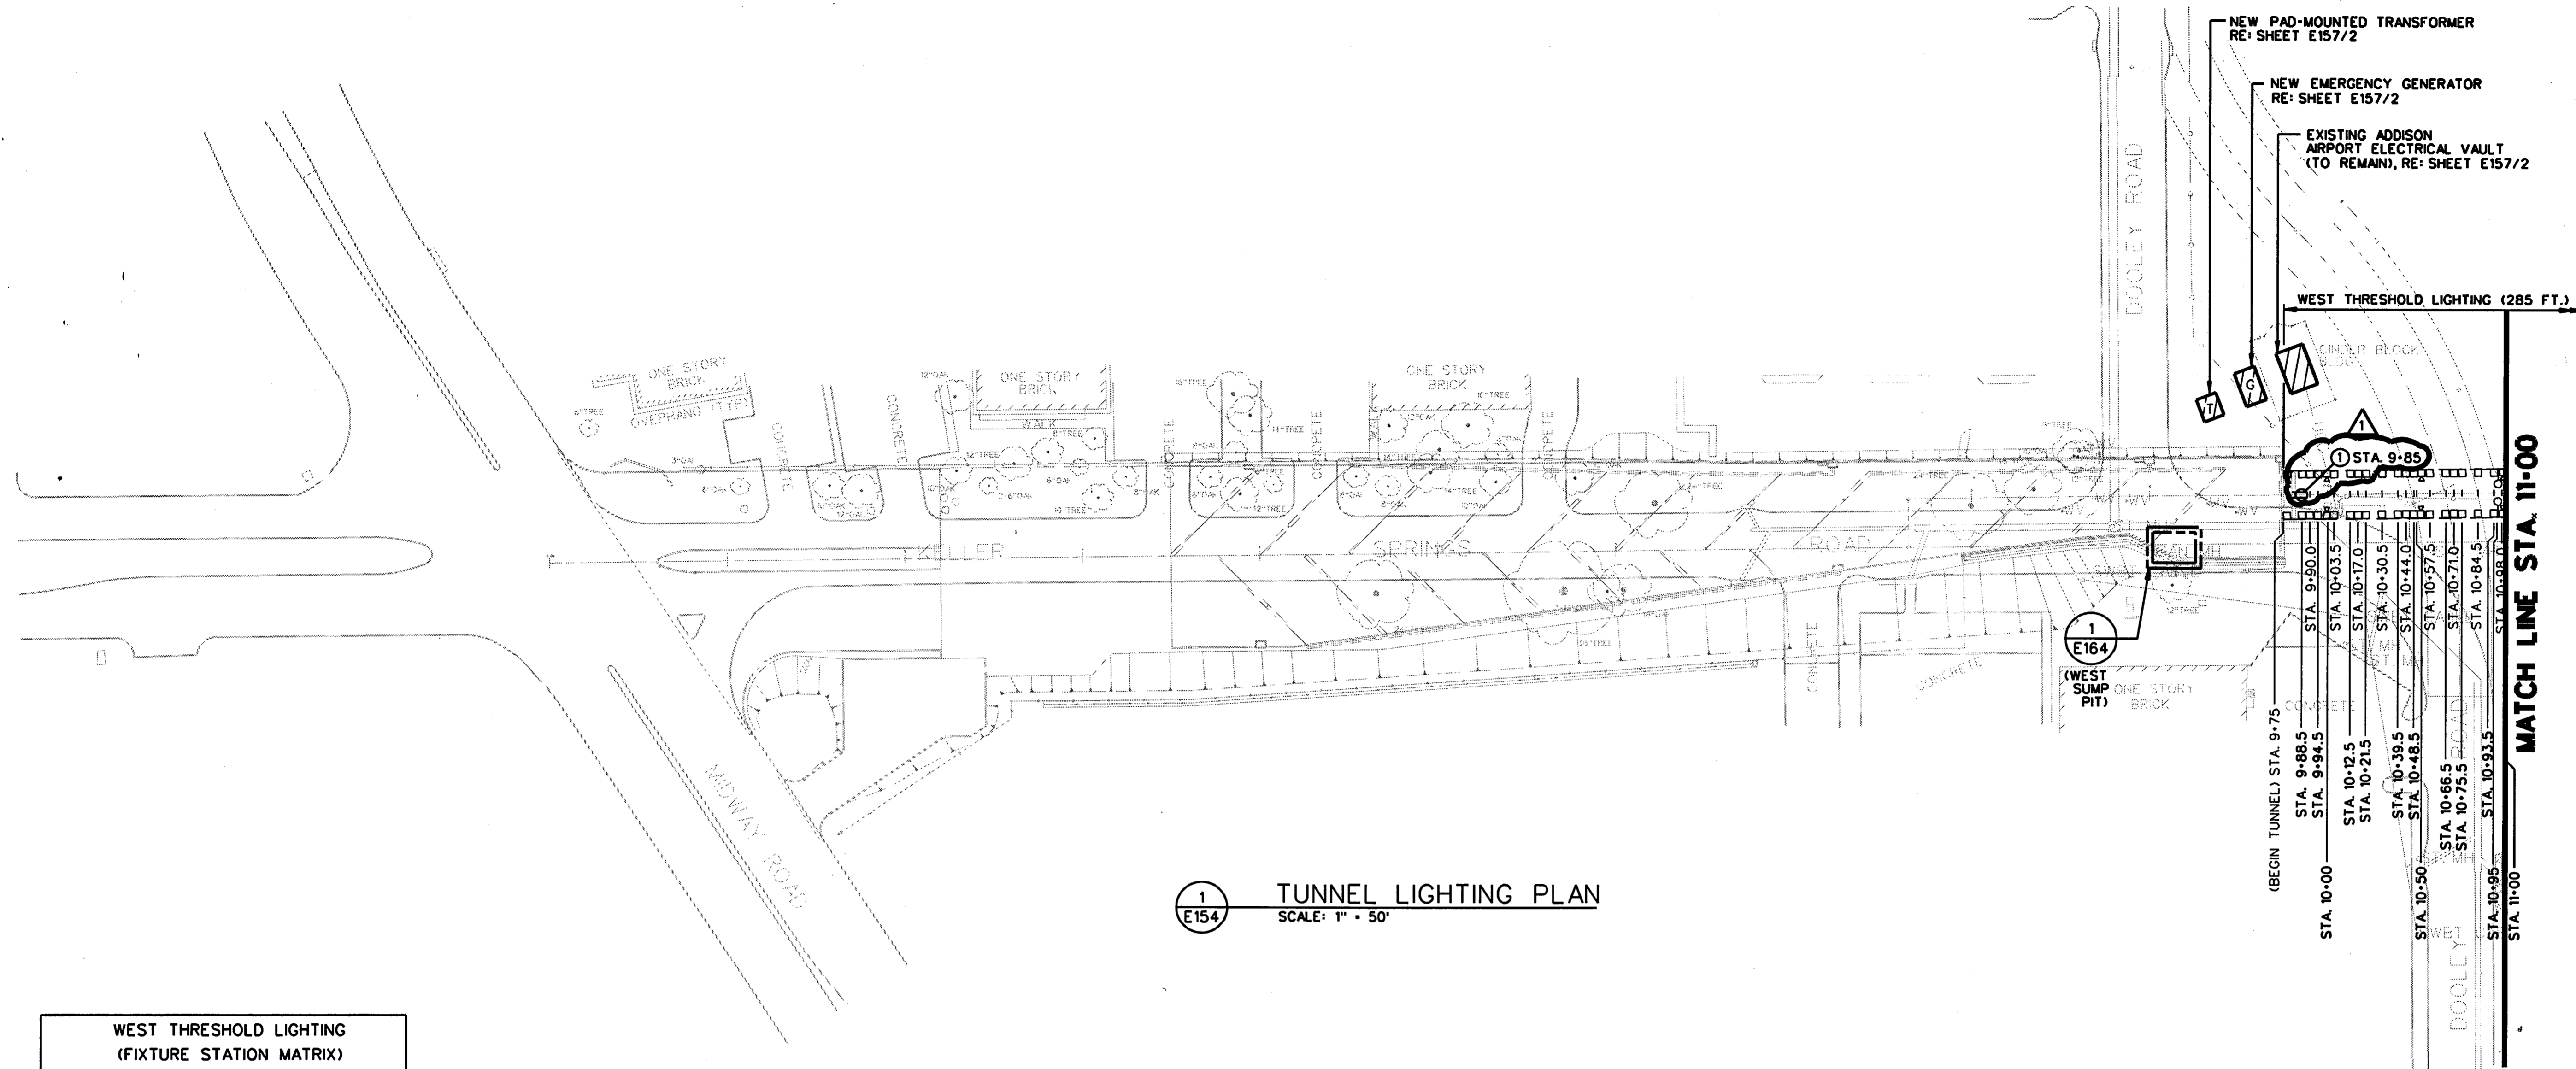

**1**  
E154 **TUNNEL LIGHTING PLAN**  
SCALE: 1" = 50'

WEST THRESHOLD LIGHTING (FIXTURE STATION MATRIX)			
STATION DESIGNATION	LIGHTING FIXTURE TYPE/ DESIGNATION	QUANTITY AT THIS STATION	BRANCH CIRCUIT
9-77.0	A	2	HWB-1/3
9-85.5	A	2	HWB-1/3
9-90.0	BR	2	HWA-1/3
9-94.5	A	2	HWB-1/3
10-00	W	2	HWA-1
10-03.5	A	2	HWB-1/3
10-12.5	A	2	HWB-1/3
10-17.0	BR	2	HWA-1/3
10-21.5	A	2	HWB-1/3
10-30.5	A	2	HWB-1/3
10-39.5	A	2	HWB-1/3
10-44.0	BR	2	HWA-1/3
10-48.5	A	2	HWB-1/3
10-50	W	2	HWA-3
10-57.5	A	2	HWB-1/3
10-66.5	A	2	HWB-5/7
10-71.0	BR	2	HWA-1/3
10-75.5	A	2	HWB-5/7
10-84.5	A	2	HWB-5/7
10-93.5	A	2	HWB-5/7
10-95.0	C	2	HWA-3
10-98.0	BR	2	HWA-1/3
11-00	W	2	HWA-1

**GENERAL NOTES:**

- A. FIXTURES SHALL BE LOCATED AT STATIONS AS SHOWN UNLESS INDICATED OTHERWISE. IN GENERAL, FIXTURE SPACING BEGINS AT BOTH THE WEST AND EAST PORTALS AND PROGRESSES TOWARDS THE TUNNEL MIDPOINT. CIRCUITING NOT INDICATED ON THIS PLAN FOR CLARITY; REFERENCE DETAIL 1/E165, "TYPICAL TUNNEL LIGHTING PLAN" FOR TYPICAL CIRCUIT.
- B. REFERENCE DETAIL 2/E166, "TYPICAL TUNNEL CONDUIT SYSTEM DETAIL" FOR GENERAL CONDUIT ROUTING INFORMATION.
- C. BRANCH CIRCUITS SERVING BOTH 480 VOLT, SINGLE-PHASE LIGHTING FIXTURES AND 277 VOLT, SINGLE-PHASE LIGHTING FIXTURES SHALL BE PROVIDED WITH NEUTRAL CONDUCTOR(S).
- D. TUNNEL LIGHTING IS REDUCED DURING NIGHT-TIME HOURS BY SWITCHING-OFF FEEDERS SERVING PANELBOARD FOR SELECTED FIXTURES. PROVIDE CONTACTOR CONTROLLED BY PHOTO-ELECTRIC CELL FOR EACH PANELBOARD INDICATED; SEE DETAIL 1/E161 AND 4/E167 FOR FURTHER INFORMATION.

**KEY NOTES:**

- ① WEATHERPROOF IG RECEPTACLE (TAYMACK #10370 OR EQUAL) FOR SECURITY CAMERA RECEPTACLE SHALL BE SERVED FROM PANELBOARD "LWA-2". EXTEND CONDUCTORS AND PROVIDE PULL BOXES AS REQUIRED. REFER TO SHEET 2/E160 FOR ADDITIONAL INFORMATION. VERIFY EXACT LOCATION WITH SECURITY CONSULTANT PRIOR TO INSTALLATION.

**FINAL RECORD  
DRAWING**  
Date: 12/25/99





THE SEAL APPEARING ON THIS DOCUMENT WAS AUTHORIZED BY LEOPOLDO F. RIOS, P.E., 58272 ON MAY 18, 1998

CHANGE ORDER		HDR		5-27-98
No.	REVISION	BY	DATE	
TEXAS TURNPIKE AUTHORITY ADDISON AIRPORT TUNNEL				
TUNNEL LIGHTING PLAN				
<b>HDR</b> HDR Engineering, Inc.				SECTION XIII
DRAWN: WTD	DATE: 12/05/96	DESIGNED: LR	DATE: 08/28/96	
CHECKED: BL	DATE: 08/28/96	SCALE: 1" = 50'		
CONTRACT No. DNT-260 SHEET E154 OF 166				

FILE: p:\additun\adgn\adtu02.dgn  
DATE: 23-Apr-96 20:01



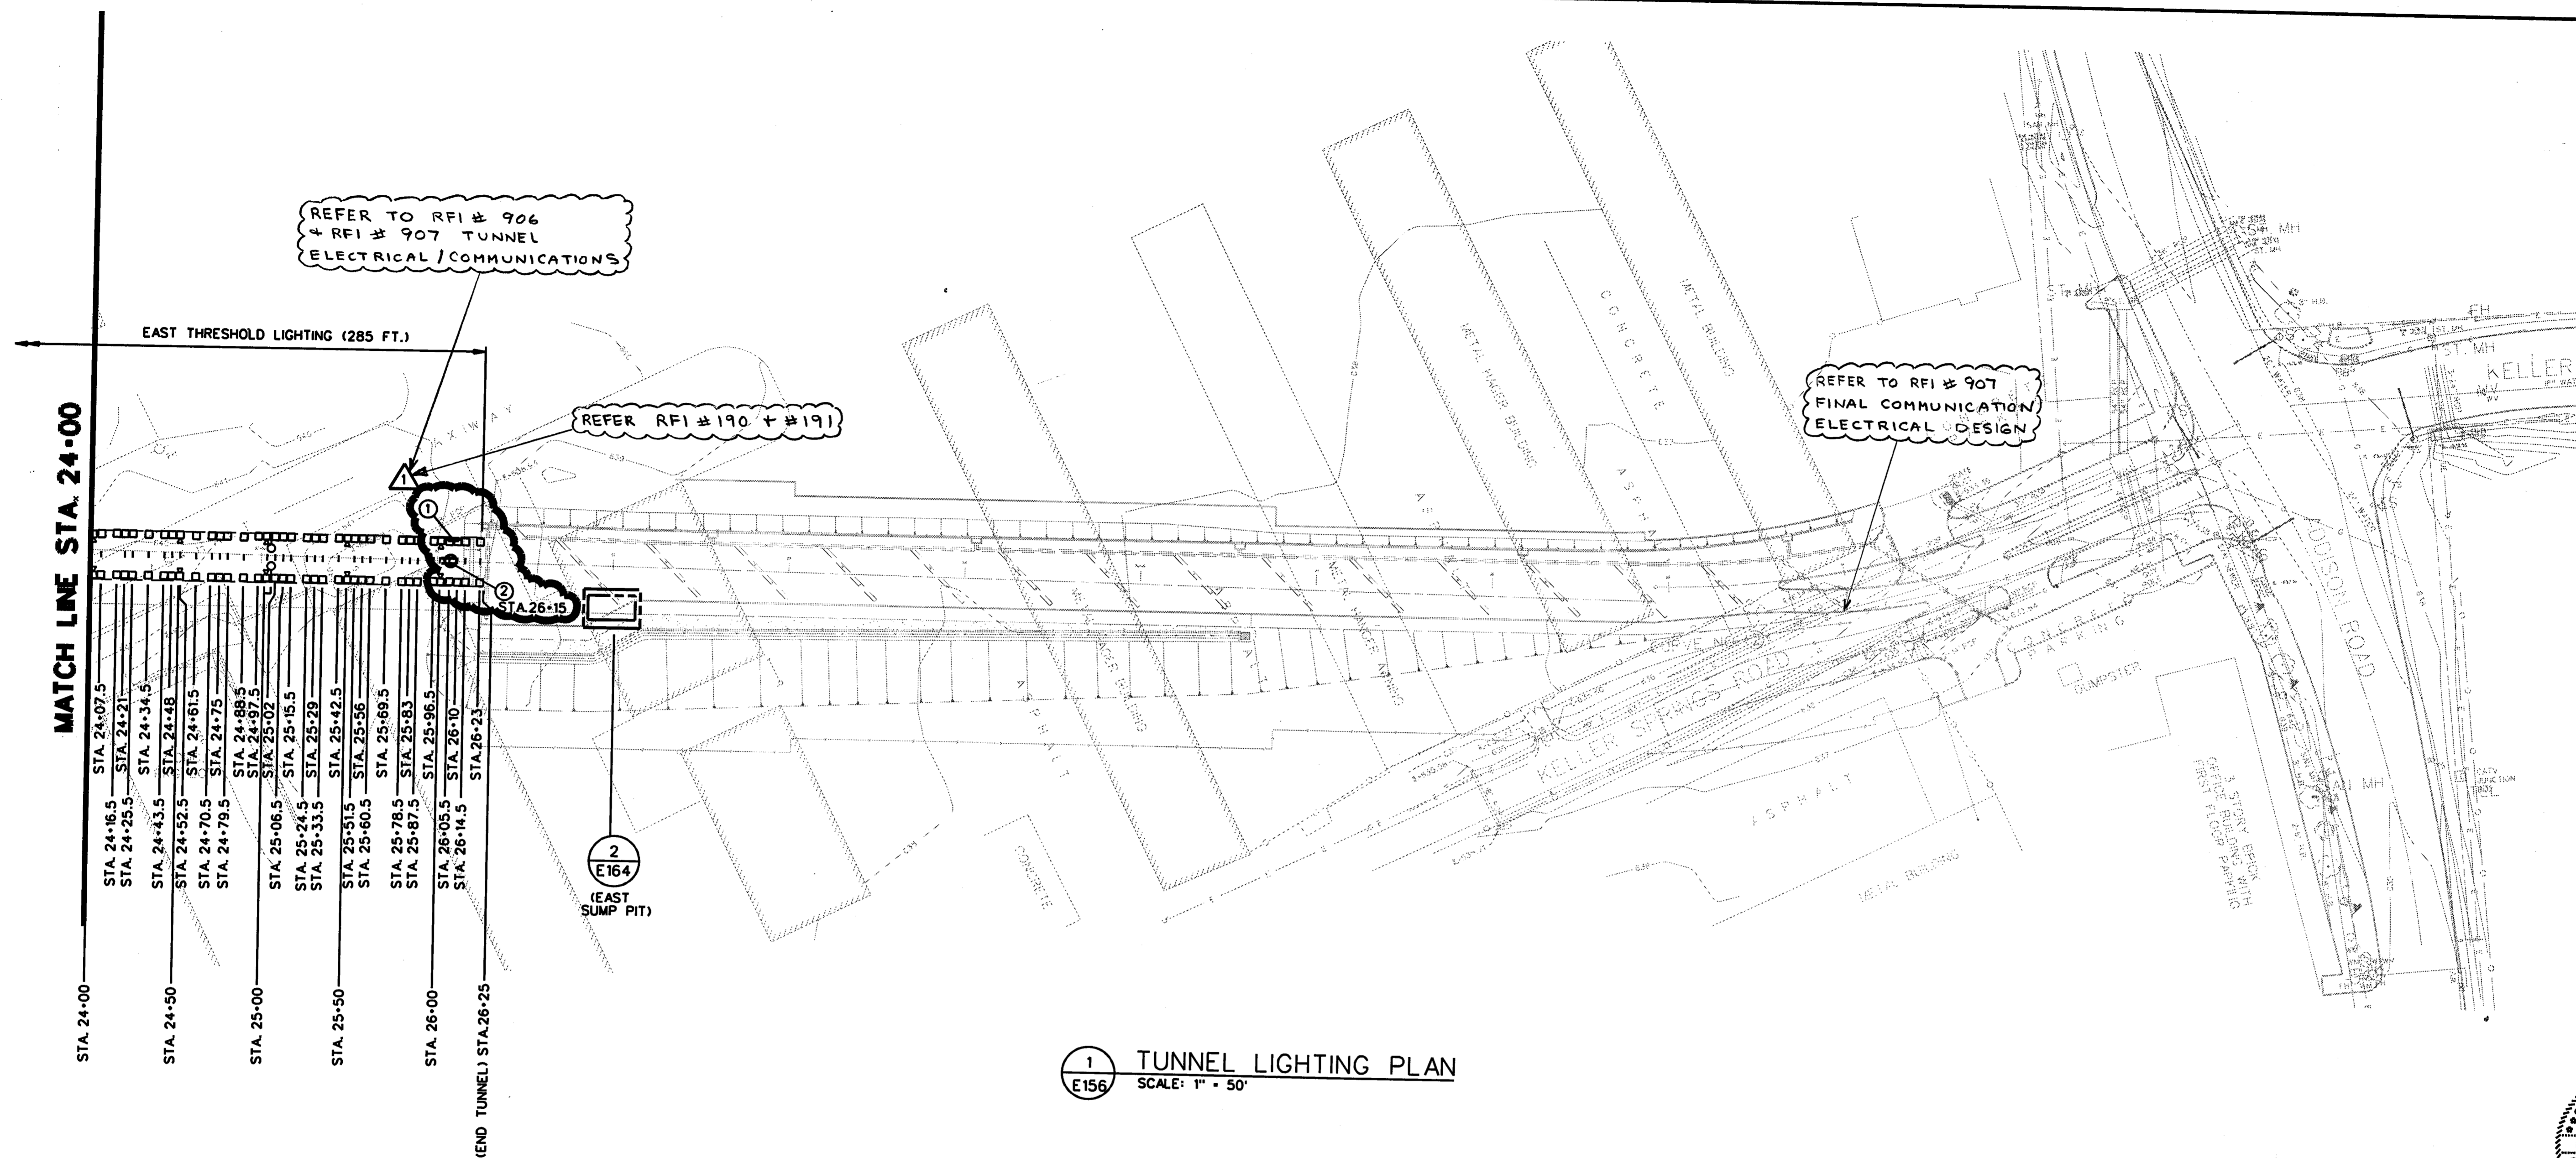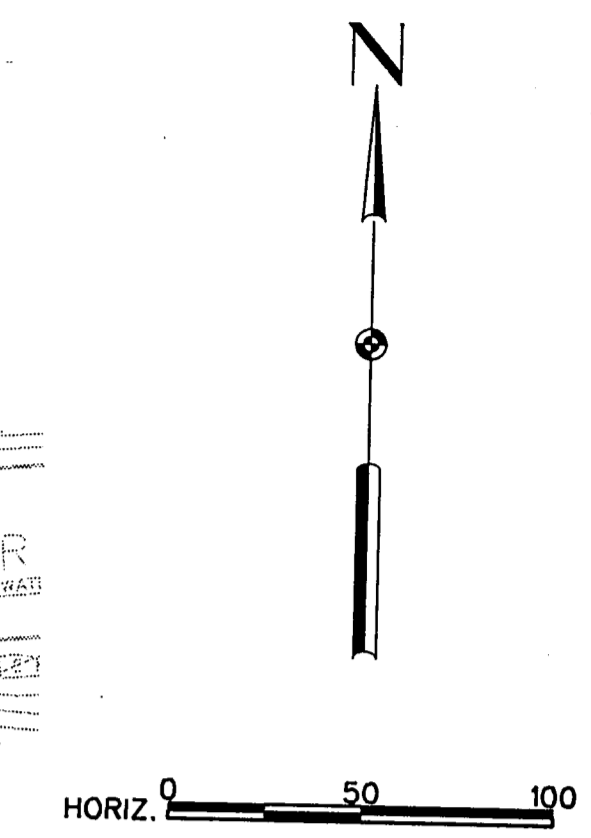

MATCH LINE STA. 24-00

STA. 24+00	STA. 24+07.5
STA. 24+16.5	STA. 24+21
STA. 24+25.5	STA. 24+34.5
STA. 24+33.5	STA. 24+48
STA. 24+43.5	STA. 24+61.5
STA. 24+52.5	STA. 24+75
STA. 24+70.5	STA. 24+88.5
STA. 24+79.5	STA. 24+97.5
STA. 25+00	STA. 25+02
STA. 25+06.5	STA. 25+15.5
STA. 25+24.5	STA. 25+29
STA. 25+33.5	STA. 25+42.5
STA. 25+51.5	STA. 25+56
STA. 25+60.5	STA. 25+69.5
STA. 25+78.5	STA. 25+83
STA. 25+87.5	STA. 25+96.5
STA. 26+05.5	STA. 26+10
STA. 26+14.5	STA. 26+23
STA. 26+25	

1 TUNNEL LIGHTING PLAN  
E156 SCALE: 1" = 50'

**GENERAL NOTES:**

- A. FIXTURES SHALL BE LOCATED AT STATIONS AS SHOWN UNLESS INDICATED OTHERWISE. IN GENERAL, FIXTURE SPACING BEGINS AT BOTH THE WEST AND EAST PORTALS AND PROGRESSES TOWARDS THE TUNNEL MIDPOINT. CIRCUITING NOT INDICATED ON THIS PLAN FOR CLARITY; REFERENCE DETAIL 1/E165, "TYPICAL TUNNEL LIGHTING PLAN" FOR TYPICAL CIRCUIT.
- B. REFERENCE DETAIL 2/E166, "TYPICAL TUNNEL CONDUIT SYSTEM DETAIL" FOR GENERAL CONDUIT ROUTING INFORMATION.
- C. BRANCH CIRCUITS SERVING BOTH 480 VOLT, SINGLE-PHASE LIGHTING FIXTURES AND 277 VOLT, SINGLE-PHASE LIGHTING FIXTURES SHALL BE PROVIDED WITH NEUTRAL CONDUCTOR(S).
- D. TUNNEL LIGHTING IS REDUCED DURING NIGHT-TIME HOURS BY SWITCHING-OFF FEEDERS SERVING PANELBOARD FOR SELECTED FIXTURES. PROVIDE CONTACTOR CONTROLLED BY PHOTO-ELECTRIC CELL FOR EACH PANELBOARD INDICATED; SEE DETAIL 1/E161 AND 4/E167 FOR FURTHER INFORMATION.

**KEY NOTES:**

- 1. 48"W x 48"H x 12"D NEMA 3R LOCKABLE ENCLOSURE WITH INTERIOR BACK PLATE MOUNTED AT STA. 26+15, 6'-0" AFF. LABEL ENCLOSURE AS "EAST" ENTRANCE SECURITY CABINET" AND PROVIDE THE FOLLOWING:
  - 1. (1) 4" CONDUIT WITH (4) 1/2" INNER-DUCTS WITH PULL STRINGS TO EAST ELECTRICAL NICHE SECURITY CABINET. REF. SHEET E160 KEY NOTE #11.
  - 2. (1) 1" CONDUIT WITH PULL STRING TO SECURITY CAMERA LOCATION. EXTEND CONDUIT TO ADDITIONAL CAMERAS AS REQUIRED BY SECURITY CONSULTANT. PROVIDE J-BOXES AS REQUIRED.
  - 3. (2) 4" CONCRETE ENCASED CONDUITS UNDERGROUND ALONG SOUTH SIDE OF KELLER SPRINGS RD. TO TU ELECTRIC UTILITY POLE LOCATED ON THE SOUTHWEST CORNER OF ADDISON RD. AND KELLER SPRINGS RD.
- 2. WEATHERPROOF I.C. RECEPTACLE (TAYMAC #10370 OR EQUAL) FOR SECURITY CAMERA RECEPTACLE SHALL BE SERVED FROM PANELBOARD "LCA-7". EXTEND CONDUCTORS AND PROVIDE PULL BOXES AS REQUIRED. REFER TO SHEET 4/E160 FOR ADDITIONAL INFORMATION. VERIFY EXACT LOCATION WITH SECURITY CONSULTANT PRIOR TO INSTALLATION.

**EAST THRESHOLD LIGHTING (FIXTURE STATION MATRIX)**

STATION DESIGNATION	LIGHTING FIXTURE TYPE/DESIGNATION	QUANTITY AT THIS STATION	BRANCH CIRCUIT
24+00	W	2	HEA-3
24+07.5	A	2	HEB-9/11
24+16.5	A	2	HEB-9/11
24+21	BR	2	HEA-1/3
24+25.5	A	2	HEB-9/11
24+34.5	A	2	HEB-9/11
24+43.5	A	2	HEB-5/7
24+48	BR	2	HEA-1/3
24+50	W	2	HEA-1
24+52.5	A	2	HEB-5/7
24+61.5	A	2	HEB-5/7
24+70.5	A	2	HEB-5/7
24+75	BR	2	HEA-1/3
24+79.5	A	2	HEB-5/7
24+88.5	A	2	HEB-5/7
24+97.5	A	2	HEB-5/7
25+00	W	2	HEA-3

**EAST THRESHOLD LIGHTING (FIXTURE STATION MATRIX)**

STATION DESIGNATION	LIGHTING FIXTURE TYPE/DESIGNATION	QUANTITY AT THIS STATION	BRANCH CIRCUIT
25+00	C	2	HEA-1
25+02	BR	2	HEA-1/3
25+06.5	A	2	HEB-5/7
25+15.5	A	2	HEB-5/7
25+24.5	A	2	HEB-5/7
25+29	BR	2	HEA-1/3
25+33.5	A	2	HEB-5/7
25+42.5	A	2	HEB-1/3
25+50	W	2	HEA-1
25+51.5	A	2	HEB-1/3
25+56	BR	2	HEA-1/3
25+60.5	A	2	HEB-1/3
25+69.5	A	2	HEB-1/3
25+78.5	A	2	HEB-1/3
25+83	BR	2	HEA-1/3
25+87.5	A	2	HEB-1/3
25+96.5	A	2	HEB-1/3
26+00	W	2	HEA-3
26+05.5	A	2	HEB-1/3
26+10	BR	2	HEA-1/3
26+14.5	A	2	HEB-1/3
26+23	A	2	HEB-1/3



THE SEAL APPEARING ON THIS DOCUMENT WAS AUTHORIZED BY LEOPOLDO F. RIOS, P.E., 58272 ON MAY 18, 1998

**FINAL RECORD DRAWING**  
Date: 12/25/99

2 REVISION PER RFI #'S 906, 1190, 191, 907

No.	REVISION	BY	DATE
	CHANGE ORDER	HDR	5-27-98

TEXAS TURNPIKE AUTHORITY  
**ADDISON AIRPORT TUNNEL**

TUNNEL LIGHTING PLANS


HDR Engineering, Inc. SECTION XIII

DRAWN: WTD DATE: 12/05/96 DESIGNED: LR DATE: 08/28/96  
CHECKED: BL DATE: 08/28/96 SCALE: 1" = 50'

CONTRACT No. DNT-260 SHEET E156 OF 166

**GENERAL NOTES:**

- A. IN GENERAL, DEVICE SPACING BEGINS AT BOTH THE EAST AND WEST ENTRIES AND PROGRESSES TOWARDS THE TUNNEL MID-POINT; DEVICE LOCATIONS SHALL BE AS INDICATED. REFERENCE MECHANICAL DRAWINGS FOR STATION LOCATIONS OF MECHANICAL EQUIPMENT AND DEVICES.
- B. SEE DETAIL 2/E165, "TYPICAL TUNNEL CONDUIT SYSTEM DETAIL" FOR GENERAL CONDUIT ROUTING/CIRCUITING INFORMATION.
- C. FIRE ALARM SYSTEM DEVICES, EMERGENCY TELEPHONE SYSTEM DEVICES AND CARBON MONOXIDE (CO) SYSTEM DEVICES SHALL BE PROVIDED WITH APPROPRIATE JUNCTION-BOXES/BACK-BOXES AND CONDUIT AS REQUIRED.
- D. REFERENCE SHEET E161 FOR BRANCH CIRCUIT/FEEDER SCHEDULE AND MOTOR FEEDER SCHEDULE FOR RESPECTIVE DESIGNATIONS SHOWN ON THIS DRAWING.
- E. INFORMATION/LOCATION OF EXISTING UTILITIES ON RELATED APPURTENANCES PROVIDED IN THESE DRAWINGS HAVE BEEN TAKEN FROM DESIGN DRAWINGS AND FIELD OBSERVATIONS. CONTRACTOR SHALL FIELD VERIFY ALL EXISTING CONDITIONS (ABOVE AND BELOW GRADE) AND LOCATION OF ALL EXISTING APPURTENANCES PRIOR TO PRICING AND COMMENCEMENT OF WORK.
- F. CONTRACTOR SHALL ASCERTAIN LOCATION, DIMENSIONS AND ELEVATIONS OF ALL EXISTING UTILITIES PRIOR TO ANY EXCAVATION REQUIRED FOR INSTALLATION OF NEW SYSTEMS.
- G. CONTRACTOR SHALL PROVIDE AND INSTALL ALL NECESSARY ELECTRICAL APPURTENANCES (JUNCTION AND PULL BOXES, ETC.) NECESSARY FOR PROPER INSTALLATION OF ELECTRICAL APPURTENANCES, CONDUITS AND EQUIPMENT.
- H. ALL IN GROUND PULL BOXES SHALL HAVE TRAFFIC RATED LID.

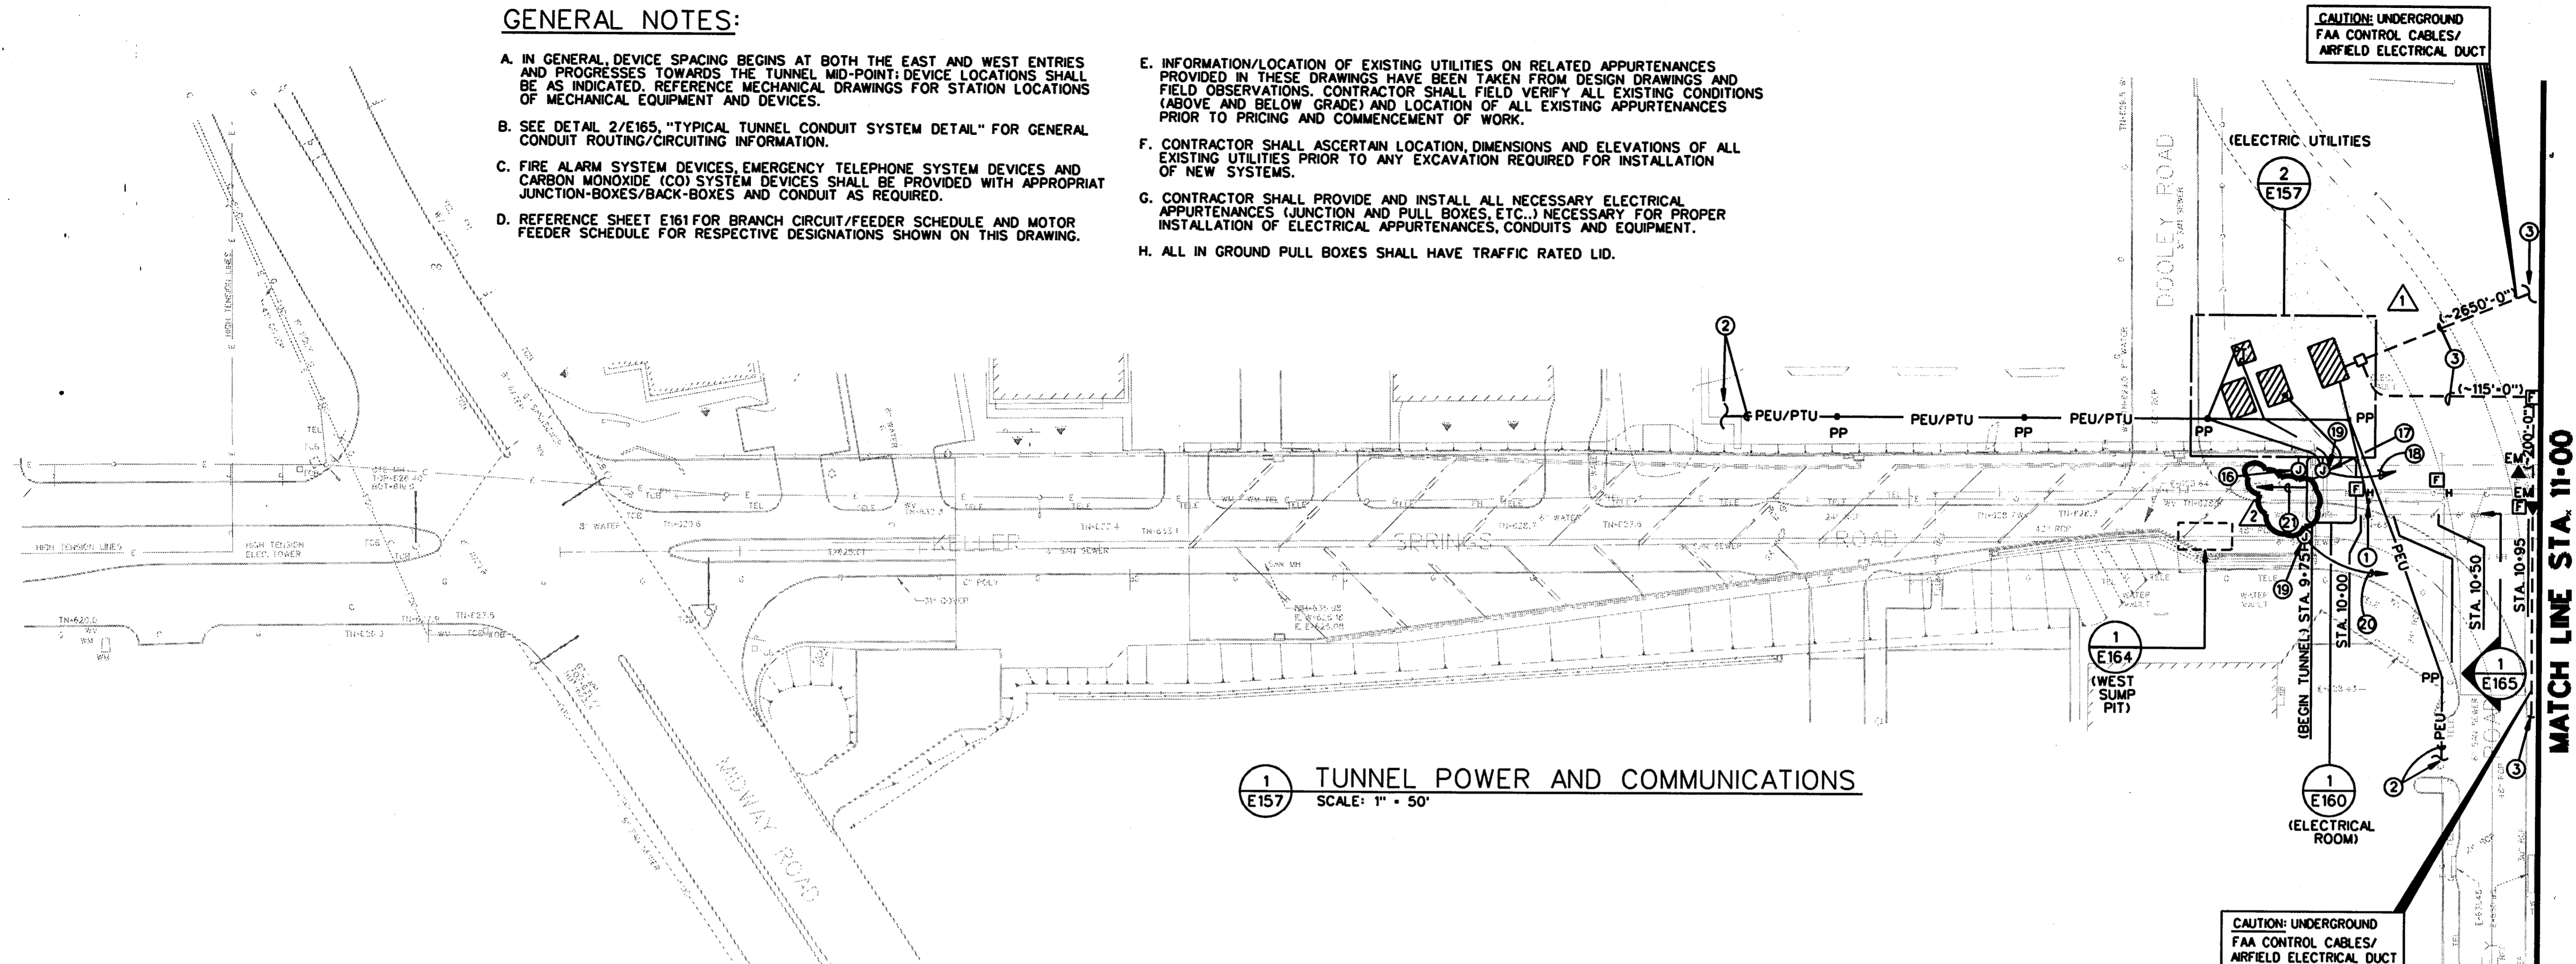


**1 TUNNEL POWER AND COMMUNICATIONS**  
SCALE: 1" = 50'

**KEY NOTES:**

- 1 EXISTING ELECTRIC UTILITY DUCTBANK TO ADDISON AIRPORT ELECTRICAL VAULT.
- 2 PROPOSED OVERHEAD PRIMARY POWER LINES BY ELECTRIC UTILITY.
- 3 EXISTING AIRFIELD HAND-HOLE/MAN-HOLE AND EXISTING UNDERGROUND FAA CONTROL CABLE/AIRFIELD ELECTRICAL DUCT TO REMAIN; COORDINATE NEW CONSTRUCTION IN THIS AREA WITH EXISTING.
- 4 PROPOSED OVERHEAD PRIMARY POWER POLE PROVIDED AND INSTALLED BY ELECTRIC UTILITY.
- 5 NEW UNDERGROUND DUCT FOR TUNNEL TELEPHONE UTILITIES.
- 6 NEW UNDERGROUND DUCT FOR TUNNEL ELECTRICAL SERVICE TO MAIN SWITCHBOARD 'MSB'.
- 7 NEW UNDERGROUND DUCTS FOR TUNNEL EMERGENCY GENERATOR ELECTRICAL SERVICE TO AUTOMATIC TRANSFER SWITCH 'ATS'.
- 8 PROPOSED PAD-MOUNTED TRANSFORMER AND WATT-HOUR METER PROVIDED AND INSTALLED BY ELECTRIC UTILITY. PROVIDE TRANSFORMER PAD IN ACCORDANCE WITH ELECTRIC UTILITY CO. STANDARDS; COORDINATE EXACT REQUIREMENTS WITH ELECTRIC UTILITY COMPANY. UNDERGROUND CONDUIT RISER FOR TRANSFORMER PRIMARY SERVICE SHALL BE PROVIDED & INSTALLED BY THE CONTRACTOR.
- 9 PROVIDE AND INSTALL EMERGENCY GENERATOR COMPLETE WITH WEATHER-PROOF HOUSING AND CONCRETE PAD; PAD SHALL EXTEND 3'-0" MINIMUM BEYOND HOUSING.
- 10 EXTEND 1-1/2" CONDUIT WITH PULL-WIRE MINIMUM TO RESPECTIVE AUTOMATIC TRANSFER SWITCH 'ATS' AND ANNUNCIATOR PANEL FOR GENERATOR CONTROL WIRING.
- 11 NOT USED.
- 12 BLOCK HEATER.
- 13 NEW UNDERGROUND TRANSFORMER PRIMARY SERVICE (2-4").
- 14 CONTRACTOR SHALL PROVIDE AND INSTALL UNISTRUT SUPPORTS FOR PROPER INSTALLATION OF THIS DEVICE INSIDE ENCLOSURE.
- 15 POWER FOR GENERATOR RECEPTACLE AND ENCLOSURE LIGHTING.
- 16 12"x12"x6" JUNCTION-BOX EMBEDDED IN WALL. REF. 568 FOR LOCATION.
- 17 STUB-OUT A 2" AND 1/2" GRS CONDUITS TO IN GROUND PULL-BOX (BROOKS CAT #38).
- 18 1/2" C. AND 2" C. TO JUNCTION BOX IN ELECTRICAL ROOM REF. SHT. E160 FOR LOCATION.
- 19 IN GROUND PULL-BOX (BROOKS CAT #38).
- 20 1/2" GRS CONDUIT TO JUNCTION BOX IN ELECTRICAL ROOM REF. SHT. E160 FOR LOCATION.

2 1-1/2" CONDUIT WITH PULL STRING ROUTED ALONG NORTH SIDE OF ROADWAY TO ADDISON TOLL PLAZA. PROVIDE PULL-BOX(ES) AS REQUIRED. REFER TO SHEET E160 FOR ADDITIONAL TOLL PLAZA REQUIREMENTS.

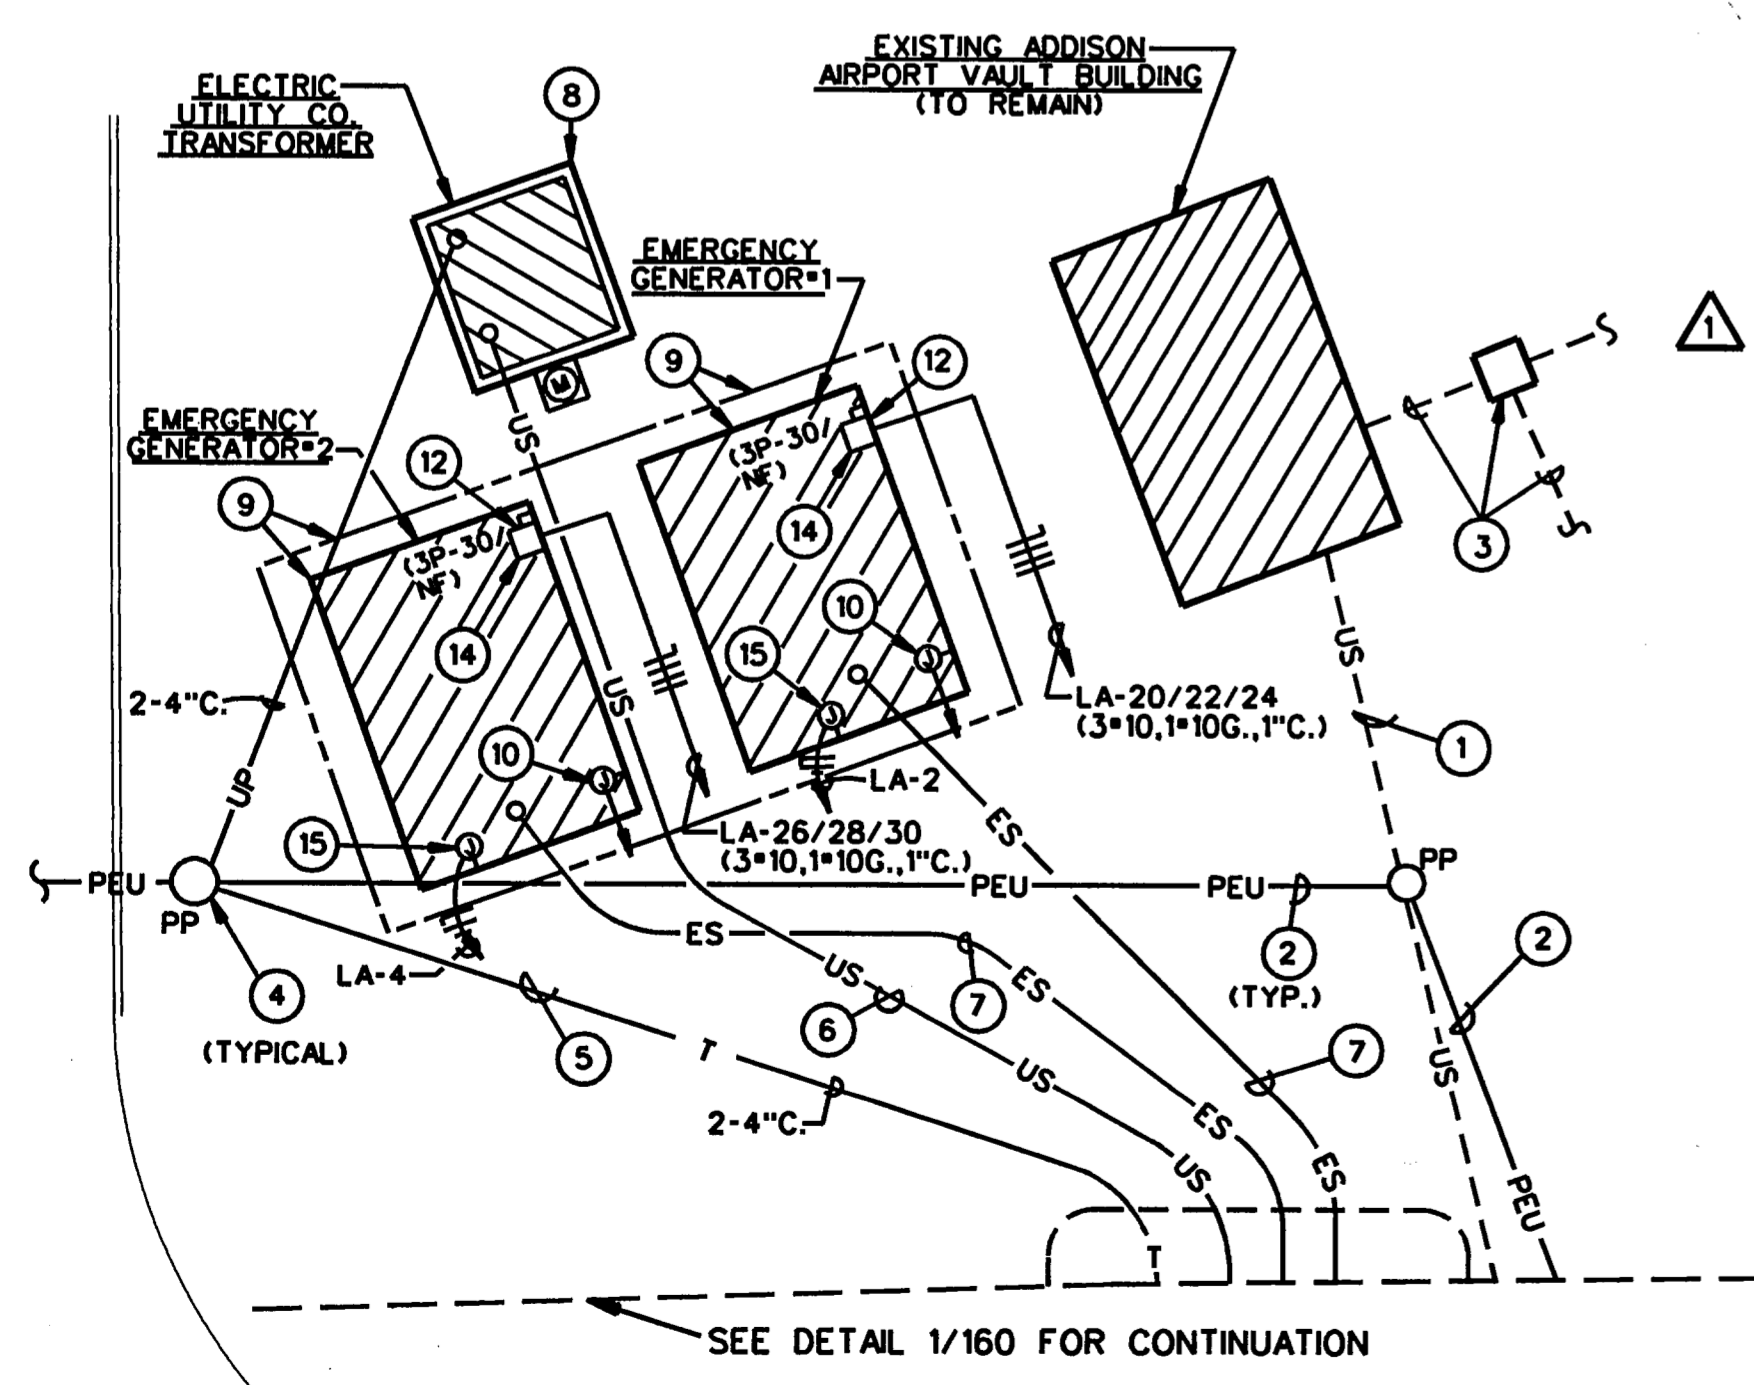

**2 PARTIAL SITE PLAN - ELECTRICAL**  
SCALE: 1" = 10'-0"



THE SEAL APPEARING ON THIS DOCUMENT WAS AUTHORIZED BY LEOPOLDO F. RIOS, P.E., 58272 ON MAY 18, 1998

**FINAL RECORD DRAWING**  
Date: 12/25/99

CHANGE ORDER	HDR	5-27-98
ADDENDUM No.1	HDR	2-12-97

No.	REVISION	BY	DATE
TEXAS TURNPIKE AUTHORITY ADDISON AIRPORT TUNNEL			

**TUNNEL POWER AND COMMUNICATIONS PLANS**



**HDR** HDR Engineering, Inc. SECTION XIII

DRAWN: WTD DATE: 12/05/96 DESIGNED: LR DATE: 08/28/98  
CHECKED: BL DATE: 08/28/96 SCALE: 1" = 50'

CONTRACT No. DNT-260 SHEET E157 OF 166

STATION DESIGNATION	DEVICE/DESIGNATION	QUANTITY AT THIS STATION	BRANCH CIRCUIT (WHERE APPLICABLE)
10-00	F <sub>H</sub>	1	N/A
10-50	F <sub>H</sub>	1	N/A
10-95	F	2	N/A
10-95	EM	2	N/A

FILE: p:\additun\dgn\aditue05.dgn DATE: 23-Apr-96 20:01

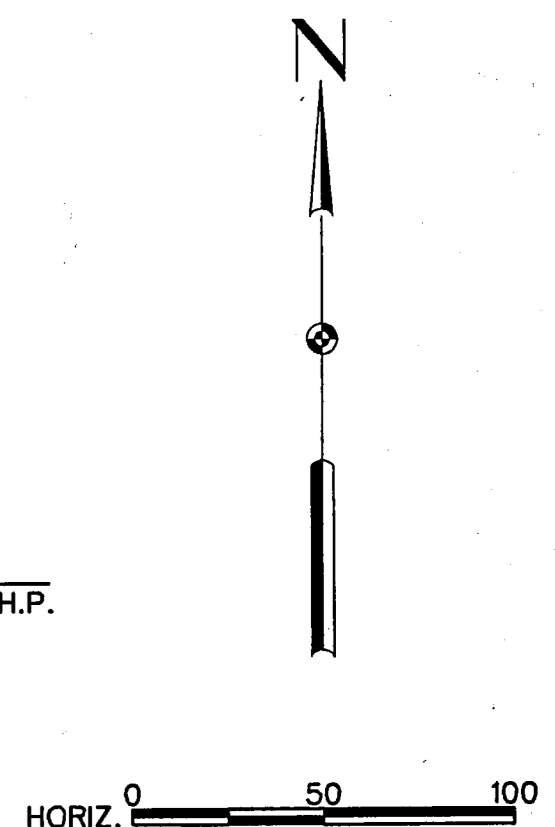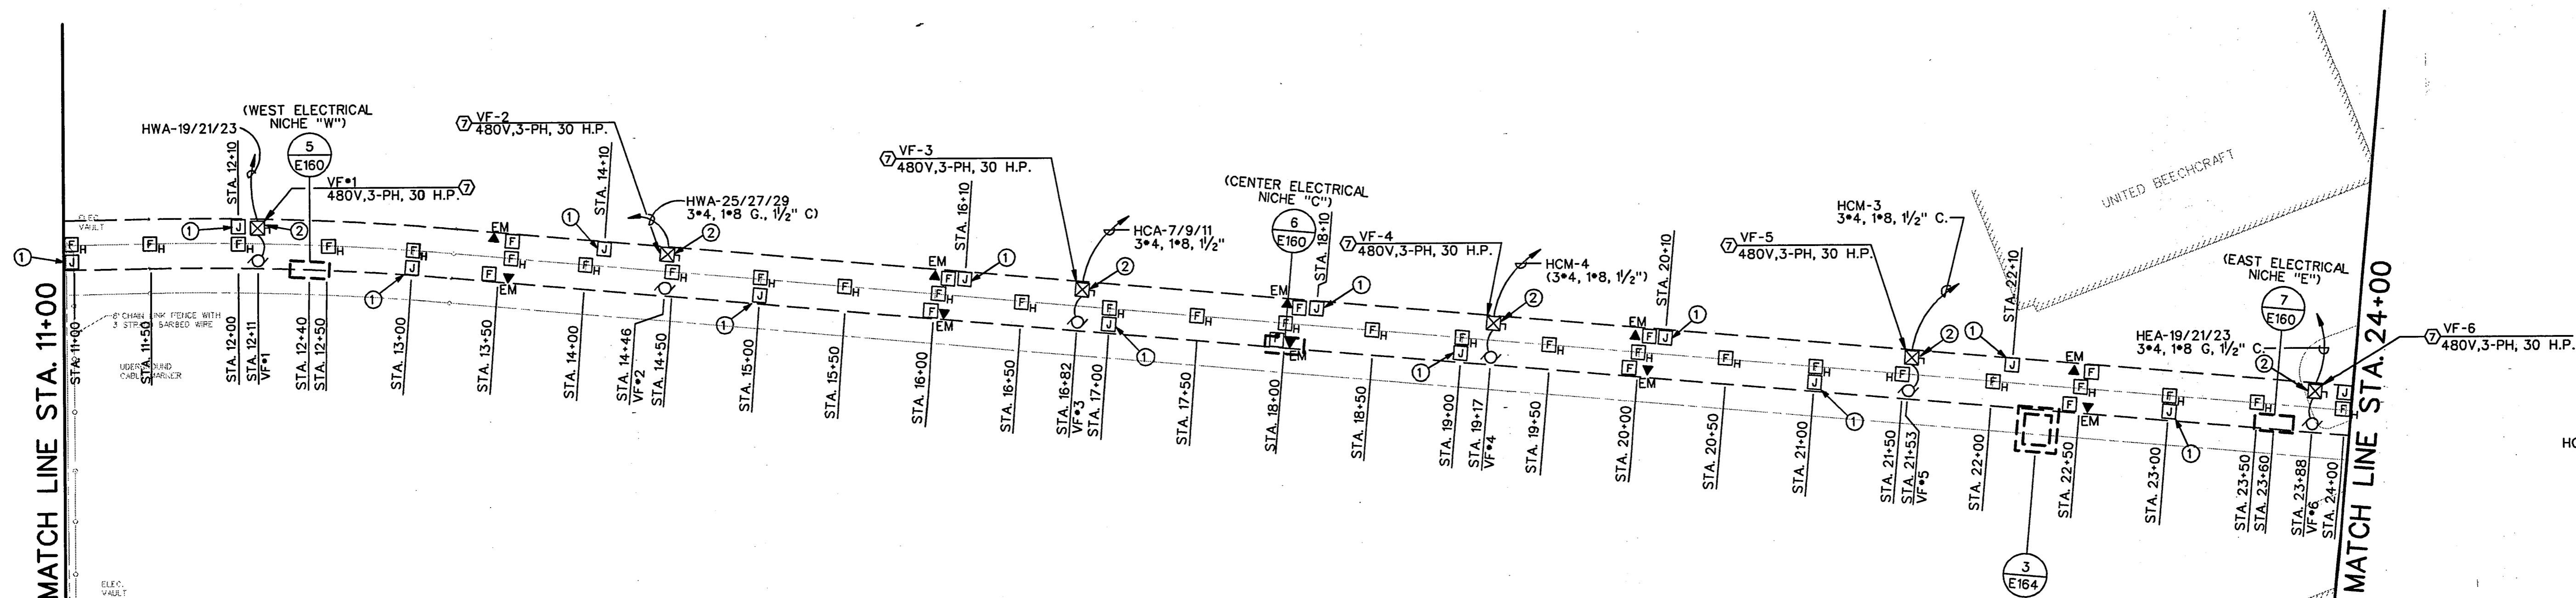

1 TUNNEL POWER AND COMMUNICATION PLAN  
 SCALE: 1" = 50'

DEVICE STATION MATRIX			
STATION DESIGNATION	DEVICE DESIGNATION	QUANTITY AT THIS STATION	BRANCH CIRCUIT (WHERE APPLICABLE)
11+00	F <sub>H</sub>	1	N/A
11+50	F <sub>H</sub>	1	N/A
12+00	F <sub>H</sub>	1	N/A
12+50	F <sub>H</sub>	1	N/A
13+00	F <sub>H</sub>	1	N/A
13+50	F	2	N/A
13+50	EM	2	N/A
13+50	F <sub>H</sub>	1	N/A
14+00	F <sub>H</sub>	1	N/A
14+50	F <sub>H</sub>	1	N/A
15+00	F <sub>H</sub>	1	N/A
15+50	F <sub>H</sub>	1	N/A
16+00	F	2	N/A
16+00	EM	2	N/A
16+00	F <sub>H</sub>	1	N/A
16+50	F <sub>H</sub>	1	N/A
17+00	F <sub>H</sub>	1	N/A
17+50	F <sub>H</sub>	1	N/A
18+00	F	2	N/A
18+00	EM	2	N/A
18+00	F <sub>H</sub>	1	N/A
18+50	F <sub>H</sub>	1	N/A
19+00	F <sub>H</sub>	1	N/A
19+50	F <sub>H</sub>	1	N/A
20+00	F	2	N/A
20+00	EM	2	N/A
20+00	F <sub>H</sub>	1	N/A
20+50	F <sub>H</sub>	1	N/A
21+00	F <sub>H</sub>	1	N/A
21+50	F <sub>H</sub>	1	N/A
22+00	F <sub>H</sub>	1	N/A
22+50	F	2	N/A
22+50	EM	2	N/A
22+50	F <sub>H</sub>	1	N/A
23+00	F <sub>H</sub>	1	N/A
23+50	F <sub>H</sub>	1	N/A
24+00	F <sub>H</sub>	1	N/A

**GENERAL NOTES:**

- A. IN GENERAL, DEVICE SPACING BEGINS AT BOTH THE EAST AND WEST ENTRIES AND PROGRESSES TOWARDS THE TUNNEL MID-POINT; DEVICE LOCATIONS SHALL BE AS INDICATED. REFERENCE MECHANICAL DRAWINGS FOR STATION LOCATIONS OF MECHANICAL EQUIPMENT AND DEVICES.
- B. SEE DETAIL 2/E165, "TYPICAL TUNNEL CONDUIT SYSTEM DETAIL" FOR GENERAL CONDUIT ROUTING/CIRCUITING INFORMATION.
- C. FIRE ALARM SYSTEM DEVICES, EMERGENCY TELEPHONE SYSTEM DEVICES AND CARBON MONOXIDE (CO) SYSTEM DEVICES SHALL BE PROVIDED WITH APPROPRIATE JUNCTION-BOXES/BACK-BOXES AND CONDUIT AS REQUIRED.
- D. REFERENCE SHEET E161 FOR BRANCH CIRCUIT/FEDER SCHEDULE AND MOTOR FEDER SCHEDULE FOR RESPECTIVE DESIGNATIONS SHOWN ON THIS DRAWING.
- E. INFORMATION/LOCATION OF EXISTING UTILITIES ON RELATED APPURTENANCES PROVIDED IN THESE DRAWINGS HAVE BEEN TAKEN FROM DESIGN DRAWINGS AND FIELD OBSERVATIONS. CONTRACTOR SHALL FIELD VERIFY ALL EXISTING CONDITIONS (ABOVE AND BELOW GRADE) AND LOCATION OF ALL EXISTING APPURTENANCES PRIOR TO PRICING AND COMMENCEMENT OF WORK.
- F. CONTRACTOR SHALL ASCERTAIN LOCATION, DIMENSIONS AND ELEVATIONS OF ALL EXISTING UTILITIES PRIOR TO ANY EXCAVATION REQUIRED FOR INSTALLATION OF NEW SYSTEMS.
- G. CONTRACTOR SHALL PROVIDE AND INSTALL ALL NECESSARY ELECTRICAL APPURTENANCES (JUNCTION AND PULL BOXES, ETC.) NECESSARY FOR PROPER INSTALLATION OF ELECTRICAL APPURTENANCES, CONDUITS AND EQUIPMENT.

**KEY NOTES:**

- ① CARBON MONOXIDE (CO) SENSOR/DETECTOR PROVIDED AND INSTALLED BY MECHANICAL CONTRACTOR; FURNISH AND INSTALL JUNCTION-BOX/BACK-BOX AND CONDUIT RACEWAY SYSTEM AS REQUIRED (STANDARD 4" J-BOXES INTERCONNECTED BY 1" CONDUIT WITH PULL-WIRE MINIMUM AND EXTENDED TO 'CO' PANEL LOCATED AT ELECTRICAL ROOM); SEE MECHANICAL DRAWINGS FOR FURTHER INFORMATION.
- ② COMBINATION MOTOR STARTER PROVIDED AND INSTALLED BY THE MECHANICAL CONTRACTOR.




THE SEAL APPEARING ON THIS DOCUMENT WAS AUTHORIZED BY LEOPOLDO F. RIOS, P.E., 58272 ON SEPTEMBER 9, 1996

**FINAL RECORD DRAWING**  
 Date: 12/25/99

No.	REVISION	BY	DATE
TEXAS TURNPIKE AUTHORITY ADDISON AIRPORT TUNNEL			
TUNNEL POWER AND COMMUNICATION PLANS			
HDR Engineering, Inc.			SECTION XIII
DRAWN: WTD	DATE: 12/05/96	DESIGNED: LR	DATE: 08/28/96
CHECKED: BL	DATE: 08/28/96	SCALE:	1" = 50'
CONTRACT No. DNT-260 SHEET E158 OF 166			



MATCH LINE STA. 24+00

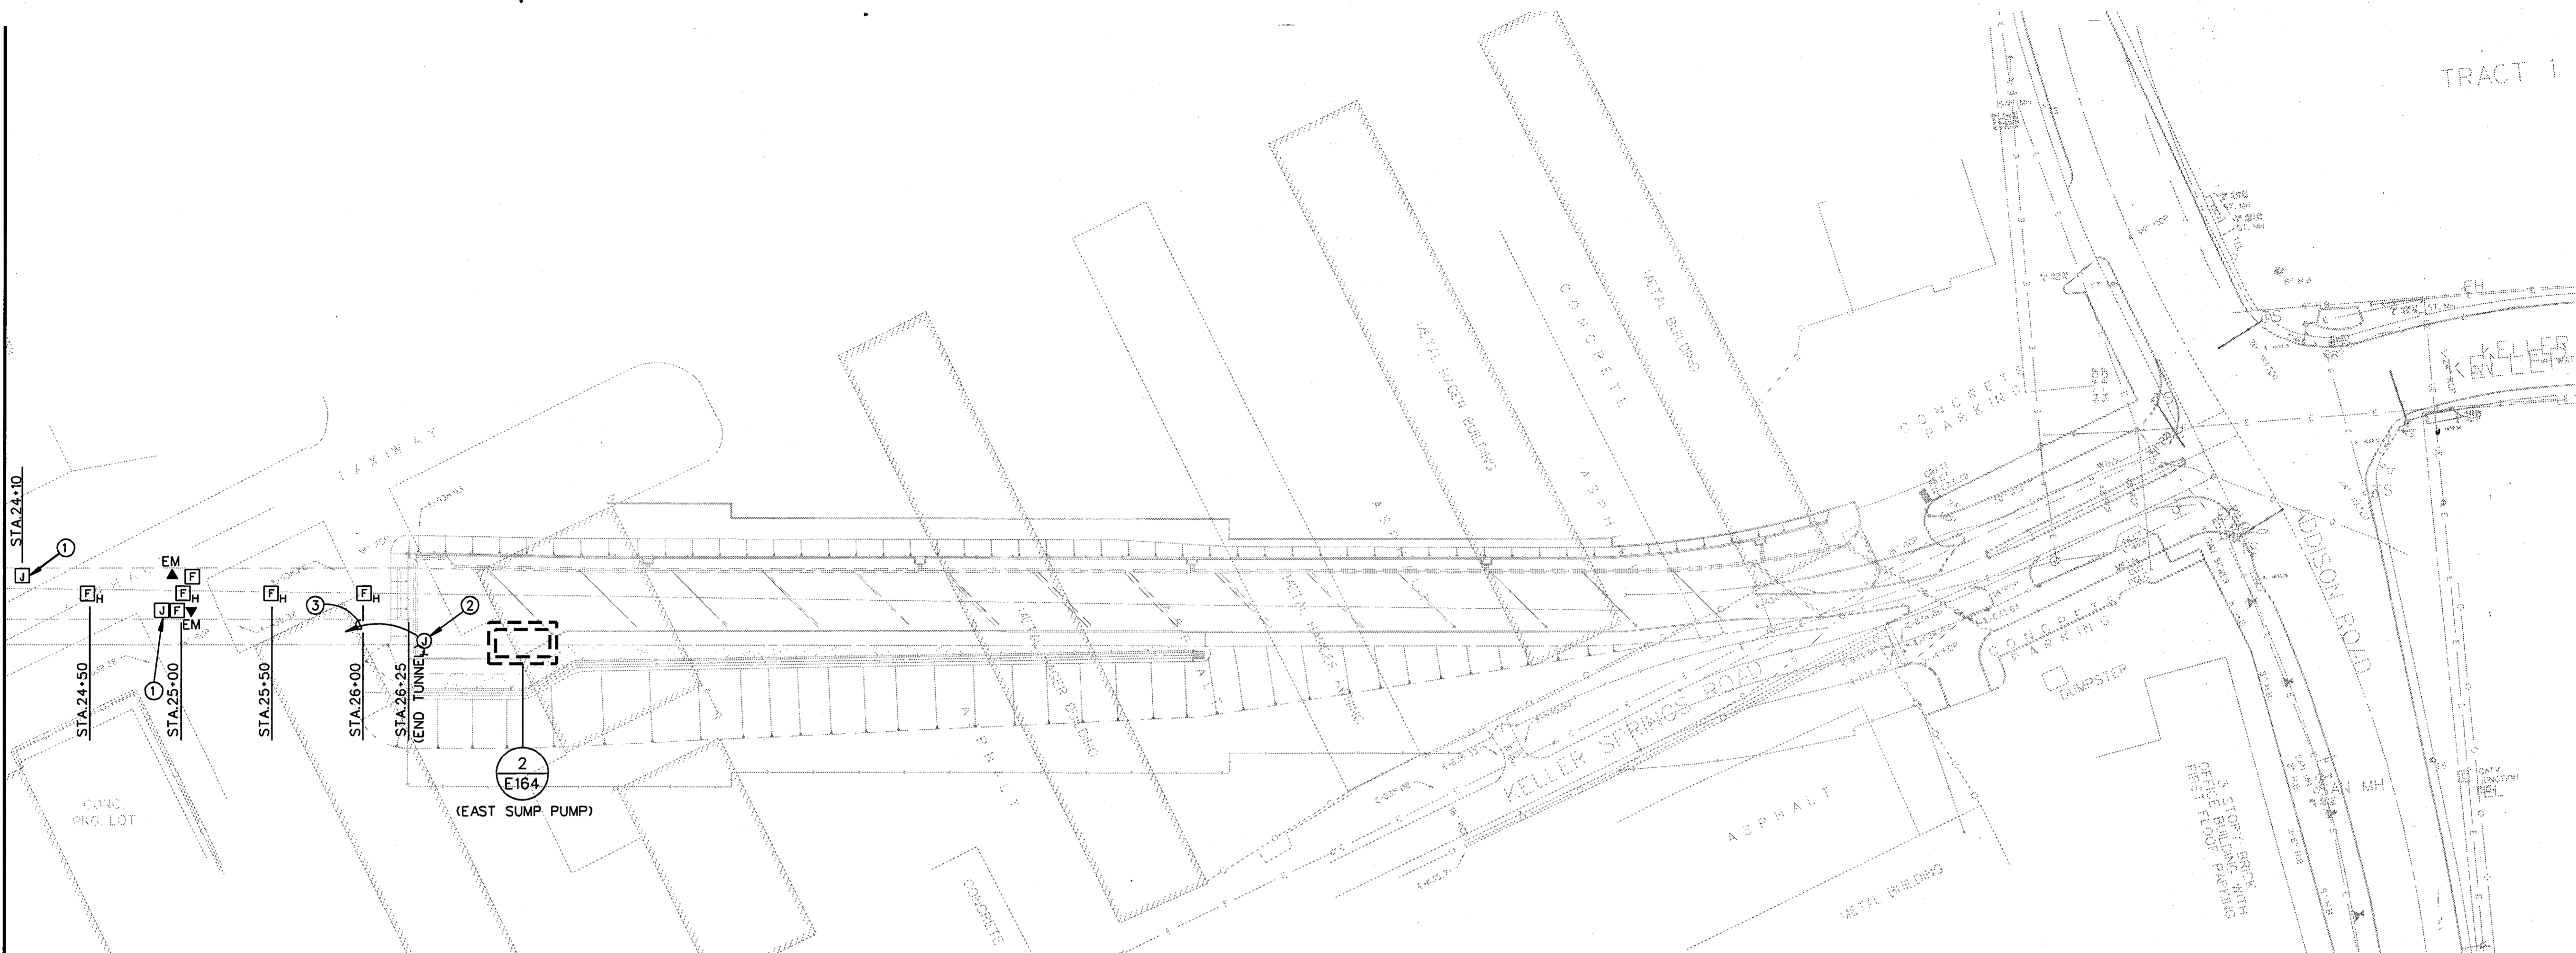

**1 POWER AND COMMUNICATION PLAN**  
 SCALE: 1" = 50'

**GENERAL NOTES:**

- A. IN GENERAL, DEVICE SPACING BEGINS AT BOTH THE EAST AND WEST ENTRIES AND PROGRESSES TOWARDS THE TUNNEL MID-POINT; DEVICE LOCATIONS SHALL BE AS INDICATED. REFERENCE MECHANICAL DRAWINGS FOR STATION LOCATIONS OF MECHANICAL EQUIPMENT AND DEVICES.
- B. SEE DETAIL 2/E165, "TYPICAL TUNNEL CONDUIT SYSTEM DETAIL" FOR GENERAL CONDUIT ROUTING/CIRCUITING INFORMATION.
- C. FIRE ALARM SYSTEM DEVICES, EMERGENCY TELEPHONE SYSTEM DEVICES AND CARBON MONOXIDE (CO) SYSTEM DEVICES SHALL BE PROVIDED WITH APPROPRIATE JUNCTION-BOXES/BACK-BOXES AND CONDUIT AS REQUIRED.
- D. REFERENCE SHEET E161 FOR BRANCH CIRCUIT/FEEDER SCHEDULE AND MOTOR FEEDER SCHEDULE FOR RESPECTIVE DESIGNATIONS SHOWN ON THIS DRAWING.
- E. INFORMATION/LOCATION OF EXISTING UTILITIES ON RELATED APPURTENANCES PROVIDED IN THESE DRAWINGS HAVE BEEN TAKEN FROM DESIGN DRAWINGS AND FIELD OBSERVATIONS. CONTRACTOR SHALL FIELD VERIFY ALL EXISTING CONDITIONS (ABOVE AND BELOW GRADE) AND LOCATION OF ALL EXISTING APPURTENANCES PRIOR TO PRICING AND COMMENCEMENT OF WORK.
- F. CONTRACTOR SHALL ASCERTAIN LOCATION, DIMENSIONS AND ELEVATIONS OF ALL EXISTING UTILITIES PRIOR TO ANY EXCAVATION REQUIRED FOR INSTALLATION OF NEW SYSTEMS.
- G. CONTRACTOR SHALL PROVIDE AND INSTALL ALL NECESSARY ELECTRICAL APPURTENANCES (JUNCTION AND PULL BOXES, ETC.) NECESSARY FOR PROPER INSTALLATION OF ELECTRICAL APPURTENANCES, CONDUITS AND EQUIPMENT.

DEVICE STATION MATRIX			
STATION DESIGNATION	DEVICE/DESIGNATION	QUANTITY AT THIS STATION	BRANCH CIRCUIT (WHERE APPLICABLE)
24+50	F <sub>H</sub>	1	N/A
25+00	F	2	N/A
25+00	EM	2	N/A
25+00	F <sub>H</sub>	1	N/A
25+50	F <sub>H</sub>	1	N/A
26+00	F <sub>H</sub>	1	N/A

**KEY NOTES:**


- ① CARBON MONOXIDE (CO) SENSOR/DETECTOR PROVIDED AND INSTALLED BY MECHANICAL CONTRACTOR; FURNISH AND INSTALL JUNCTION-BOX/BACK-BOX AND CONDUIT RACEWAY SYSTEM AS REQUIRED (STANDARD 4" J-BOXES INTERCONNECTED BY 1" CONDUIT WITH PULL-WIRE MINIMUM AND EXTENDED TO 'CO' PANEL LOCATED AT ELECTRICAL ROOM); SEE MECHANICAL DRAWINGS FOR FURTHER INFORMATION.
- ② IN GROUND PULL-BOX (BROOKS CAT#38) REFERENCE SHEET T130 FOR LOCATION.
- ③ 1/2" C. TO JUNCTION-BOX IN EAST ELECTRICAL NICHE 'E'.




THE SEAL APPEARING ON THIS DOCUMENT WAS AUTHORIZED BY LEOPOLDO F. RIOS, P.E., 58272 ON SEPTEMBER 9, 1996

**FINAL RECORD DRAWING**  
 Date: 12/25/99


No.	REVISION	BY	DATE
TEXAS TURNPIKE AUTHORITY ADDISON AIRPORT TUNNEL			
TUNNEL POWER AND COMMUNICATION PLANS			
HDR Engineering, Inc.			SECTION XIII
DRAWN: WTD	DATE: 12/05/96	DESIGNED: LR	DATE: 08/28/96
CHECKED: BL	DATE: 08/28/96	SCALE: 1" = 50'	
CONTRACT No. DNT-260 SHEET E159 OF 166			

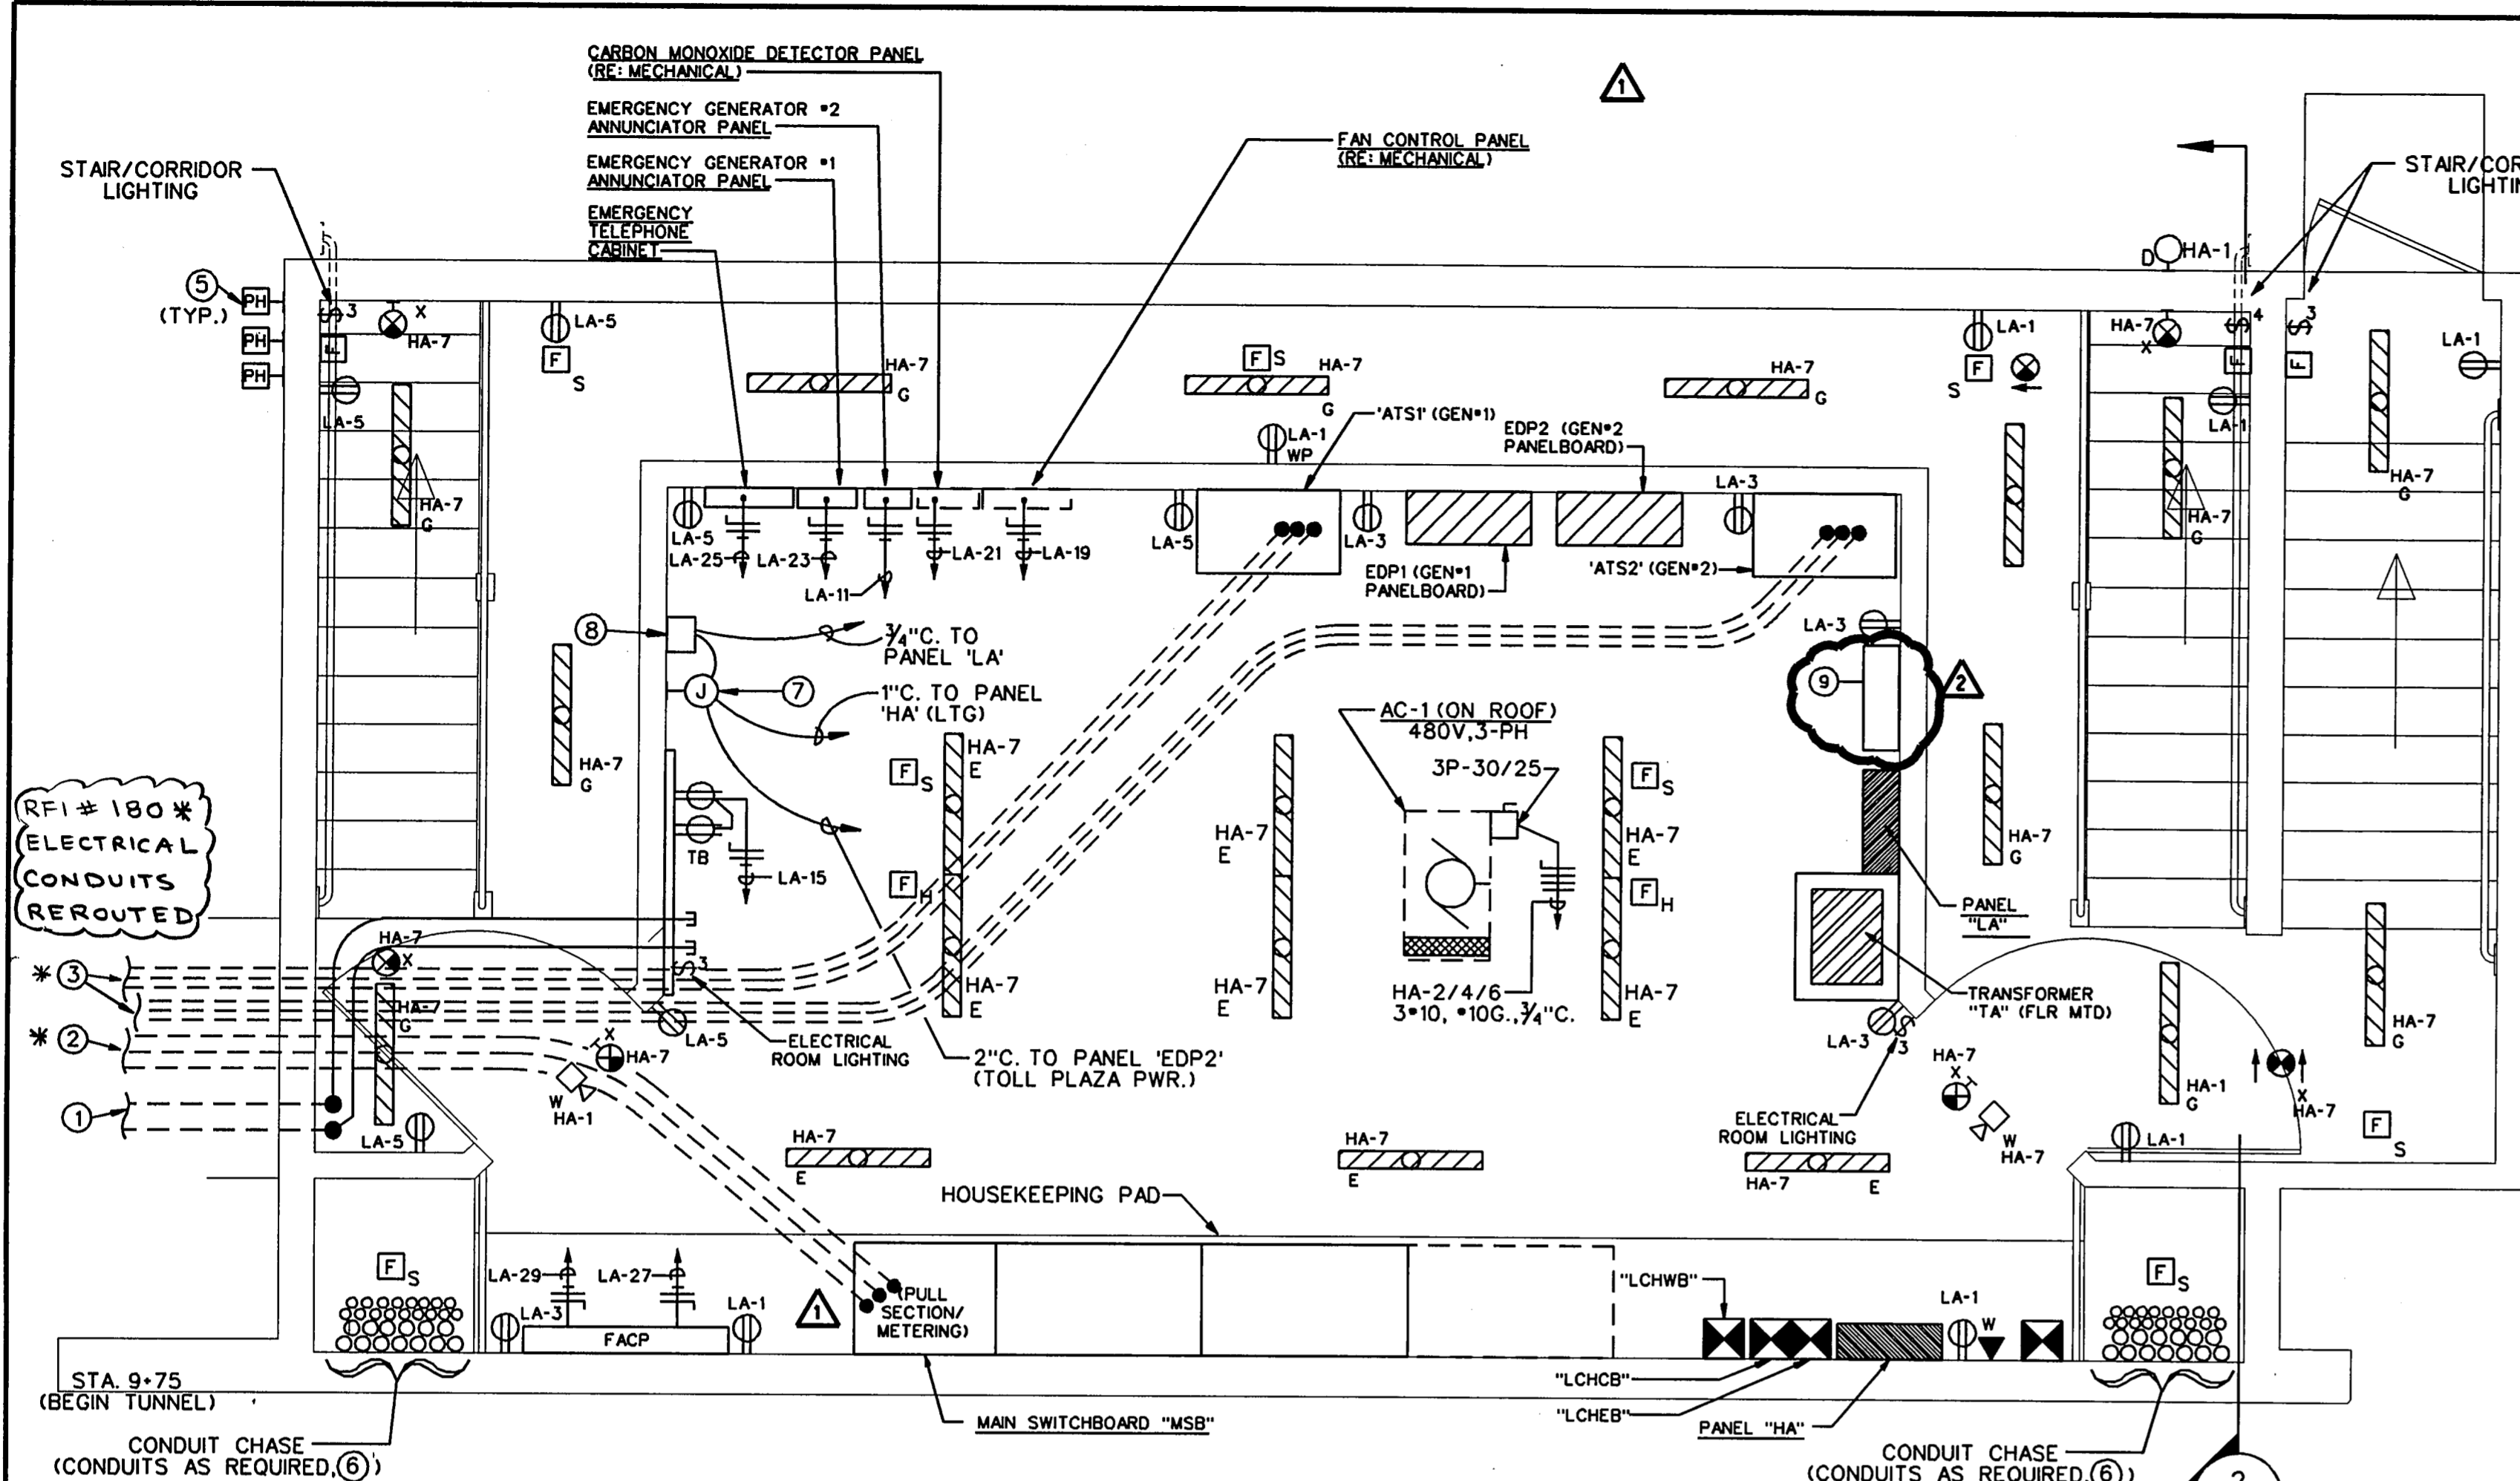


1 ELECTRICAL ROOM - POWER/LIGHTING PLAN  
E160 SCALE: 3/8" = 1'-0"  
NORTH

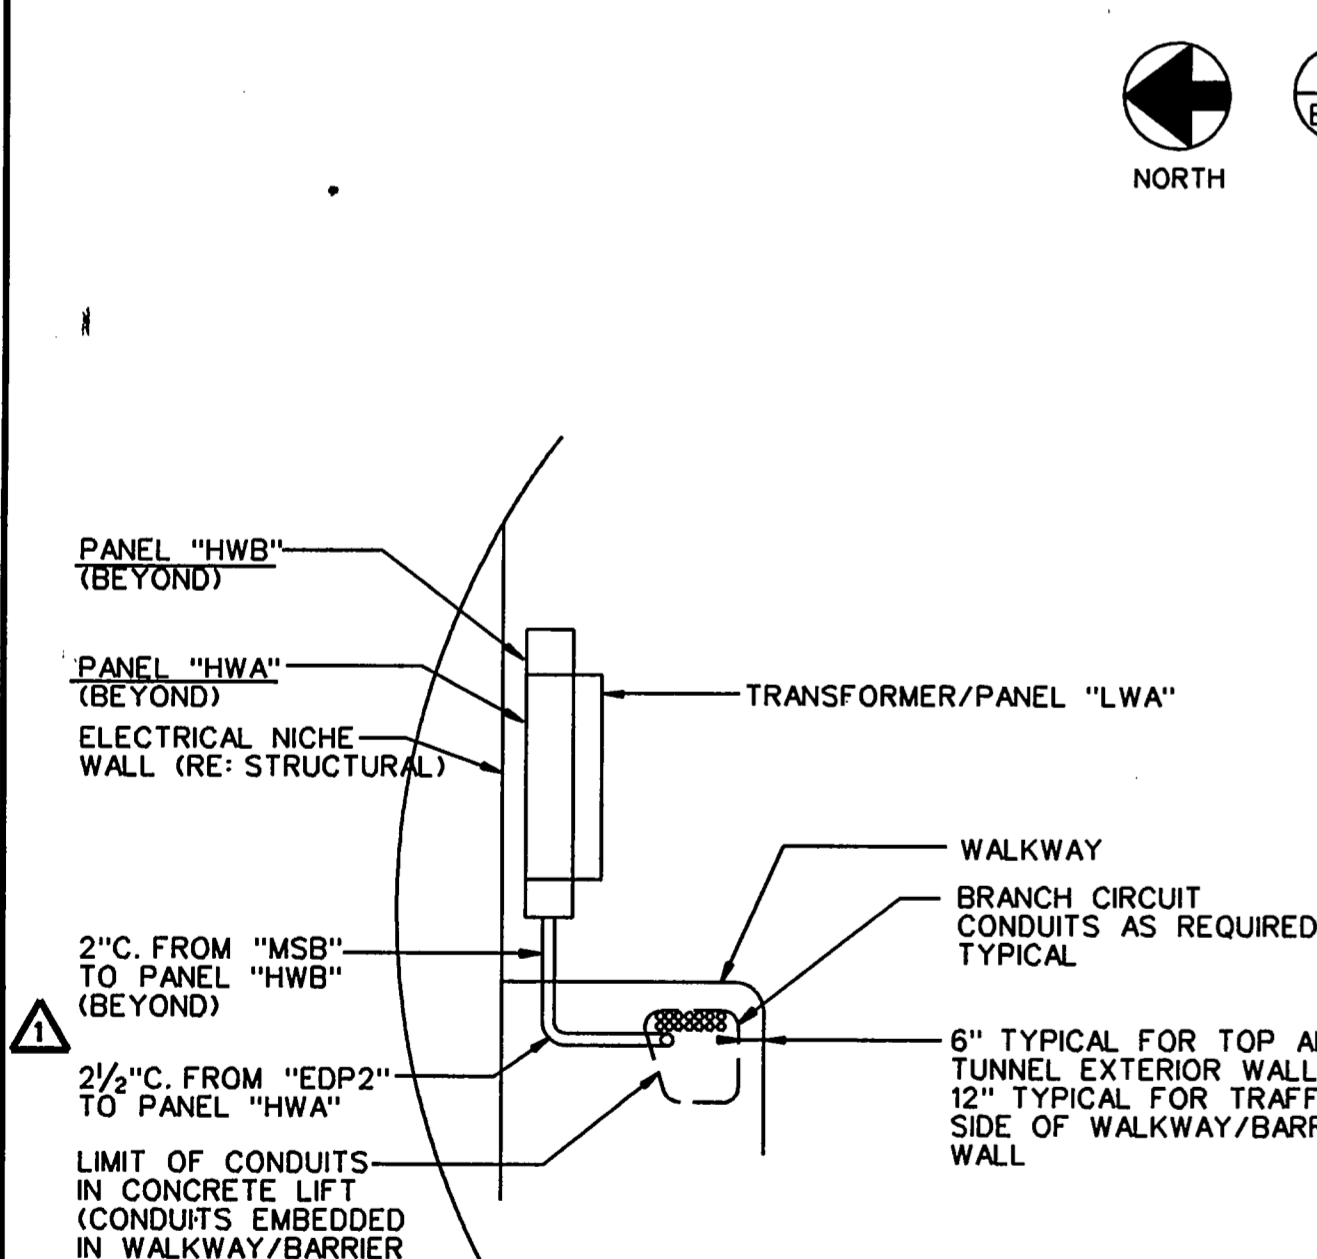


5 WEST ELECTRICAL NICHE "W" - SECTION  
E160 NO SCALE

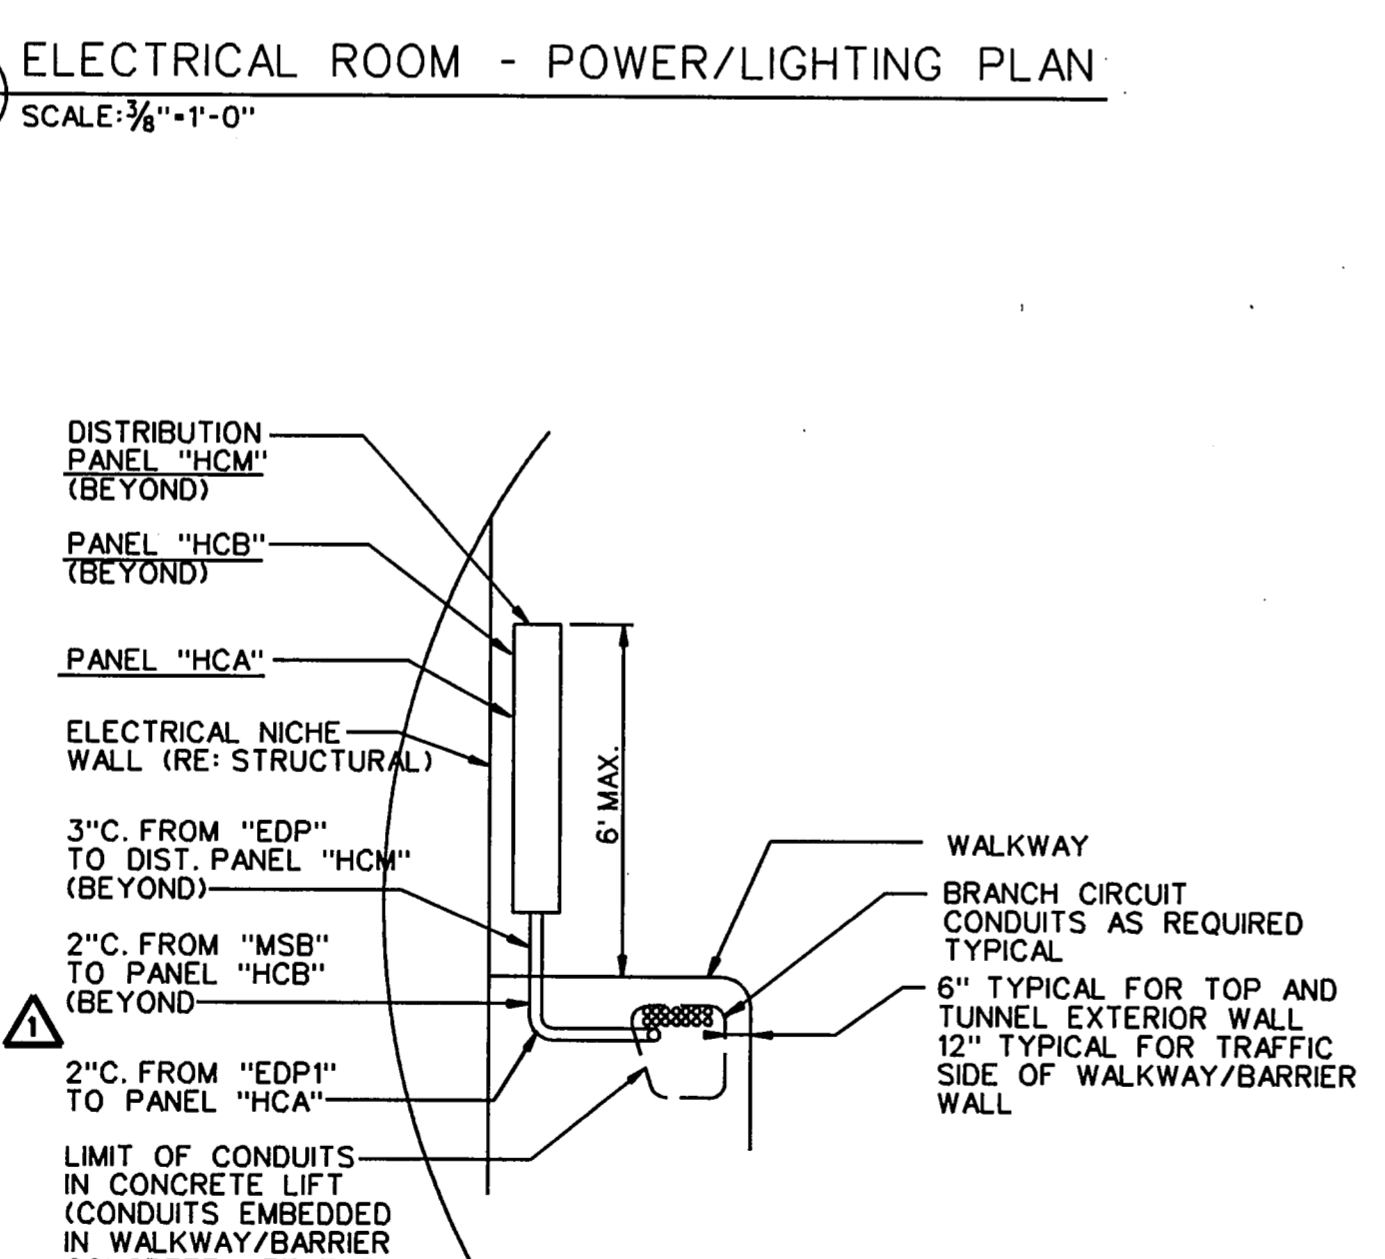


6 CENTER ELECTRICAL NICHE "C" - SECTION  
E160 NO SCALE

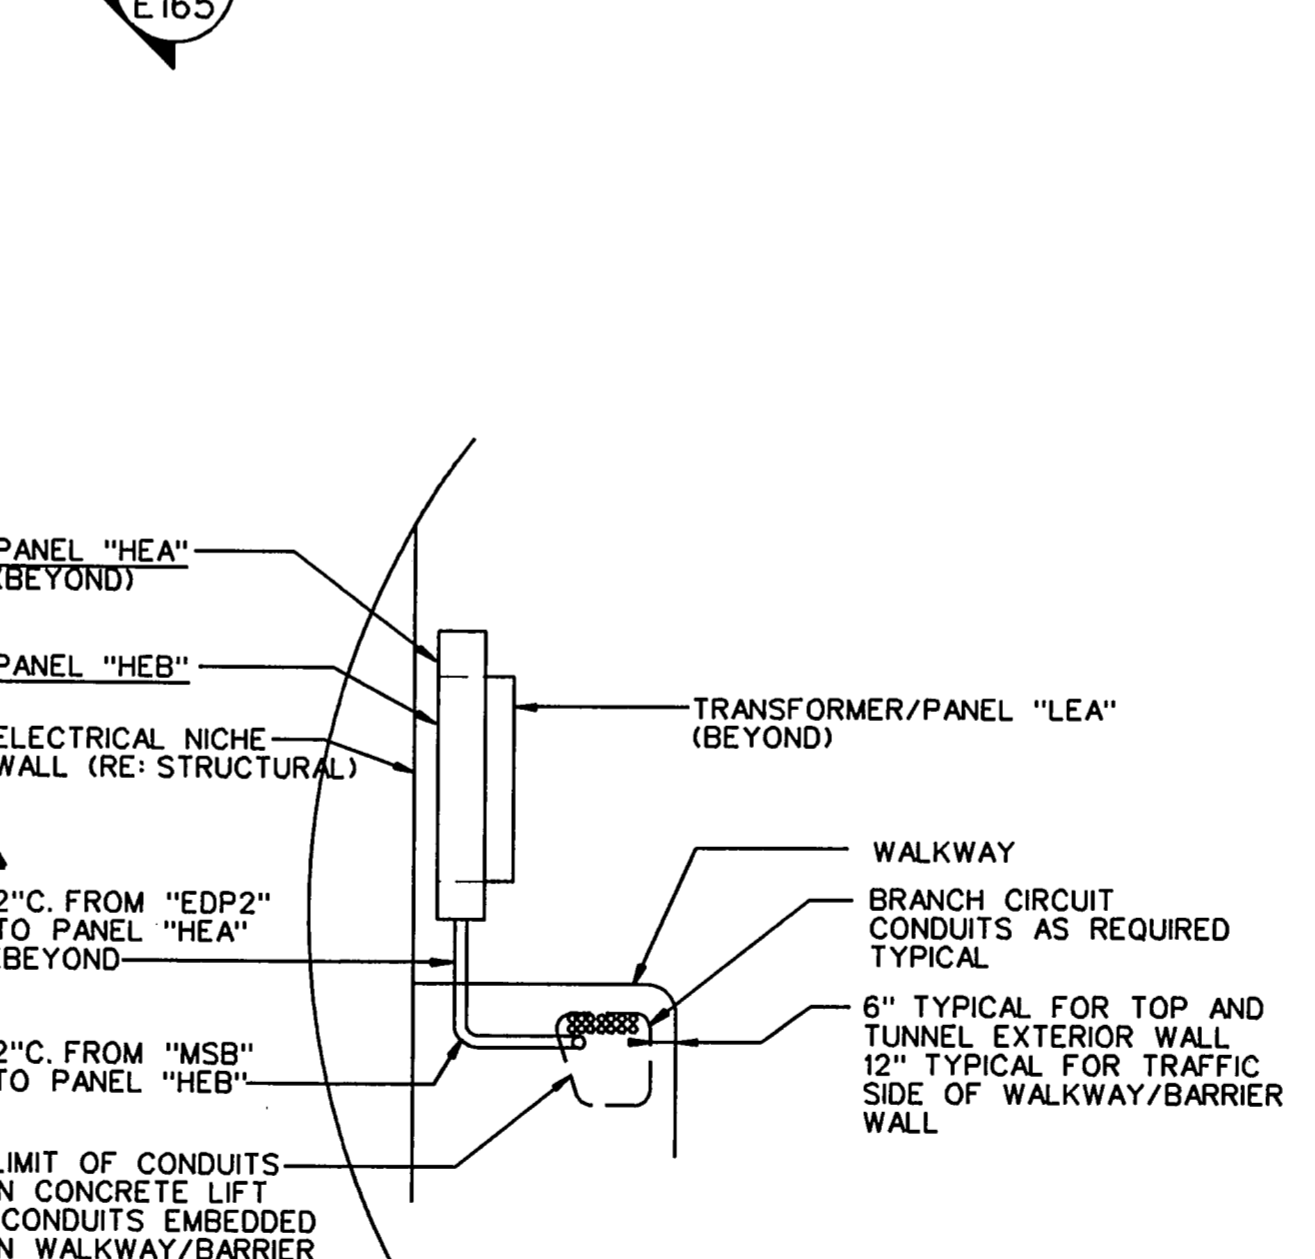


7 EAST ELECTRICAL NICHE "E" - SECTION  
E160 NO SCALE

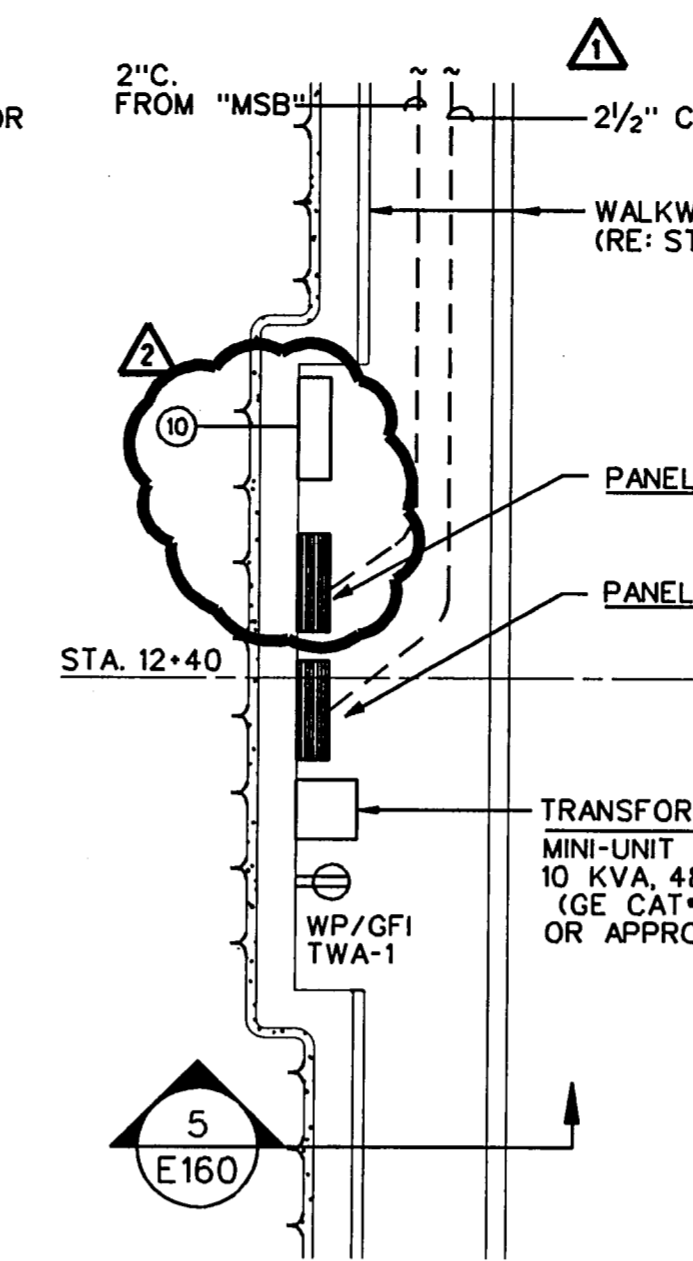

2 WEST ELECTRICAL NICHE "W" PLAN  
E160 NO SCALE  
NORTH

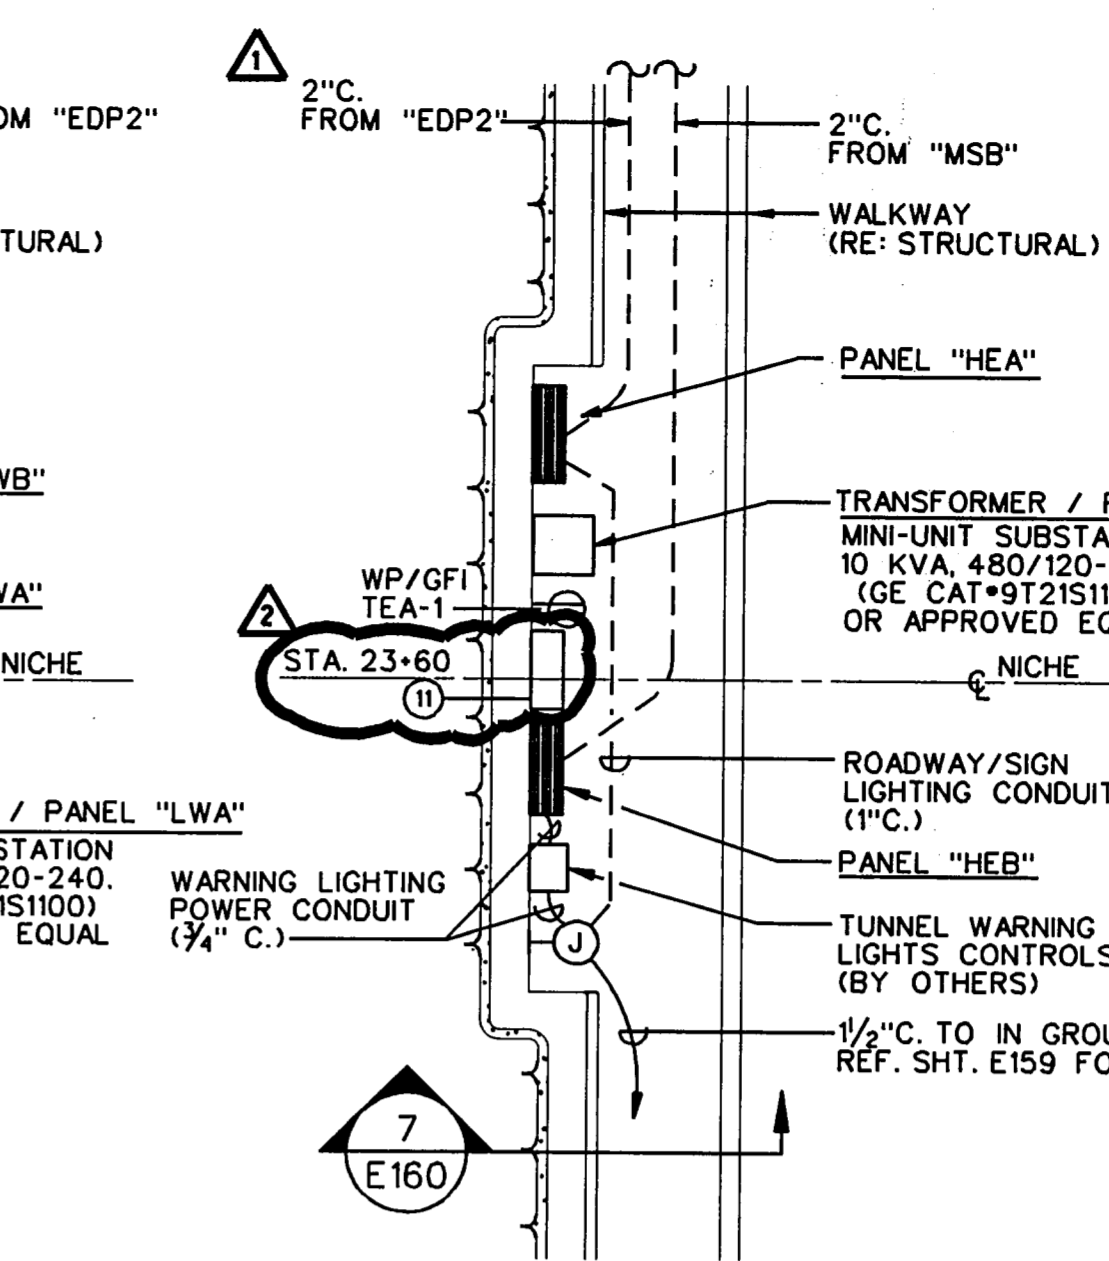

3 EAST ELECTRICAL NICHE "E" PLAN  
E160 NO SCALE  
NORTH

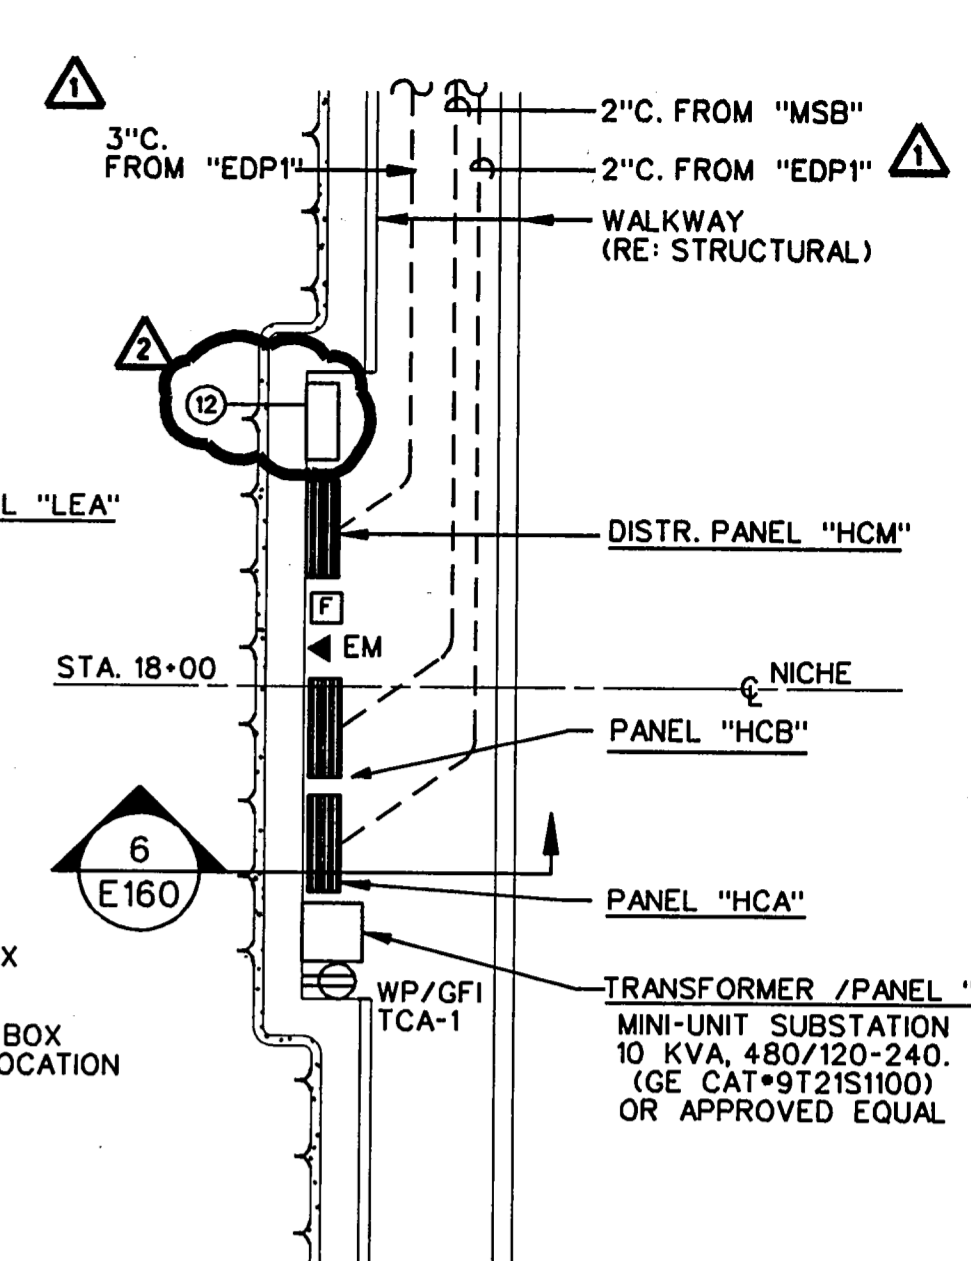

4 CENTER ELECTRICAL NICHE "C" PLAN  
E160 NO SCALE  
NORTH


- KEY NOTES: ("ELECTRICAL ROOM - POWER/LIGHTING PLAN" ONLY):
1 NEW UNDERGROUND DUCT FOR TUNNEL TELEPHONE UTILITIES...
2 NEW UNDERGROUND DUCT FOR TUNNEL ELECTRICAL SERVICE TO MAIN SWITCHBOARD...
3 NEW UNDERGROUND DUCTS FOR TUNNEL EMERGENCY GENERATORS...
4 AC-1 LOCATION...
5 PHOTOELECTRIC CONTROL...
6 CONDUITS FORM MAIN SWITCHBOARD...
7 JUNCTION BOX...
8 TUNNEL WARNING LIGHT CONTROL BOX...
9 36" x 36" x 12" NEMA INTERIOR BACK PLATE LOCKABLE ENCLOSURE...
10 36" x 36" x 12" NEMA 3R LOCKABLE ENCLOSURE WITH INTERIOR BACK PLATE MOUNTED AT 6'-0" A.F.F. LABEL ENCLOSURE AS "WEST ELECTRICAL NICHE SECURITY CABINET" AND PROVIDE THE FOLLOWING:
1. 3\*12,1\*12GRD-3/4"C. HOMERUN TO (2) 1P-20A CIRCUIT BREAKER...
2. (3)4" CONDUIT WITH (4) 1/4" INNER-DUCTS...
3. (2)-2" SPARE CONDUITS TO ADDISON TOLL PLAZA...
4. (3)-1" CONDUITS, ONE TO FIRE ALARM CONTROL CABINET...
5. (1) 1" CONDUIT TO SECURITY CAMERA LOCATION...
6. (1) 4" CONDUIT WITH (4) 1/4" INNER-DUCTS...
7. (1) 1" CONDUIT WITH PULL STRING TO SECURITY CAMERA LOCATION...



THE SEAL APPEARING ON THIS DOCUMENT WAS AUTHORIZED BY LEOPOLDO F. RIOS, P.E., 58272 ON MAY 14, 1998

Table with project details for Texas Turnpike Authority Addison Airport Tunnel. Includes drawing title 'PARTIAL PLANS FINAL RECORD DRAWING', date '12/25/99', and sheet number 'SECTION XIII'.

FILE: p:\additun\dgn\aditue08.dgn DATE: 23-Apr-96 20:01

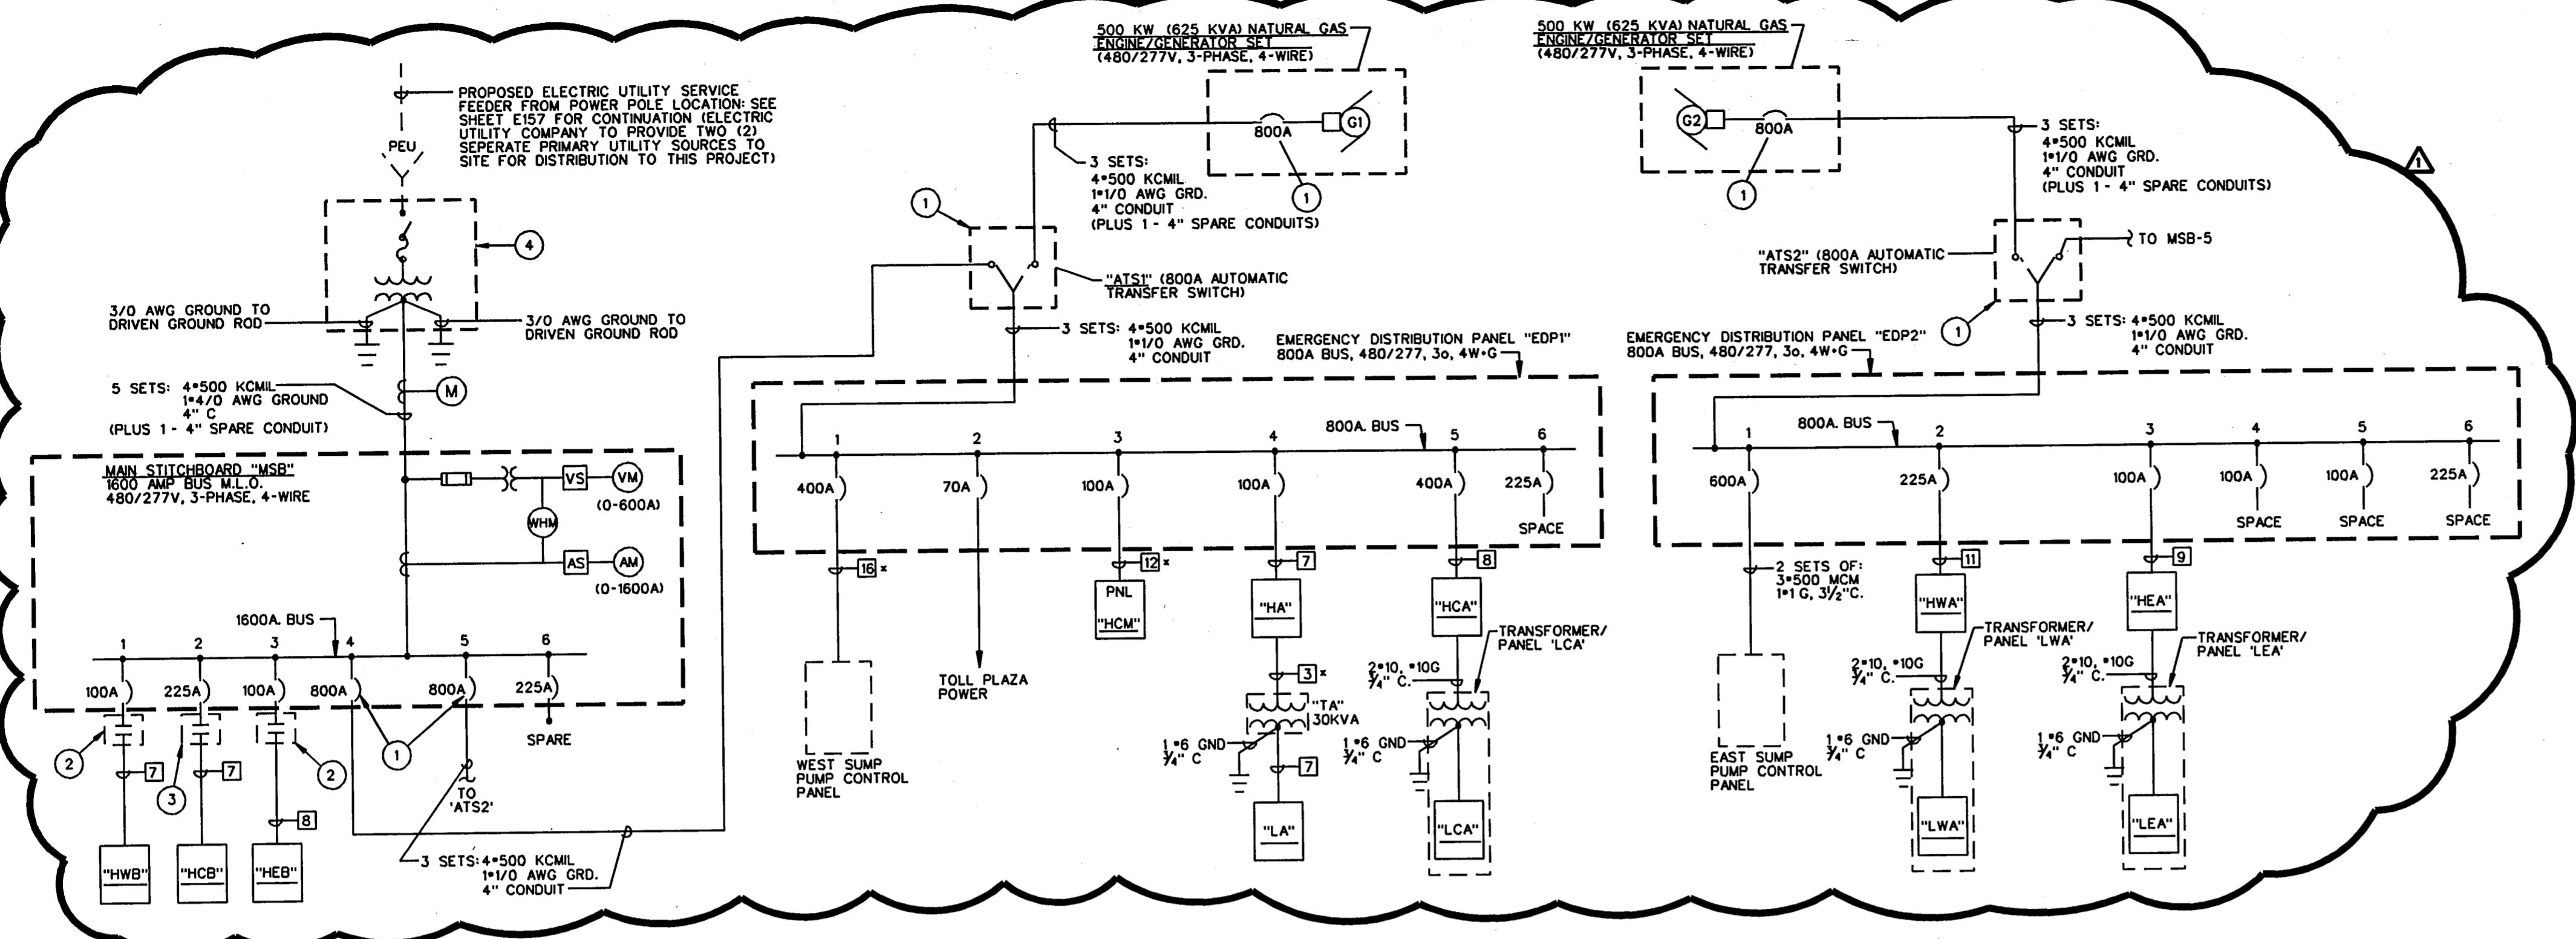

1 TUNNEL ONE-LINE DISTRIBUTION DIAGRAM  
E161 NO SCALE

GENERAL NOTES:  
A. WHERE FEEDERS ARE IN EXCESS OF 400 FT. AND/OR CONDUIT RUNS REQUIRE 360 DEGREE OR MORE OF BENDING RADIUS, PULL-BOXES SHALL BE PROVIDED IN ACCORDANCE WITH ARTICLE 370 OF THE NATIONAL ELECTRICAL CODE, ARTICLE 370.

- KEY NOTES:
- 1 FULLY-RATED CIRCUIT BREAKER/ATS.
  - 2 PANELBOARD CONTACTOR (ASCO MODEL NO. 920-3-100-9 OR APPROVED EQUAL) CONTROLLED BY PHOTOCELL LOCATED AT EXTERIOR OF ELECTRICAL ROOM. REF: SHEET 1/E160.
  - 3 PANELBOARD CONTACTOR (ALSO MODEL NO. 920-3-22J-9 OR APPROVED EQUAL) CONTROLLED BY PHOTOCELL LOCATED AT EXTERIOR OF ELECTRICAL RM. REF: SHEET 1/E160.
  - 4 ELECTRIC UTILITY CO. PROVIDED AND INSTALLED PAD MOUNTED TRANSFORMER. CONTRACTOR SHALL PROVIDE XFR PAD FOR UTILITY SIDS. & PRIMARY SERVICE CONDUITS/RISER TO POLE. UTILITY CO. WILL PROVIDE PRIMARY SERVICE CONDUCTORS TO TRANSFORMER AND WILL MAKE ALL PRIMARY AND SECONDARY CONDUCTORS CONNECTIONS TO TRANSFORMER.

MAIN SWITCHBOARD "MSB"

BREAKER: "MLO" VOLTAGE: 480V/277, 3 - PH, 4 - WIRE  
MINIMUM AC RATING: 35,000A MAINS: 1600A  
LOCATION: ELECTRICAL ROOM

NO.	POLES	DESIGNATION	VOLT-AMPS	NO.	PHASE LOAD (VOLTS-AMPS)			NO.	VOLT-AMPS	DESIGNATION	NO.	DEVICES
					QA	QB	QC					
100	3	PANEL "HWB"	12532	1				2	1504	PANEL "HCB"	3	225
			12532						1504			
			12532						159671	PANEL "EDP1"	3	800
100	3	PANEL "HEB"	12532	3				4	159671			
			12532						159671			
			12532						156525	PANEL "EDP2"	3	800
			12532						156525			
			12532						156525			
TOTAL			1023780									
CONNECTED												

FEEDER SCHEDULE

SYMBOL	CONDUCTORS	CONDUIT
1	4*10 * 10 GROUND	3/4"
2	4*8 * 10 GROUND	1"
3	4*6 * 8 GROUND	1/4"
4	4*4 * 8 GROUND	1/4"
5	4*3 * 8 GROUND	1/4"
6	4*2 * 6 GROUND	1/2"
7	4*1 * 6 GROUND	2"
8	4*1/0 * 6 GROUND	2"
9	4*2/0 * 6 GROUND	2"
10	4*3/0 * 6 GROUND	2 1/2"
11	4*4/0 * 4 GROUND	2 1/2"
12	4*250 * 4 GROUND	3"
13	4*300 * 4 GROUND	3"
14	4*350 * 3 GROUND	3"
15	4*400 * 3 GROUND	3"
16	4*500 * 3 GROUND	3 1/2"

NOTES:  
1. WIRES SIZES ARE BASED ON N.E.C. TABLE 310-16 AMPACITIES FOR AWG COPPER CONDUCTORS WITH 75°C INSTALLATION.  
\* 2. DENOTES "OMITS NEUTRAL CONDUCTORS"

MOTOR FEEDER SCHEDULE

COPPER CONDUCTORS, 75°C INSULATION

DESIGNATION	HORSE POWER	C.B. TRIP AT 480V, 30	MINIMUM "NEMA MOTOR STARTER SIZE" (SEE NOTE 3)	DISCONNECT SWITCH SIZE (SEE NOTE 3)	TIME DELAY FUSE SIZE (WHERE REQ'D.)	CONDUIT AND WIRE SIZE (UNLESS INDICATED OTHERWISE)
1	1/2, 3/4, 1, 1 1/2, 2	15A	1	3P-30	(SEE NOTE 2)	3/4" C., 3*10 & 1*10 GROUND
2	3, 5	20A	1	3P-30	(SEE NOTE 2)	3/4" C., 3*10 & 1*10 GROUND
3	7 - 1/2, 10	30A	1	3P-30	20A	3/4" C., 3*10 & 1*10 GROUND
4	15	50A	2	3P-30	30A	1" C., 3*10 & 1*10 GROUND
5	20	50A	2	3P-60	40A	1" C., 3*8 & 1*10 GROUND
6	25	70A	2	3P-60	50A	1" C., 3*6 & 1*8 GROUND
7	30	90A	3	3P-60	60A	1" C. 3 * 6 & 1*8 GROUND
8	40	100A	3	3P-100	80A	1/2" C., 3*4 & 1*8 GROUND
9	50	100A	3	3P-200	100A	1/2" C., 3*3 & 1*8 GROUND
10	60	125A	4	3P-200	125A	1/2" C., 3*1 & 1*6 GROUND
11	75	150A	4	3P-200	150A	1/2" C., 3*1/0 & 1*6 GROUND
12	100	200A	4	3P-200	200A	2" C., 3*2/0 & 1*6 GROUND

NOTES:  
1. FOR SPECIAL EQUIPMENT OR OPERATING CONDITIONS, REFER TO MANUFACTURER'S RECOMMENDATIONS FOR OVERCURRENT PROTECTIVE DEVICES AND CONDUCTOR SIZING.  
2. TIME DELAY FUSES FOR: 1/2 HP, THRU 1-1/2 HP, SHALL BE 4 AMPERE; 2 HP, SHALL BE 5 AMPERES; 3 HP, SHALL BE 8 AMPERE; AND 5 HP, SHALL BE 15 AMPERE.  
3. NEMA MOTORS STARTERS AND DISCONNECT SWITCHES BASED ON FULL-VOLTAGE NON-REVERSING MOTORS; SPECIAL EQUIPMENT REQUIRING TWO-SPEED PART-WINDING/TWO-WINDING MOTORS AND/OR REVERSING TYPE MOTORS SHALL BE PROVIDED WITH MATCHING MOTOR STARTERS/DISCONNECT SWITCHES BY THE EQUIPMENT MANUFACTURER AND SHALL BE INSTALLED IN ACCORDANCE WITH THE MANUFACTURERS RECOMMENDATIONS.



THE SEAL APPEARING ON THIS DOCUMENT WAS AUTHORIZED BY LEOPOLDO F. RIOS, P.E., 58272 ON SEPTEMBER 9, 1996


FINAL RECORD DRAWING  
Date: 12/25/99

GEN. SETS		LR	2/7/97
No.	REVISION	BY	DATE
TEXAS TURNPIKE AUTHORITY ADDISON AIRPORT TUNNEL			
ONE-LINE DIAGRAM & SCHEDULES			
HDR Engineering, Inc.		SECTION XIII	
DRAWN: WTD	DATE: 12/05/96	DESIGNED: LR	DATE: 08/28/96
CHECKED: BL	DATE: 08/28/96	SCALE: NONE	
CONTRACT No. DNT-260 SHEET E161 OF 166			


FILE: p:\additun\dgn\adtue09.dgn  
DATE: 23-Apr-96 20:01






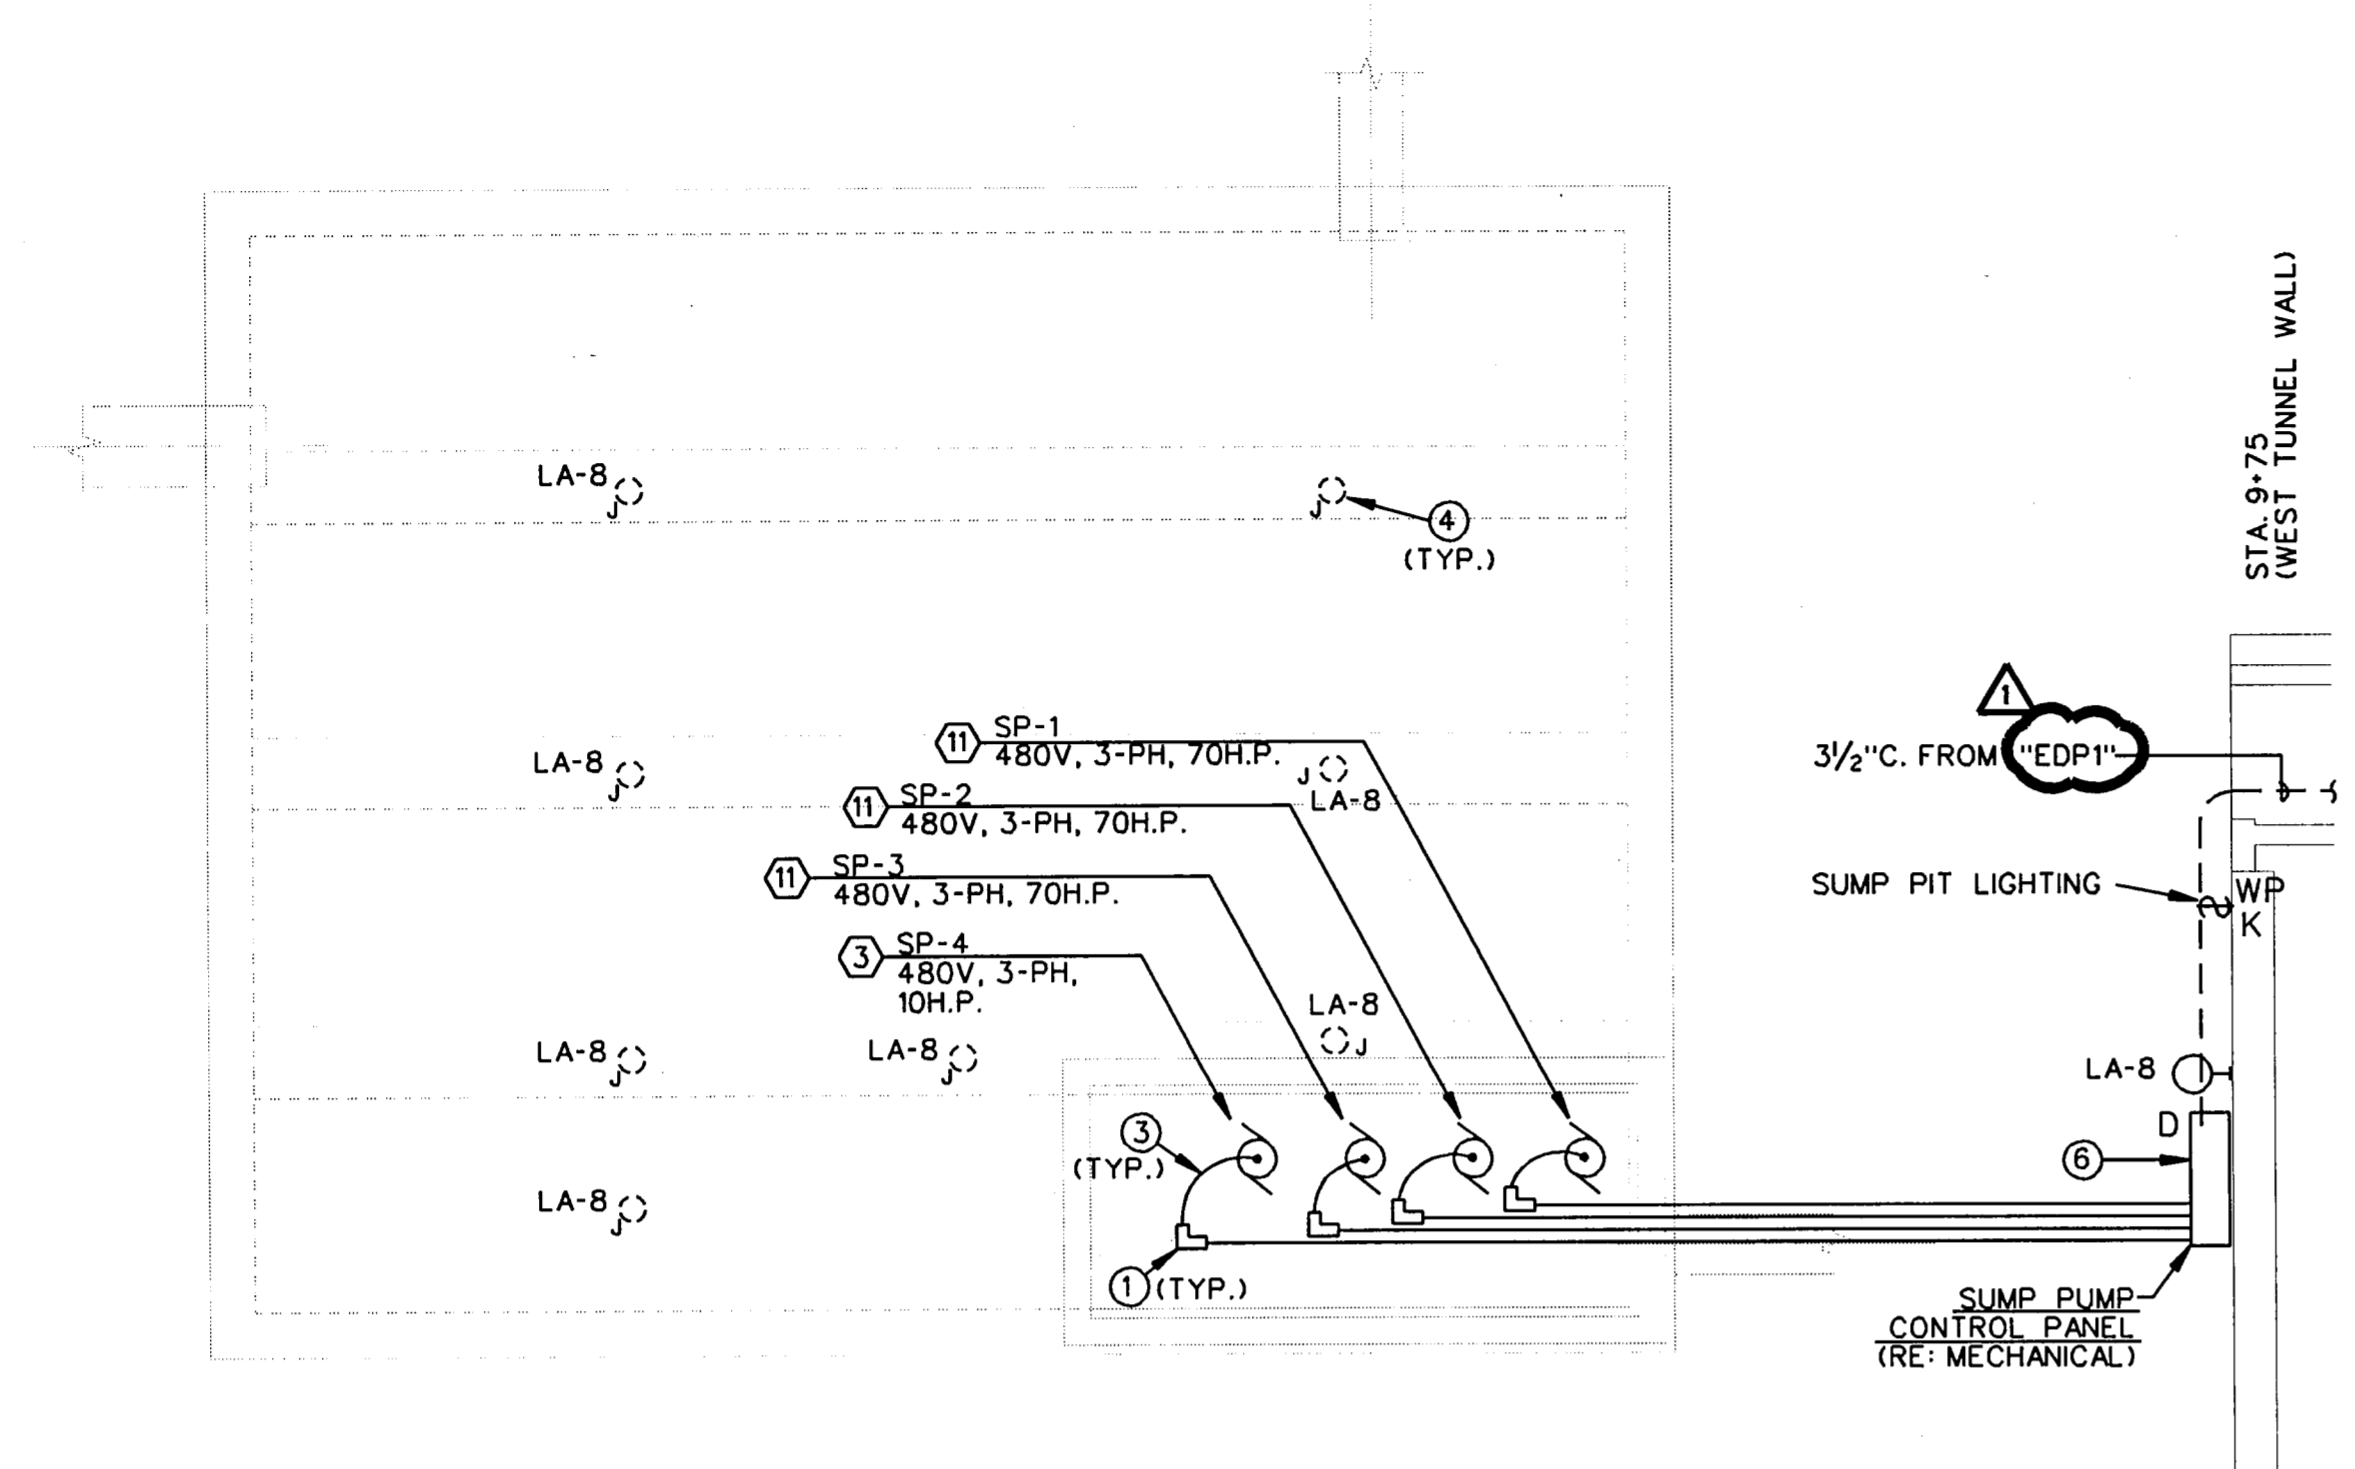


**1 WEST SUMP PIT PLAN**  
 E164 SCALE: 3/16" = 1'-0"

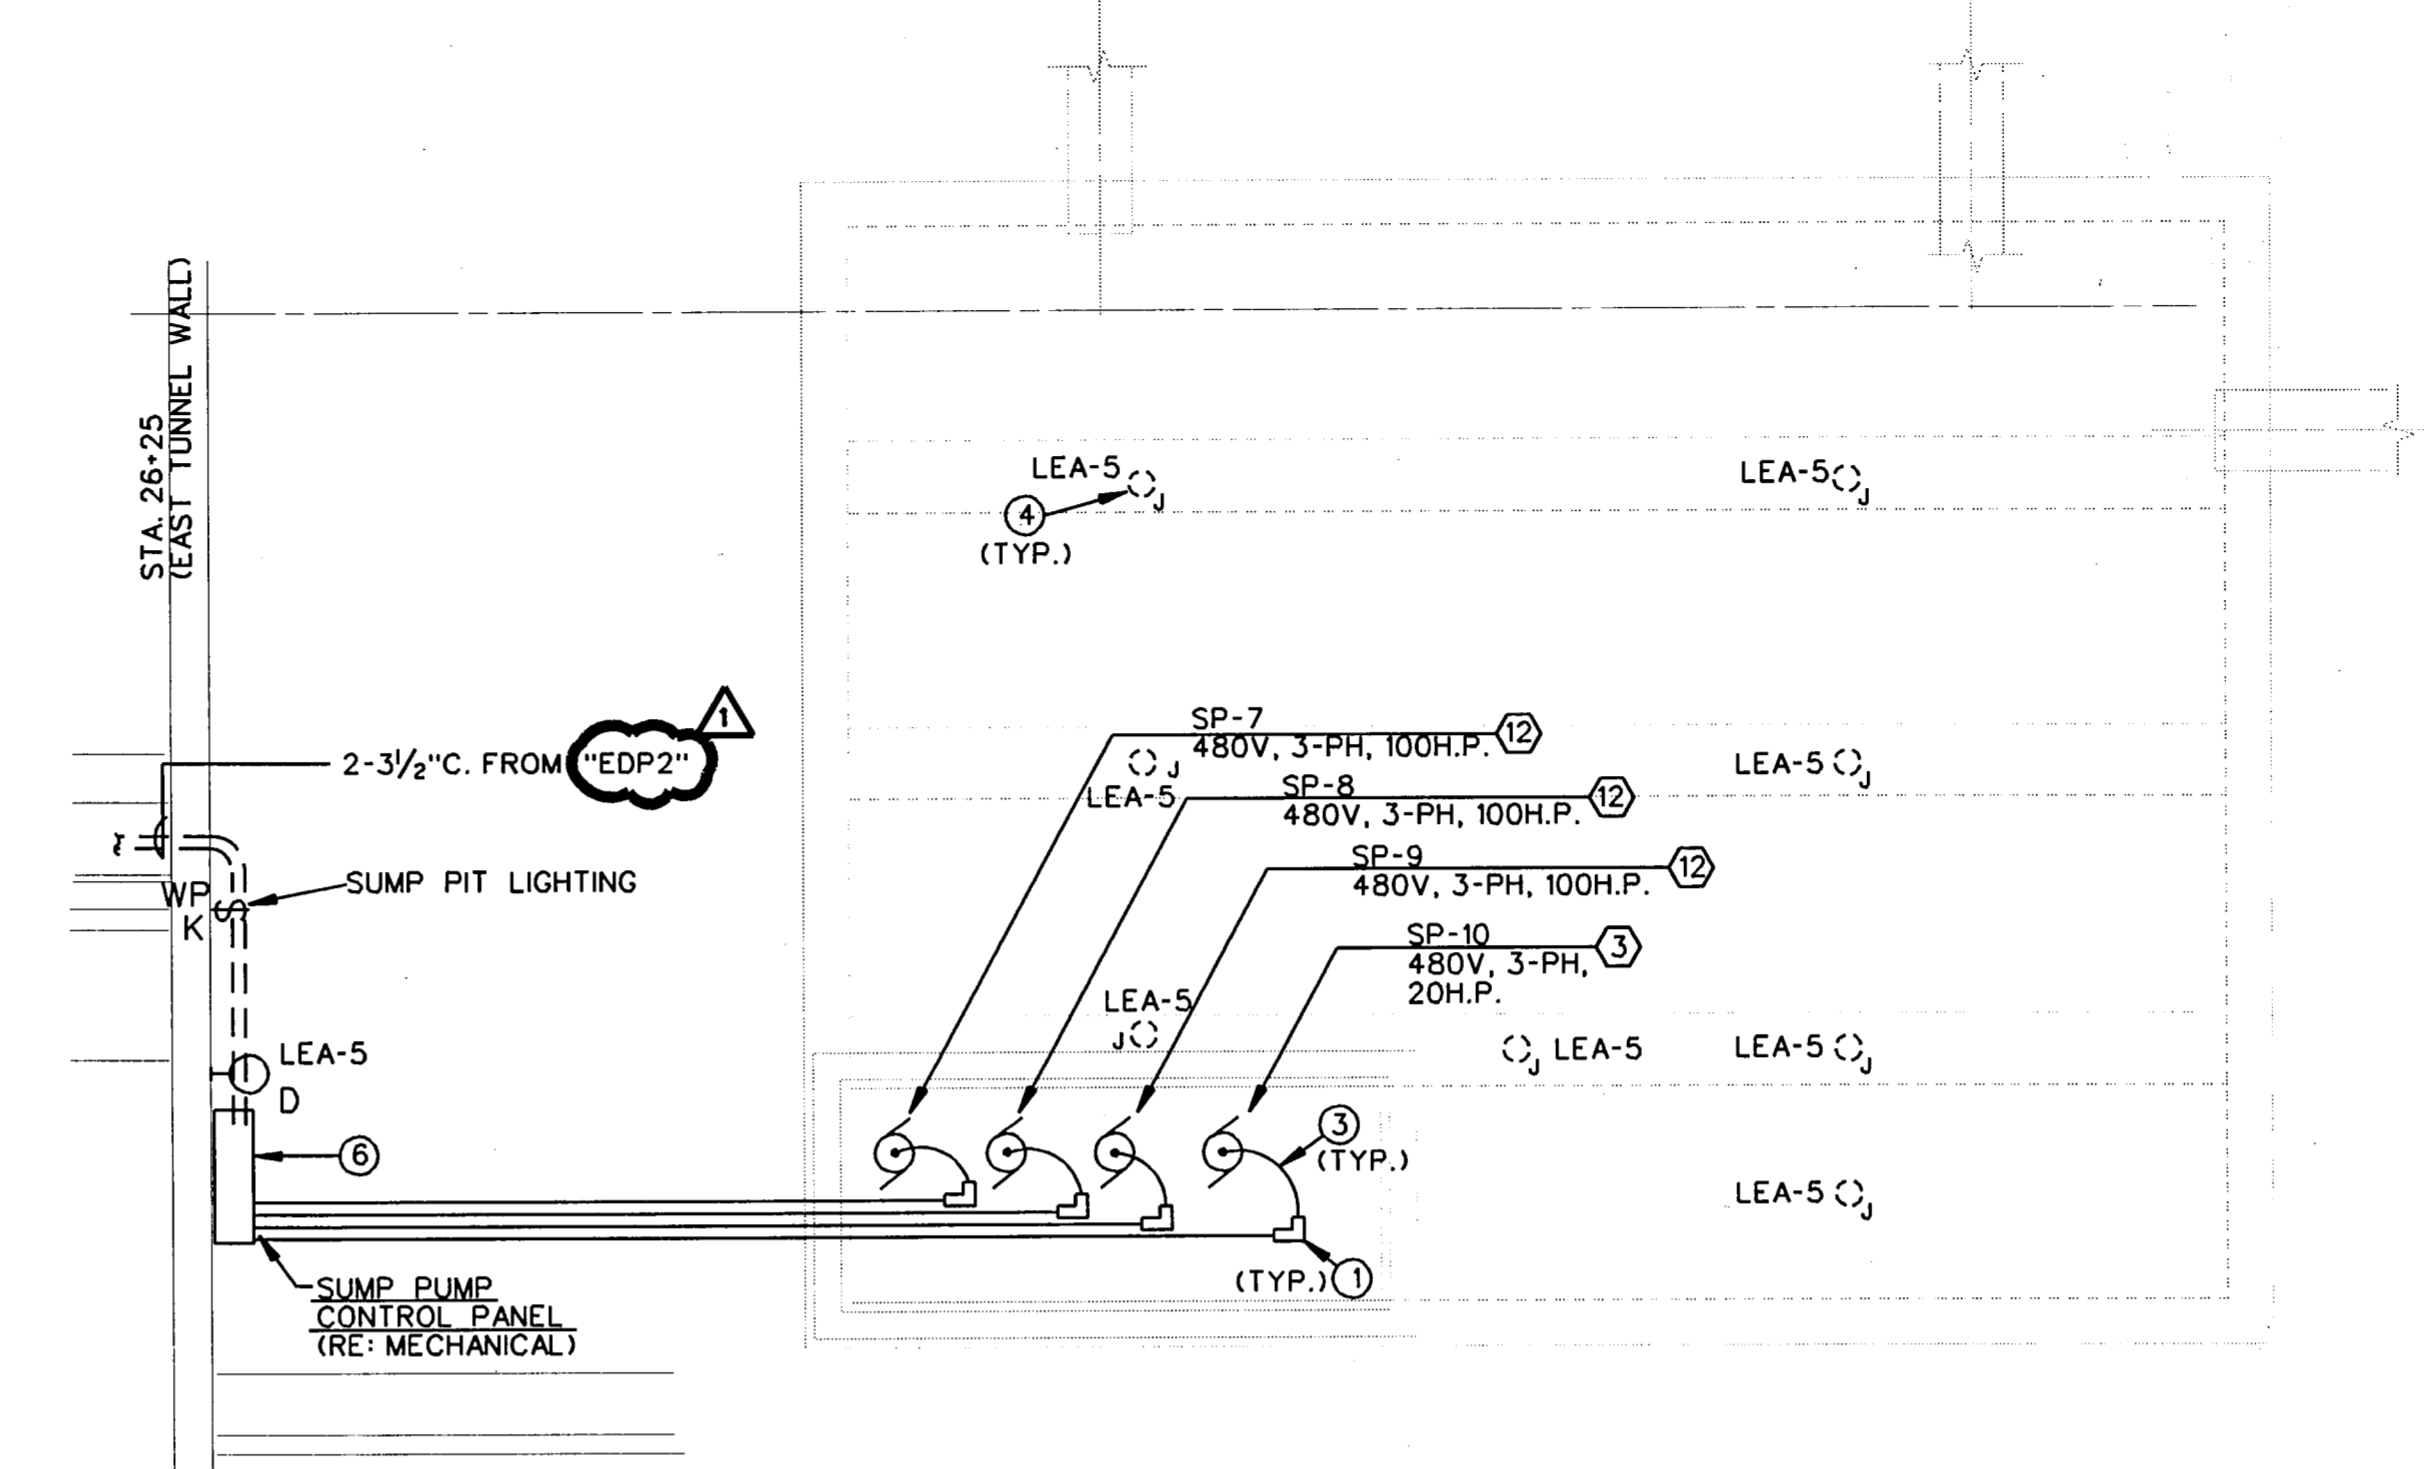

**2 EAST SUMP PIT PLAN**  
 E164 SCALE: 3/16" = 1'-0"

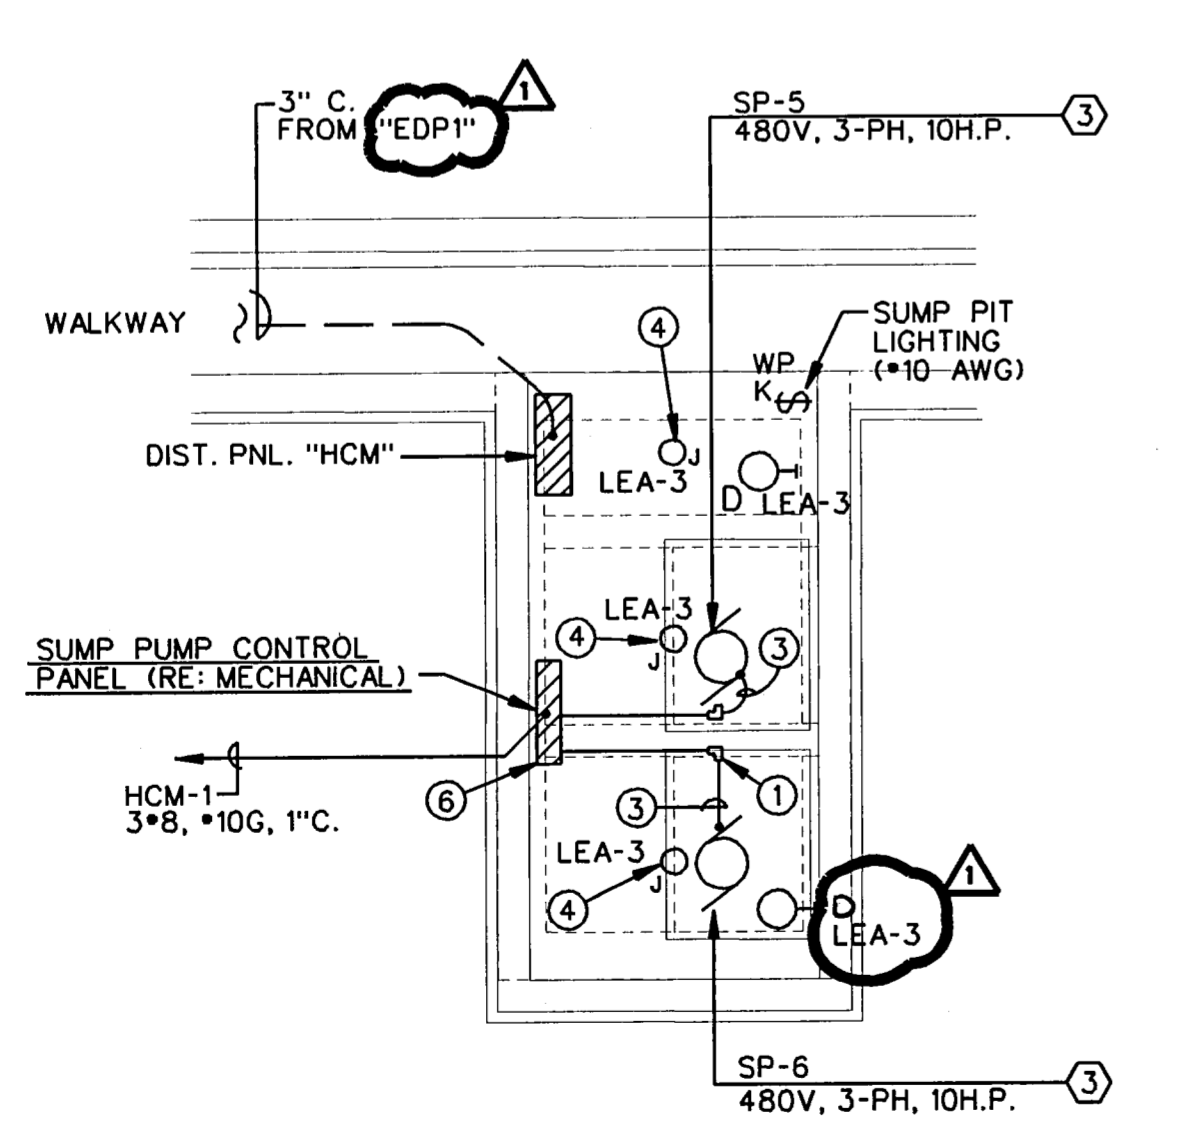

**3 CENTER SUMP PIT NICHE PLAN**  
 E164 NO SCALE

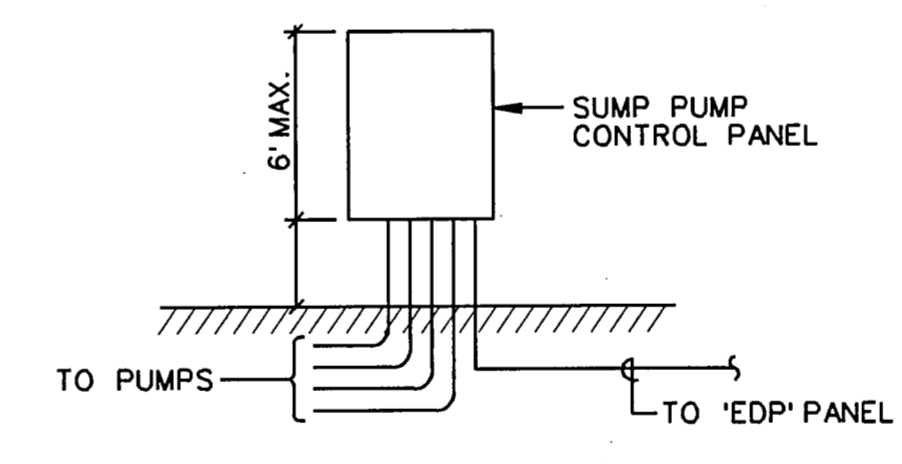

**3 SUMP PUMP CONTROL PANEL**  
 E164 NO SCALE

- KEY NOTES: (SUMP PIT PLANS ONLY)
- ① GASKETED CONDUIT BODY FOR TRANSITION FROM RIGID GALVANIZED CONDUIT TO LIQUID TIGHT FLEXIBLE NON-METALIC CONDUIT.
  - ② MAINTAIN WORKING CLEARANCES BETWEEN TUNNEL APPURTANCES AND FRONT OF ELECTRICAL EQUIPMENT IN ACCORDANCE WITH N.E.C.
  - ③ LIQUID TIGHT CONDUIT FASTENED TO SURFACE MOUNTED BRACKETS AND EXTENDED UP TO STARTER/DISCONNECT.
  - ④ CEILING SURFACE MOUNTED SUMP PIT LIGHTING FIXTURE TYPE "J", TYPICAL.
  - ⑤ NOT USED.
  - ⑥ SUMP PUMP CONTROL PANEL AND COMBINATION MOTOR STARTERS/DISCONNECTS PROVIDED BY MECHANICAL CONTRACTOR; RE: MECHANICAL DRAWINGS.




THE SEAL APPEARING ON THIS DOCUMENT WAS AUTHORIZED BY LEOPOLDO F. RIOS, P.E., 58272 ON SEPTEMBER 9, 1996


**FINAL RECORD DRAWING**  
 Date: 12/25/99

No.	REVISION	BY	DATE
GEN. SETS LR 2/7/97			
TEXAS TURNPIKE AUTHORITY ADDISON AIRPORT TUNNEL			
PARTIAL PLANS/DETAILS			
HDR HDR Engineering, Inc.			SECTION XIII
DRAWN: WTD	DATE: 12/05/96	DESIGNED: LR	DATE: 08/28/96
CHECKED: BL	DATE: 08/28/96	SCALE: AS SHOWN	
CONTRACT No. DNT-260 SHEET E164 OF 166			

FILE: p:\addtun\dgn\adtuell2.dgn DATE: 23-Apr-96 2:01

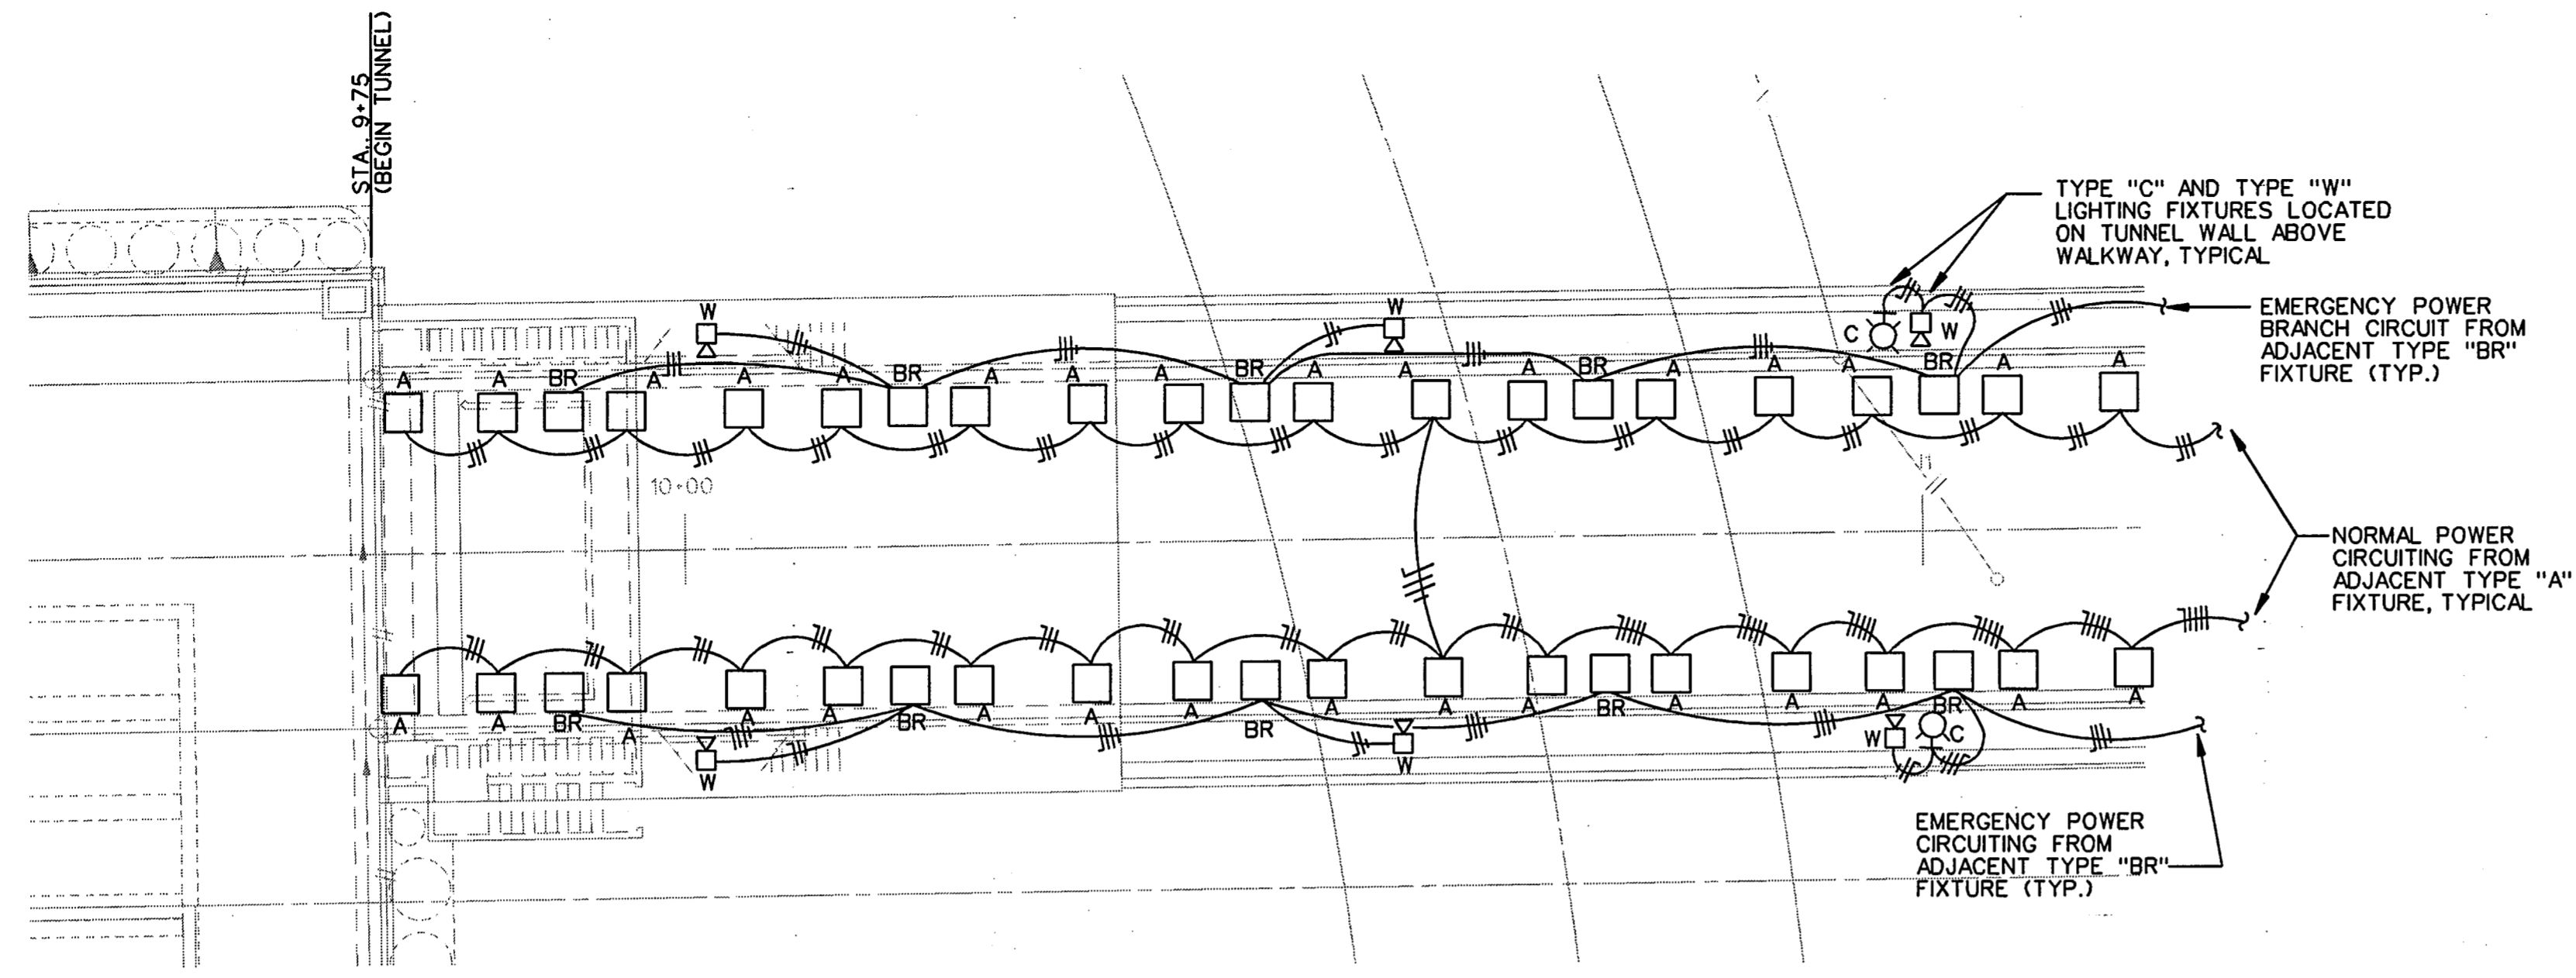

1 TYPICAL TUNNEL LIGHTING PLAN  
E165 NO SCALE

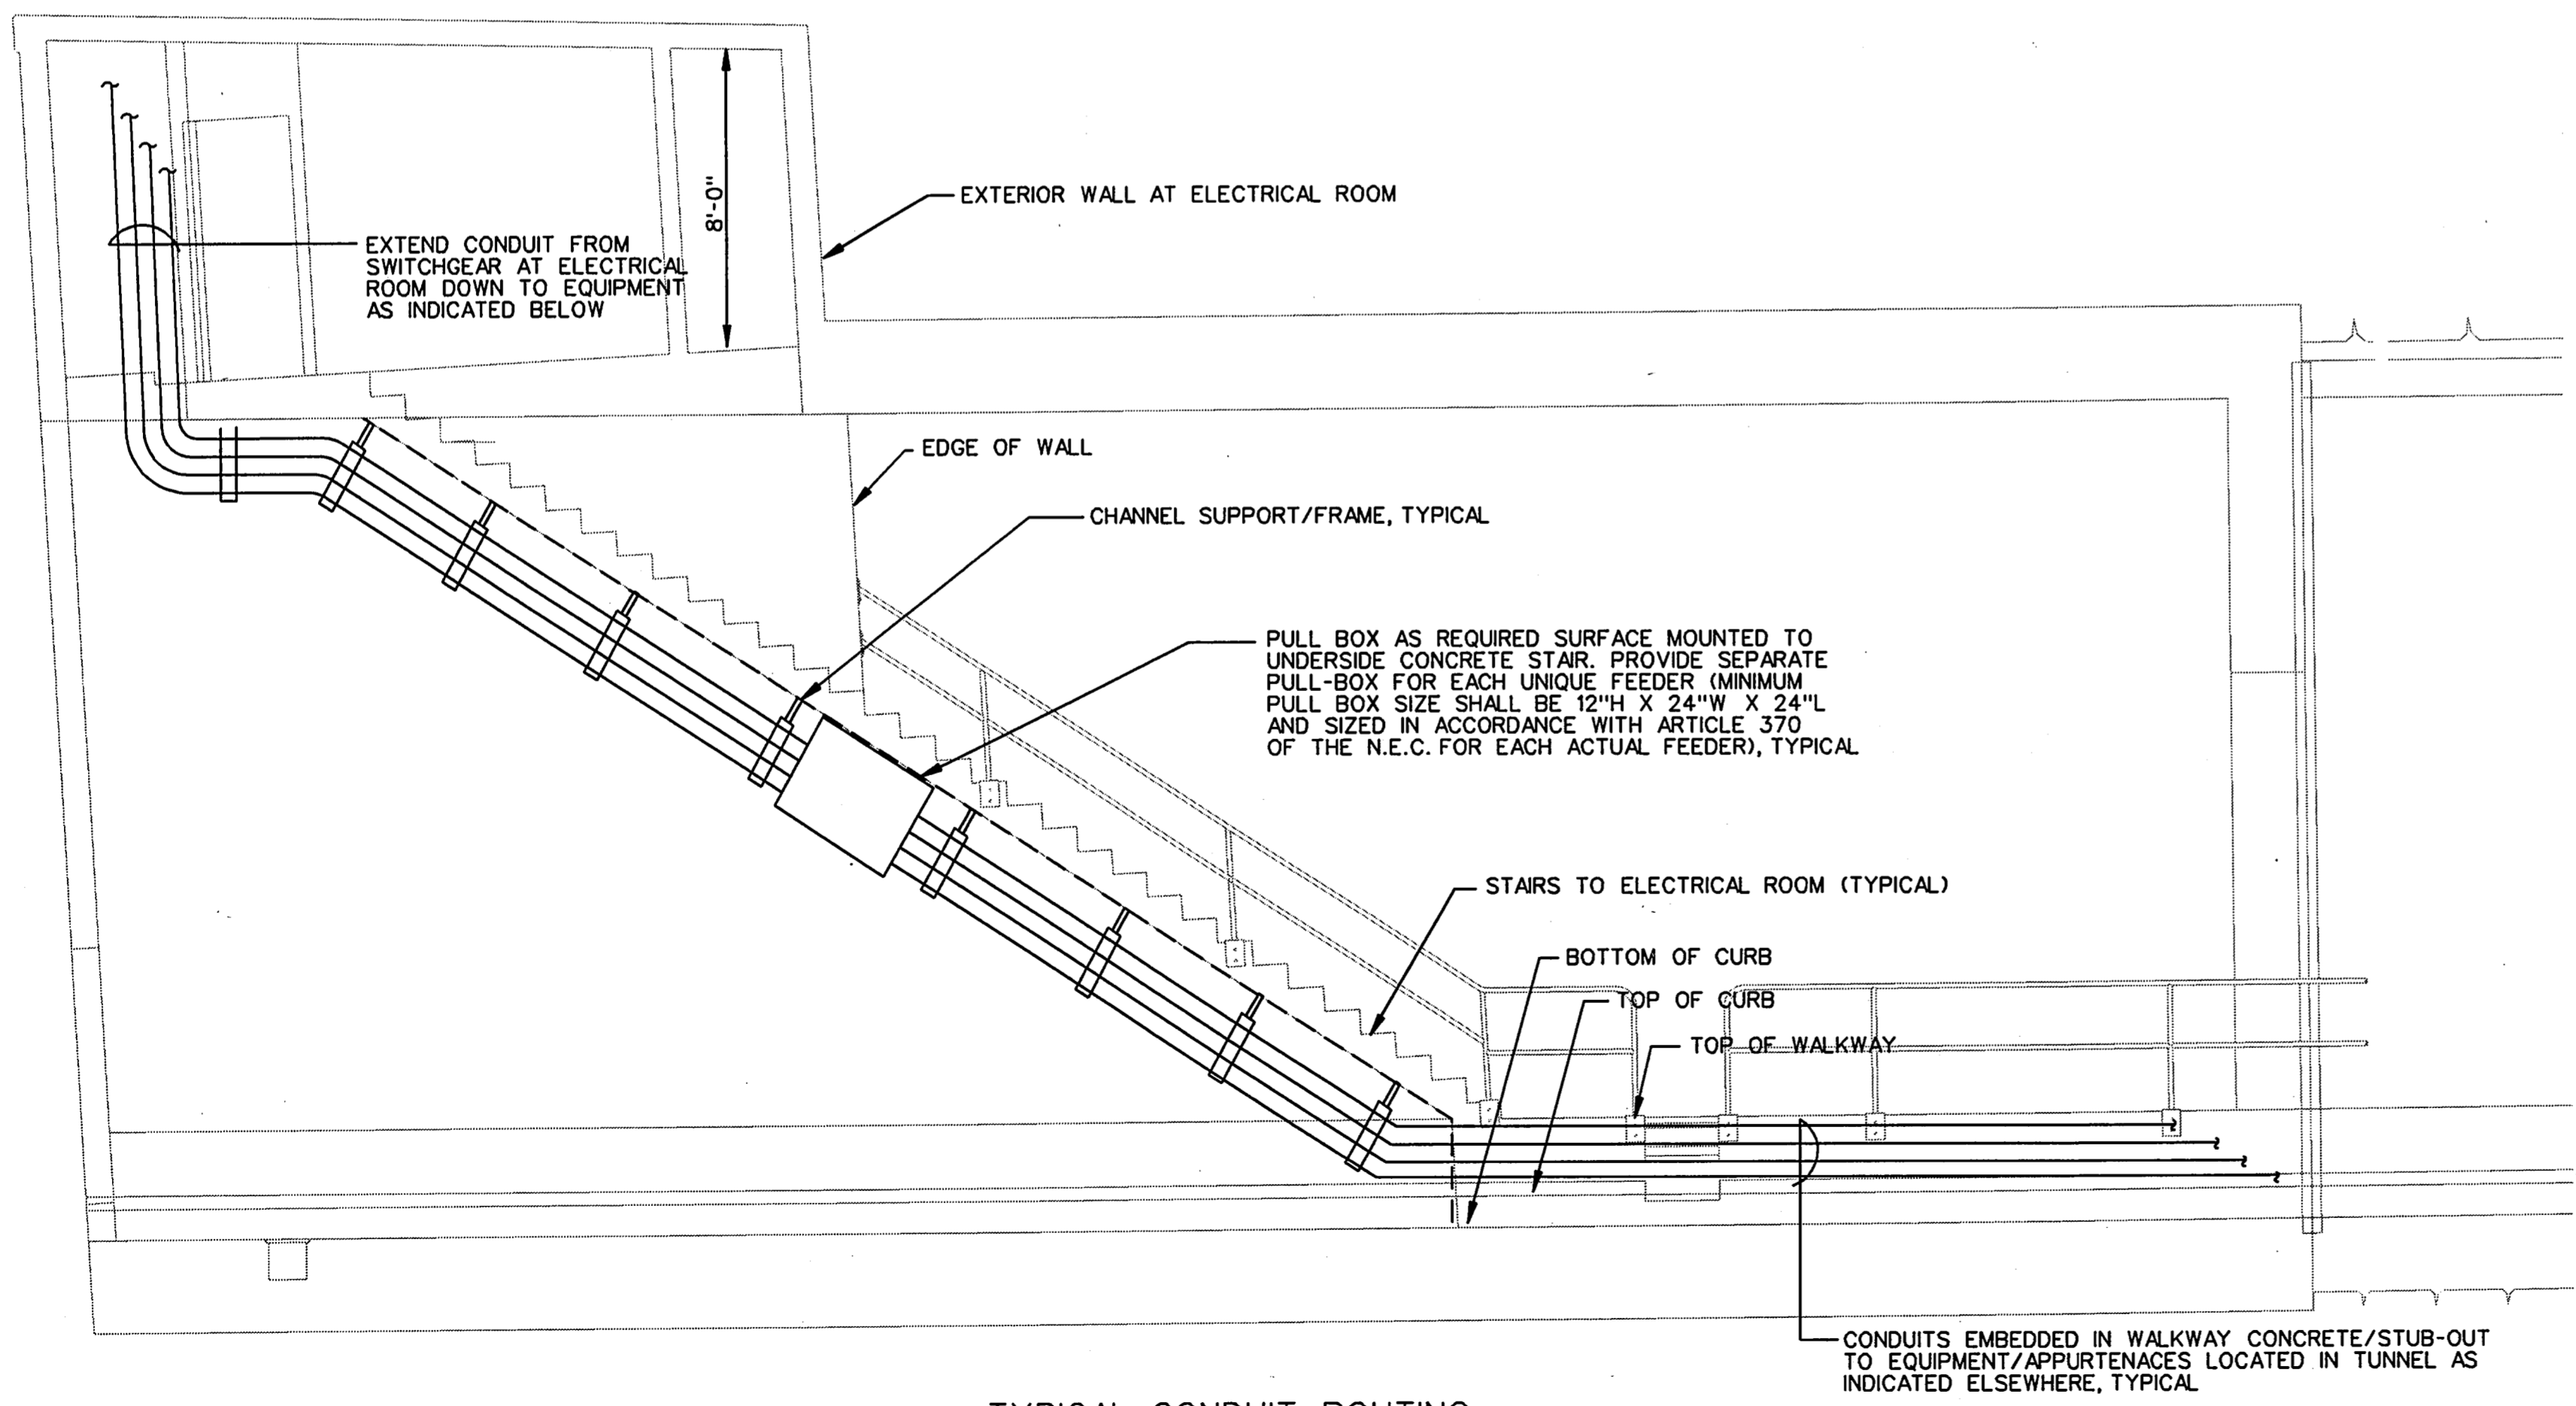

2 TYPICAL CONDUIT ROUTING - SECTION AT ELECTRICAL ROOM  
E165 NO SCALE




THE SEAL APPEARING ON THIS DOCUMENT WAS AUTHORIZED BY LEOPOLDO F. RIOS, P.E., 58272 ON SEPTEMBER 9, 1996

FINAL RECORD  
DRAWING  
Date: 12/25/99


No.	REVISION	BY	DATE
TEXAS TURNPIKE AUTHORITY ADDISON AIRPORT TUNNEL			
PARTIAL PLANS/DETAILS			
HDR Engineering, Inc.			SECTION XIII
DRAWN: WTD	DATE: 12/05/96	DESIGNED: LR	DATE: 08/28/96
CHECKED: BL	DATE: 08/28/96	SCALE: NONE	
CONTRACT No. DNT-260 SHEET E165 OF 166			

FILE: p:\additum\ogn\adttue113.dgn  
DATE: 23-Apr-96 20:01

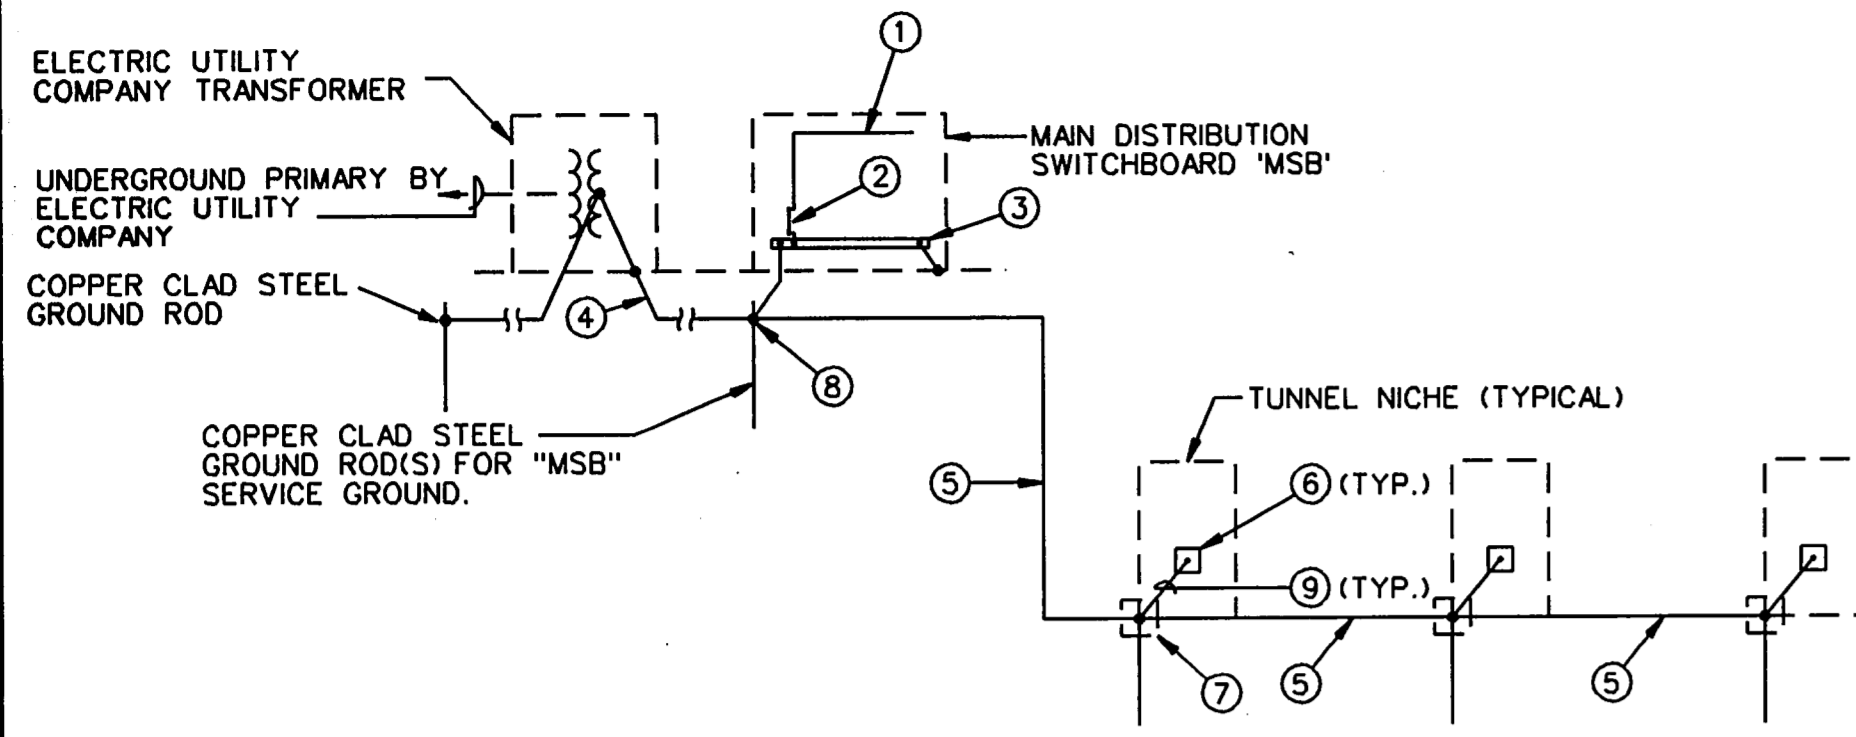


1 GROUNDING SYSTEM SCHEMATIC  
E166 NO SCALE

- KEY NOTES (GROUNDING SYSTEM SCHEMATIC ONLY):
- NEUTRAL BUS IN SWITCHBOARD.
  - NEUTRAL DISCONNECT LINK.
  - GROUND BUS.
  - GROUNDING SYSTEM CONNECTION.
  - SYSTEM GROUND CONDUCTORS IN CONDUIT; SEE ONE-LINE DIAGRAM, 1/E161, FOR FURTHER INFORMATION.
  - GROUND PLATE, INSTALL 3/8" x 12" x 4" COPPER PLATE IN NICHE WALL; BOND COPPER CONDUCTORS AS REQUIRED FROM GROUND ROD TO GROUND PLATE. PROVIDE DRILLED AND TAPPED HOLES IN GROUND PLATE FOR GROUND LUGS.
  - PROVIDE GROUND TEST WELL AT EACH NICHE. (TYP.)
  - ADD SUFFICIENT NUMBER OF GROUND RODS TO BRING GROUND RESISTANCE TO LESS THAN 25 OHMS, SEE SPECIFICATIONS SECTION 16452 FOR FURTHER INFORMATION.

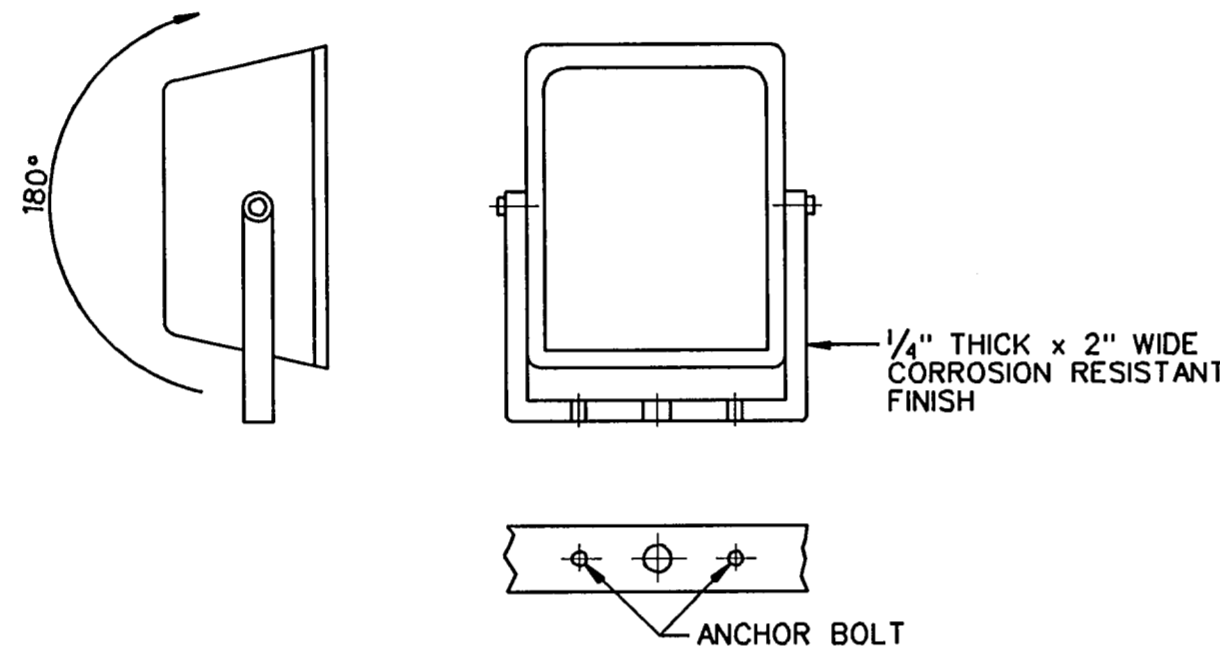

6 MOUNTING BRACKET DETAIL  
E166 NO SCALE

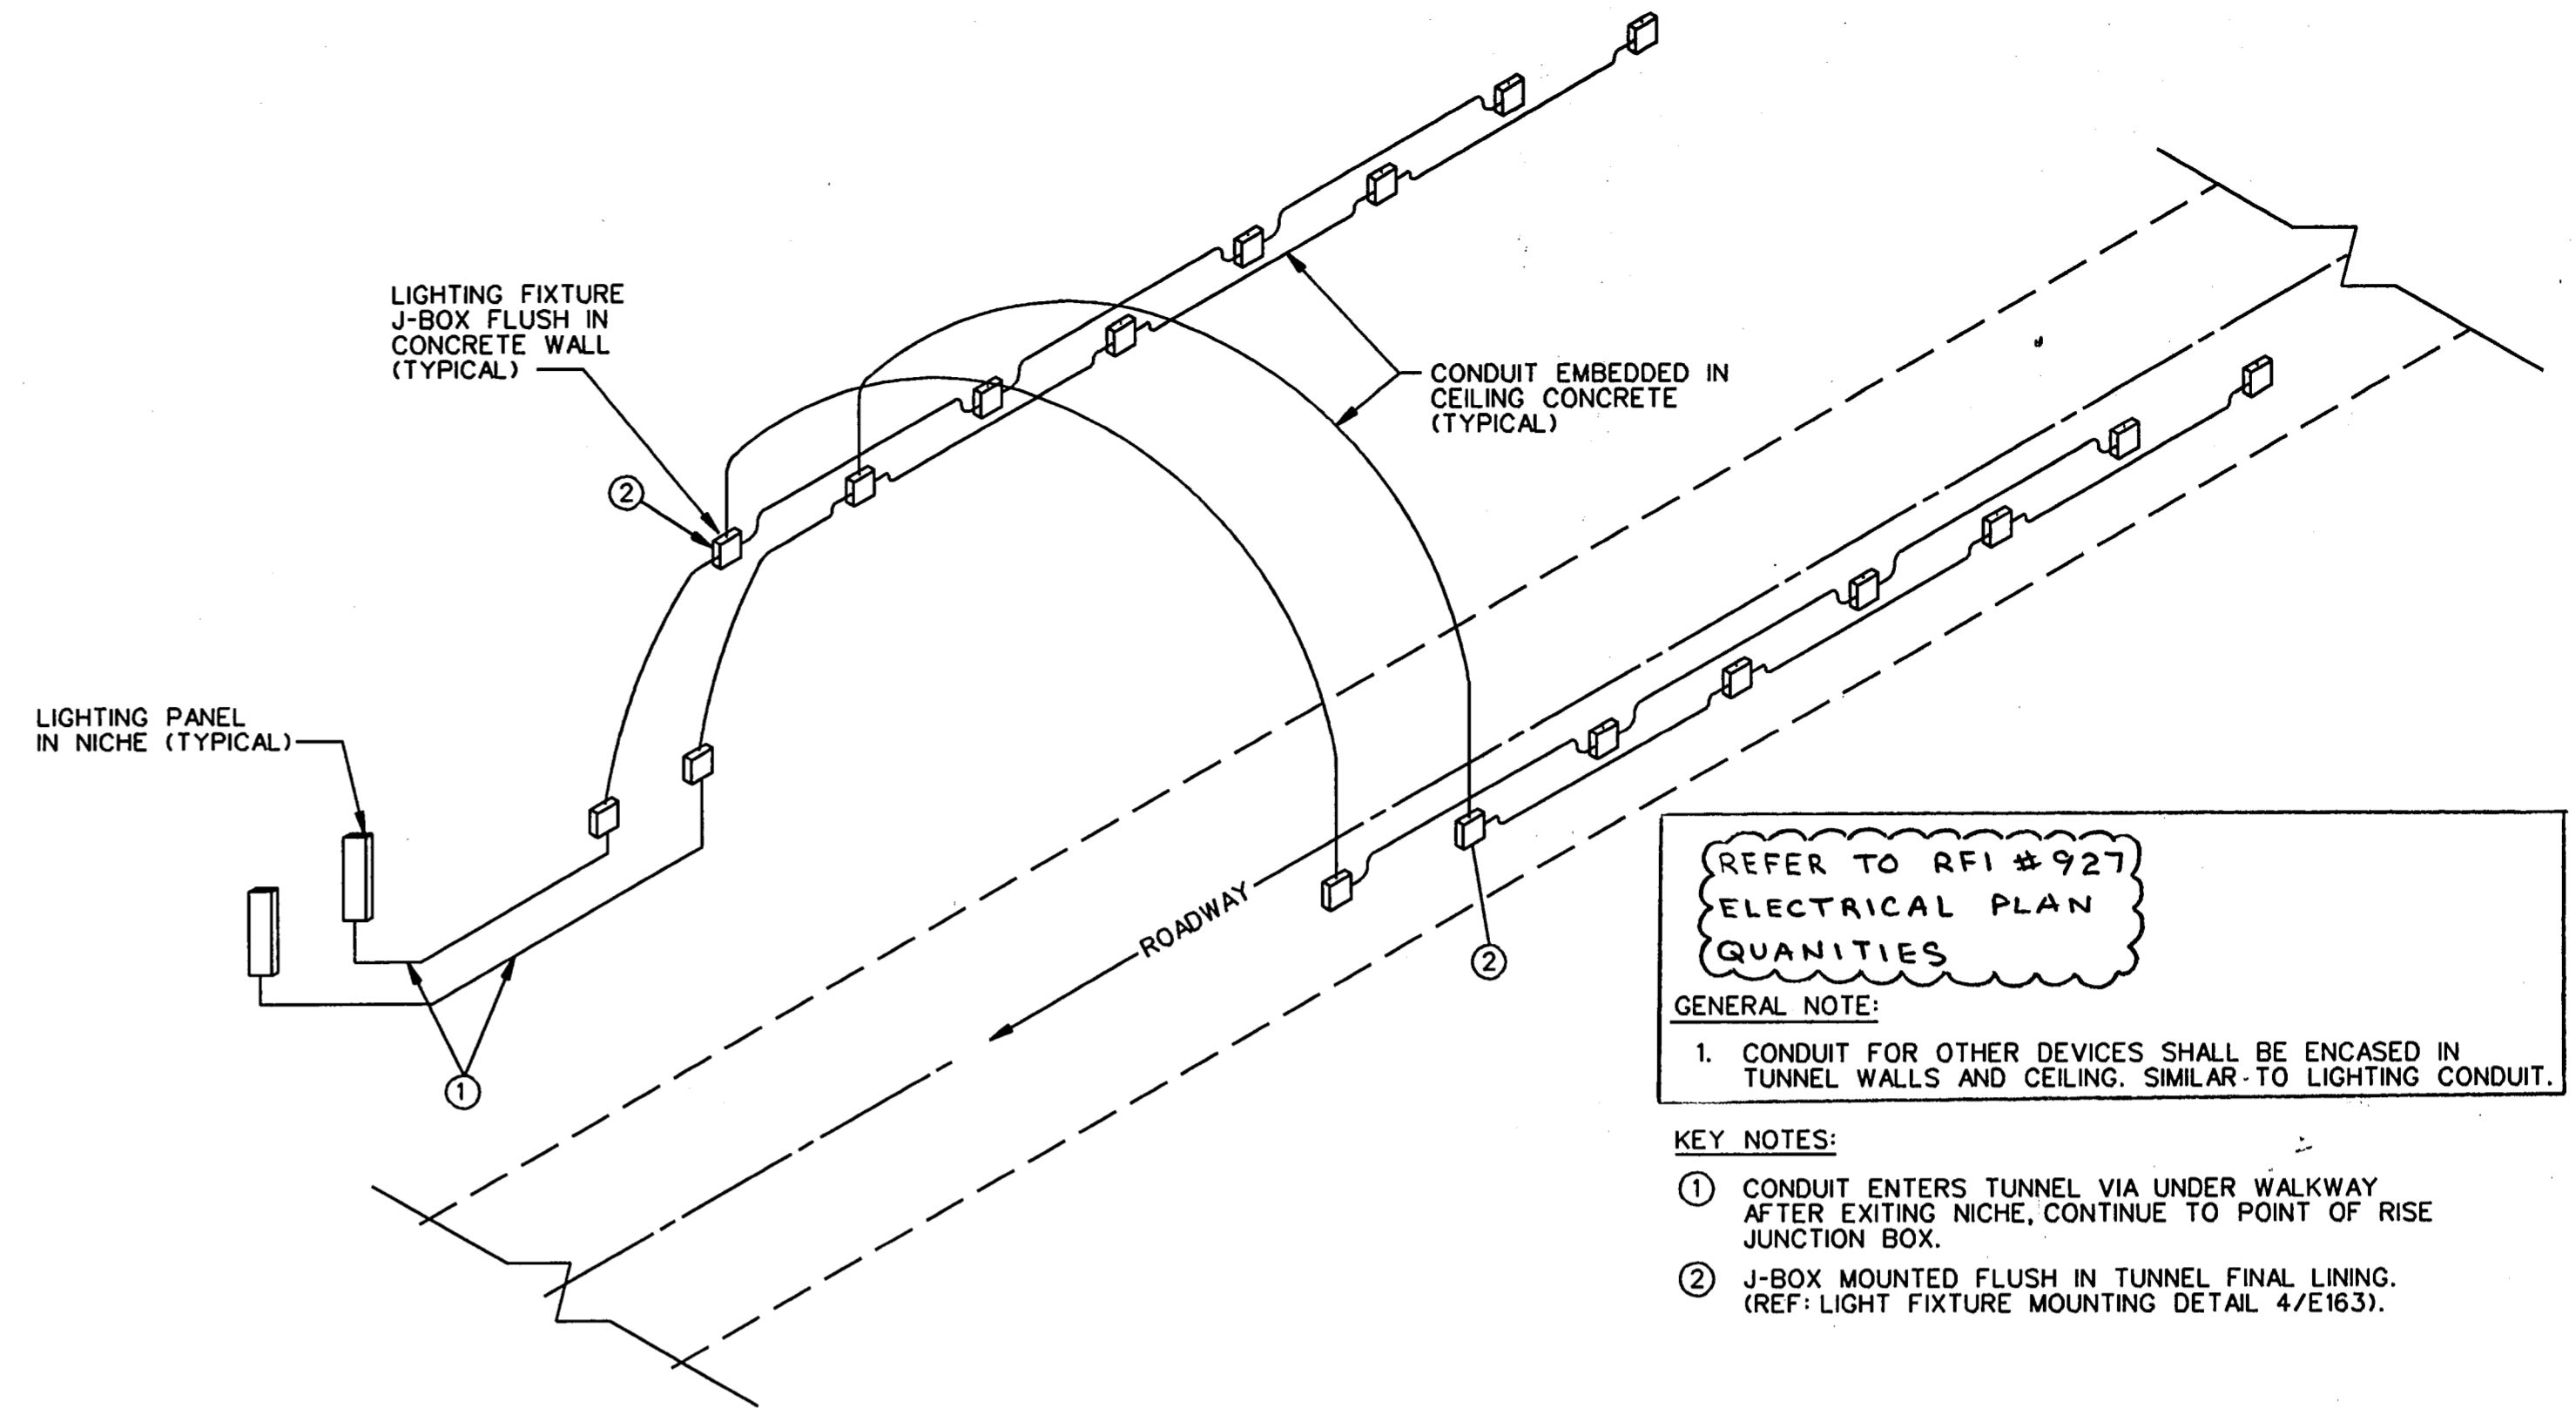


REFER TO RFI #927  
ELECTRICAL PLAN  
QUANTITIES


GENERAL NOTE:  
1. CONDUIT FOR OTHER DEVICES SHALL BE ENCASED IN TUNNEL WALLS AND CEILING, SIMILAR TO LIGHTING CONDUIT.

- KEY NOTES:
- CONDUIT ENTERS TUNNEL VIA UNDER WALKWAY AFTER EXITING NICHE, CONTINUE TO POINT OF RISE JUNCTION BOX.
  - J-BOX MOUNTED FLUSH IN TUNNEL FINAL LINING. (REF: LIGHT FIXTURE MOUNTING DETAIL 4/E163).


2 TYPICAL TUNNEL CONDUIT SYSTEM DETAIL  
E166 NO SCALE

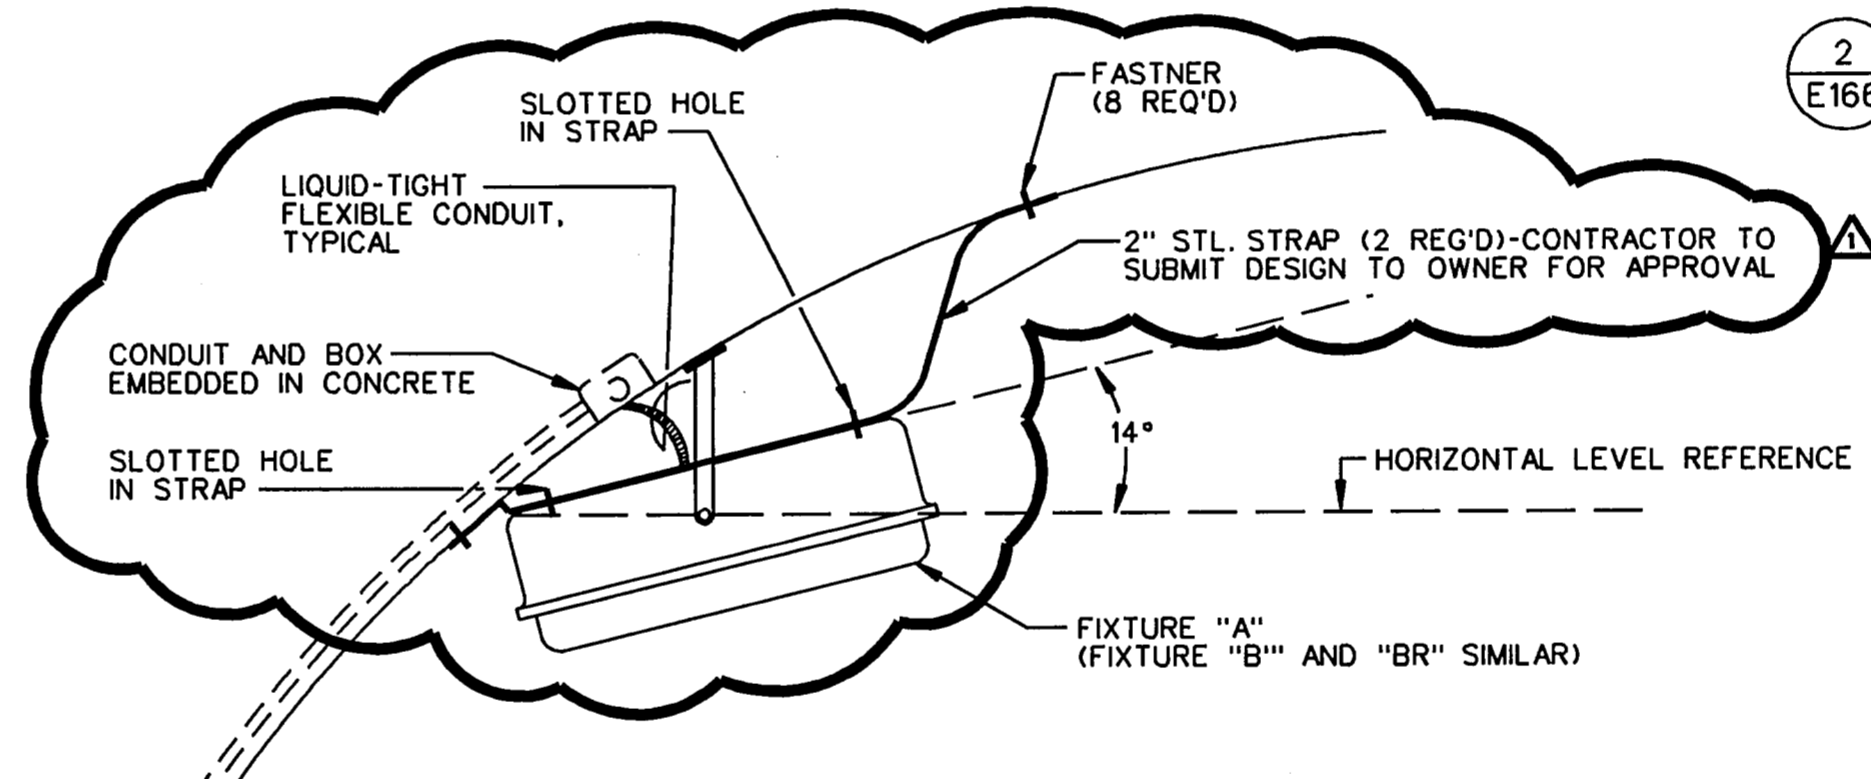

5 TYPICAL TUNNEL LIGHTING FIXTURE MOUNTING DETAIL  
E166 NO SCALE

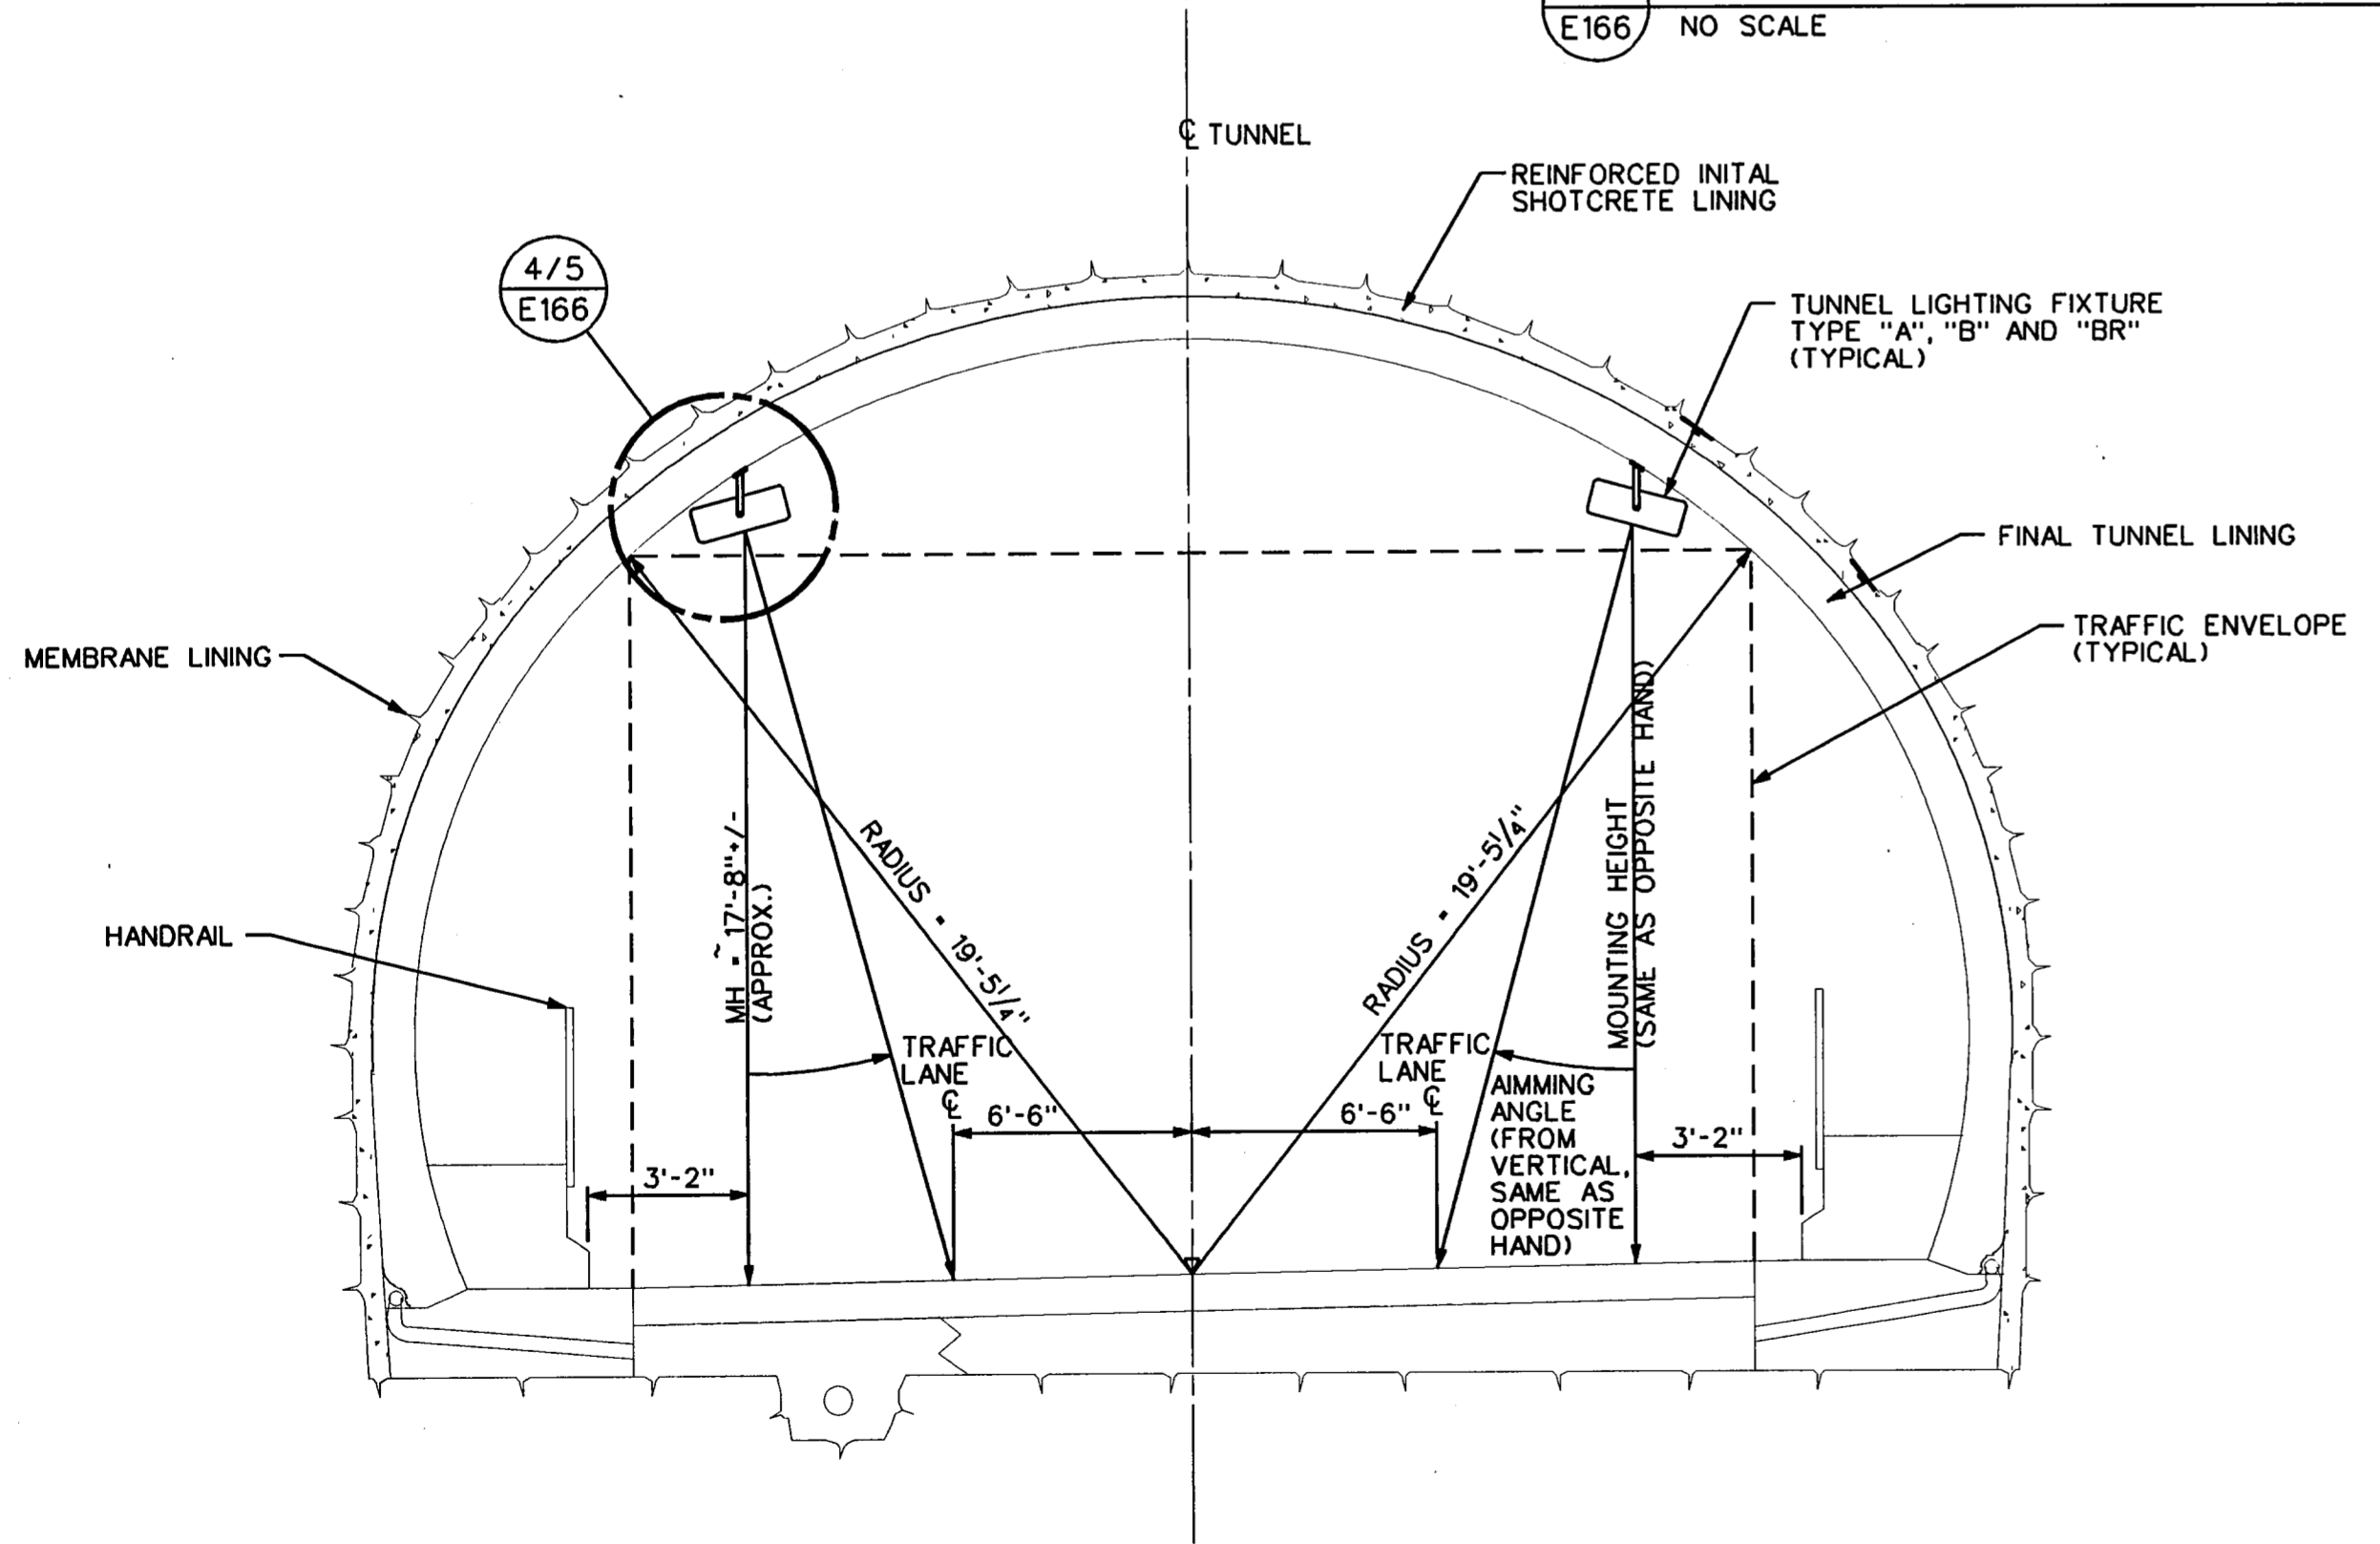


3 TUNNEL CROSS SECTION/LIGHTING FIXTURE MOUNTING AND AIMING DETAIL  
E166 NO SCALE

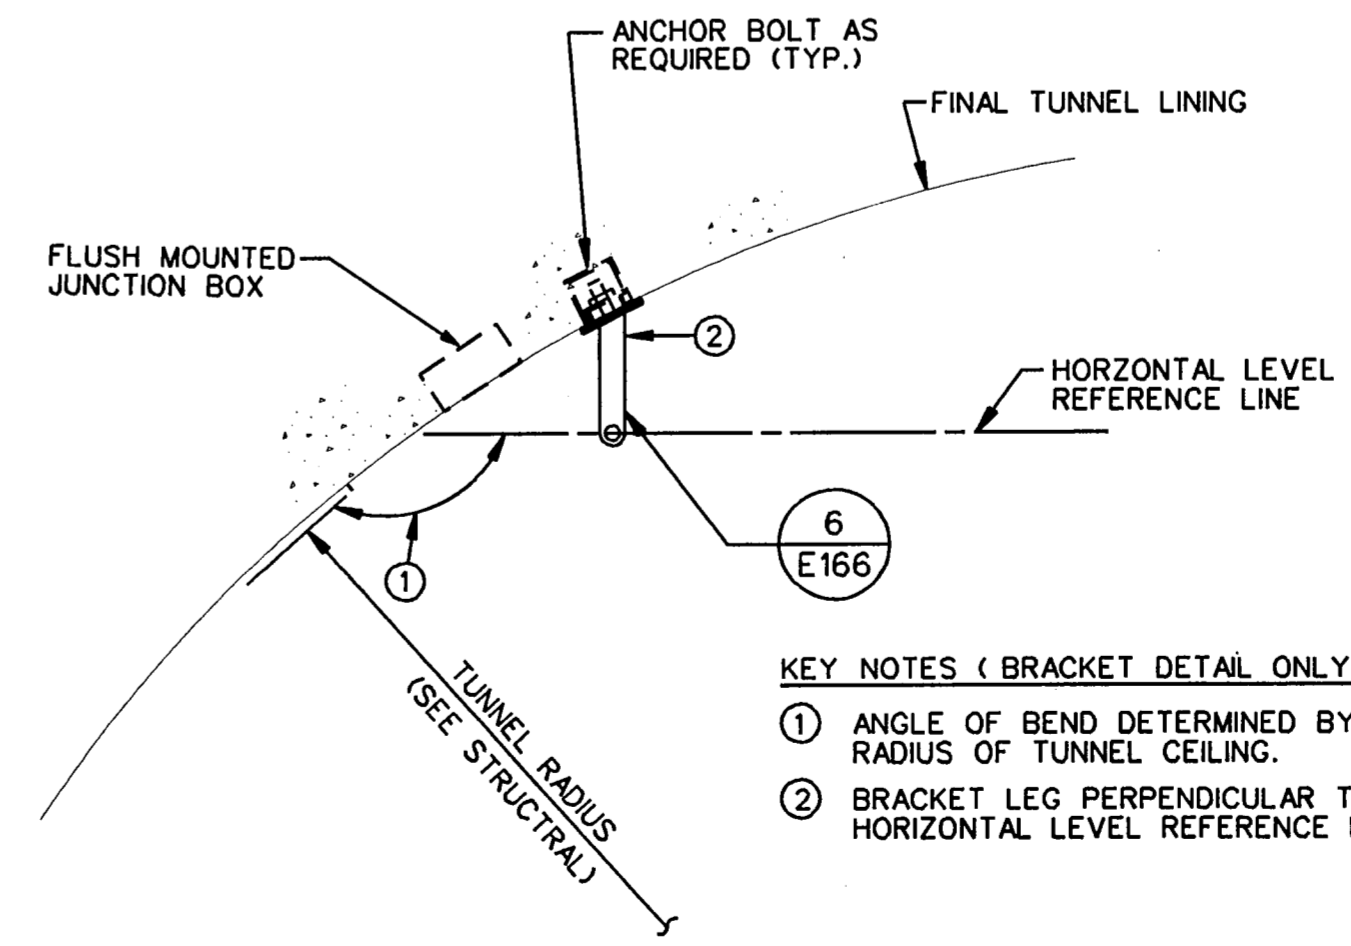

4 TYPICAL TUNNEL LIGHTING FIXTURE MOUNTING BRACKET DETAIL  
E166 NO SCALE

- KEY NOTES (BRACKET DETAIL ONLY):
- ANGLE OF BEND DETERMINED BY RADIUS OF TUNNEL CEILING.
  - BRACKET LEG PERPENDICULAR TO HORIZONTAL LEVEL REFERENCE LINE.

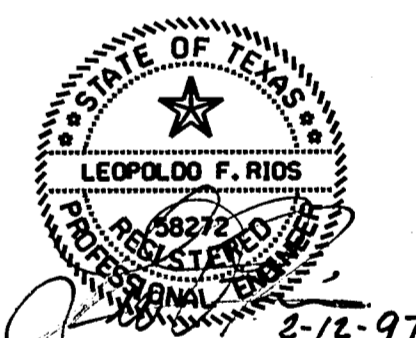

THE SEAL APPEARING ON THIS DOCUMENT WAS AUTHORIZED BY LEOPOLDO F. RIOS, P.E., 58272 ON SEPTEMBER 9, 1996

FINAL RECORD DRAWING  
Date: 12/25/99

2 REVISED PER RFI #927  
ADDENDUM No. 1 LR 2/12/97


No.	REVISION	BY	DATE

TEXAS TURNPIKE AUTHORITY  
ADDISON AIRPORT TUNNEL


DETAILS

HDR Engineering, Inc.		SECTION XIII
DRAWN: WTD	DATE: 12/05/96	DESIGNED: LR DATE: 08/28/96
CHECKED: BL	DATE: 08/28/96	SCALE: NONE
CONTRACT No. DNT-260 SHEET E166 OF 166		



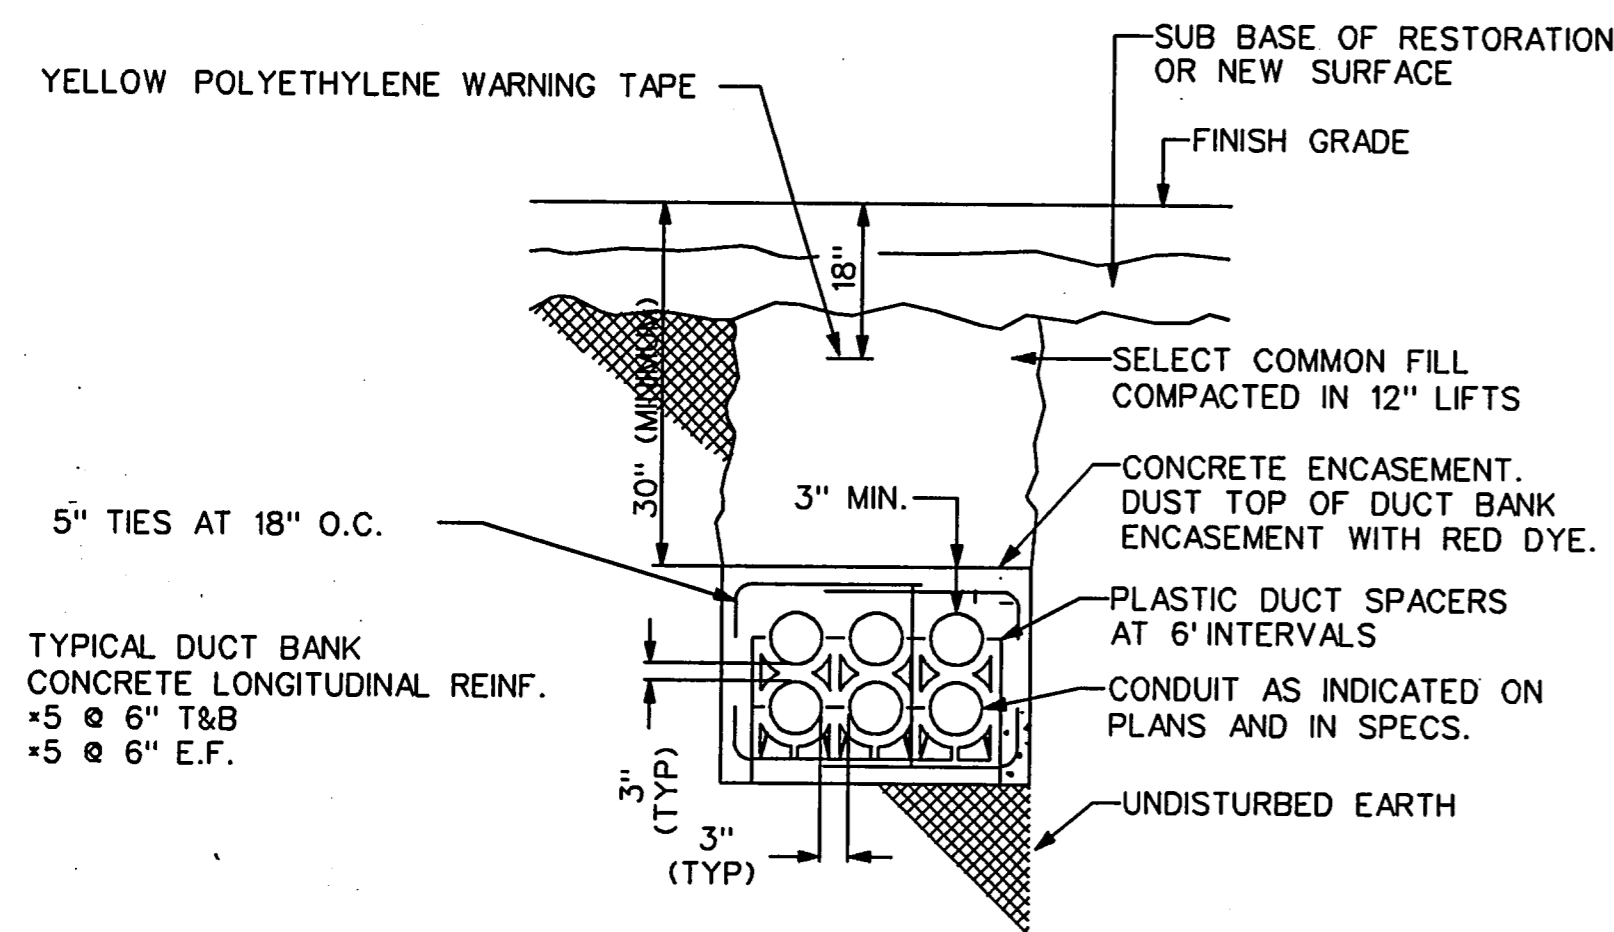


1 TYPICAL REINFORCED CONDUIT DUCT DETAIL  
E166A NO SCALE

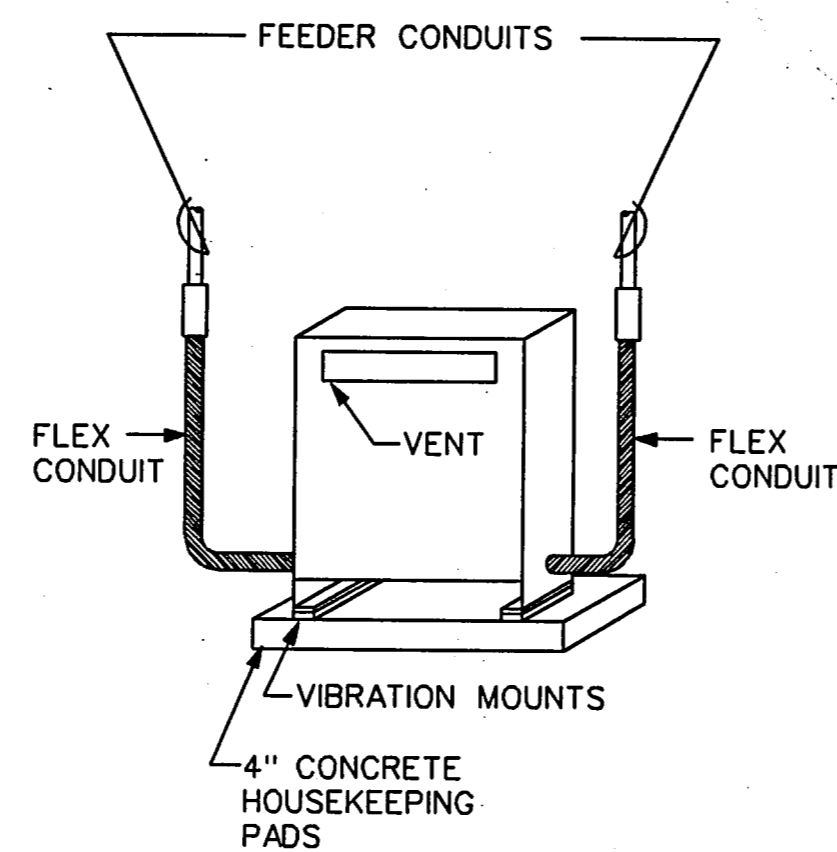

2 TYPICAL FLOOR MOUNTED TRANSFORMER DETAIL  
E166A NO SCALE

- NOTES:
1. MAINTAIN MINIMUM OF 6" DISTANCE FROM VERTICAL CONSTRUCTION (WALLS, DUCTS, ETC.) AND 12" FROM ALL HORIZONTAL CONSTRUCTIONS (CEILINGS, DUCTS, ETC.)
  2. FLEXIBLE CONDUIT SHALL BE LENGTH IN SPECIFICATIONS AND POSITIONED TO AVOID TRANSMISSION OF VIBRATION.
  3. VIBRATION ISOLATORS SHALL BE SUBMITTED FOR APPROVAL.

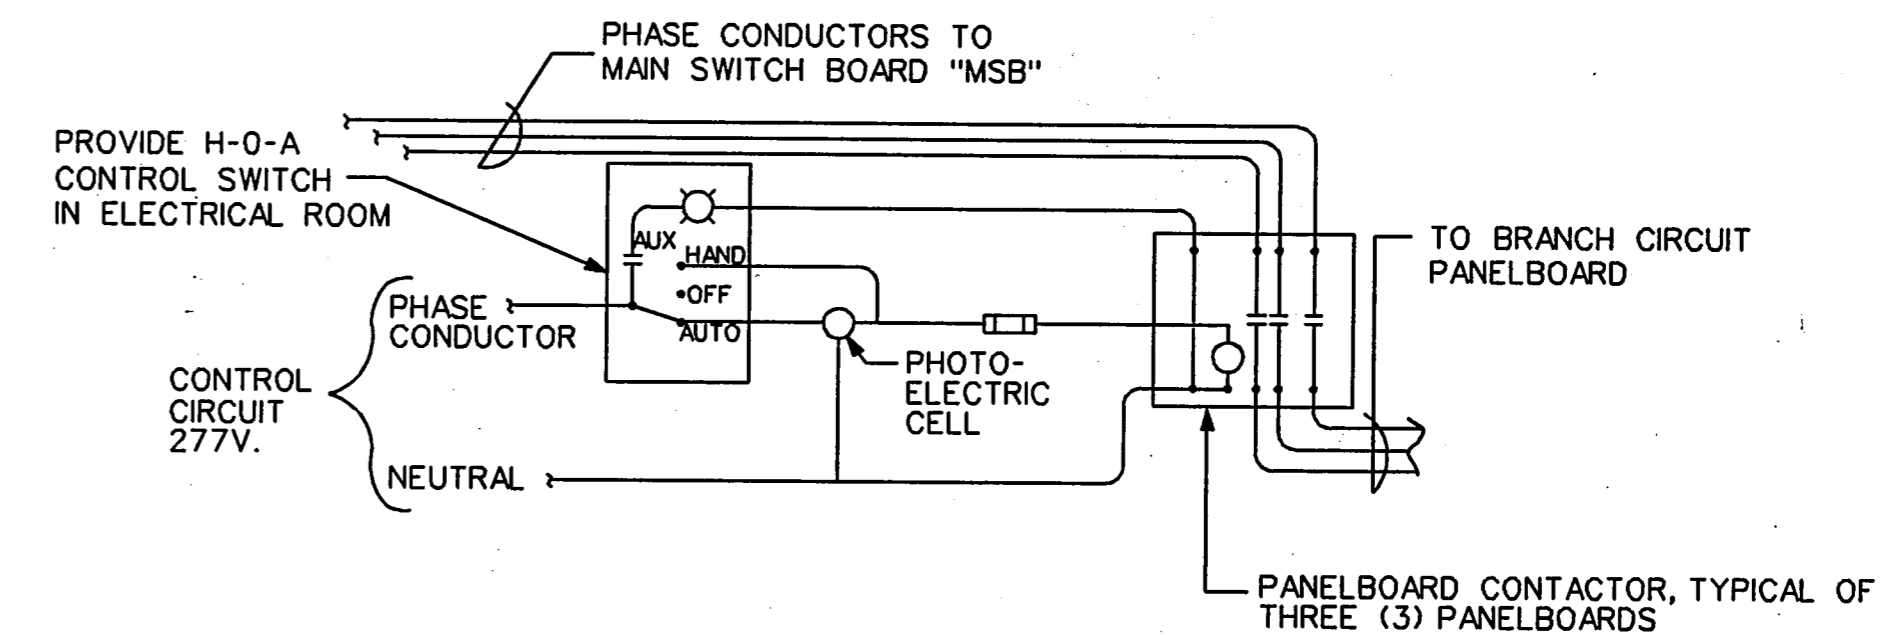

NOTE:  
LIGHTING CONTROL SIMILAR EXCEPT SINGLE PHASE.

3 TYPICAL PHOTOELECTRIC CELL/  
CONTRACTOR CONTROL DETAIL  
E166A NO SCALE



THE SEAL APPEARING ON THIS DOCUMENT WAS AUTHORIZED BY LEOPOLDO F. RIOS, P.E., 58272 ON SEPTEMBER 9, 1996

FINAL RECORD  
DRAWING  
Date: 12/25/99

No.	REVISION	BY	DATE
TEXAS TURNPIKE AUTHORITY ADDISON AIRPORT TUNNEL			
DETAILS			
HDR HDR Engineering, Inc.			SECTION XIII
DRAWN: WTQ	DATE: 12/05/96	DESIGNED: LR	DATE: 08/28/96
CHECKED: PL	DATE: 08/28/96	SCALE: NONE	
CONTRACT No. DNT-260 SHEET E166A OF 166			

# NORTH TEXAS TOLLWAY AUTHORITY

## CONTRACT NO. DNT-260

# SIGNING, PAVEMENT MARKING, AND ILLUMINATION PLANS

SECTION XIII

VOL. 4


# ADDISON AIRPORT TUNNEL

STANDARD DRAWINGS

SHEET NO.	NTTA STANDARDS
27	CANTILEVER OVERHEAD SIGN SUPPORTS (STD. NO. SS-23)
28	CANTILEVER OVERHEAD SIGN SUPPORT DETAILS (STD. NO. SS-24)
29	CANTILEVER OVERHEAD SIGN SUPPORT FOUNDATION (STD. NO. SS-25)
30	SIGN LIGHTING (ELECTRICAL DETAILS) (STD. NO. SS-26)
31	SUPPORT BRACKETS FOR SIGNS, WALKWAY & LIGHTS (STD. NO. SS-27)
<b>TxDOT STANDARDS</b>	
32	IM(2)-93 (MOD.)
33	IM(5)-93
34	PM(1)-95
35	PM(3)-92
36	RPM(1)-92
37	R(1)-95 (MOD.)
38	R(2)-95 (MOD.)
39	R(3)-95 (MOD.)
40	R(4)-95A (MOD.)
41	W(1)-95 (MOD.)
42	W(2)-95 (MOD.)
43	SMD(1-1)-95 (MOD.)
44	SMD(1-2)-95 (MOD.)
45	SMD(1-3)-95
46	SMD(1-4)-95 (MOD.)
47	SMD(2-1)-95
48	SMD(2-2)-95
49	SMD(2-3)-95 (MOD.)
50	SMD(P-1) (MOD.)
51	SB(SWL-1) (MOD.)
52	TCP NOTES-95

INDEX OF SHEETS

SHEET NO.	DESCRIPTION
1	TITLE SHEET
2	ESTIMATE & QUANTITY SUMMARY
3,4	QUANTITY/ITEM SUMMARIES
5	SUMMARY OF LARGE SIGNS
6,7	SUMMARY OF SMALL SIGNS
8-10	SIGNING & PAVEMENT MARKING LAYOUT
11,12	SIGN DETAILS
13,14	CANTILEVER OVERHEAD SIGN STRUCTURE
15,16	PORTAL OVERHEAD SIGN ATTACHMENT LOCATION
17	TUNNEL PORTAL SIGN MOUNTING DETAILS
18-23	ROADWAY ILLUMINATION LAYOUT
24-26	MISCELLANEOUS ELECTRICAL DETAILS

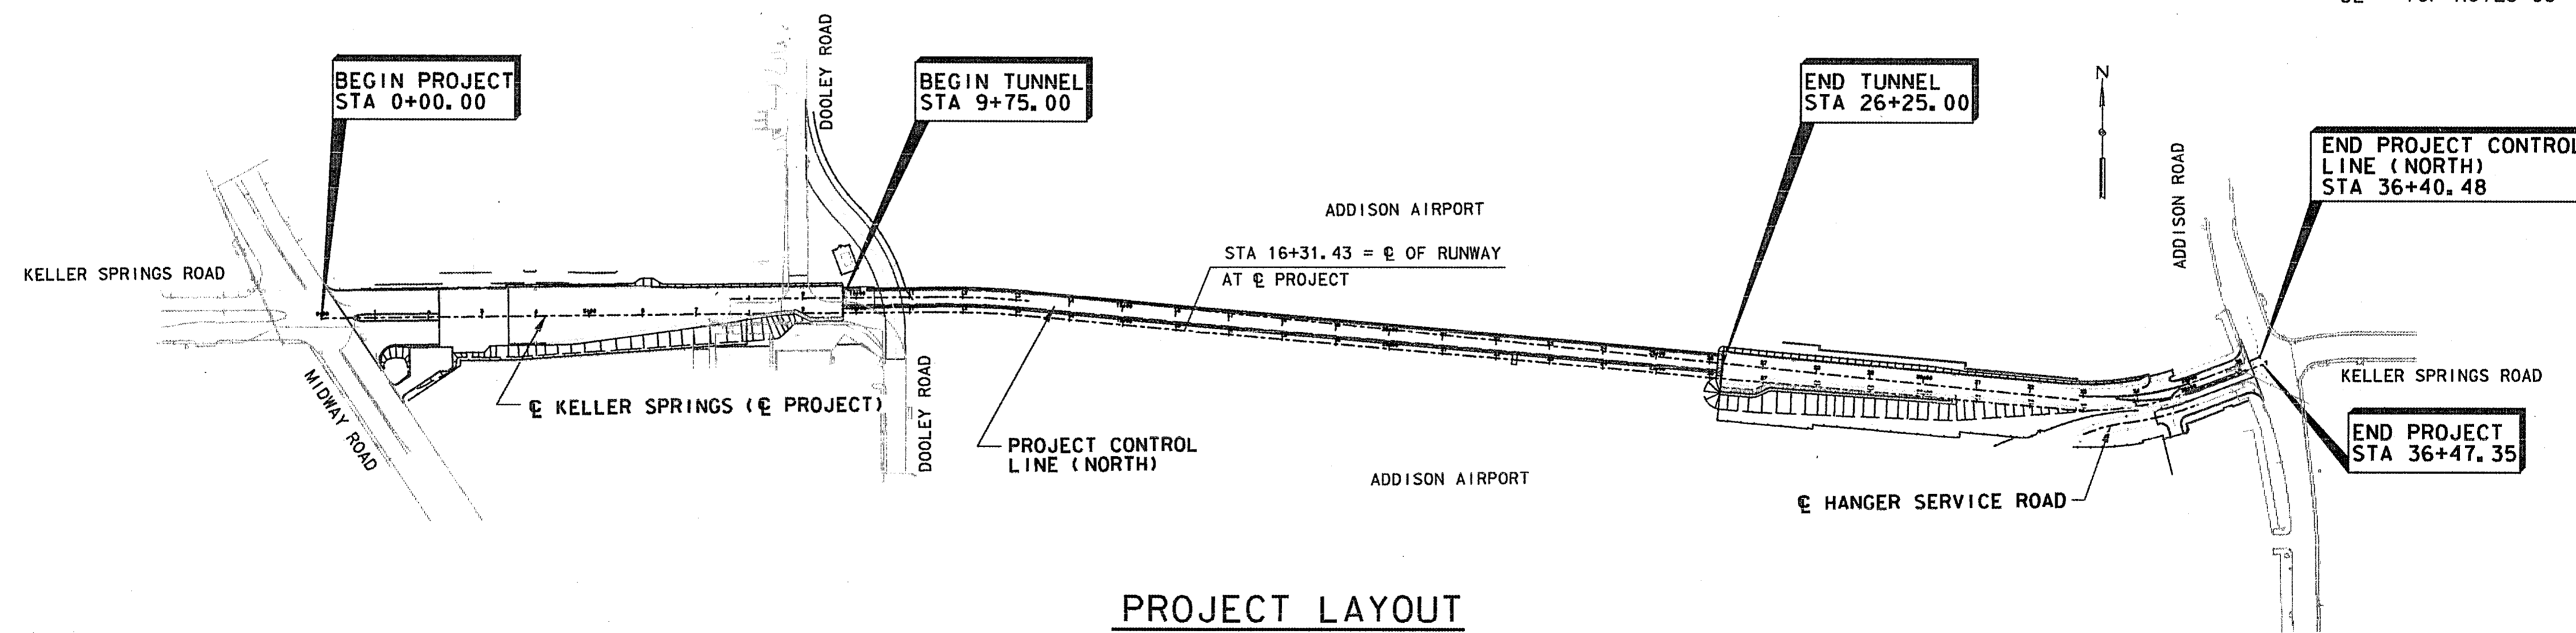

PROJECT LAYOUT

SCALE: 1" = 200'

AT ANY LOCATION WITHIN THESE PLANS AND ACCOMPANYING SPECIFICATIONS, PROPOSALS, AND CONTRACT WHERE THE WORDS "TEXAS TURNPIKE AUTHORITY" APPEAR, THESE WORDS SHALL, BY DEFINITION, MEAN THE "NORTH TEXAS TOLLWAY AUTHORITY", A BODY POLITIC AND CORPORATE AND A POLITICAL SUBDIVISION OF THE STATE OF TEXAS.

THE STANDARD SHEETS SPECIFICALLY IDENTIFIED ABOVE HAVE BEEN SELECTED BY ME, OR UNDER MY RESPONSIBLE SUPERVISION, AS BEING APPLICABLE TO THE PROJECT.

*RK Laird* P. E. 1/12/99  
DATE



Prepared by:  
MATEO CONSULTING ENGINEERS, INC.

Recommended by:  
HNTB CORPORATION

Recommended by:  
THE GINN CORPORATION

Recommended by:  
NORTH TEXAS TOLLWAY AUTHORITY

Approved by:  
NORTH TEXAS TOLLWAY AUTHORITY

*Mateo Foy*  
Project Manager  
Date: 1/14/99

*Daniel B. Baker*  
Consulting Engineer  
Date: 01/15/99

*Fl. Wayne Smith PE.*  
Project Engineer  
Date: 1/18/99

*Maria Bourne*  
Project Engineer  
Date: 1-15-99

*Christina*  
Executive Director  
Date: 1/15/99

FINAL RECORD  
DRAWING  
Date: 12/25/99

### ESTIMATE SUMMARY

ITEM NO.	DESCRIPTION	UNIT	TOTAL			ITEM NO.	DESCRIPTION	UNIT	TOTAL	
			EST.	FINAL					EST.	FINAL
500 AND SP	MOBILIZATION	LS	1.00	1.00		SS 760	LIGHTING POLE FOUNDATIONS	EA	17.00	17.00 ✓
636 AND SP	ALUMINUM SIGNS (TY A)(GROUND MOUNT)	SF	36.00	36.00 ✓		SS 760	GROUND WIRE (#6 BARE)	LF	554.00	554.00 ✓
636 AND SP	ALUMINUM SIGNS (TY A)(OVERHEAD)	SF	224.25	224.30 ✓		SS 760	GROUND WIRE (#8 BARE)	LF	1096.00	1,096.00 ✓
636 AND SP	ALUMINUM SIGNS (TY A)(PORTAL)	SF	117.00	117.00 ✓		SS 760	GROUND WIRE (#10 BARE)	LF	463.00	463.00 ✓
644 AND SP	SMALL ROADSIDE TRAFFIC SIGN (TY A MOUNT)	EA	25.00	25.00 ✓		SS 760	CONDUCTOR (#6 THHN/THWN)	LF	908.00	908.00 ✓
644 AND SP	SMALL ROADSIDE TRAFFIC SIGN (TY A B-B MOUNT)	EA	1.00	1.00 ✓		SS 760	CONDUCTOR (#8 THHN/THWN)	LF	6170.00	6,170.00 ✓
644 AND SP	SMALL ROADSIDE TRAFFIC SIGN (TY A-1 MOUNT)	EA	5.00	5.00 ✓		SS 760	CONDUCTOR (#10 THHN/THWN)	LF	3627.00	3,627.00 ✓
644 AND SP	SMALL ROADSIDE TRAFFIC SIGN (TY B MOUNT)	EA	10.00	10.00 ✓		SS 760	GROUND PULL BOXES (13"X24" )(INSTALL)	EA	8.00	8.00 ✓
644 AND SP	SMALL ROADSIDE TRAFFIC SIGN (TY D-2 MOUNT)	EA	4.00	4.00 ✓		SS 760	DUCT-CABLE (2 #6)(2 #8)(1 #6 GRND)(1 1/4" CONDUIT)	LF	801.00	801.00 ✓
644 AND SP	SMALL ROADSIDE TRAFFIC SIGN (TY D-6 MOUNT)	EA	2.00	2.00 ✓		SS 760	DUCT-CABLE (2 #8)(1 #8 GRND)(1 1/4" CONDUIT)	LF	1240.00	1,240.00 ✓
644 AND SP	SMALL ROADSIDE TRAFFIC SIGN (STRUCTURE MOUNT)	EA	2.00	2.00 ✓		SS 760	DISTRIBUTION AND CONTROL CENTER	LS	1.00	1.00 ✓
647 AND SP	LARGE ROADSIDE SIGN SUPPORTS (STRUCT STL)	LBS	255.20	255.20 ✓		SS 760	CONDUIT (1" GRS)	LF	150.00	150.00 ✓
650 AND SP	OVERHEAD SIGN SUPPORTS (30' CANTILEVER)	EA	2.00	2.00 ✓		SS 760	CONDUIT (1 1/2" GRS)	LF	285.00	285.00 ✓
666 AND SP	REFL PVMT MRKGS (TY I)(WHITE, 4" SOLID)	LF	6625.00	6,625.00 ✓	101	SS 760	SIGN-MOUNT SIGNAL LIGHTS (INSTALL)	PAIR	5.00	5.00 ✓
666 AND SP	REFL PVMT MRKGS (TY I)(WHITE, 4" BROKEN)	LF	70.00	70.00 ✓		SS 760	SIGN FACE LUMINAIRES (INSTALL)	EA	6.00	6.00 ✓
666 AND SP	REFL PVMT MRKGS (TY I)(WHITE, 18" SOLID)	LF	185.00	185.00 ✓	174	SS 760	FUSED CONNECTOR KITS (INSTALL)	EA	56.00	56.00 ✓
672 AND SP	RAISED PAVEMENT MARKERS (TY II-A-A)(CL B)	EA	310.00	310.00 ✓		SS 760	UNFUSED (WIRE) CONNECTOR KITS (INSTALL)	EA	28.00	28.00 ✓
672 AND SP	RAISED PAVEMENT MARKERS (TY II-C-R)(CL B)	EA	7.00	7.00 ✓						
672 AND SP	RAISED PVMT MARKERS (TY Y)(CL C)(TRAF BTN)	EA	925.00	925.00 ✓	1028					
672 AND SP	RAISED PVMT MARKERS (TY Y)(CL A)(JIGGLE BAR)	EA	156.00	156.00 ✓	11					
SS 760	LIGHTING POLE LUMINAIRES (II-400-10-40MH)(INSTALL)	EA	13.00	13.00 ✓						
SS 760	LIGHTING POLE LUMINAIRES (III-400-10-40MH)(INSTALL)	EA	4.00	4.00 ✓						
SS 760	LIGHTING POLE FLOODLIGHT (400 FLOOD-40MH)(INSTALL)	EA	10.00	10.00 ✓						
SS 760	LIGHTING POLE (GROUND MOUNTED) (INSTALL)	EA	17.00	17.00 ✓						
SS 760	LIGHTING POLE (WALL MOUNTED)(INSTALL)	EA	4.00	4.00 ✓						
SS 760	WALL MOUNTED LUMINAIRES (150W)(INSTALL)	EA	5.00	5.00 ✓						
SS 760	WALL MOUNTED LUMINAIRES WITH SWITCH (150W)(INSTALL)	EA	2.00	2.00 ✓						

THE SEAL APPEARING ON THIS DOCUMENT WAS AUTHORIZED BY RICHARD K. LAIRD, P.E. NO. 59187 ON JANUARY 12, 1999. ALTERATION OF A SEALED DOCUMENT WITHOUT PRIOR NOTIFICATION TO THE RESPONSIBLE ENGINEER IS AN OFFENSE UNDER THE TEXAS ENGINEERING PRACTICE ACT.

**FINAL RECORD DRAWING**  
Date: 12/25/99



No.	REVISION	BY	DATE
NORTH TEXAS TOLLWAY AUTHORITY ADDISON AIRPORT TUNNEL			
ESTIMATE & QUANTITY SUMMARY			
MATED CONSULTING ENGINEERS, INC. <small>5540 PETERSON LANE SUITE 225 DALLAS, TEXAS 75240 (972) 233-6700</small>			SECTION XIII
DRAWN: SA	DATE: 5/97	DESIGNED: SA	DATE: 5/97
CHECKED: RKL	DATE: 5/97	SCALE: NONE	
CONTRACT No. DNT-260 SHEET 2 OF 52			

ITEM NO. 636 & SP  
SUMMARY OF ALUMINUM SIGNS (TY A)

SHEET NO.	LOCATION	QUANTITY, SF		
		GROUND MOUNT	OVERHEAD	PORTAL *
8	MIDWAY RD. - STA. 10+00	36.00	100.75	58.50
9	STA. 10+00 - STA. 33+00		-	58.50
10	STA. 33+00 - ADDISON RD.		123.50	
	TOTAL	36.00	224.25	117.00

\* MATERIALS & LABOR FOR SIGN MOUNTING TO BE SUBSIDIARY TO PORTAL SIGN.

ITEM NO. 666 & SP  
SUMMARY OF REFL PVMT MARKINGS (TY 1)

SHEET NO.	LOCATION	QUANTITY, EA		QUANTITY, LF		
		WHITE				
		ARROW	WORD	4" SOLID	4" BROKEN	18" SOLID
8	MIDWAY RD. - STA. 10+00			1720		141
9	STA. 10+00 - STA. 33+00			4600	10	
10	STA. 33+00 - ADDISON RD.			305	60	44
	TOTAL			6625	70	185

ITEM NO. SS 760  
SUMMARY OF LIGHTING POLE LUMINAIRES (INSTALL)\*

SHEET NO.	LOCATION	QUANTITY, EA	
		11-400-10-40MH	111-400-10-40MH
18	MIDWAY RD. - STA. 3+50	2	-
19	STA. 3+50 - STA. 8+00	4	2
21	STA. 23+00 - STA. 28+00	1	1
22	STA. 28+00 - STA. 33+00	4	-
23	STA. 33+00 - ADDISON RD.	2	1
	TOTAL	13	4

\* ALL LUMINAIRES SHALL BE PROVIDED BY NTTA.

ITEM NO. 644 & SP  
SUMMARY OF SMALL ROADSIDE SIGN ASSEMBLIES

SHEET NO.	LOCATION	QUANTITY, EA						
		TY A	TY A (B-B)	TY A-1	TY B	TY D-2	TY D-6	SM
8	MIDWAY RD. - STA. 10+00	11.00		1.00	6.00	2.00	1.00	1.00
9	STA. 10+00 - STA. 33+00	5.00						1.00
10	STA. 33+00 - ADDISON RD.	9.00	1.00	4.00	4.00	2.00	1.00	
	TOTAL	25.00	1.00	5.00	10.00	4.00	2.00	2.00

ITEM NO. 672 & SP  
SUMMARY OF RAISED PAVEMENT MARKERS

SHEET NO.	LOCATION	QUANTITY, EA			
		CL B	CL C	CL B	CL A
		TY 11-A-A	TY Y TRAF BTN	TY 11-C-R	TY Y JIGGLE BAR
8-10	MIDWAY RD. - ADDISON RD.	310	925	7	156
	TOTAL	310	925	7	156

ITEM NO. SS 760  
SUMMARY OF LIGHTING POLE FLOODLIGHTS (INSTALL)\*

SHEET NO.	LOCATION	QUANTITY, EA
18	MIDWAY RD. - STA. 3+50	6
19	STA. 3+50 - STA. 8+00	4
	TOTAL	10

\* ALL FLOODLIGHTS SHALL BE PROVIDED BY NTTA.

ITEM NO. 647 & SP  
SUMMARY OF LARGE ROADSIDE SIGN SUPPORTS

SHEET NO.	LOCATION	QUANTITY, LBS
		MOUNT TYPE 321
8	STA. 1+75	255.20
	TOTAL	255.20

ITEM NO. SS 760  
SUMMARY OF SIGN-MOUNT SIGNAL LIGHTS (INSTALL)\*

SHEET NO.	LOCATION	QUANTITY, PAIR
8	STA. 1+75, MEDIAN SIGN	1.00
8	STA. 6+05, LT. CANT. SIGN	1.00
8	STA. 9+75, OVERHEAD STRUC	1.00
9	STA. 26+25, OVERHEAD STRUC	1.00
10	STA. 35+15, LT. CANT. SIGN	1.00
	TOTAL	5.00

\* ALL SIGN-MOUNT SIGNAL LIGHTS SHALL BE PROVIDED BY NTTA.

ITEM NO. SS 760  
SUMMARY OF LIGHTING POLES (INSTALL)\* AND LIGHTING POLE FOUNDATIONS

SHEET NO.	LOCATION	GROUND MOUNTED POLES EA	LIGHTING POLE FOUNDATIONS EA	POLES MOUNTED ON EXISTING WALL EA
18	MIDWAY RD. - STA. 3+50	5	5	-
19	STA. 3+50 - STA. 8+00	4	4	4
21	STA. 23+00 - STA. 28+00	2	2	-
22	STA. 28+00 - STA. 33+00	4	4	-
23	STA. 33+00 - ADDISON RD.	2	2	-
	TOTAL	17	17	4

\* ALL LIGHTING POLES SHALL BE PROVIDED BY NTTA.

ITEM NO. 650 & SP  
SUMMARY OF OVERHEAD SIGN SUPPORTS

SHEET NO.	LOCATION	CANT. SPAN X TOWER HEIGHT	QUANTITY, EA
8	STA. 6+05, LT.	30'-0" X 16'-0"	1.00
10	STA. 35+15, LT.	30'-0" X 22'-6"	1.00
	TOTAL		2.00

ITEM NO. SS 760  
SUMMARY OF SIGN FACE LUMINAIRES (INSTALL)\*

SHEET NO.	LOCATION	QUANTITY, EA
8	STA. 6+05, LT. CANT. SIGN	2.00
10	STA. 35+15, LT. CANT. SIGN	4.00
	TOTAL	6.00

\* ALL SIGN LIGHTS SHALL BE PROVIDED BY NTTA.

THE SEAL APPEARING ON THIS DOCUMENT WAS AUTHORIZED BY RICHARD K. LAIRD, P.E. NO. 59187 ON JANUARY 12, 1999. ALTERATION OF A SEALED DOCUMENT WITHOUT PRIOR NOTIFICATION TO THE RESPONSIBLE ENGINEER IS AN OFFENSE UNDER THE TEXAS ENGINEERING PRACTICE ACT.



FINAL RECORD  
DRAWING  
Date: 12/25/99

No.	REVISION	BY	DATE
NORTH TEXAS TOLLWAY AUTHORITY ADDISON AIRPORT TUNNEL			
QUANTITY/ITEM SUMMARIES			
MATED CONSULTING ENGINEERS, INC. 5540 PETERSON LANE SUITE 225 DALLAS, TEXAS 75240 (972) 233-6700			SECTION XIII
DRAWN: TMF	DATE: 5/97	DESIGNED: RKL	DATE: 5/97
CHECKED: SCF	DATE: 5/97	SCALE: NONE	
CONTRACT No. DNT-260 SHEET 3 OF 52			

ITEM NO. SS 760  
SUMMARY OF CONDUITS AND CONDUCTORS

CONDUIT AND CONDUCTOR RUNS (SHEETS 18, 19 & 20)											CONDUIT AND CONDUCTOR RUNS (SHEETS 21, 22 & 23)													
RUN No.	GROUND LENGTH (FEET)		CONDUCTOR No. & LENGTH (FEET)		DUCT-CABLE CONDUCTOR NUMBER & LENGTH (FEET)				CONDUIT (FEET)		RUN No.	GROUND LENGTH (FEET)		CONDUCTOR No. & LENGTH (FEET)		DUCT-CABLE CONDUCTOR NUMBER & LENGTH (FEET)				CONDUIT (FEET)				
	#8 BARE	#10 BARE	#8 THHN/THWN	#10 THHN/THWN	GROUND BARE #8	#8 THHN/THWN	#10 THHN/THWN	1 1/4" POLY DUCT	1 1/2" GRS	1" GRS		#6 BARE	#8 BARE	#10 BARE	#6 THHN/THWN	#8 THHN/THWN	#10 THHN/THWN	GROUND BARE #6	#8 THHN/THWN	#10 THHN/THWN	1 1/4" POLY DUCT	1 1/2" GRS	1" GRS	
1	1-45		4-45						45		33	300			2-300	5-300	2-300							
2	1-20		4-27								34			1-65			5-65							
3	1-36		4-43								35			1-20			2-20							
4	1-36		4-43								36			1-20			2-20							
5	1-36		4-43								37	1-20			2-20	2-20								
6	1-36		4-43								38	1-41			2-41	2-41	2-50					41		
7	1-56		4-56	2-50							39					2-50	1-131	2-131	2-131		131			
8	1-131		4-131	2-50							40					2-50	1-126	2-126	2-126		126			
9	1-61		4-61								41					2-50	1-126	2-126	2-126		126			
10	1-78		4-78	2-50							42					2-50	1-126	2-126	2-126		126			
11	1-131		4-131	2-50							43					2-50	1-126	2-126	2-126		126			
12	1-81		4-81								44					2-50	1-126	2-126	2-126		126			
13				2-50	1-190		2-190		190		45						1-40	2-40	2-40		40			
14				2-50	1-106		2-106		106		46	1-93		2-93		4-50						28		
15		1-40		2-40						40	47		1-45		4-45								19	
16	1-40	1-40	4-40	2-40					40		48	1-100			4-100							30		
17		1-30		2-30							49			1-16		3-16							16	
18		1-22		2-22																				
19					1-210		4-210		210															
20				2-50	1-131		4-131		131															
21				2-50	1-131		4-131		131															
22				2-50	1-131		4-131		131															
23					1-176		4-176		176															
24				2-50	1-68		4-68		68		TOTAL	554	45	121	908	2112	1953	801		1602	1602	801	99	35
25					1-56		4-56		56															
26	1-91		4-91	2-50					91															
27				2-50	41		2-41		41															
28	1-88		2-88	4-50																				
29		1-25		2-25																			25	
30		1-20		3-20																			20	
31	1-30		4-30																				30	
32	1-55	3-55	2-55						55															
TOTAL	1051	342	4058	1674	1240	-	4286		1240	186	115													

ITEM NO. SS 760  
SUMMARY OF GROUND BOX (13"X24"X12") (INSTALL)\*

SHEET No.	EA.
18	3
19	1
20	2
21	1
23	1
TOTAL	8

\* TO BE PROVIDED BY N.T.T.A.

ITEM NO. SS 760  
SUMMARY OF DISTRIBUTION AND CONTROL CENTER

SHEET NO.	LOCATION	QUANTITY, LS
18-26	VARIOUS	1
TOTAL		1

ITEM NO. SS 760  
SUMMARY OF WALL MOUNTED LUMINAIRES (INSTALL)\*

SHEET NO.	LOCATION	QUANTITY, EA	
		NO SWITCH	WITH SWITCH
20	STA. 8+00 - STA. 13+00	5	1
21	STA. 26+25	-	1
TOTAL		5	2

\* ALL LUMINAIRES SHALL BE PROVIDED BY N.T.T.A.

ITEM NO. SS 760  
SUMMARY OF CONNECTOR KITS

SHEET NO.	LOCATION	QUANTITY, EA	
		FUSED	UNFUSED (WIRE)
18	MIDWAY RD. - STA. 3+50	10	5
19	STA. 3+50 - STA. 8+00	16	8
20	STA. 8+00 - STA. 13+00	12	6
21	STA. 23+00 - STA. 28+00	6	3
22	STA. 28+00 - STA. 23+00	8	4
23	STA. 33+00 - ADDISON RD.	4	2
TOTAL		56	28

THE SEAL APPEARING ON THIS DOCUMENT WAS AUTHORIZED BY RICHARD J. MILLER, P.E. NO. 42812 ON JANUARY 12, 1999. ALTERATION OF A SEALED DOCUMENT WITHOUT PRIOR NOTIFICATION TO THE RESPONSIBLE ENGINEER IS AN OFFENSE UNDER THE TEXAS ENGINEERING PRACTICE ACT.

FINAL RECORD  
DRAWING  
Date: 12/25/99



No.	REVISION	BY	DATE
NORTH TEXAS TOLLWAY AUTHORITY ADDISON AIRPORT TUNNEL			
QUANTITY/ITEM SUMMARIES			
MCE MATHEMATICAL CONSULTING ENGINEERS, INC. 5540 PETERSON LANE SUITE 225 DALLAS, TEXAS 75240 (972) 232-6700			SECTION XIII
DRAWN: SAA	DATE: 5/97	DESIGNED: DR	DATE: 5/97
CHECKED: RJM	DATE: 5/97	SCALE: NONE	
CONTRACT No. DNT-260 SHEET 4 OF 52			


## SUMMARY OF LARGE SIGNS

PLAN SHEET NO.	SIGN NO.	SIGN BACK-GROUND COLOR	SIGN MESSAGE	SIGN DIMENSIONS	ROUTE SHIELDS, EXIT ONLY PANELS, & OTHER ATTACHMENTS	BACKGROUND SUBSTRATE (SQ FT)				TYPE OF MOUNT	"X" DIMENSION			GALVANIZED STRUCTURAL STEEL				DRILLED SHAFT <sup>C</sup>								
						GROUND MOUNT		OVERHEAD			post ①	post ②	post ③	SIZE	LINEAR FEET			TOTAL WEIGHT LBS.	LINEAR FEET REINFORCED							
						PLYWOOD (TYPE A)	ALUMINUM (TYPE A)	ALUMINUM (TYPE A)	ALUMINUM (TYPE A)						post ①	post ②	post ③		NON-REINF 12"Ø	24"Ø	30"Ø	36"Ø				
8	5	GREEN	Stop Ahead Pay Toll	186X78					100.75	COSS <sup>A</sup>	FOR DETAILS SEE SHEET 13 FOR COSS NO. 1															
8	18	YELLOW	DO NOT ENTER TUNNEL WHEN LIGHTS ARE FLASHING	96X54					36.00	321	0.0	0.0		S4X7.7	12.0	12.0				255.2	10					
8	23	YELLOW	DO NOT ENTER TUNNEL WHEN LIGHTS ARE FLASHING	108X78					58.50	SM <sup>B</sup>																
9	29	YELLOW	DO NOT ENTER TUNNEL WHEN LIGHTS ARE FLASHING	108X78					58.50	SM <sup>B</sup>																
10	37	GREEN	Addison Toll Tunnel ↑ Doolittle Rd DO NOT ENTER TUNNEL WHEN LIGHTS ARE FLASHING	156X60					65.00	COSS <sup>A</sup>	FOR DETAILS SEE SHEET 14 FOR COSS NO. 2															
	38	YELLOW	DO NOT ENTER TUNNEL WHEN LIGHTS ARE FLASHING	108X78					58.50																	
PAGE TOTALS									36.00	341.25											255.2	10				
PROJECT TOTALS									36.00	341.25												255.2	10			

<sup>A</sup>CANTILEVER OVERHEAD SIGN SUPPORT

<sup>B</sup>STRUCTURE MOUNTED

<sup>C</sup>FOR CONTRACTOR'S INFORMATION ONLY

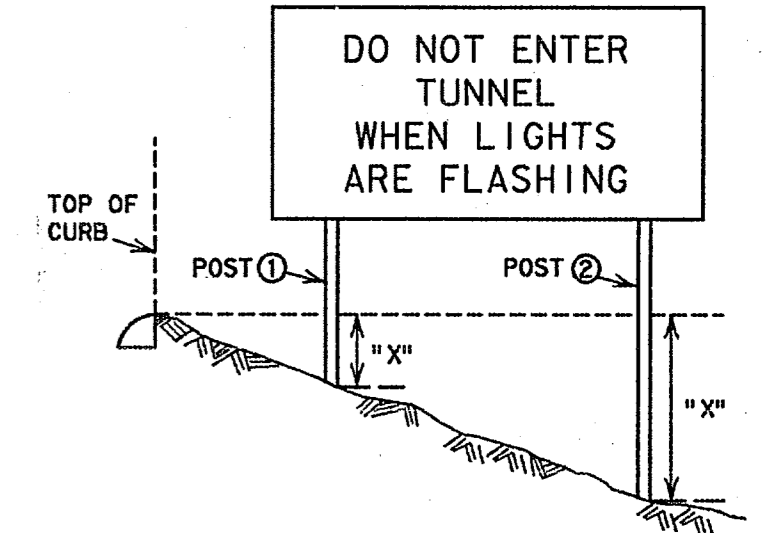


The "X" dimension is the elevation difference at the post between the ground and the edge of pavement or top of curb.

Sign supports shall be located as shown on the plans, except that the Engineer may shift the sign supports, within design guidelines, where necessary to secure a more desirable location or to avoid conflict with utilities. Unless otherwise shown on the plans, the Contractor shall stake and the Engineer will verify all sign support locations.

The post lengths listed here are approximations. The corrected post lengths will be furnished by the Engineer after the contractor has placed the stud posts.

Tower heights shall be verified with the Engineer before fabrication.

THE SEAL APPEARING ON THIS DOCUMENT WAS AUTHORIZED BY RICHARD K. LAIRD, P.E. NO. 59187 ON JANUARY 12, 1999. ALTERATION OF A SEALED DOCUMENT WITHOUT PRIOR NOTIFICATION TO THE RESPONSIBLE ENGINEER IS AN OFFENSE UNDER THE TEXAS ENGINEERING PRACTICE ACT.

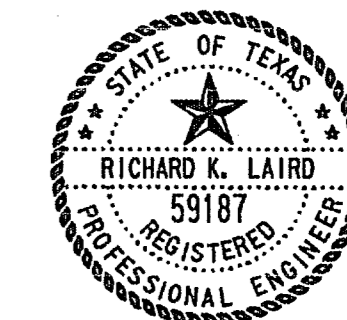

No.	REVISION	BY	DATE
-----	----------	----	------

NORTH TEXAS TOLLWAY AUTHORITY  
ADDISON AIRPORT TUNNEL

SUMMARY OF LARGE SIGNS

**MCE** MUTED CONSULTING ENGINEERS, INC.  
6500 PETERSON LANE SUITE 225  
DALLAS, TEXAS 75240 (972) 233-6100

SECTION XIII

DRAWN: TMF	DATE: 5/97	DESIGNED: RKL	DATE: 5/97
CHECKED: SCF	DATE: 5/97	SCALE: NONE	

**FINAL RECORD  
DRAWING**  
Date: 12/25/99

CONTRACT No. DNT-260 SHEET 5 OF 52



## SUMMARY OF SMALL SIGNS

PLAN SHEET NO.	SIGN NO.	SIGN TYPE	SIGN TEXT	SIGN DIMENSIONS	REFLECTIVE SHEETING	PLYWOOD TYPE A	ALUMINUM TYPE A	TYPE OF MOUNT															DRIVEABLE		MILEPOSTS										
								A	A (B-B)	A-1	B	C	D-1	D-2	SM*	D-4	D-5	D-6	F	G	TY I	TY II	MP	MW											
10	46	R5-1	DO NOT ENTER	30X30	C		1	1																											
	47	R1-2	YIELD	36X36X36	C		1	1																											
	48	R3-8(MOD)	LANE USE (SYMBOL)	48X30	C		1																												
	49	R3-8(MOD)	LANE USE (SYMBOL)	48X30	C		1																												
	50	DNT-1	DNT (SYMBOL)	24" DIA.	C		1	1																											
		M6-3G	↑	21X15	C		1																												
	50A	DNT-1	DNT (SYMBOL)	24" DIA.	C		1	1																											
		M6-3G	↑	21X15	C		1																												
	51	R14-3	HAZARD. CARGO PROHIB. (SYM.)	24X24	C		1																												
		ATT-1	Addison Toll Tunnel	24X24	C		1																												
		M6-1 L	←	21X15	C		1																												
		DNT-1	DNT (SYMBOL)	24" DIA.	C		1																												
		M6-1GR	→	21X15	C		1																												
	52	R14-3	HAZARD. CARGO PROHIB. (SYM.)	24X24	C		1																												
		ATT-1	Addison Toll Tunnel	24X24	C		1																												
		M6-8 L	LEFT LANE	24X18	C		1																												
		DNT-1	DNT (SYMBOL)	24" DIA.	C		1																												
10		M6-8GR	RIGHT LANE	24X18	C		1																												
8	53	SPECIAL	HANDICAPPED SPACE SIGN (SYM.)	12X16	C		1																												
		PLAQUE	VAN ACCESSIBLE	12X06	C		1	1																											
8	54	SPECIAL	50ø TOLL ALL VEHICLES	108X36	C		1																												
10	55	SPECIAL	50ø TOLL ALL VEHICLES	108X36	C		1																												
PAGE TOTALS								5			2				2						2														
PROJECT TOTALS								25	1	5	10				4	2							2												

Sign supports shall be located as shown on the plans, except that the Engineer may shift the sign supports, within design guidelines, where necessary to secure a more desirable location or to avoid conflict with utilities. Unless otherwise shown on the plans, the Contractor shall stake and the Engineer will verify all sign support locations.

Reflective sheeting will be designated as:

Type C - High Specific Intensity


\* FOR STRUCTURE MOUNTING DETAILS, SEE SHEETS 15 THRU 17.

Note:

- The DNT and the Addison Toll Tunnel Logo Sign Trailblazers will come from the NTTA for installation by the contractor.



THE SEAL APPEARING ON THIS DOCUMENT WAS AUTHORIZED BY RICHARD K. LAIRD, P.E. NO. 59187 ON JANUARY 12, 1999. ALTERATION OF A SEALED DOCUMENT WITHOUT PRIOR NOTIFICATION TO THE RESPONSIBLE ENGINEER IS AN OFFENSE UNDER THE TEXAS ENGINEERING PRACTICE ACT.

**FINAL RECORD DRAWING**  
Date: 12/25/99

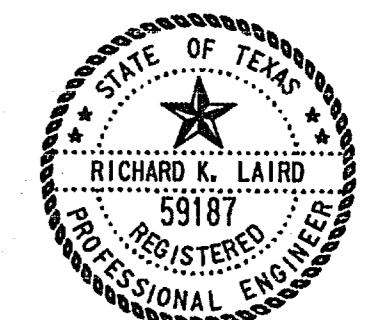

No.	REVISION	BY	DATE
NORTH TEXAS TOLLWAY AUTHORITY ADDISON AIRPORT TUNNEL			
SUMMARY OF SMALL SIGNS			
MATED CONSULTING ENGINEERS, INC. 5510 PETERSON LANE SUITE 325 DALLAS, TEXAS 75240 (972) 233-6700			SECTION XIII
DRAWN: TMF	DATE: 5/97	DESIGNED: RKL	DATE: 5/97
CHECKED: SCF	DATE: 5/97	SCALE: NONE	
CONTRACT No. DNT-260 SHEET 7 OF 52			



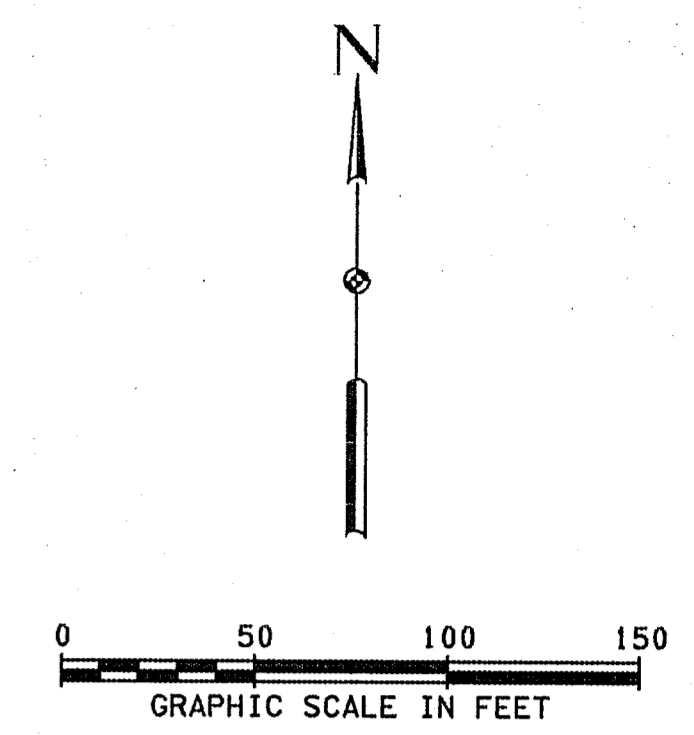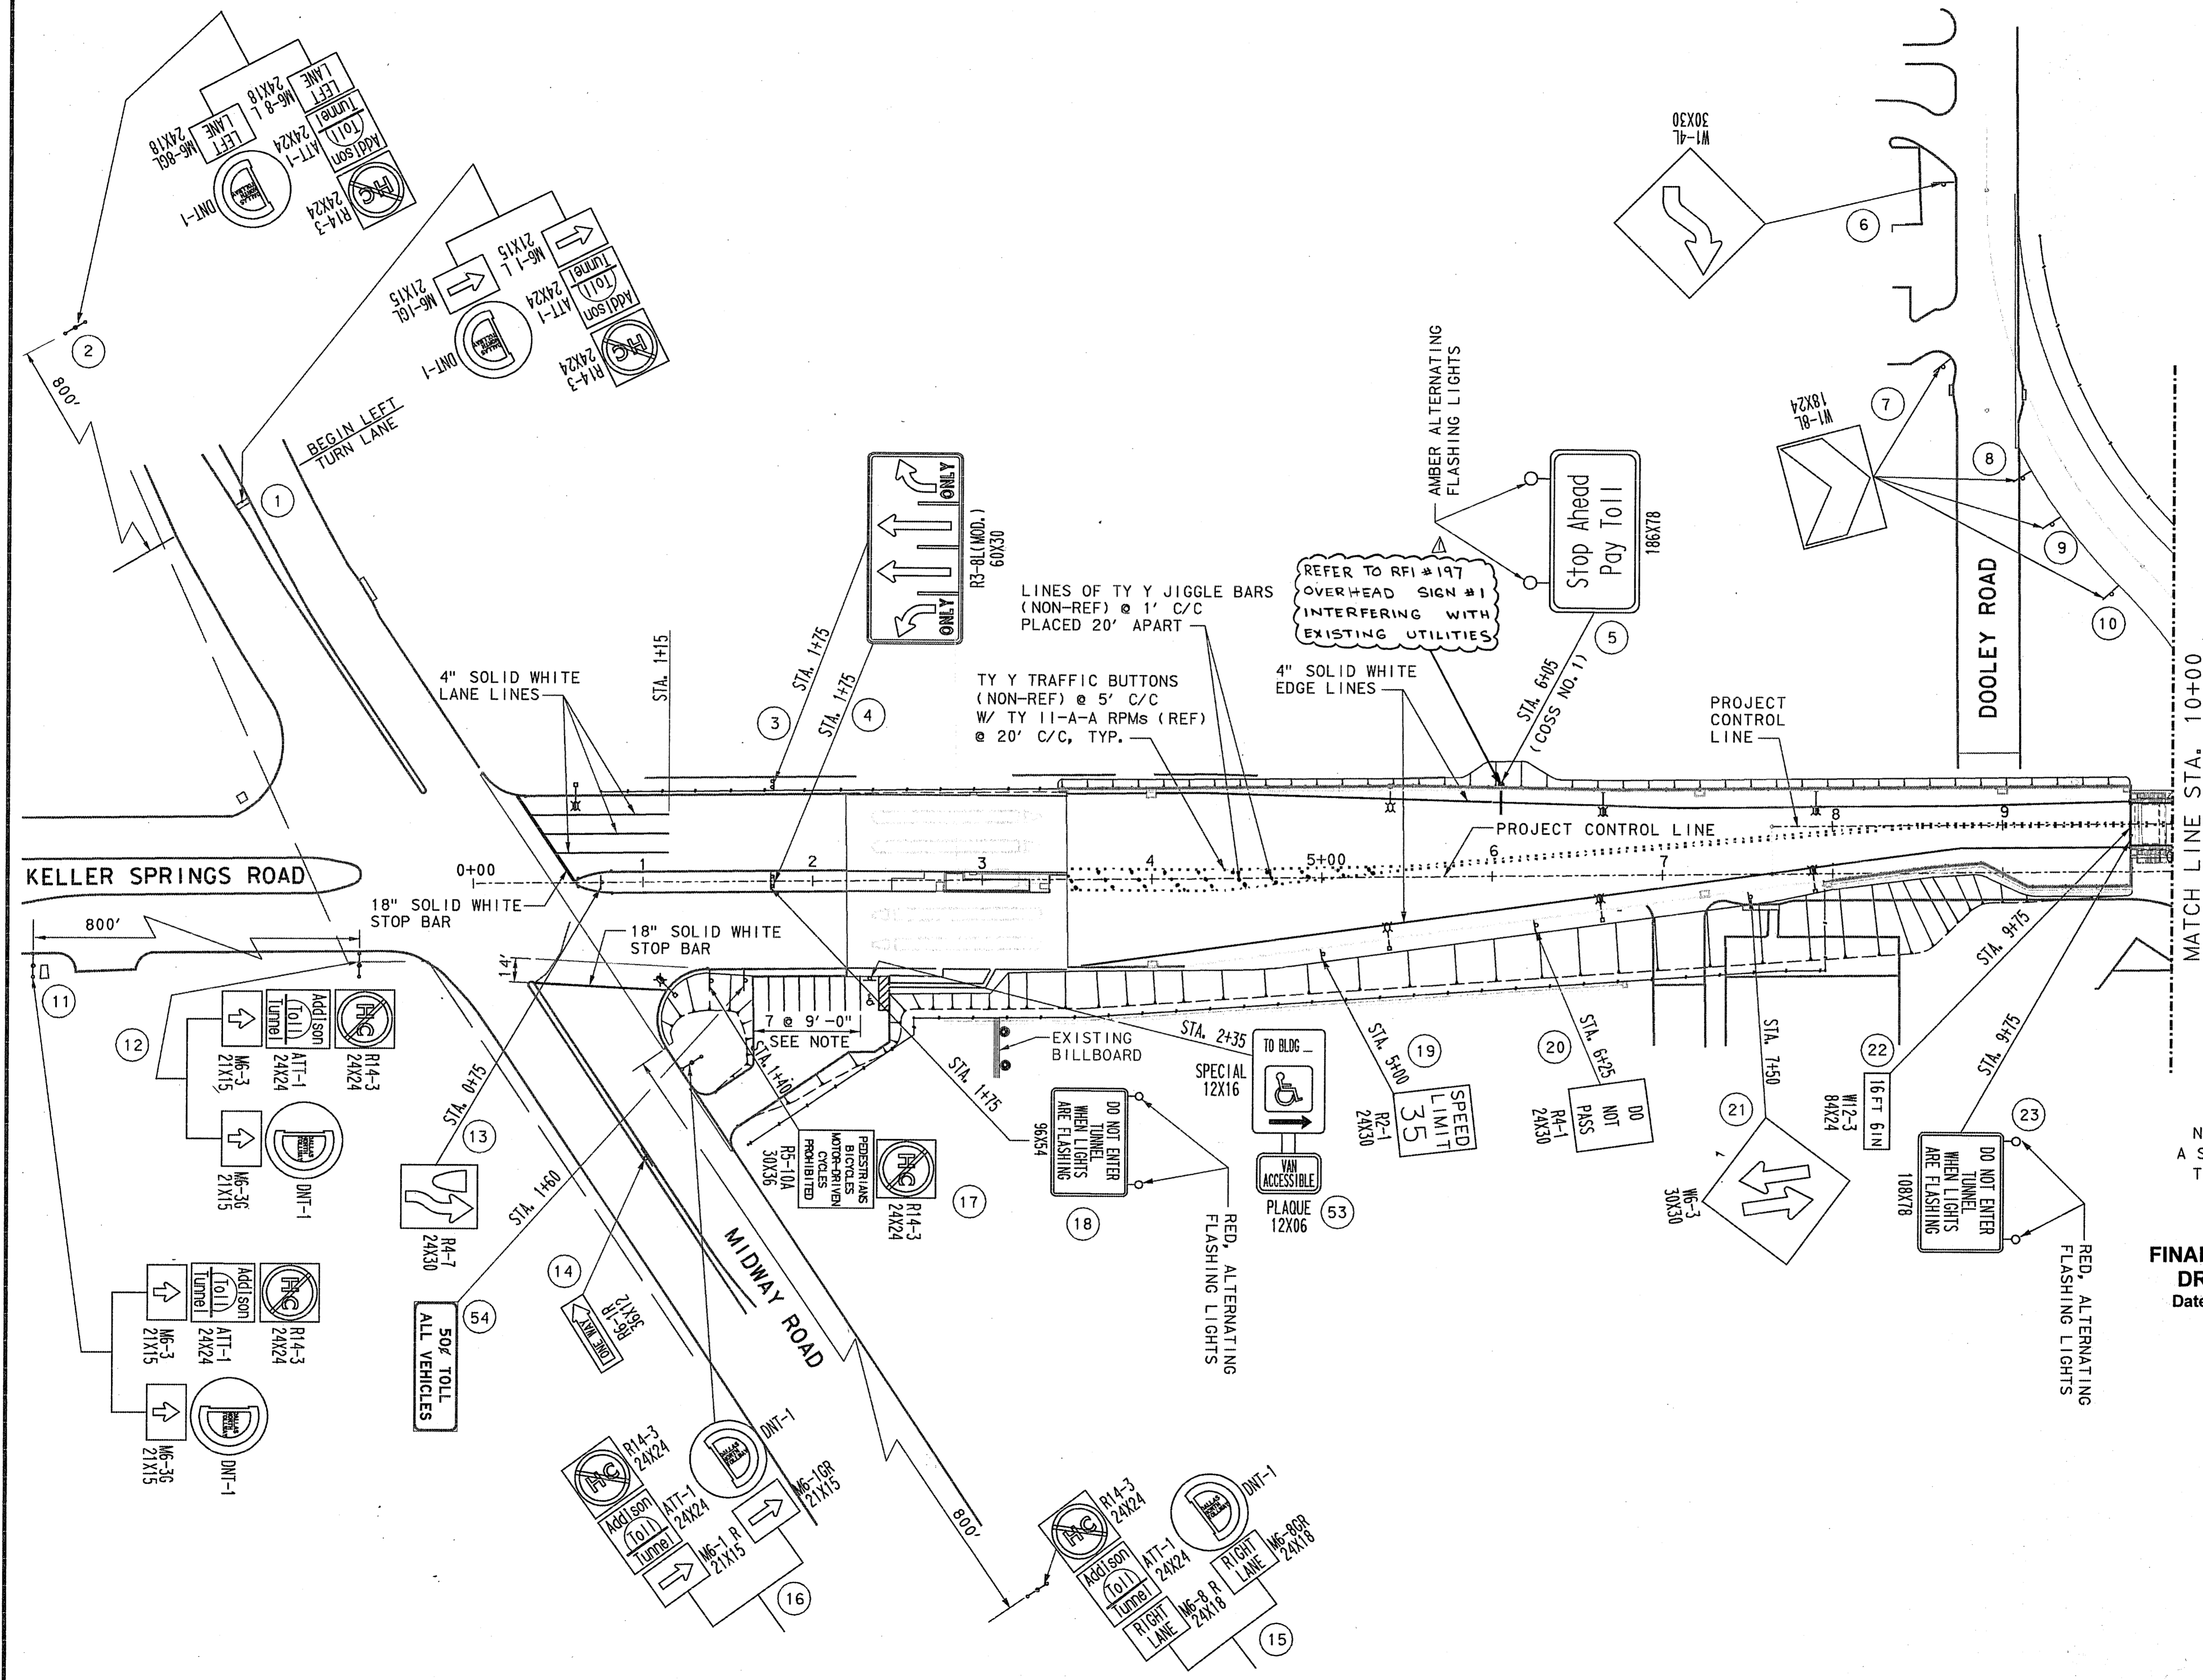

**LEGEND:**

(X) SIGN NUMBER

COSS - CANTILEVER OVERHEAD SIGN STRUCTURE

**NOTE:**

PARKING SPACES SHALL BE STRIPED IN THIS CONTRACT. NORMAL 9' SPACES SHALL BE STRIPED 4" WIDE BY 20'. 12' HANDICAPPED SPACE SHALL BE 4" BY 20' WITH A 5' WIDE LOADING ZONE WITH 4" SOLID WHITE DIAGONALS AT 3' SPACING.



THE SEAL APPEARING ON THIS DOCUMENT WAS AUTHORIZED BY RICHARD K. LAIRD, P.E. NO. 59187 ON JANUARY 12, 1999. ALTERATION OF A SEALED DOCUMENT WITHOUT PRIOR NOTIFICATION TO THE RESPONSIBLE ENGINEER IS AN OFFENSE UNDER THE TEXAS ENGINEERING PRACTICE ACT.

**FINAL RECORD DRAWING**  
Date: 12/25/99



REVISED PER RFI # 97

No.	REVISION	BY	DATE
NORTH TEXAS TOLLWAY AUTHORITY ADDISON AIRPORT TUNNEL			
SIGNING AND PAVEMENT MARKING LAYOUT MIDWAY ROAD TO STA. 10+00			
MCE MATED CONSULTING ENGINEERS, INC. 5500 PETERSON LANE SUITE 225 DALLAS, TEXAS 75240 (972) 233-6700			SECTION XIII
DRAWN: TMF	DATE: 5/97	DESIGNED: SA	DATE: 5/97
CHECKED: SCF	DATE: 5/97	SCALE: 1" = 50'	
CONTRACT No. DNT-260 SHEET 8 OF 52			

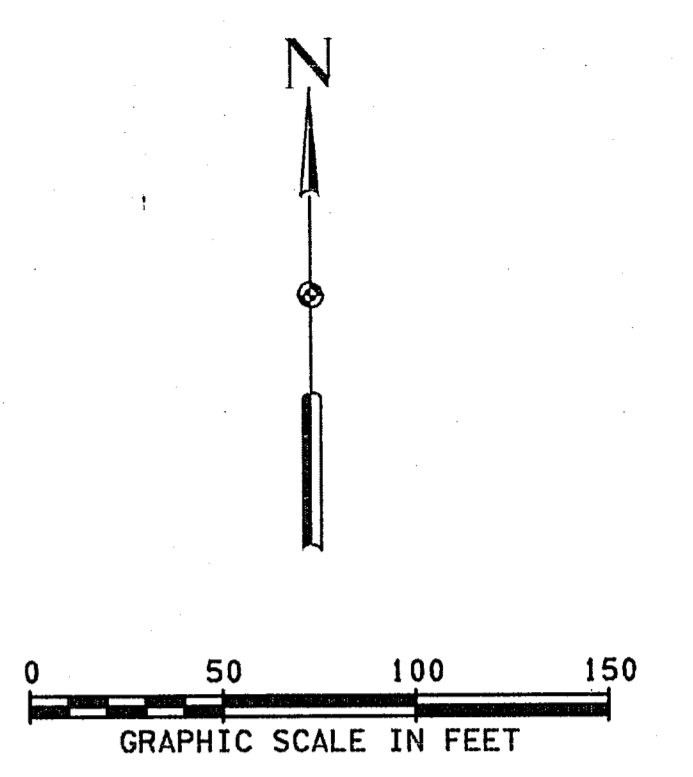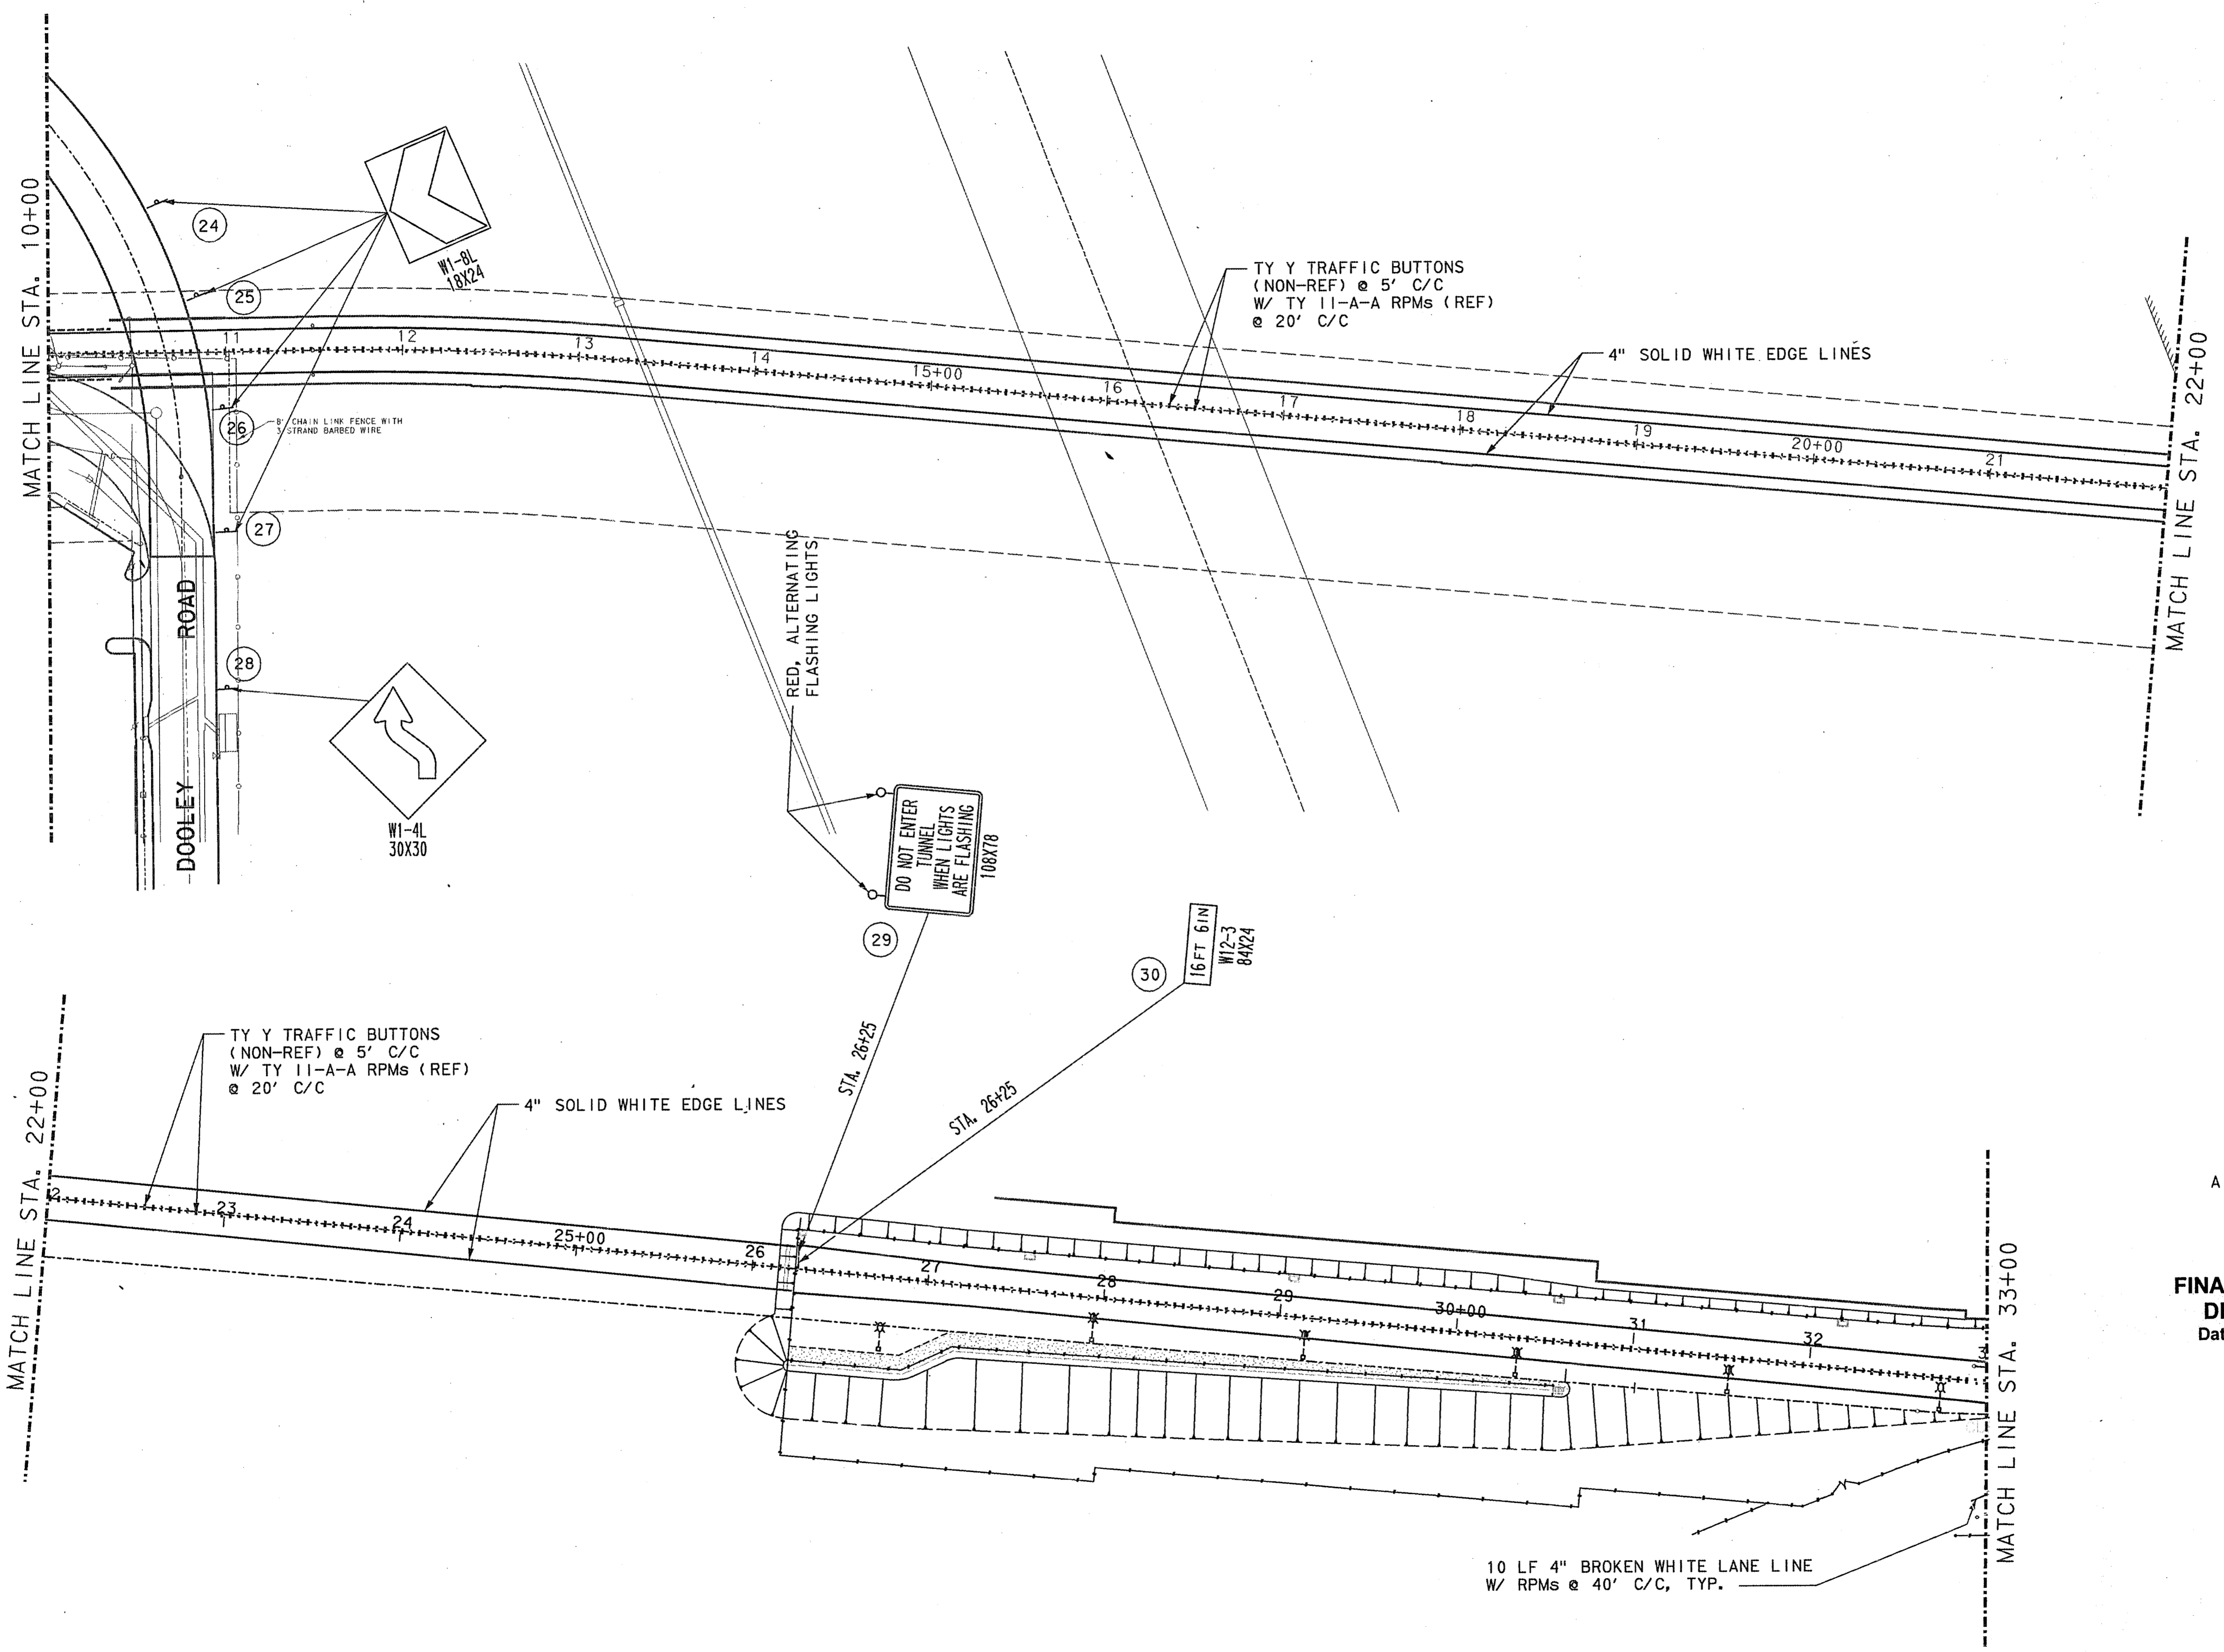



LEGEND:  
 (X) SIGN NUMBER  
 COSS - CANTILEVER OVERHEAD SIGN STRUCTURE

THE SEAL APPEARING ON THIS DOCUMENT WAS AUTHORIZED BY RICHARD K. LAIRD, P.E. NO. 59187 ON JANUARY 12, 1999. ALTERATION OF A SEALED DOCUMENT WITHOUT PRIOR NOTIFICATION TO THE RESPONSIBLE ENGINEER IS AN OFFENSE UNDER THE TEXAS ENGINEERING PRACTICE ACT.

**FINAL RECORD DRAWING**  
 Date: 12/25/99



No.	REVISION	BY	DATE
NORTH TEXAS TOLLWAY AUTHORITY ADDISON AIRPORT TUNNEL			
SIGNING AND PAVEMENT MARKING LAYOUT STA. 10+00 TO STA. 33+00			
MATED CONSULTING ENGINEERS, INC. <small>5540 PETERSON LANE SUITE 223 DALLAS, TEXAS 75240 (972) 235-6100</small>			SECTION XIII
DRAWN: TMF	DATE: 5/97	DESIGNED: SA	DATE: 5/97
CHECKED: RKL	DATE: 5/97	SCALE: 1" = 50'	
CONTRACT No. DNT-260 SHEET 9 OF 52			

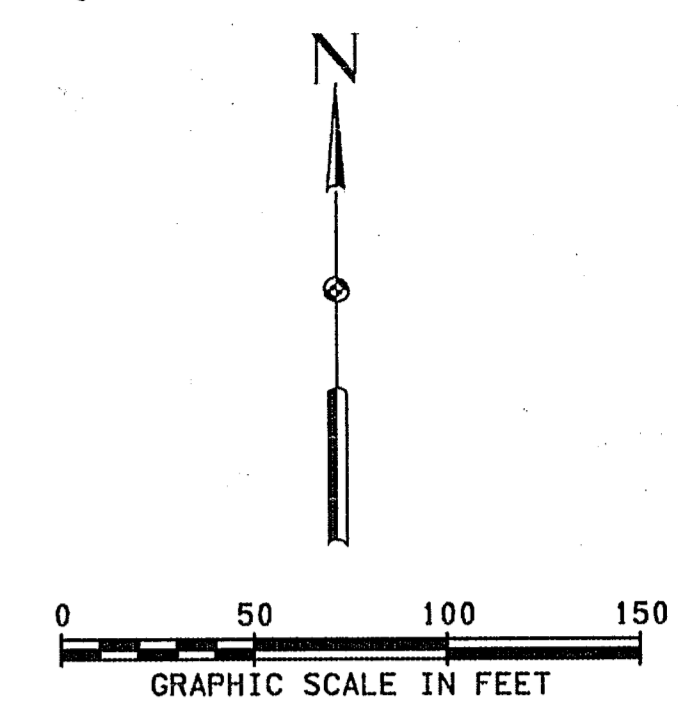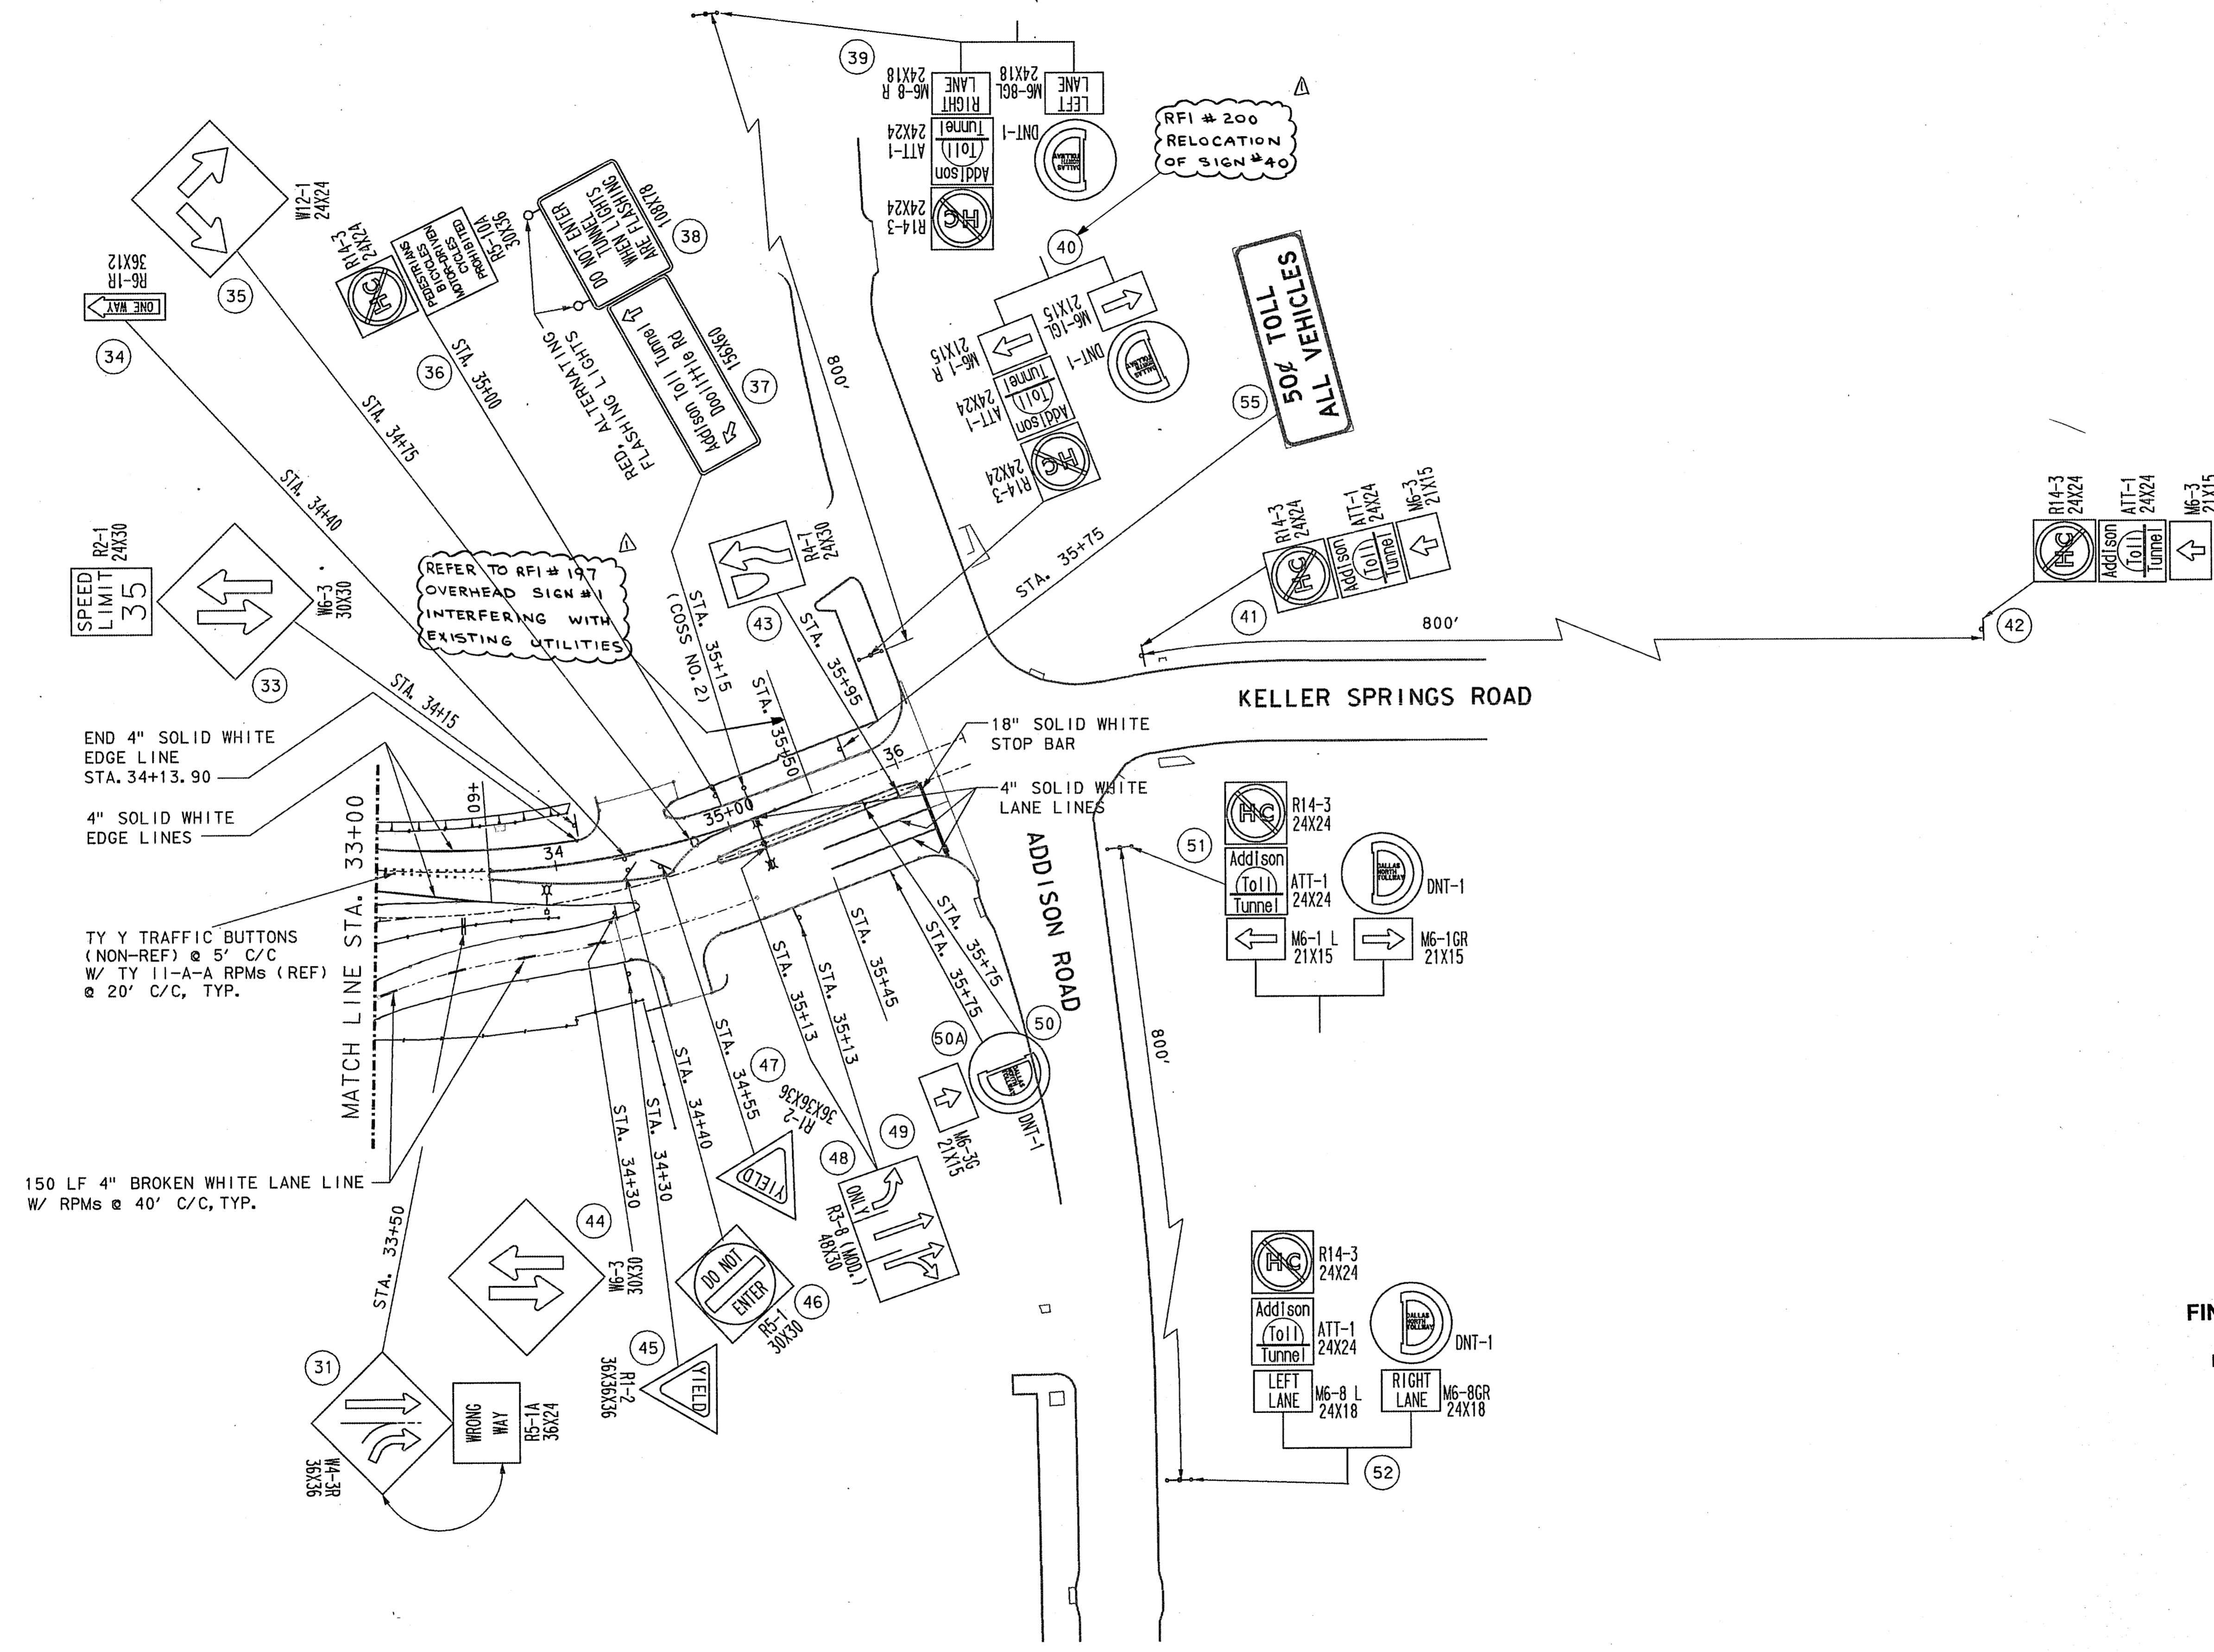

LEGEND:  
 (X) SIGN NUMBER  
 COSS - CANTILEVER OVERHEAD SIGN STRUCTURE

END 4" SOLID WHITE EDGE LINE STA. 34+13.90  
 4" SOLID WHITE EDGE LINES  
 TYPED TRAFFIC BUTTONS (NON-REF) @ 5' C/C W/ TY 11-A-A RPMs (REF) @ 20' C/C, TYP.  
 150 LF 4" BROKEN WHITE LANE LINE W/ RPMs @ 40' C/C, TYP.

REFER TO RFI # 197 OVERHEAD SIGN #1 INTERFERING WITH EXISTING UTILITIES

RFI # 200 RELOCATION OF SIGN # 40


THE SEAL APPEARING ON THIS DOCUMENT WAS AUTHORIZED BY RICHARD K. LAIRD, P.E. NO. 59187 ON JANUARY 12, 1999. ALTERATION OF A SEALED DOCUMENT WITHOUT PRIOR NOTIFICATION TO THE RESPONSIBLE ENGINEER IS AN OFFENSE UNDER THE TEXAS ENGINEERING PRACTICE ACT.

FINAL RECORD DRAWING  
 Date: 12/25/99




REVISOR PER RFI # 197, RFI # 200

No.	REVISION	BY	DATE
NORTH TEXAS TOLLWAY AUTHORITY ADDISON AIRPORT TUNNEL			
SIGNING AND PAVEMENT MARKING LAYOUT STA. 33+00 TO ADDISON ROAD			
MATED CONSULTING ENGINEERS, INC. 6540 PETERSON LANE SUITE 225 DALLAS, TEXAS 75240 (972) 233-6700			SECTION XIII
DRAWN SA	DATE 5/97	DESIGNED RKL	DATE 5/97
CHECKED SCF	DATE 5/97	SCALE 1" = 50'	
CONTRACT No. DNT-260 SHEET 10 OF 52			

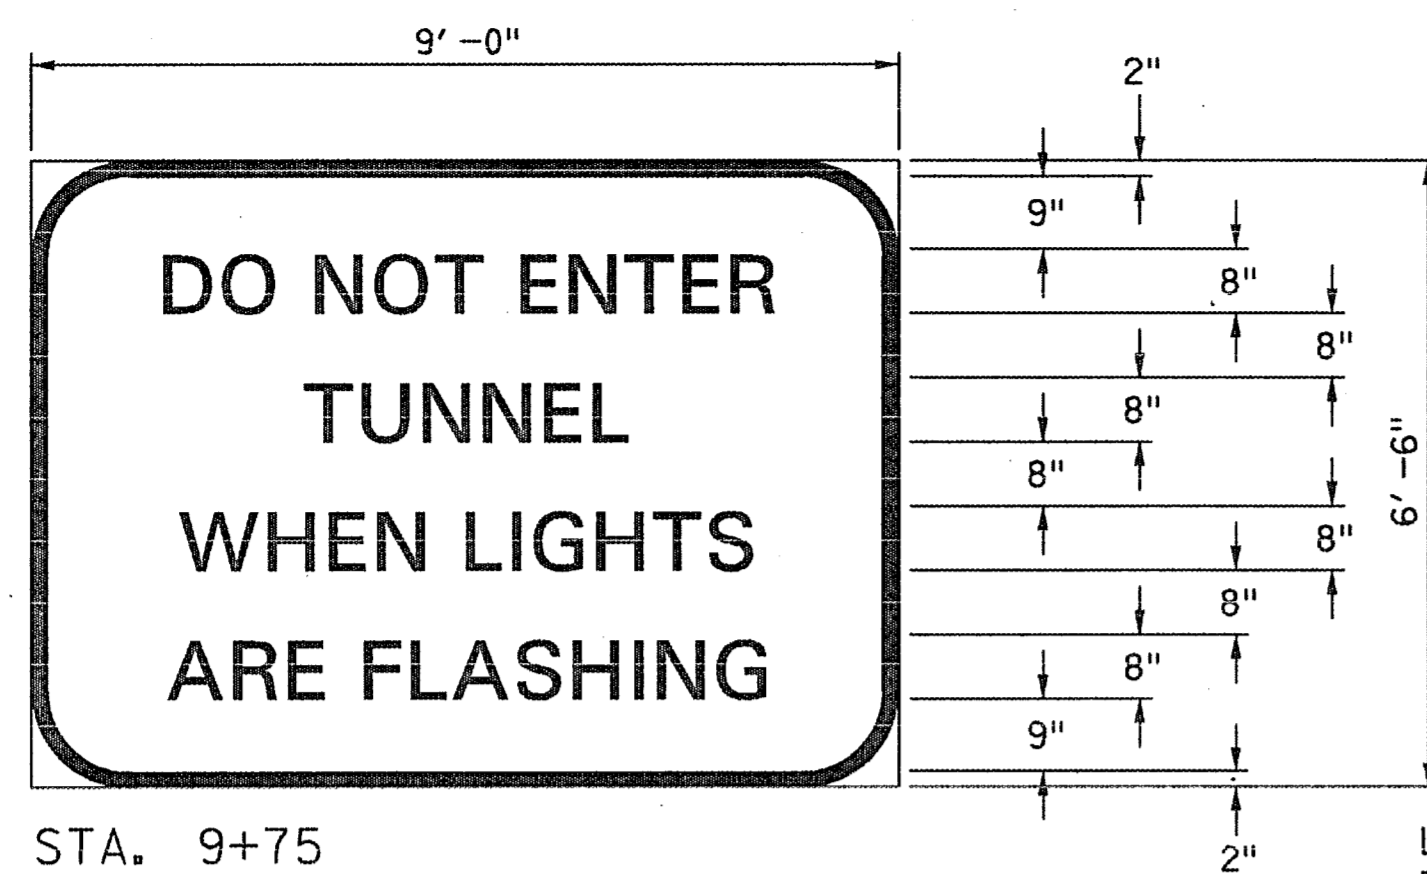


STA. 9+75  
 STA. 26+25  
 STA. 35+15 (TY A - ENGINEER GRADE)

LEGEND : BLACK  
 BORDER : BLACK  
 BACKGROUND : YELLOW  
 SHEETING : HIGH SPECIFIC INTENSITY (TY C)  
 BORDER RADIUS : 1'-0"  
 SCALE : 1/2" = 1'-0"

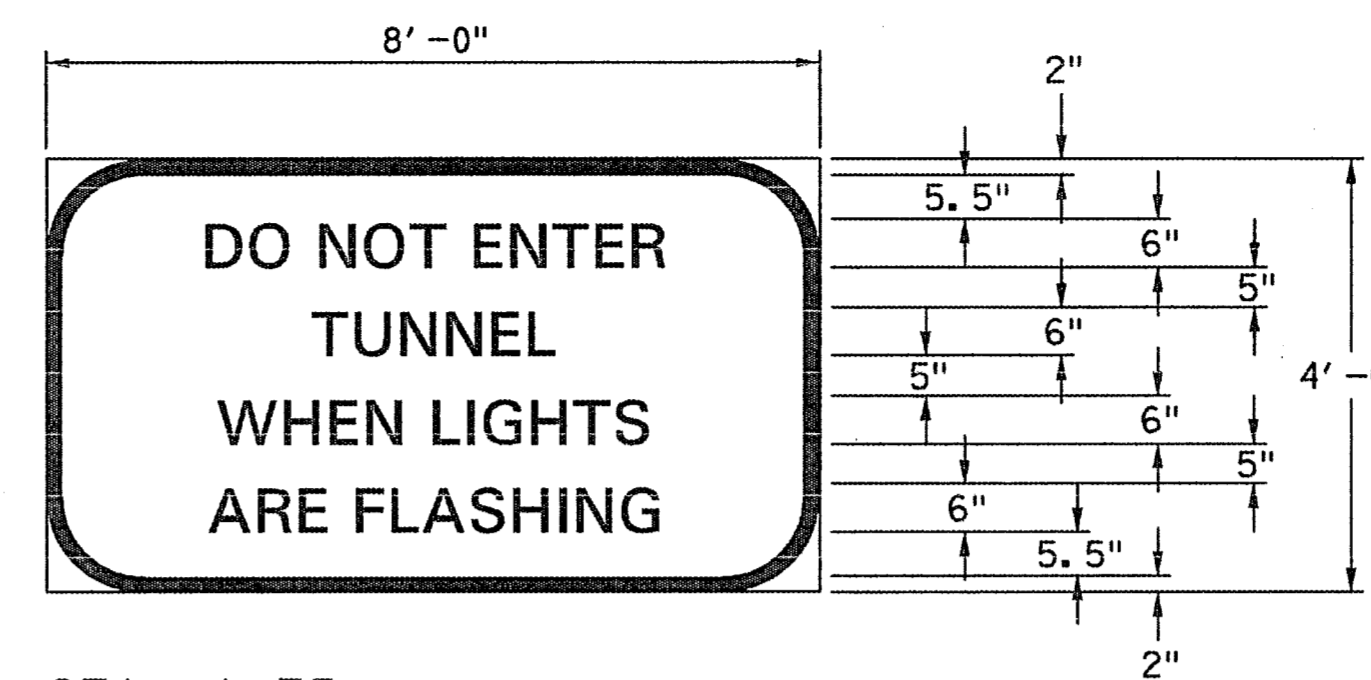


STA. 1+75

LEGEND : BLACK  
 BORDER : BLACK  
 BACKGROUND : YELLOW  
 SHEETING : HIGH SPECIFIC INTENSITY (TY C)  
 BORDER RADIUS : 9"  
 SCALE : 1/2" = 1'-0"

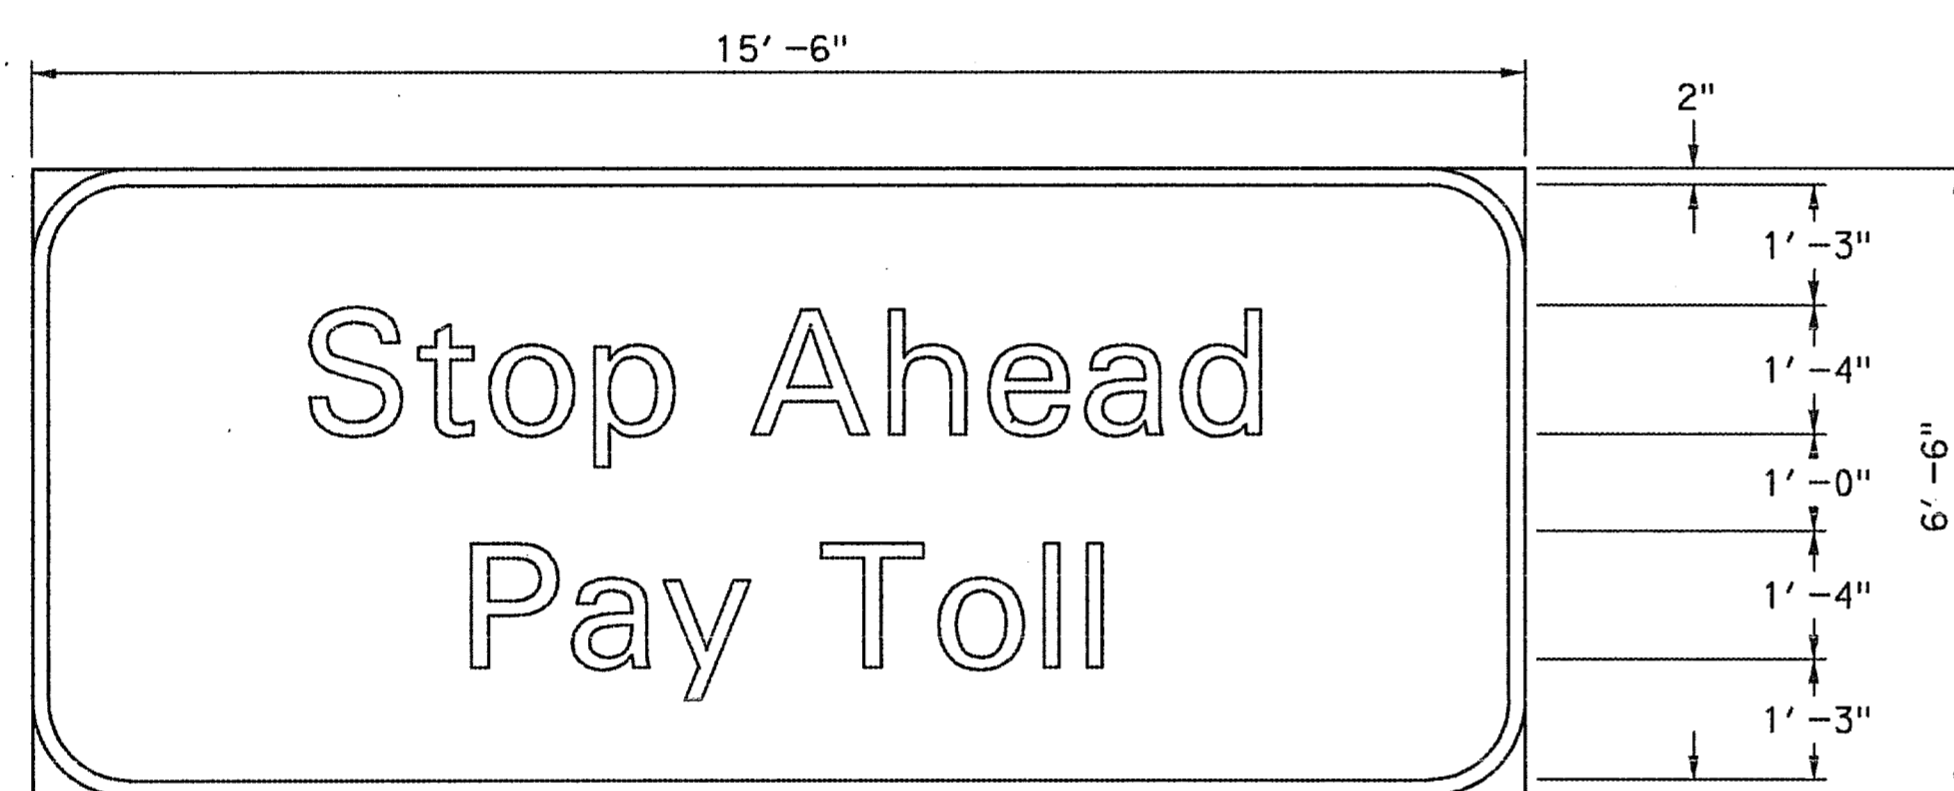

STA. 6+05

LEGEND : WHITE  
 BORDER : WHITE  
 BACKGROUND : GREEN  
 SHEETING : TY A - ENGINEER GRADE  
 BORDER RADIUS : 1'-0"  
 SCALE : 1/2" = 1'-0"

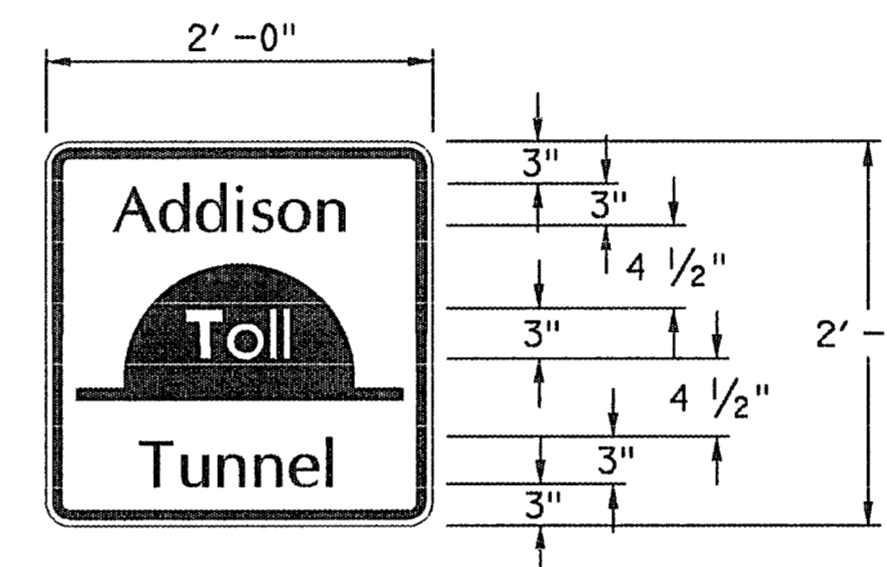


2 ON W. KELLER SPRINGS RD  
 2 ON E. KELLER SPRINGS RD  
 2 ON N. MIDWAY RD  
 2 ON S. MIDWAY RD  
 2 ON N. ADDISON RD  
 2 ON S. ADDISON RD

LEGEND : TEXT, WHITE, AND TUNNEL, BLACK  
 BORDER : WHITE  
 BACKGROUND : CORAL  
 SHEETING : HIGH SPECIFIC INTENSITY (TY C)  
 BORDER RADIUS : 3"  
 SCALE : 1" = 1'-0"

### LETTER SIZES AND TYPES

UPPER CASE	LOWER CASE LOOP HEIGHT	SERIES
16"	12"	E(M)
8"	6"	E(M)
6"	—	E
3"	2 1/4"	E

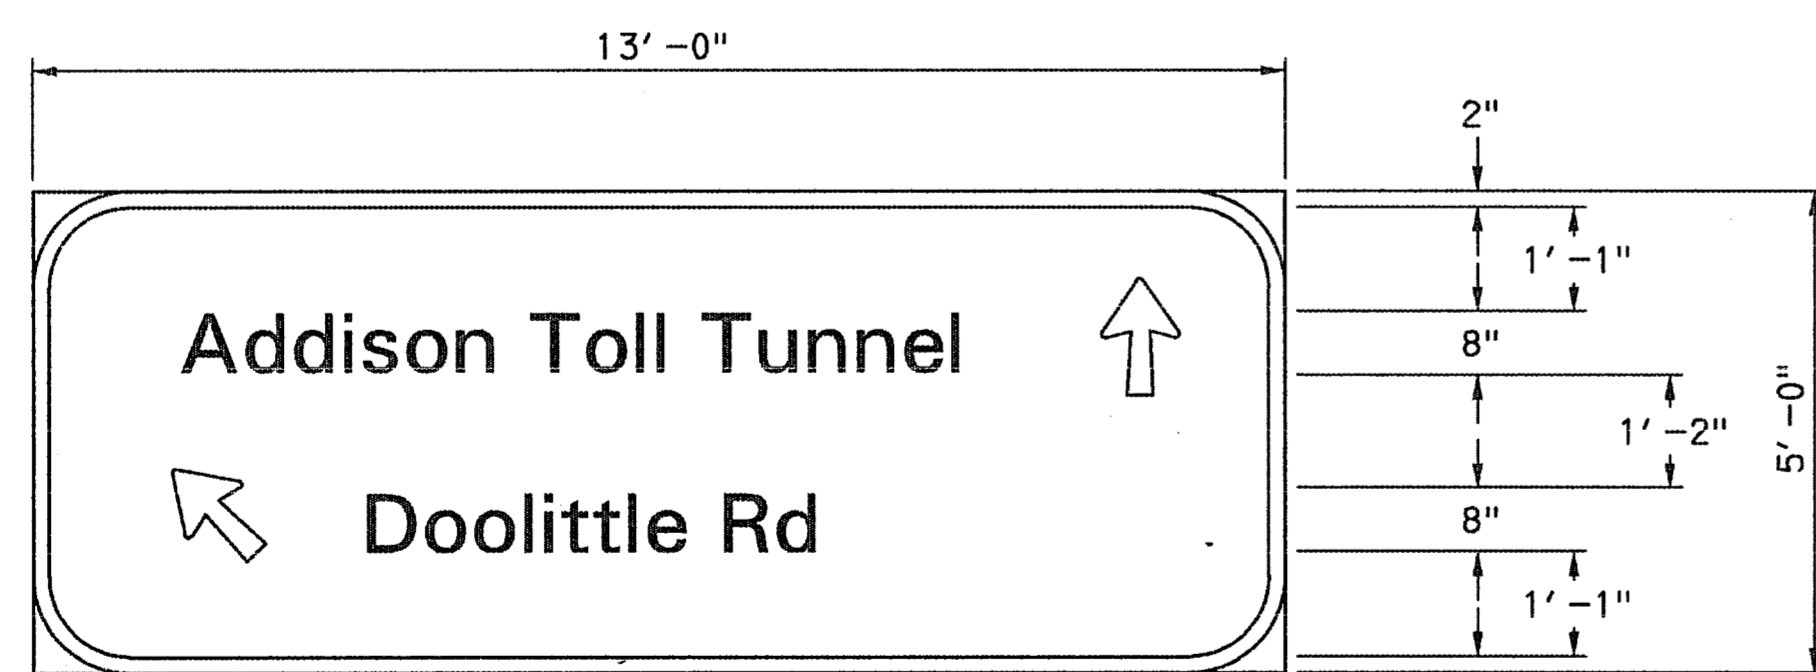

STA. 35+15


LEGEND : WHITE  
 BORDER : WHITE  
 BACKGROUND : GREEN  
 SHEETING : TY A - ENGINEER GRADE  
 BORDER RADIUS : 9"  
 SCALE : 1/2" = 1'-0"

THE SEAL APPEARING ON THIS DOCUMENT WAS AUTHORIZED BY RICHARD K. LAIRD, P.E. NO. 59187 ON JANUARY 12, 1999. ALTERATION OF A SEALED DOCUMENT WITHOUT PRIOR NOTIFICATION TO THE RESPONSIBLE ENGINEER IS AN OFFENSE UNDER THE TEXAS ENGINEERING PRACTICE ACT.

FINAL RECORD DRAWING  
 Date: 12/25/99




No.	REVISION	BY	DATE
NORTH TEXAS TOLLWAY AUTHORITY ADDISON AIRPORT TUNNEL			
SIGN DETAILS			
MATED CONSULTING ENGINEERS, INC. <small>2540 PETERSON LANE SUITE 224 DALLAS, TEXAS 75240 (972) 233-6100</small>			SECTION XIII
DRAWN: SA	DATE: 5/97	DESIGNED: RKL	DATE: 5/97
CHECKED: SCF	DATE: 5/97	SCALE: AS NOTED	
CONTRACT No. DNT-260 SHEET 11 OF 52			

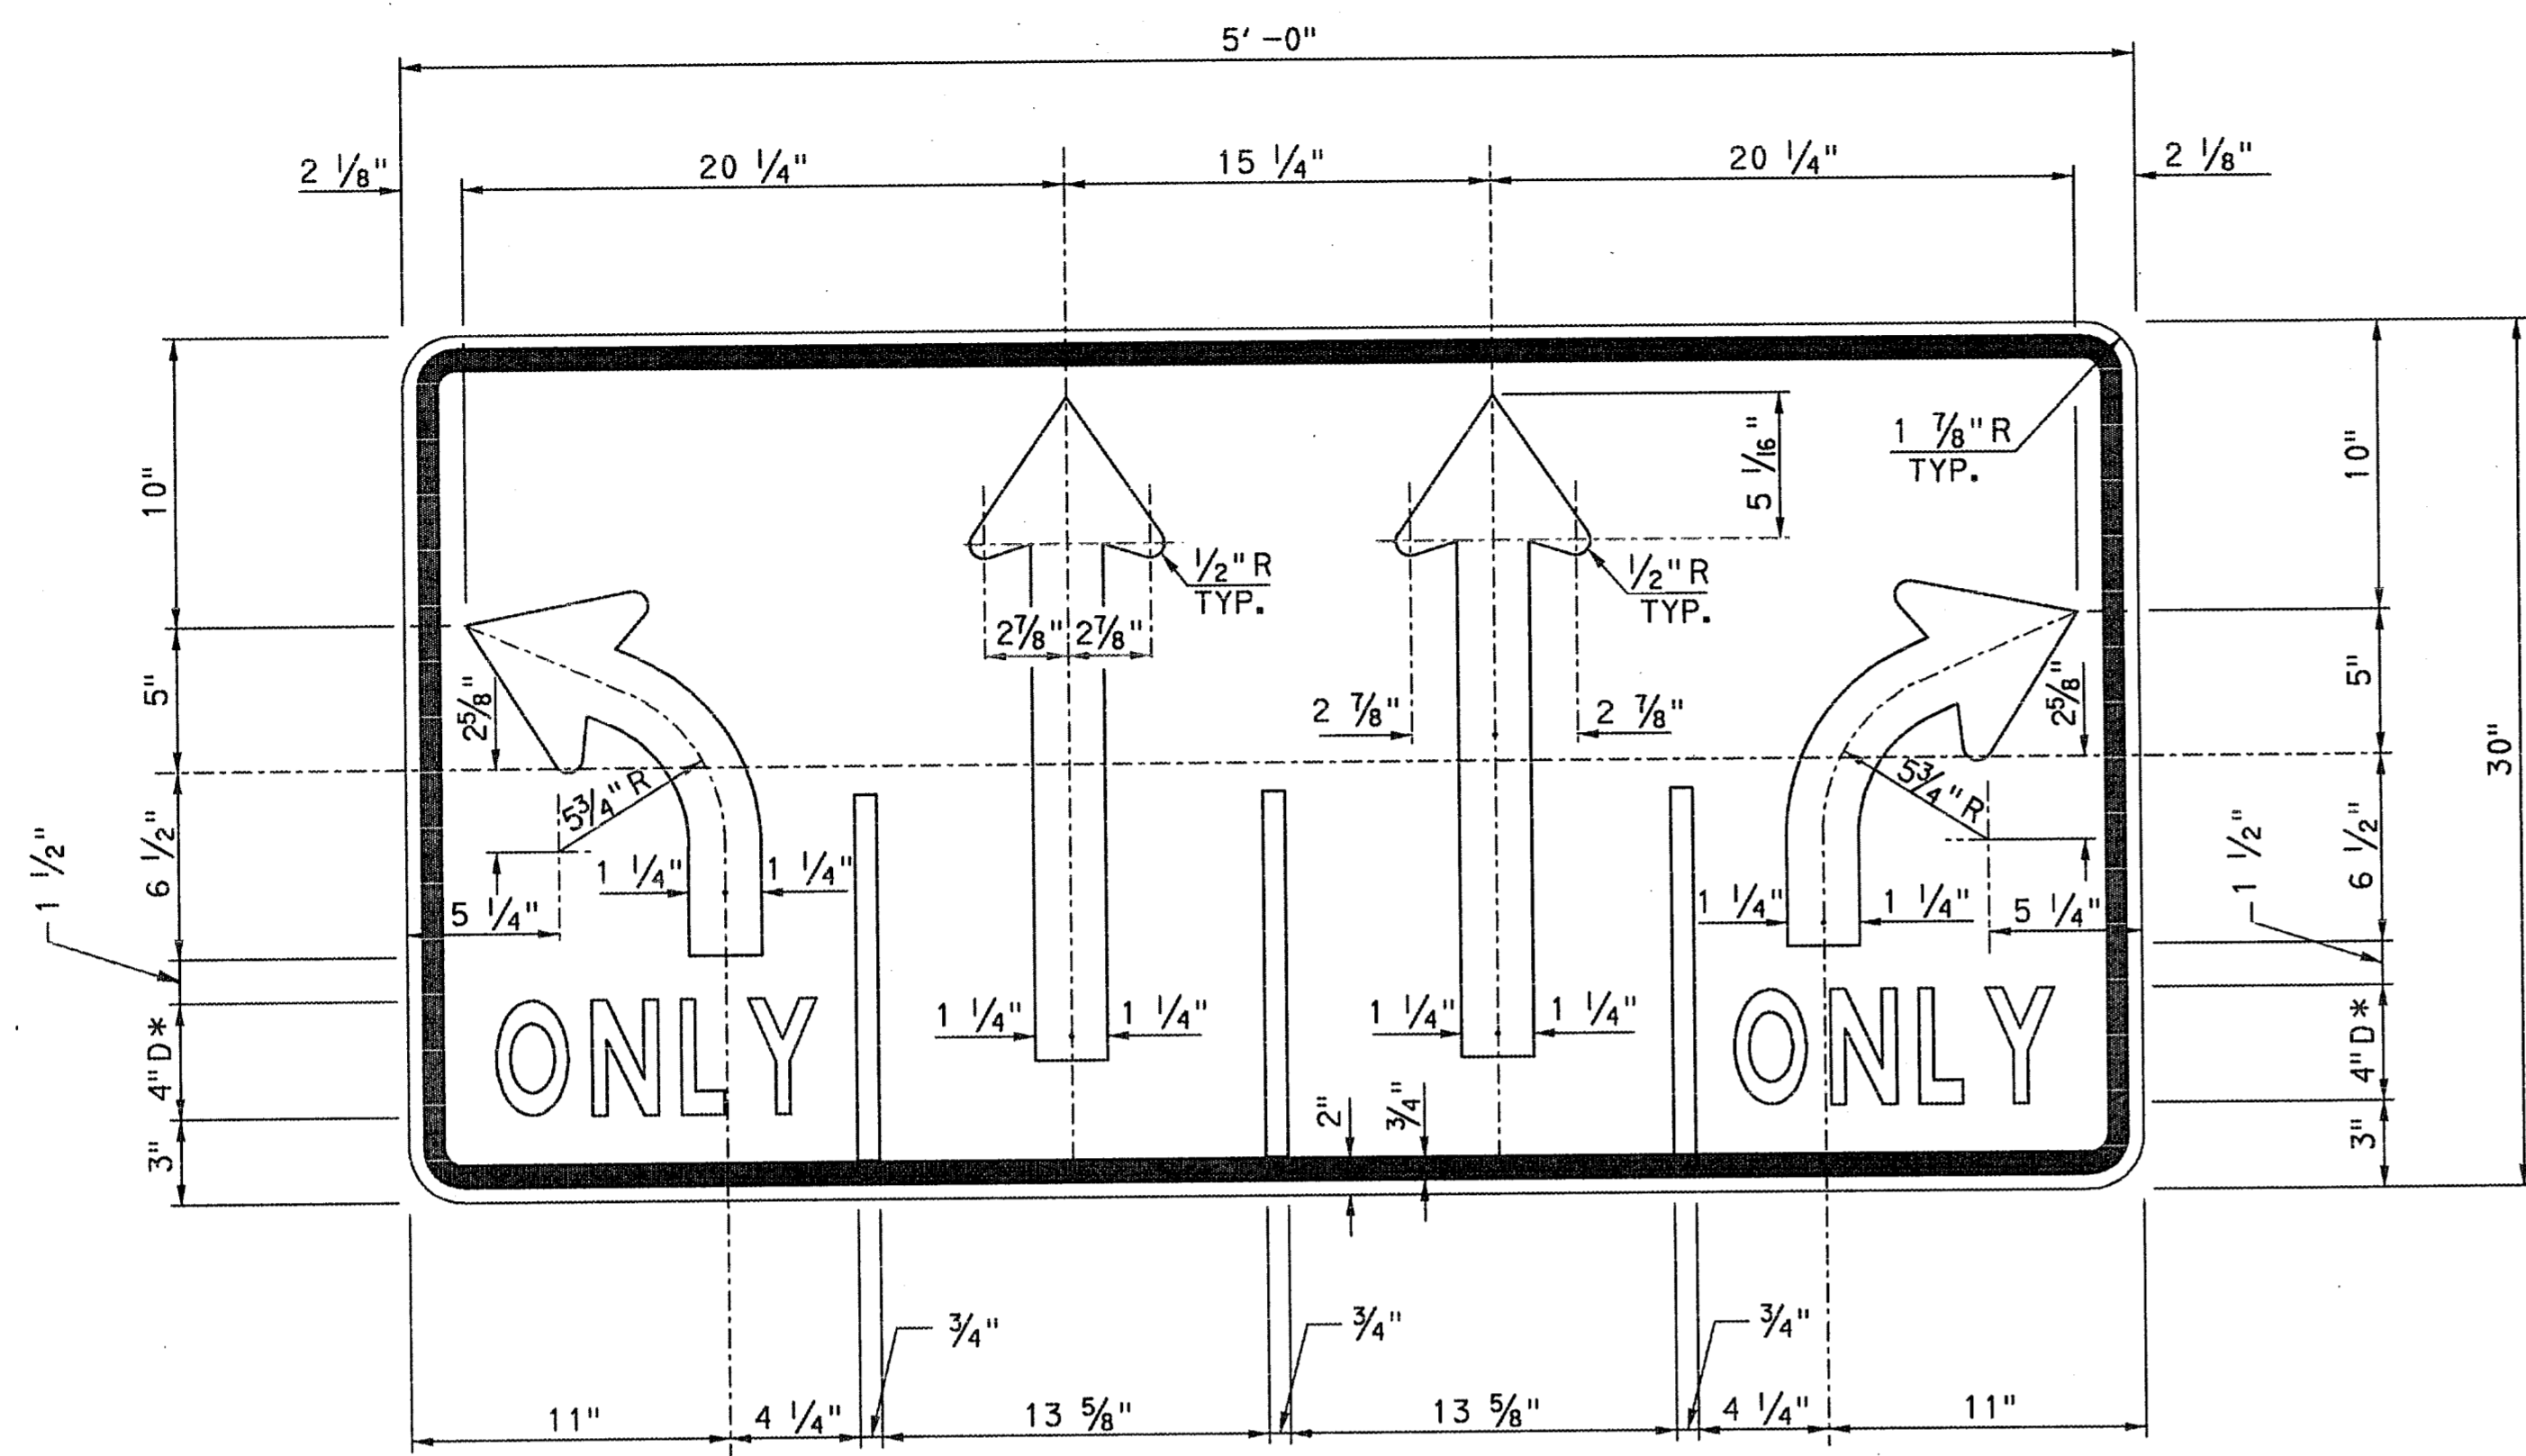


2 AT STA. 1+75

- LEGEND
- BLACK
  - BLACK
  - BLACK
  - WHITE
  - HIGH SPECIFIC INTENSITY (TY C)
  - \* ■ SPACING REDUCED 50%

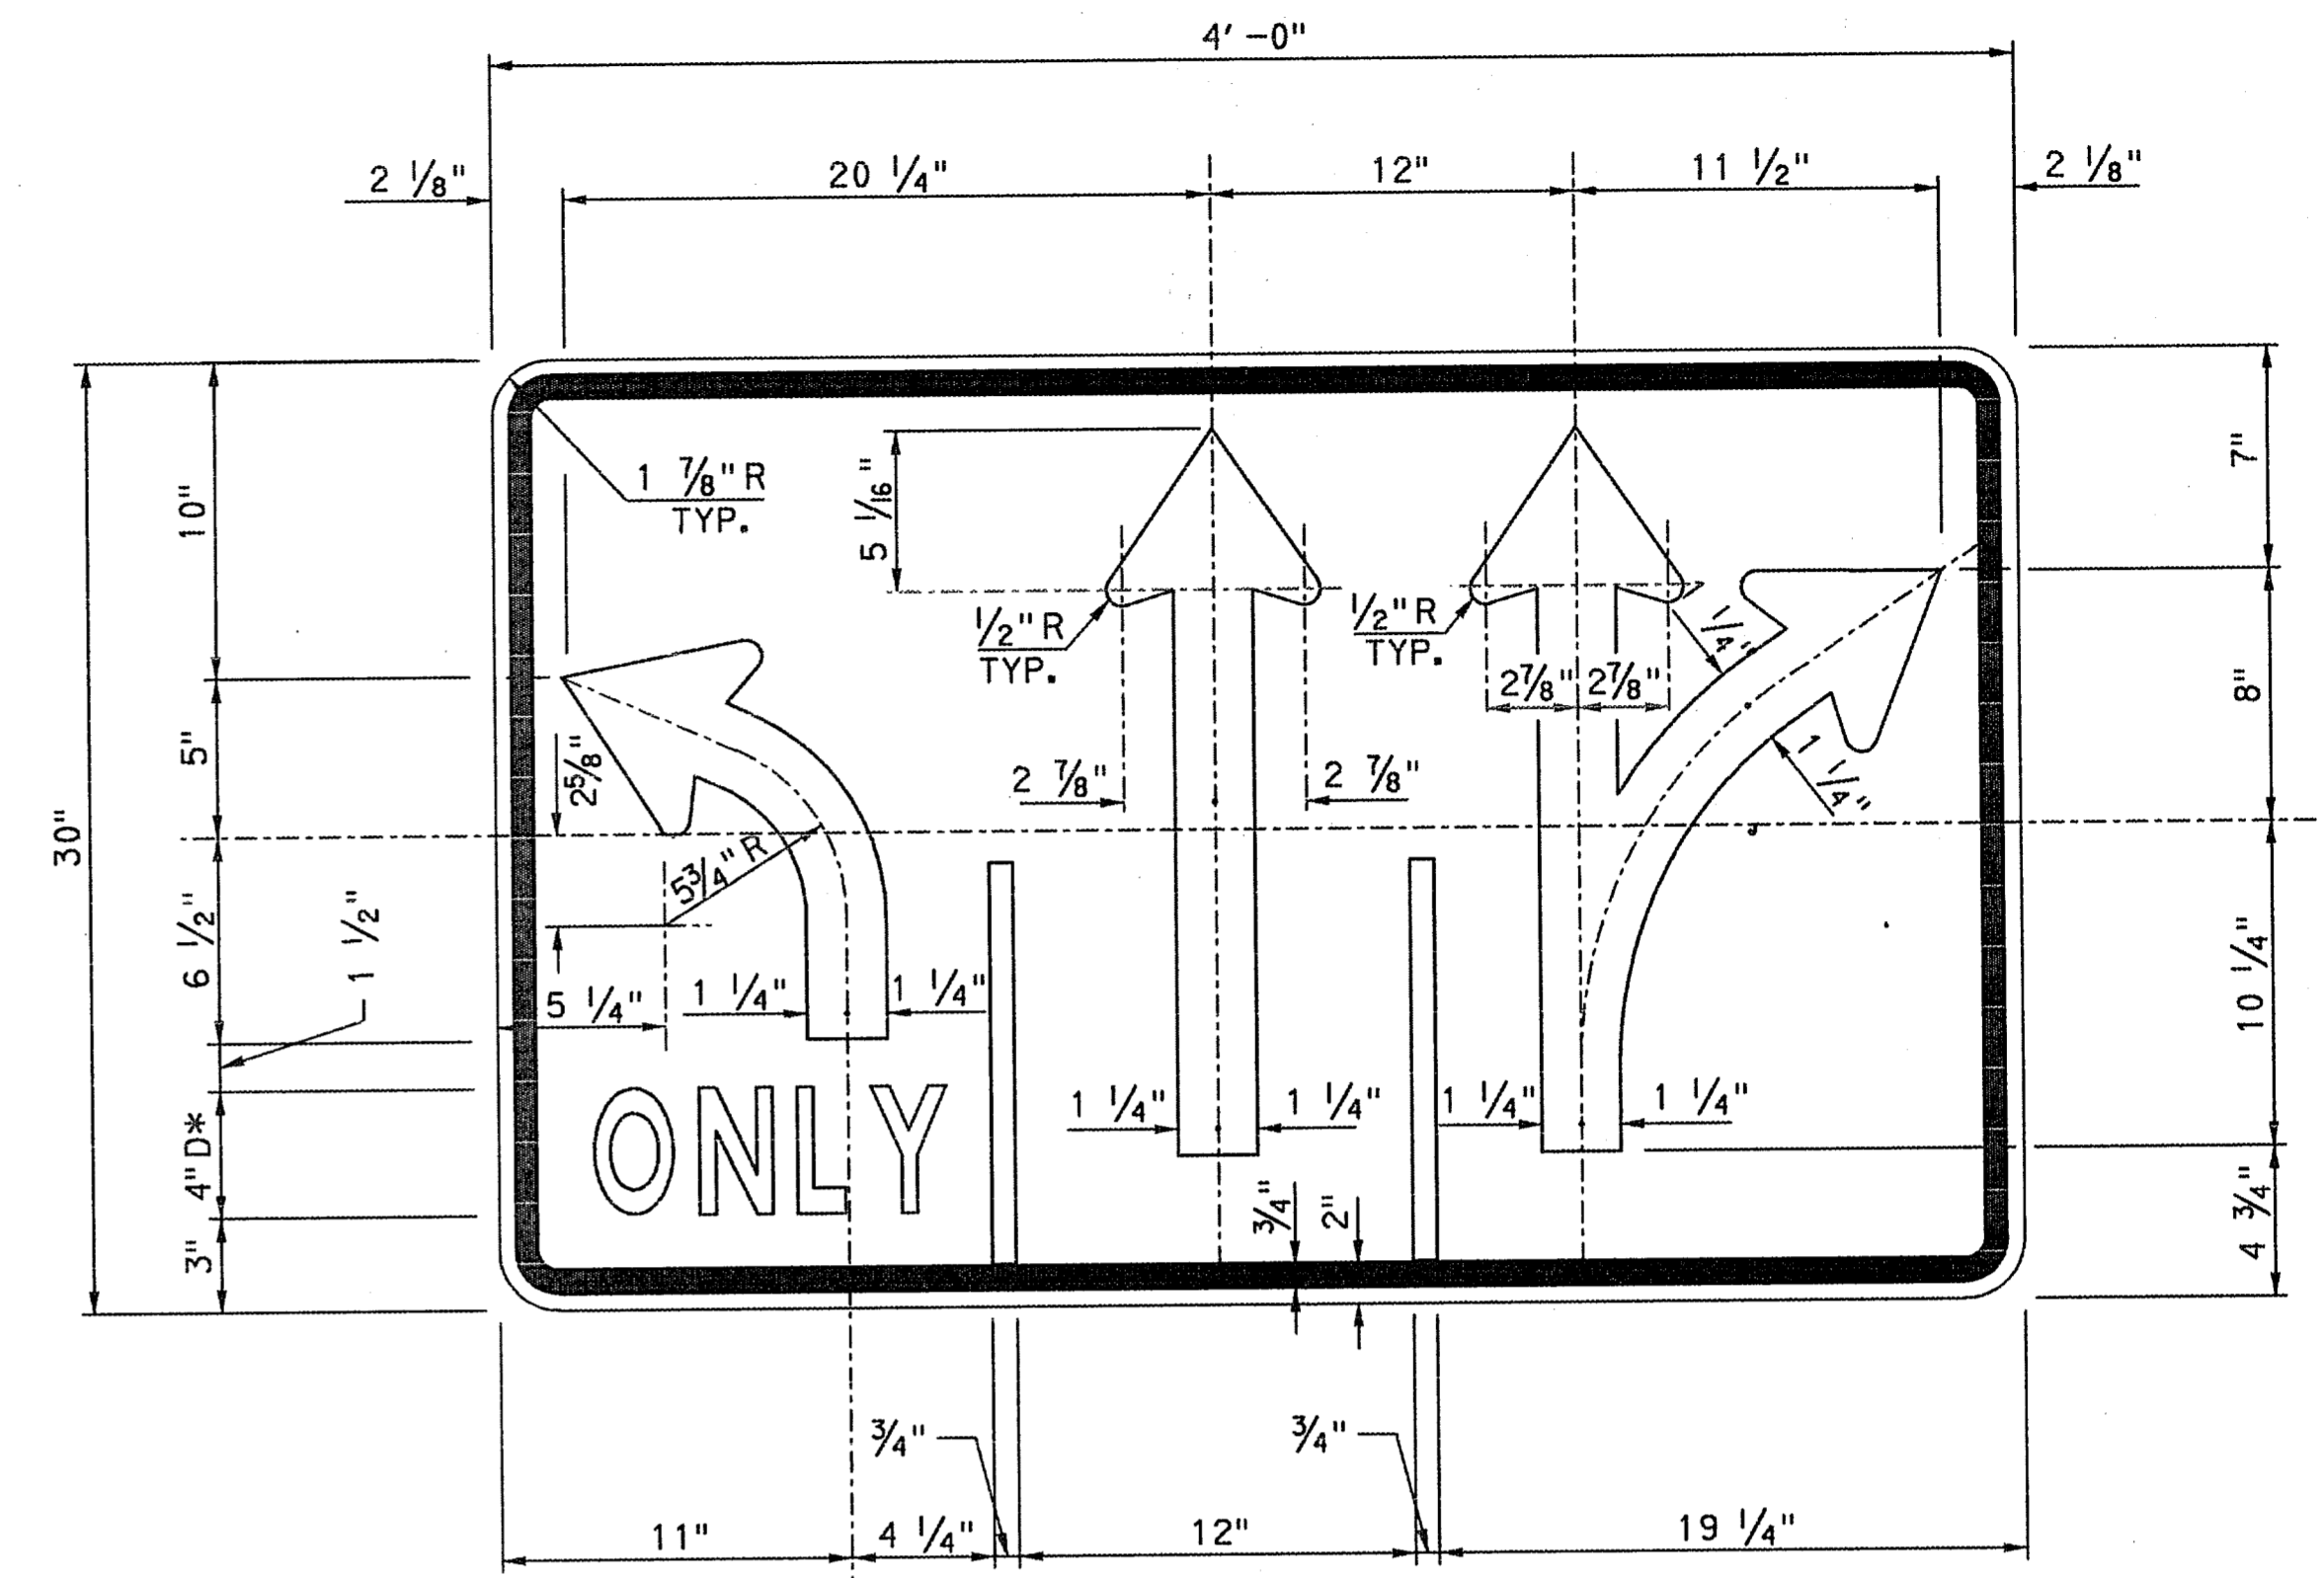


2 AT STA. 35+13

- LEGEND
- BLACK
  - BLACK
  - BLACK
  - WHITE
  - HIGH SPECIFIC INTENSITY (TY C)
  - \* ■ SPACING REDUCED 50%


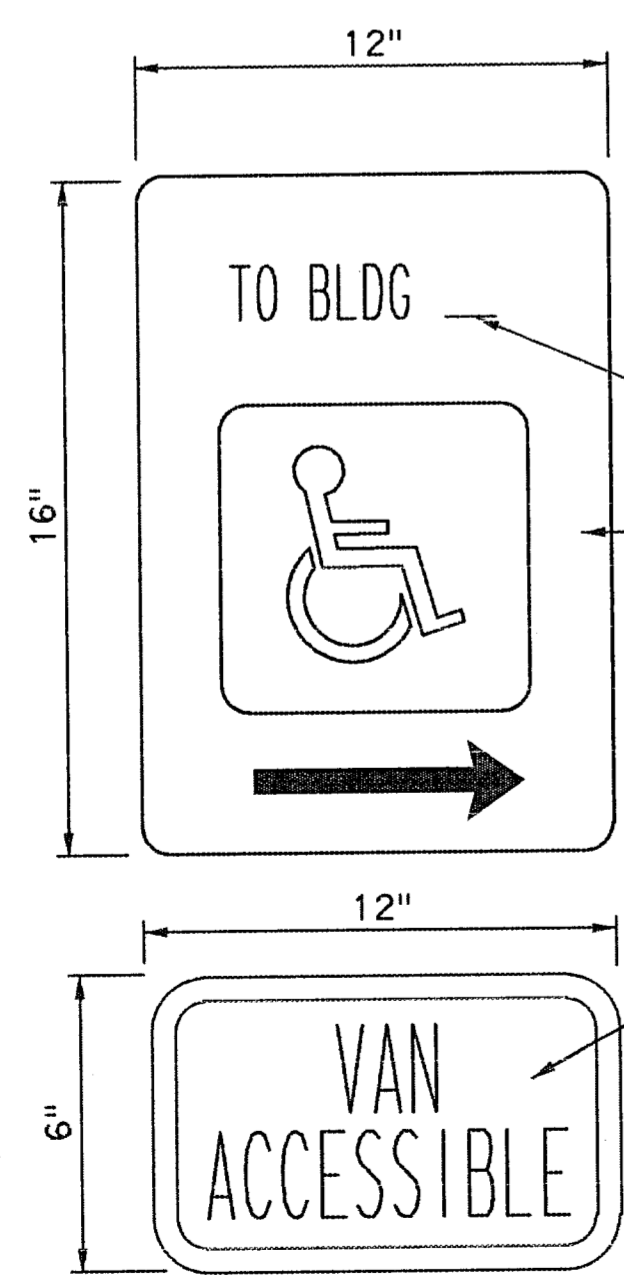


- DESIGNATION BY AUTHORITY, IF ANY
- COLORS:  
 LEGEND & BORDER - GREEN  
 BACKGROUND - WHITE  
 SYMBOL - WHITE ON BLUE BACKGROUND

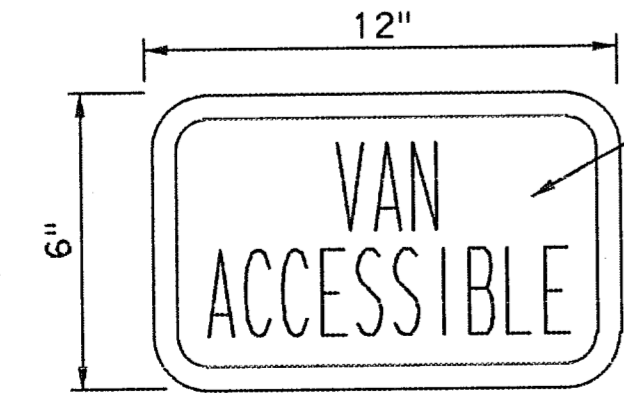

- COLORS:  
 LEGEND & BORDER - WHITE  
 BACKGROUND - BLUE

1 EACH AT STA. 2+35

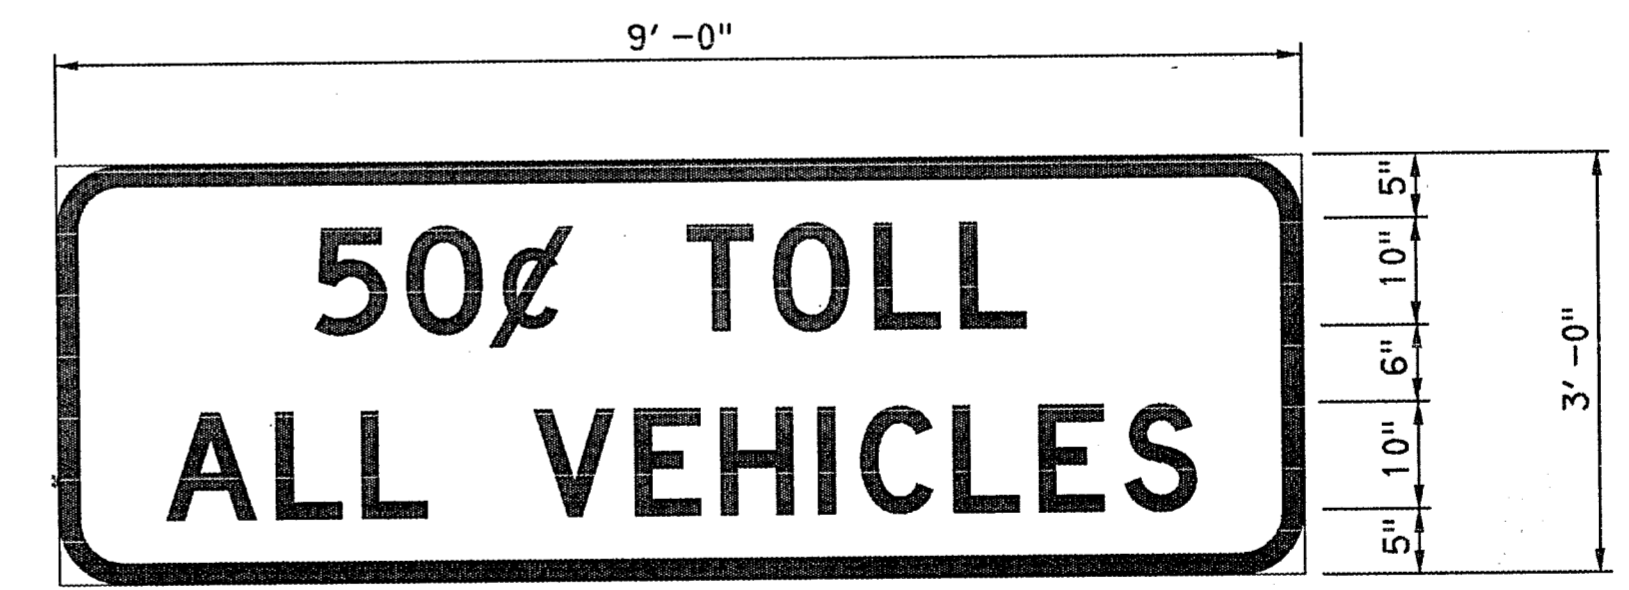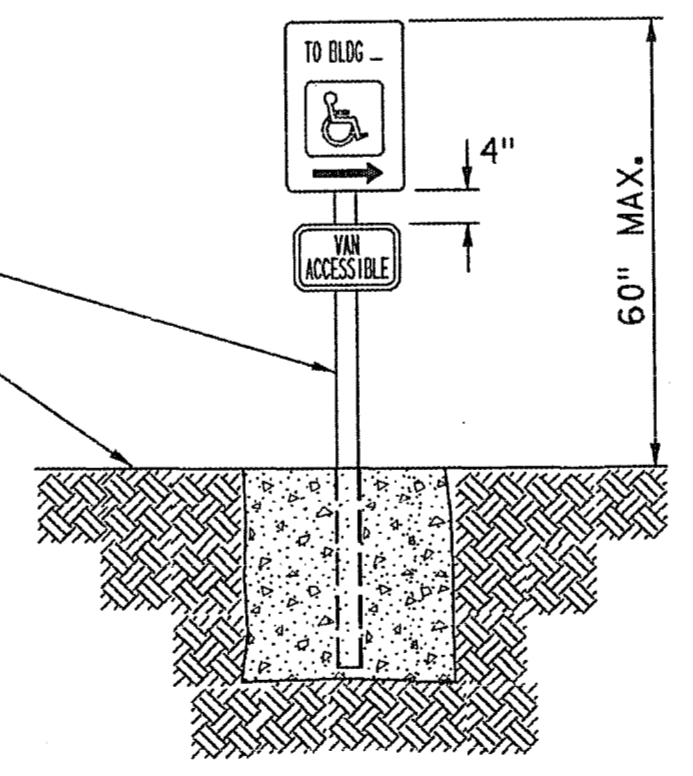

1 AT STA. 1+60  
 1 AT STA. 35+75

- LEGEND
- WHITE
  - WHITE
  - GREEN
  - HIGH SPECIFIC INTENSITY (TY C)
  - BORDER RADIUS : 6"

**HANDICAPPED SPACE SIGN**

N. T. S.  
 NOTE: CONTRACTOR TO FURNISH AND INSTALL ONE (1)  
 H. C. SIGN IN PROJECT VICINITY AS SHOWN ON THE PLANS.

THE SEAL APPEARING ON THIS DOCUMENT WAS AUTHORIZED BY RICHARD K. LAIRD, P.E. NO. 59187 ON JANUARY 12, 1999. ALTERATION OF A SEALED DOCUMENT WITHOUT PRIOR NOTIFICATION TO THE RESPONSIBLE ENGINEER IS AN OFFENSE UNDER THE TEXAS ENGINEERING PRACTICE ACT.



**FINAL RECORD DRAWING**  
 Date: 12/25/99

No.	REVISION	BY	DATE
NORTH TEXAS TOLLWAY AUTHORITY ADDISON AIRPORT TUNNEL			
SIGN DETAILS			
MATED CONSULTING ENGINEERS, INC. 5800 PETERSON LANE SUITE 225 DALLAS, TEXAS 75240 (972) 233-6700			SECTION XIII
DRAWN: SA	DATE: 5/97	DESIGNED: RKL	DATE: 5/97
CHECKED: SCF	DATE: 5/97	SCALE: NONE	
CONTRACT No. DNT-260 SHEET 12 OF 52			

**DESIGN DATA**

SPAN LENGTH	25.50	FT
DESIGN HEIGHT	17.08	FT
TOWER HEIGHT	16.00	FT
DESIGN SIGN AREA	255.00	SF
ACTUAL SIGN AREA	100.75	SF
PENETROMETER VALUE	ASSUME 15	

**STRUCTURE SIZE**


TRUSS TYPE	4.0' x 4.0'
TOWER TYPE	24"Ø PIPE

**SUMMARY OF DRILLED SHAFT**

TOTAL 42 IN. DIA. DRILLED SHAFT = 26 LF

**SUMMARY OF SIGN LIGHTS**

TOTAL = 2 EACH

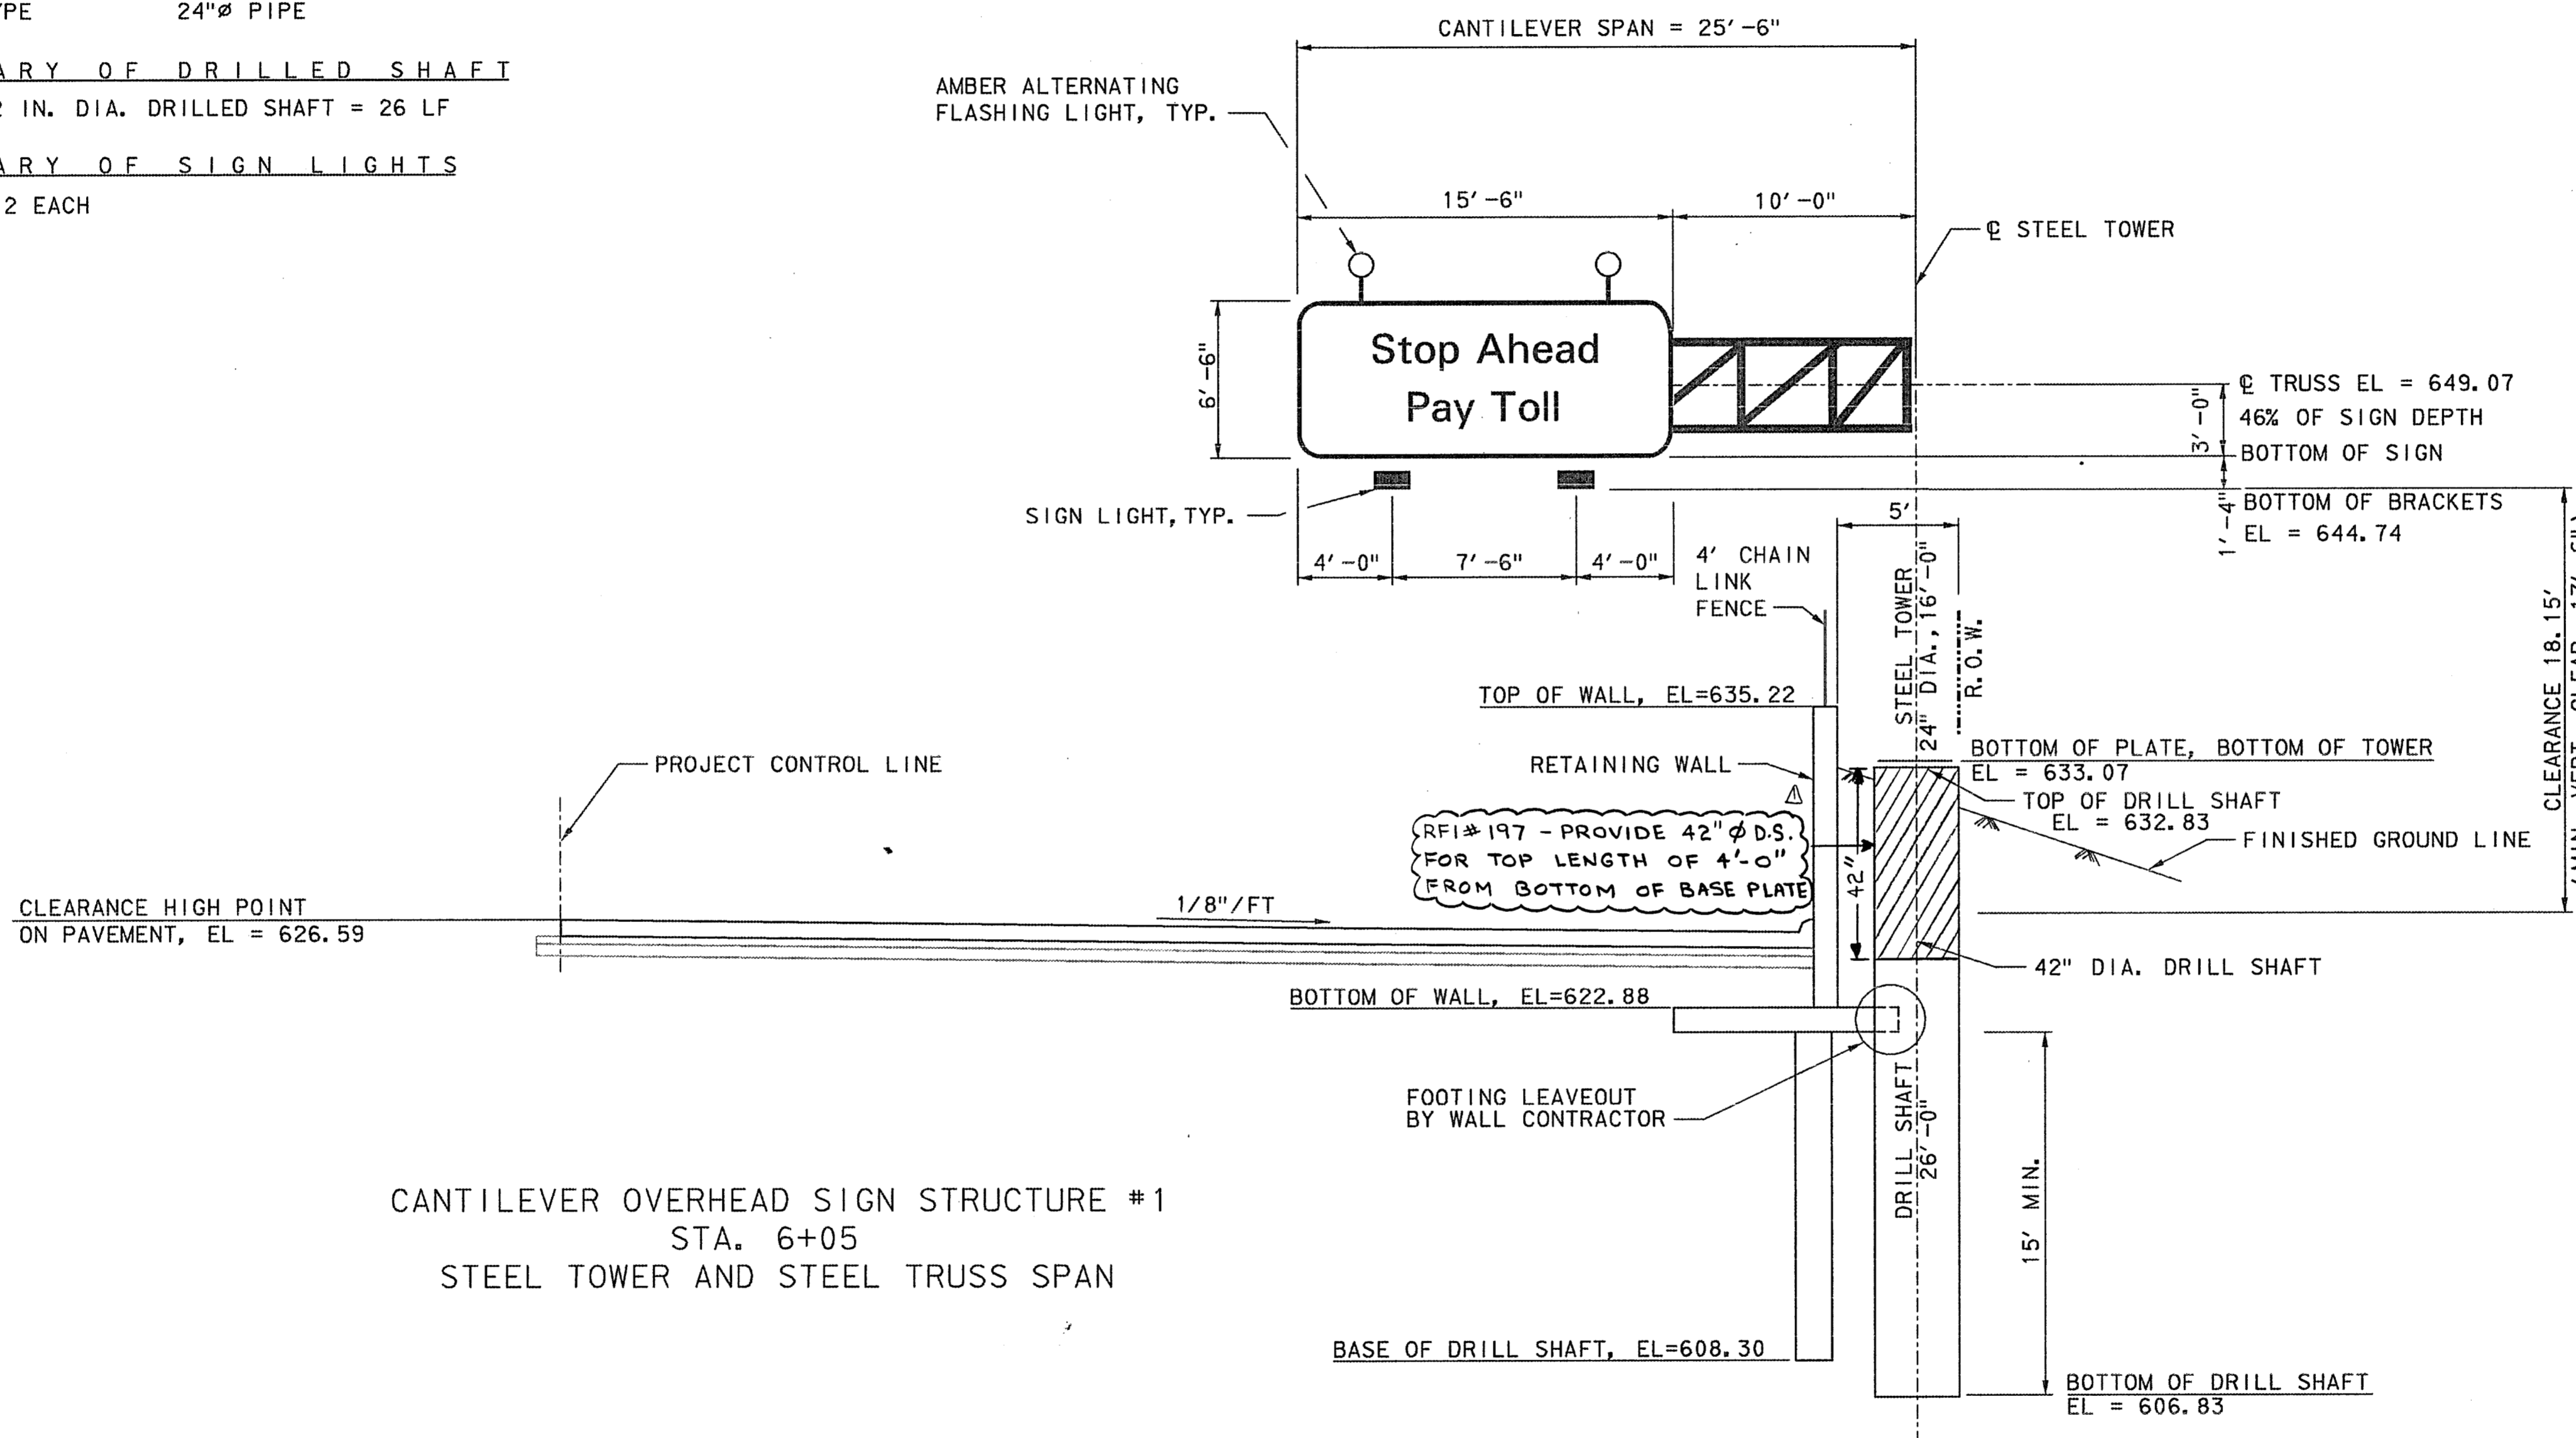


CANTILEVER OVERHEAD SIGN STRUCTURE #1  
STA. 6+05  
STEEL TOWER AND STEEL TRUSS SPAN

**GENERAL NOTES:**

1. THIS OVERHEAD SIGN STRUCTURE WILL BE CONSTRUCTED WITH STEEL TOWER AND STEEL TRUSS.
2. TRUSS CONSTRUCTION SHALL CONFORM TO STANDARD DRAWINGS NO. SS-23, SS-24, AND SS-25.
3. SIGN, SIGN LIGHT BRACKETS, AND SIGN LIGHTS WILL BE INSTALLED UNDER THIS CONTRACT.
4. SEE STANDARD DRAWINGS NO. SS-26 AND SS-27 FOR ADDITIONAL INFORMATION.

THE SEAL APPEARING ON THIS DOCUMENT WAS AUTHORIZED BY RICHARD K. LAIRD, P.E. NO. 59187 ON JANUARY 12, 1999. ALTERATION OF A SEALED DOCUMENT WITHOUT PRIOR NOTIFICATION TO THE RESPONSIBLE ENGINEER IS AN OFFENSE UNDER THE TEXAS ENGINEERING PRACTICE ACT.

**FINAL RECORD DRAWING**  
Date: 12/25/99

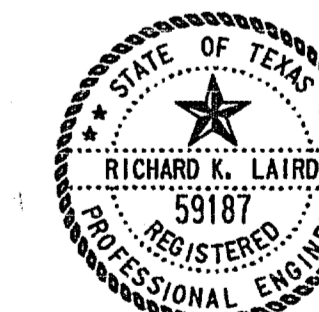

△ REVISED PER RFI# 157

No.	REVISION	BY	DATE
NORTH TEXAS TOLLWAY AUTHORITY ADDISON AIRPORT TUNNEL			
CANTILEVER OVERHEAD SIGN STRUCTURE #1 STA. 6+05			
MATED CONSULTING ENGINEERS, INC. 5540 PETERSON LANE SUITE 225 DALLAS, TEXAS 75240 (972) 233-0700			SECTION XIII
DRAWN SA	DATE 5/97	DESIGNED RKL	DATE 5/97
CHECKED SCF	DATE 5/97	SCALE 1" = 5'-0"	
CONTRACT No. DNT-260 SHEET 13 OF 52			

DESIGN DATA

SPAN LENGTH	30.00	FT
DESIGN HEIGHT	23.24	FT
TOWER HEIGHT	22.50	FT
DESIGN SIGN AREA	300.00	SF
ACTUAL SIGN AREA	123.50	SF
PENETROMETER VALUE	ASSUME 15	

STRUCTURE SIZE


TRUSS TYPE	4.0' x 4.0'
TOWER TYPE	24" Ø PIPE

SUMMARY OF DRILLED SHAFT

TOTAL 48 IN. DIA. DRILLED SHAFT = 28 LF

SUMMARY OF SIGN LIGHTS

TOTAL = 4 EACH

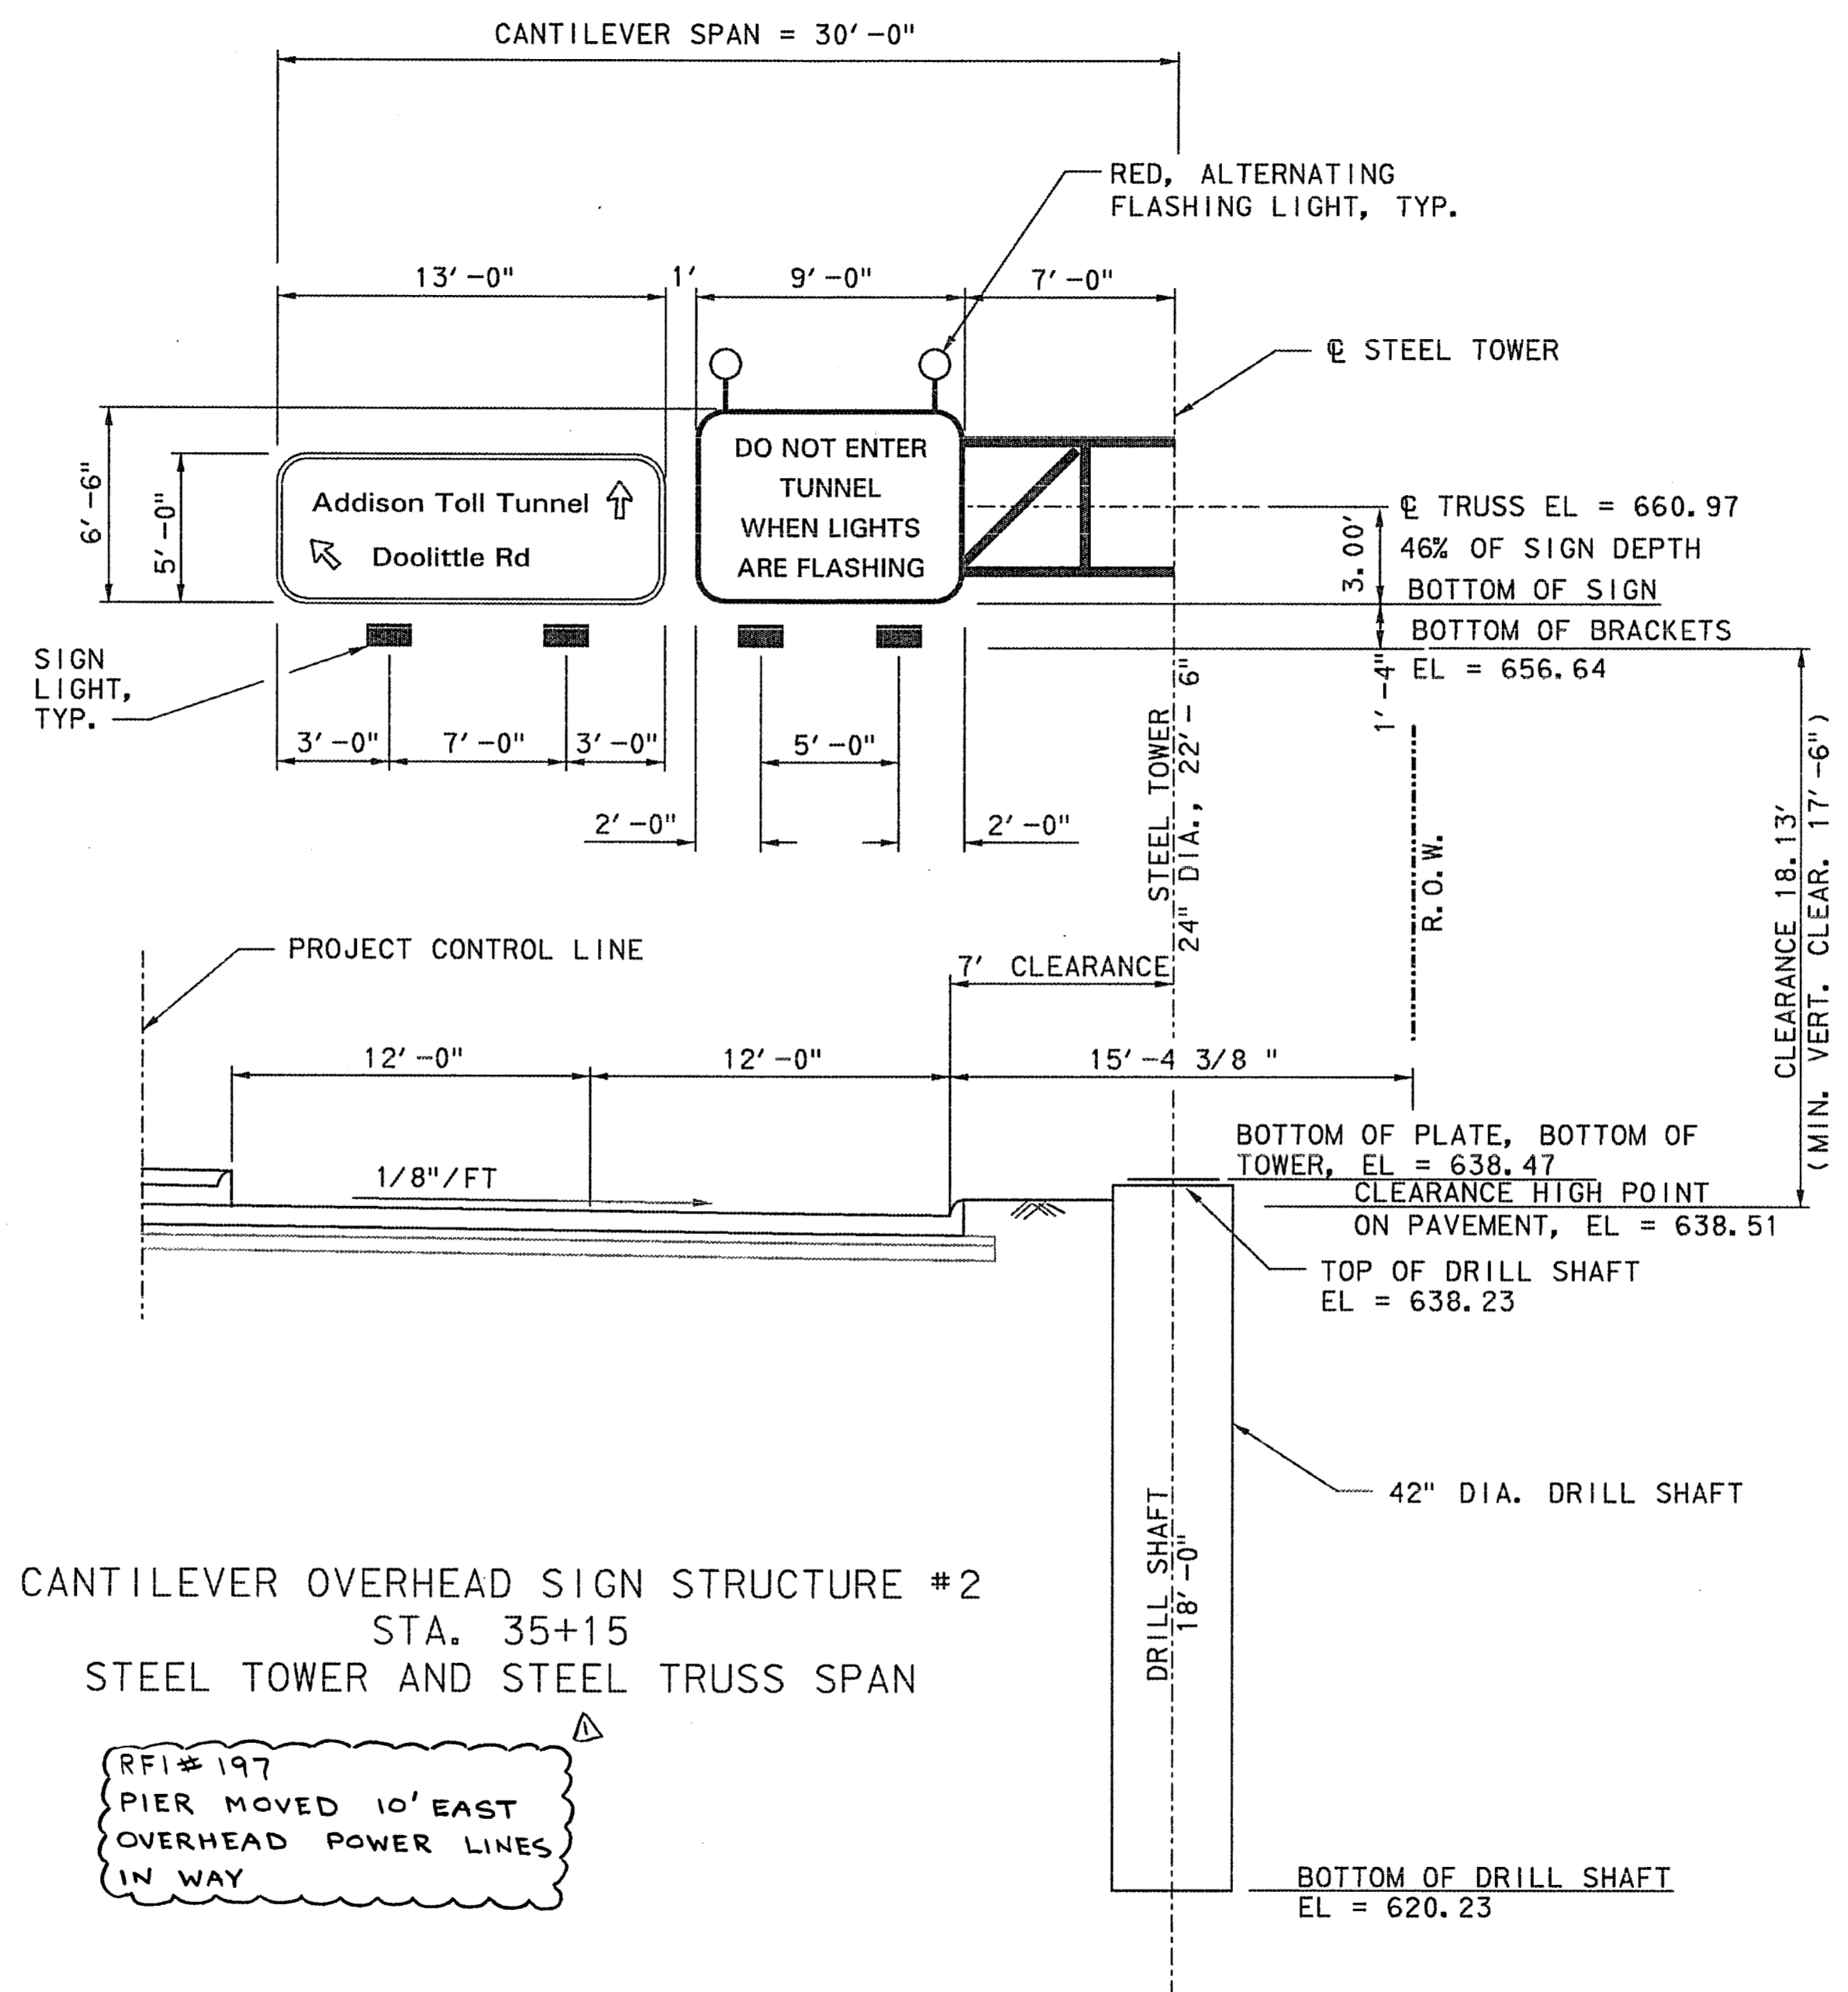

CANTILEVER OVERHEAD SIGN STRUCTURE #2  
STA. 35+15  
STEEL TOWER AND STEEL TRUSS SPAN

RFI # 197  
PIER MOVED 10' EAST  
OVERHEAD POWER LINES  
IN WAY

GENERAL NOTES:

1. THIS OVERHEAD SIGN STRUCTURE WILL BE CONSTRUCTED WITH STEEL TOWER AND STEEL TRUSS.
2. TRUSS CONSTRUCTION SHALL CONFORM TO STANDARD DRAWINGS NO. SS-23, SS-24, AND SS-25.
3. SIGN, SIGN LIGHT BRACKETS, AND SIGN LIGHTS WILL BE INSTALLED UNDER THIS CONTRACT.
4. SEE STANDARD DRAWINGS NO. SS-26 AND SS-27 FOR ADDITIONAL INFORMATION.


THE SEAL APPEARING ON THIS DOCUMENT WAS AUTHORIZED BY RICHARD K. LAIRD, P.E. NO. 59187 ON JANUARY 12, 1999. ALTERATION OF A SEALED DOCUMENT WITHOUT PRIOR NOTIFICATION TO THE RESPONSIBLE ENGINEER IS AN OFFENSE UNDER THE TEXAS ENGINEERING PRACTICE ACT.

**FINAL RECORD  
DRAWING**  
Date: 12/25/99



REVISOR PER RFI # 197

No.	REVISION	BY	DATE
NORTH TEXAS TOLLWAY AUTHORITY ADDISON AIRPORT TUNNEL			
CANTILEVER OVERHEAD SIGN STRUCTURE #2 STA. 35+15			
MCE MATED CONSULTING ENGINEERS, INC. 5540 PETERSON LANE SUITE 225 DALLAS, TEXAS 75240 (972) 235-0700			SECTION XIII
DRAWN SA	DATE 5/97	DESIGNED RKL	DATE 5/97
CHECKED SCF	DATE 5/97	SCALE 1" = 5'-0"	
CONTRACT No. DNT-260 SHEET 14 OF 52			

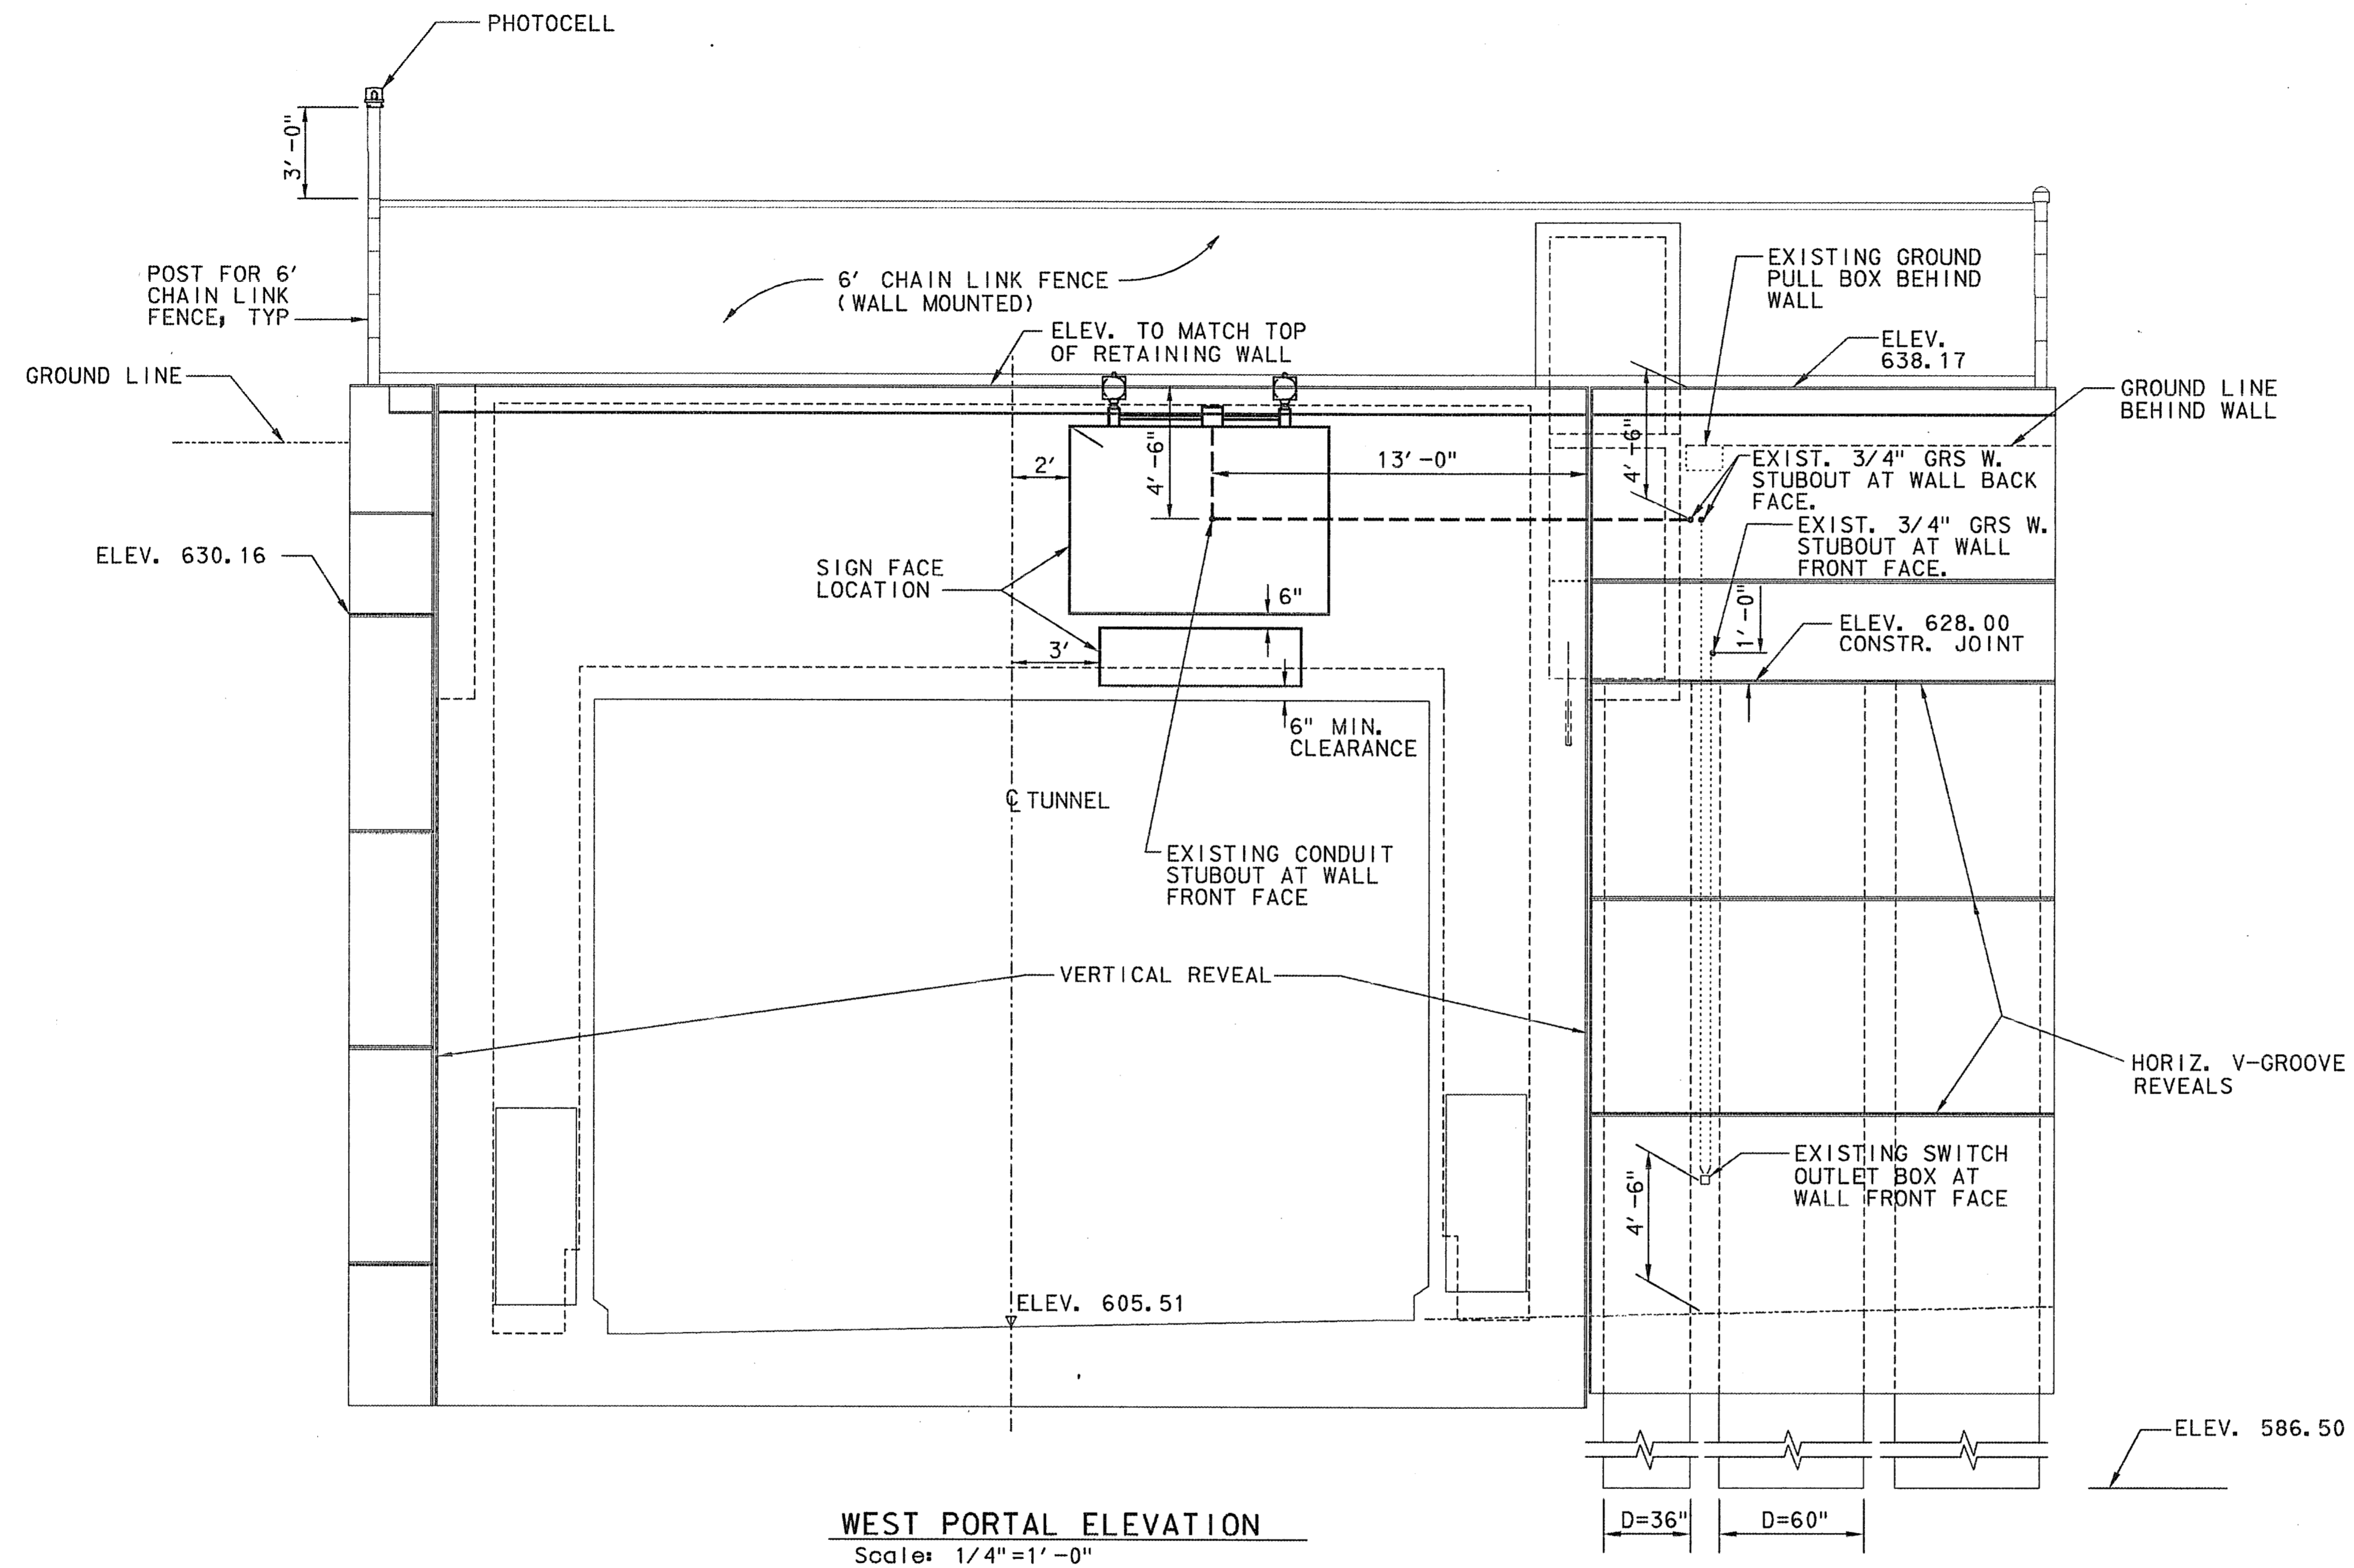


THE SEAL APPEARING ON THIS DOCUMENT WAS AUTHORIZED BY RICHARD K. LAIRD, P.E. NO. 59187 ON JANUARY 12, 1999. ALTERATION OF A SEALED DOCUMENT WITHOUT PRIOR NOTIFICATION TO THE RESPONSIBLE ENGINEER IS AN OFFENSE UNDER THE TEXAS ENGINEERING PRACTICE ACT.

**FINAL RECORD  
DRAWING**  
Date: 12/25/99



No.	REVISION	BY	DATE
NORTH TEXAS TOLLWAY AUTHORITY ADDISON AIRPORT TUNNEL			
WEST PORTAL STA. 9+75 OVERHEAD SIGN ATTACHMENT LOCATION			
MATED CONSULTING ENGINEERS, INC. 5505 PETERSON LANE, SUITE 225 DALLAS, TEXAS 75240 (972) 233-6100			SECTION XIII
DRAWN: SA	DATE: 5/97	DESIGNED: RKL	DATE: 5/97
CHECKED: SCF	DATE: 5/97	SCALE: AS SHOWN	
CONTRACT No. DNT-260 SHEET 15 OF 52			



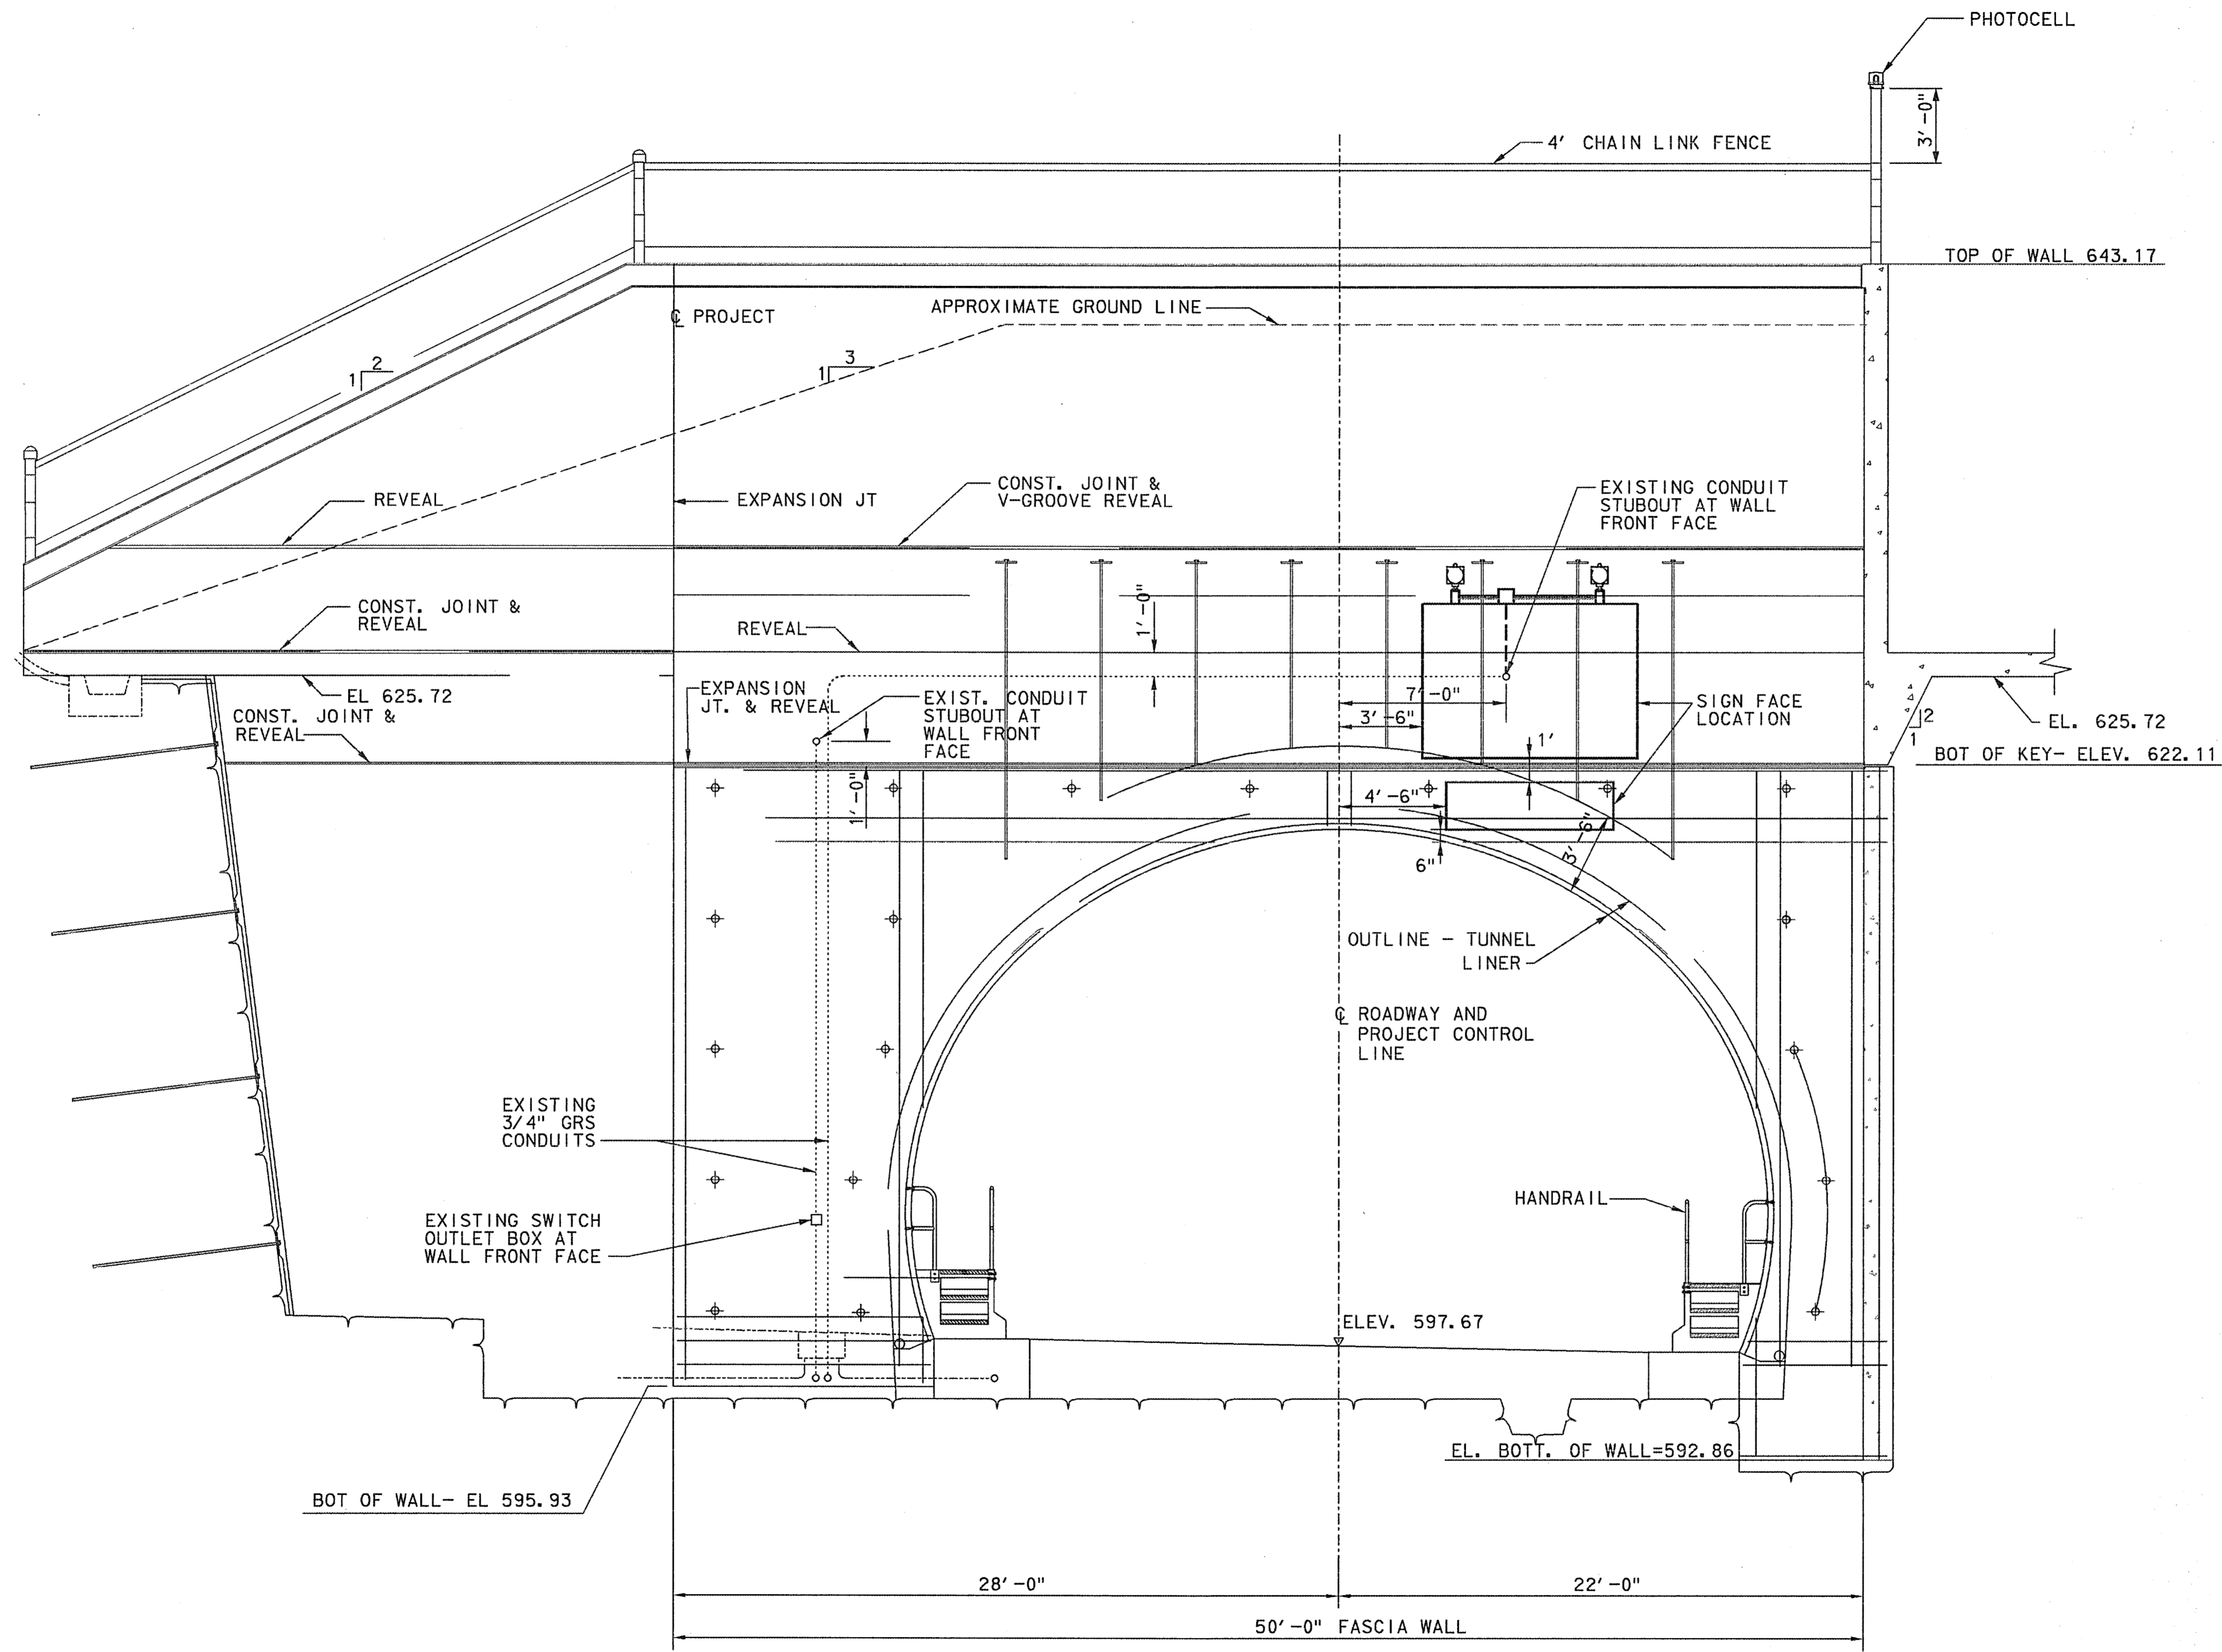


THE SEAL APPEARING ON THIS DOCUMENT WAS AUTHORIZED BY RICHARD K. LAIRD, P.E. NO. 59187 ON JANUARY 12, 1999. ALTERATION OF A SEALED DOCUMENT WITHOUT PRIOR NOTIFICATION TO THE RESPONSIBLE ENGINEER IS AN OFFENSE UNDER THE TEXAS ENGINEERING PRACTICE ACT.

**FINAL RECORD DRAWING**  
Date: 12/25/99




**SECTIONAL ELEVATION - STA. 26+25**  
(LOOKING WEST)  
SCALE: 1/4" = 1'-0"

No.	REVISION	BY	DATE
NORTH TEXAS TOLLWAY AUTHORITY ADDISON AIRPORT TUNNEL			
EAST PORTAL STA. 26+25 OVERHEAD SIGN ATTACHMENT LOCATION			
MATED CONSULTING ENGINEERS, INC. 5580 PETERSON LANE SUITE 225 DALLAS, TEXAS 75246 (972) 535-0700			SECTION XIII
DRAWN: SA	DATE: 5/97	DESIGNED: SA	DATE: 5/97
CHECKED: SCF	DATE: 5/97	SCALE: AS SHOWN	
CONTRACT No. DNT-260 SHEET 16 OF 52			

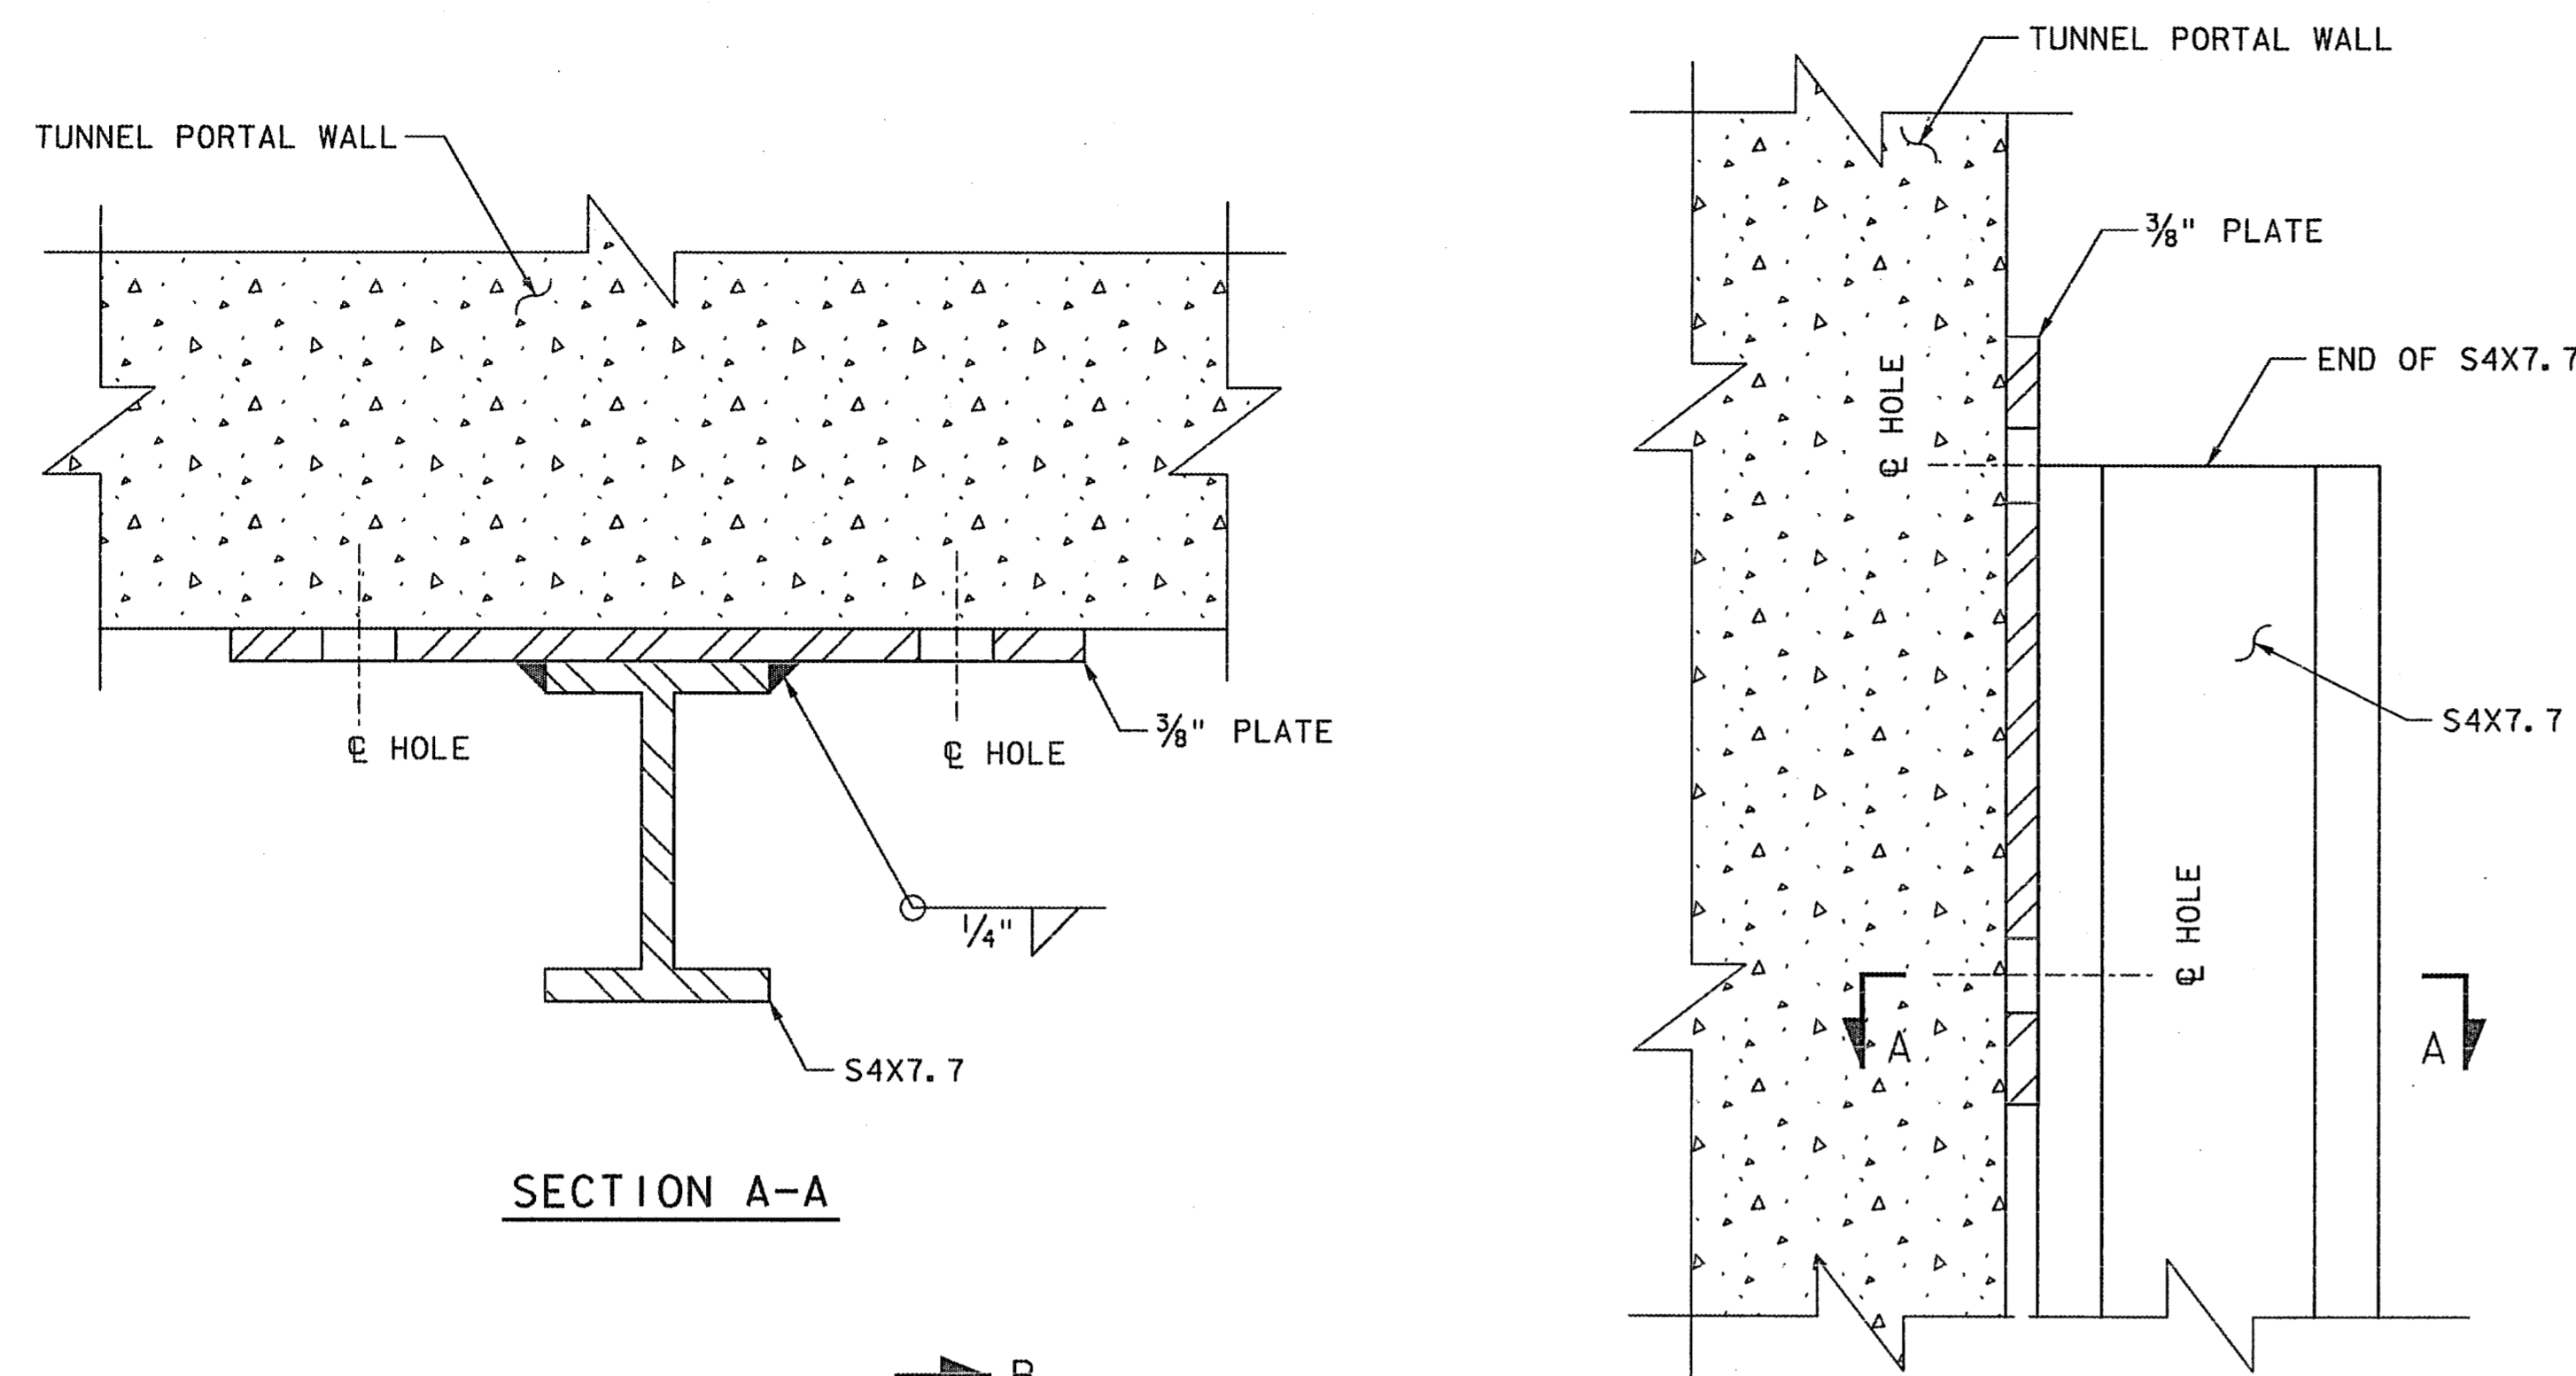

SECTION A-A

SECTION B-B

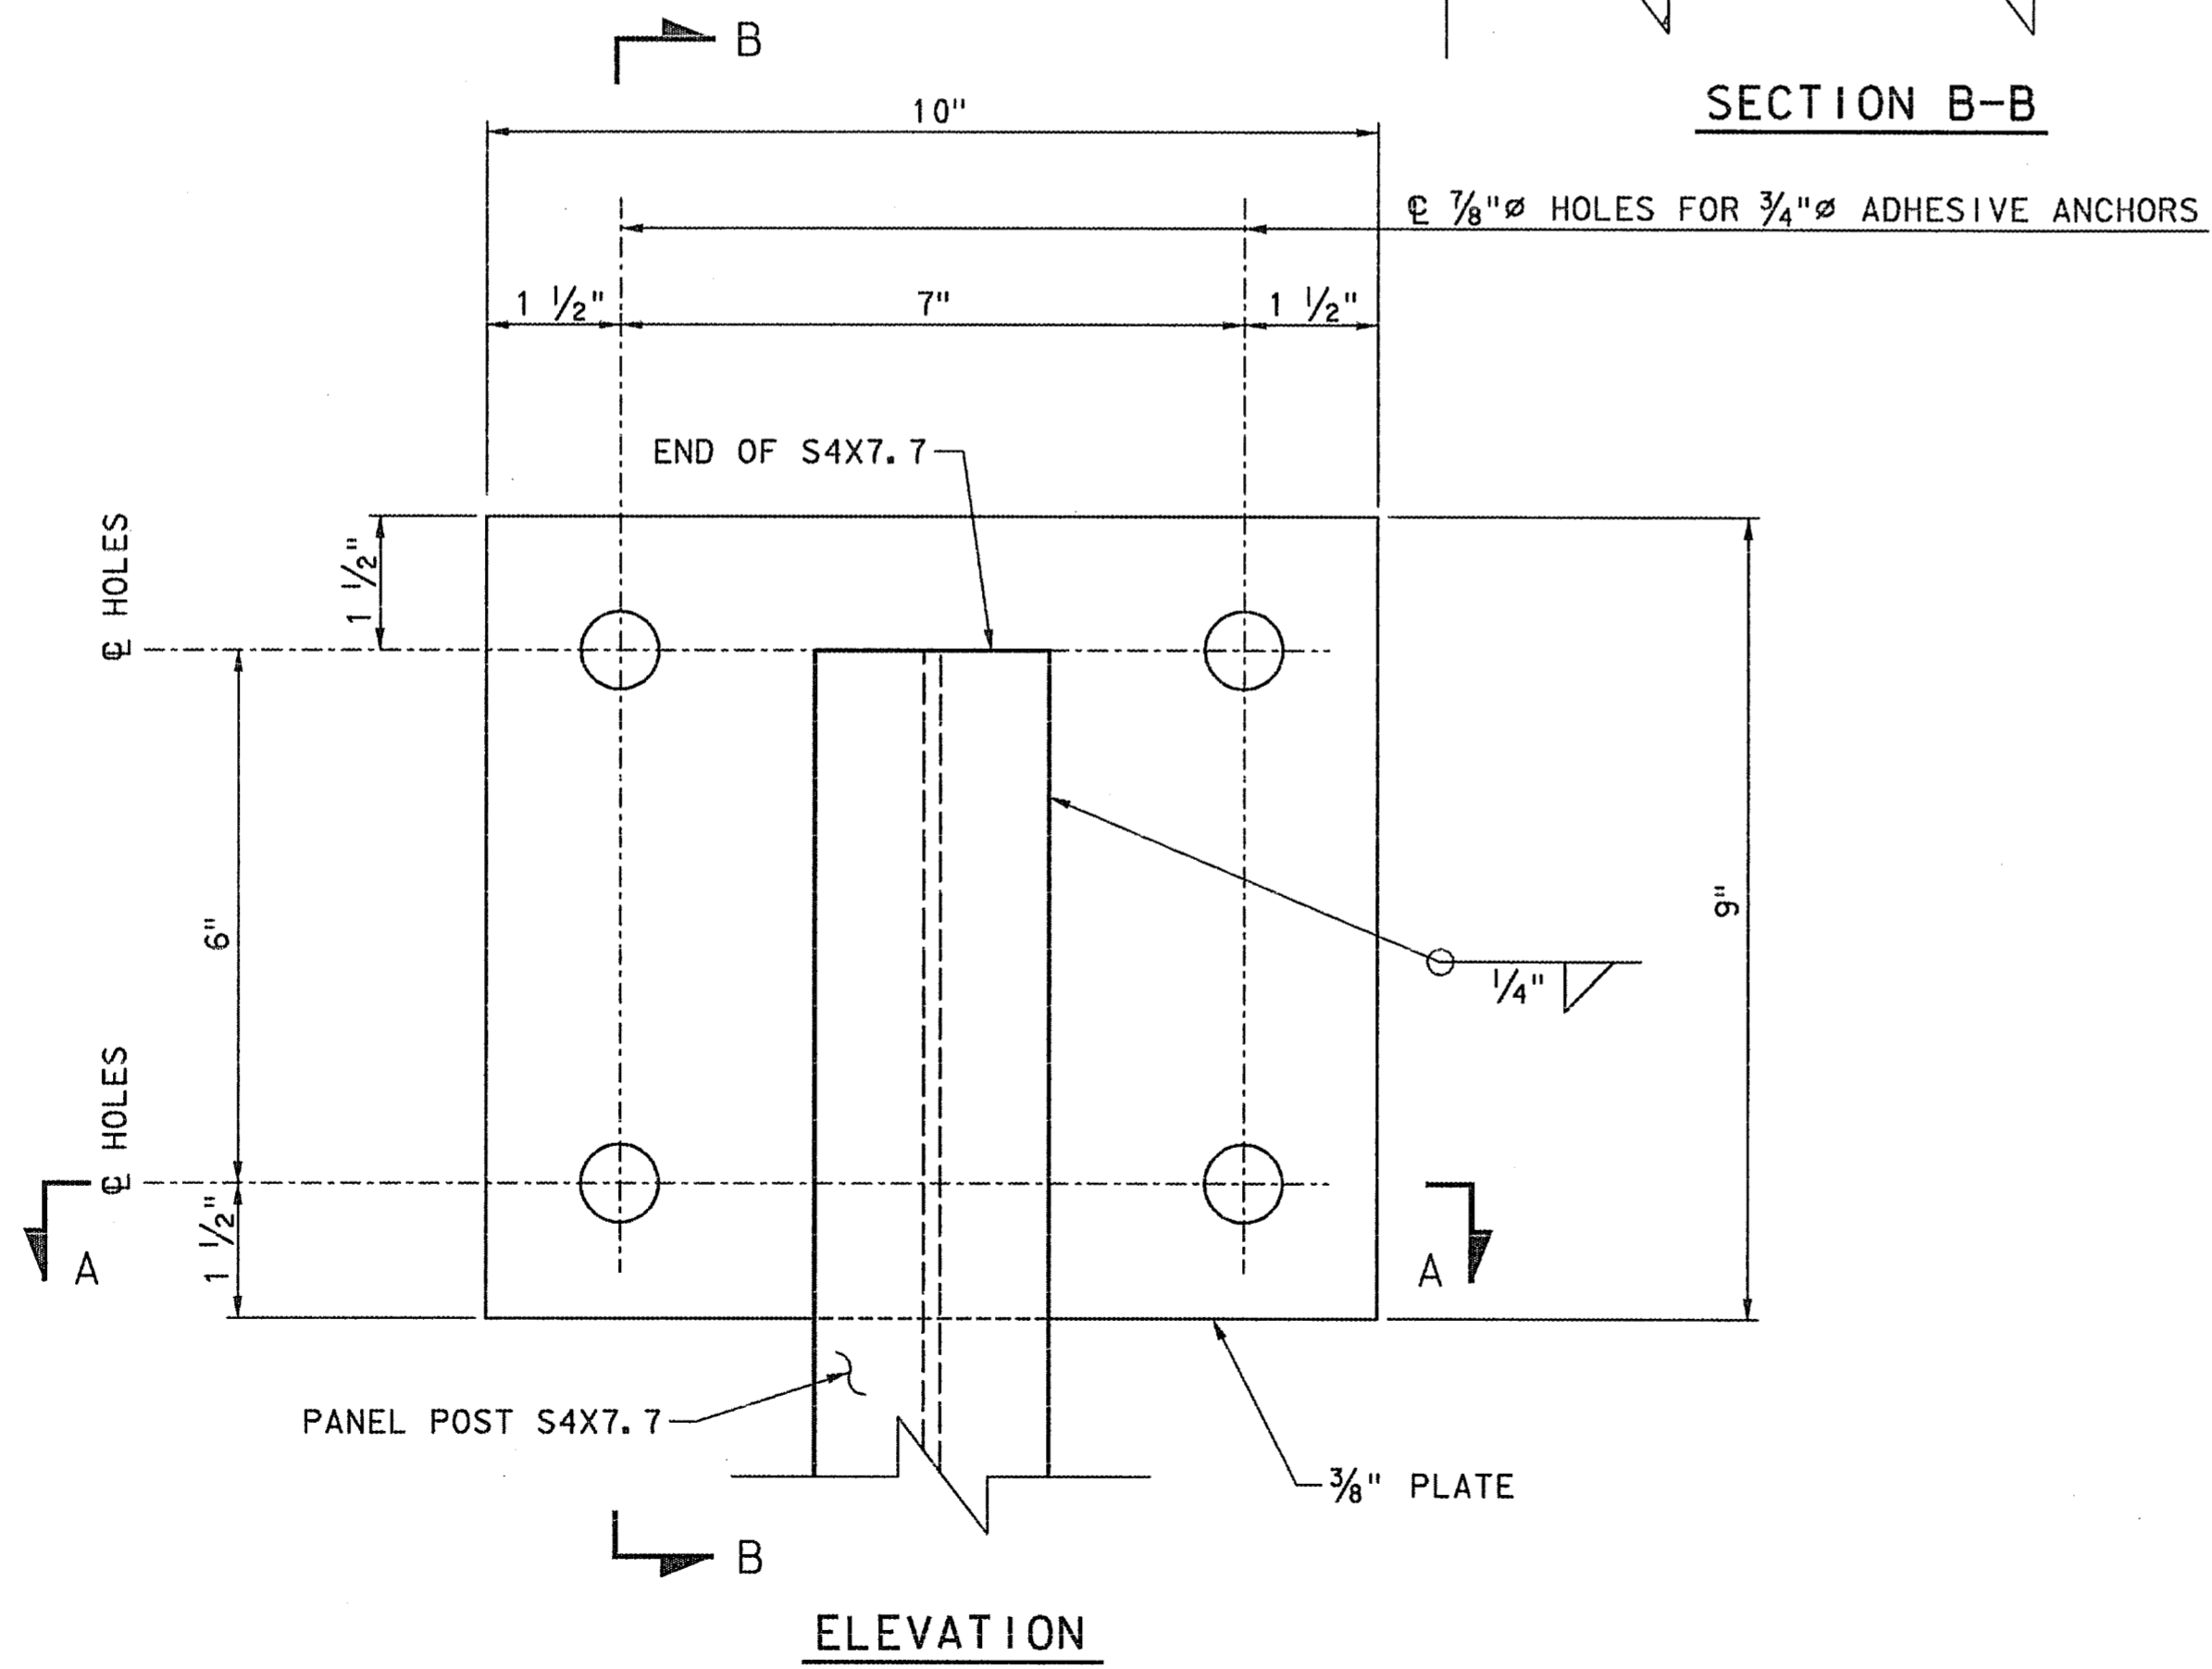


ELEVATION

**MOUNTING PLATE DETAILS**

NOTES:

1. 4 EACH 3/4"Ø X 6 5/8" ADHESIVE TYPE ANCHORS AS APPROVED BY ENGINEER.
2. ONE MOUNTING PLATE AT EACH END OF S4X7.7 POST.

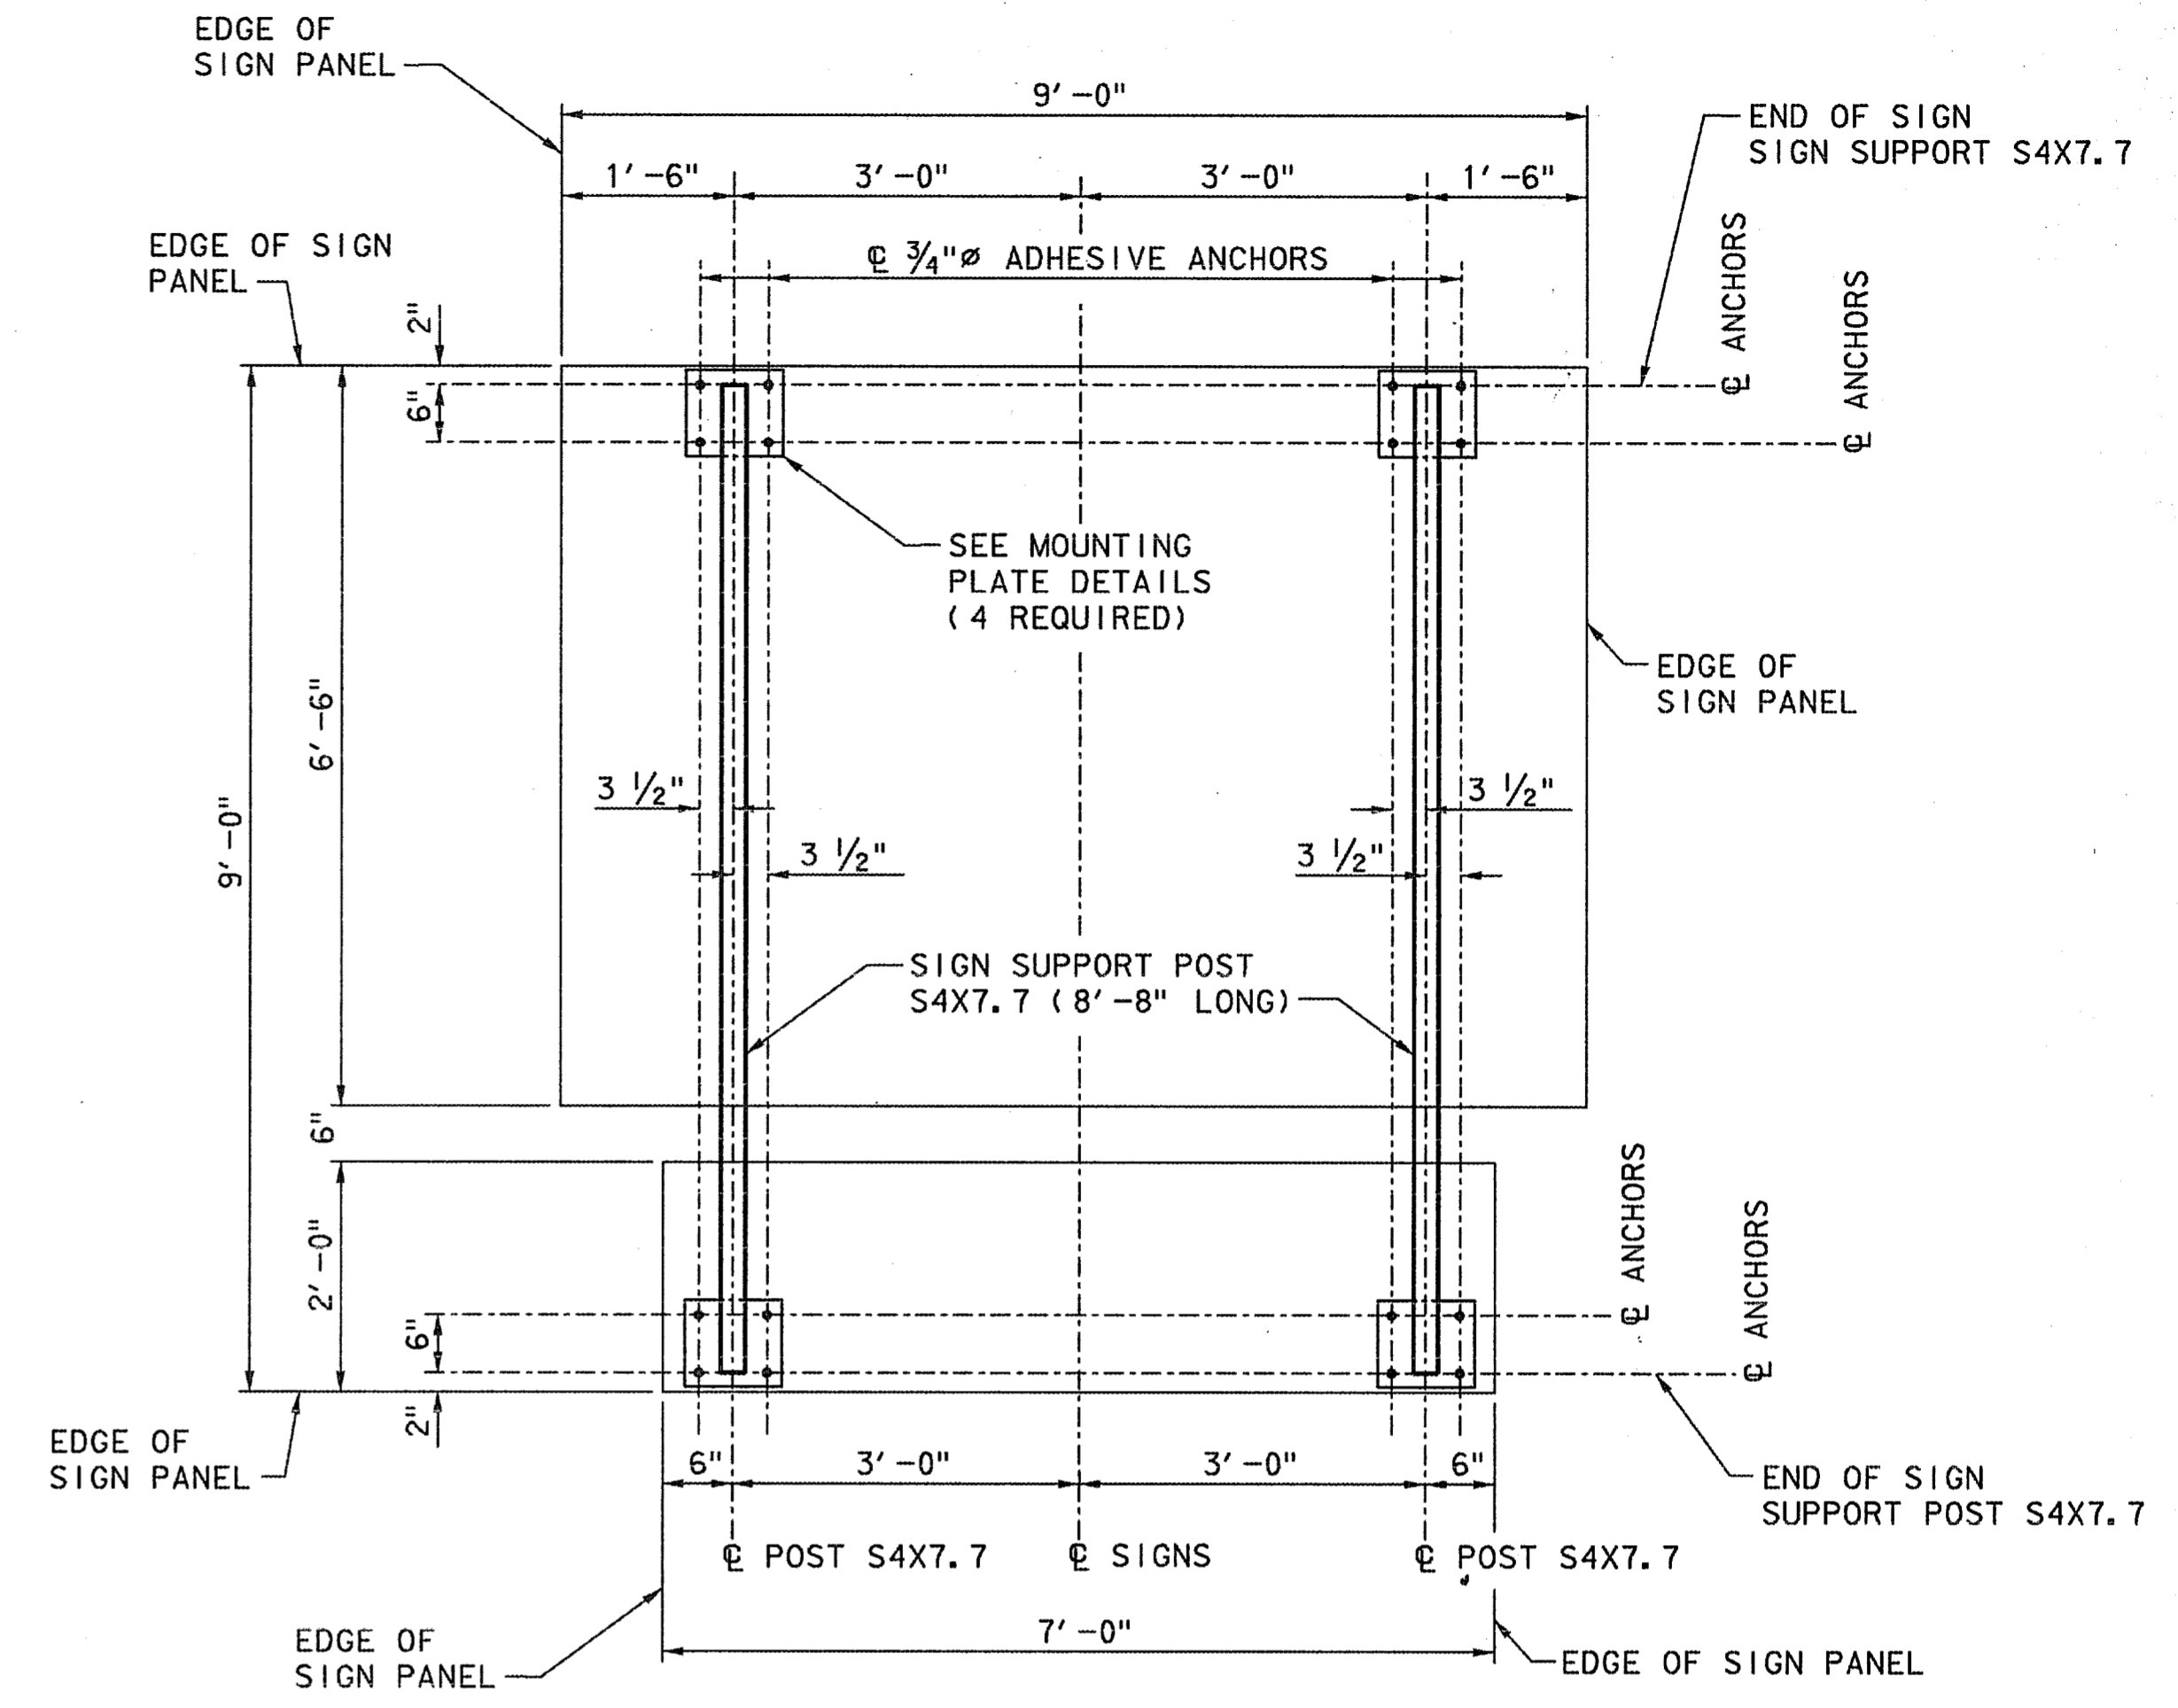

SIGN SUPPORT FRAMING AND ANCHOR DETAILS

GENERAL NOTES:


1. ADHESIVE TYPE ANCHORS SHALL BE APPROVED BY THE ENGINEER.
2. NO DIRECT PAYMENT WILL BE MADE FOR SIGN MOUNTING. COST OF MATERIALS AND LABOR SHALL BE INCLUDED IN THE PRICE BID FOR PORTAL SIGNS ITEM NO. 636 & SP.
3. STRUCTURAL STEEL SHALL CONFORM TO SPECIFICATION ITEM 441.
4. SHOP WELD 3/8" PLATE TO PANEL POST S4X7.7. LOCATE SIGN ON TUNNEL PORTAL AND USE 3/8" PLATE AS TEMPLATE FOR LOCATION OF ADHESIVE ANCHORS BEFORE DRILLING HOLES IN CONCRETE.
5. THE CONTRACTOR MAY SUBMIT A FRAMING TEMPLATE FOR LOCATING THE ANCHOR BOLT PATTERN PRIOR TO ERECTION.
6. FOR OTHER DETAILS, SEE STANDARD SMD (P-1)(MOD.). PROVIDE STRAIGHT 8'-8" LONG S4X7.7 POST FOR SIGN SUPPORT. WALKWAYS WILL NOT BE PROVIDED AND LIGHTS WILL NOT BE PROVIDED AT TUNNEL PORTAL.

THE SEAL APPEARING ON THIS DOCUMENT WAS AUTHORIZED BY RICHARD K. LAIRD, P.E. NO. 59187 ON JANUARY 12, 1999. ALTERATION OF A SEALED DOCUMENT WITHOUT PRIOR NOTIFICATION TO THE RESPONSIBLE ENGINEER IS AN OFFENSE UNDER THE TEXAS ENGINEERING PRACTICE ACT.

**FINAL RECORD DRAWING**  
Date: 12/25/99



No.	REVISION	BY	DATE
NORTH TEXAS TOLLWAY AUTHORITY ADDISON AIRPORT TUNNEL			
TUNNEL PORTAL SIGN MOUNTING DETAILS			
MATED CONSULTING ENGINEERS, INC. 5980 PETERSON LANE SUITE 225 DALLAS, TEXAS 75249 (972) 235-8700			SECTION XIII
DRAWN: SA	DATE: 5/97	DESIGNED: RKL	DATE: 5/97
CHECKED: SCF	DATE: 5/97	SCALE: NONE	
CONTRACT No. DNT-260 SHEET 17 OF 52			

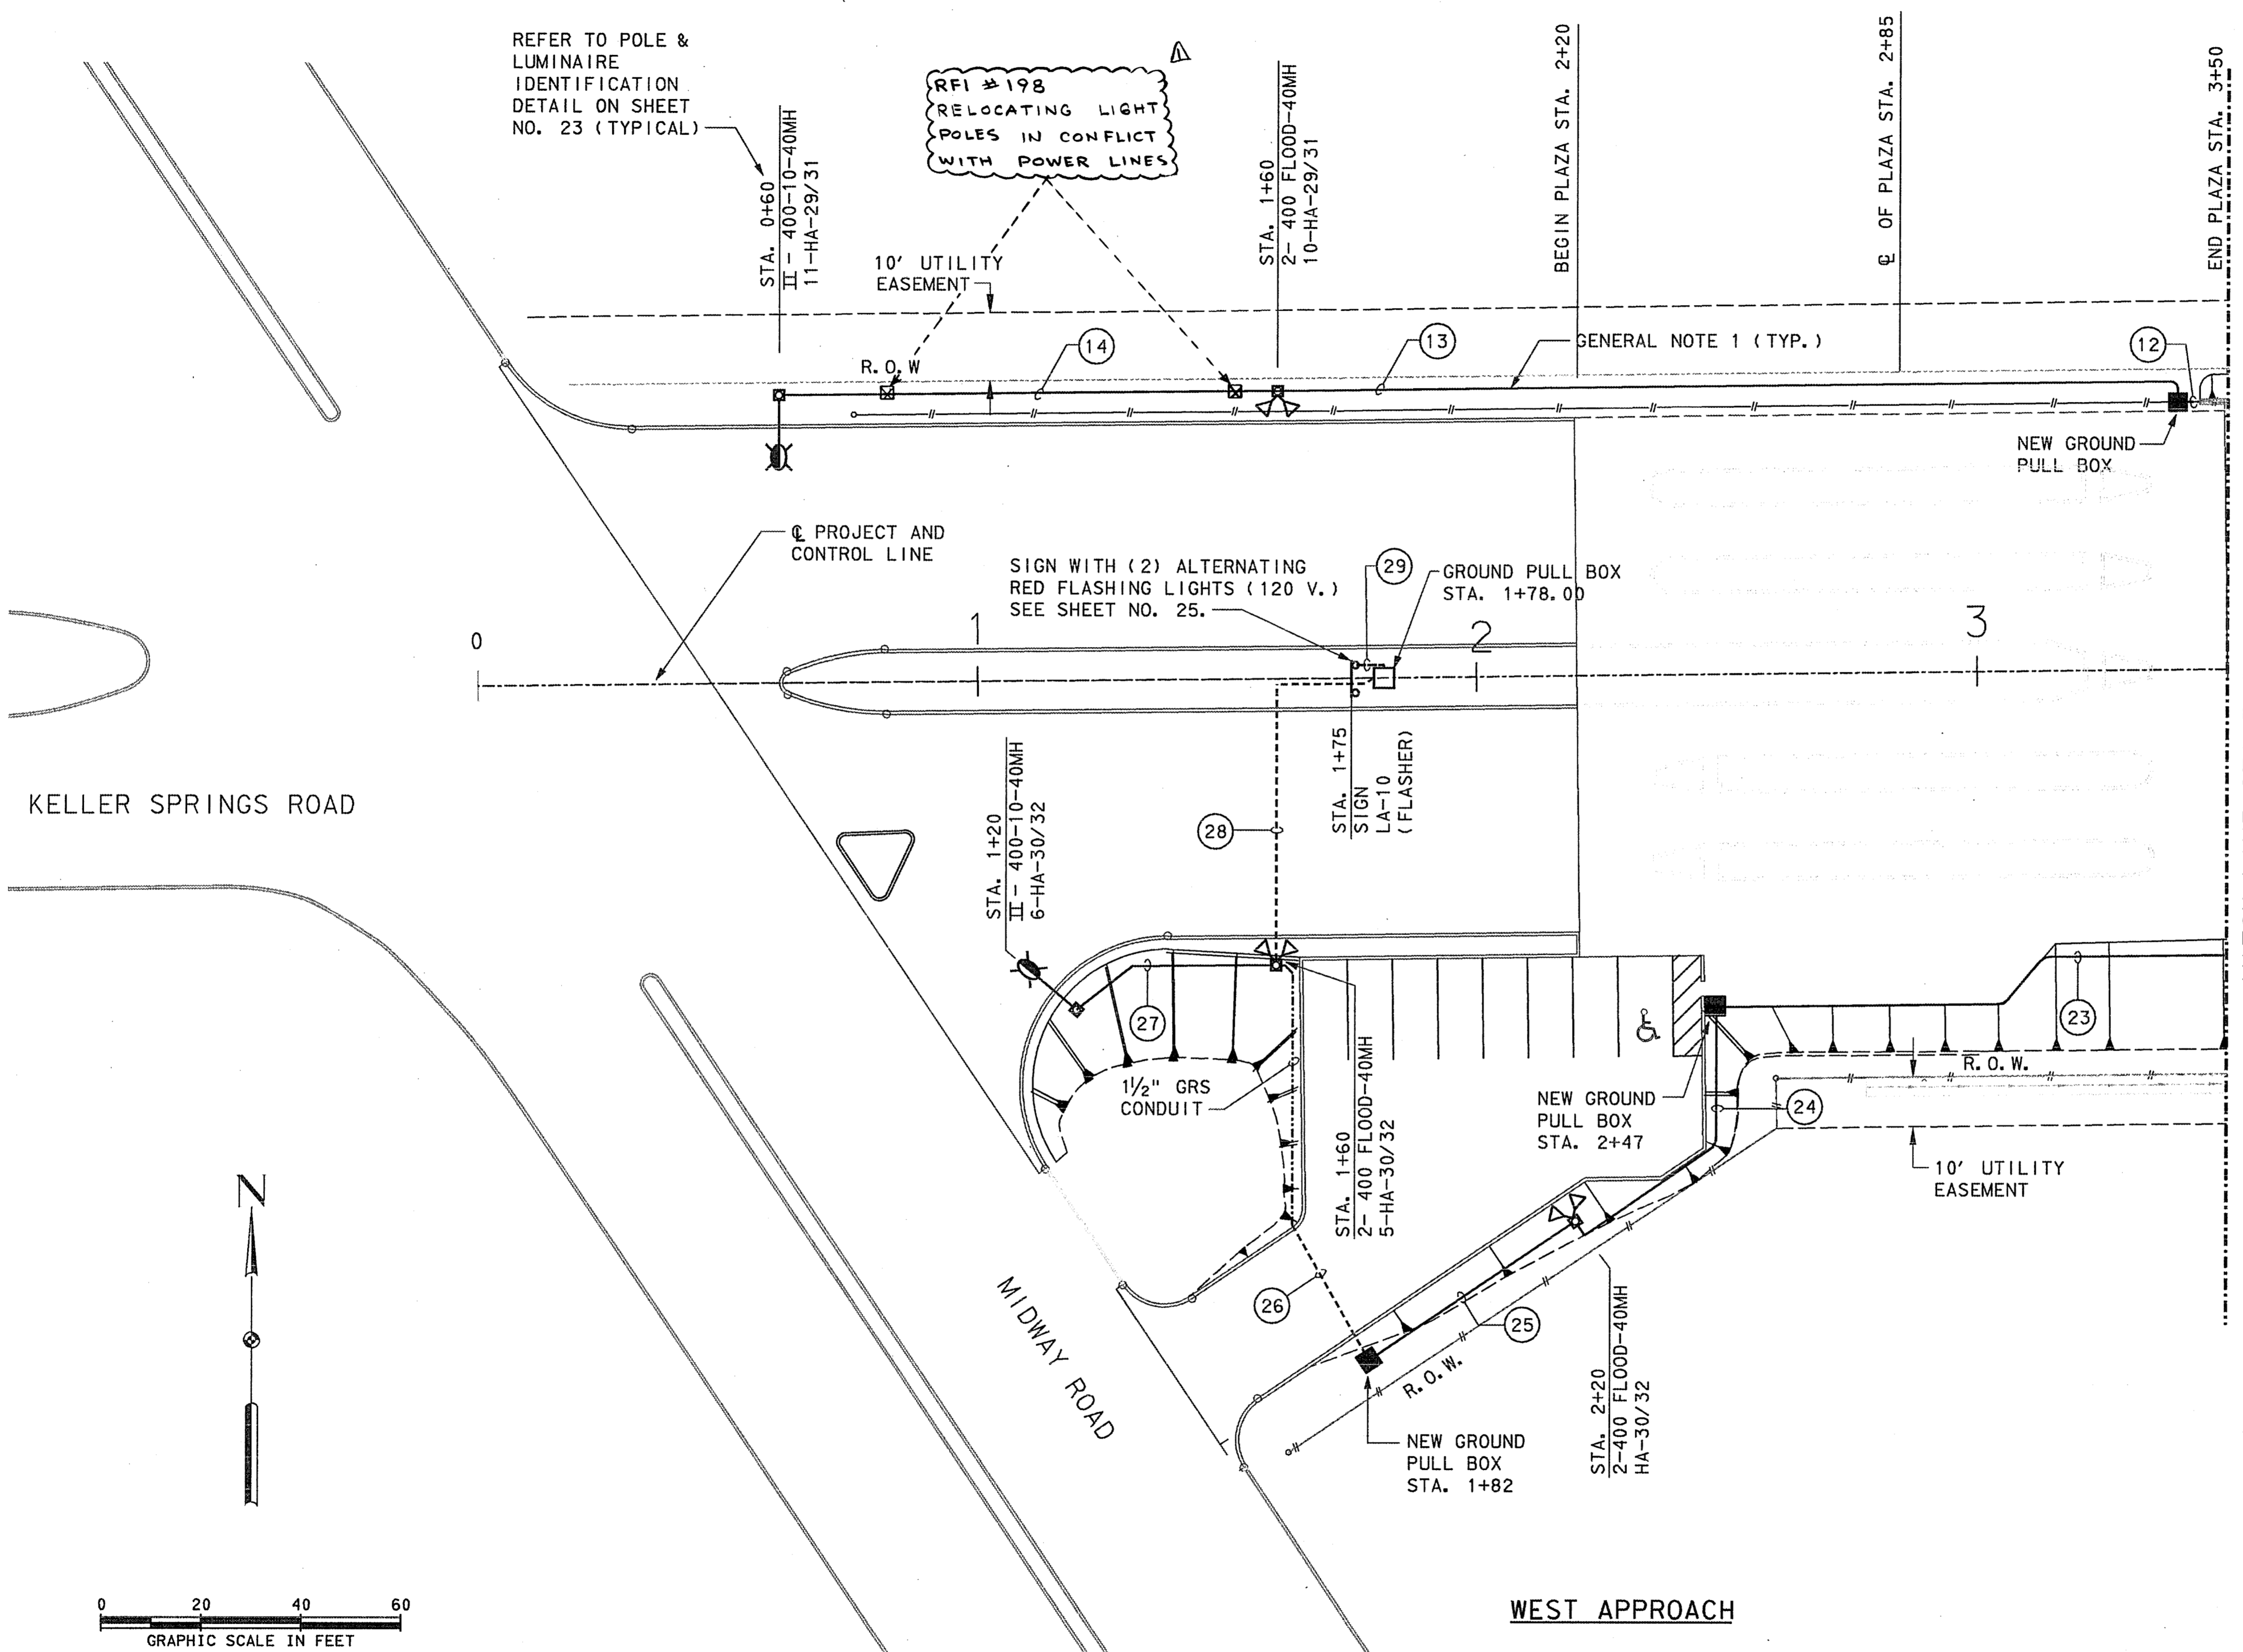

- LEGEND:**
- ROADWAY LIGHTING LUMINAIRE: 400 WATT HIGH PRESSURE SODIUM, TYPE III DISTRIBUTION.
  - ROADWAY LIGHTING LUMINAIRE: 400 WATT HIGH PRESSURE SODIUM, TYPE II DISTRIBUTION.
  - ROADWAY LIGHTING FLOODLIGHTS: NEMA 6X5, 400 WATT HIGH PRESSURE SODIUM, MOUNTED ON POLE TOP BRACKET.
  - WALL-MOUNTED LIGHTING FIXTURE: 150 WATT HIGH PRESSURE SODIUM.
  - W.P. TOGGLE SWITCH.
  - PHOTOCELL.
  - GROUND-MOUNTED LIGHTING UNIT.
  - STRUCTURE-MOUNTED LIGHTING UNIT.
  - GROUND-MOUNTED ROADSIDE SIGN WITH LIGHTS, AS NOTED ON THE PLAN.
  - GROUND-MOUNTED OVERHEAD SIGN WITH LIGHTS, AS NOTED ON THE PLAN.
  - NEW GROUND PULL BOX, SEE SHEET NO. 9.
  - PREVIOUSLY INSTALLED GROUND PULL BOX.
  - PREVIOUSLY INSTALLED EMBEDDED STRUCTURE PULL BOX.
  - PREVIOUSLY INSTALLED CONDUIT.
  - DUCT-CABLE WITH INSULATED AND ONE BARE CONDUCTOR, SIZE AS SHOWN ON THE PLAN.
  - NEW UNDERGROUND CONDUIT, SIZE AS SHOWN ON THE PLAN.
  - CONDUIT AND CONDUCTOR RUNS NUMBER, REFER TO SHEET NO. 4, QUANTITY/ITEMS SUMMARIES.



- GENERAL NOTES**
1. COORDINATE DUCT-CABLE AND CONDUIT INSTALLATION WITH CIVIL CONSTRUCTION ELEMENTS—UNDERDRAINS, CONCRETE GUTTERS, FENCES, ETC.

THE SEAL APPEARING ON THIS DOCUMENT WAS AUTHORIZED BY RICHARD J. MILLER, P.E. NO. 42812 ON JANUARY 12, 1999. ALTERATION OF A SEALED DOCUMENT WITHOUT PRIOR NOTIFICATION TO THE RESPONSIBLE ENGINEER IS AN OFFENSE UNDER THE TEXAS ENGINEERING PRACTICE ACT.

**FINAL RECORD DRAWING**  
Date: 12/25/99




REVISED PER RFI #198			
No.	REVISION	BY	DATE
NORTH TEXAS TOLLWAY AUTHORITY ADDISON AIRPORT TUNNEL			
ROADWAY ILLUMINATION LAYOUT STA. 0+00 TO STA. 3+50			
MATED CONSULTING ENGINEERS, INC. 5500 PETERSON LANE SUITE 225 DALLAS, TEXAS 75240 (972) 233-8700			SECTION XIII
DRAWN: SAA	DATE: 5/97	DESIGNED: DR	DATE: 5/97
CHECKED: RJM	DATE: 5/97	SCALE: 1"=20'	
CONTRACT No. DNT-260 SHEET 18 OF 52			

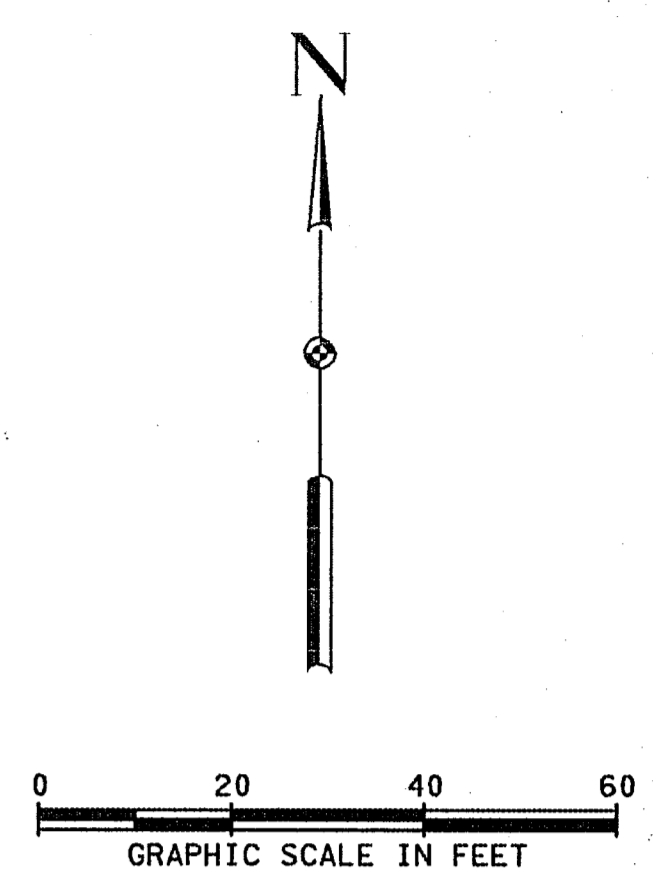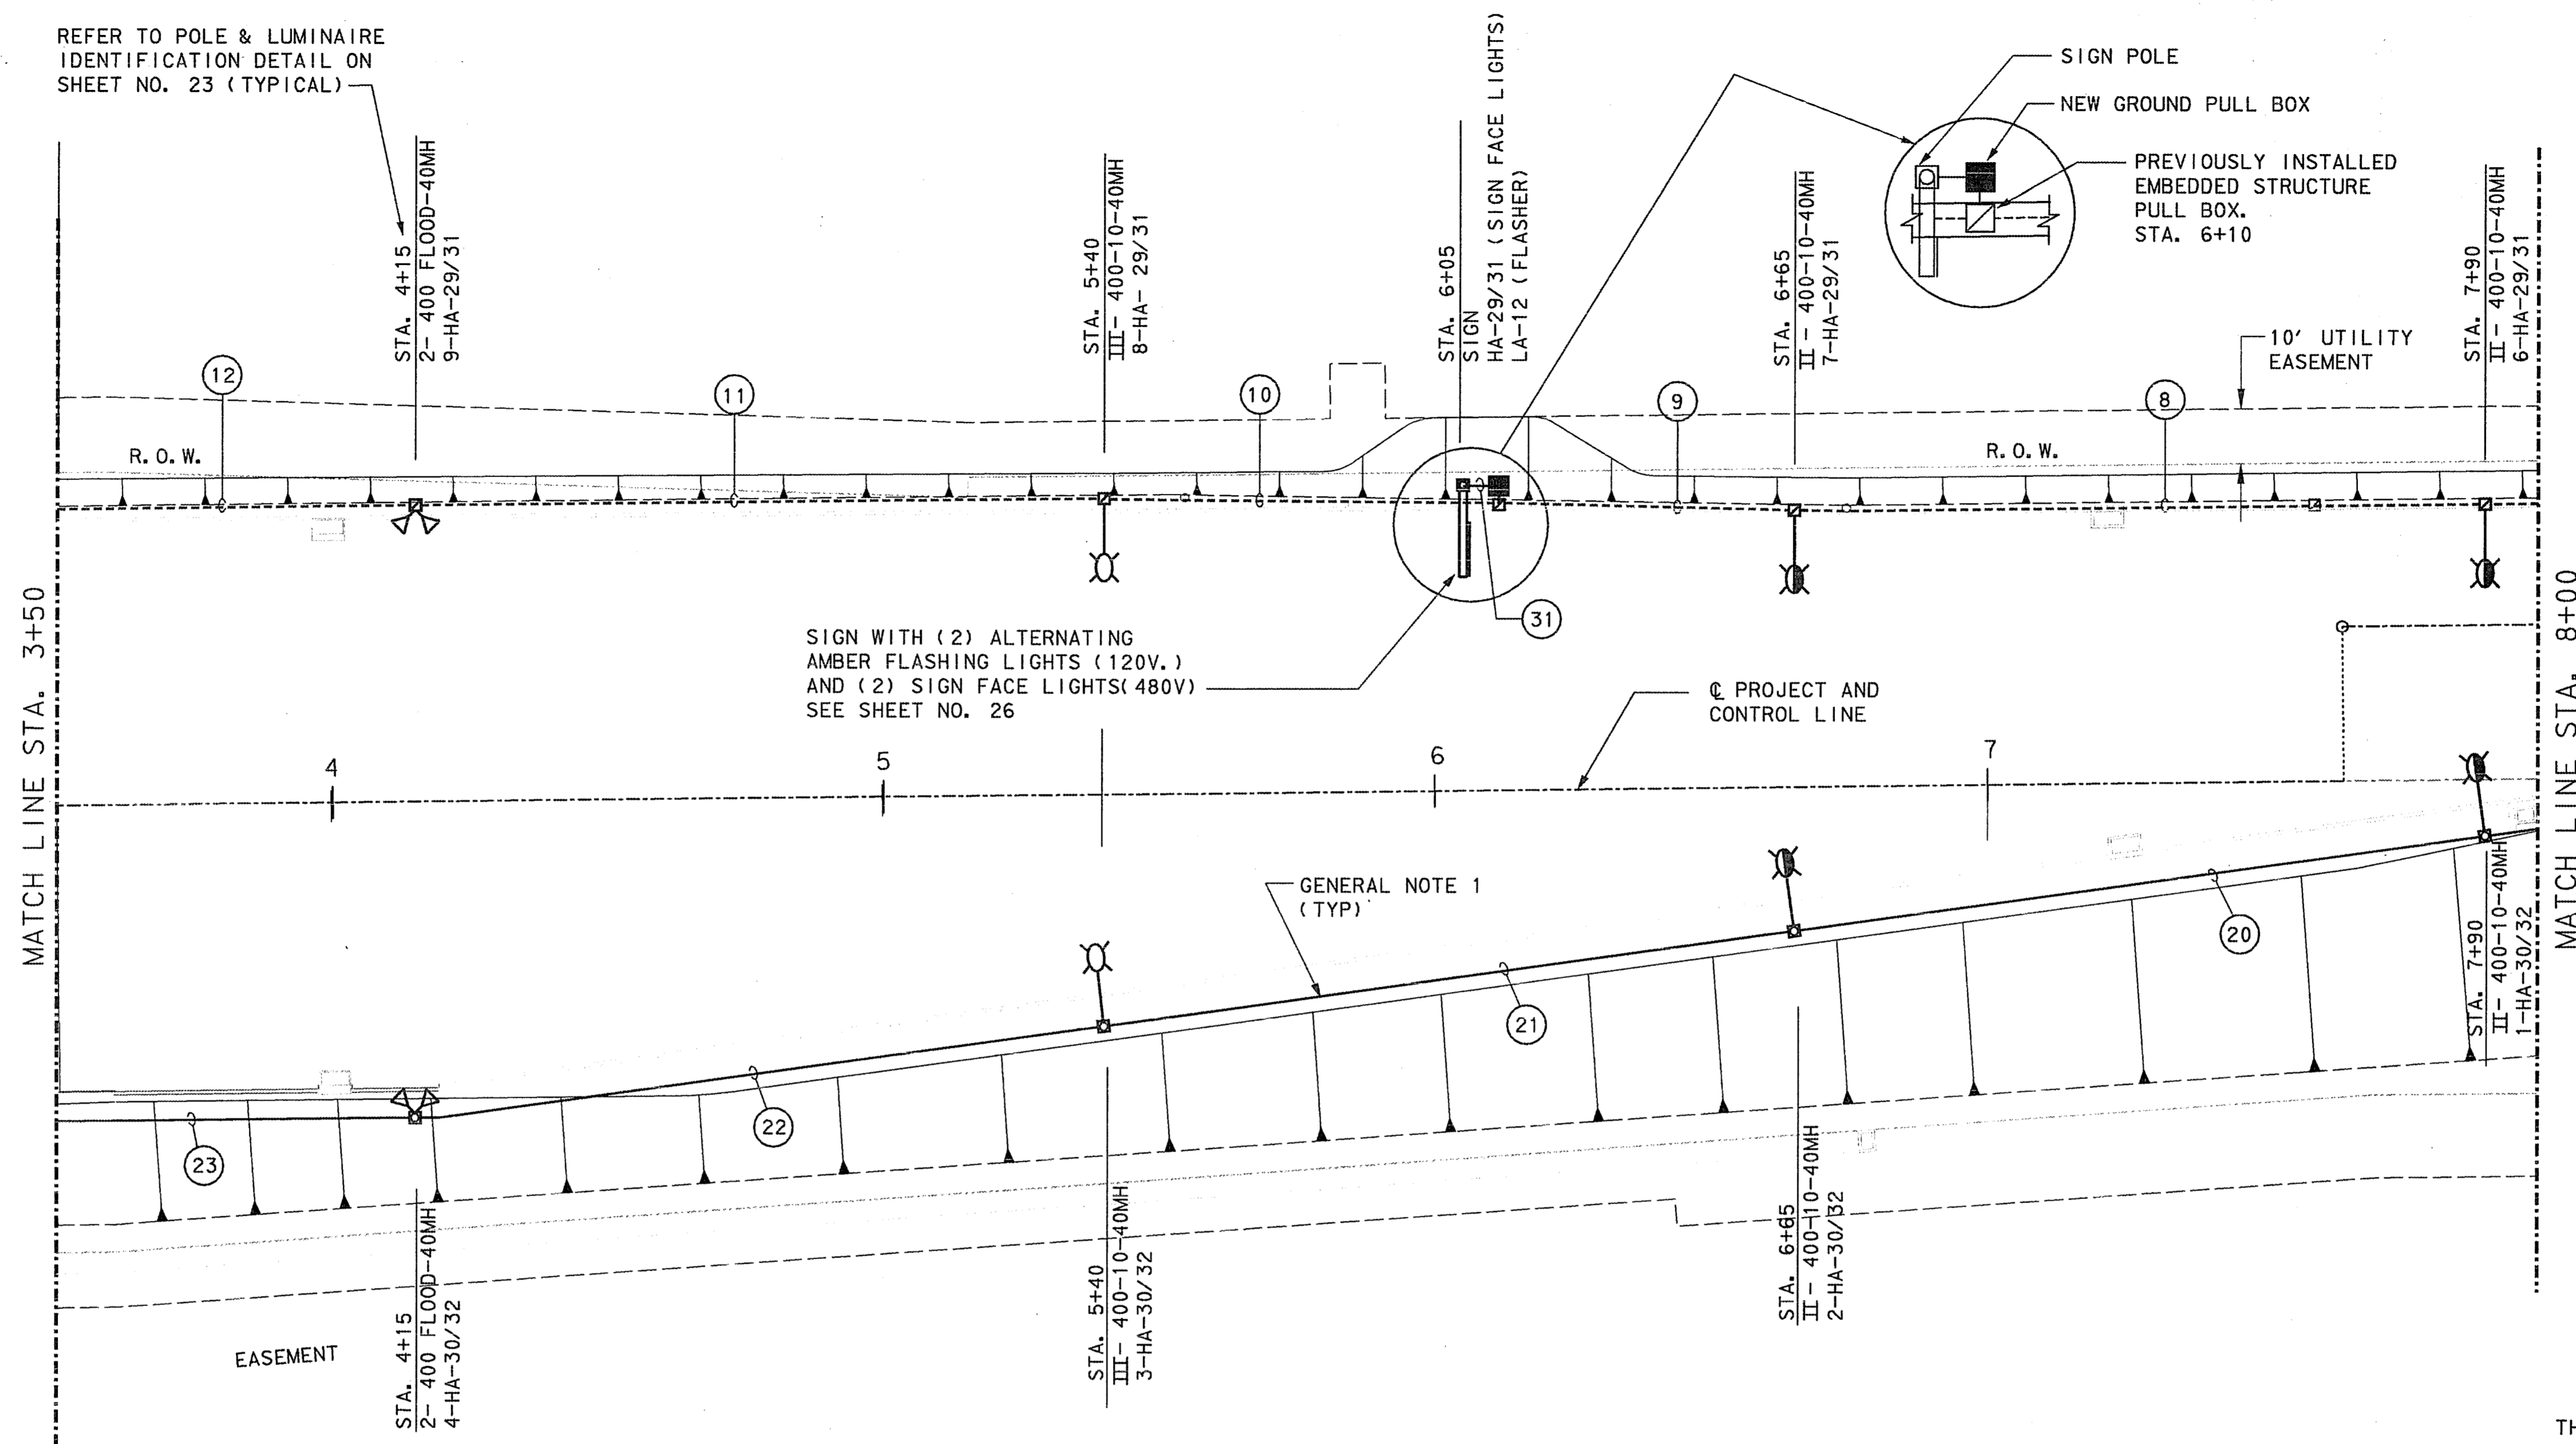

NOTES:  
 1. SEE SHEET NO. 18 FOR GENERAL NOTES AND LEGEND.


WEST APPROACH

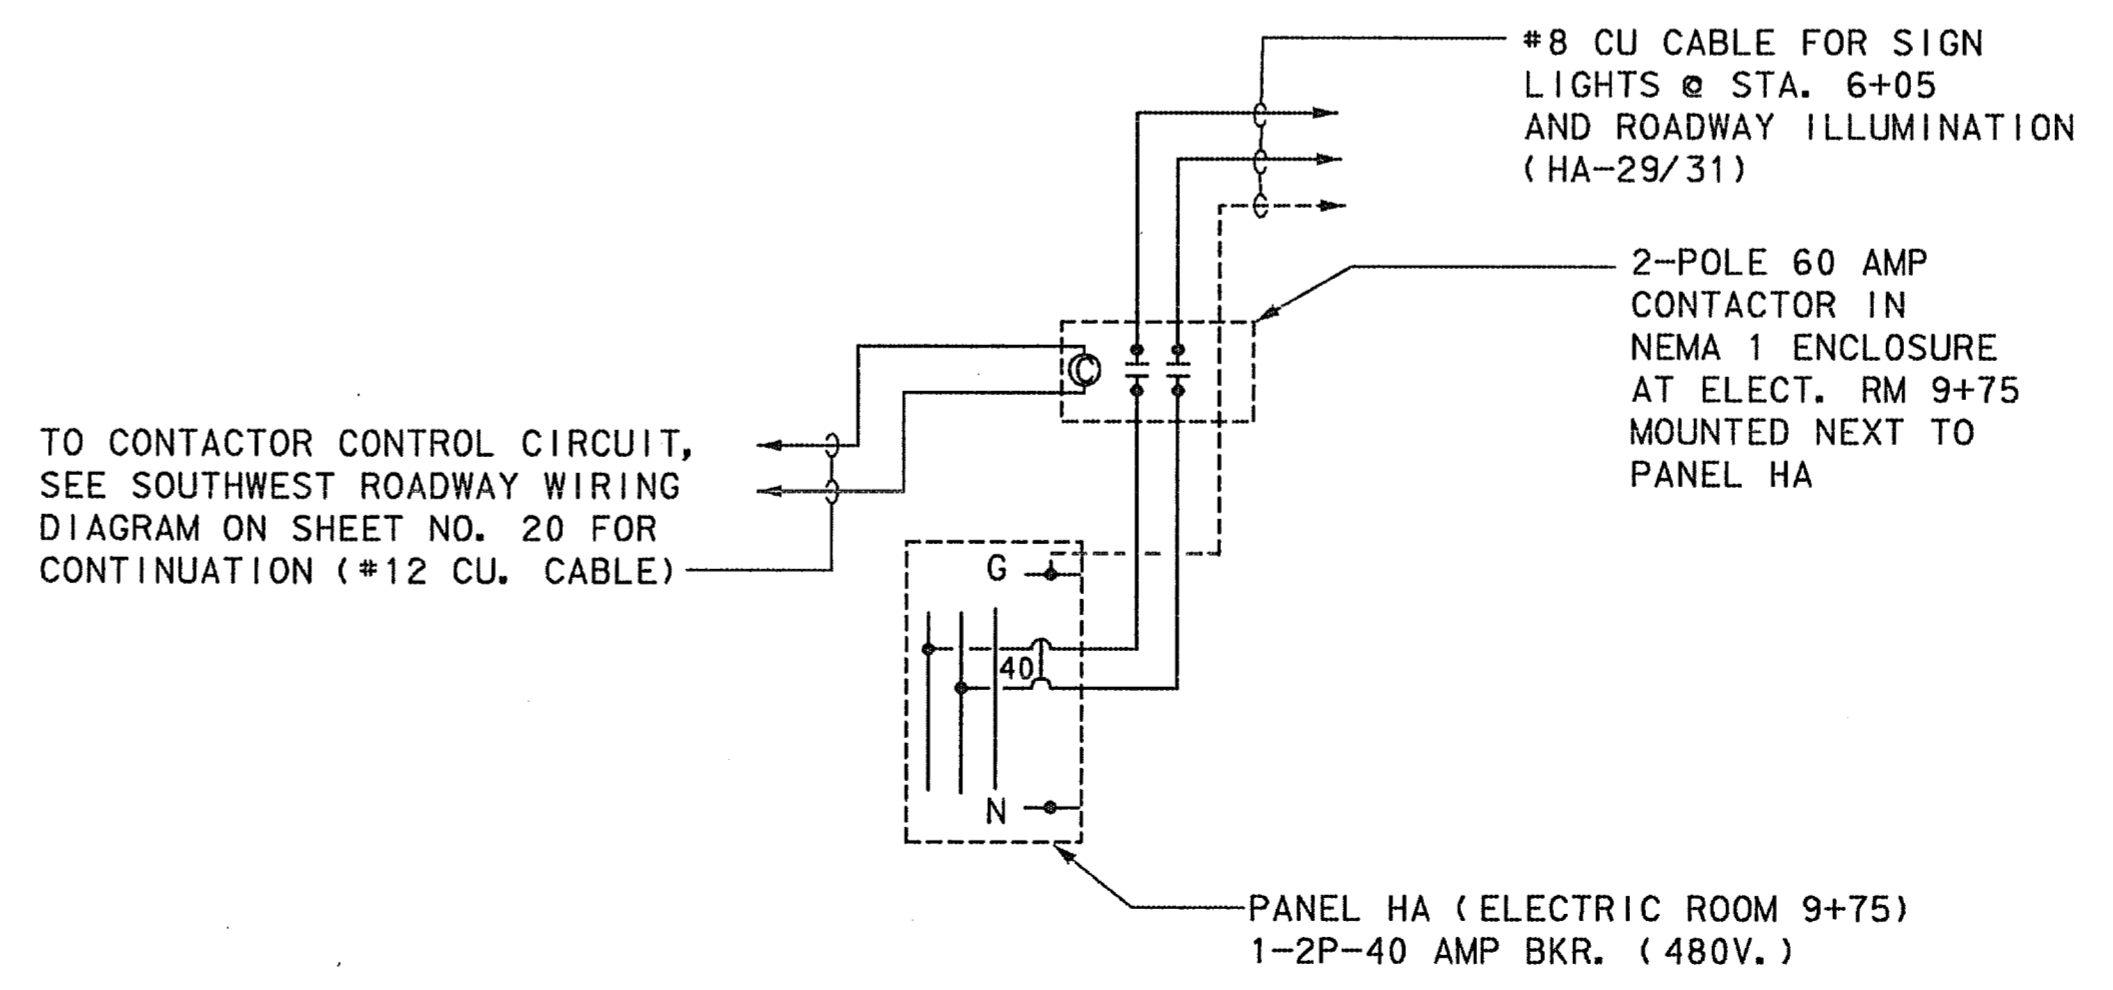


NORTHWEST ROADWAY - TYPICAL ILLUMINATION WIRING DIAGRAM  
 N. T. S.

THE SEAL APPEARING ON THIS DOCUMENT WAS AUTHORIZED BY RICHARD J. MILLER, P.E. NO. 42812 ON JANUARY 12, 1999. ALTERATION OF A SEALED DOCUMENT WITHOUT PRIOR NOTIFICATION TO THE RESPONSIBLE ENGINEER IS AN OFFENSE UNDER THE TEXAS ENGINEERING PRACTICE ACT.





FINAL RECORD DRAWING  
 Date: 12/25/99

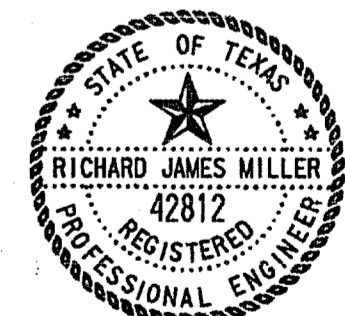

No.	REVISION	BY	DATE
NORTH TEXAS TOLLWAY AUTHORITY ADDISON AIRPORT TUNNEL			
ROADWAY ILLUMINATION LAYOUT STA. 3+50 TO STA. 8+00			
<b>MCE</b> MATED CONSULTING ENGINEERS, INC. <small>5560 PETERSON LANE, SUITE 225          DALLAS, TEXAS 75240 (972) 233-6700</small>			SECTION XIII.
DRAWN: SAA	DATE: 5/97	DESIGNED: DR	DATE: 5/97
CHECKED: RJM	DATE: 5/97	SCALE: 1"=20'	
CONTRACT No. DNT-260 SHEET 19 OF 52			

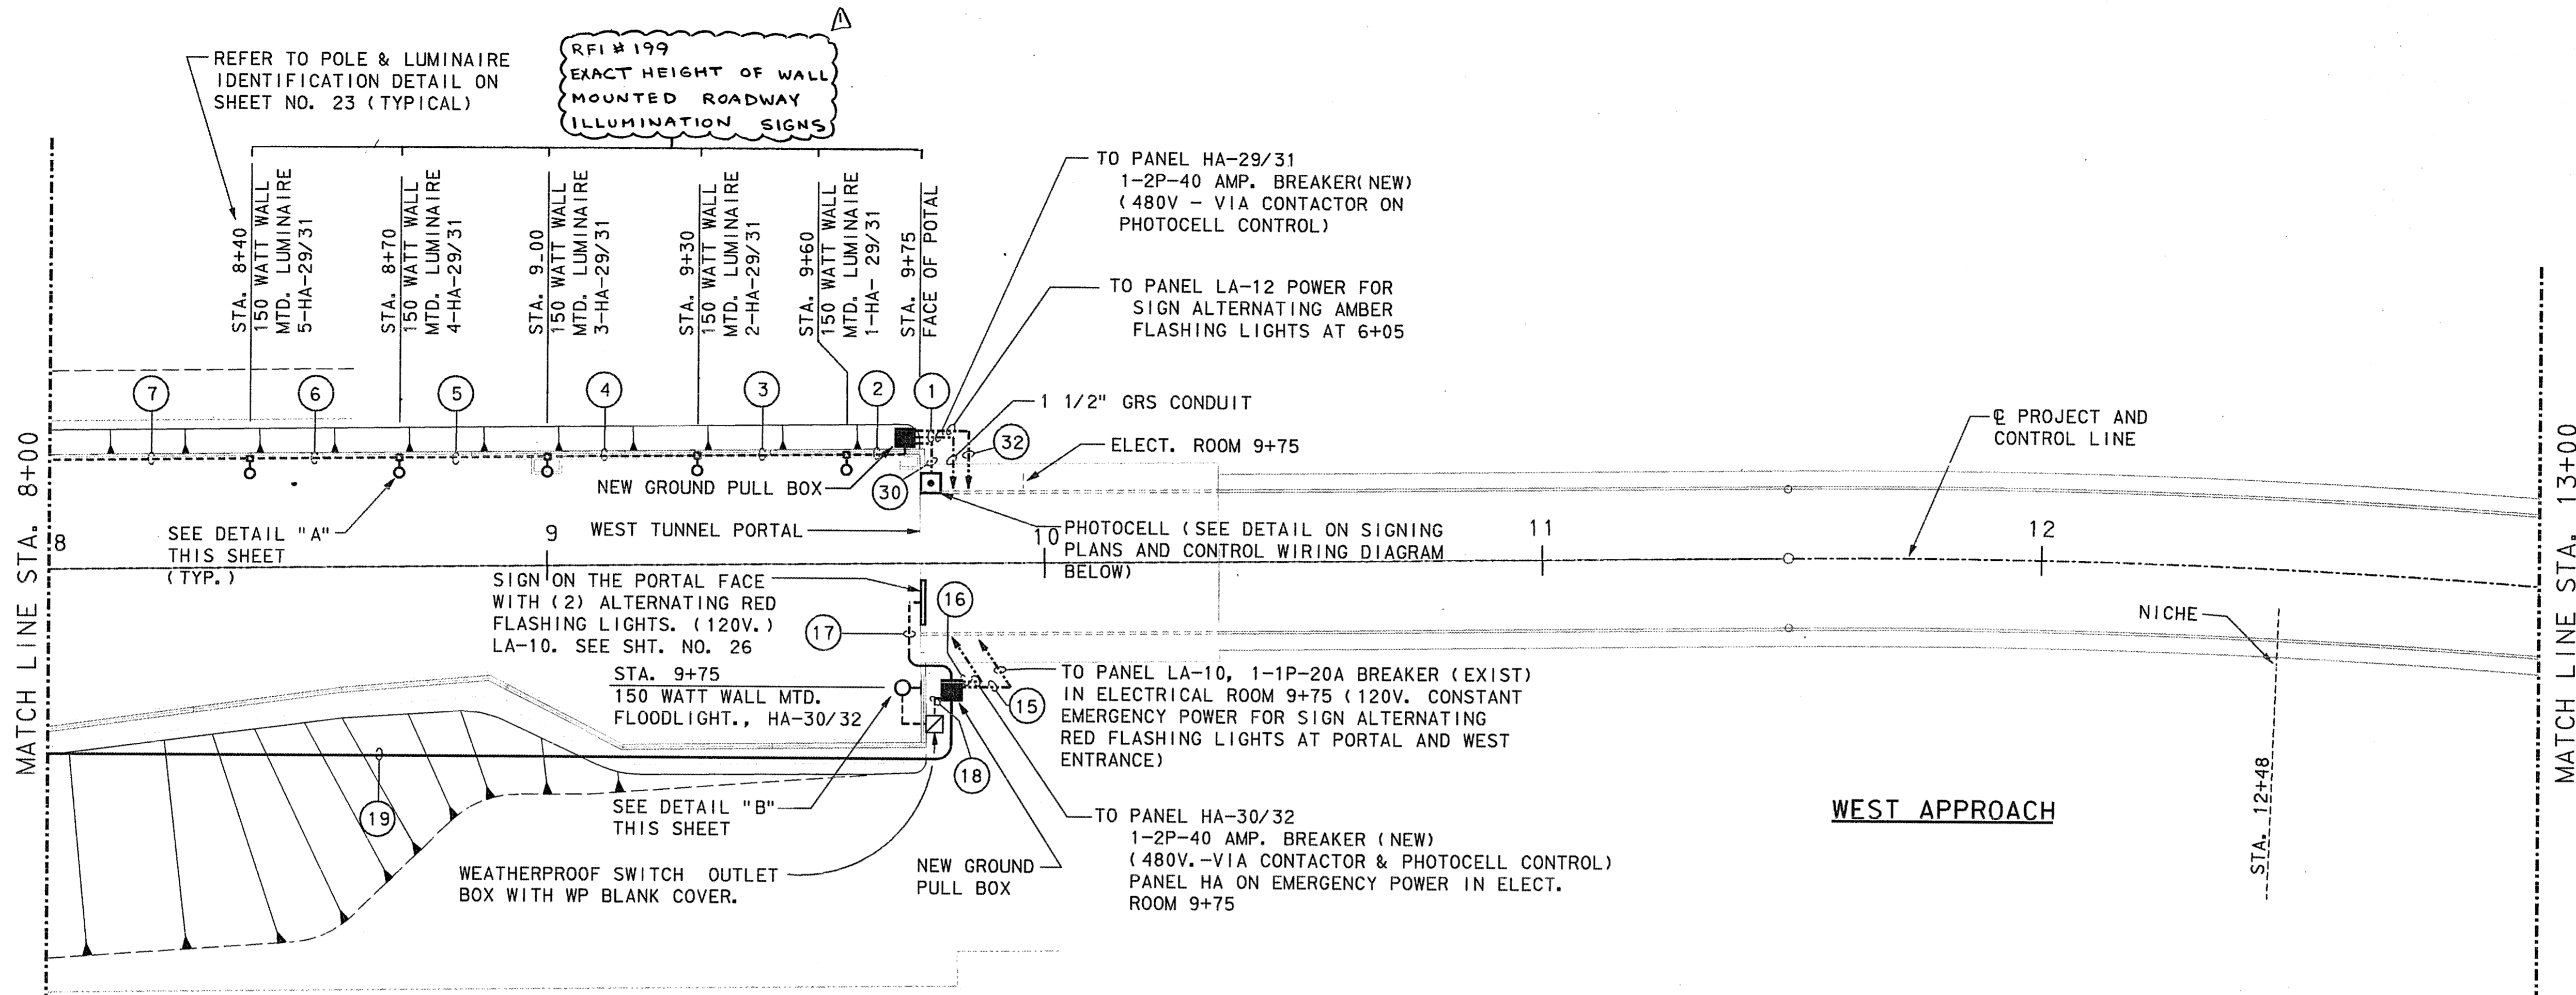

NOTE:  
SEE SHEET NO. 18 FOR GENERAL NOTES AND LEGEND.

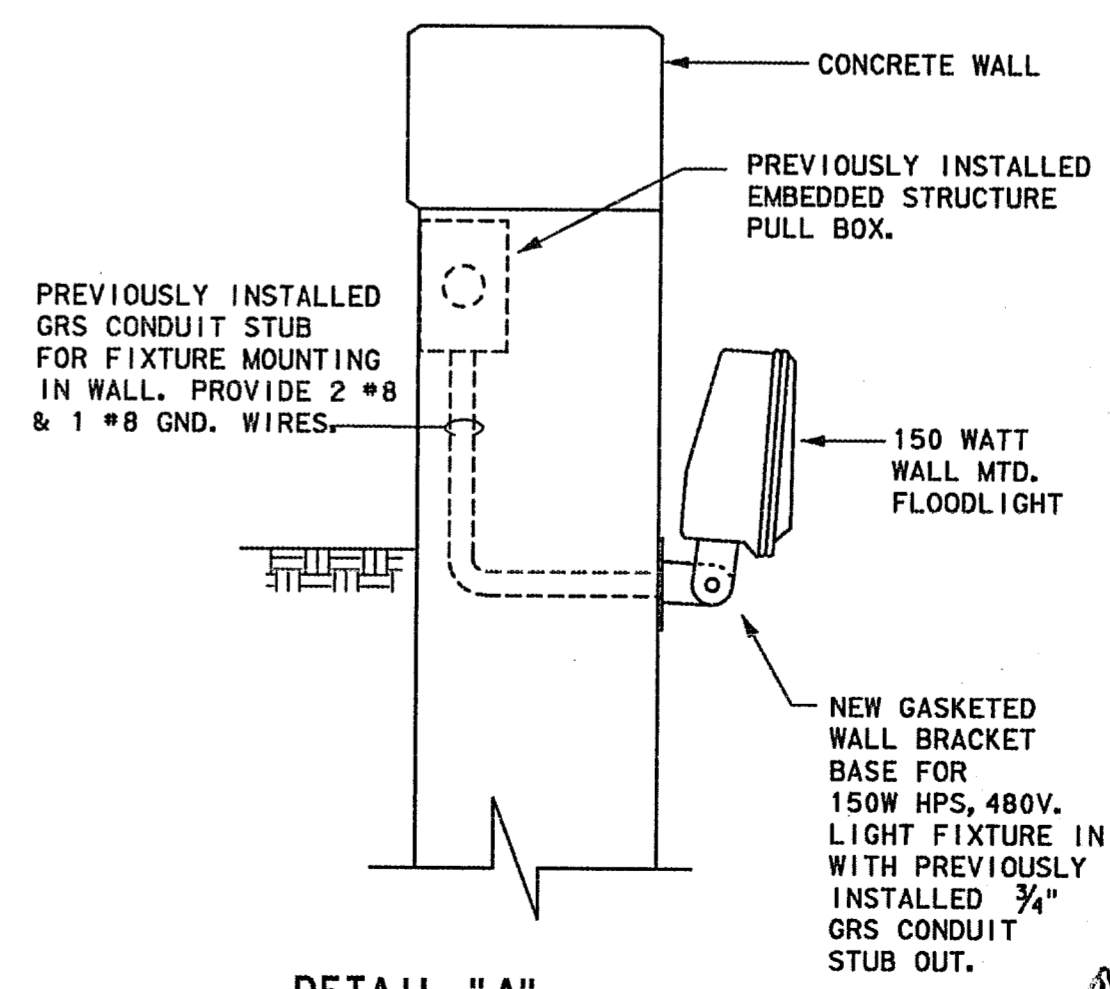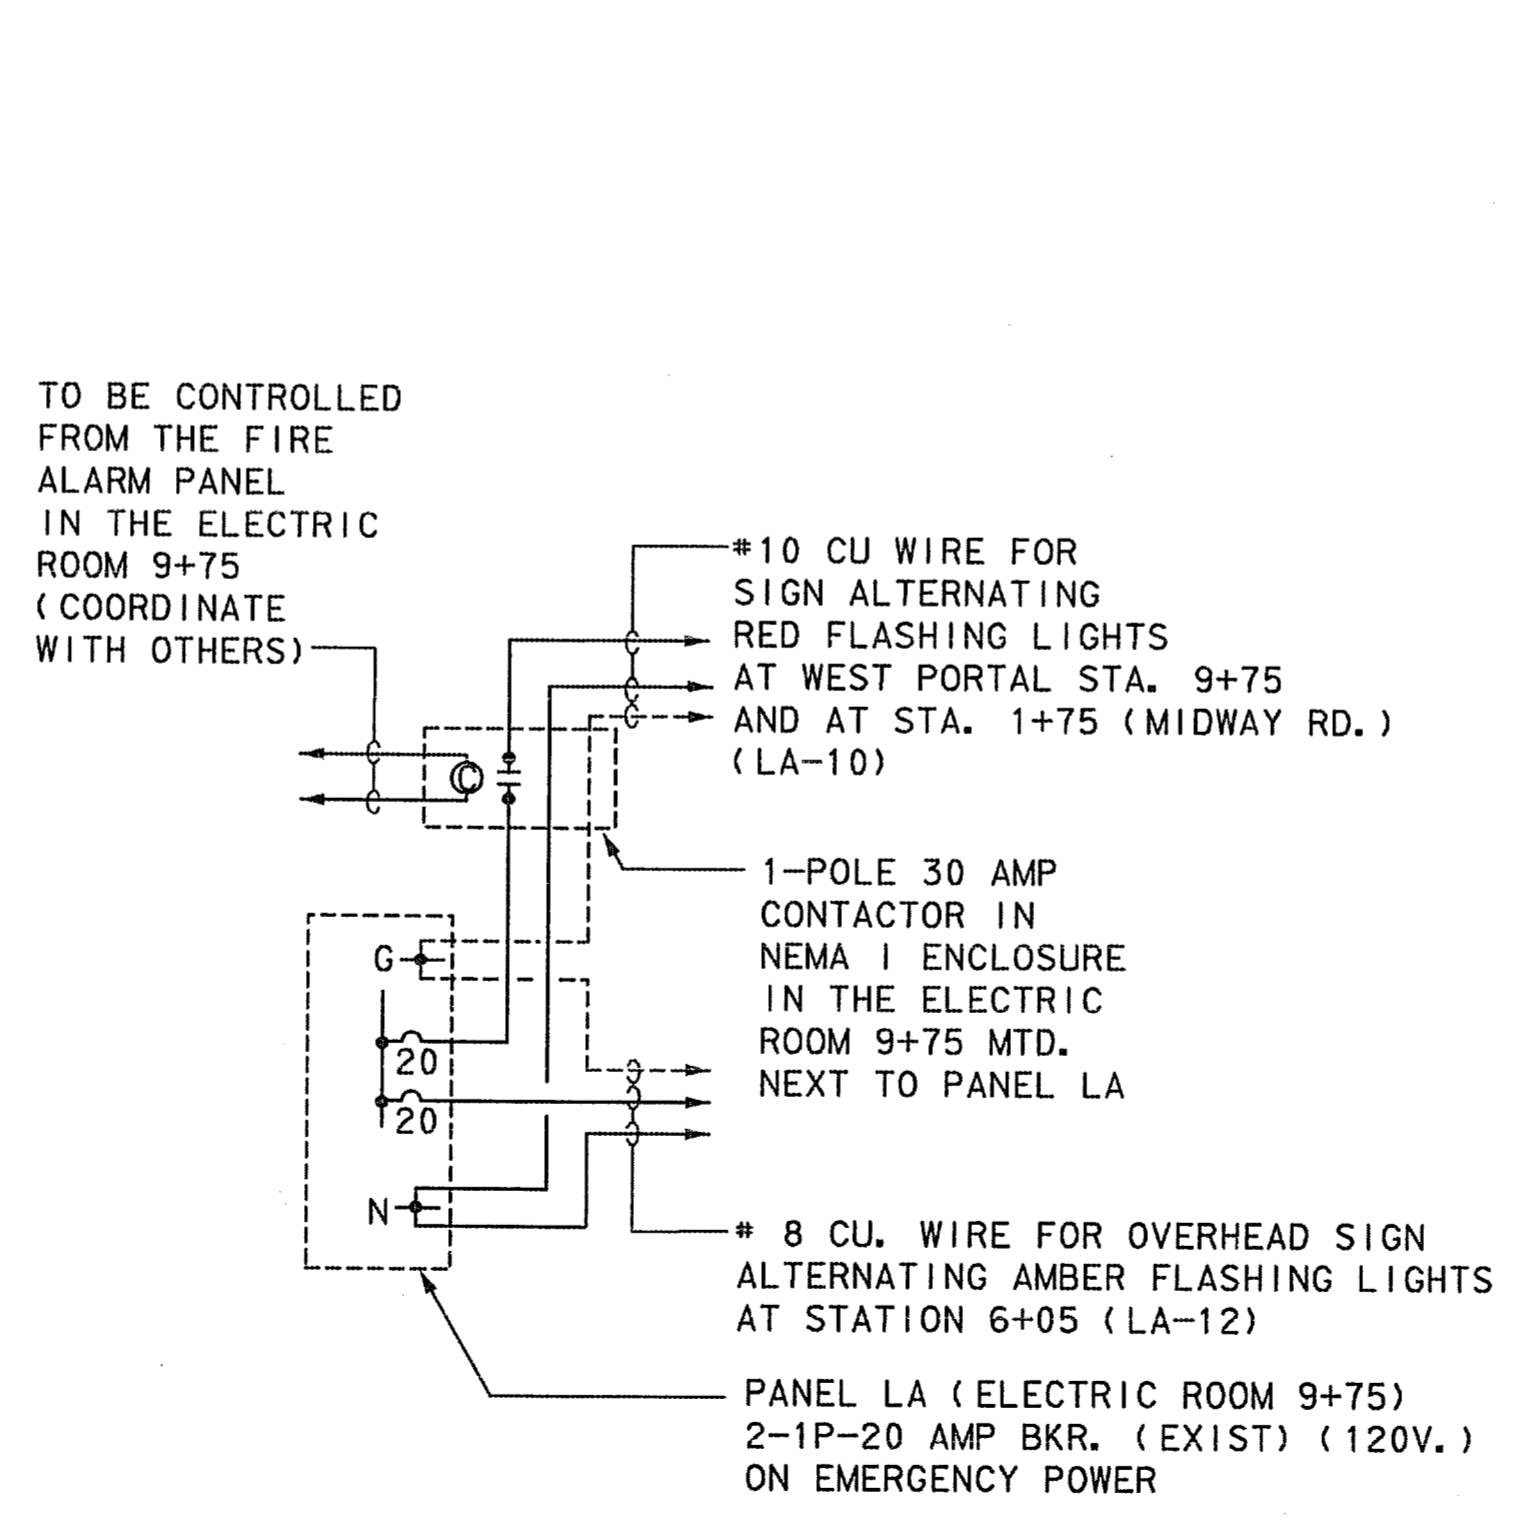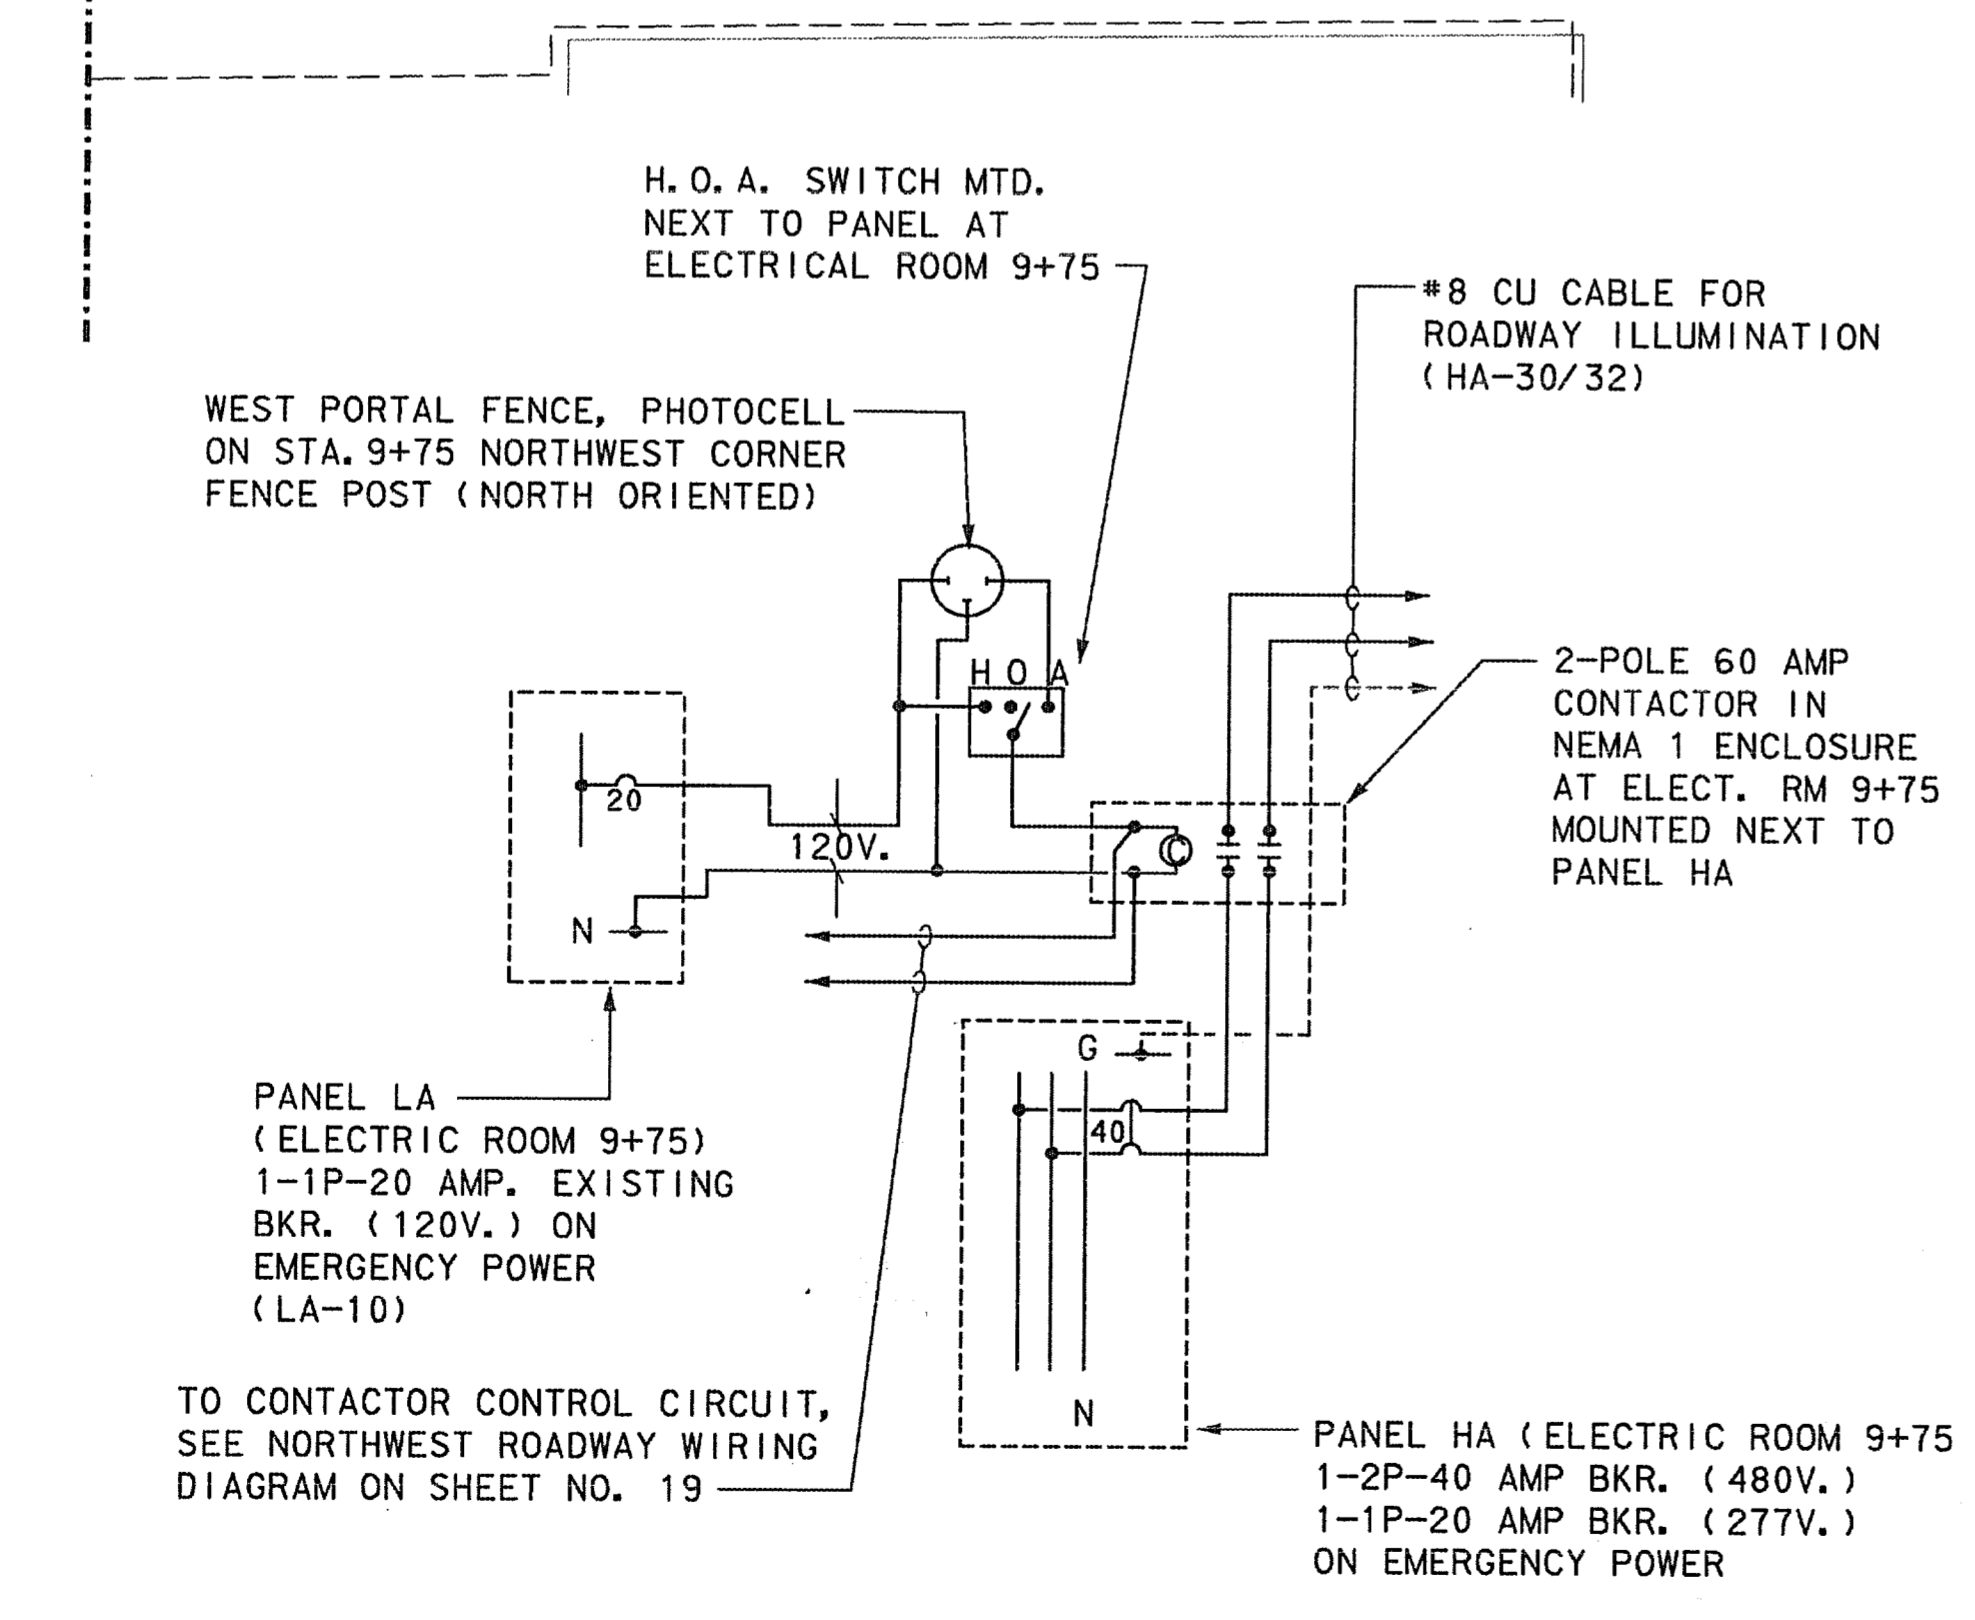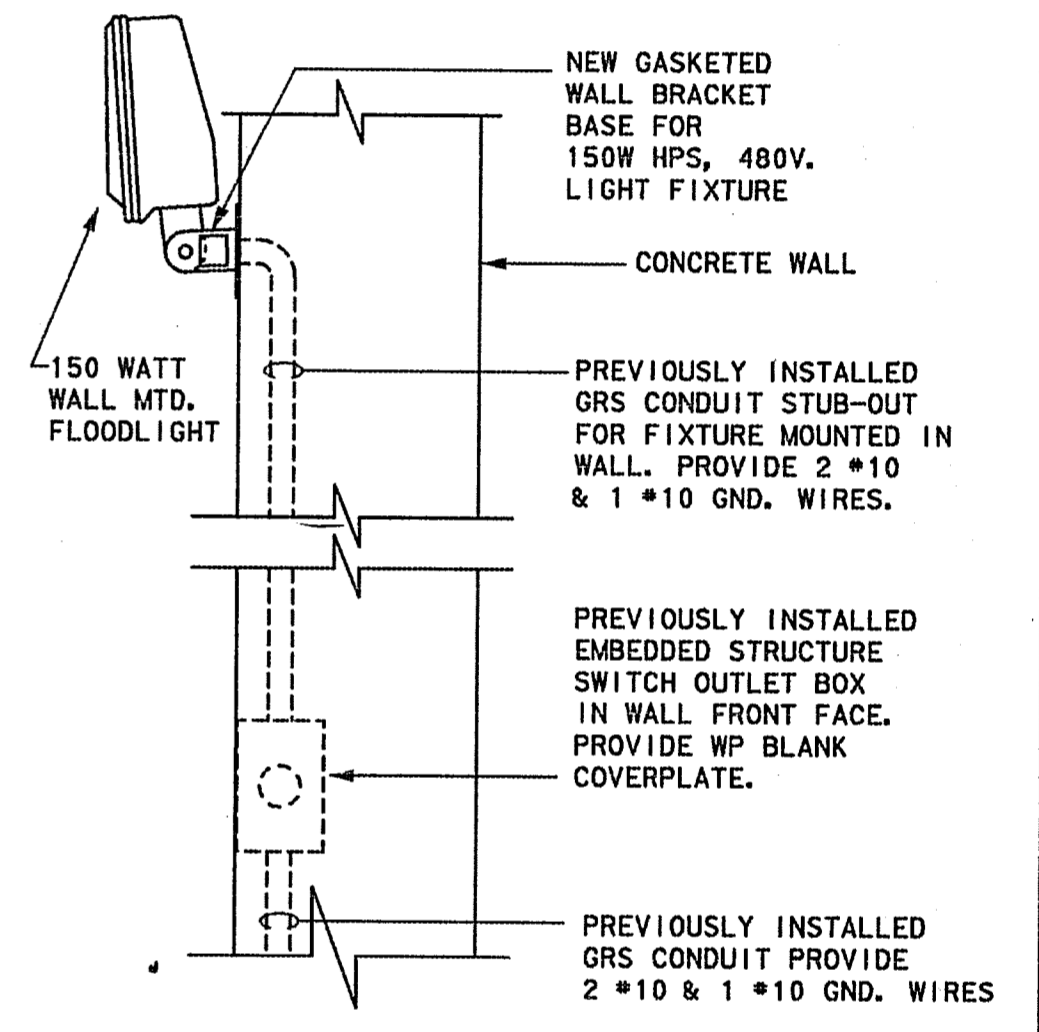


THE SEAL APPEARING ON THIS DOCUMENT WAS AUTHORIZED BY RICHARD J. MILLER, P.E. NO. 42812 ON JANUARY 12, 1999. ALTERATION OF A SEALED DOCUMENT WITHOUT PRIOR NOTIFICATION TO THE RESPONSIBLE ENGINEER IS AN OFFENSE UNDER THE TEXAS ENGINEERING PRACTICE ACT.

FINAL RECORD  
DRAWING  
Date: 12/25/99




REVISION PER RFI # 199			
No.	REVISION	BY	DATE
NORTH TEXAS TOLLWAY AUTHORITY ADDISON AIRPORT TUNNEL			
ROADWAY ILLUMINATION LAYOUT STA. 8+00 TO STA. 13+00			
MCE MATED CONSULTING ENGINEERS, INC. 3500 PETERSON LANE SUITE 225 DALLAS, TEXAS 75240 (972) 233-6700		SECTION XIII	
DRAWN: SAA	DATE: 5/97	DESIGNED: DR	DATE: 5/97
CHECKED: RJM	DATE: 5/97	SCALE: 1"=20'	
CONTRACT No. DNT-260 SHEET 20 OF 52			


RFI # 199  
EXACT HEIGHT OF WALL  
MOUNTED ROADWAY  
ILLUMINATION SIGNS

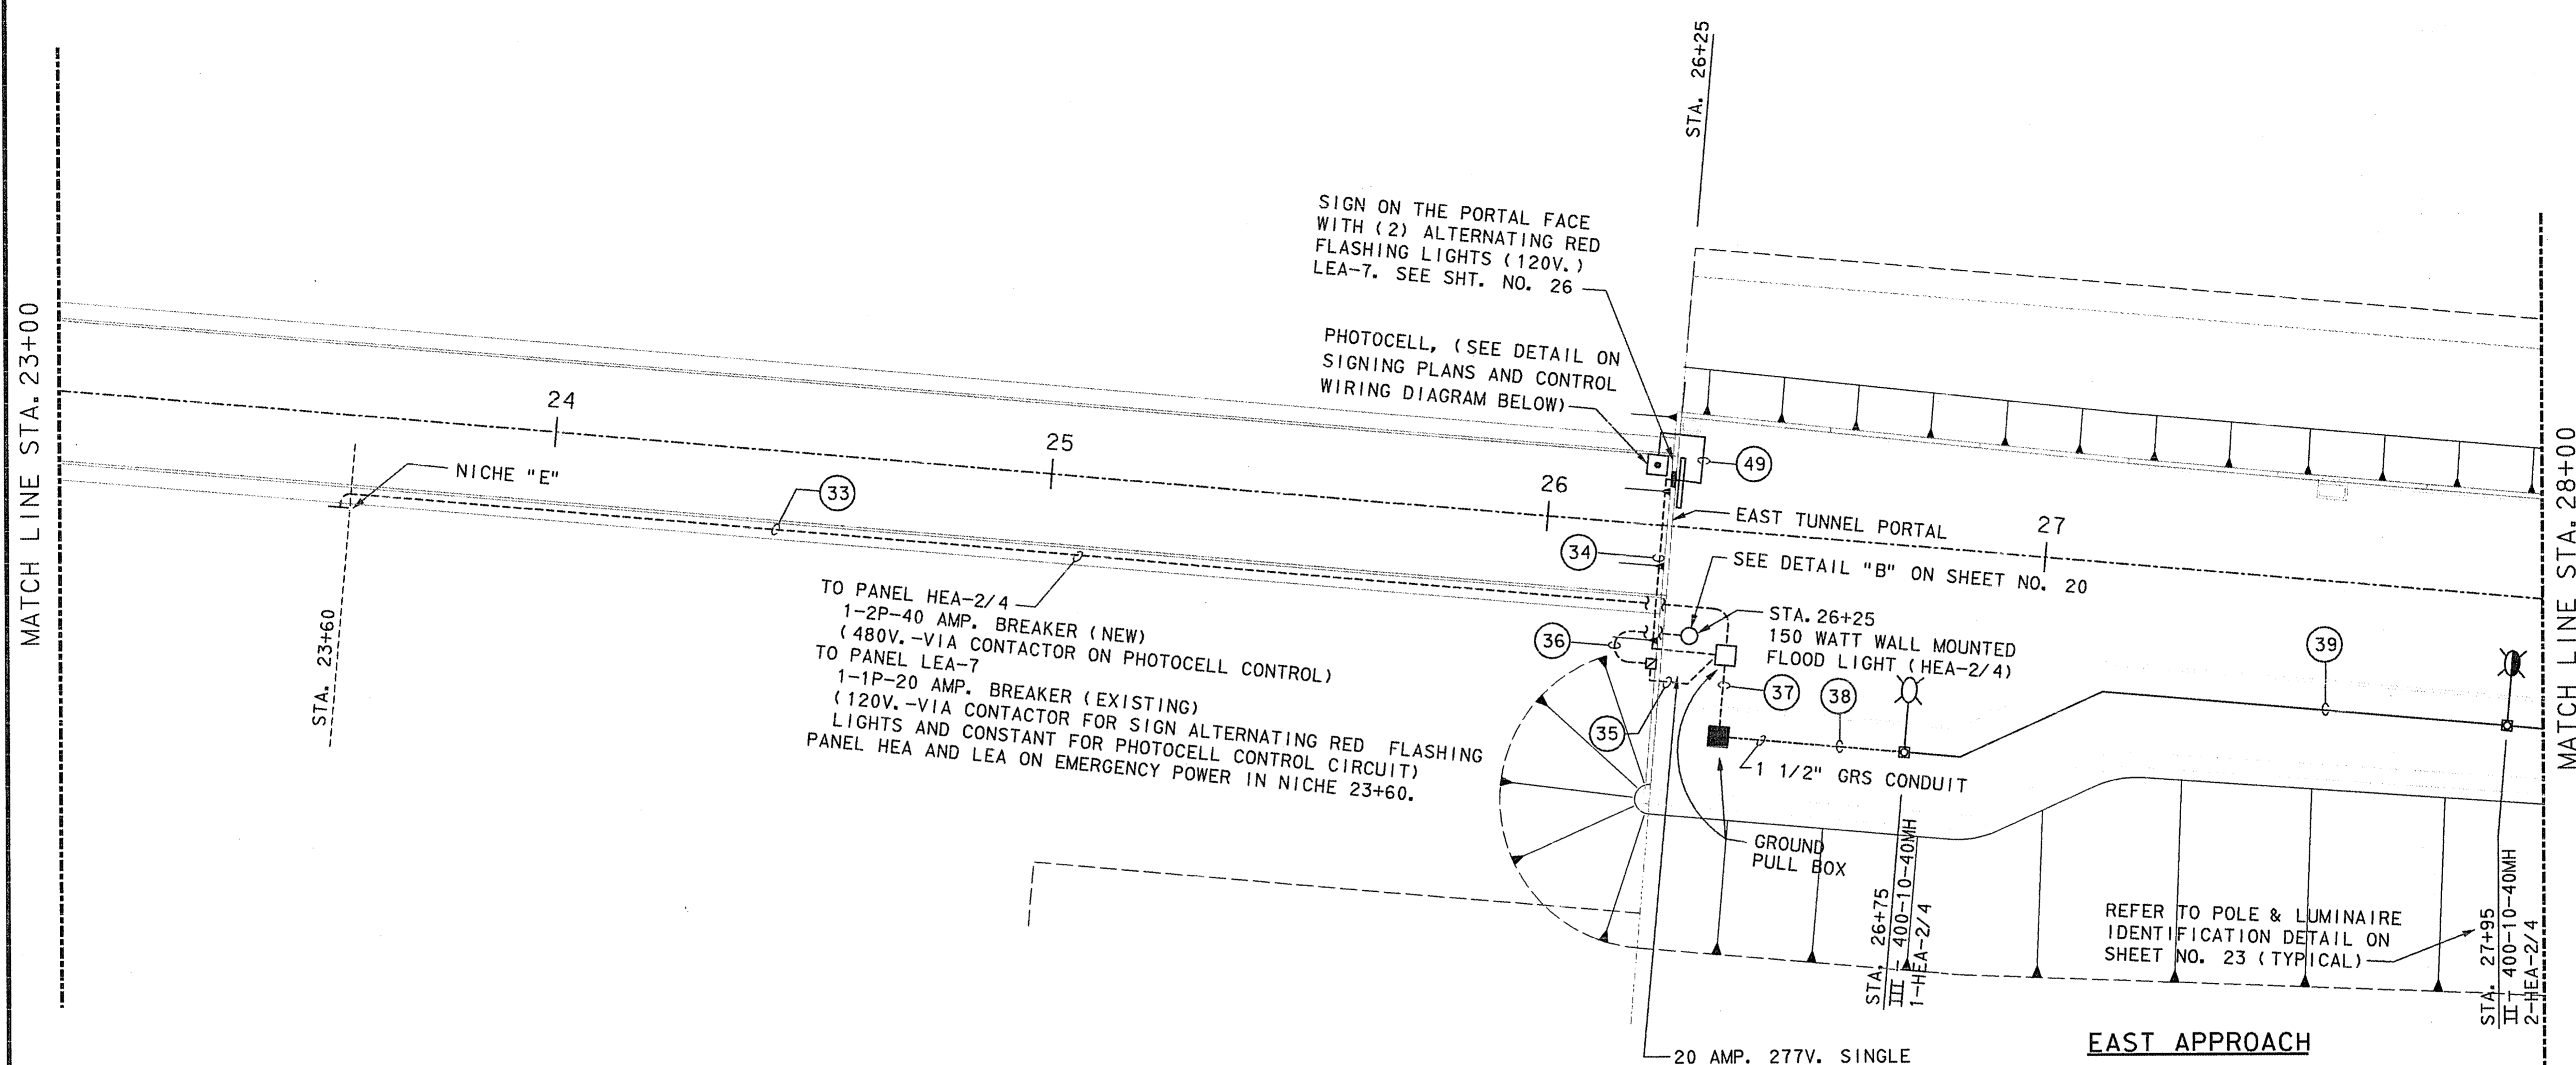


**NOTE:**  
1. SEE SHEET NO. 18 FOR GENERAL NOTES AND LEGEND.

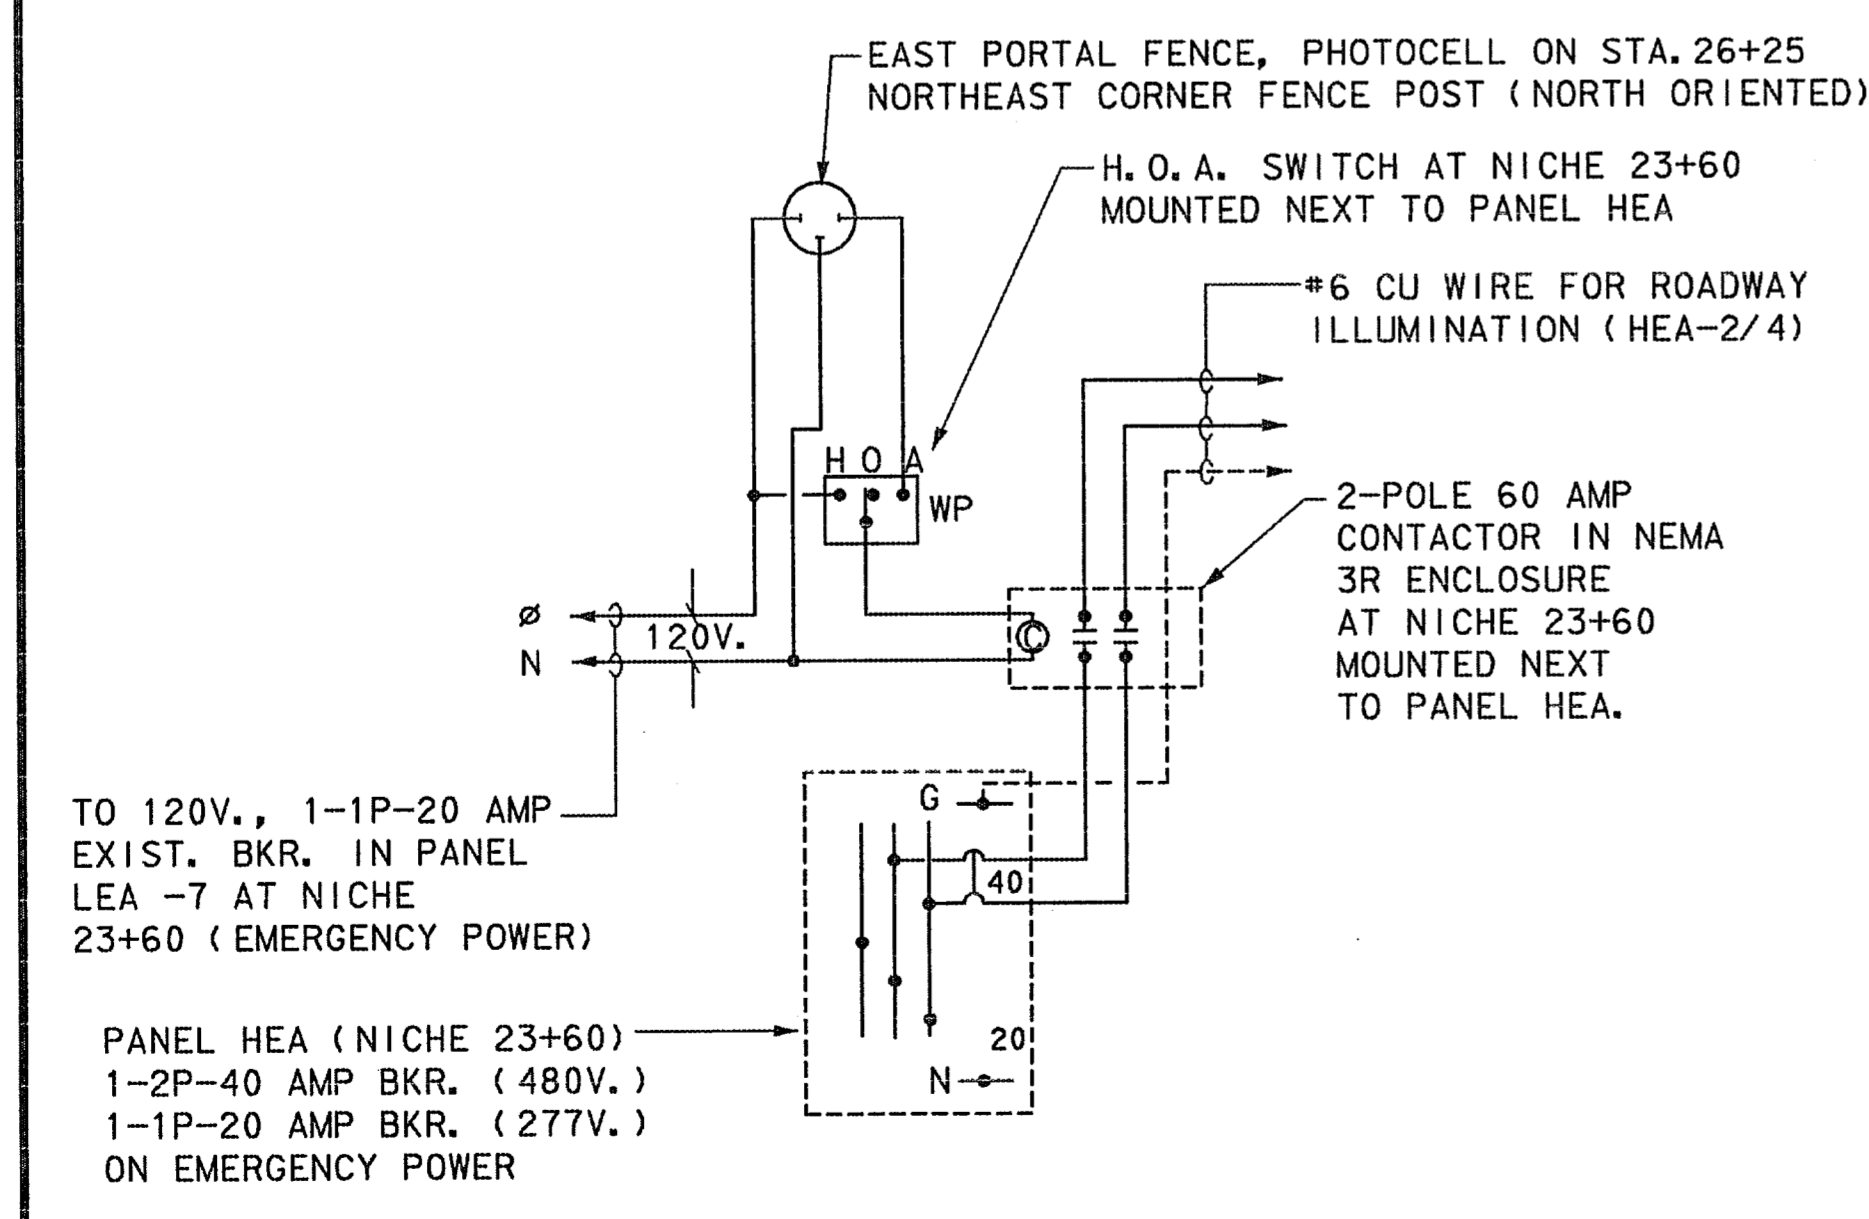

**EAST ROADWAY-TYPICAL ILLUMINATION WIRING DIAGRAM**  
N. T. S.

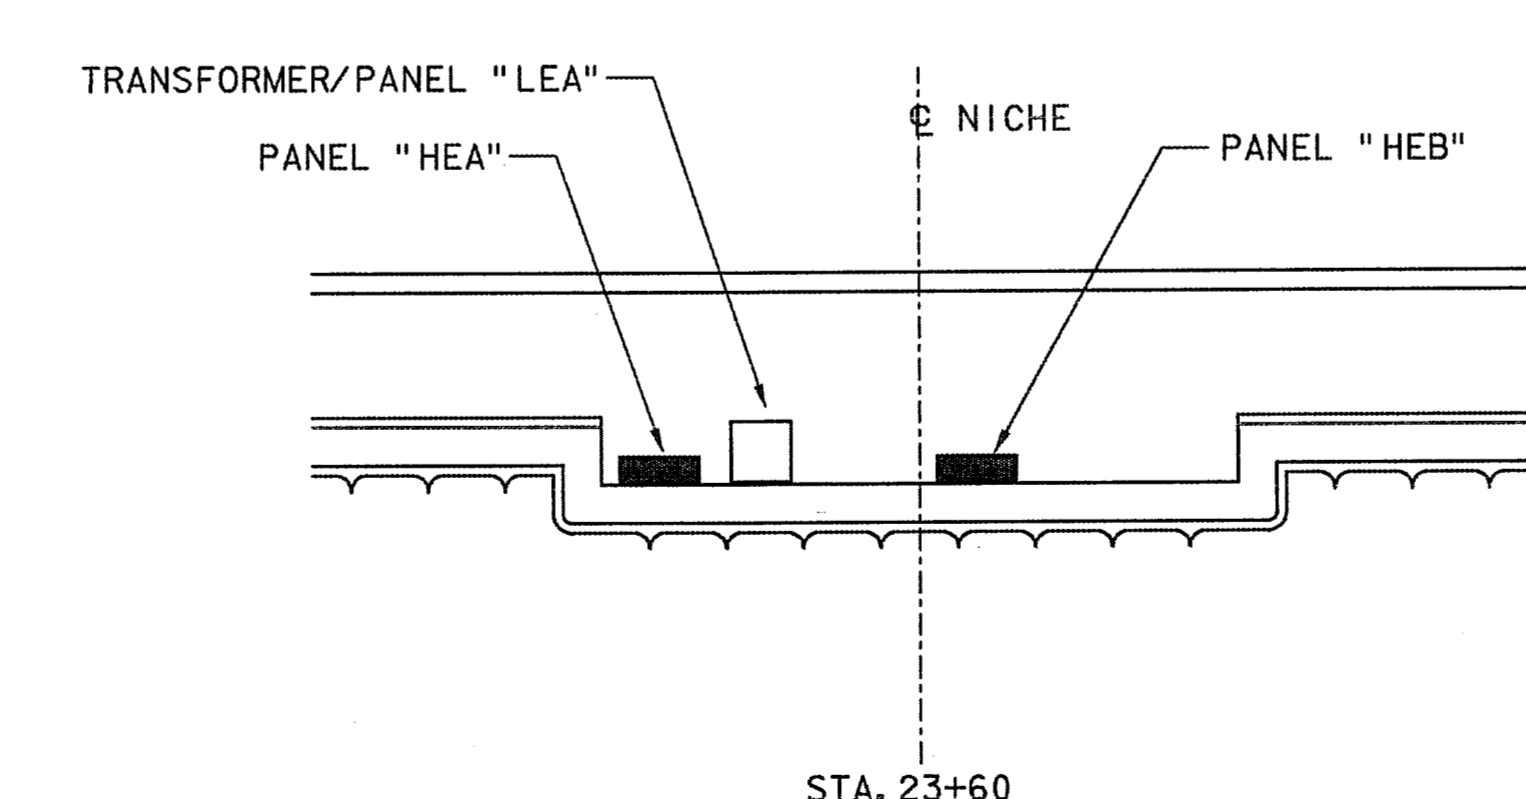

**LIGHTING PANELBOARDS IN EAST NICHE "E"**  
N. T. S.  
THESE PANELS, TRANSFORMER ETC ... WILL BE FURNISHED AND INSTALLED UNDER THE TUNNEL DOCUMENTS. UNLESS OTHERWISE NOTED.

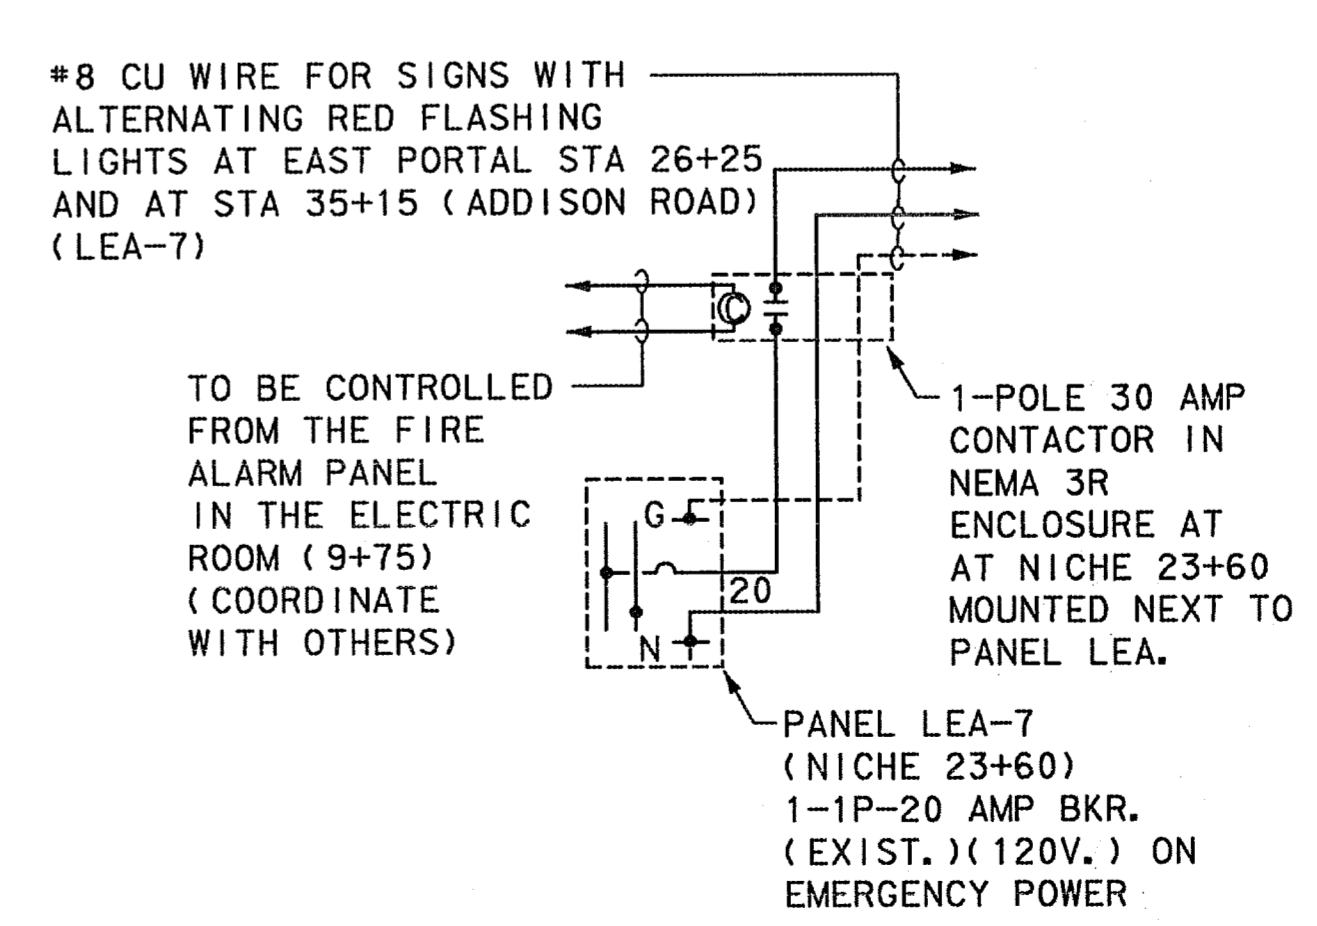



**ALARM SIGNS WIRING DIAGRAM (EAST ENTRANCE)**  
N. T. S.

**FINAL RECORD DRAWING**  
Date: 12/25/99

THE SEAL APPEARING ON THIS DOCUMENT WAS AUTHORIZED BY RICHARD J. MILLER, P.E. NO. 42812 ON JANUARY 12, 1999. ALTERATION OF A SEALED DOCUMENT WITHOUT PRIOR NOTIFICATION TO THE RESPONSIBLE ENGINEER IS AN OFFENSE UNDER THE TEXAS ENGINEERING PRACTICE ACT.



No.	REVISION	BY	DATE
NORTH TEXAS TOLLWAY AUTHORITY ADDISON AIRPORT TUNNEL			
ROADWAY ILLUMINATION LAYOUT STA. 23+00 TO STA. 28+00			
MATED CONSULTING ENGINEERS, INC. 3580 PETERSON LANE, SUITE 225 DALLAS, TEXAS 75240 (972) 233-6700			SECTION XIII
DRAWN: SAA	DATE: 5/97	DESIGNED: DR	DATE: 5/97
CHECKED: RJM	DATE: 5/97	SCALE: 1"=20'	
CONTRACT No. DNT-260 SHEET 21 OF 52			

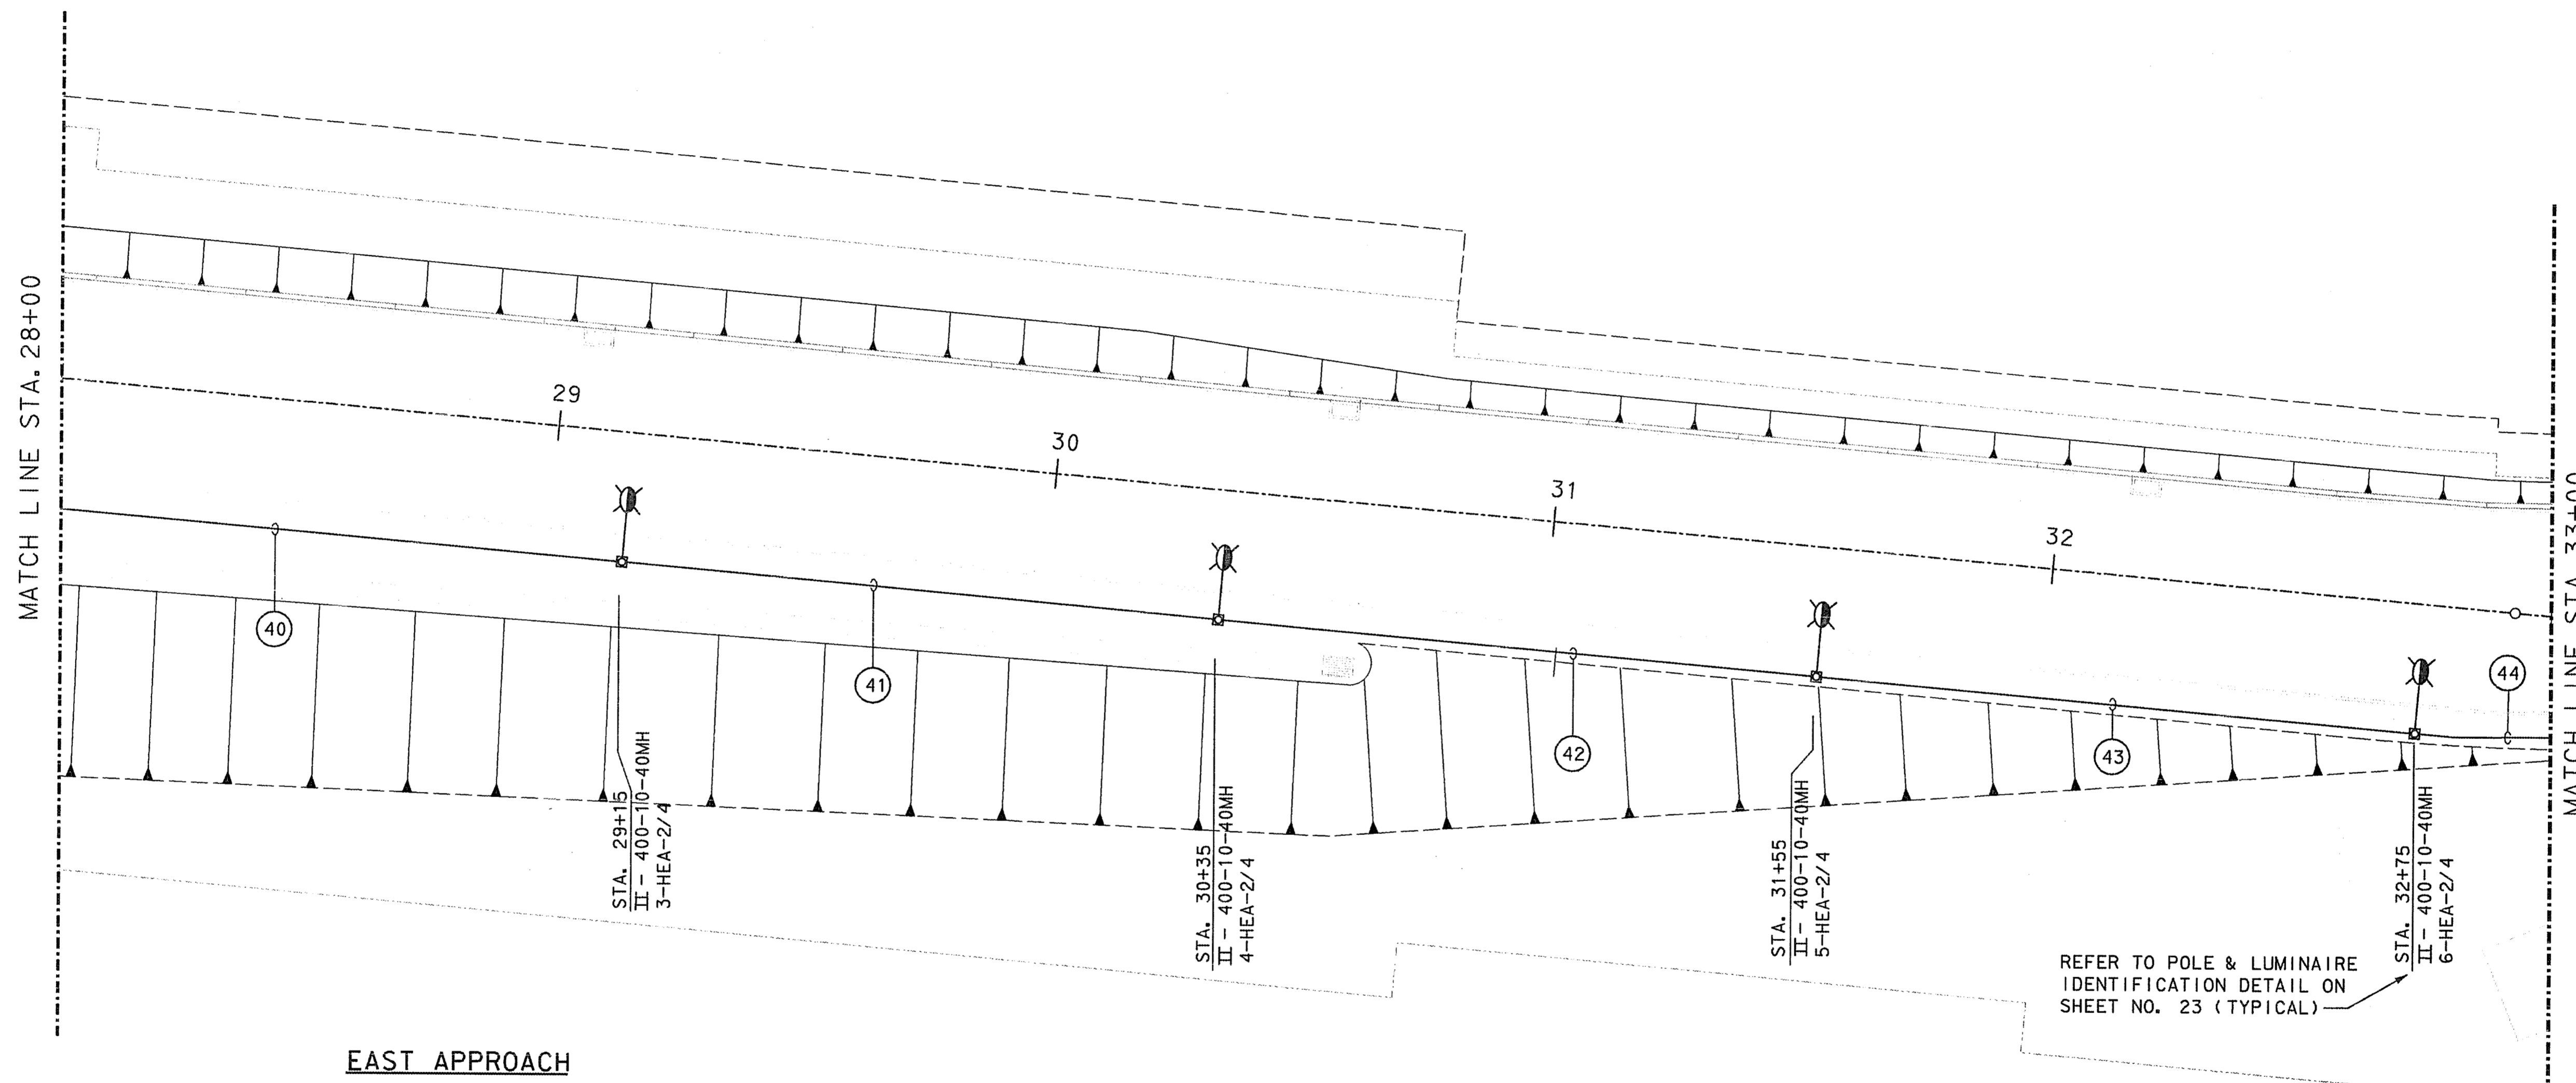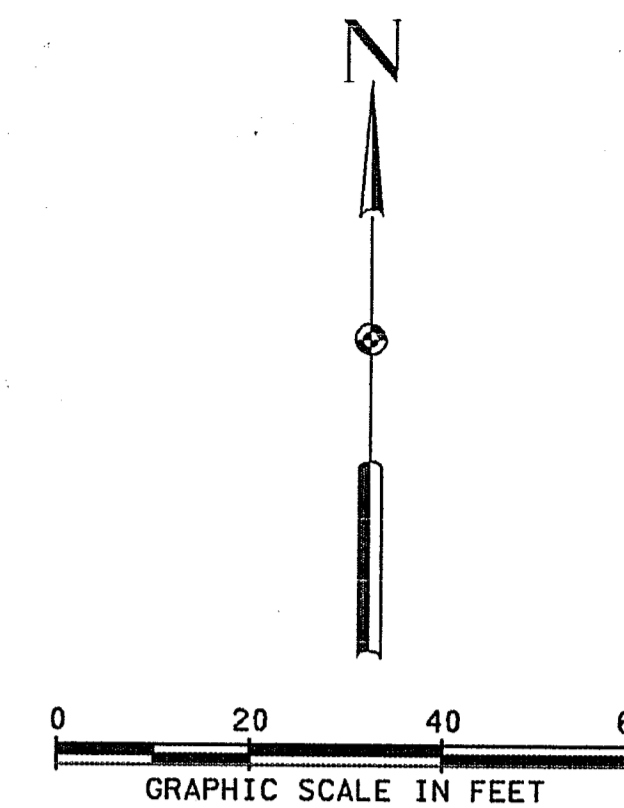


**NOTE:**  
1. SEE SHEET NO. 18 FOR GENERAL NOTES AND LEGEND.

REFER TO POLE & LUMINAIRE IDENTIFICATION DETAIL ON SHEET NO. 23 (TYPICAL)



**EAST APPROACH**

**FINAL RECORD DRAWING**  
Date: 12/25/99

THE SEAL APPEARING ON THIS DOCUMENT WAS AUTHORIZED BY RICHARD J. MILLER, P.E. NO. 42812 ON JANUARY 12, 1999. ALTERATION OF A SEALED DOCUMENT WITHOUT PRIOR NOTIFICATION TO THE RESPONSIBLE ENGINEER IS AN OFFENSE UNDER THE TEXAS ENGINEERING PRACTICE ACT.

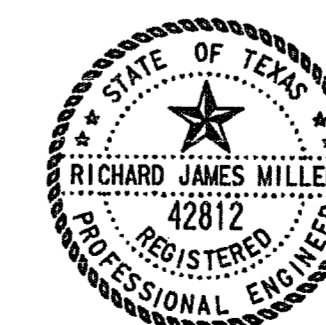

No.	REVISION	BY	DATE
NORTH TEXAS TOLLWAY AUTHORITY ADDISON AIRPORT TUNNEL			
ROADWAY ILLUMINATION LAYOUT STA. 28+00 TO STA. 33+00			
<b>MCE</b> MATED CONSULTING ENGINEERS, INC. <small>5540 PETERSON LANE SUITE 225 DALLAS, TEXAS 75240 (972) 233-6100</small>			SECTION XIII
DRAWN: SAA	DATE: 5/97	DESIGNED: DR	DATE: 5/97
CHECKED: RJM	DATE: 5/97	SCALE: 1"=20'	
CONTRACT No. <u>DNT-260</u> SHEET <u>22</u> OF <u>52</u>			

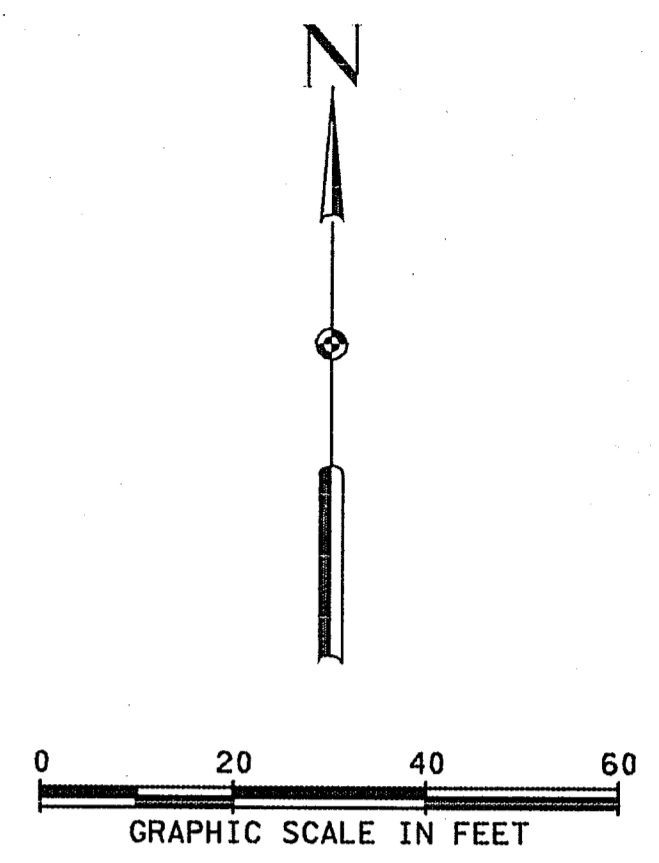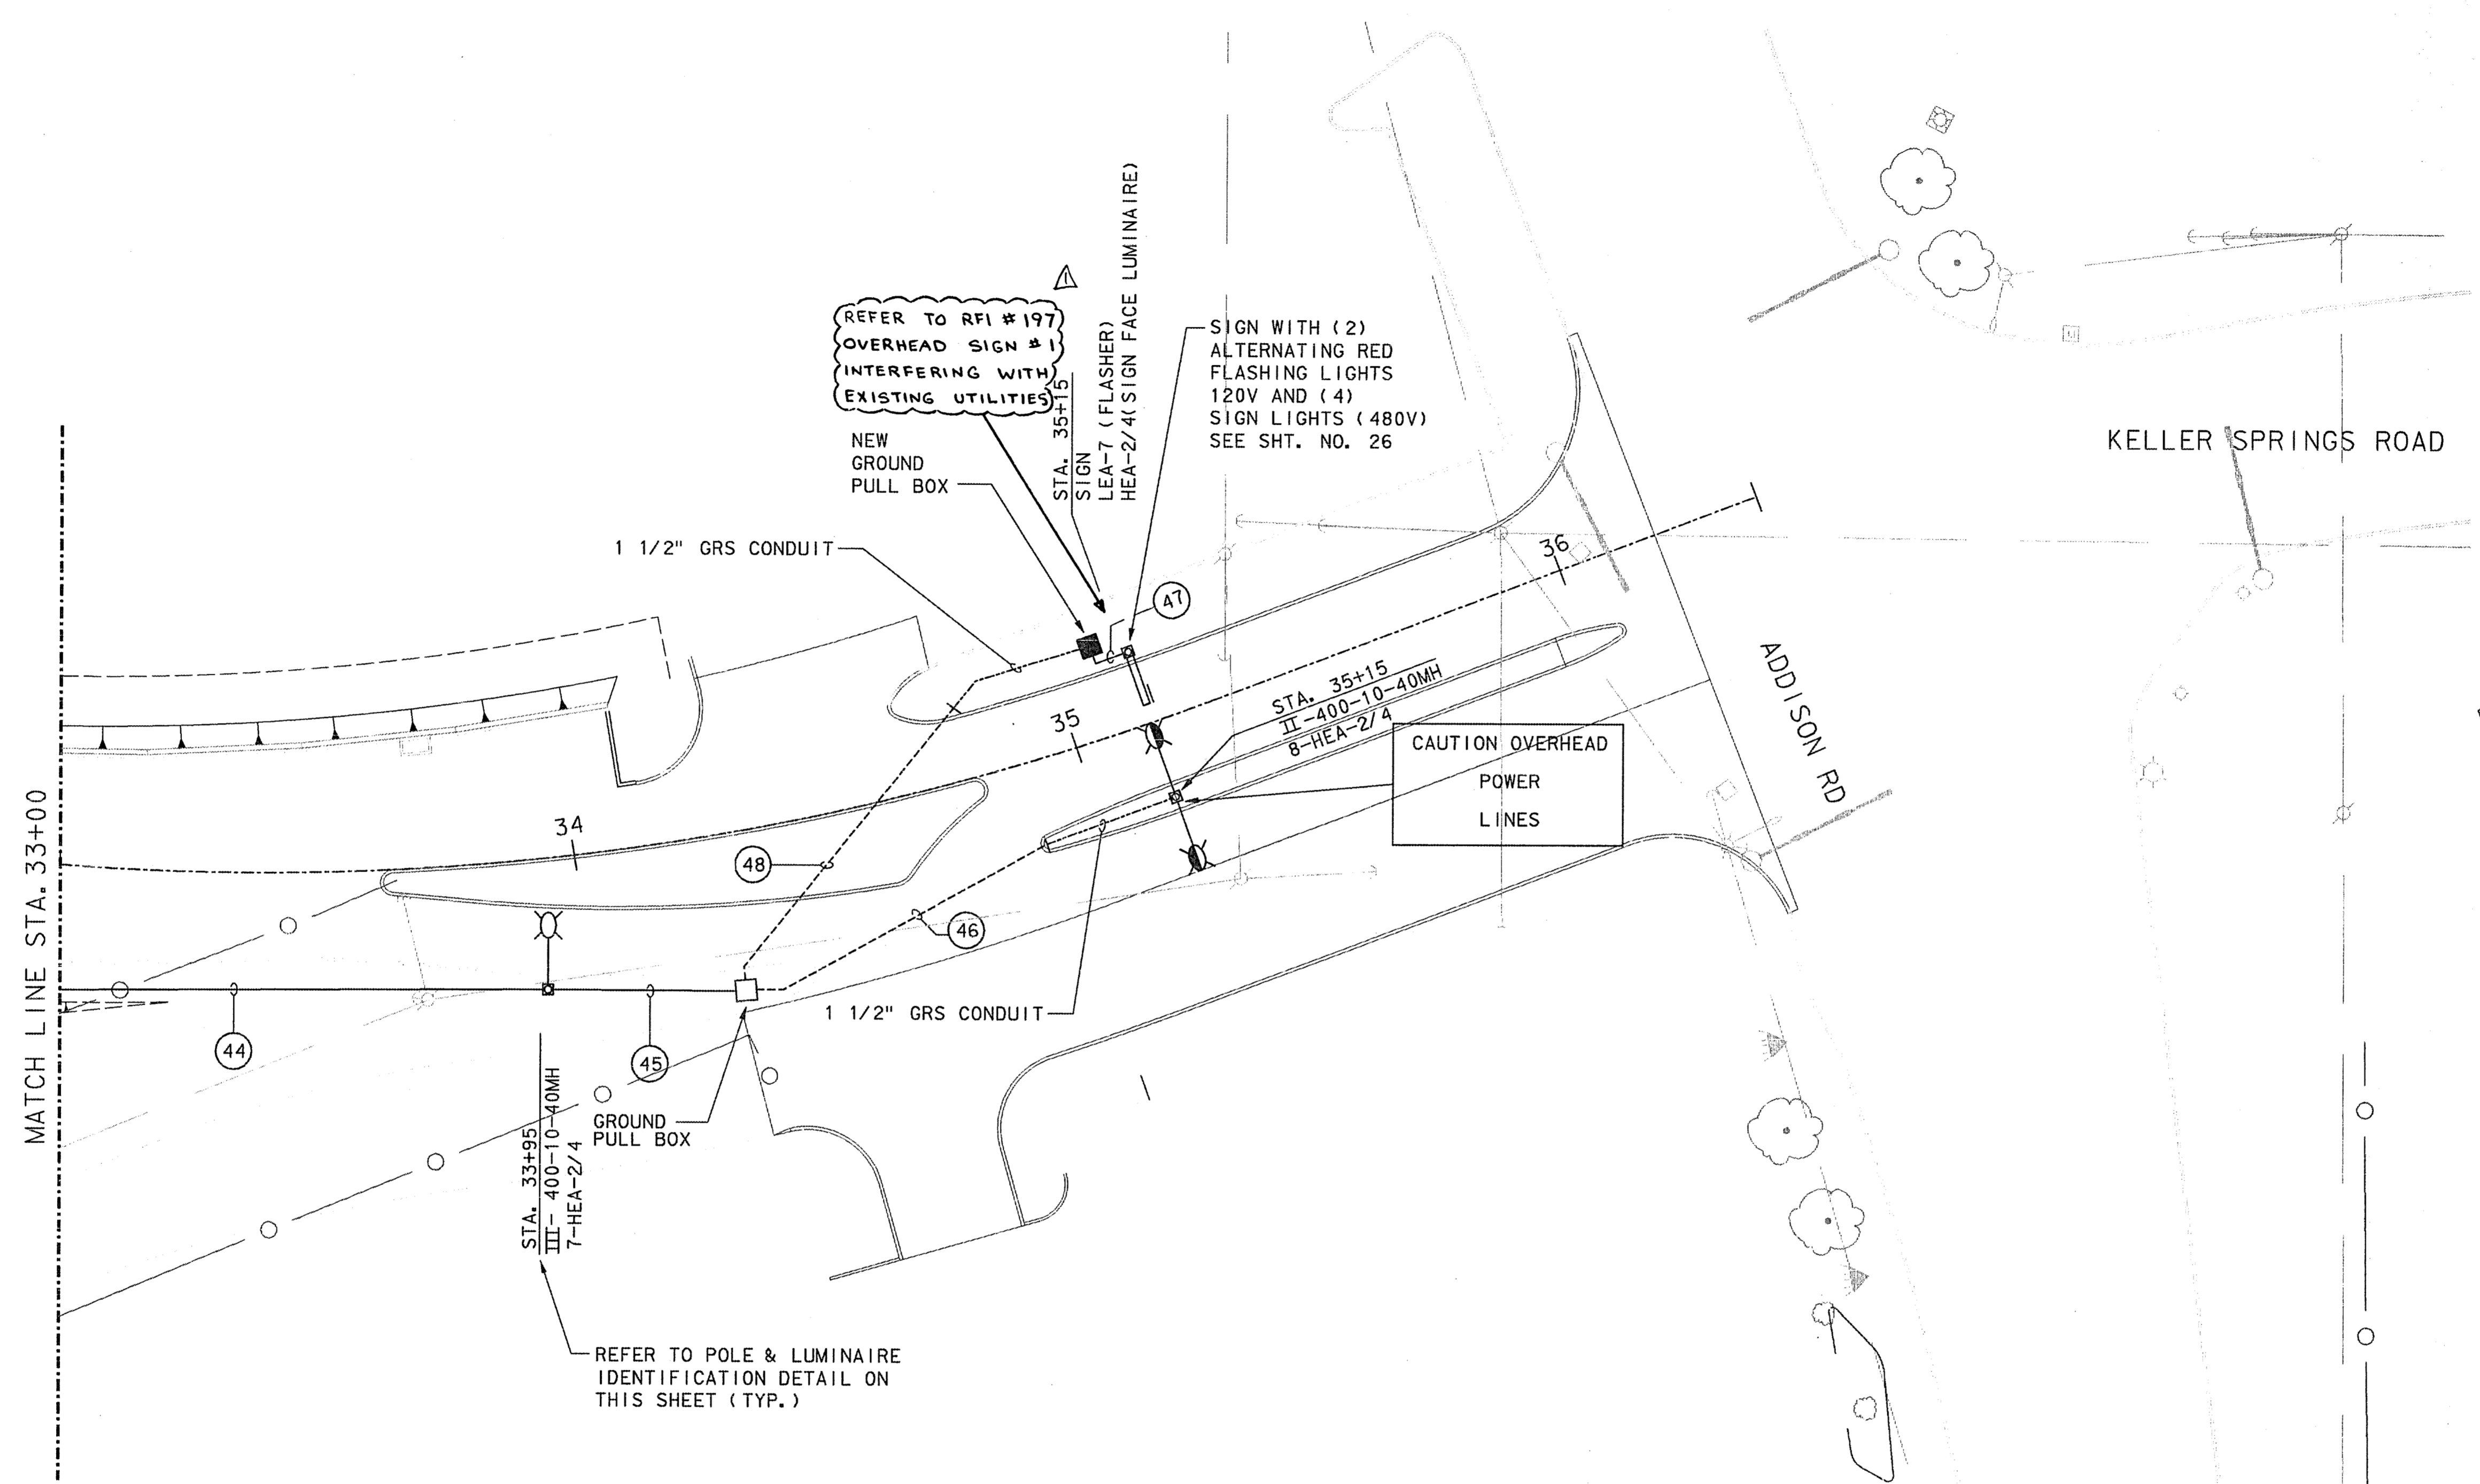

- INDICATES LOCATION
- STA. X+XX  
III- 400-10-40MH  
XX-XXX-XX I
- INDICATES MOUNTING HEIGHT OF LUMINAIRE IN FEET
- INDICATES POLE ARM LENGTH IN FEET
- INDICATES HPS LAMP WATTAGE
- INDICATES THE POLE NO. AND THE PANEL & CIRCUIT NUMBER SERVING THE LUMINAIRE
- INDICATES LIGHT DISTRIBUTION OR THE NUMBER OF MOUNTED FLOODLIGHTS.

**TYPICAL POLE AND LUMINAIRE IDENTIFICATION DETAIL**

THE SEAL APPEARING ON THIS DOCUMENT WAS AUTHORIZED BY RICHARD J. MILLER, P.E. NO. 42812 ON JANUARY 12, 1999. ALTERATION OF A SEALED DOCUMENT WITHOUT PRIOR NOTIFICATION TO THE RESPONSIBLE ENGINEER IS AN OFFENSE UNDER THE TEXAS ENGINEERING PRACTICE ACT.

**FINAL RECORD DRAWING**  
Date: 12/25/99




△ REVISED PER RFI # 197


No.	REVISION	BY	DATE
NORTH TEXAS TOLLWAY AUTHORITY ADDISON AIRPORT TUNNEL			
ROADWAY ILLUMINATION LAYOUT STA. 33+00 TO STA. 36+10			
MATED CONSULTING ENGINEERS, INC. 5500 PETERSON LANE SUITE 225 DALLAS, TEXAS 75240 (972) 233-6100			SECTION XIII
DRAWN: SAA	DATE: 5/97	DESIGNED: DR	DATE: 5/97
CHECKED: RJM	DATE: 5/97	SCALE: 1"=20'	
CONTRACT No. DNT-260 SHEET 23 OF 52			

EAST APPROACH




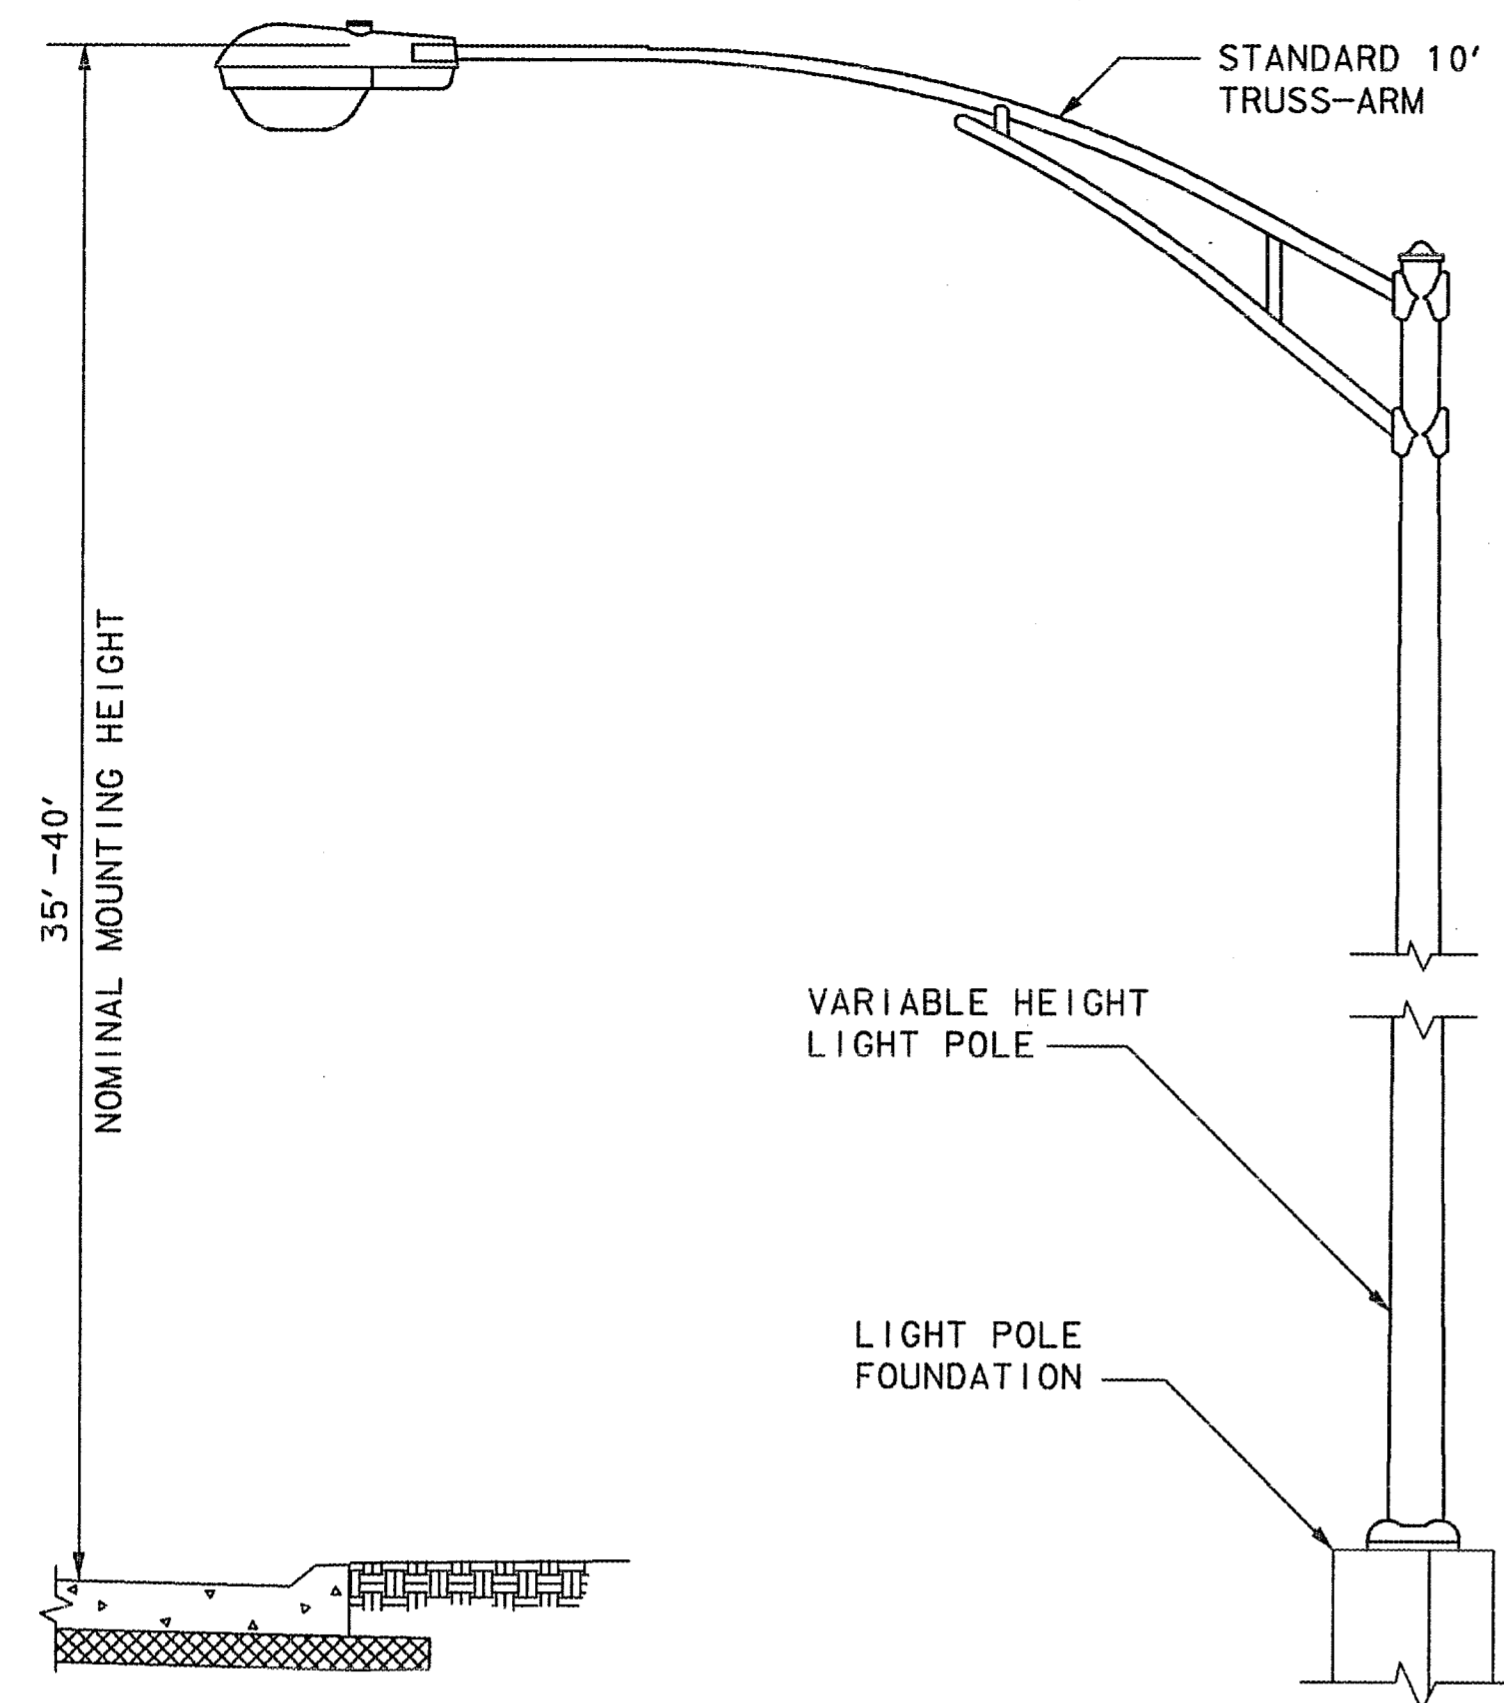


**WALL-MOUNTED LIGHTING STANDARD DETAIL**

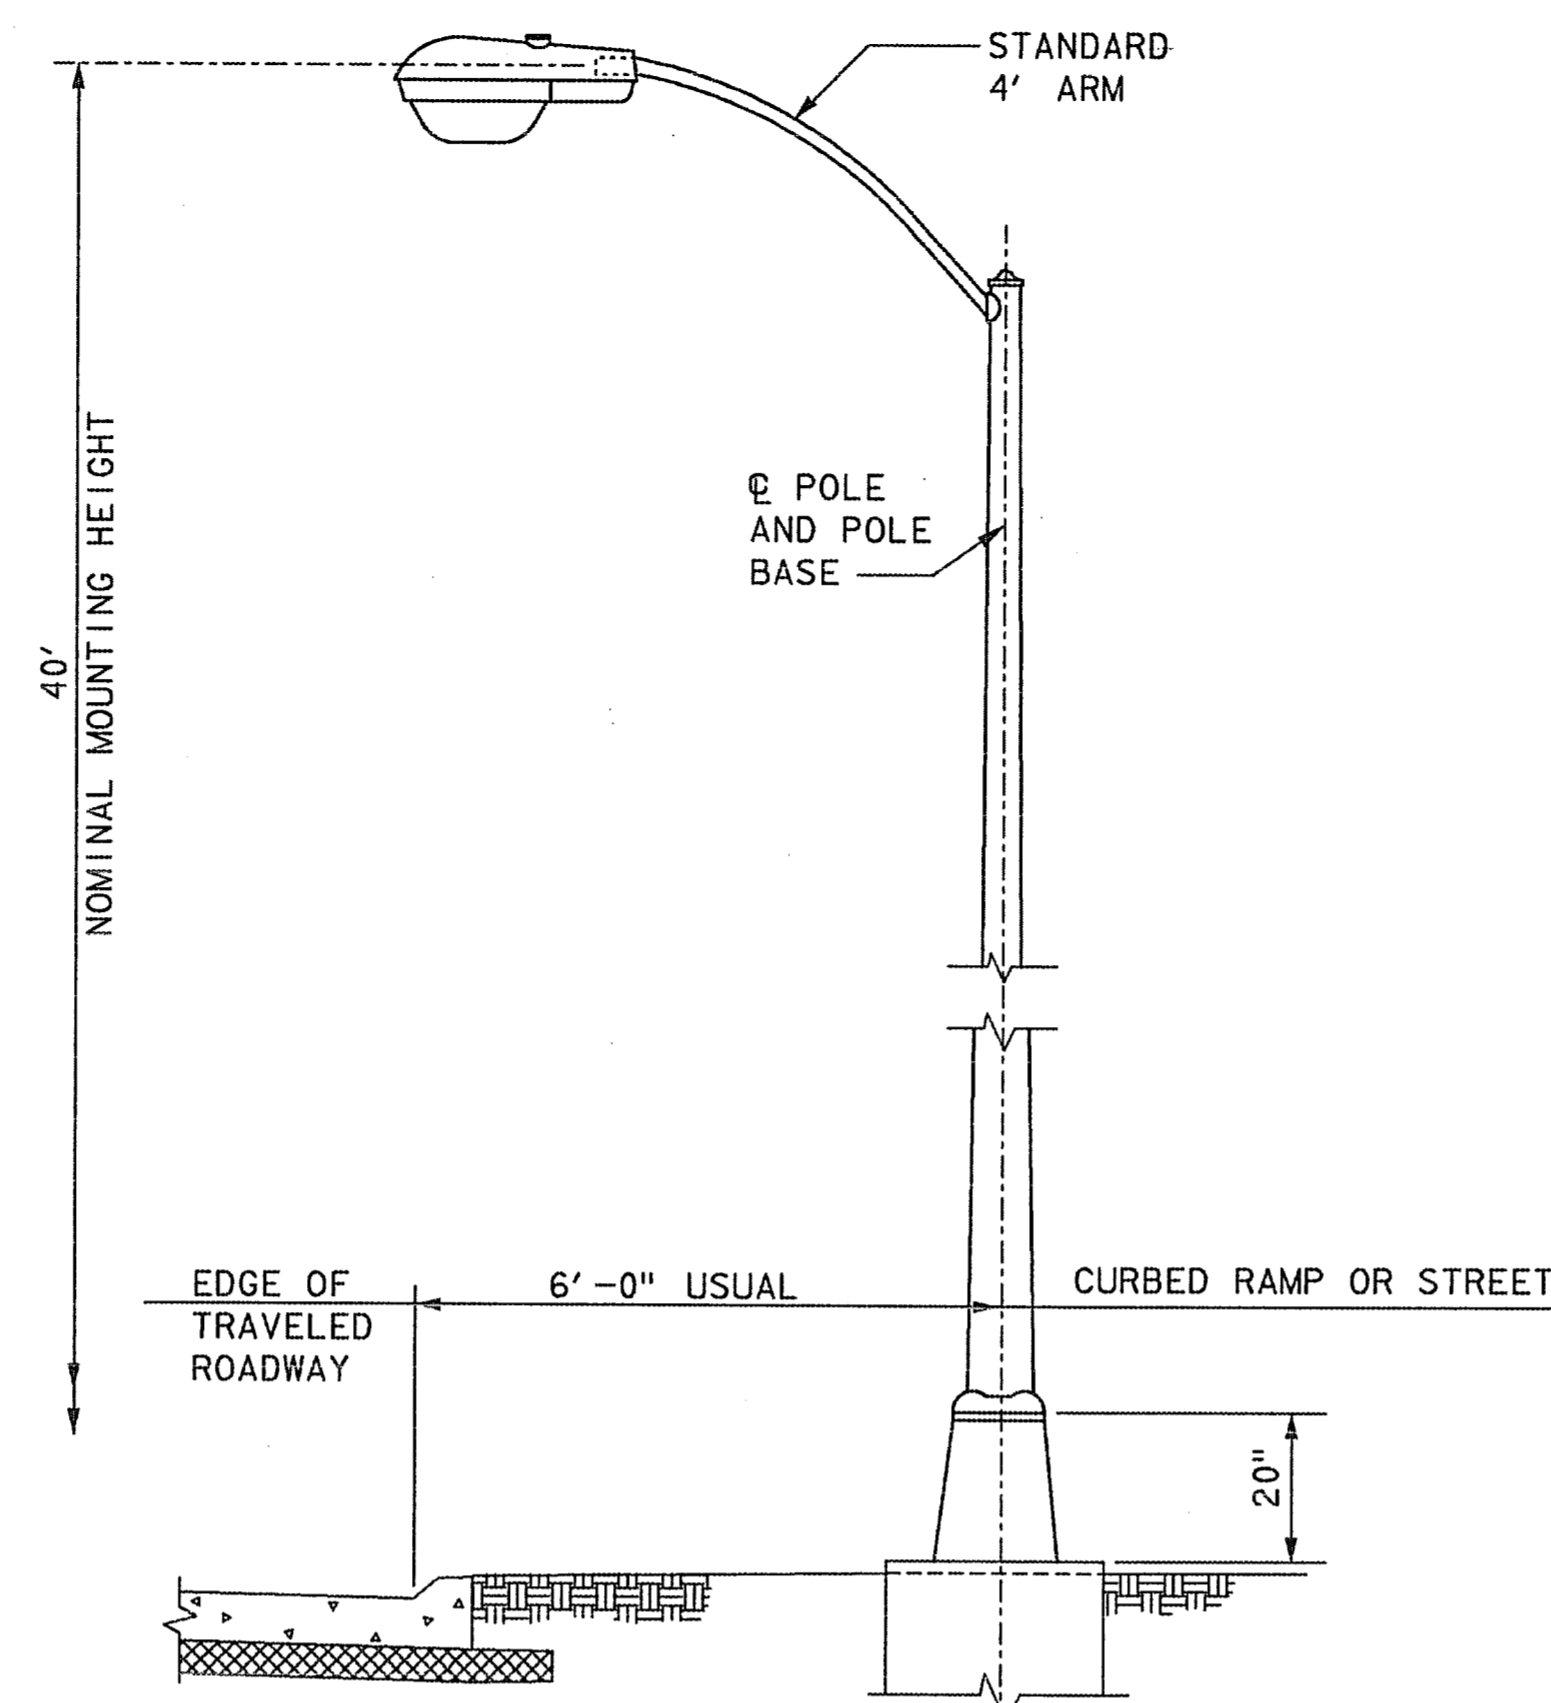


**GROUND-MOUNTED LIGHTING STANDARD DETAIL**

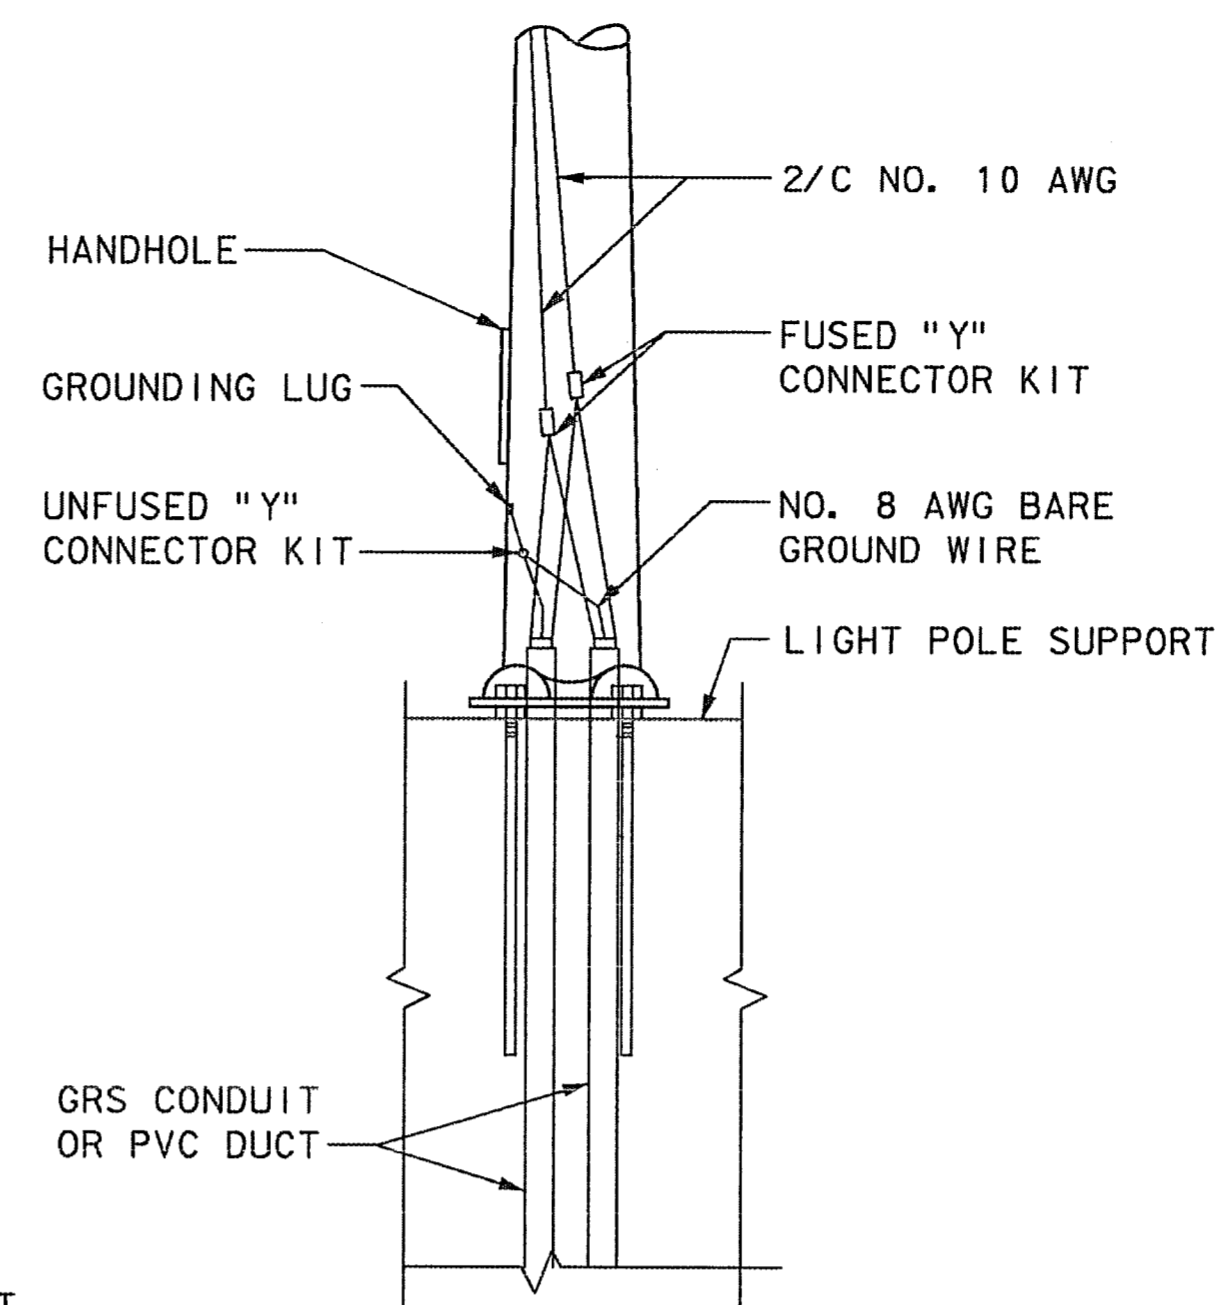


**POLE BASE CONDUCTOR CONNECTION DETAIL**

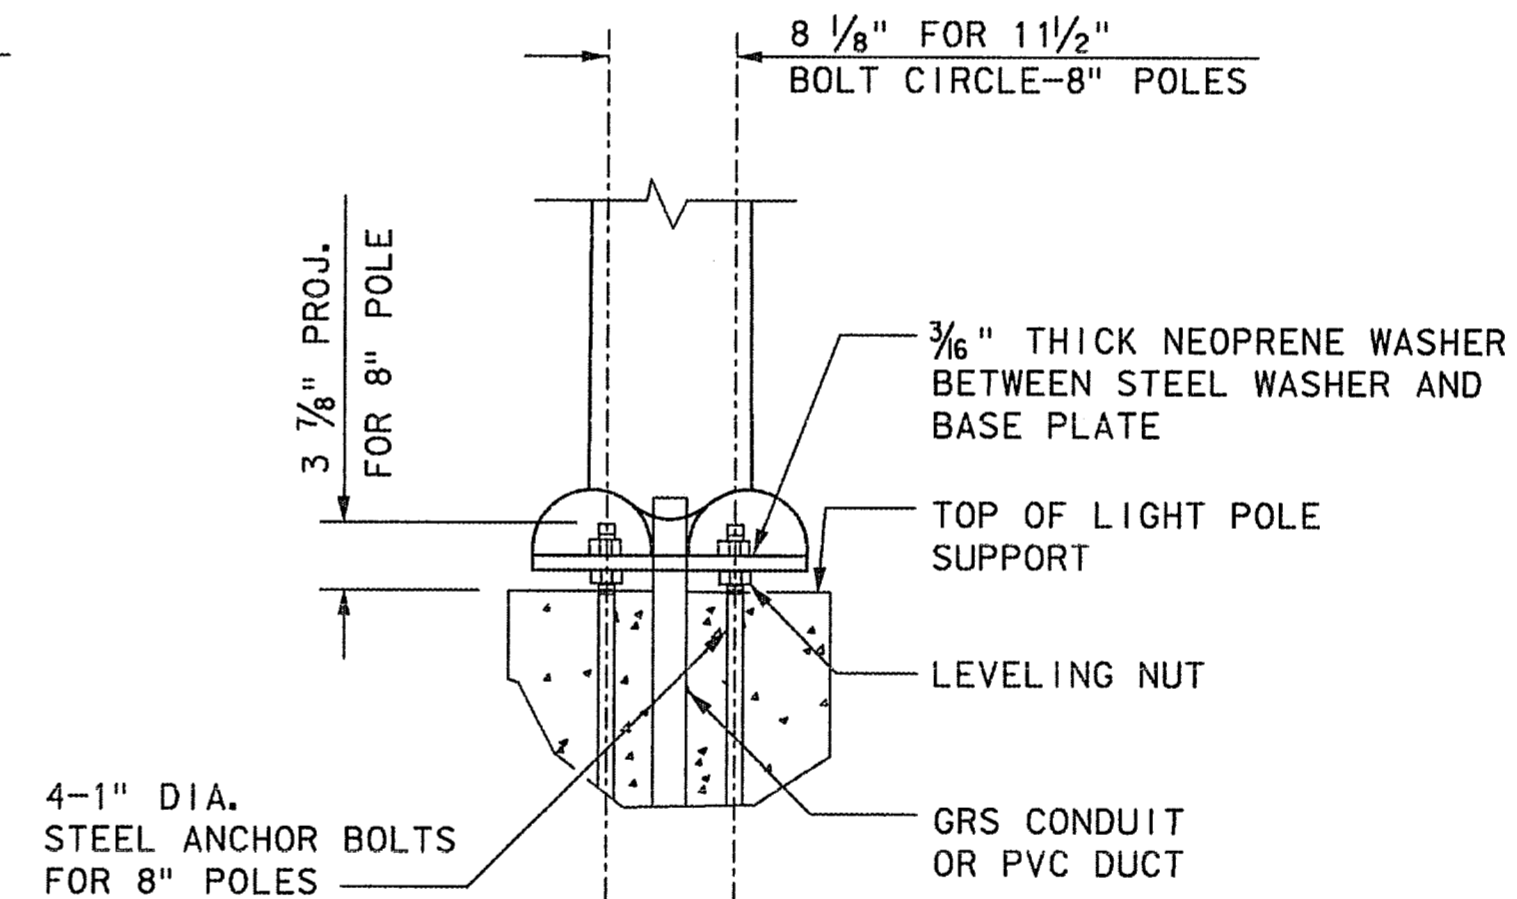


**STRUCTURE POLE MOUNTING DETAIL**

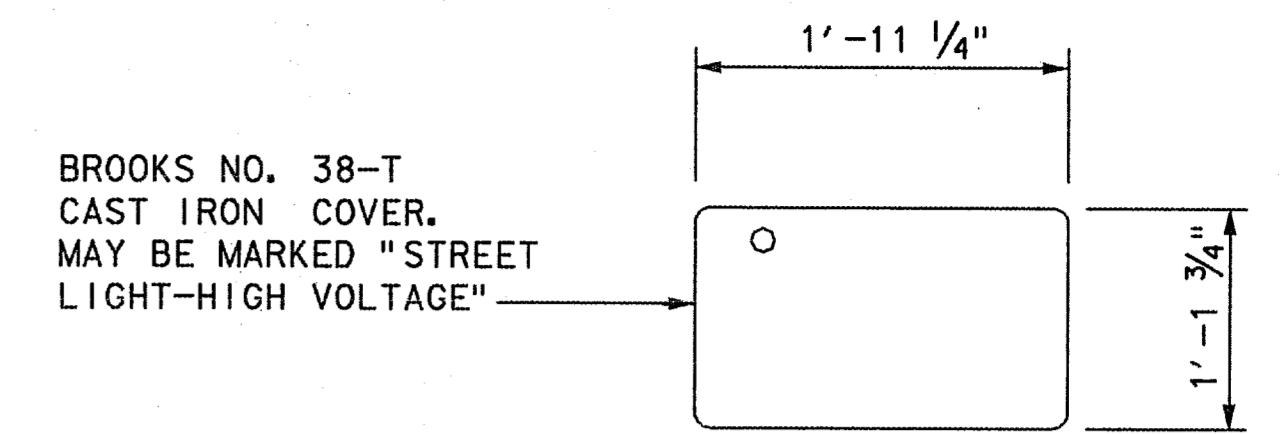

**COVER PLAN**

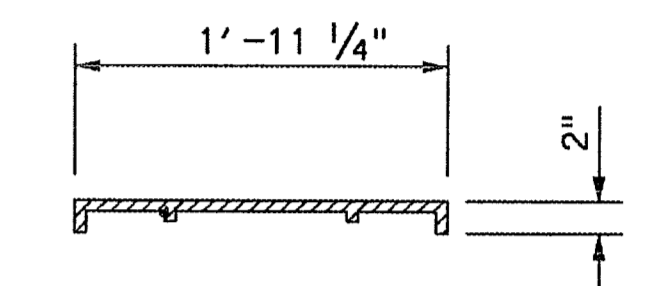


**COVER SECTION**


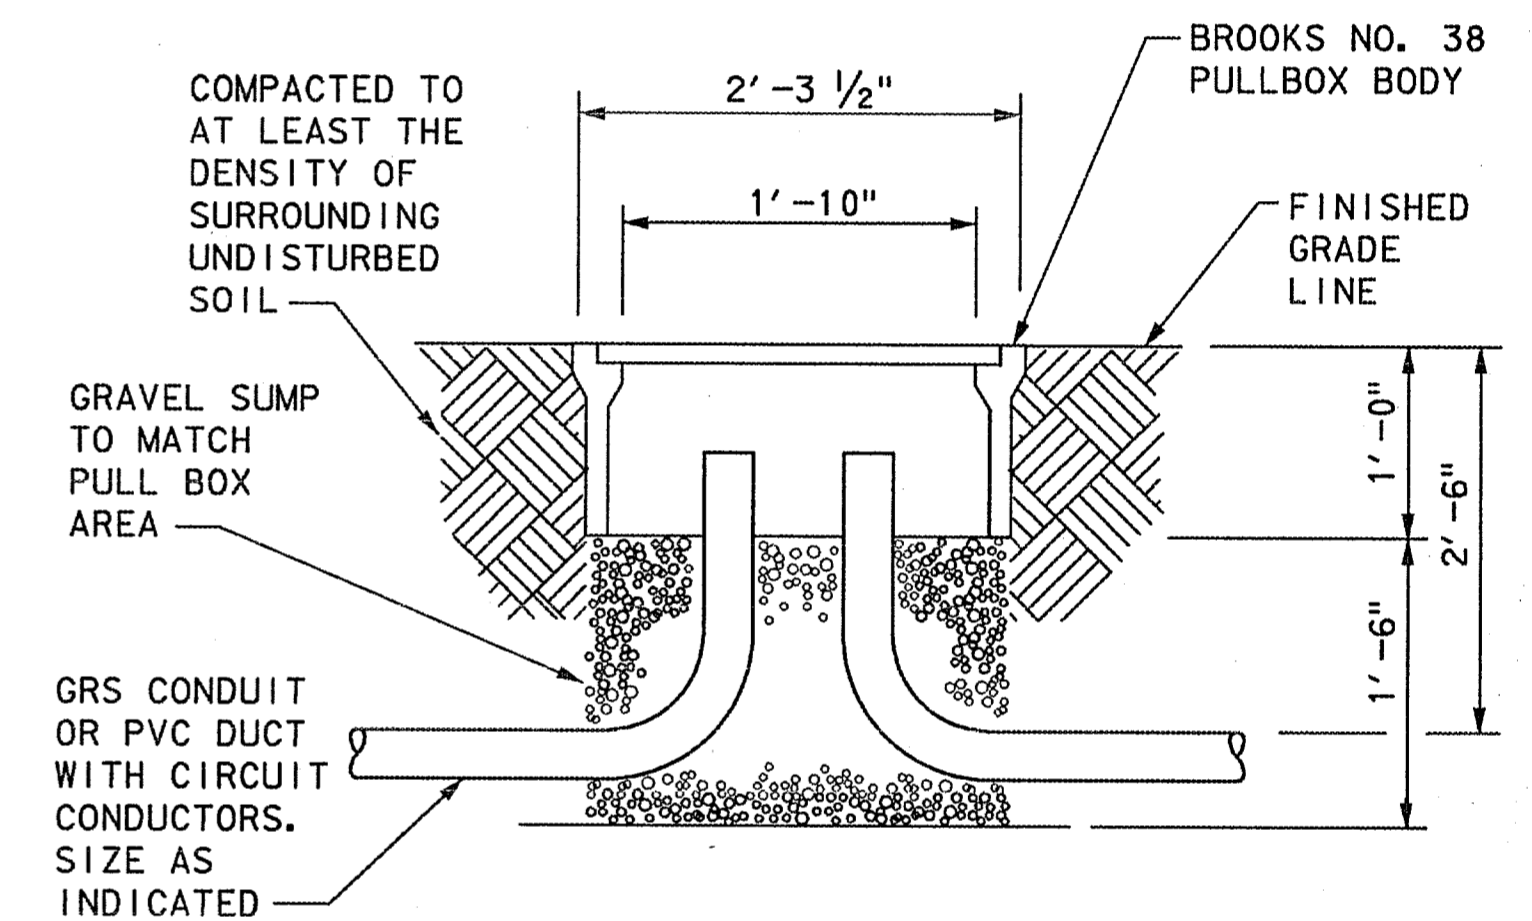


**SECTION PULL BOX DETAILS**

THE SEAL APPEARING ON THIS DOCUMENT WAS AUTHORIZED BY RICHARD J. MILLER, P.E. NO. 42812 ON JANUARY 12, 1999. ALTERATION OF A SEALED DOCUMENT WITHOUT PRIOR NOTIFICATION TO THE RESPONSIBLE ENGINEER IS AN OFFENSE UNDER THE TEXAS ENGINEERING PRACTICE ACT.

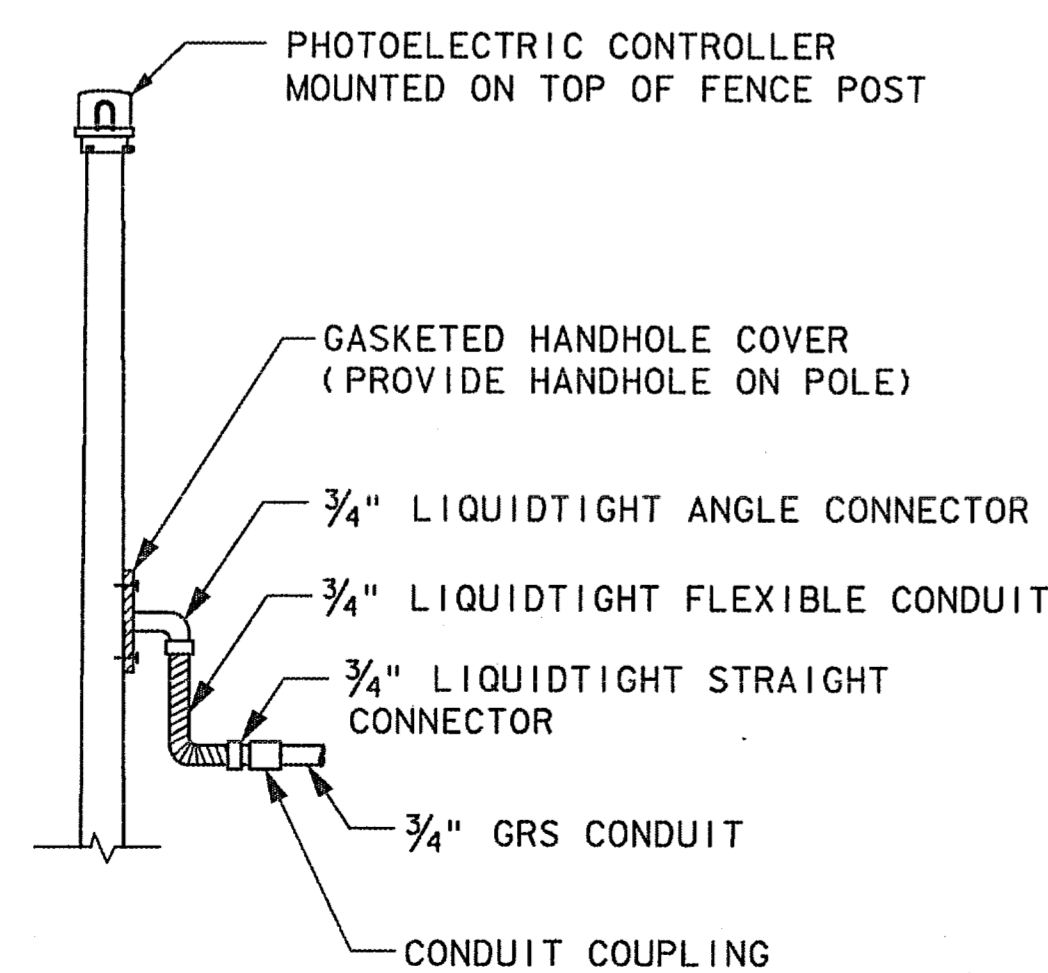

**PHOTOELECTRIC CONTROLLER-MOUNTING DETAIL ON TOP OF FENCE POST**

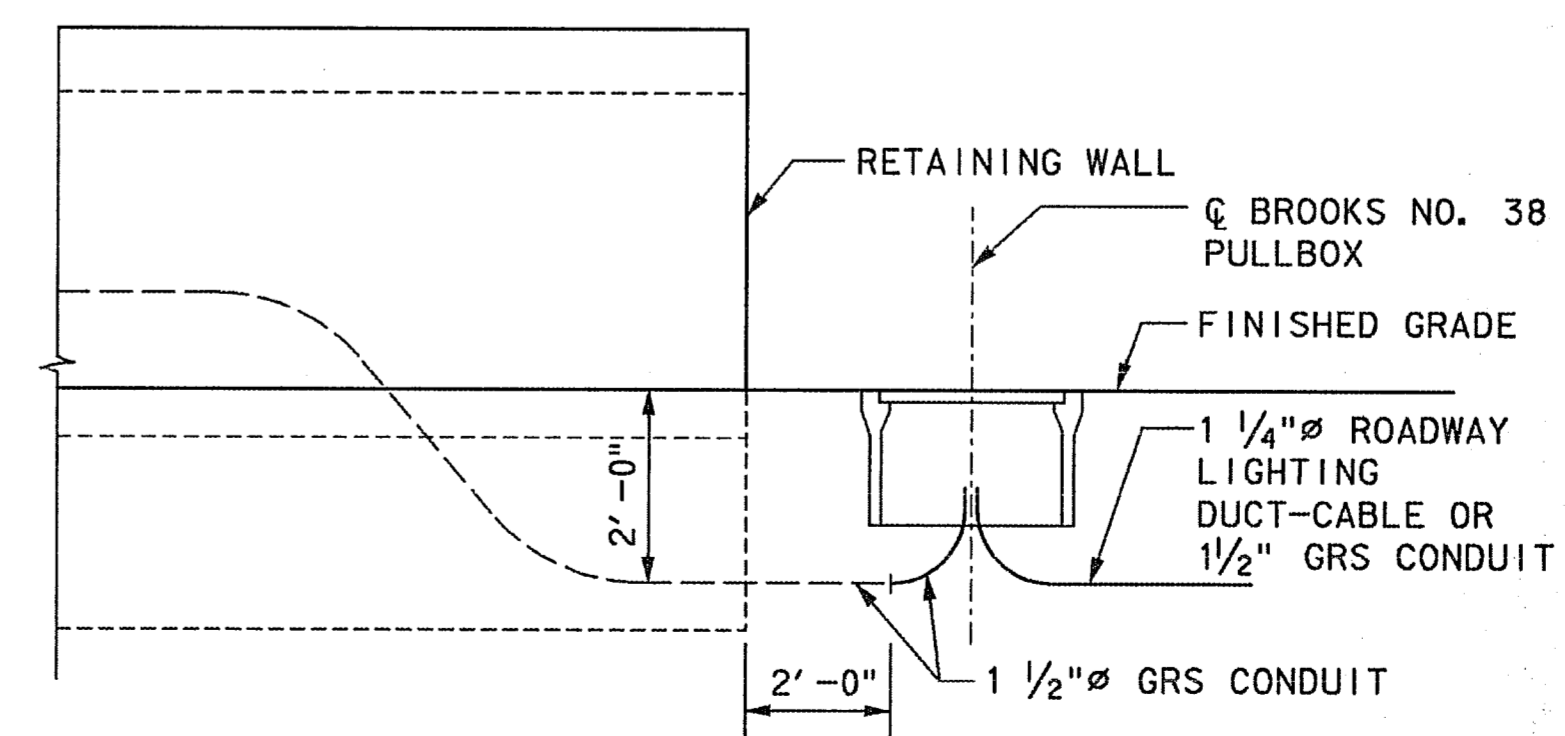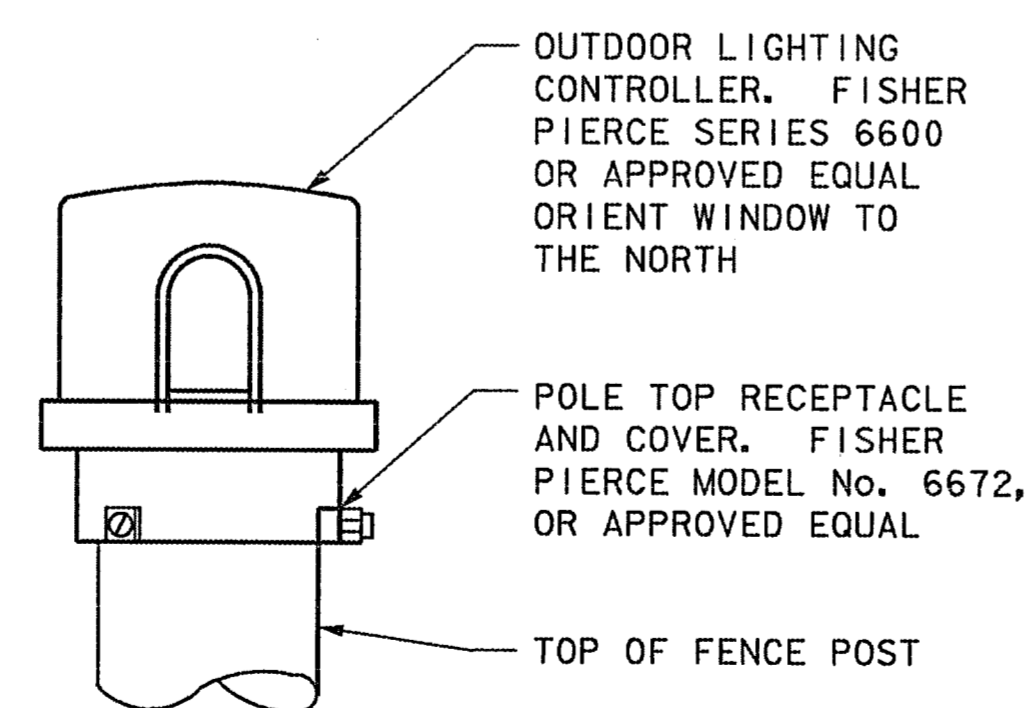


**RAIL TERMINAL STRUCTURAL CONDUIT DETAIL**


**FINAL RECORD DRAWING**  
Date: 12/25/99



No.	REVISION	BY	DATE
NORTH TEXAS TOLLWAY AUTHORITY ADDISON AIRPORT TUNNEL			
MISCELLANEOUS ELECTRICAL DETAILS			
MCE MATED CONSULTING ENGINEERS, INC. 5549 PETERSON LANE SUITE 225 DALLAS, TEXAS 75240 (972) 233-6700		SECTION XIII	
DRAWN: SAA	DATE: 5/97	DESIGNED: DR	DATE: 5/97
CHECKED: RJM	DATE: 5/97	SCALE: NONE	
CONTRACT No. DNT-260 SHEET 24 OF 52			

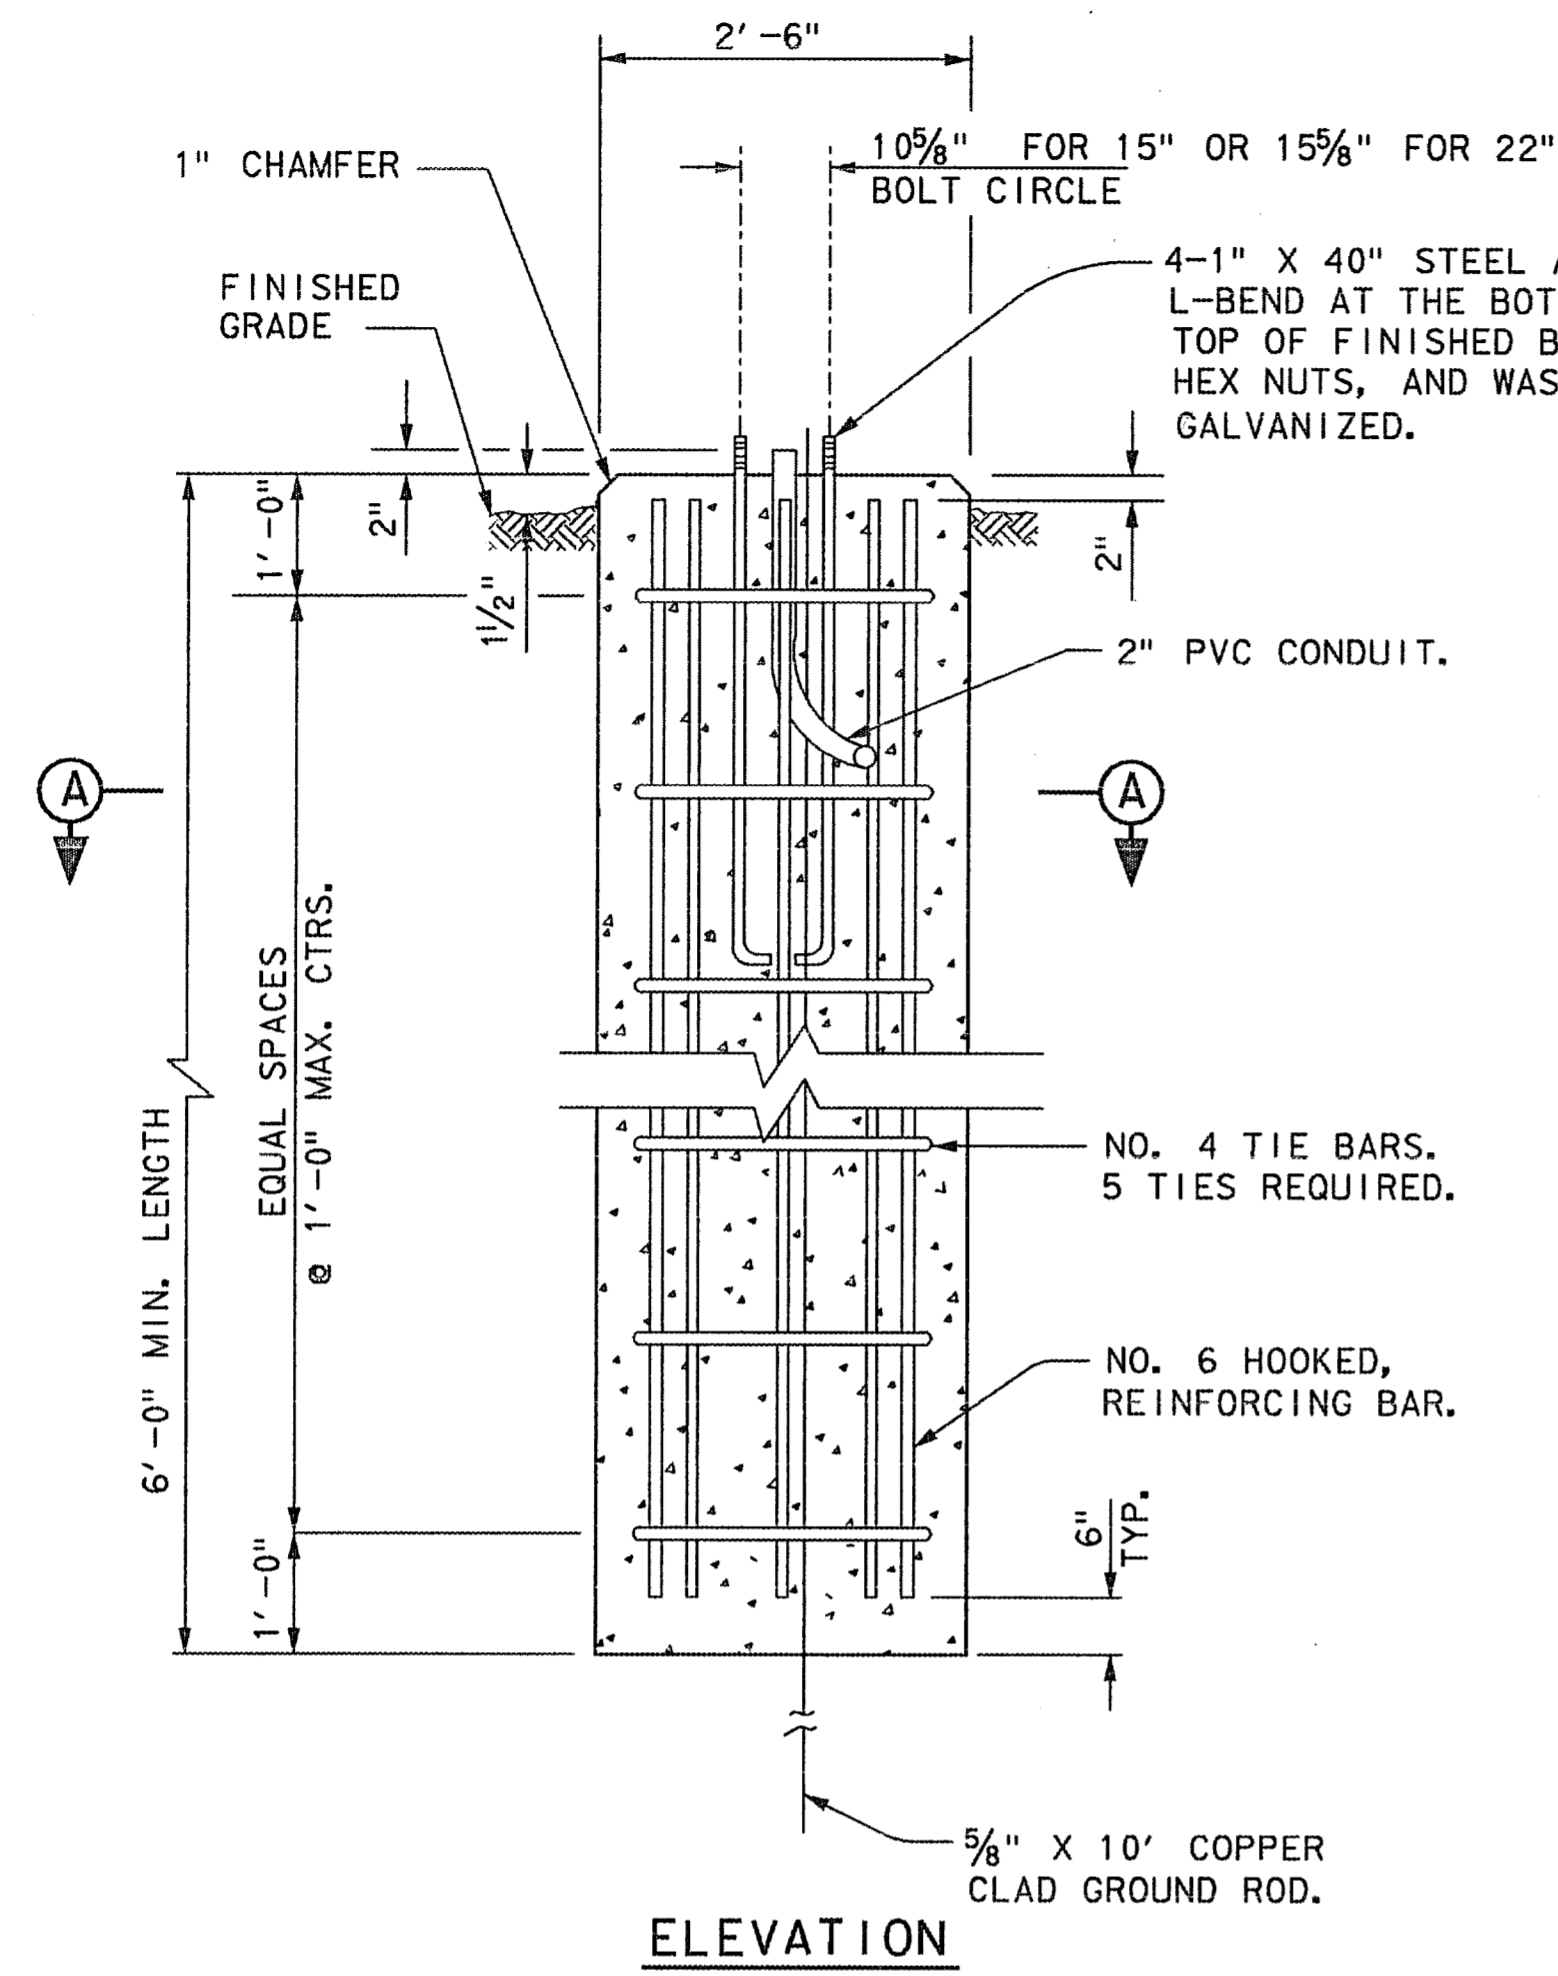


**ELEVATION**

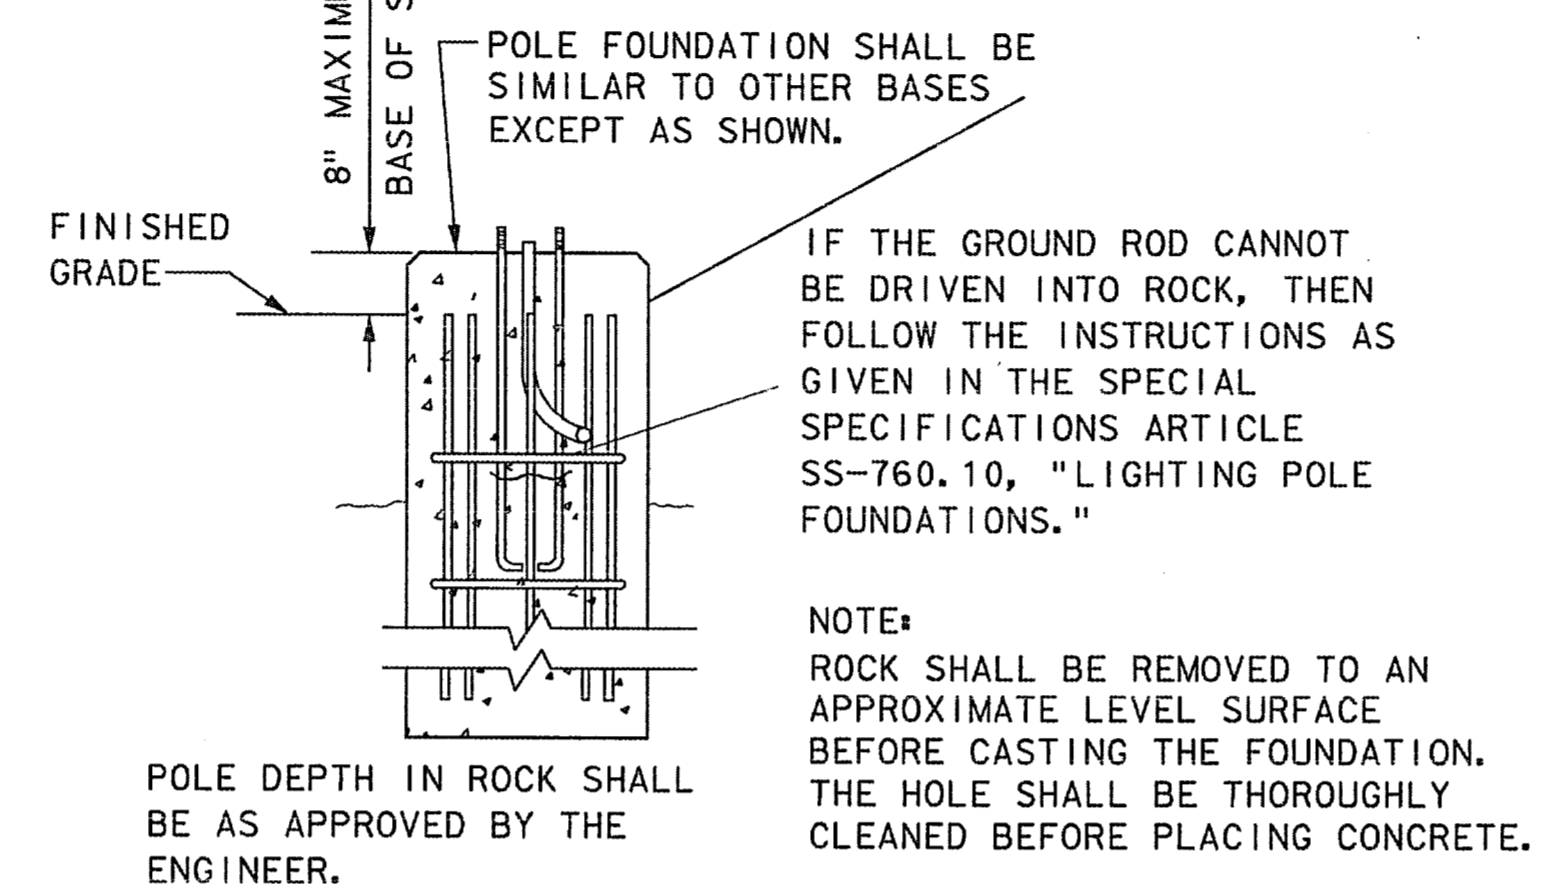


**MODIFIED GROUND-MOUNTED LIGHTING STANDARD FOUNDATION ROCK ANCHORAGE**




**SECTION A-A GROUND-MOUNTED LIGHTING STANDARD FOUNDATION**

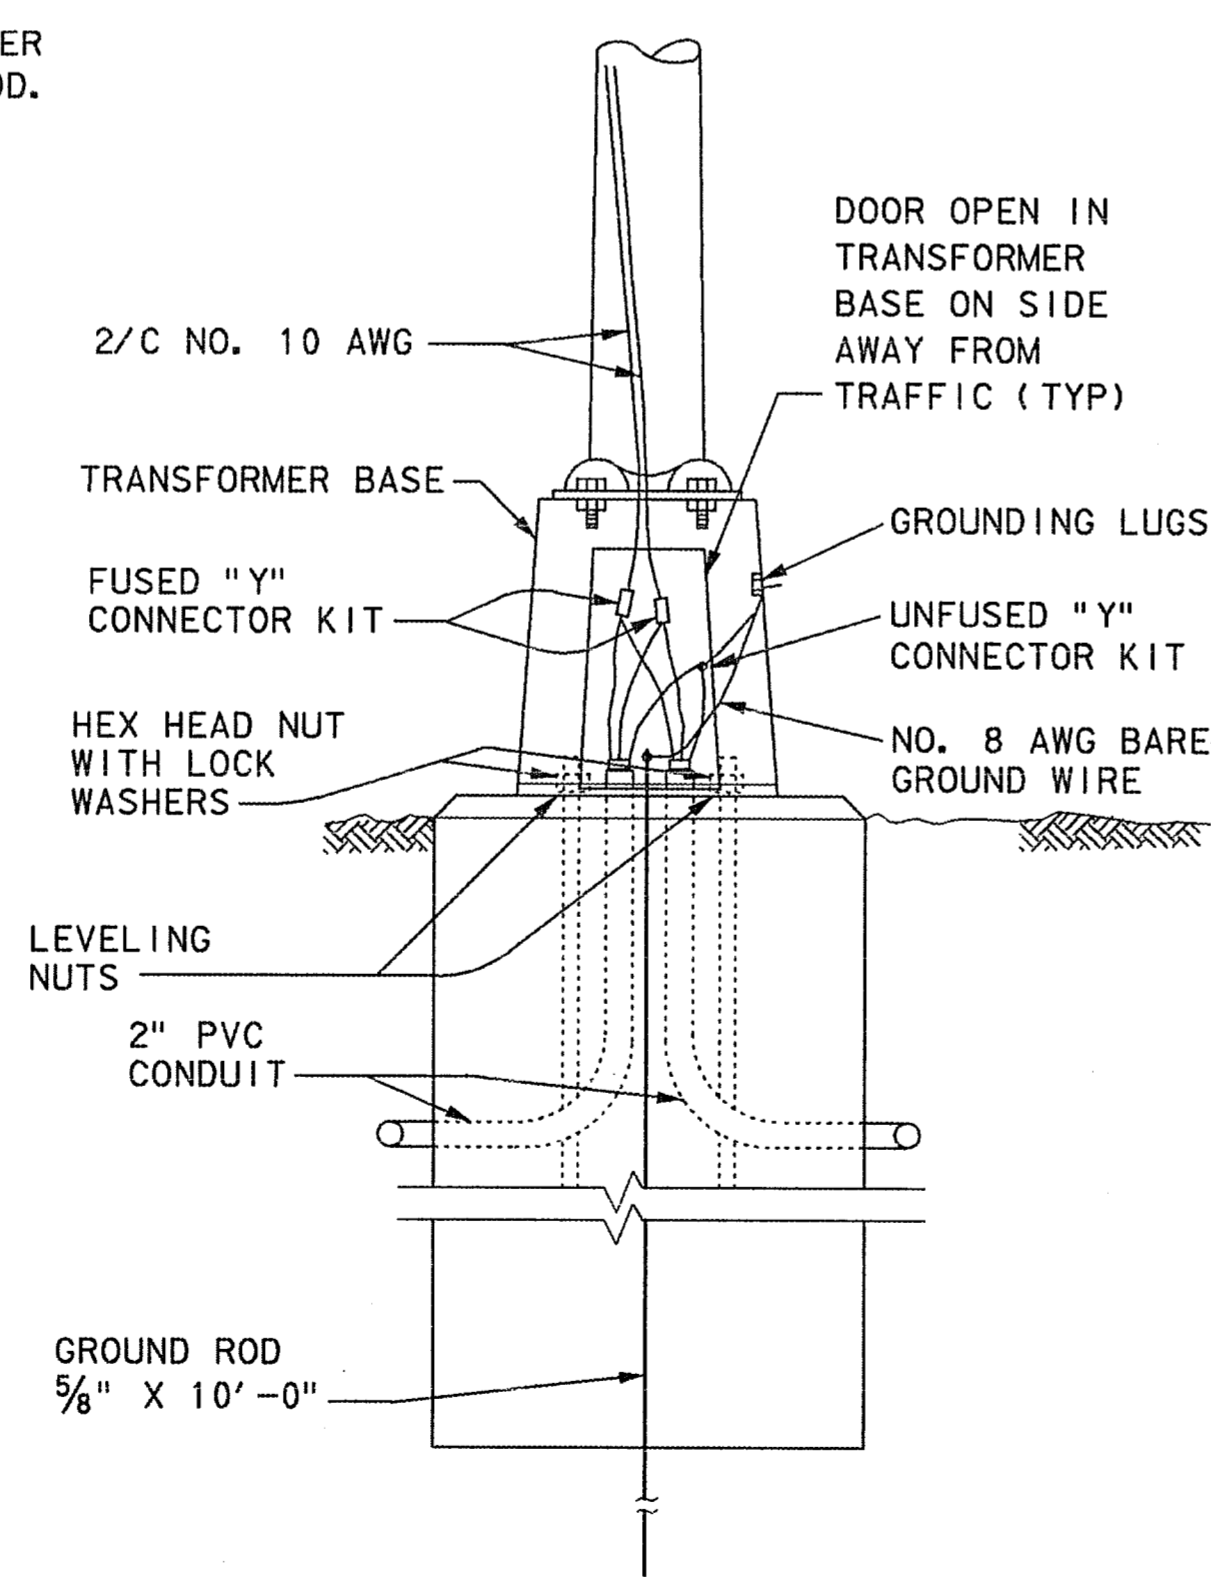

**GROUND-MOUNTED STANDARD MOUNTING AND WIRING DETAIL**

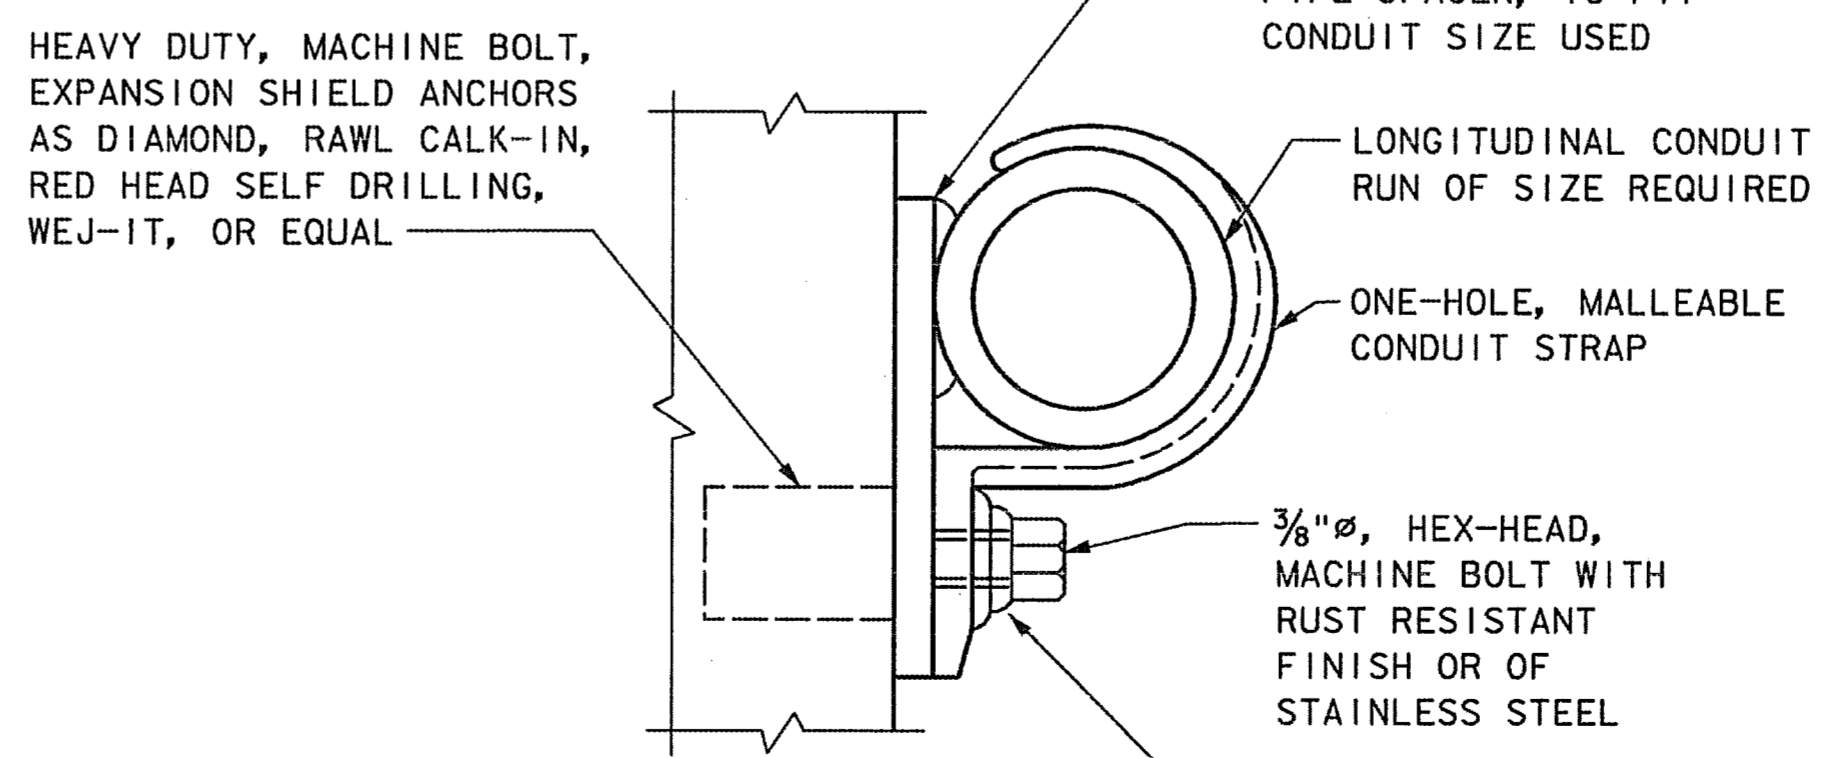


**CONDUIT FASTENING DETAIL**

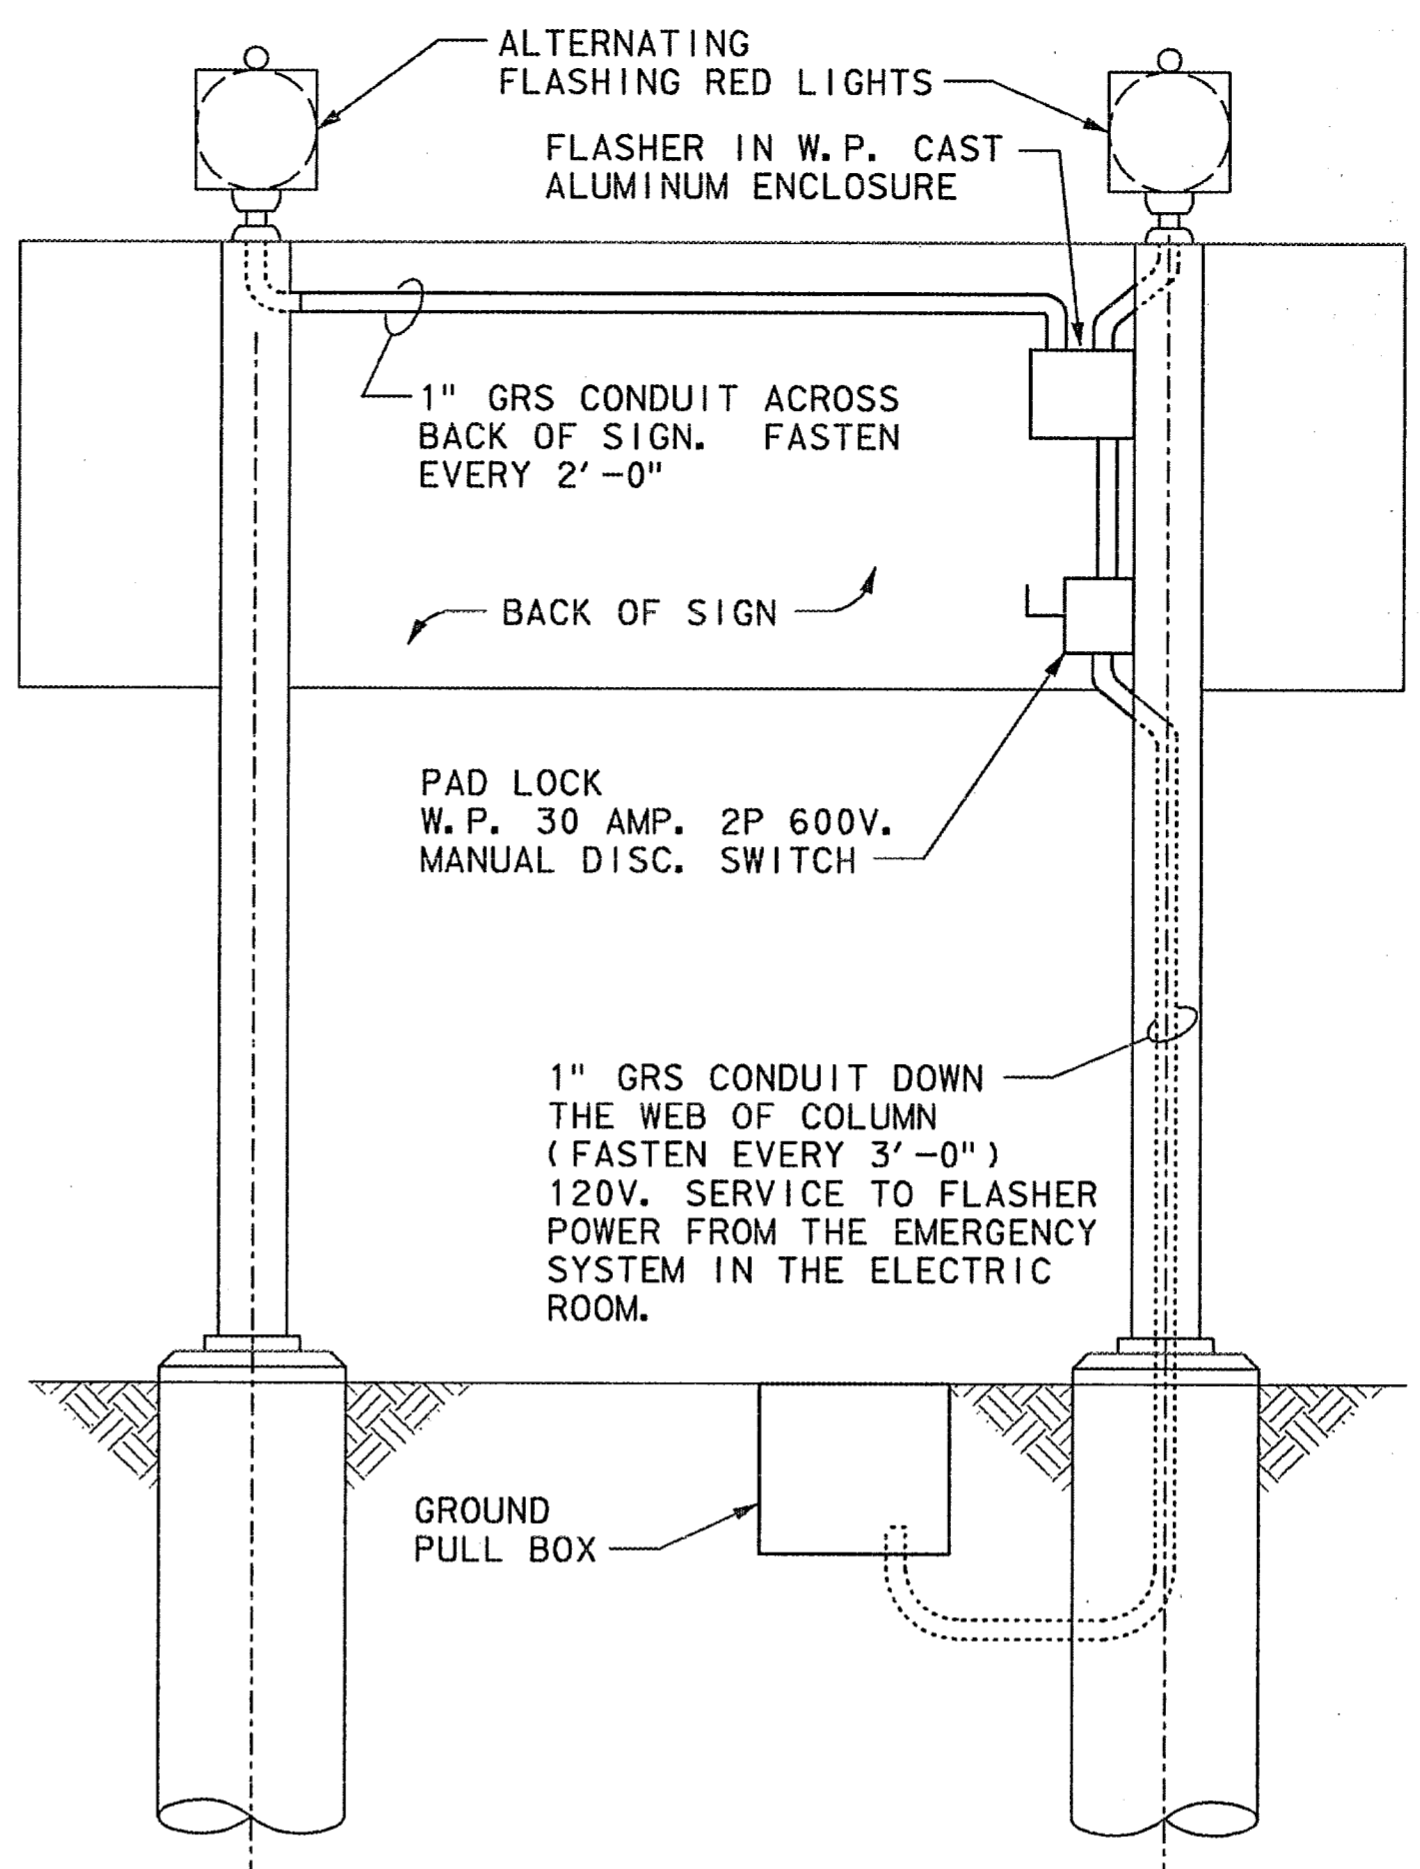


NOTES:  
1. SIGN, COLUMNS, CONCRETE BASES ETC. BY OTHERS.

**WARNING LIGHTS "DO NOT ENTER" SIGN ELECTRICAL DETAIL**

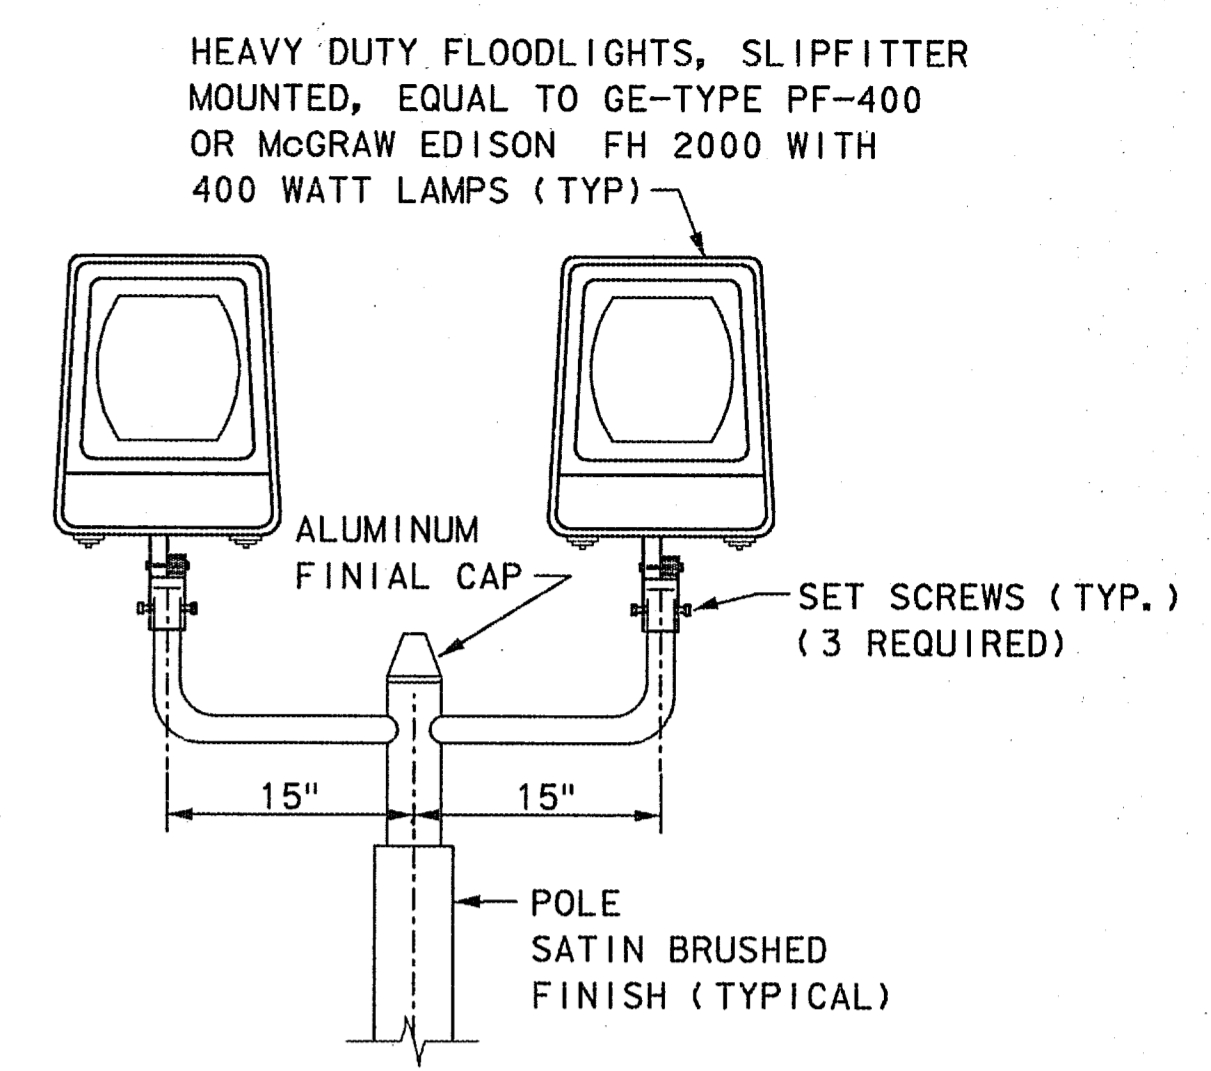

**ELEVATION TYPICAL MAIN TOLL PLAZA LIGHTING UNITS**

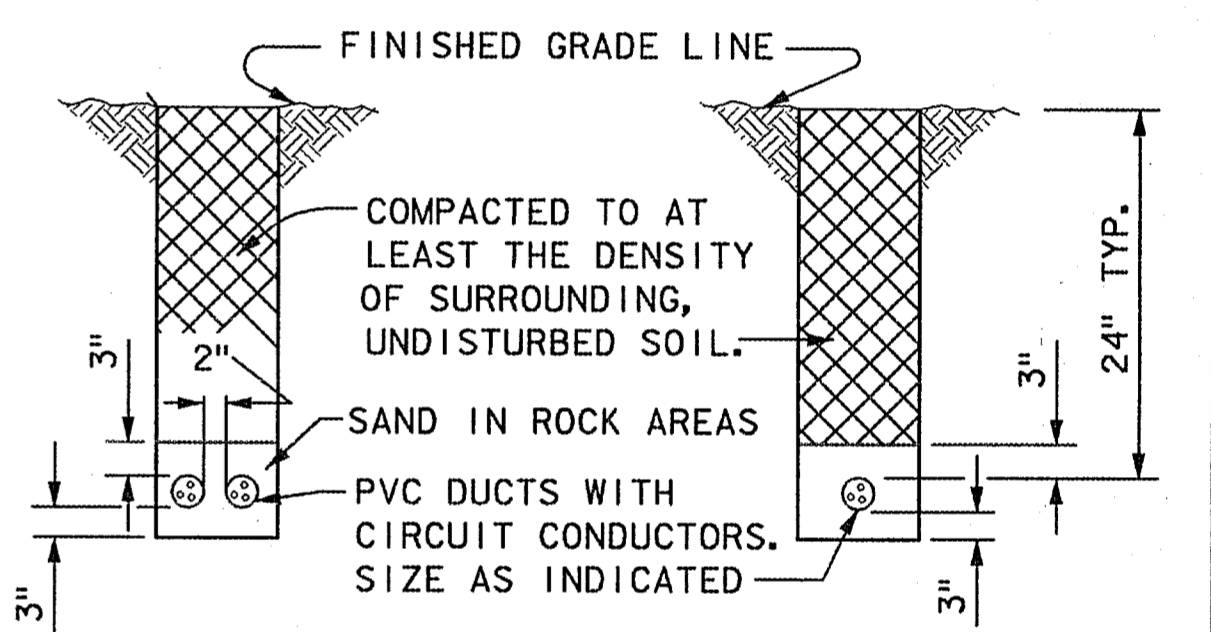

**PVC DIRECT BURIAL DUCT**


NOTES:  
1. IF THE DUCT-CABLE TRENCH EXTENDS INTO ROCK, THE DUCT-CABLE SHALL BE BEDDED IN 3 INCHES OF DAMP SAND AND COVERED WITH 3 INCHES OF DAMP SAND BEFORE BACKFILLING IS STARTED.  
2. IN ROCK, THE DUCT-CABLE BURIAL DEPTH MAY BE REDUCED FROM 24 INCHES TO 18 INCHES, WHERE THIS DUCT IS IN A 3 INCH SAND BED ON TOP OF THE ROCK. BURIAL MAY BE LESS THAN 18 INCHES IF DUCT-CABLE AND SAND BED ARE EMBEDDED TO AN 8 INCH MINIMUM.

THE SEAL APPEARING ON THIS DOCUMENT WAS AUTHORIZED BY RICHARD J. MILLER, P.E. NO. 42812 ON JANUARY 12, 1999. ALTERATION OF A SEALED DOCUMENT WITHOUT PRIOR NOTIFICATION TO THE RESPONSIBLE ENGINEER IS AN OFFENSE UNDER THE TEXAS ENGINEERING PRACTICE ACT.




**FINAL RECORD DRAWING**  
Date: 12/25/99


No.	REVISION	BY	DATE
NORTH TEXAS TOLLWAY AUTHORITY ADDISON AIRPORT TUNNEL			
MISCELLANEOUS ELECTRICAL DETAILS			
<b>MCE</b> MATED CONSULTING ENGINEERS, INC. 5519 PETERSON LANE SUITE 225 DALLAS, TEXAS 75240 (972) 933-6100			
DRAWN: SAA	DATE: 5/97	DESIGNED: DR	DATE: 5/97
CHECKED: RJM	DATE: 5/97	SCALE: NONE	
CONTRACT No. DNT-260 SHEET 25 OF 52			

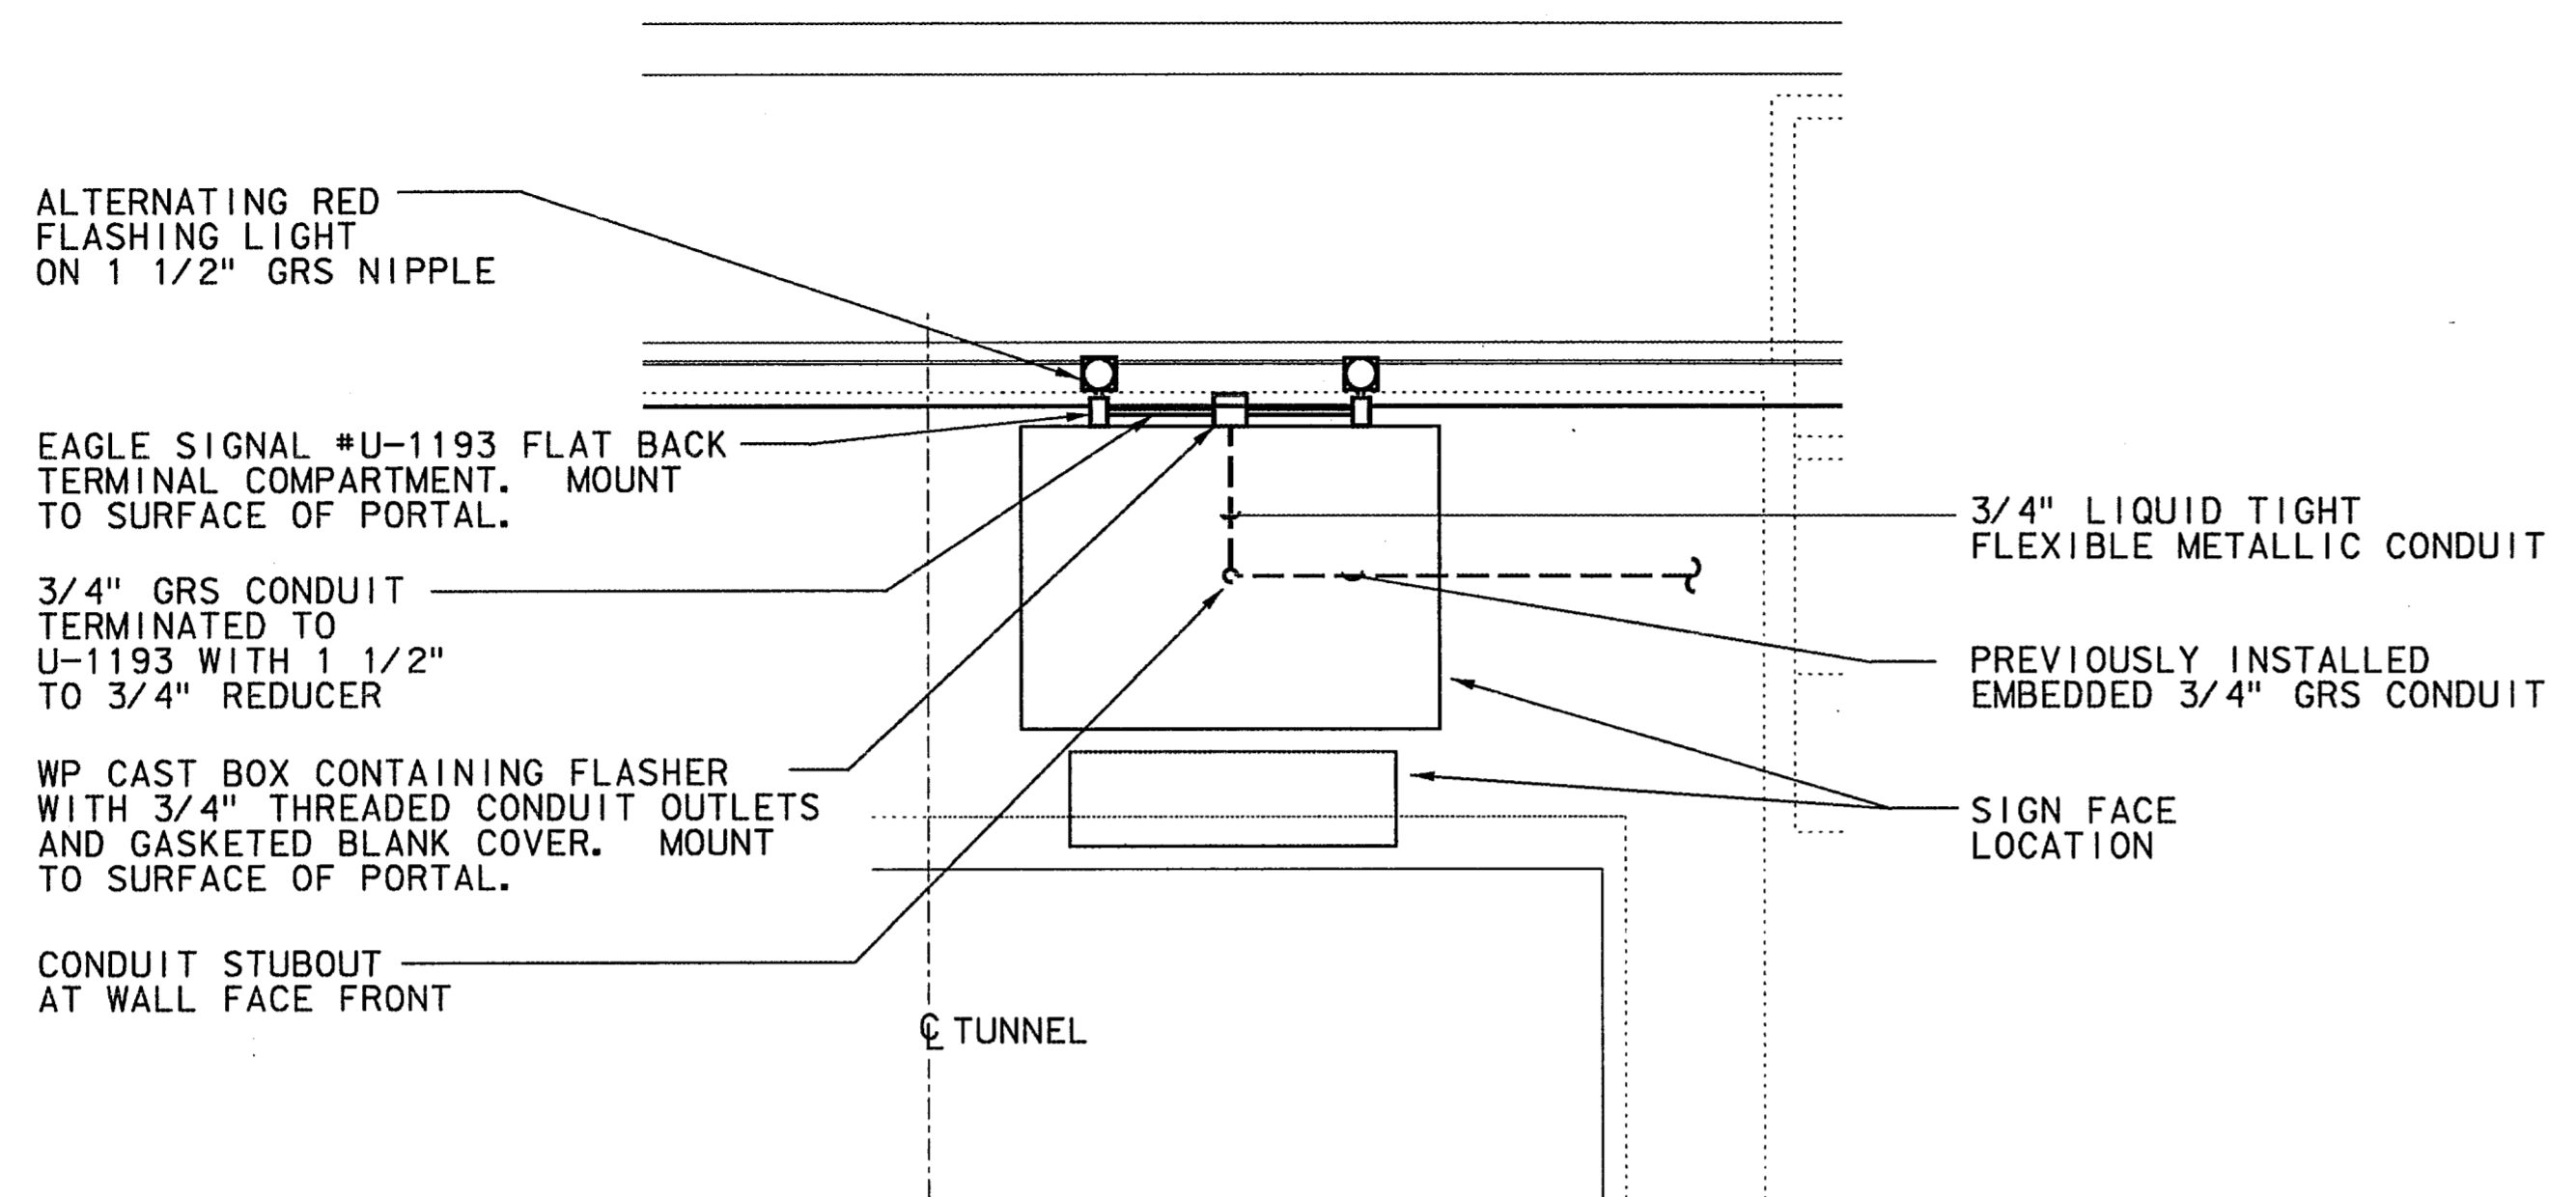

INSTALLATION DETAIL OF ALTERNATING RED FLASHING LIGHTS ON WEST PORTAL SIGN

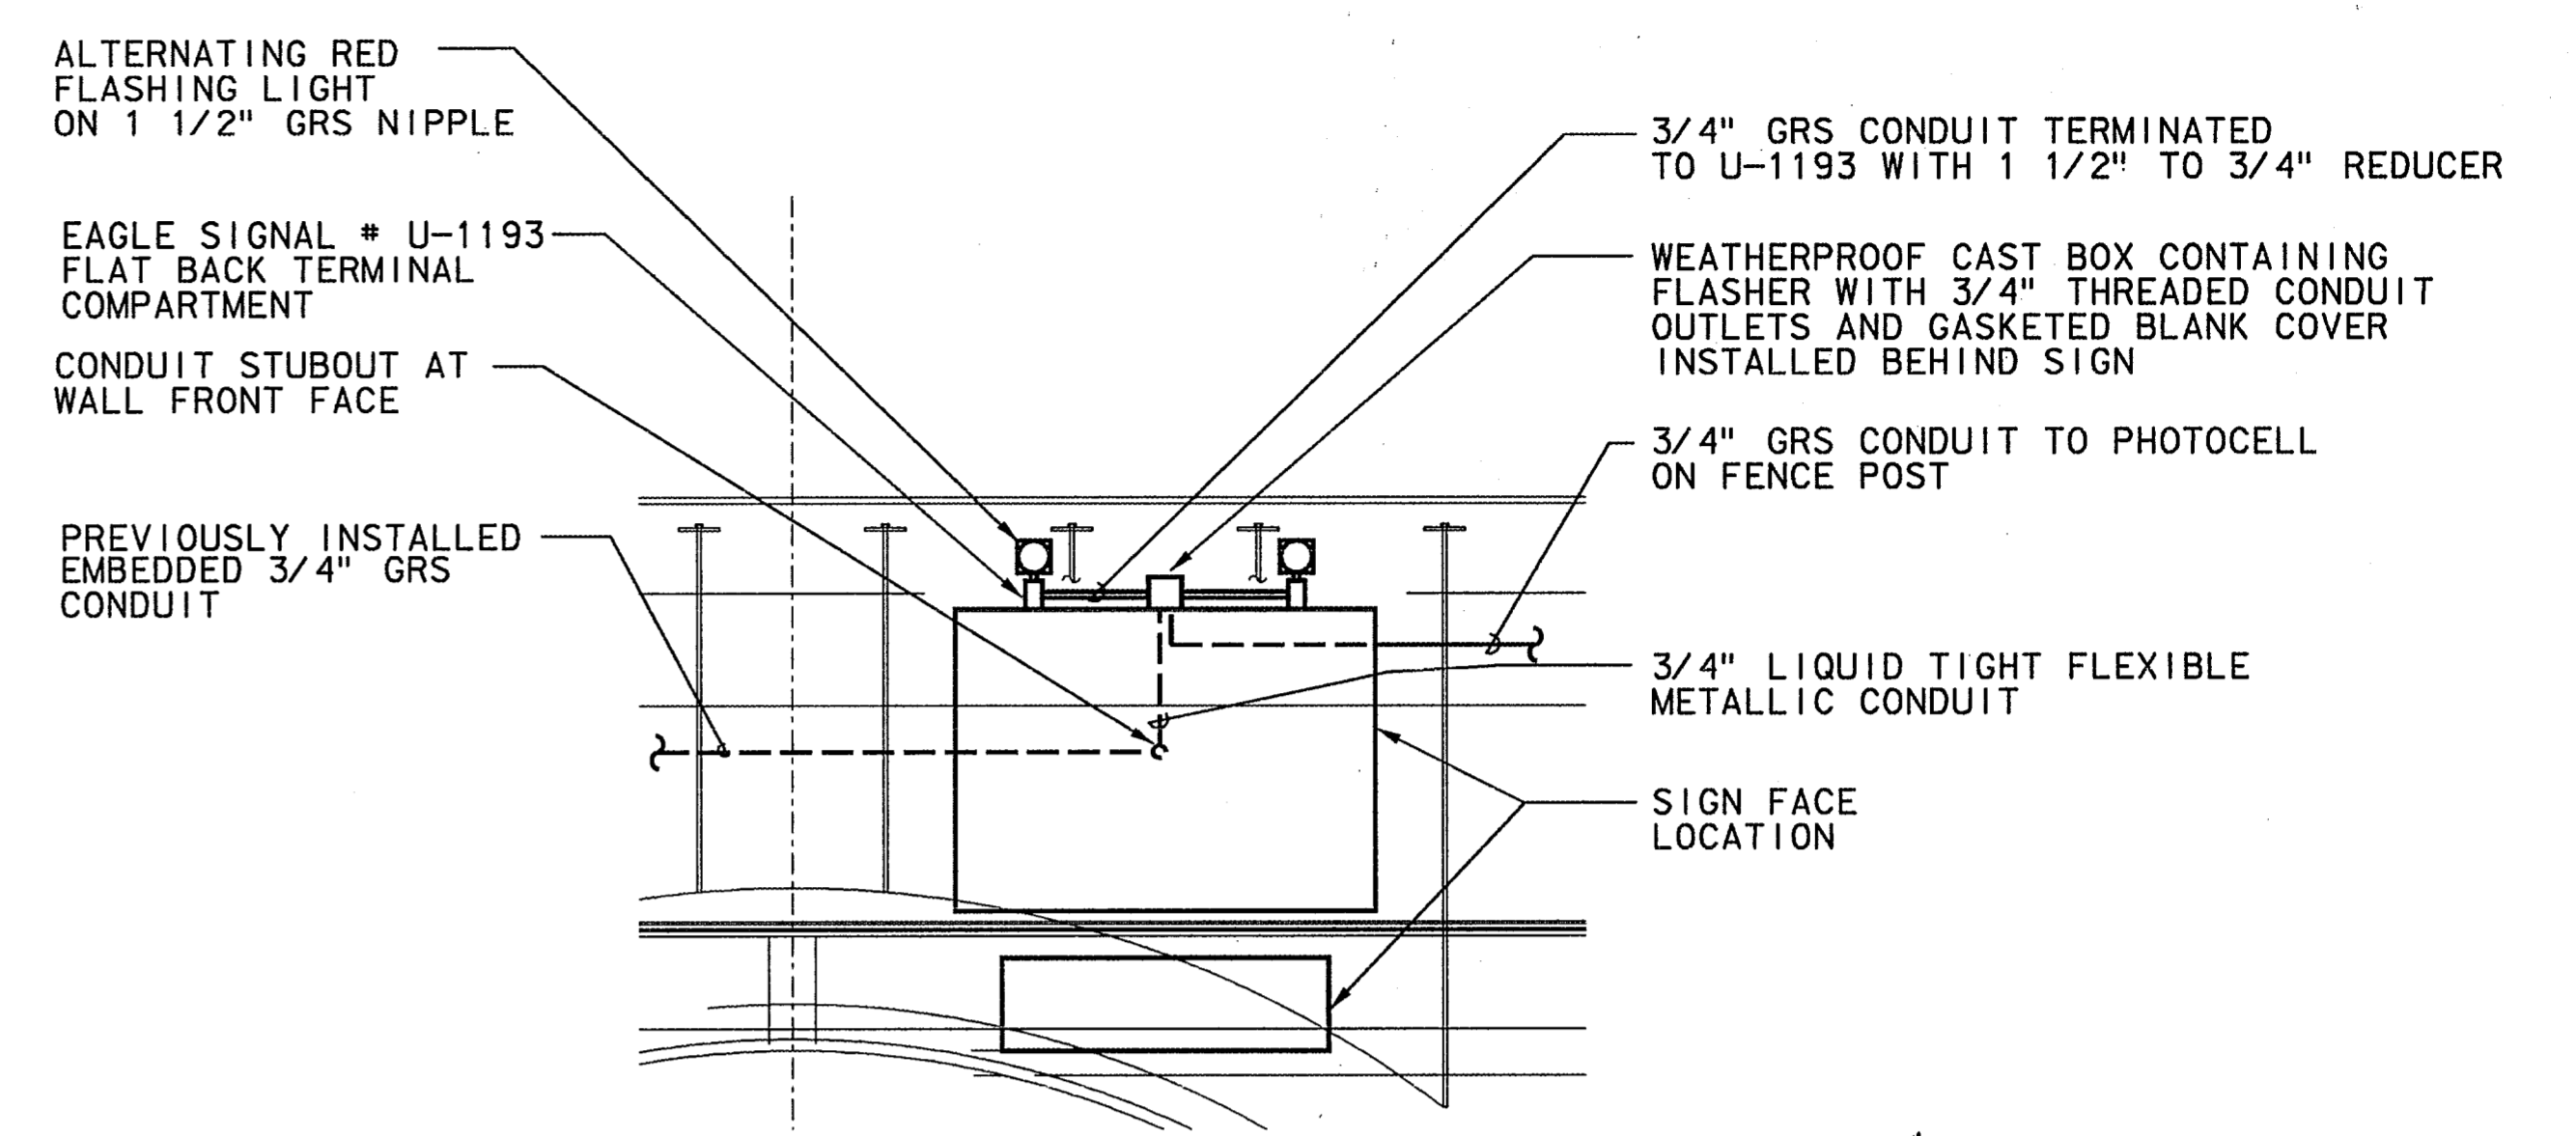

INSTALLATION DETAIL OF ALTERNATING RED FLASHING LIGHTS ON EAST PORTAL SIGN  
NOT TO SCALE

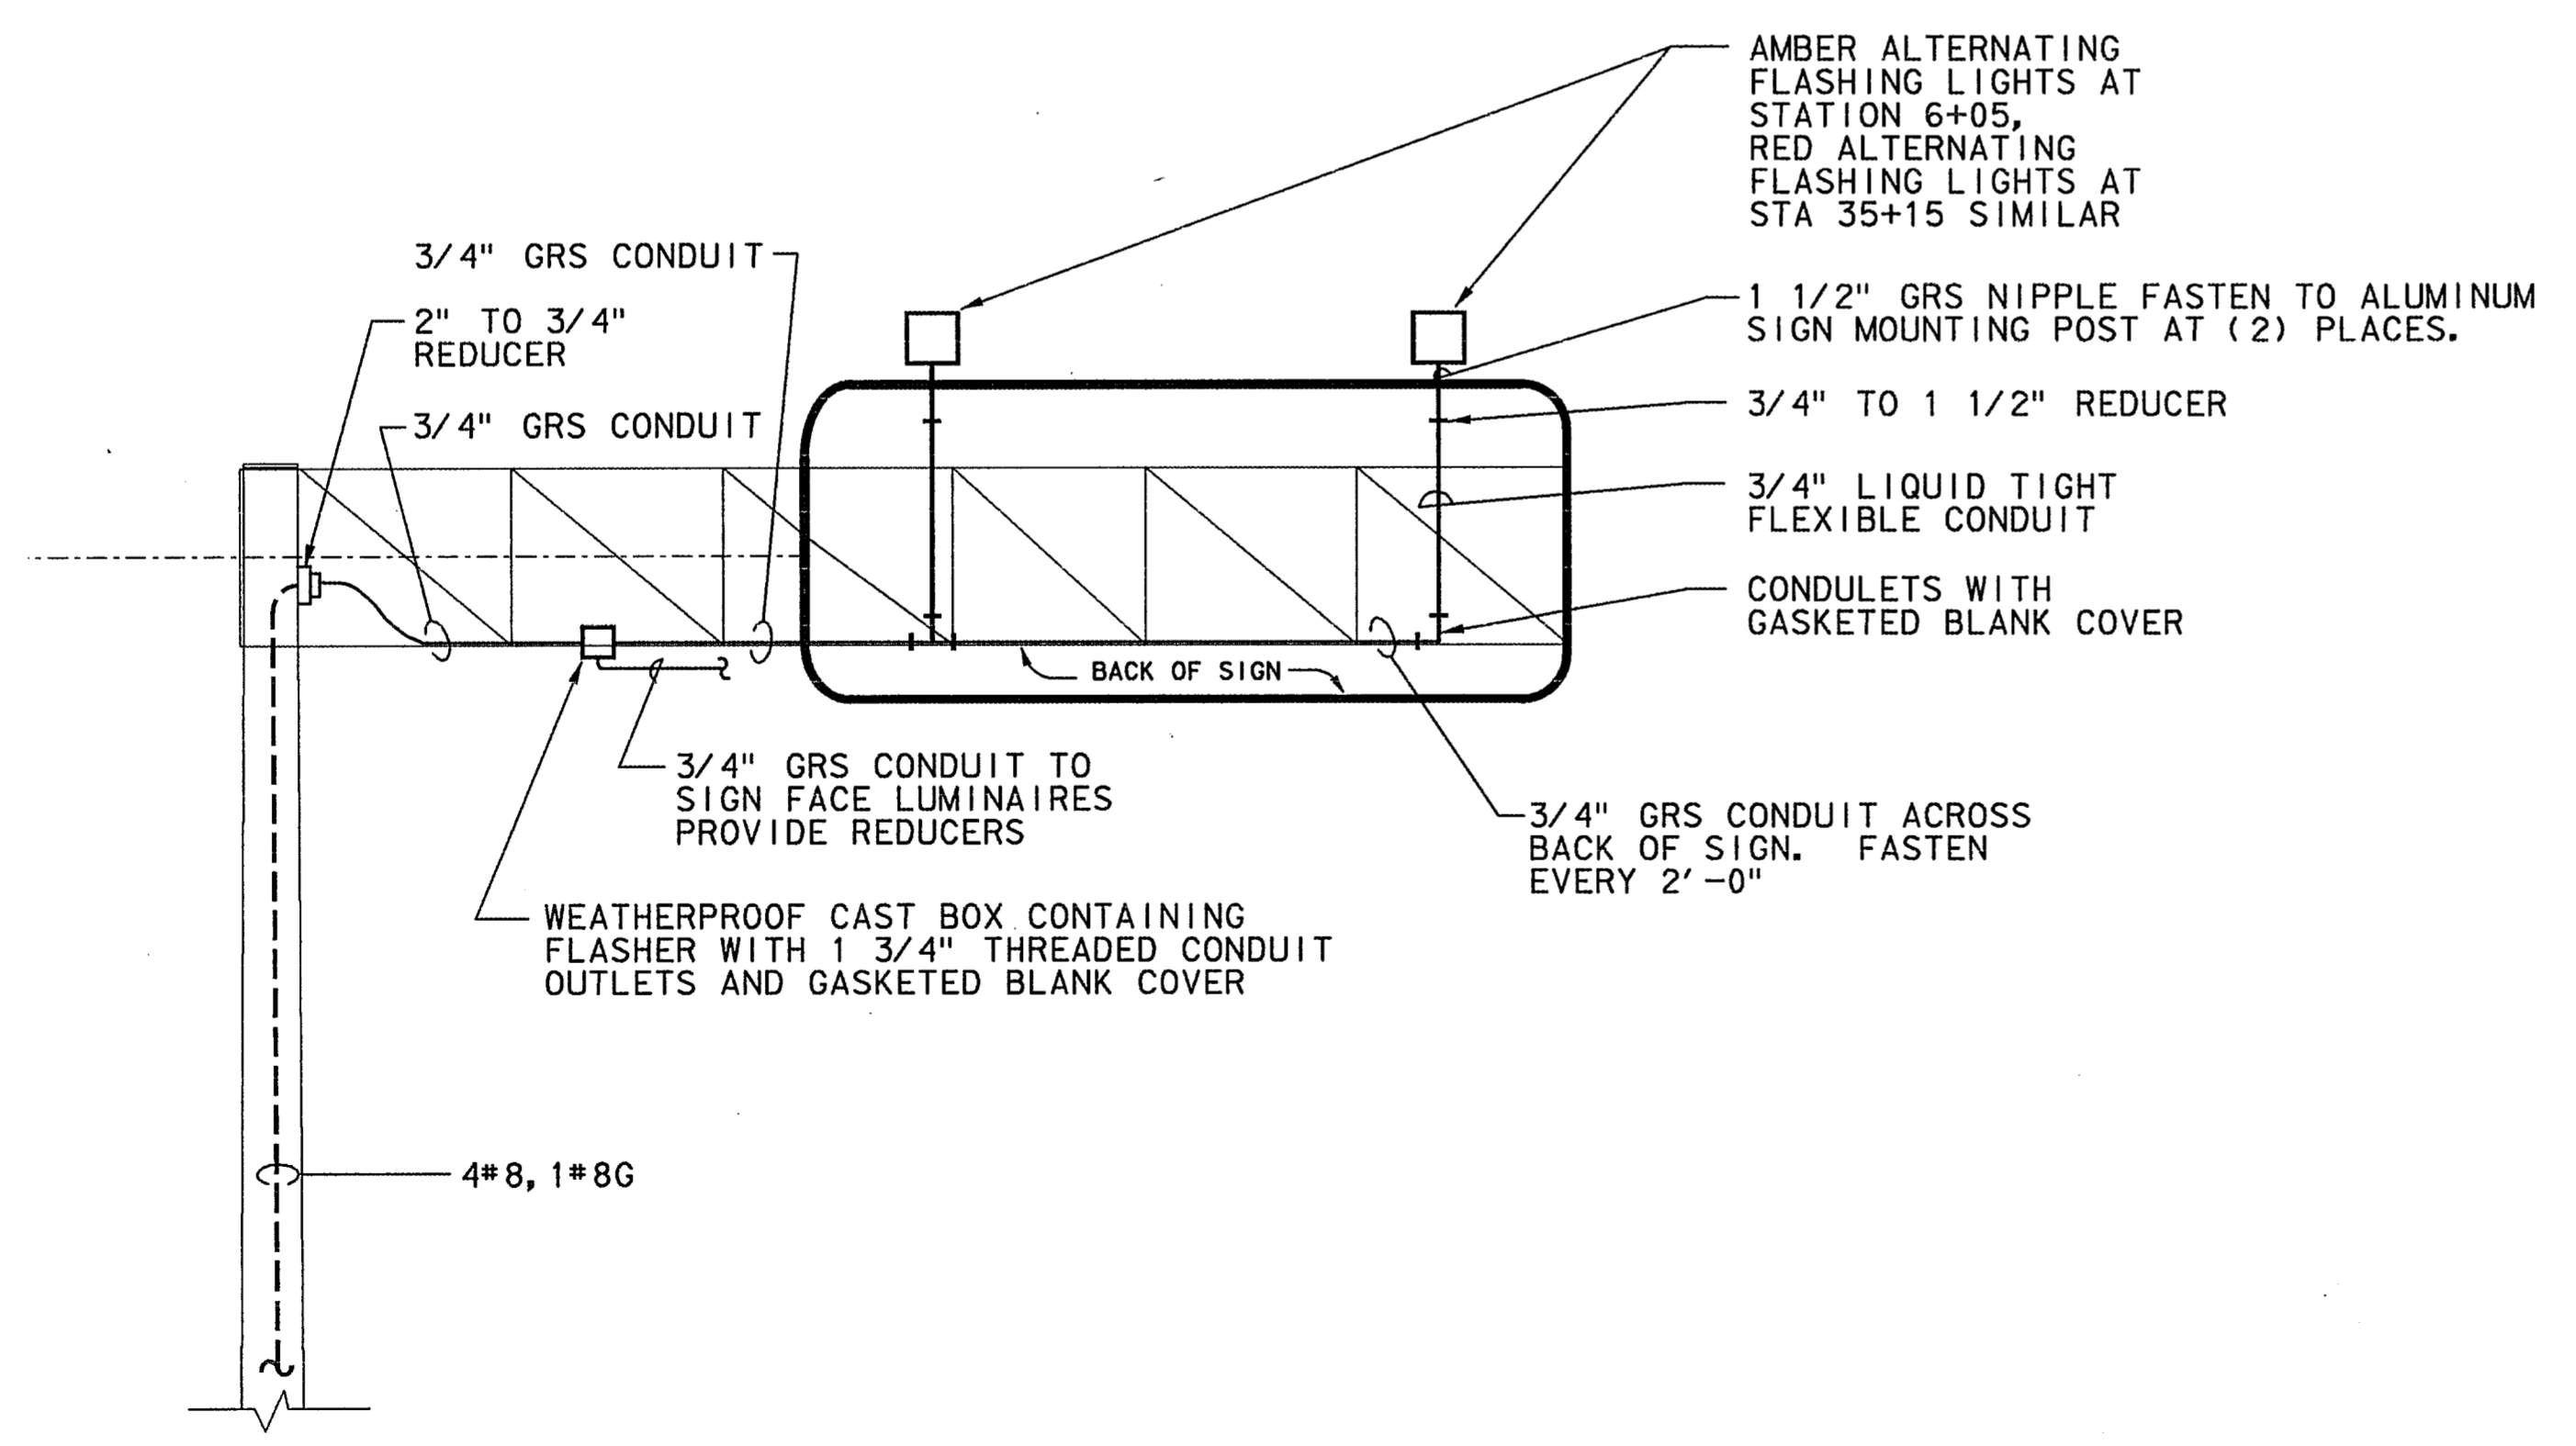

INSTALLATION DETAIL OF ALTERNATING FLASHING LIGHT AT SIGN STRUCTURE ON STEEL POLE  
NOT TO SCALE

**NOTES:**

1. INSTALL FLASHING LIGHTS, FLASHER AND SIGNS FURNISHED BY THE AUTHORITY.
2. FASTEN ALL CONDUIT RUNS.







THE SEAL APPEARING ON THIS DOCUMENT WAS AUTHORIZED BY RICHARD J. MILLER, P.E. NO. 42812 ON JANUARY 12, 1999. ALTERATION OF A SEALED DOCUMENT WITHOUT PRIOR NOTIFICATION TO THE RESPONSIBLE ENGINEER IS AN OFFENSE UNDER THE TEXAS ENGINEERING PRACTICE ACT.



No.	REVISION	BY	DATE
NORTH TEXAS TOLLWAY AUTHORITY ADDISON AIRPORT TUNNEL			
MISCELLANEOUS ELECTRICAL DETAILS			
MATED CONSULTING ENGINEERS, INC. 5580 PETERSON LANE SUITE 225 DALLAS, TEXAS 75240 (972) 235-6700			SECTION XIII
DRAWN: SAA	DATE: 5/97	DESIGNED: DR	DATE: 5/97
CHECKED: RJM	DATE: 5/97	SCALE: AS SHOWN	
CONTRACT No. DNT-260 SHEET 26 OF 52			








**FINAL RECORD  
DRAWING**  
Date: 12/25/99



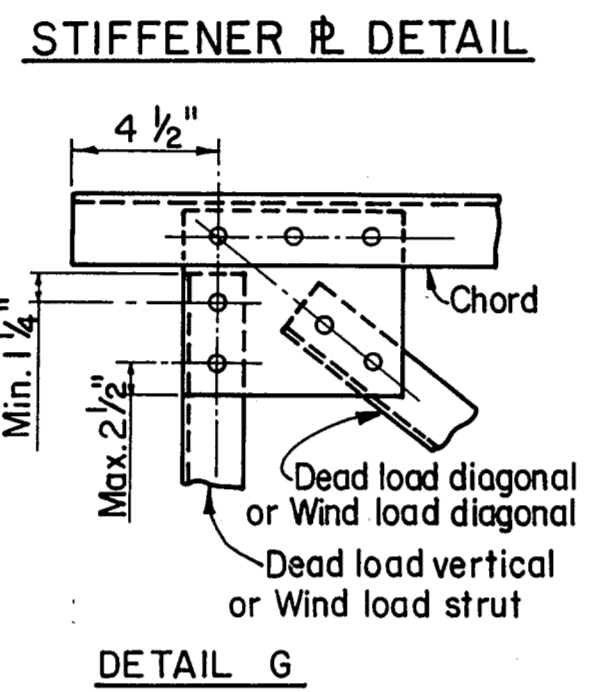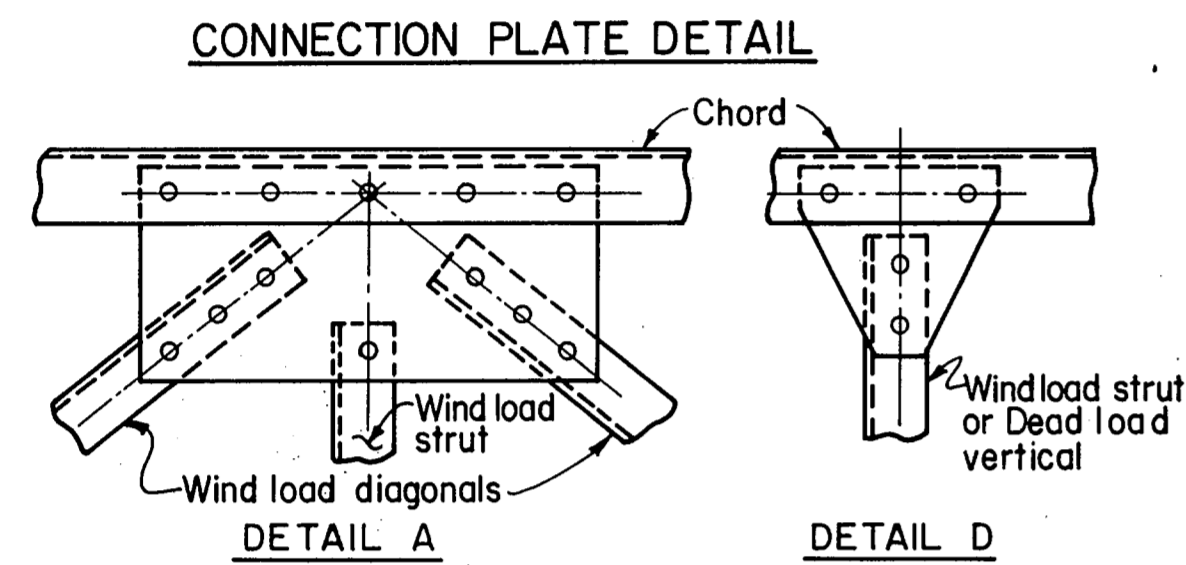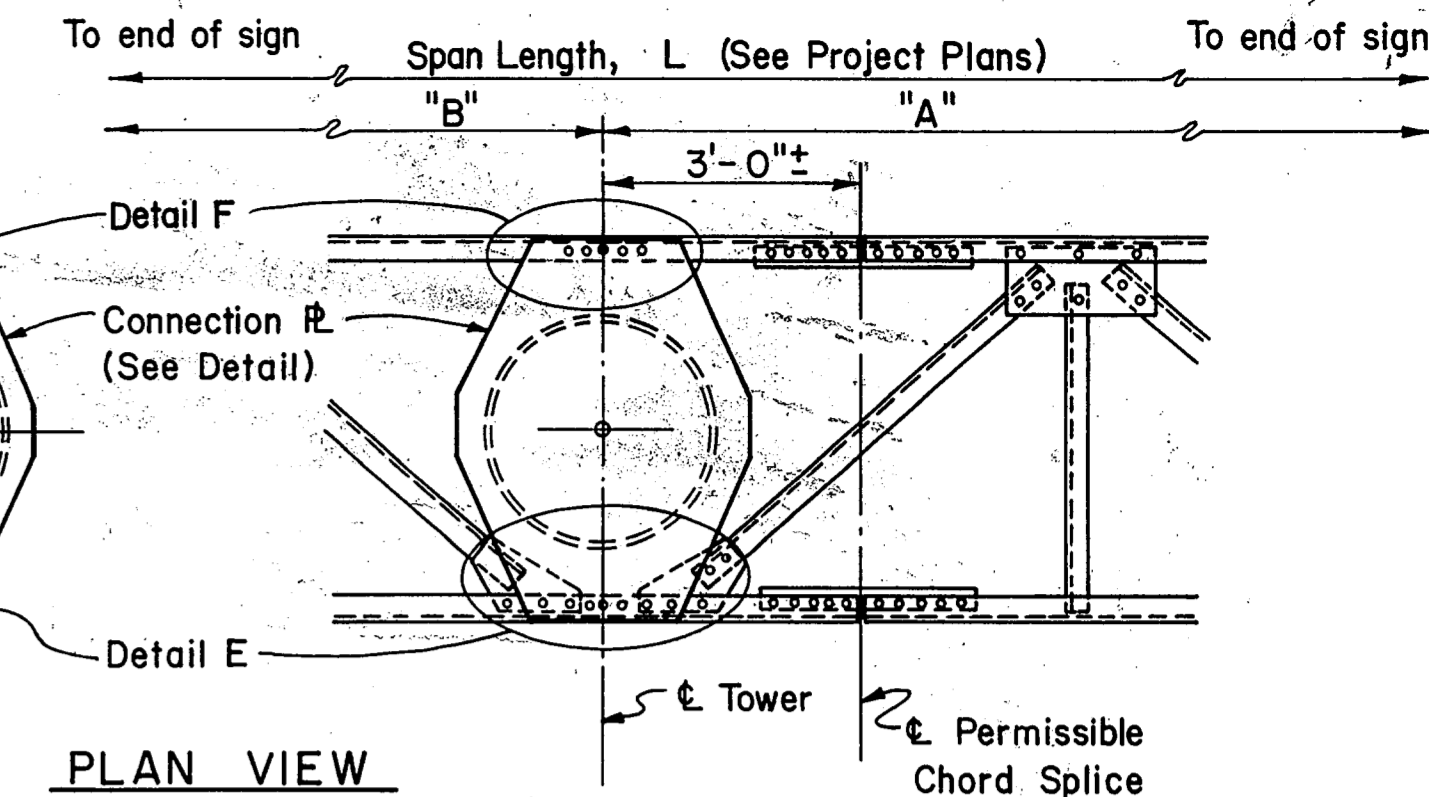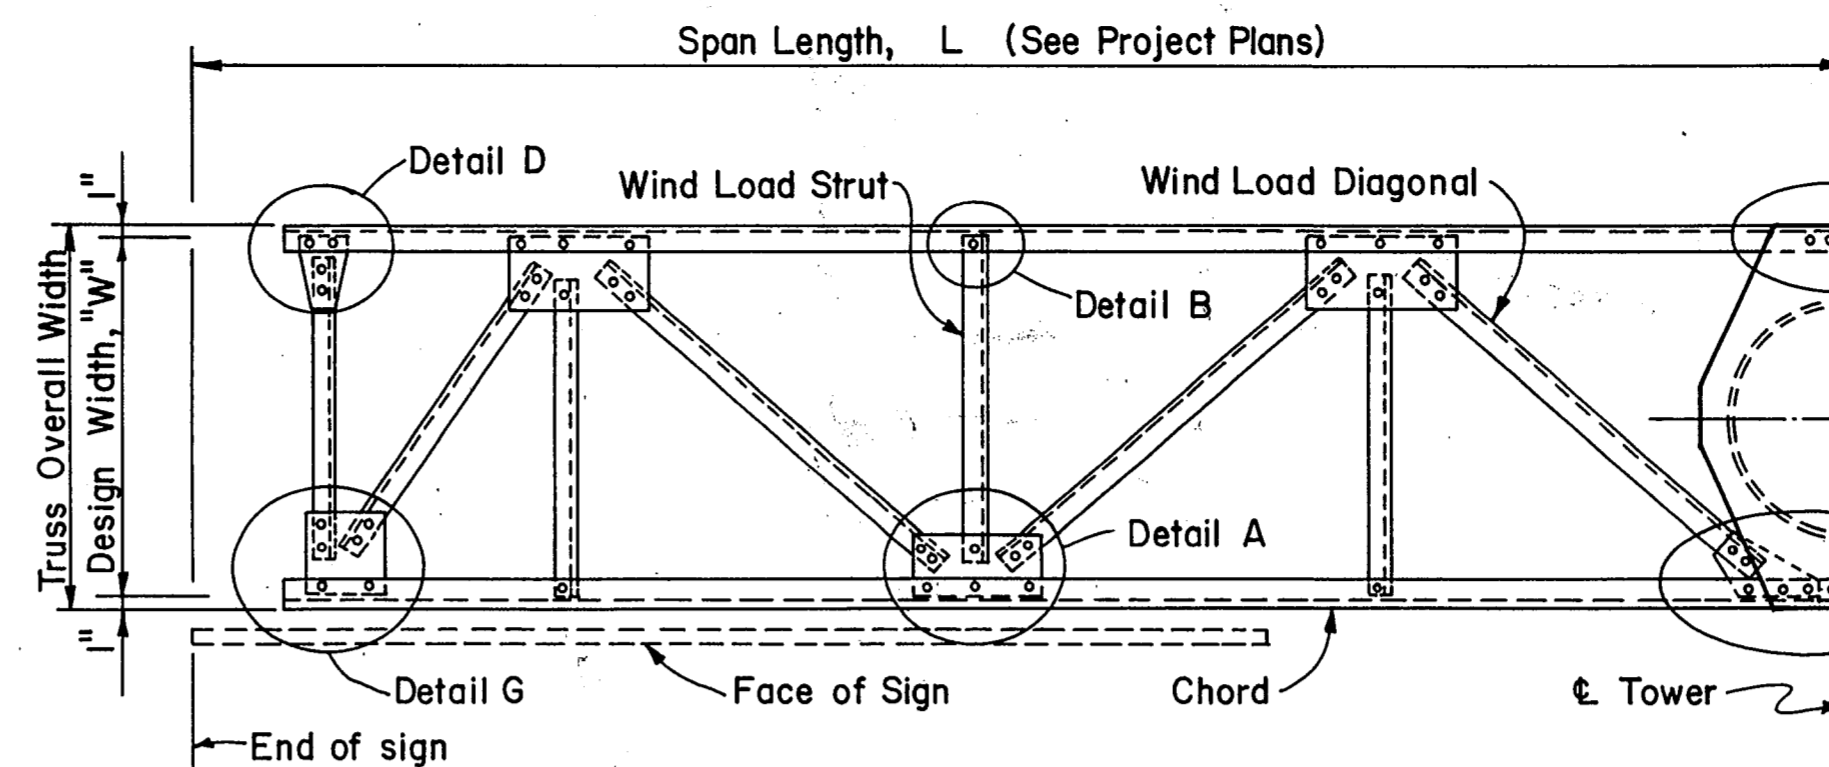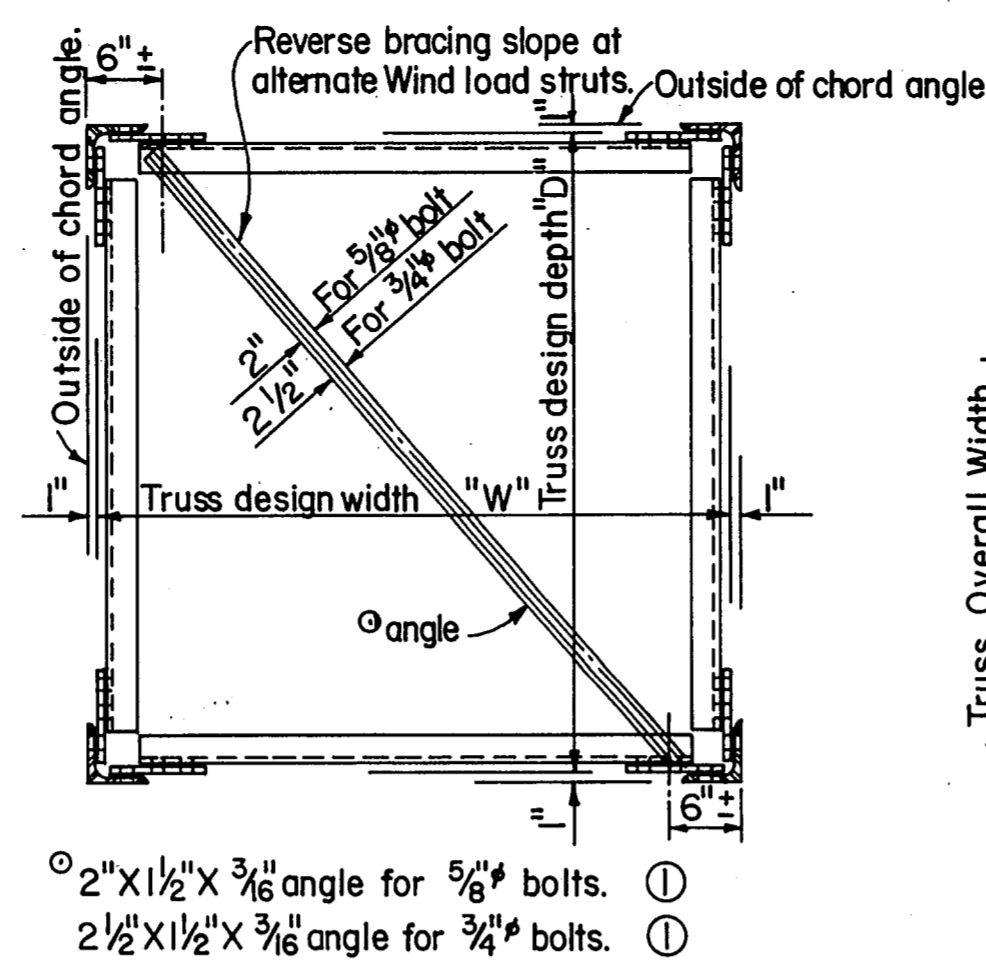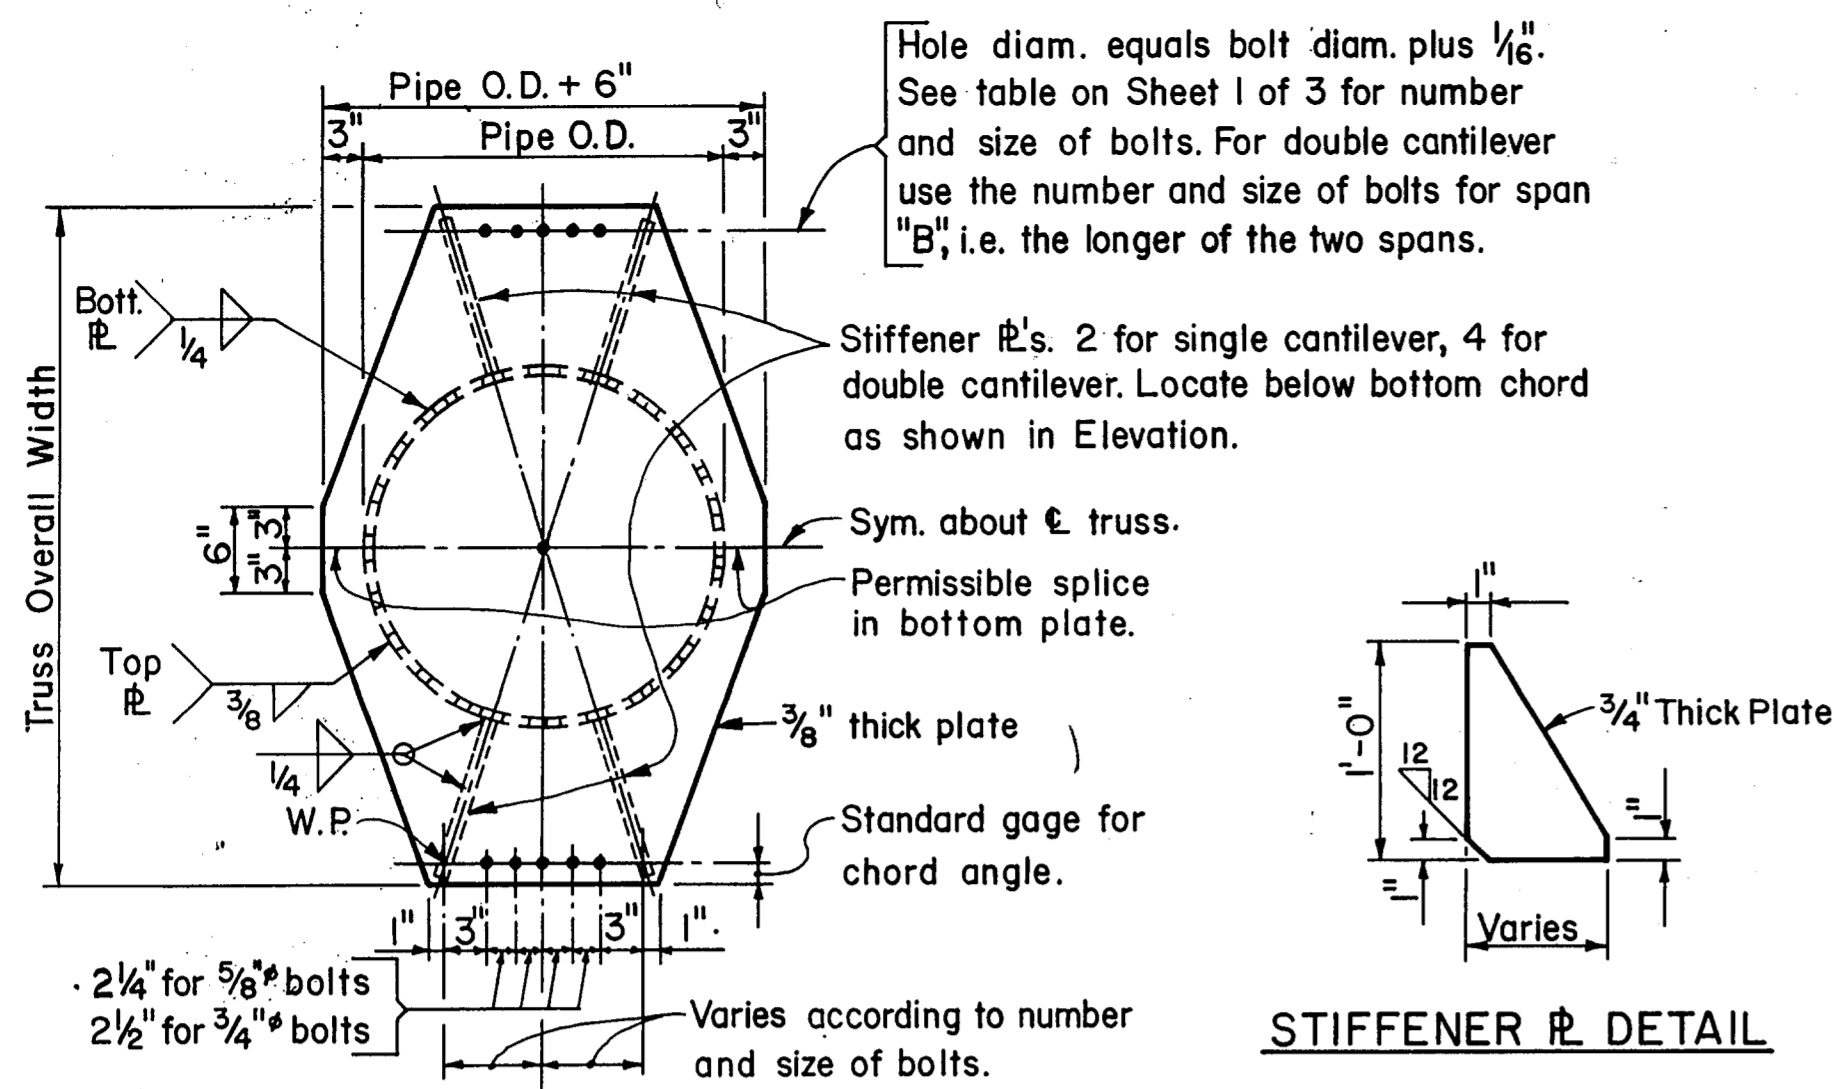

**TRUSS SECTION (DIAGONALS NOT SHOWN)**

TOTAL NO. OF BOLTS IN JOINT IN DIAGS.	NO. OF BOLTS REQD. IN GUSSET TO CHORD CONNECTION
0	2
2	2
3	3
4	3
5	4
6	4
8	5
10	6

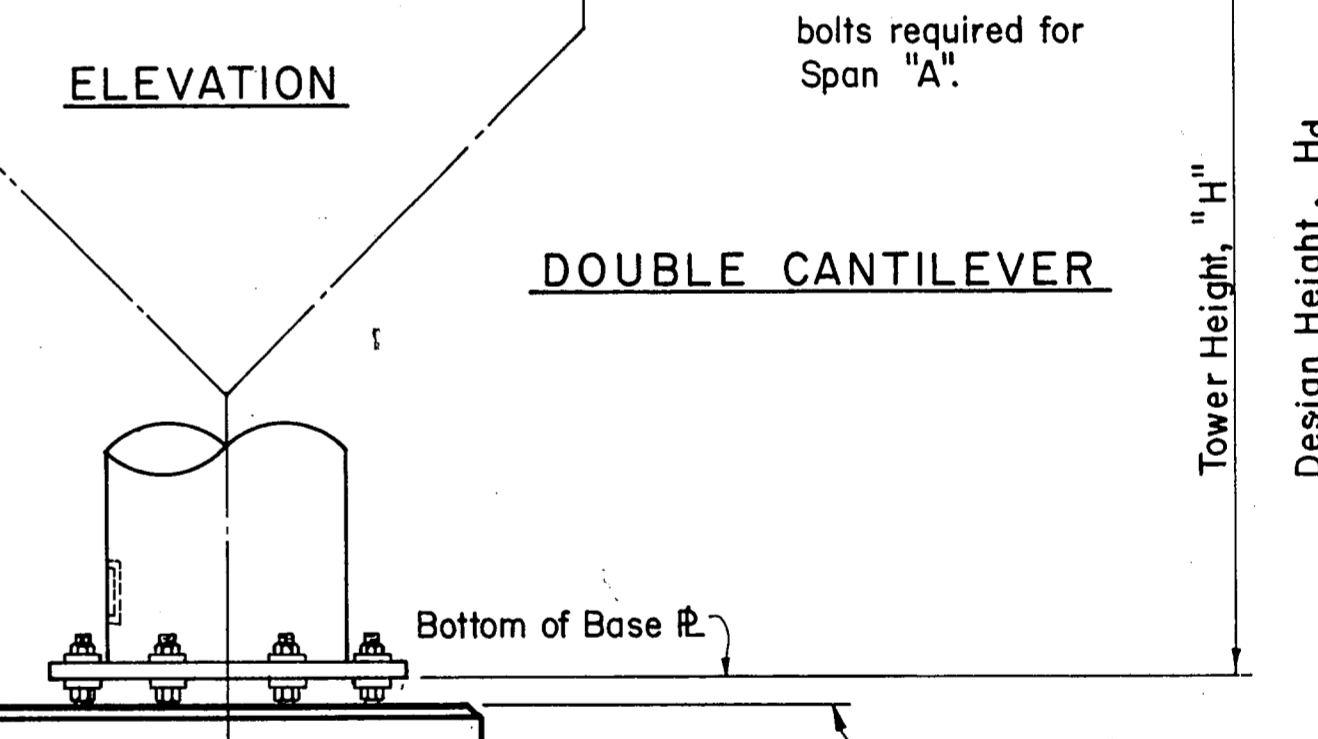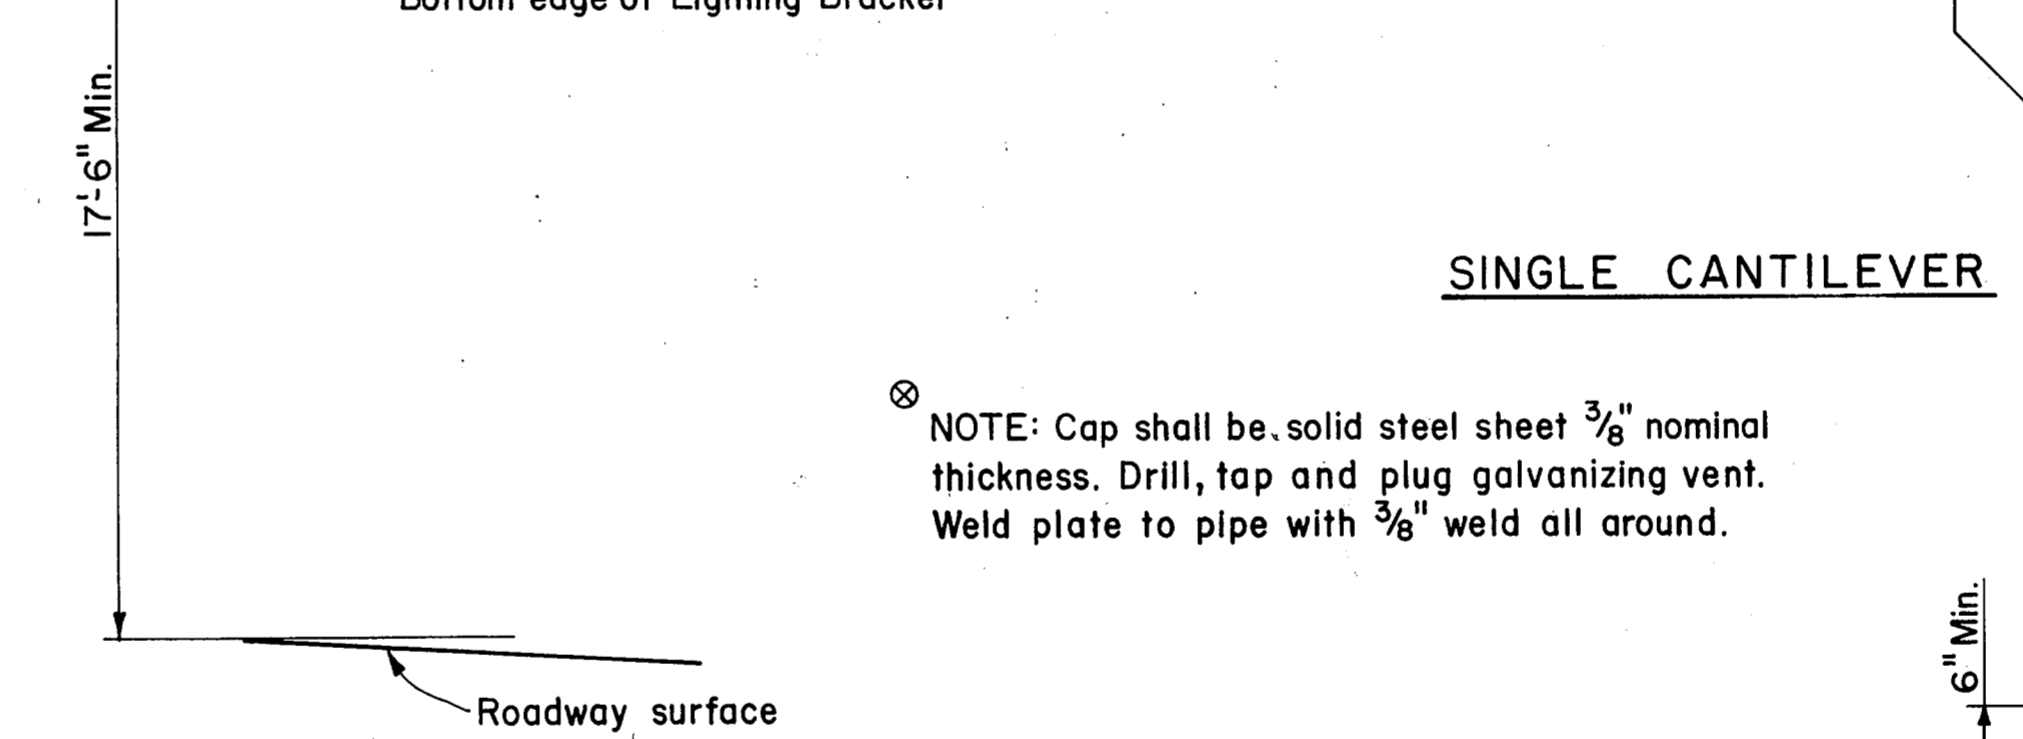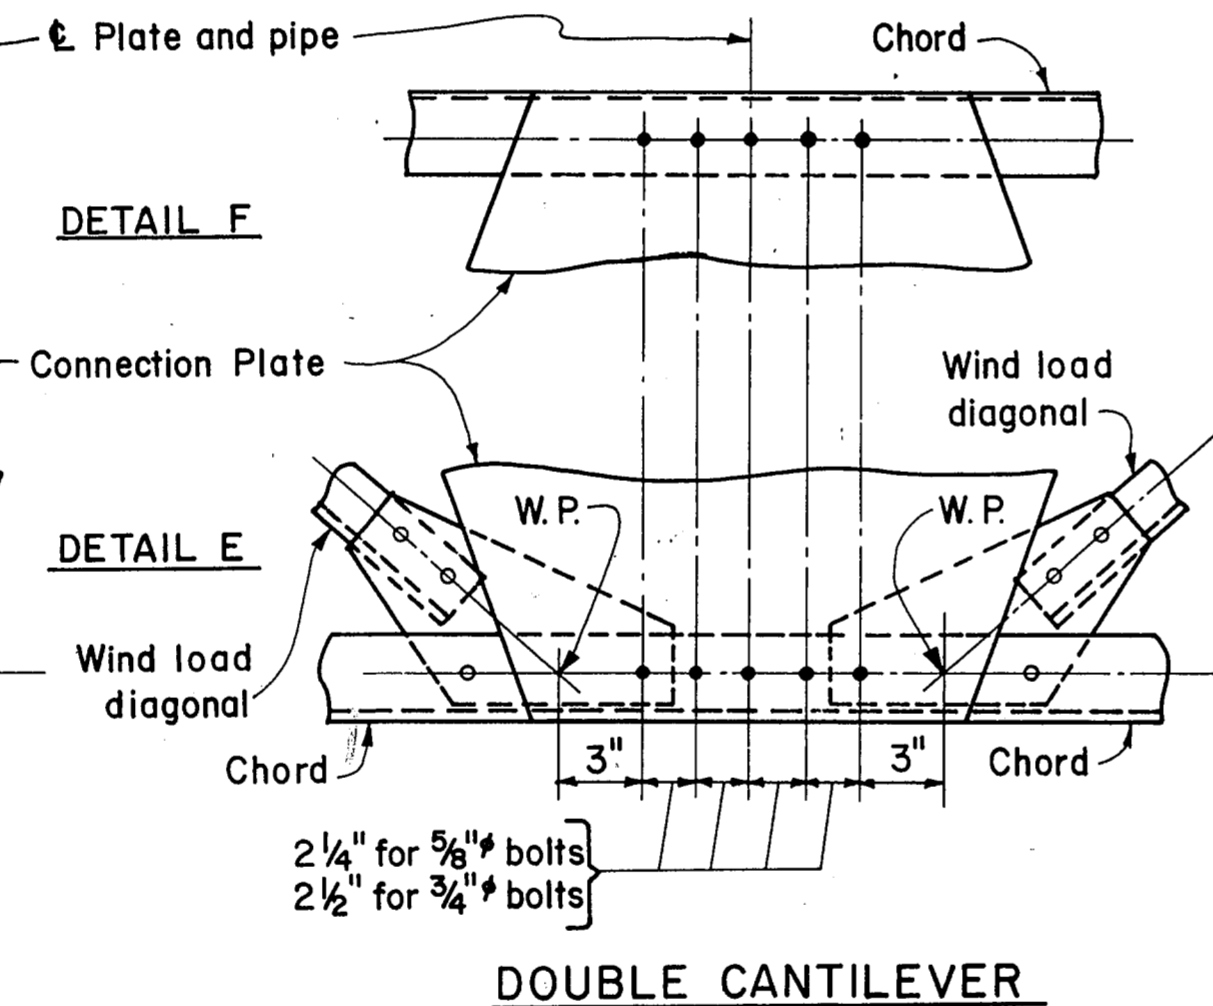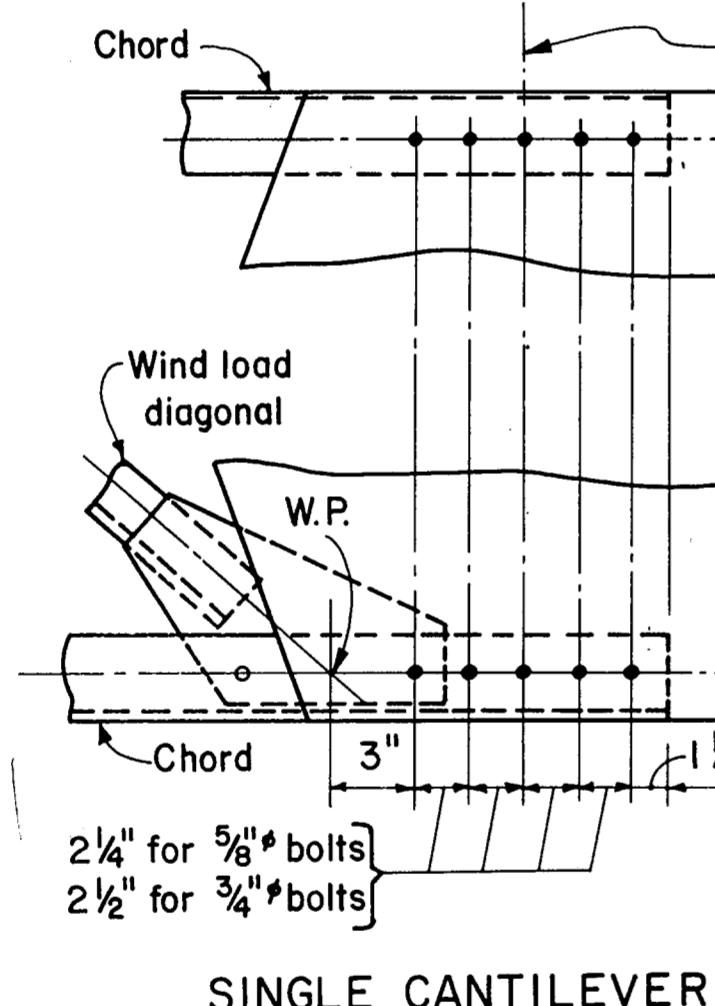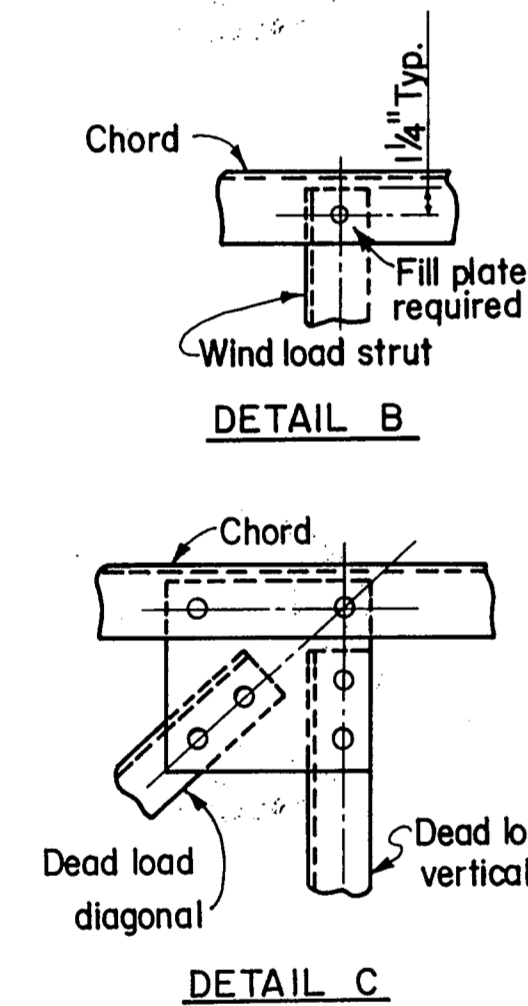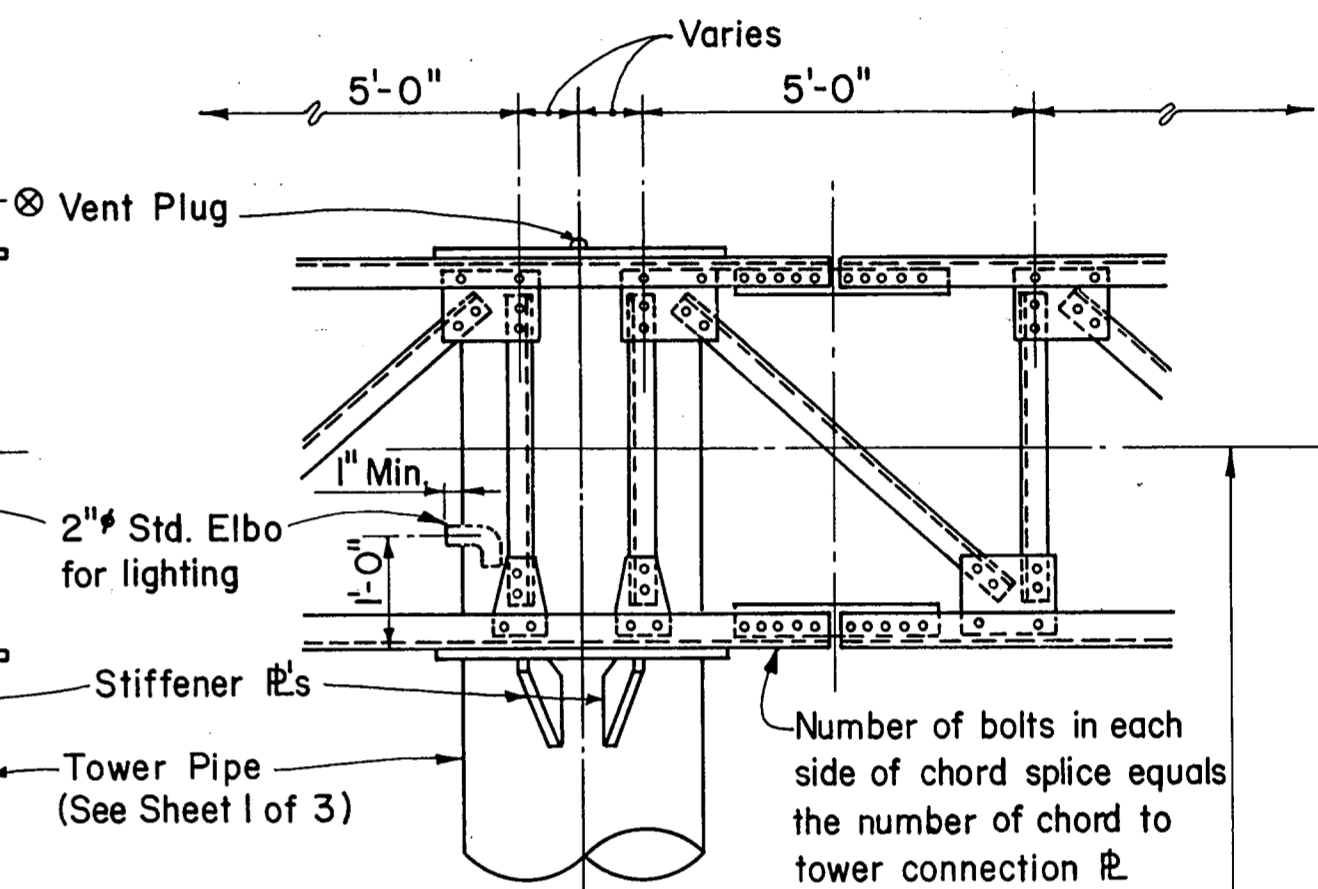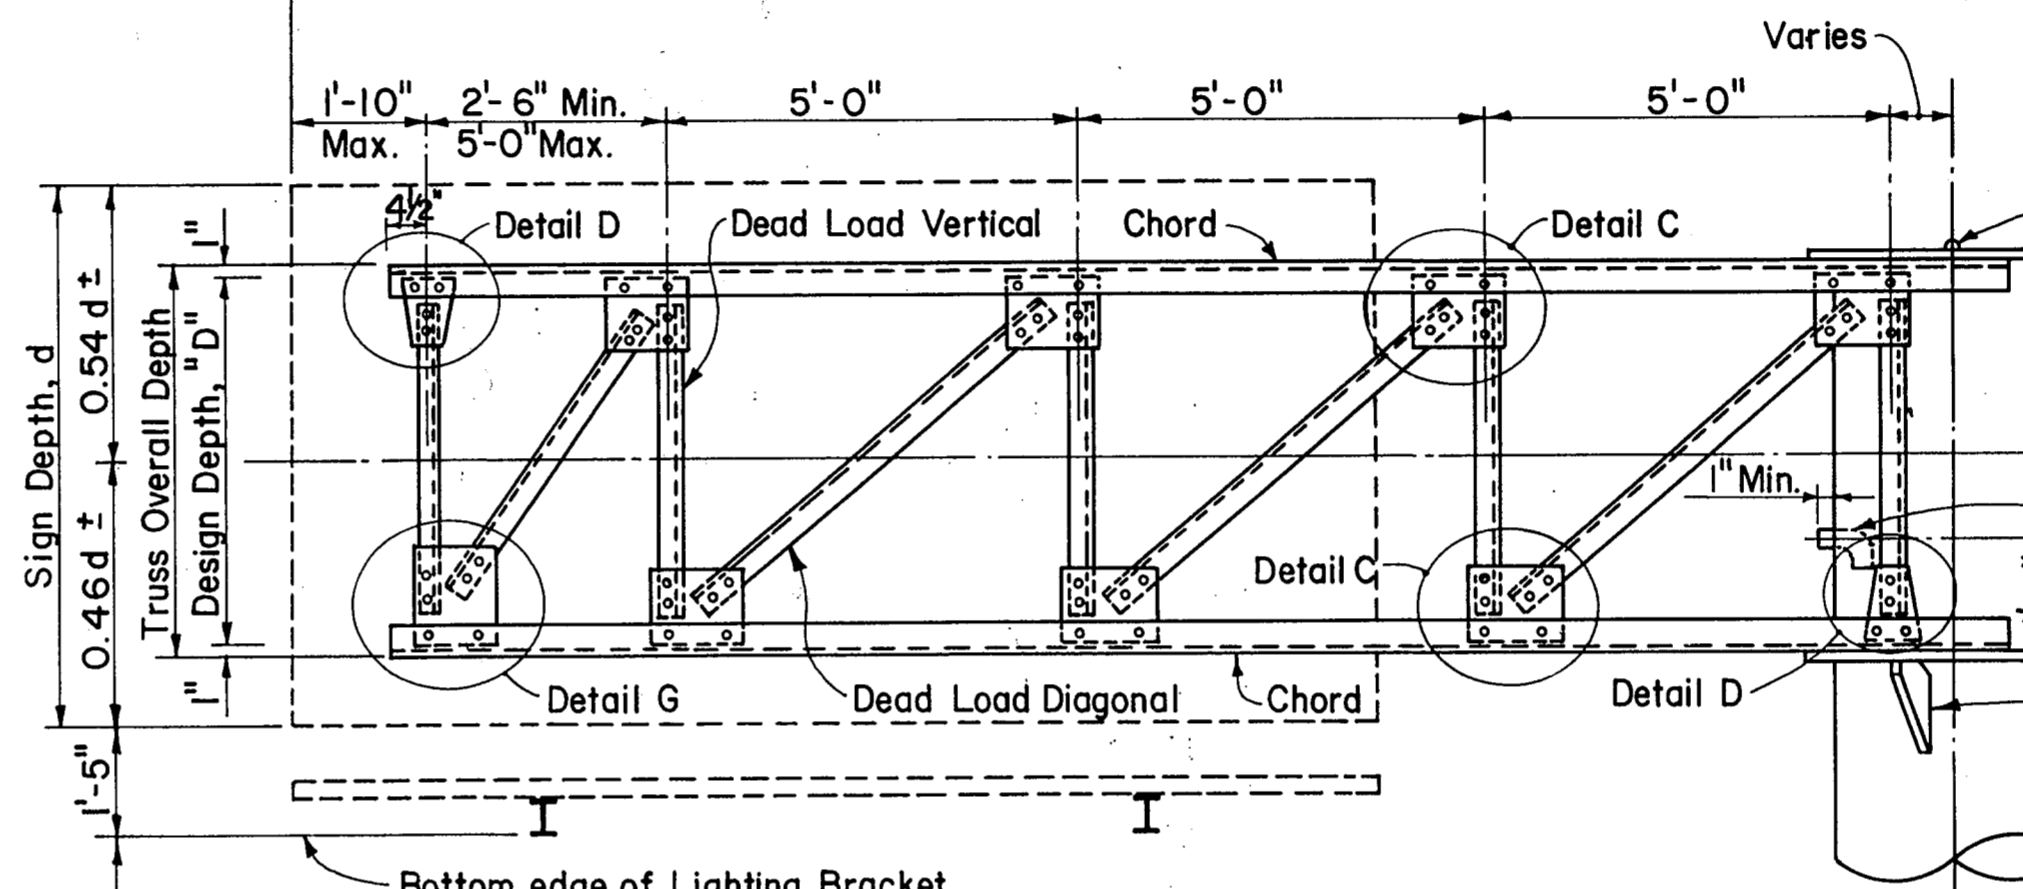

NOTE: Cap shall be solid steel sheet  $\frac{3}{8}$ " nominal thickness. Drill, tap and plug galvanizing vent. Weld plate to pipe with  $\frac{3}{8}$ " weld all around.




See Sheet 3 of 3 for Hand Hole, Base R, Anchor Bolt and Foundation Details.

GENERAL NOTES:  
 Design conforms to 1975 AASHTO Standard Specifications for Structural Supports for Highway Signs, Luminaires and Traffic Signals and Interim revisions thereto. Connection details are typical only. Actual size of member and number of bolts will vary. The details on this sheet are intended as a guide only. See Sheet 1 of 3 for number of bolts and size of members.  
 Gusset plates to be same thickness as thickest web member in connection.

**\* MINIMUM LENGTH OF  $\frac{3}{16}$ " FILLET WELD REQUIRED**

NUMBER OF BOLTS	TO REPLACE $\frac{5}{8}$ " BOLTS	TO REPLACE $\frac{3}{4}$ " BOLTS
1	2"	3"
2	4"	6"
3	6"	9"
4	8"	11 1/2"
5	10"	14 1/2"
6	12"	17 1/2"
7	14"	20"

**CONNECTION DETAILS**

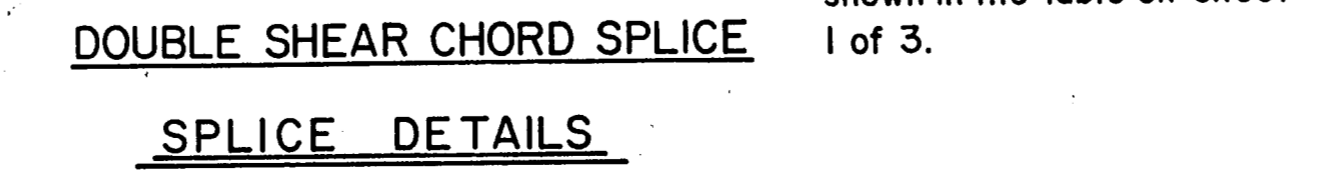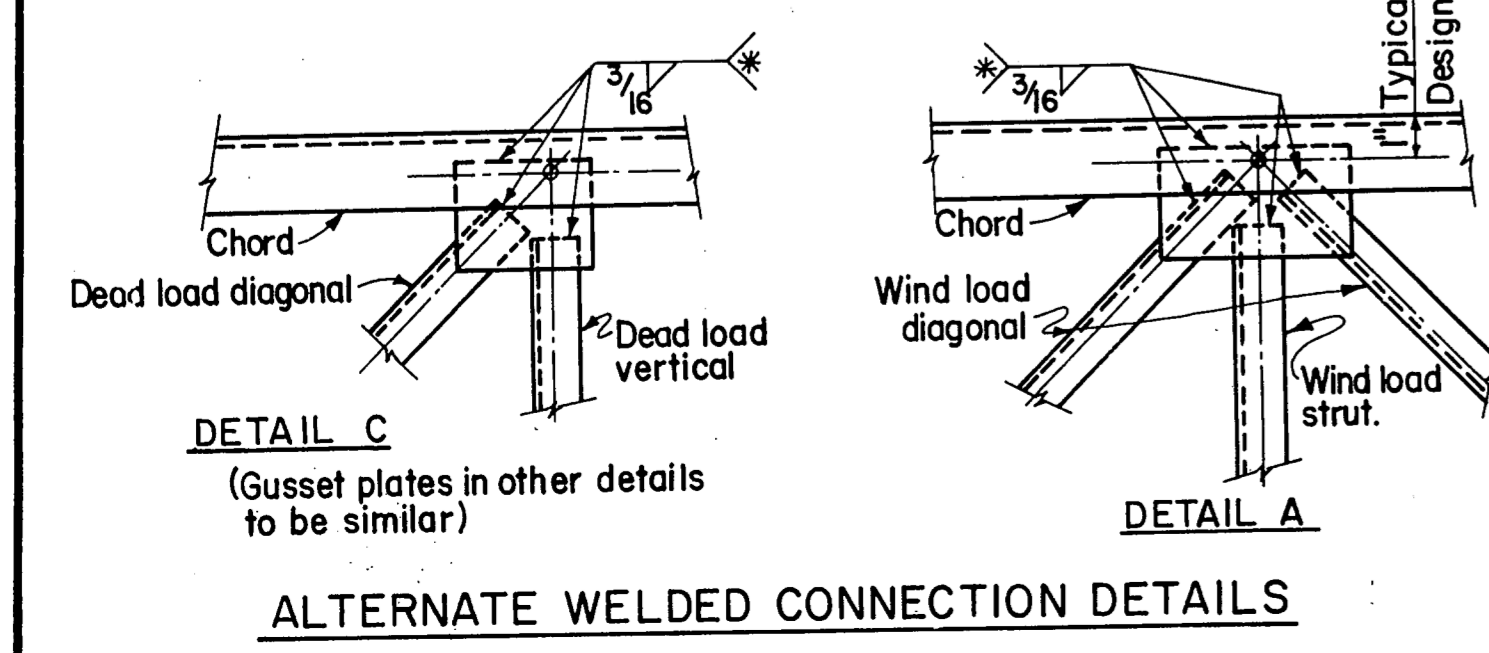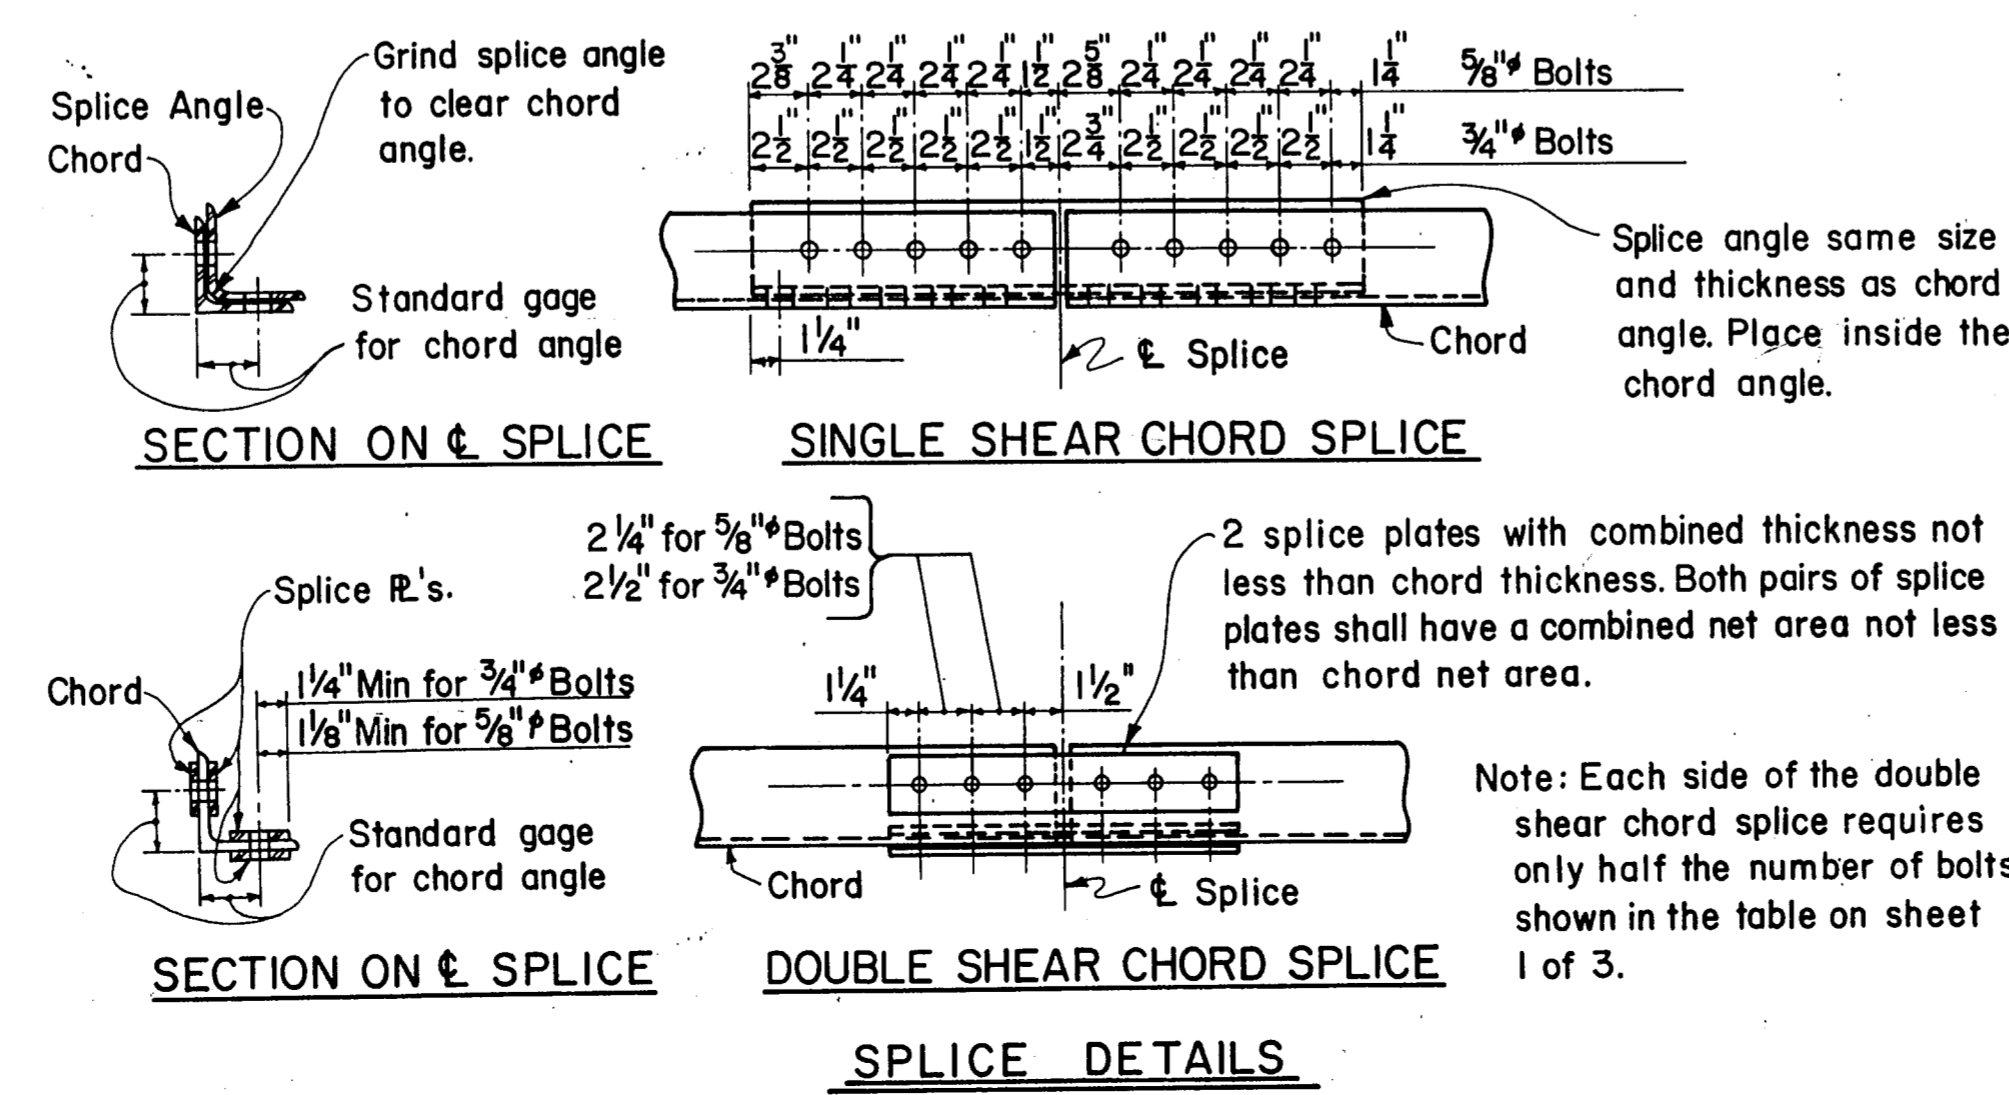

REPRODUCED FROM STATE DEPARTMENT OF HIGHWAYS AND PUBLIC TRANSPORTATION STANDARD DRAWING COSSD

FINAL RECORD DRAWING  
 Date: 12/25/99


NO.	MISC. REVISION	PJ	9-19-91
<b>TEXAS TURNPIKE AUTHORITY</b>			
<b>DALLAS NORTH TOLLWAY</b>			
CANTILEVER OVERHEAD SIGN SUPPORT DETAILS			28
<b>HNTB</b>			
<small>HOWARD NEEDLES TAMMEN &amp; BERENDORFF</small>			
DESIGNED	DATE	DESIGNED	DATE
CHECKED	DATE	SCALE	
STANDARD DRAWING NO. SS-24			

ANCHOR BOLT SIZE	PIPE OUTSIDE DIAMETER											
	16"			20"			24"			30"		
	BOLT CIRCLE DIA.	DR. SHAFT SIZE	DR. SHAFT REINF.	BOLT CIRCLE DIA.	DR. SHAFT SIZE	DR. SHAFT REINF.	BOLT CIRCLE DIA.	DR. SHAFT SIZE	DR. SHAFT REINF.	BOLT CIRCLE DIA.	DR. SHAFT SIZE	DR. SHAFT REINF.
1 1/4" X 2'-1"	20 1/2"	36"	14-#8 (A)	24 1/2"	36"	14-#8 (A)						
1 3/8" X 3'-1"	20 3/4"	36"	12-#9 (A)	24 3/4"	36"	12-#9 (A)						
1 1/2" X 3'-4"	21"	36"	12-#9 (A)	25"	42"	14-#9 (A)	29"	42"	14-#9 (C)			
1 3/4" X 3'-10"	21 1/2"	36"	10-#10 (A)	25 3/8"	42"	12-#10 (B)	29 3/8"	42"	12-#10 (C)	35 3/8"	48"	16-#10 (C)
2" X 4'-3"	22"	36"	12-#10 (A)	25 3/4"	42"	12-#10 (B)	29 3/4"	48"	16-#10 (C)	35 3/4"	54"	18-#10 (C)
2 1/4" X 4'-9"	22 1/2"	36"	10-#11 (A)	26"	42"	10-#11 (B)	30"	48"	14-#11 (C)	36"	54"	14-#11 (D)
2 1/2" X 5'-2"				26 1/2"	42"	12-#11 (B)	30 1/2"	48"	16-#11 (C)	36 1/2"	54"	16-#11 (D)
2 3/4" X 5'-8"							31 1/2"	48"	18-#11 (D)	37"	54"	20-#11 (D)
3" X 6'-1"										37 1/2"	54"	24-#11 (D)

A = #3 Plain Spiral at 6" pitch (Grade 40)  
 B = #4 Plain Spiral at 6" pitch (Grade 40)  
 C = #4 Plain Spiral at 6" pitch (Grade 60)  
 D = #4 Plain Spiral at 3 1/2" pitch (Grade 60)


Washers shall conform to ASTM F436-76b.

ANCHOR BOLT DIA. d	WASHER DIMENSIONS			HOLE IN BASE PLATE
	OUTSIDE DIAMETER	HOLE DIAMETER	THICKNESS MIN. MAX.	
1 1/2" or less	2d	d + 1/8"	0.136" 0.177"	d + 1/4"
1 3/4"	2d - 1/8"	d + 1/8"	0.178" 0.280"	d + 5/16"
2"	2d - 1/4"	d + 1/8"	0.178" 0.280"	d + 5/16"
Over 2"	2d - 1/2"	d + 1/8"	0.240" 0.340"	d + 5/16"

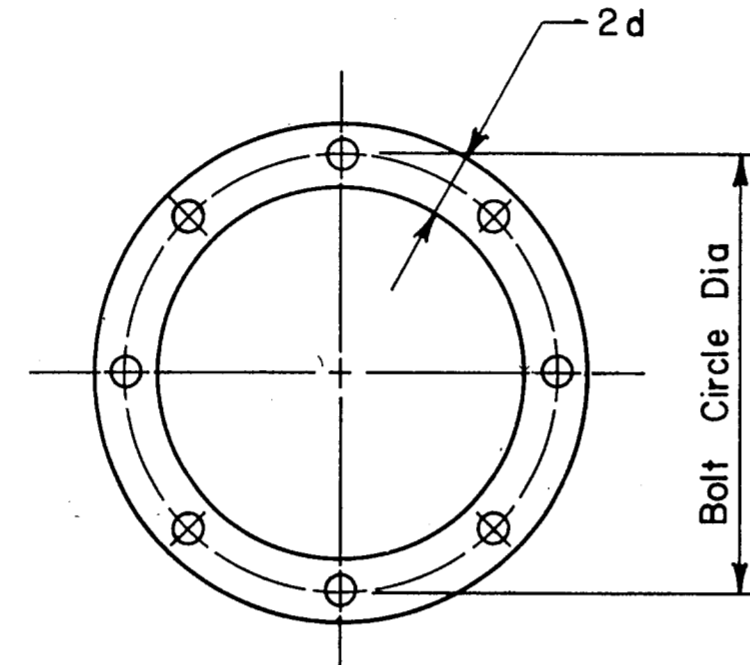


ANCHOR BOLT SIZE		
DIA.	LENGTH*	PROJ. & THREAD
1 1/4"	2'-11"	5"
1 3/8"	3'-1"	5 1/2"
1 1/2"	3'-4"	6"
1 3/4"	3'-10"	7"
2"	4'-3"	8"
2 1/4"	4'-9"	9"
2 1/2"	5'-2"	10"
2 3/4"	5'-8"	11"
3"	6'-1"	12"

\* Minimum dimensions are given.

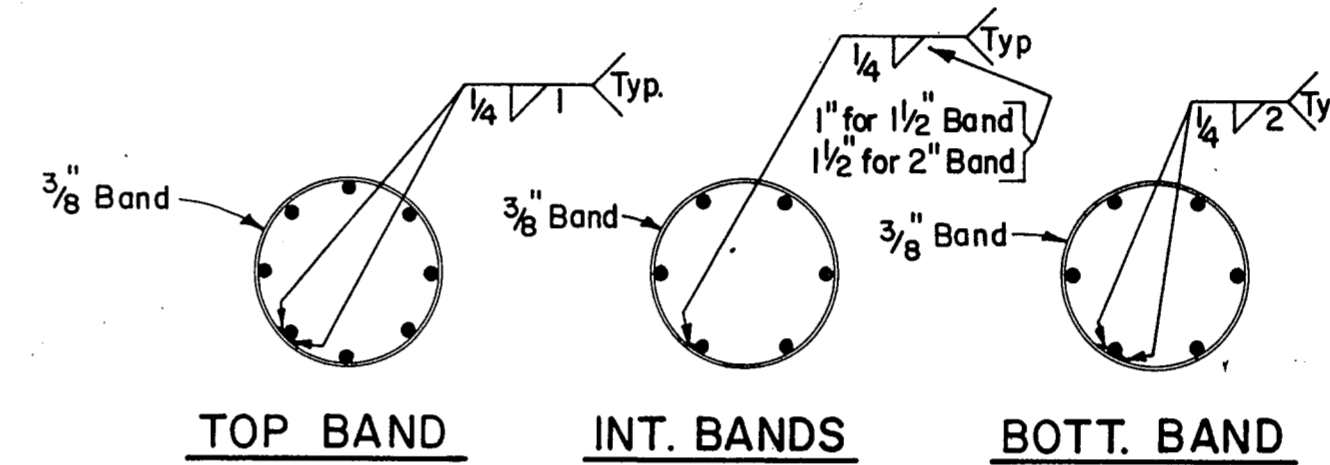


TOP BAND INT. BANDS BOTT. BAND


TOP VIEW OF TOP & BOTTOM TEMPLATES

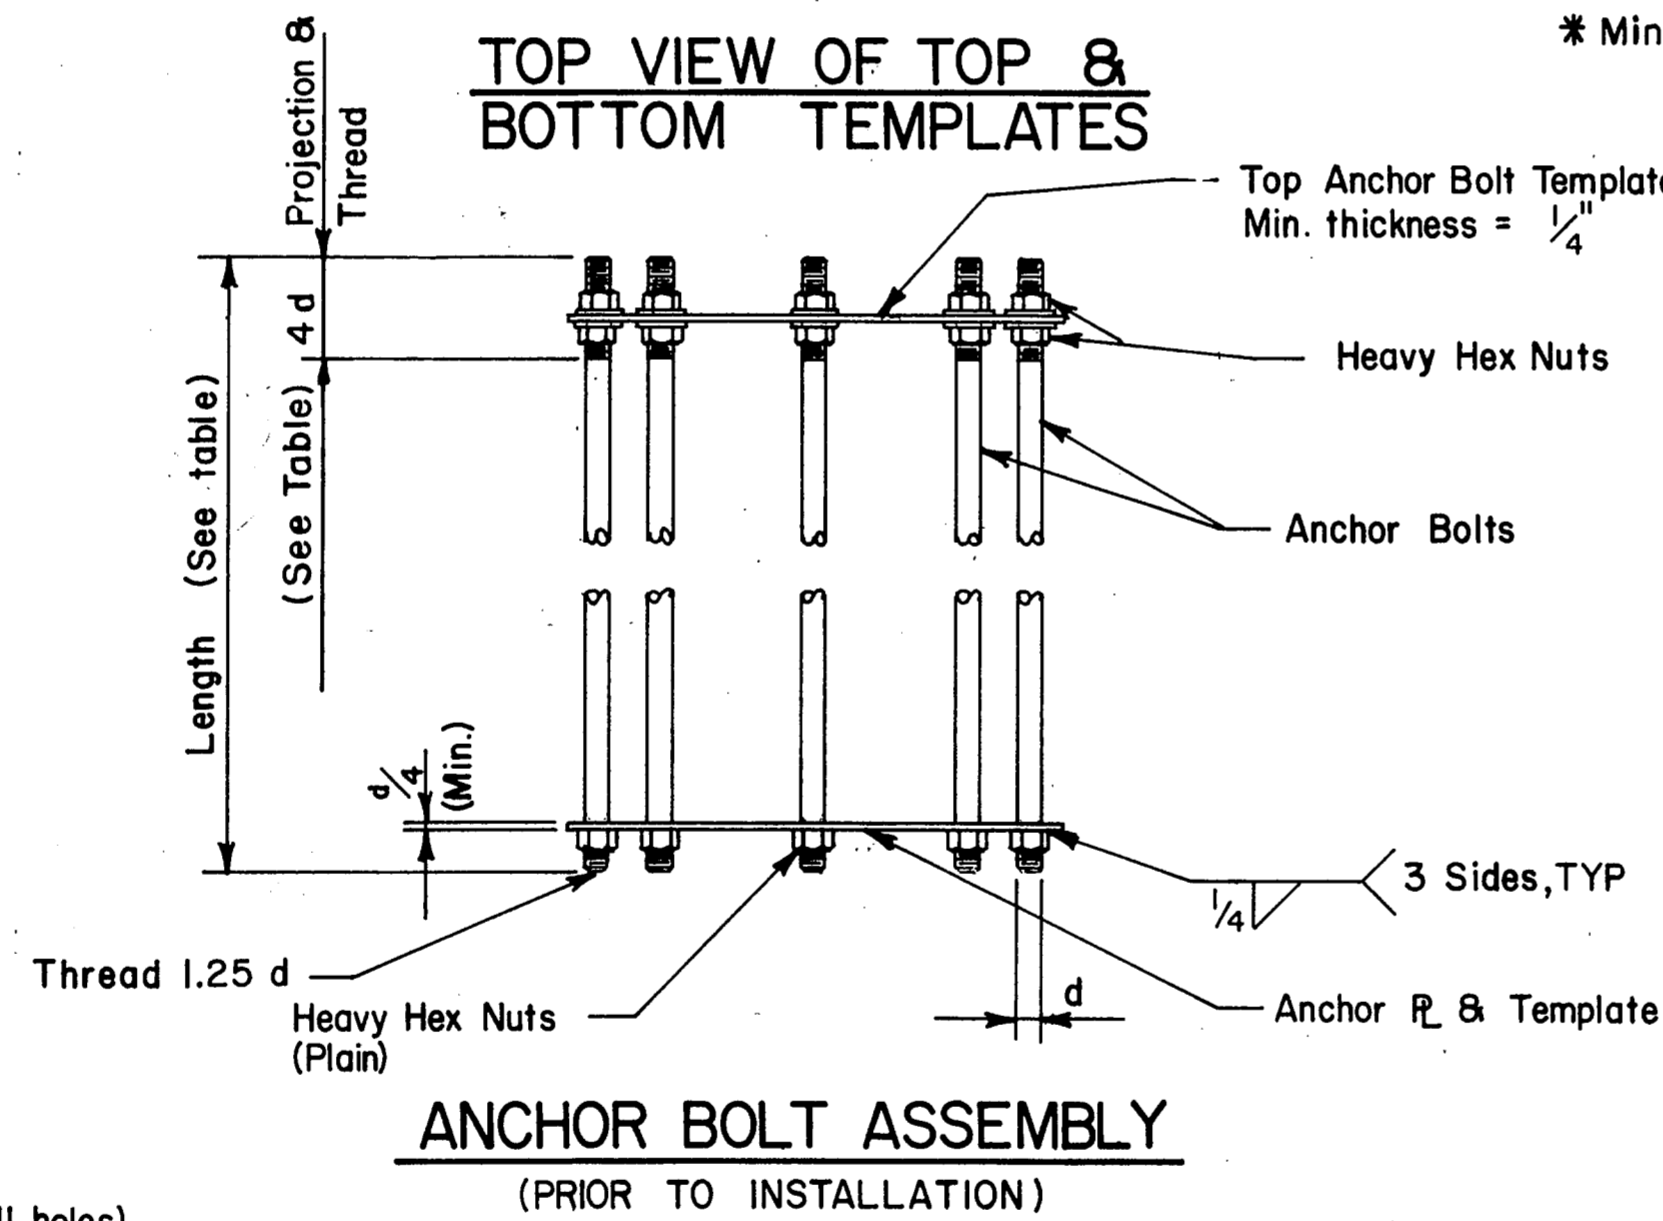


ANCHOR BOLT ASSEMBLY (PRIOR TO INSTALLATION)

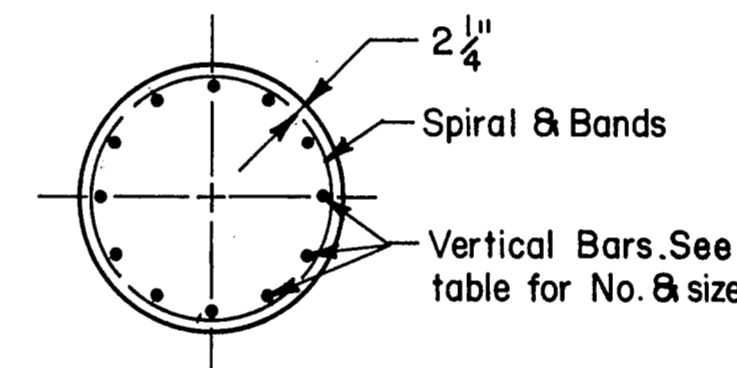


SECTION

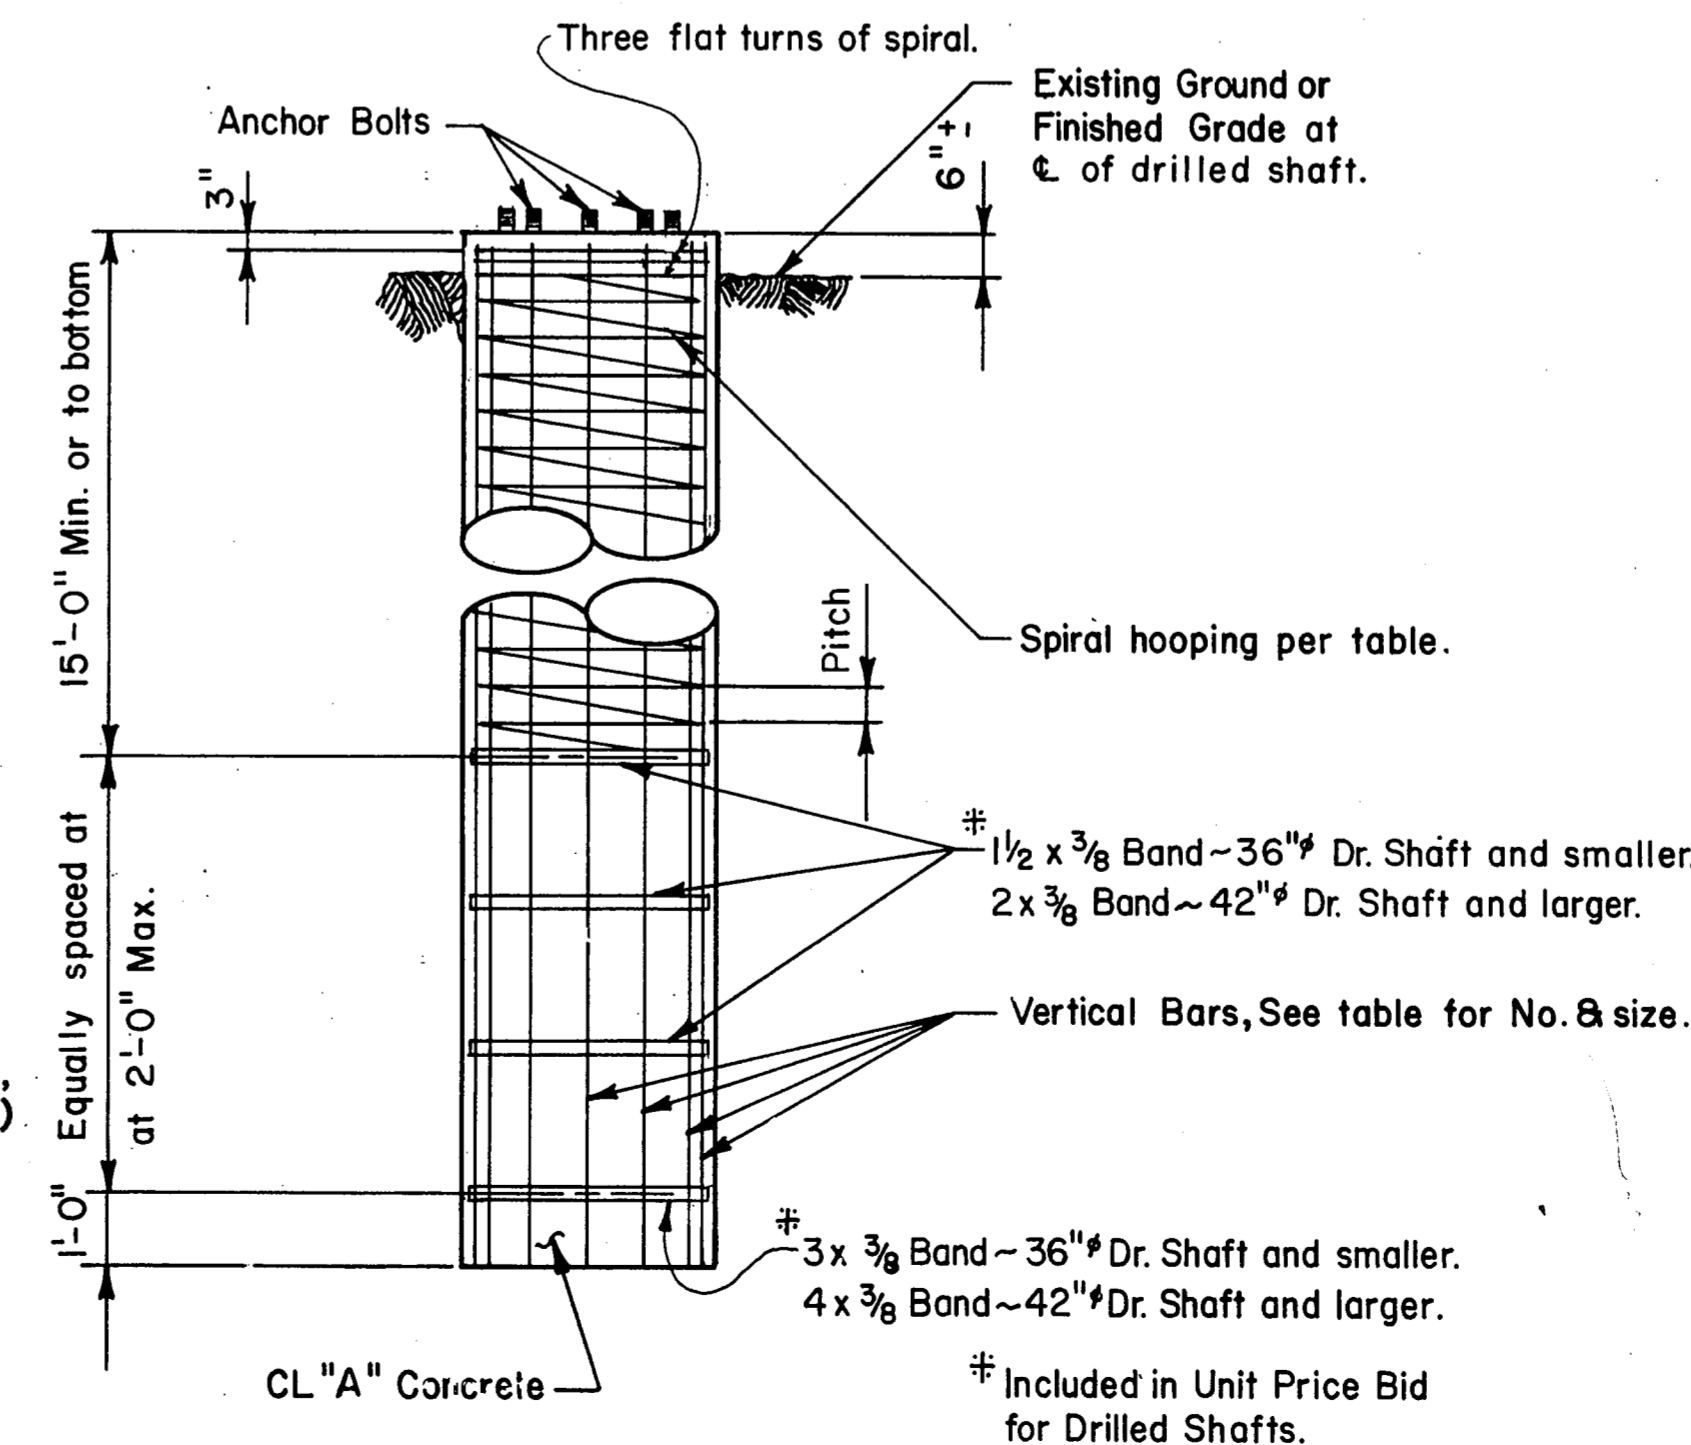

FOUNDATION DETAIL

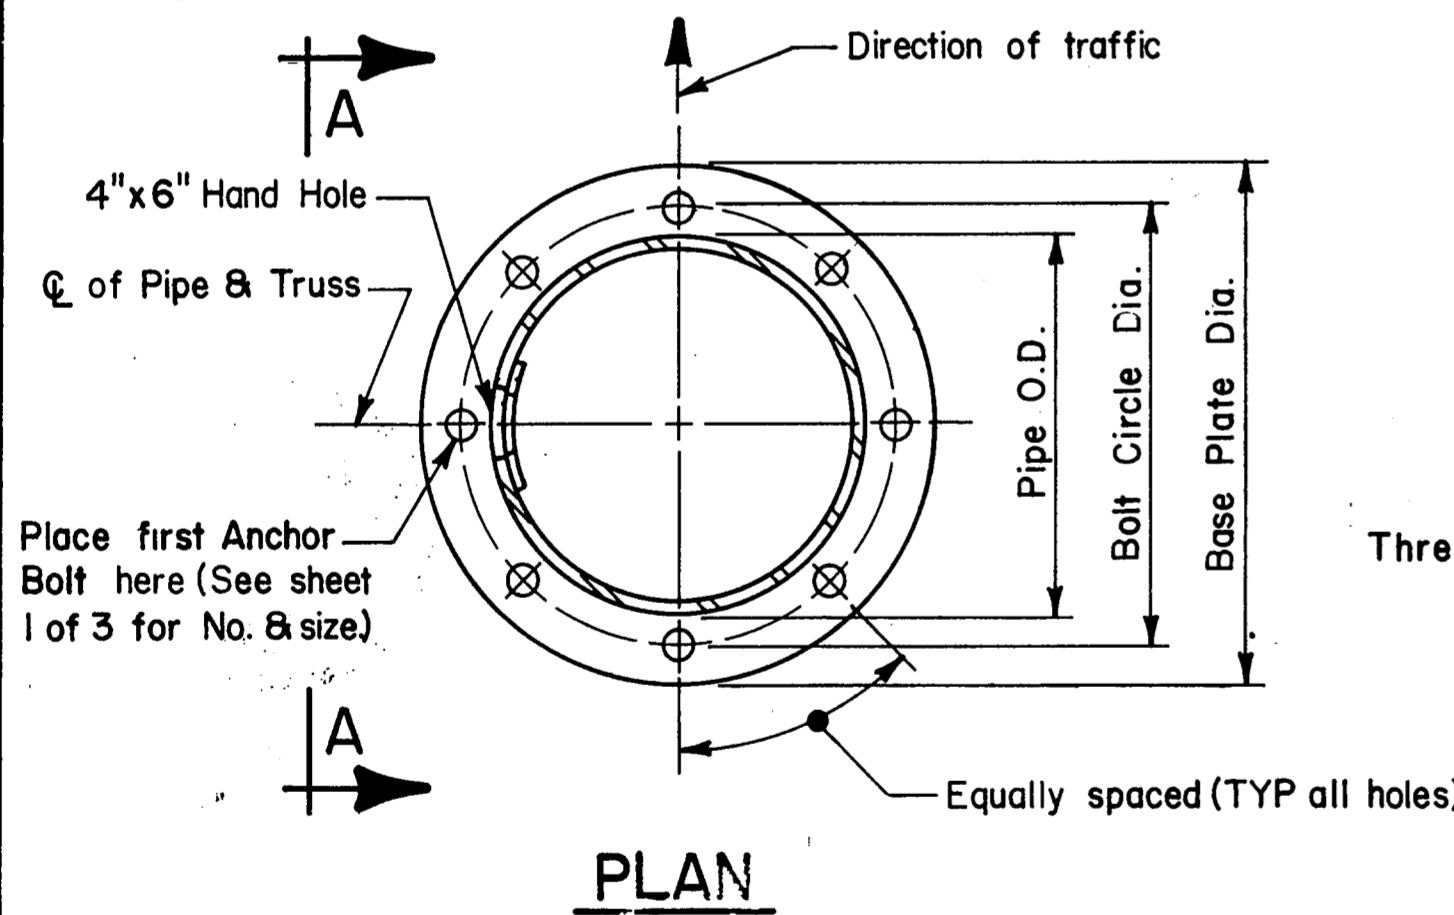


PLAN

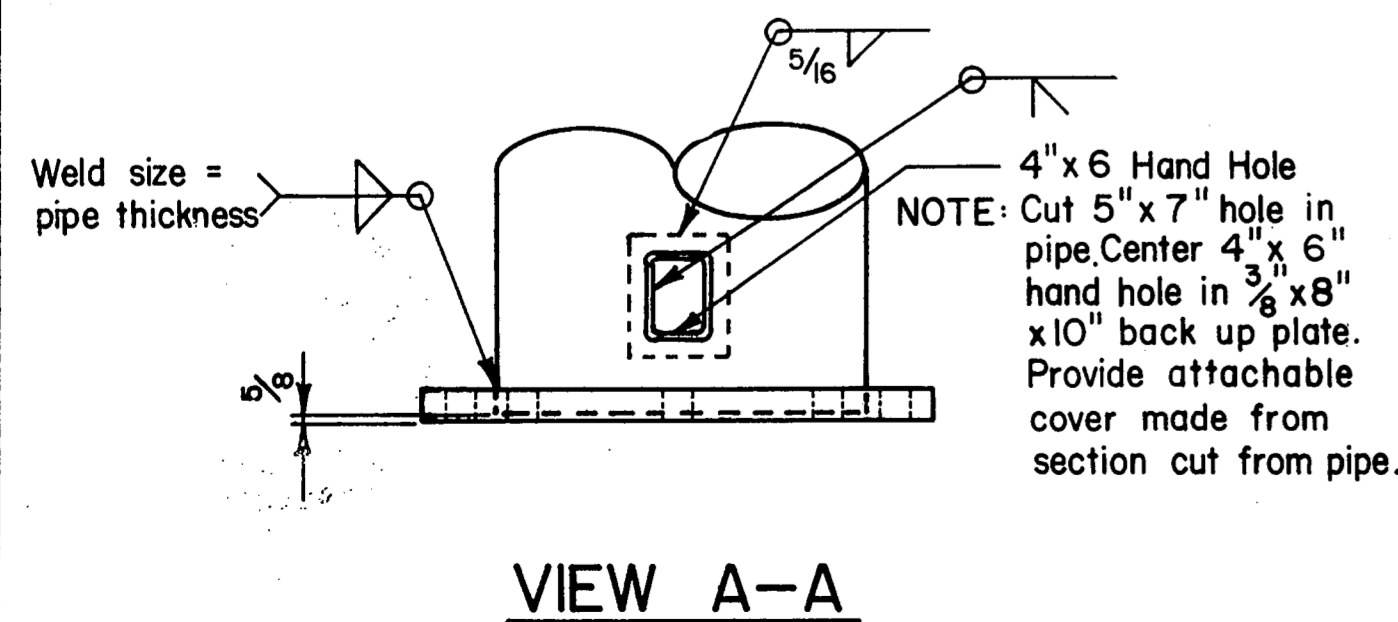

VIEW A-A

BASE PLATE & HANDHOLE DETAILS

(SEE SHEET 1 OF 3 FOR DIAMETER & THICKNESS OF BASE PLATE)

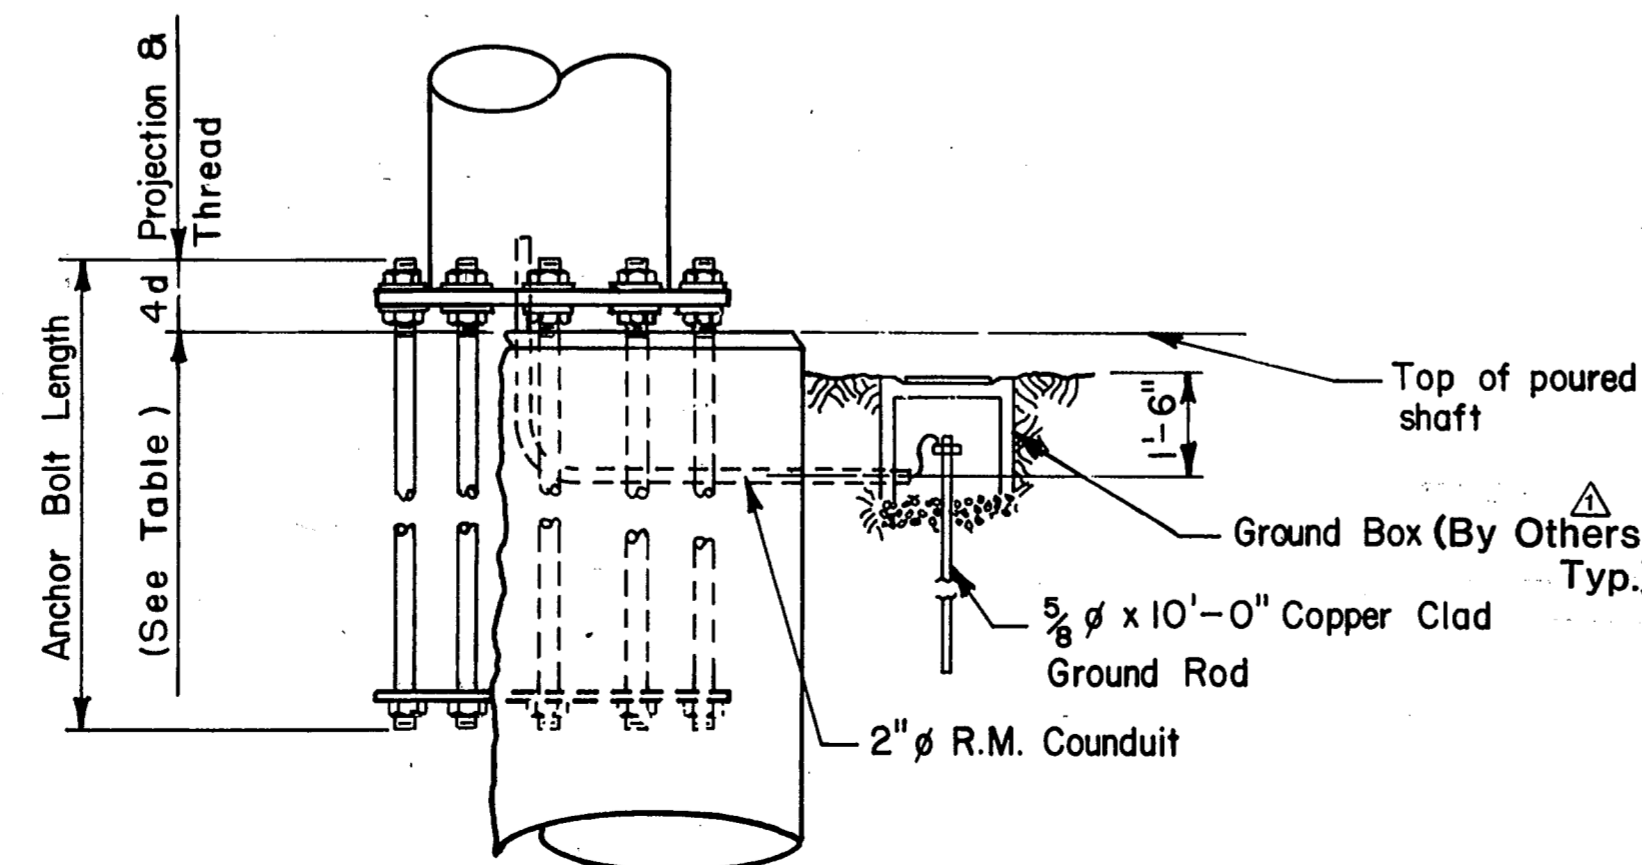

BEARING SEAT ELEVATION

GENERAL NOTES:

Concrete shall be Class "A".  
 Reinforcing shall conform to item 440.  
 Anchor bolts shall conform to ASTM A193-B7. Nuts for anchor bolts shall be heavy hex and shall conform to ASTM A194-2H. Thread for anchor bolts and nuts shall be 8 UN. Unless noted otherwise, anchor bolt top end projection plus 6" shall be galvanized. Nuts and washers at the base plate shall be galvanized. Nuts shall be tapped or chased after galvanizing. Bolts and nuts shall have Class 2A and 2B fit tolerances.  
 Anchor bolts shall be rigidly held in position during concrete placement using steel templates at the top and bottom. The top templates shall be removed after the concrete has set.  
 After the structure has been aligned in its final position, tack weld anchor bolt nuts to washer, and tack weld washers to base plate. Galvanizing in welded area shall be repaired in accordance with the Specification.  
 Unless shown otherwise welded steel bands may be replaced with spiral as noted on the foundation detail.  
 All vertical reinforcing shall be carried to the bottom of the Dr. Shaft.

REPRODUCED FROM STATE DEPARTMENT OF HIGHWAYS AND PUBLIC TRANSPORTATION STANDARD DRAWING COSSE

FINAL RECORD DRAWING  
 Date: 12/25/99

2	MISC. REVISION	PJ	9-19-91
1	ADD NOTE	GAL	4-1-86
NO.	REVISION	BY	DATE


TEXAS TURNPIKE AUTHORITY  
 DALLAS NORTH TOLLWAY

CANTILEVER OVERHEAD  
 SIGN SUPPORT FOUNDATION


HNTB  
 HOWARD NEEDLES TAMMEN & BERGENDOFF

DRAWN	DATE	DESIGNED	DATE
CHECKED	DATE	SCALE	


STANDARD DRAWING NO. SS-25

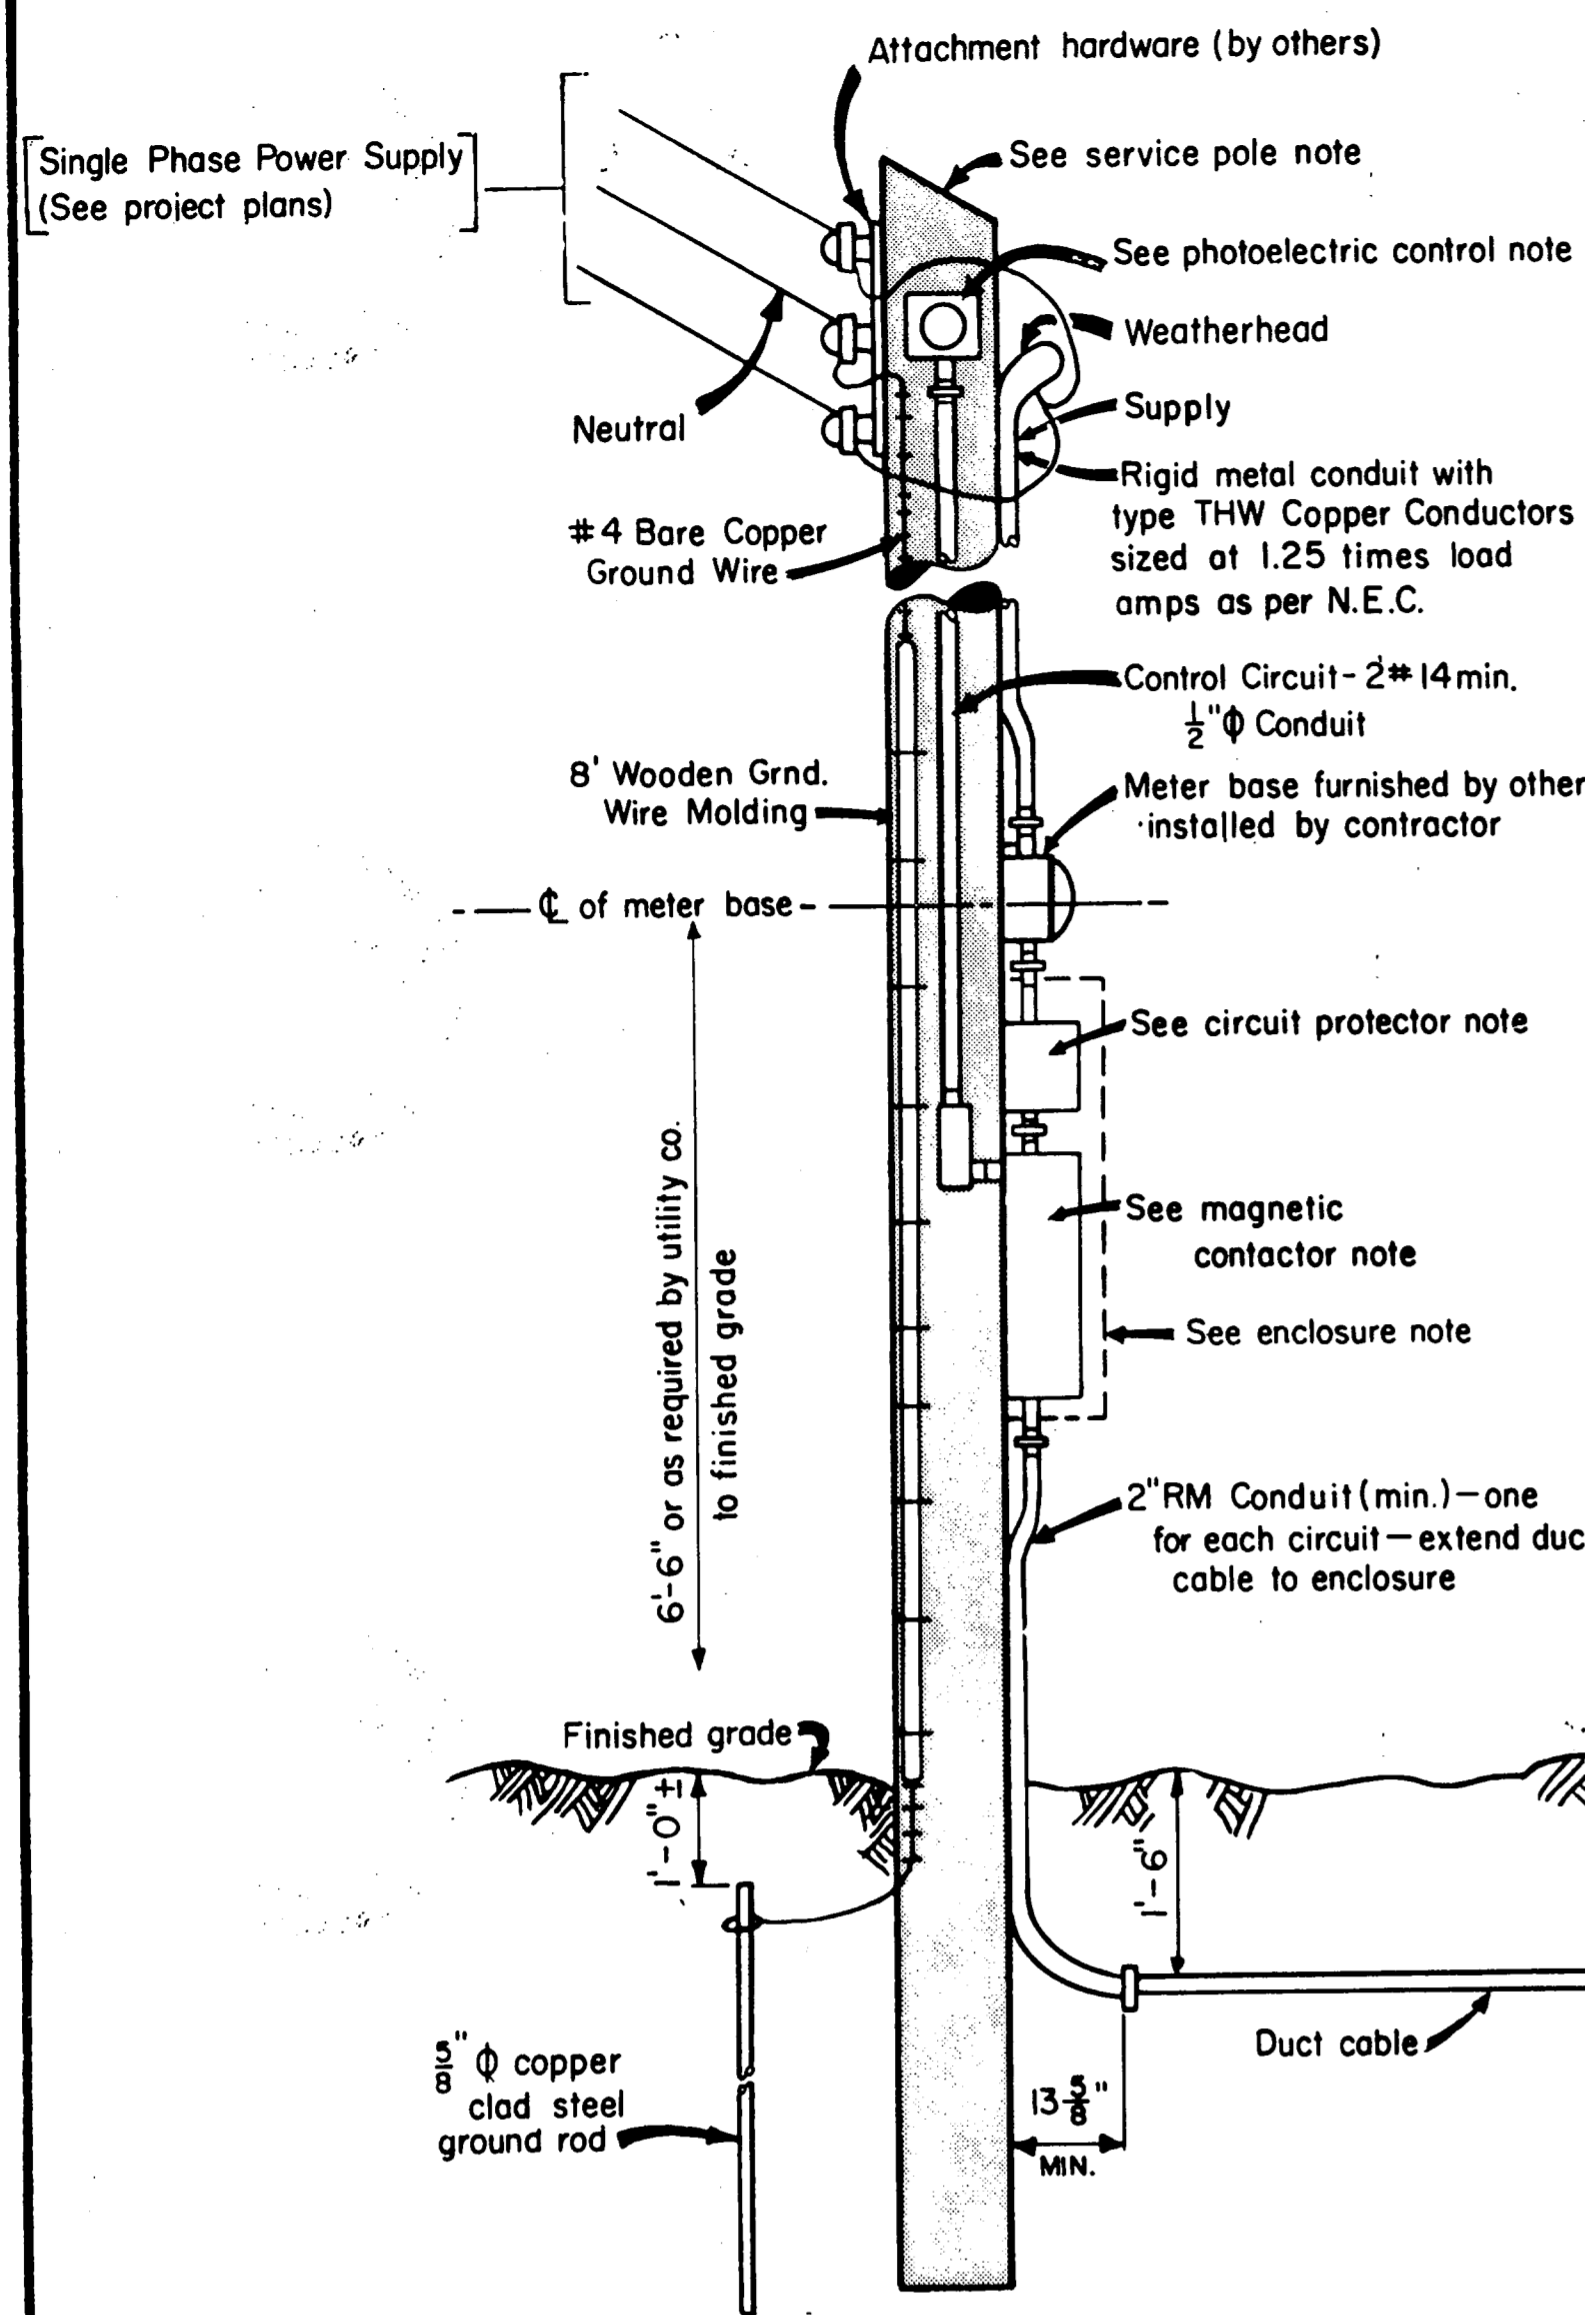


**TYPICAL SERVICE POLE**  
 Serving Sign Lights Only. Conduit and wire sizes are minimum, larger sizes shall be provided for if called for elsewhere in the plans.  
 (NOT IN CONTRACT)

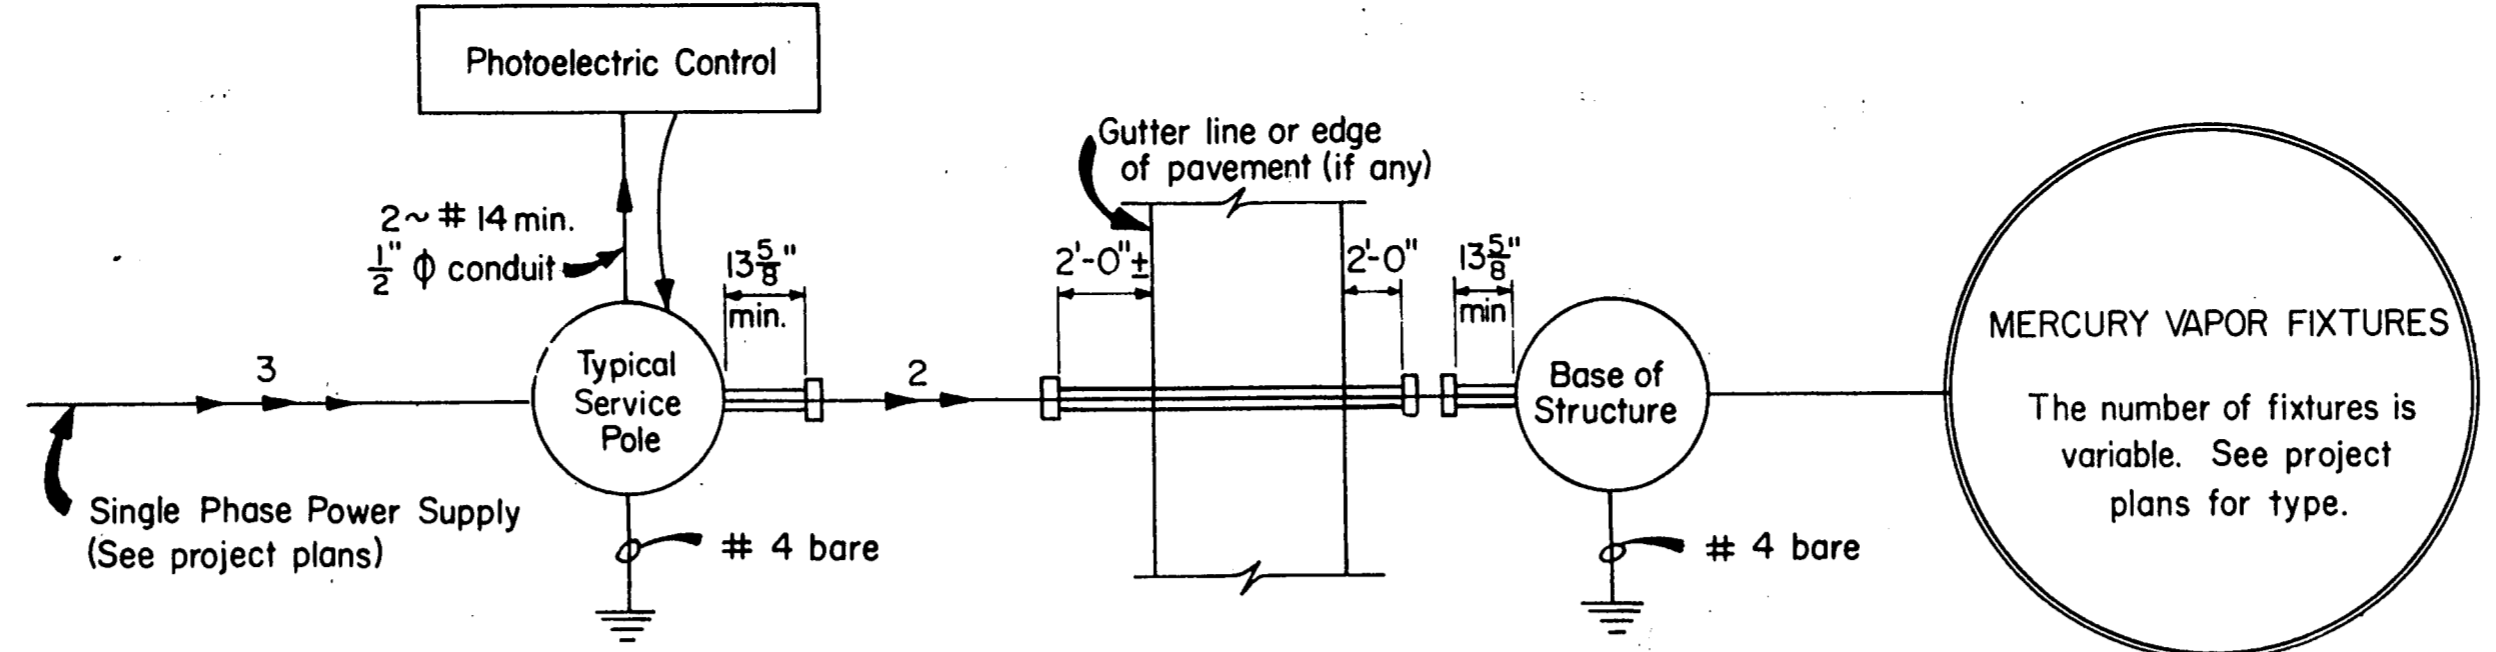


**TYPICAL WIRING AND CONDUIT DIAGRAM**  
 BASED ON ONE SERVICE POLE PER SIGN STRUCTURE. WIRE AND CONDUIT SIZE SHALL BE AS REQUIRED BY THE ELECTRICAL LOAD (SERVICE POLES NOT IN CONTRACT)

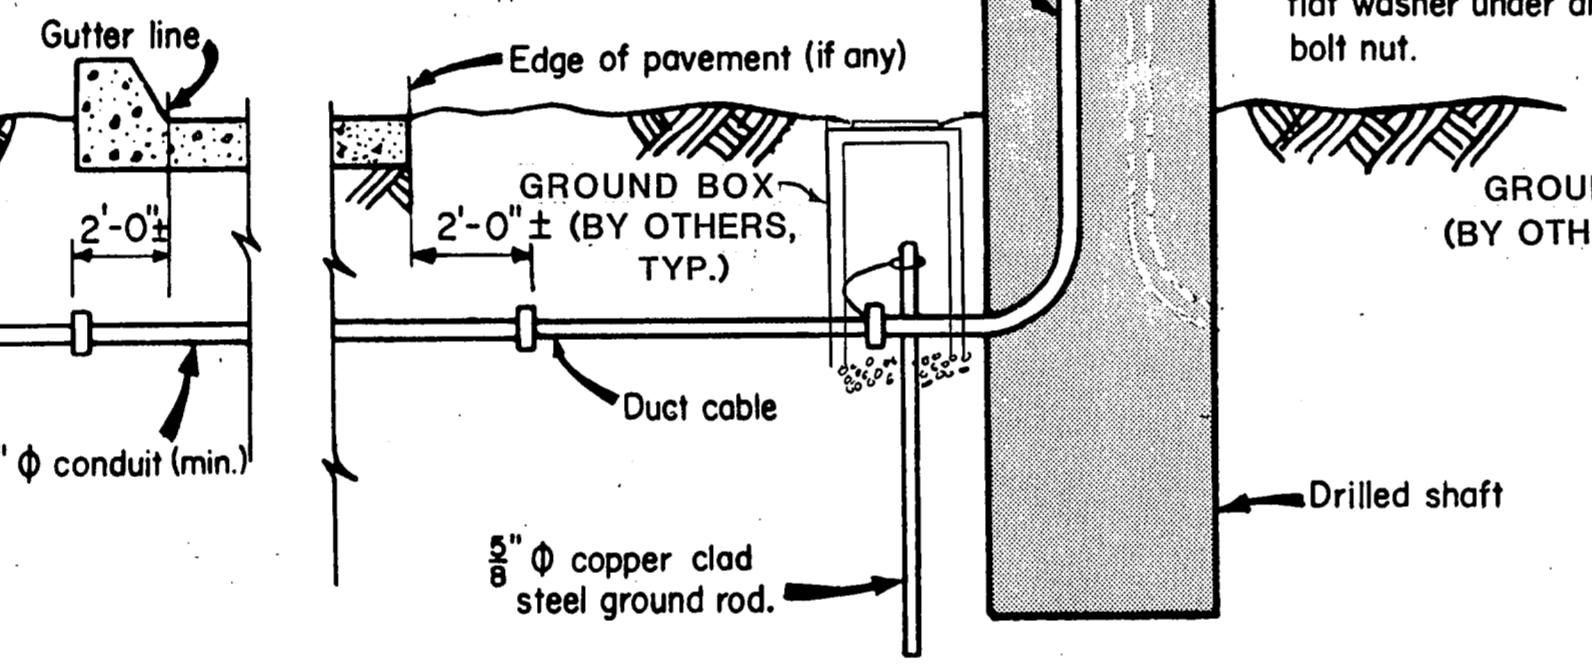


**CABLE TRENCH DETAILS**

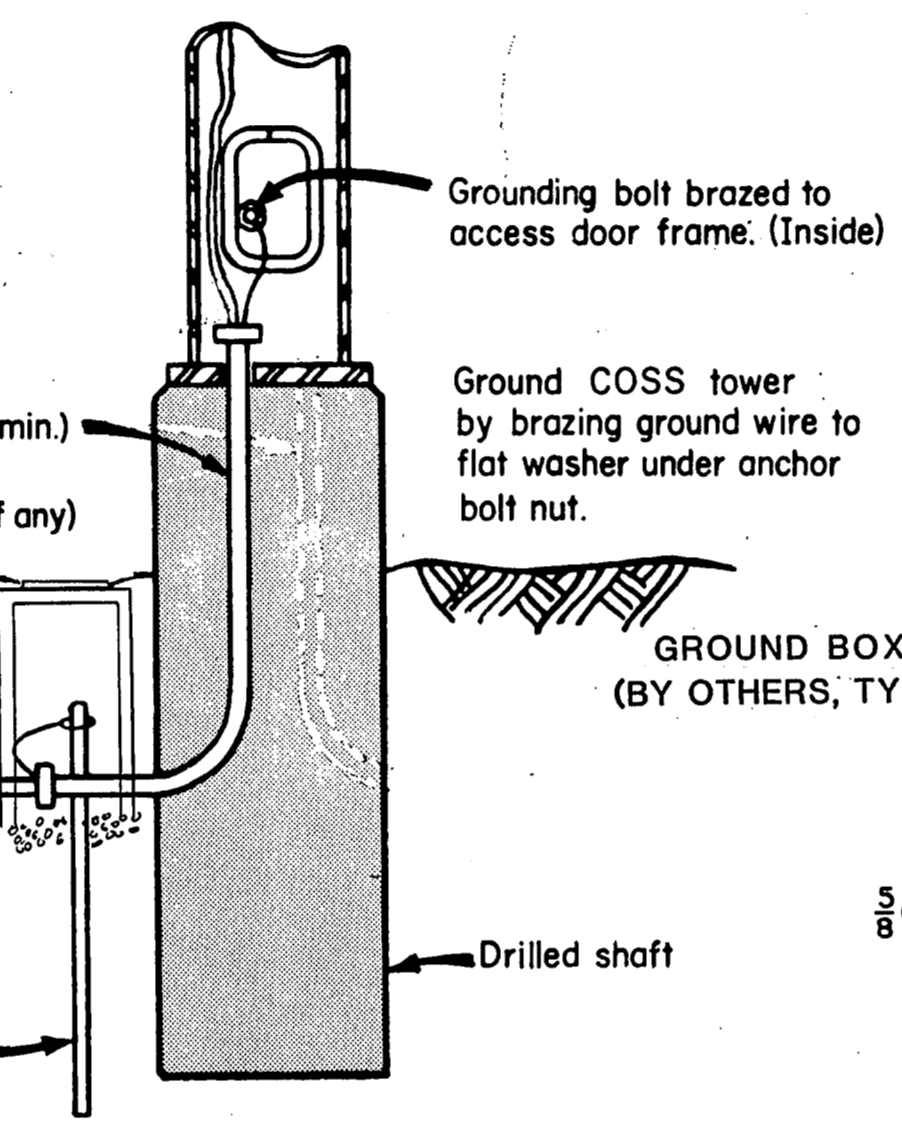


**BASE OF OVERHEAD SIGN STRUCTURE**  
 TYPE COSS

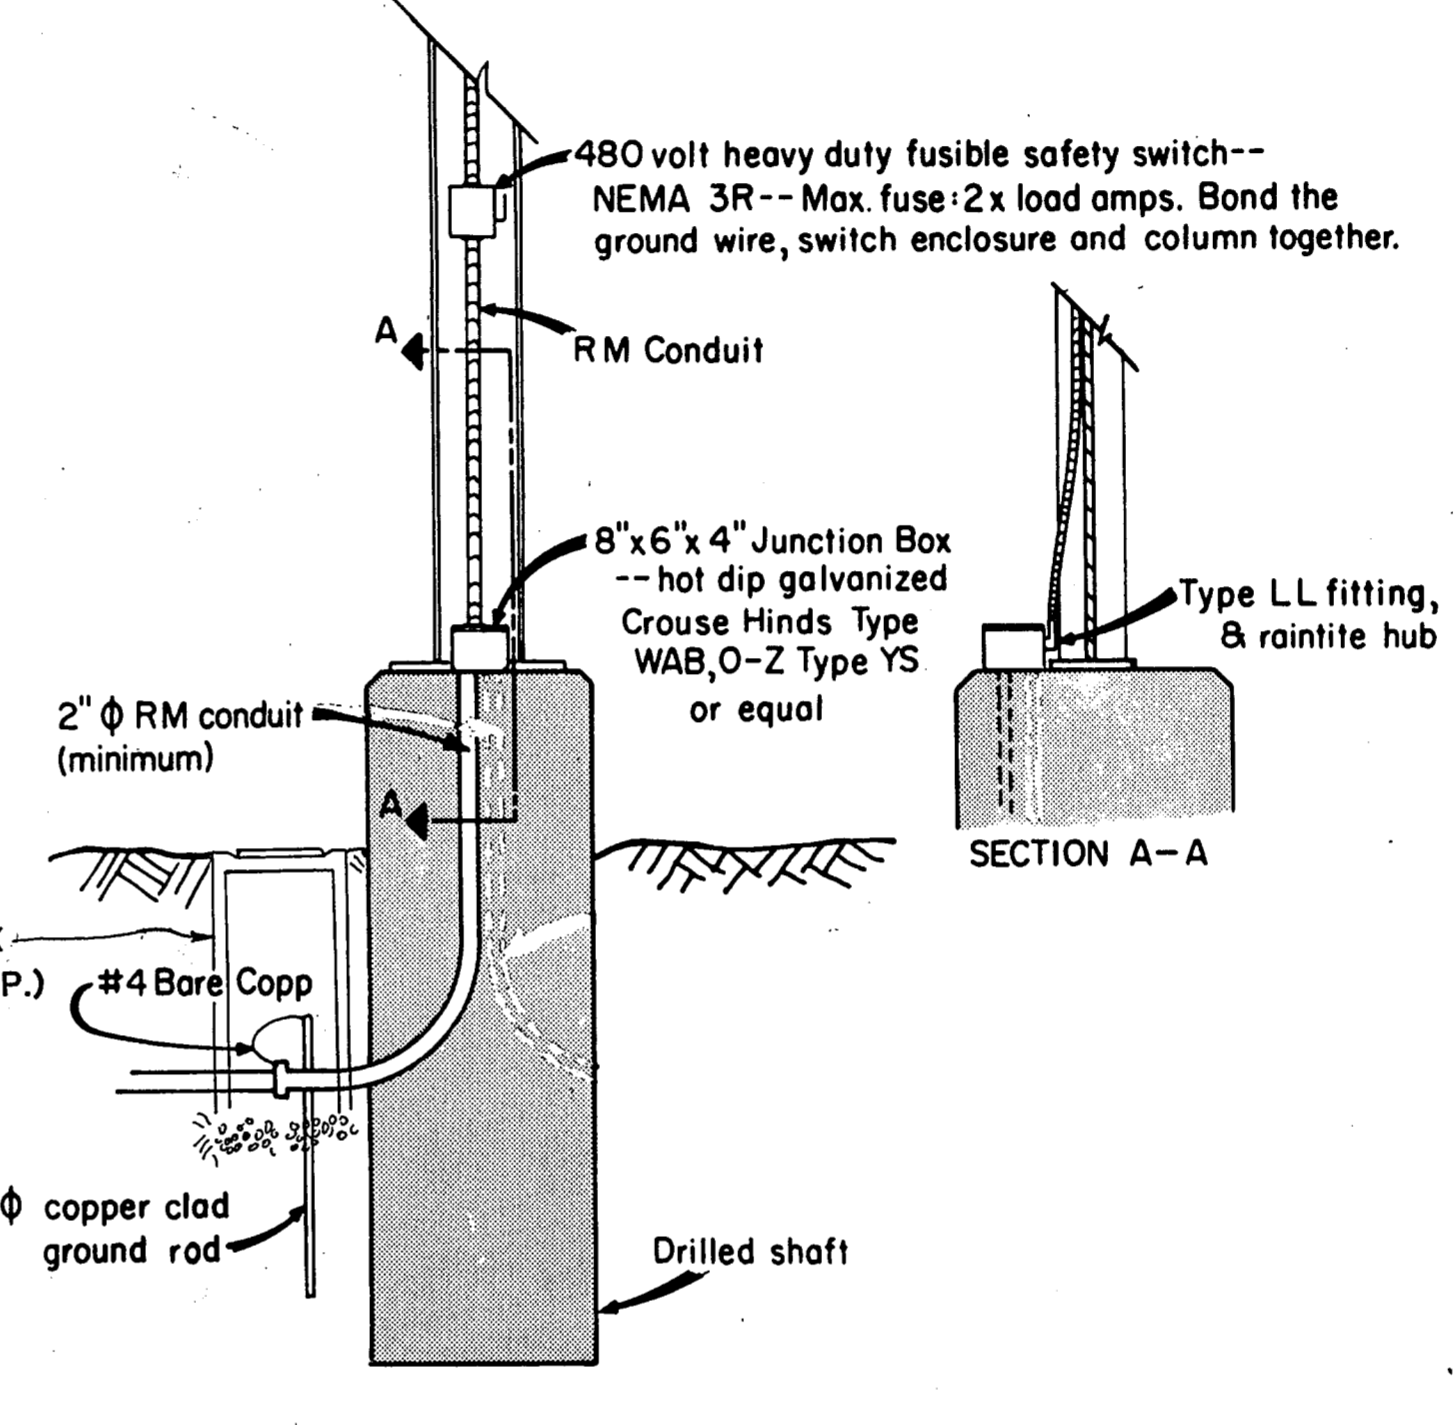

**BASE OF OVERHEAD SIGN STRUCTURE**  
 TYPE OSBT

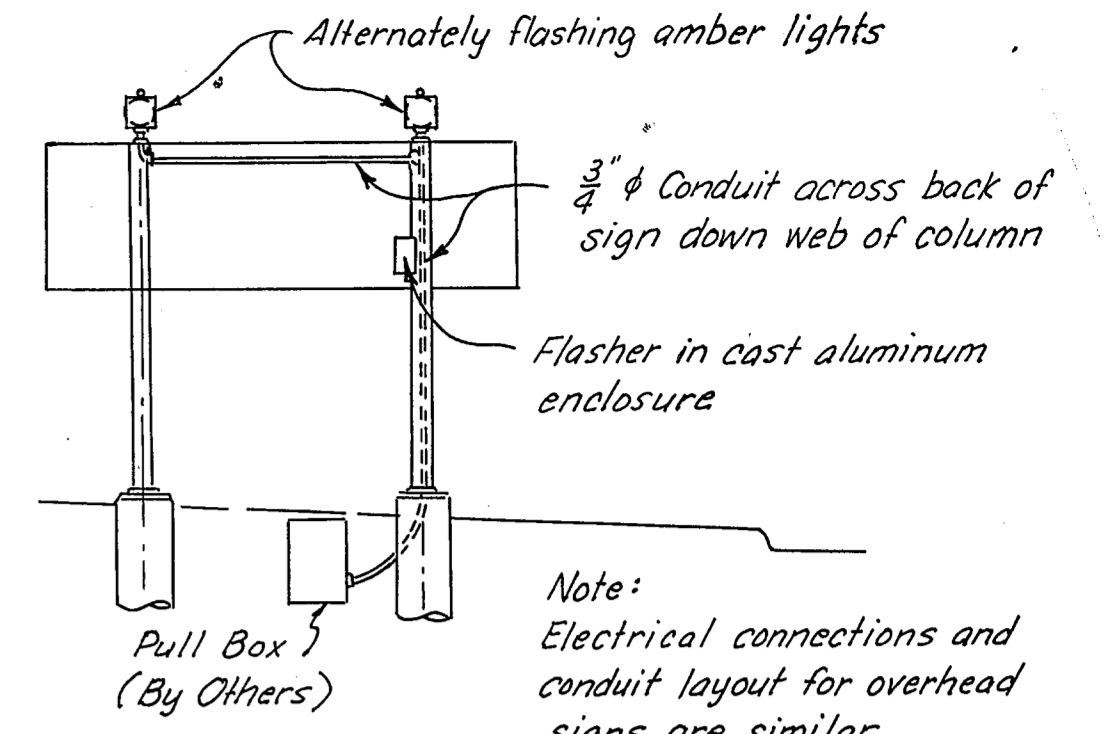

**APPROACH WARNING LIGHTS**  
 "STOP AHEAD PAY TOLL" SIGN

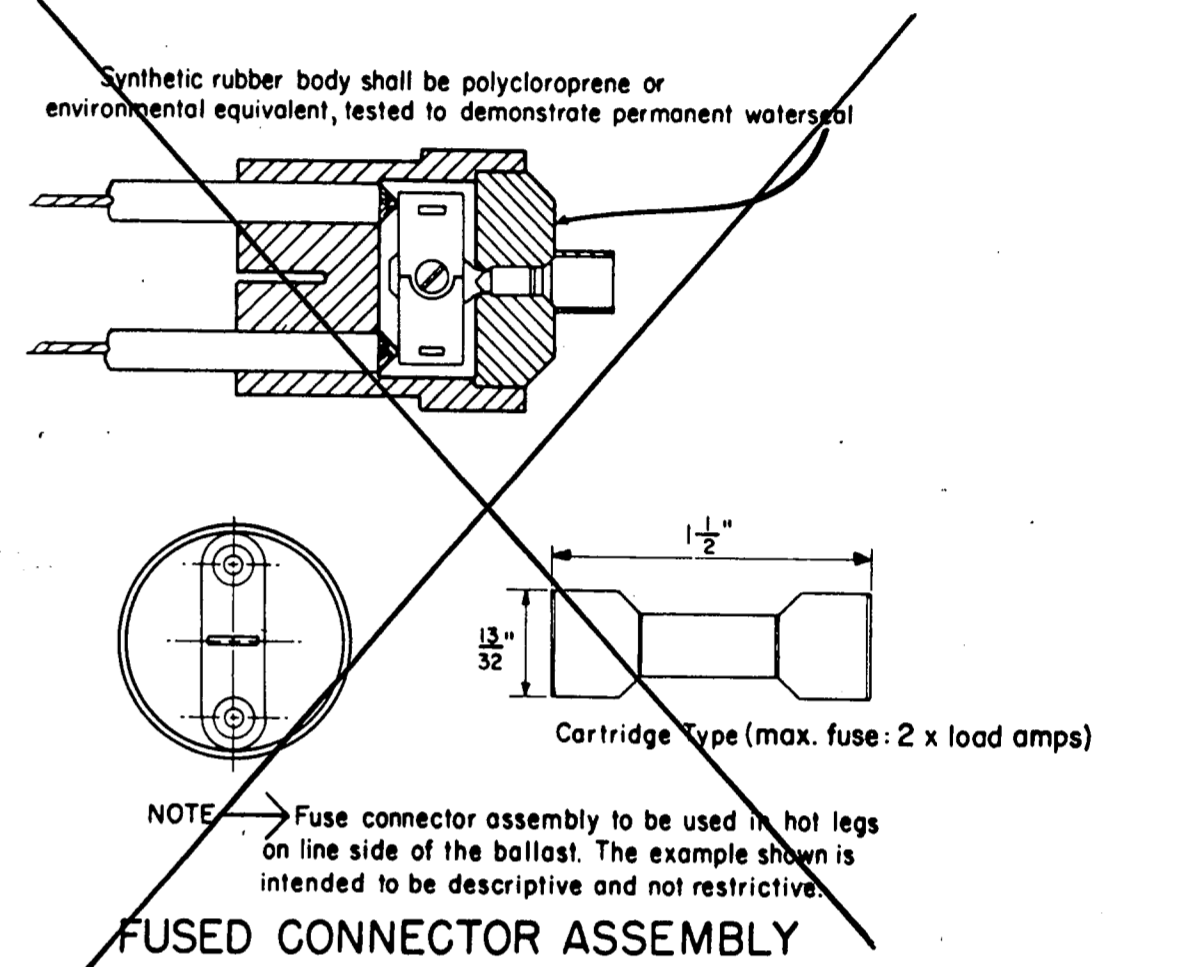

**FUSED CONNECTOR ASSEMBLY**

**ELECTRICAL NOTES AND SPECIFICATIONS**

**GENERAL NOTES**  
 ALL WORK, MATERIALS, AND SERVICES NOT SHOWN ON THE PLANS, WHICH MAY BE NECESSARY FOR COMPLETE AND PROPER CONSTRUCTION, SHALL BE PERFORMED, FURNISHED, AND INSTALLED BY THE CONTRACTOR. THE LOCATION OF CONDUCTOR, CONDUIT, OTHER ELECTRICAL EQUIPMENT, AND SERVICE POLE IS DIAGRAMMATIC ONLY AND MAY BE SHIFTED BY THE ENGINEER TO ACCOMMODATE LOCAL CONDITIONS. ALL SPECIFICATIONS AND PROVISIONS NOT COVERED HEREIN SHALL BE IN ACCORDANCE WITH THE STANDARD SPECIFICATION ITEMS AND ANY SPECIAL PROVISIONS THERETO. CONDUIT AND EQUIPMENT SHALL BE SECURELY ATTACHED TO THEIR SUPPORTS.

**CONDUCTORS**  
 ALL CONDUCTORS SHALL COMPLY TO ITEM "ELECTRICAL CONDUCTOR" OF THE SPECIFICATIONS.

**CONDUIT**  
 ALL INSULATED CONDUCTORS ABOVE GROUND, EXCEPT CONDUCTORS IN PIPE TOWER LEGS, SHALL BE INSTALLED IN CONDUIT BETWEEN EQUIPMENT. CONDUIT SHALL BE PLACED ALONG AND ATTACHED TO THE POLE OR STRUCTURAL FRAME UNLESS OTHERWISE DIRECTED BY THE ENGINEER.  
 CONDUIT ALONG THE MAST OR TOWER LEG SHALL BE RIGID METAL. CONDUIT FROM THE MAST OR TOWER LEG TO AND BETWEEN FIXTURES, AND CONDUIT BETWEEN FIXTURES SHALL PREFERABLY BE RIGID METAL, POLYVINYL CHLORIDE (PVC) OR ELECTRICAL METALLIC TUBING (EMT). HOWEVER, AT PLACES WHERE RIGID METAL, PVC OR EMT IS NOT FEASIBLE, CONDUIT MAY, WITH THE APPROVAL OF THE ENGINEER, BE LIQUID-TIGHT FLEXIBLE CONDUIT. CONDUIT BURIED IN TRENCH OR CONCRETE SHALL BE EITHER RIGID METAL, PVC OR HIGH DENSITY POLYETHYLENE (HDP) AS INDICATED ON THE PLANS OR AS DETERMINED BY THE ENGINEER FROM THE SOIL CHARACTERISTICS. ALL BURIED CONDUIT SHALL HAVE STANDARD BUSHINGS AT THE EXTREMITIES.

**CIRCUIT PROTECTOR ASSEMBLY (NOT IN CONTRACT)**  
 THE AMPERE RATING OF THE CIRCUIT BREAKER SHALL BE 1.25 TIMES THE CALCULATED CIRCUIT LOAD CURRENT. THE RATING OF THE ASSEMBLY SHALL BE CONSISTENT WITH THE LOAD SERVED AND SHALL BE AS INDICATED ON THE PLANS OR AS DIRECTED BY THE ENGINEER. THE CIRCUIT BREAKERS SHALL BE DOUBLE POLE, THERMAL-MAGNETIC, FRONT MOUNTED, RATED AT THE SUPPLIED VOLTAGE. THE BREAKER OPERATING HANDLE SHALL BE TRIP FREE SO CONTACT CANNOT BE HELD AGAINST SHORT CIRCUIT OR ABNORMAL OVERLOAD. THE SHORT CIRCUIT INTERRUPTING CAPACITY SHALL BE 15,000 AMPERES SYMMETRICAL.

**SERVICE POLE (NOT IN CONTRACT)**  
 THE POLE LENGTH SHALL BE 25 FEET UNLESS OTHERWISE NOTED ON THE PLANS. SERVICE POLE SHALL BE CREOSOTE-TREATED TO 8 POUNDS PER CUBIC FOOT RETENTION OR PENTACHLOROPHENOL TREATED TO 0.4 POUNDS PER CUBIC FOOT RETENTION IN ACCORDANCE WITH THE ITEM "TIMBER PRESERVATIVE AND TREATMENT". FOR A PROJECT REQUIRING 10 OR LESS POLES, THE CONTRACTOR MAY PURCHASE POLES LOCALLY IF SOURCE AND TREATMENT ARE DOCUMENTED.

**PHOTOELECTRIC CONTROL (NOT IN CONTRACT)**  
 THE PHOTOELECTRIC CONTROL SHALL BE OF THE SINGLE POLE, SINGLE THROW TYPE, DOUBLE BREAK, RATED AT THE SUPPLIED VOLTAGE. CONTROLLER SHALL HAVE FOOTCANDLE ADJUSTMENT, MAGNETICALLY OPERATED RELAY, OPAQUE COVER, AND SHALL BE THE DIRECT ORIENTATION TYPE. THE MOUNTING BRACKET AND CONTROL SHALL BE MOUNTED ON THE SERVICE POLE. THE CONTROL SHALL BE ORIENTED NORTH OR AS SPECIFIED BY THE MANUFACTURER. THE PHOTOELECTRIC CONTROL CIRCUIT SHALL HAVE A THREE POSITION HAND-OFF-AUTOMATIC SELECTOR SWITCH AT A CONVENIENT LOCATION.

**MAGNETIC CONTACTOR (NOT IN CONTRACT)**  
 THE MAGNETIC CONTACTOR SHALL BE OF THE TWO POLE TYPE WITH A MINIMUM CONTACT RATING OF 480 VOLTS AND A MINIMUM CONTACT RATING OF 30 AMPS.

**GROUNDING**  
 ALL SERVICE POLES AND SIGN STRUCTURE TOWERS SHALL BE GROUNDED IN ACCORDANCE WITH THE NATIONAL ELECTRICAL CODE AND DETAILS SHOWN ON THE PLANS. GROUND RODS SHALL BE 5/8" DIAMETER COPPER CLAD STEEL. WHERE DRILLED HOLES ARE REQUIRED, THE RODS SHALL BE 8 FEET LONG AND THE BACKFILL MATERIAL SHALL HAVE AN ADMIXTURE OF COMMON SALT. DRIVEN GROUND RODS SHALL BE 10 FEET LONG.


**ENCLOSURES (NOT IN CONTRACT)**  
 ALL ENCLOSURES HOUSING ELECTRICAL EQUIPMENT SHALL BE GALVANIZED, RAIN-TIGHT, AND DESIGNED FOR OUT-DOOR INSTALLATION IN ACCORDANCE WITH THE NATIONAL ELECTRICAL MANUFACTURES ASSOCIATION SPECIFICATIONS. THE MAGNETIC CONTACTOR AND CIRCUIT PROTECTOR SHOWN ON THE SERVICE POLE MAY, AT THE CONTRACTOR'S OPTION, BE GROUPED IN ONE ENCLOSURE, OR MAY BE HOUSED IN SEPARATE ENCLOSURES. EACH ENCLOSURE SHALL BE PROVIDED WITH A LOCK AND THE CONTRACTOR SHALL PROVIDE THE ENGINEER WITH THREE COPIES OF A MASTER KEY.

**PAYMENT**  
 ALL ITEMS NECESSARY TO ACCOMPLISH THE ILLUMINATION OF THE SIGNS SHALL BE MEASURED AND PAID FOR AS STATED IN THE SPECIFICATIONS.


REPRODUCED FROM STATE DEPARTMENT OF HIGHWAYS AND PUBLIC TRANSPORTATION STANDARD DRAWING SL(1)

**FINAL RECORD DRAWING**  
 Date: 12/25/99

NO.	MISC. REVISIONS	GRB	4-1-88
NO.	REVISION	BY	DATE
<b>TEXAS TURNPIKE AUTHORITY</b>			
<b>DALLAS NORTH TOLLWAY</b>			
SIGN LIGHTING			
(ELECTRICAL DETAILS) 30			
<b>HNTB</b> HOWARD NEEDLES TAMMEN & BERENSON/PCF			
DRAWN	DATE	DESIGNED	DATE
CHECKED	DATE	SCALE	
STANDARD DRAWING NO. SS-26			

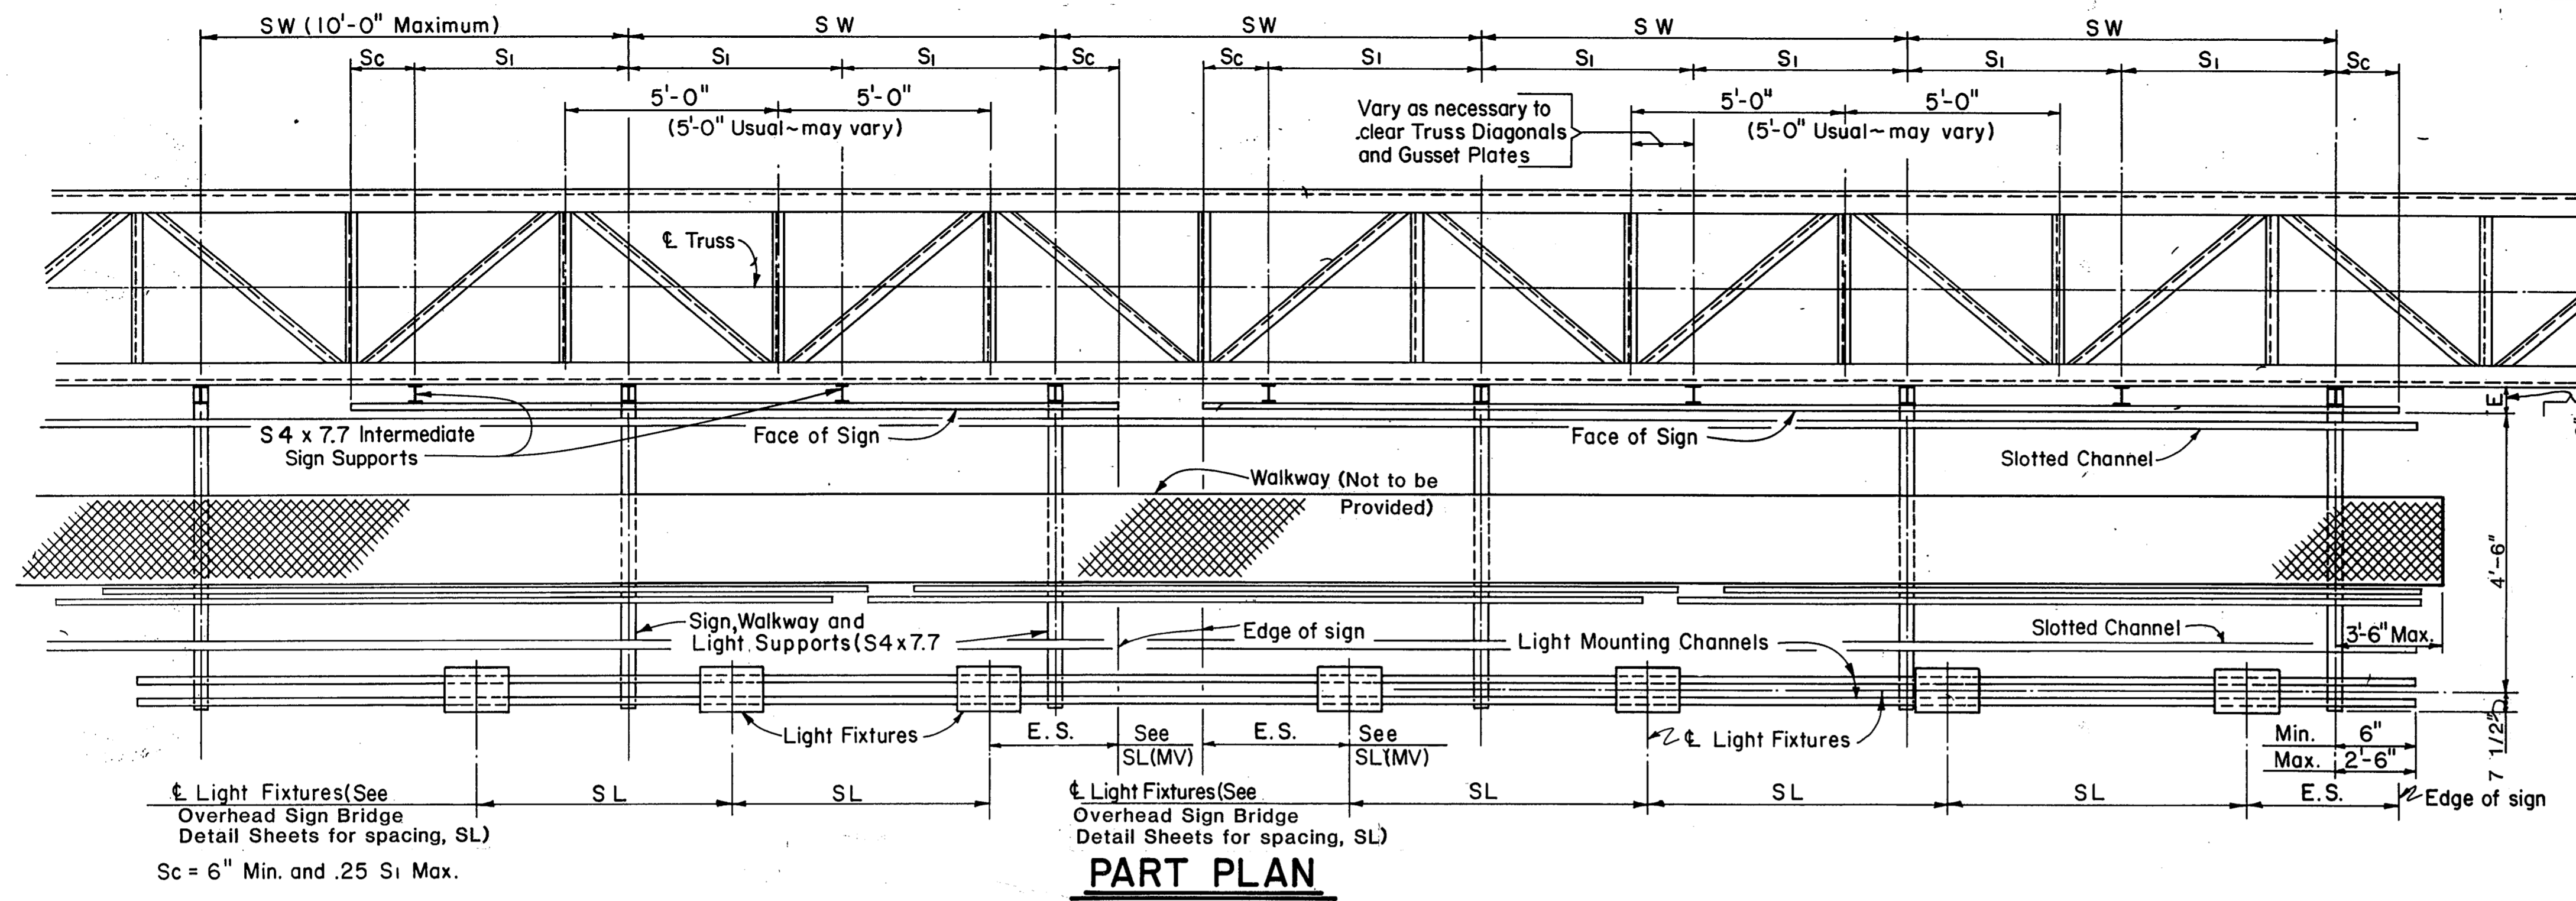





**PART PLAN**  
(Showing Truss, Signs, Walkways and Lights)

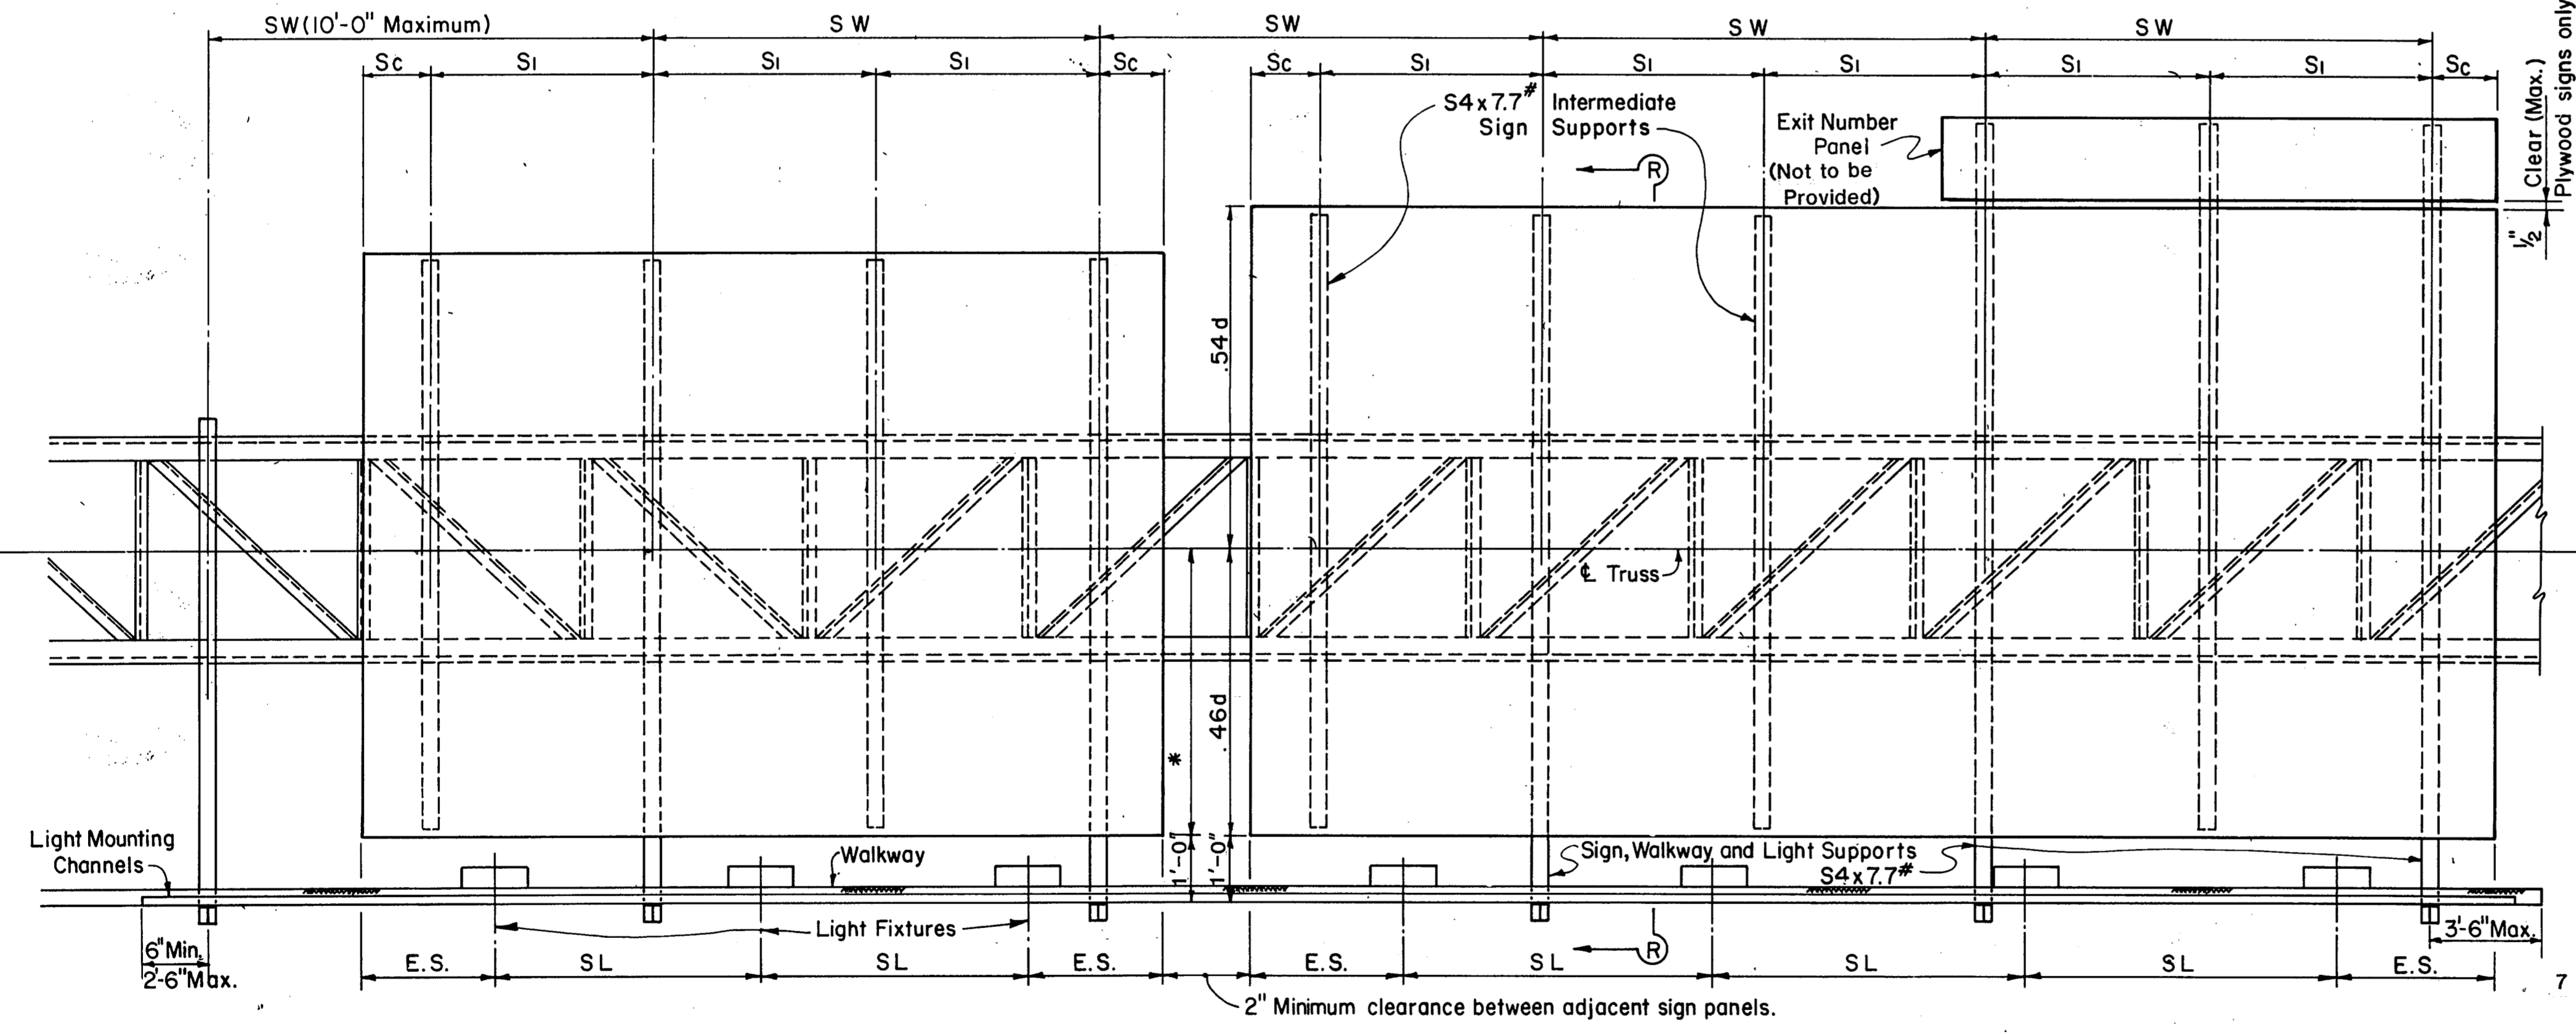

**PART ELEVATION**

\* Where signs of different depths are used, the bottom edges of all signs may be placed in line. Where this is done, all signs should be so positioned that the bottom edges are approximately 0.46 of the depth of the deepest sign below the  $\epsilon$  of the truss. When signs are spaced thusly,  $S_1$  is determined by the deepest sign.

See Overhead Sign Bridge Detail Sheets for Spacing SL & E.S.  
See Standard Drawing No. SS-19 for Aluminum Sign Details & Max. Spa. for Si.  
Sc = 6" Minimum, .25 Si Maximum.

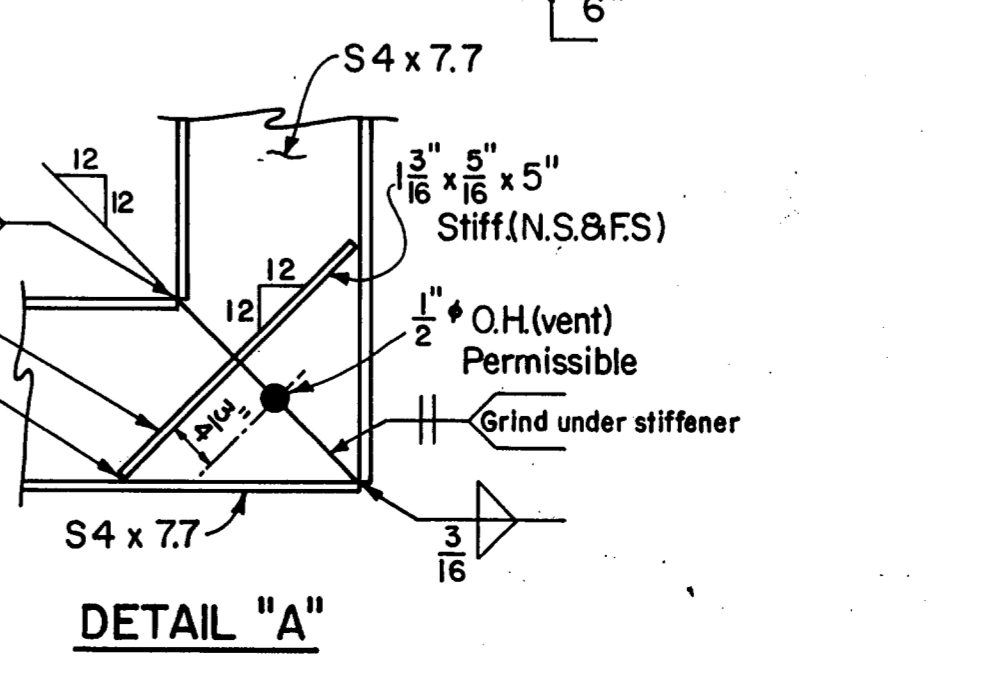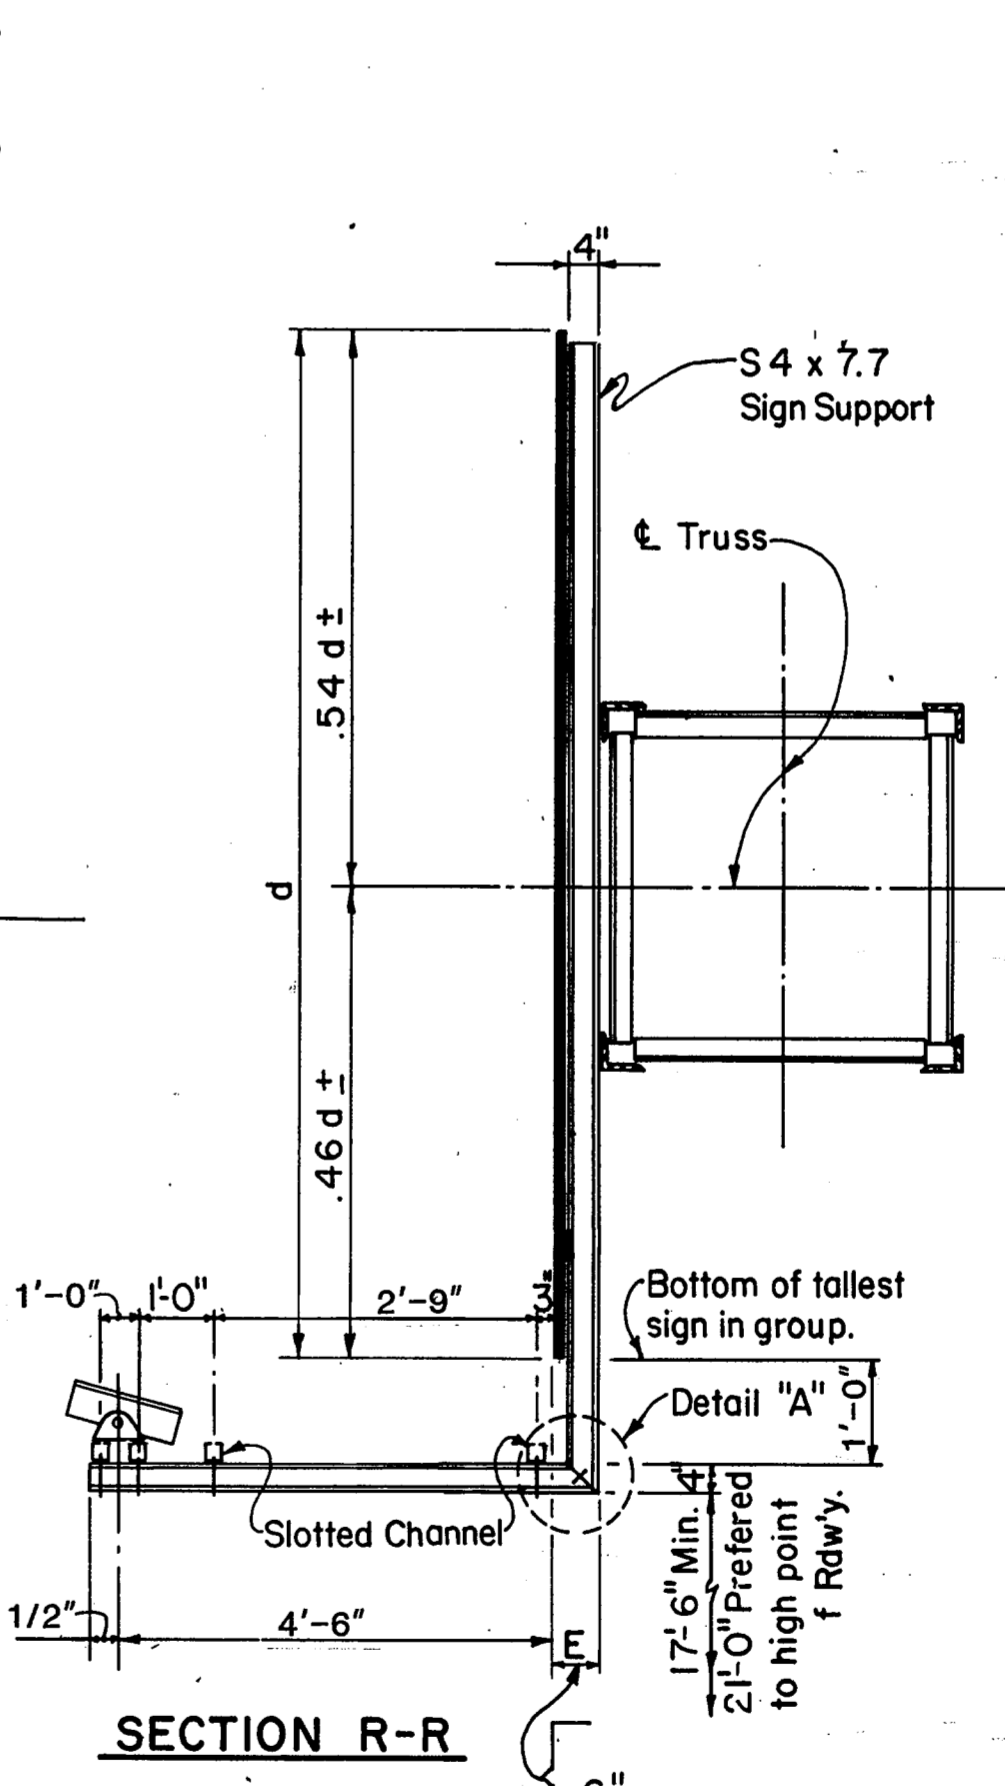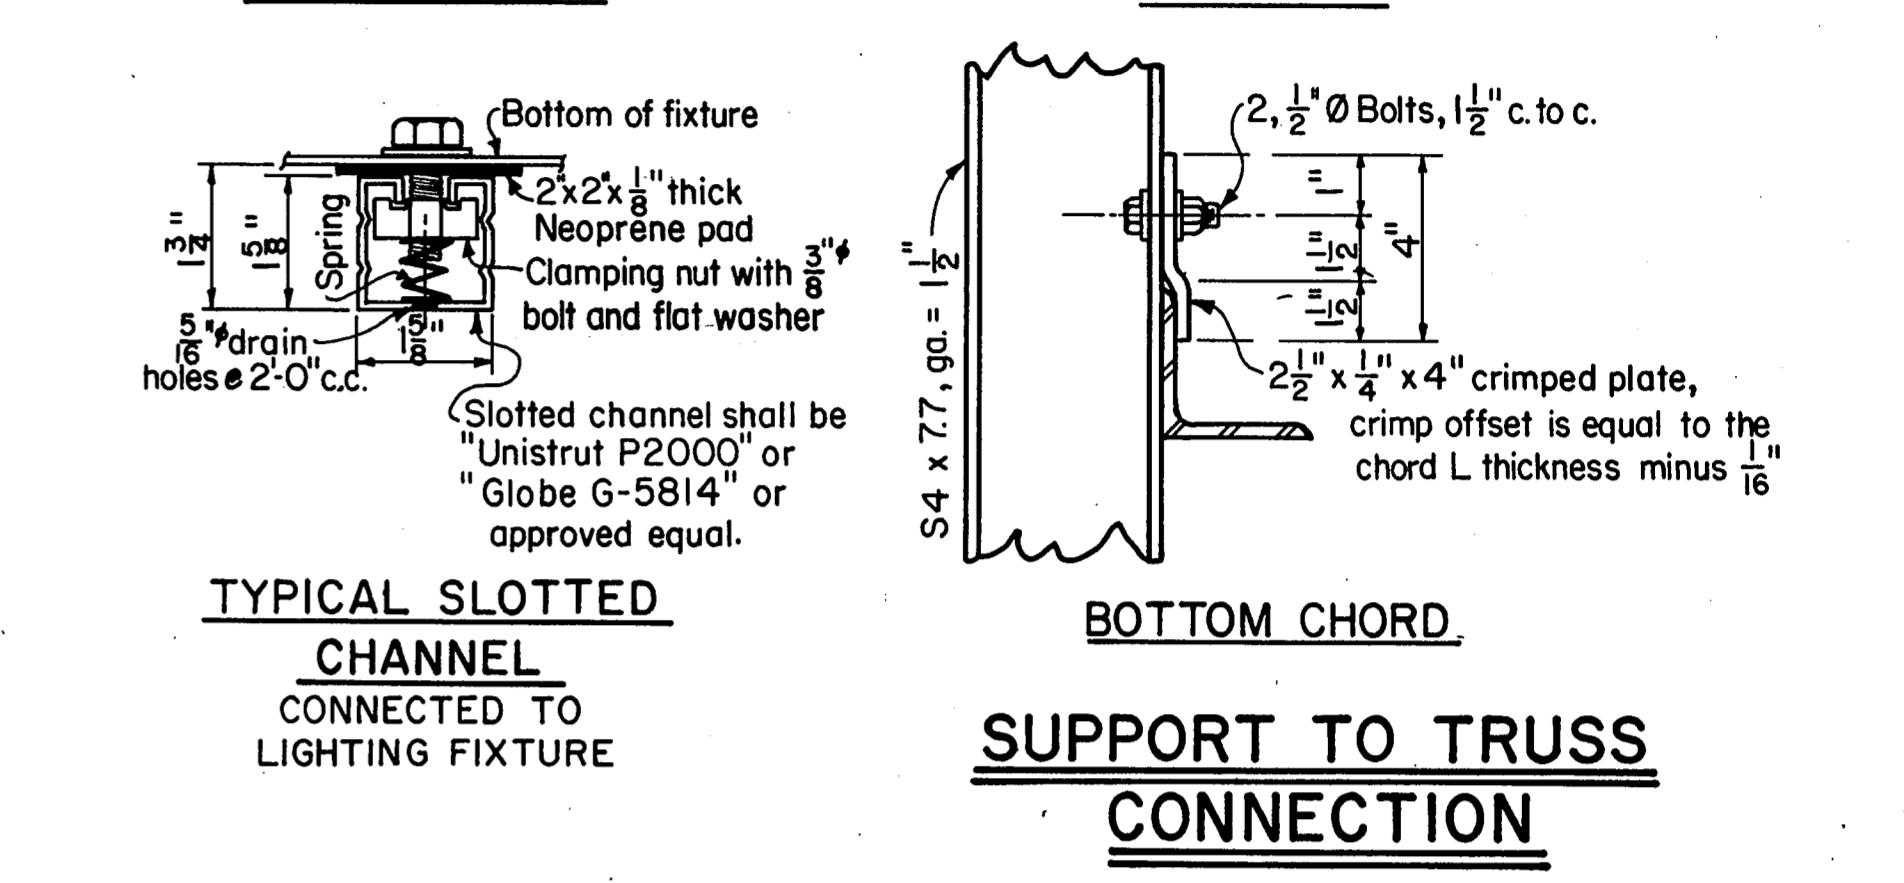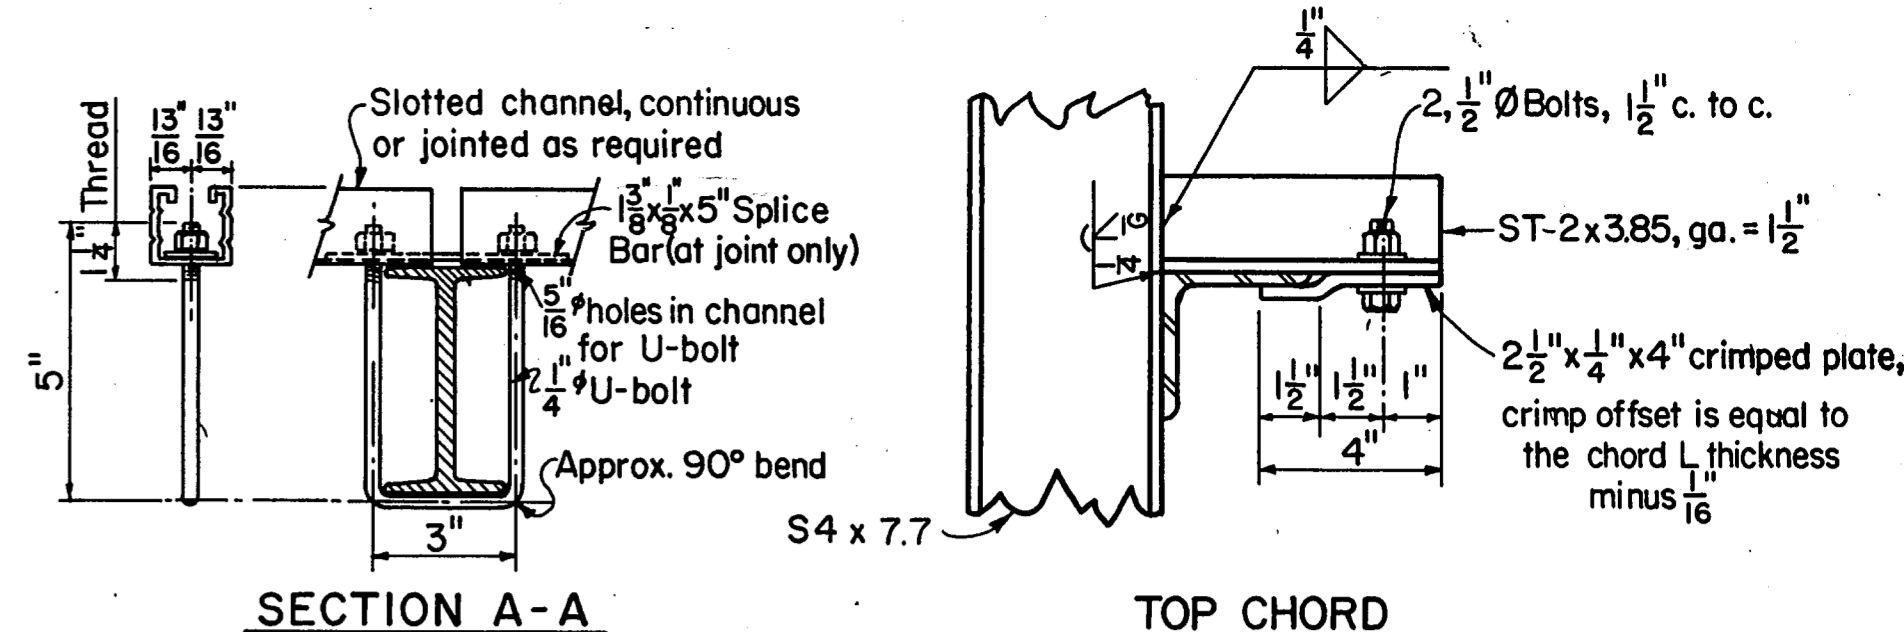

**GENERAL NOTES:**  
Design conforms to the AASHTO Standard Specifications for Structural Supports for Highway Signs, Luminaires and Traffic Signals.  
Materials, Fabrication, Construction and Erection shall conform with the requirements of specifications for Interstate Signage and Delineation Projects and Texas Department of Highways and Public Transportation Standard Specifications for Construction of Highways, Streets and Bridges. Structural Steel shall conform with A.S.T.M. Specification A 36 unless noted otherwise.  
Bolts shall have Hexagon Heads and Nuts and conform with A.S.T.M. Specification A 307.  
All parts shall be galvanized after fabrication.  
Sign Walkways shall not be provided for this Project.


REPRODUCED FROM STATE DEPARTMENT OF HIGHWAYS AND PUBLIC TRANSPORTATION STANDARD DRAWING SB(SWL-1)

**FINAL RECORD DRAWING**  
Date: 12/25/99

1. MISC. REVISIONS		GRB.	4-1-86
NO.	REVISION	BY	DATE
<b>TEXAS TURNPIKE AUTHORITY</b>			
<b>DALLAS NORTH TOLLWAY</b>			
SUPPORT BRACKETS FOR SIGNS, WALKWAY & LIGHTS 31			
<b>HNTB</b> HOWARD NEEDLES TAMMEN & BERGENDOFF			
DRAWN	DATE	DESIGNED	DATE
CHECKED	DATE	SCALE	
STANDARD DRAWING NO. SS-27			




TYPICAL ATTACHMENT OF ROUTE MARKERS AND "EXIT ONLY" PANELS TO GUIDE SIGNS

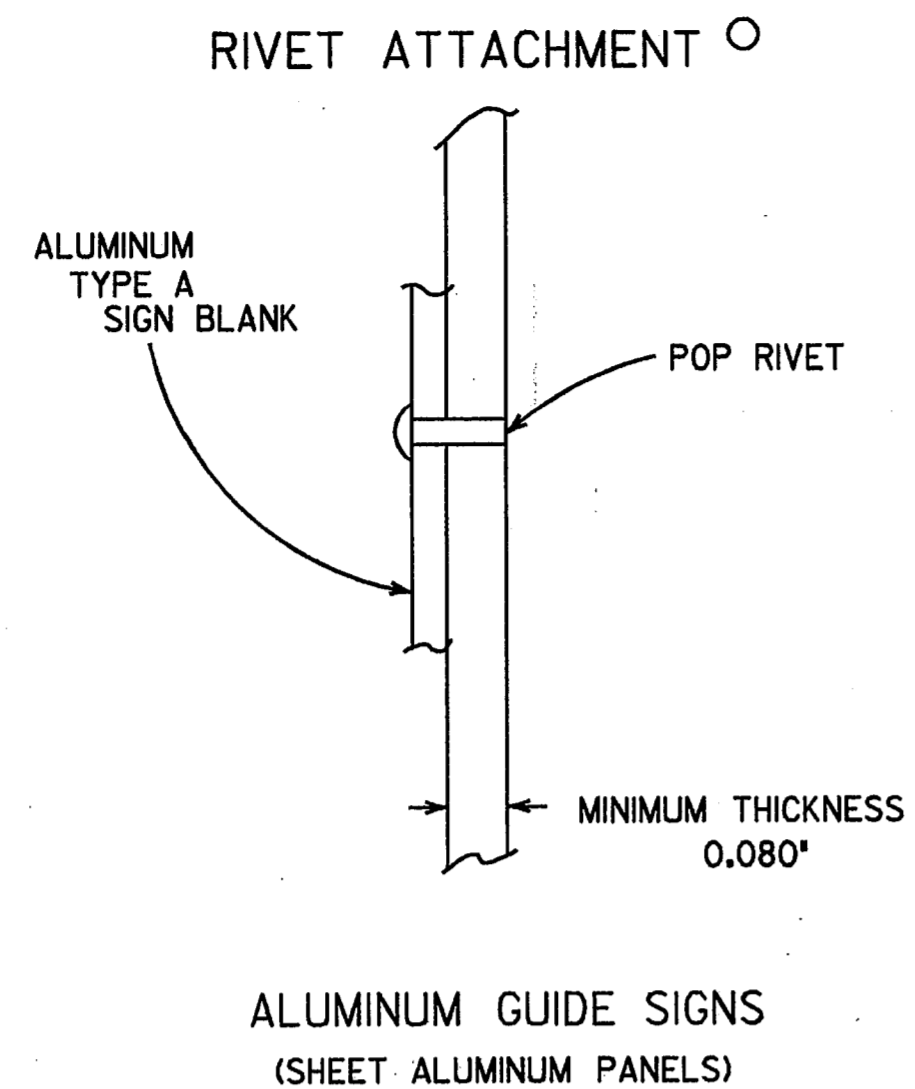

ALUMINUM GUIDE SIGNS  
(SHEET ALUMINUM PANELS)


△

SIGN BLANK PUNCHING DETAILS FOR ROUTE MARKERS WHEN ATTACHED TO GUIDE SIGN

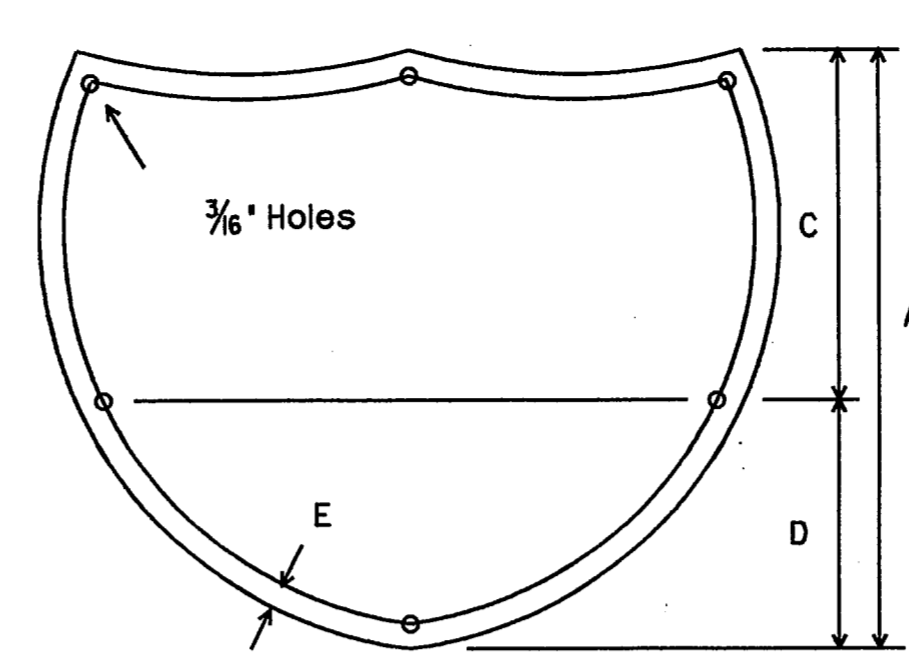


INTERSTATE ROUTE MARKERS

A	C	D	E
36	21	15	1/2
48	28	20	3/4

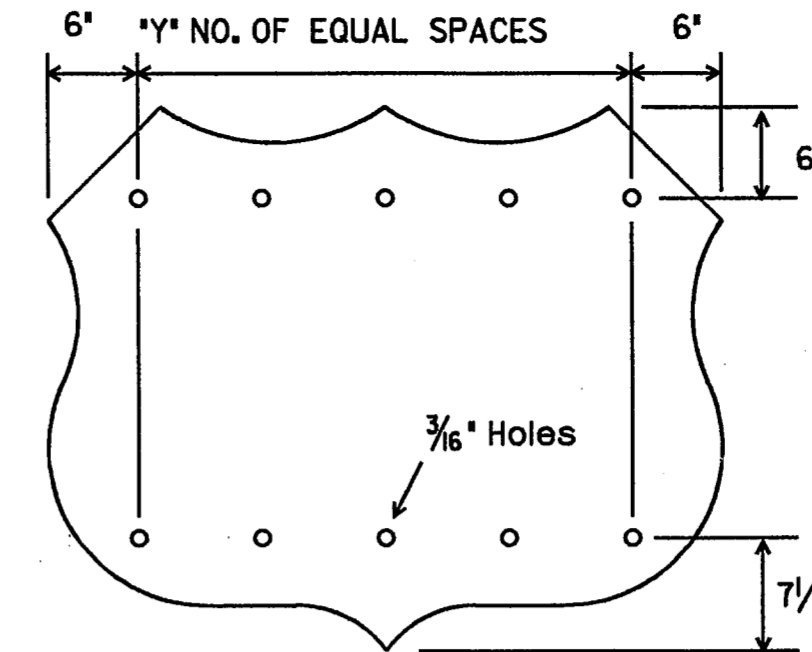

U.S. ROUTE MARKERS

Sign Type	"Y"
MI-4D2	2
MI-4D3	3
MI-4E2	3
MI-4E3	4
MI-4F2	4
MI-4F3	5

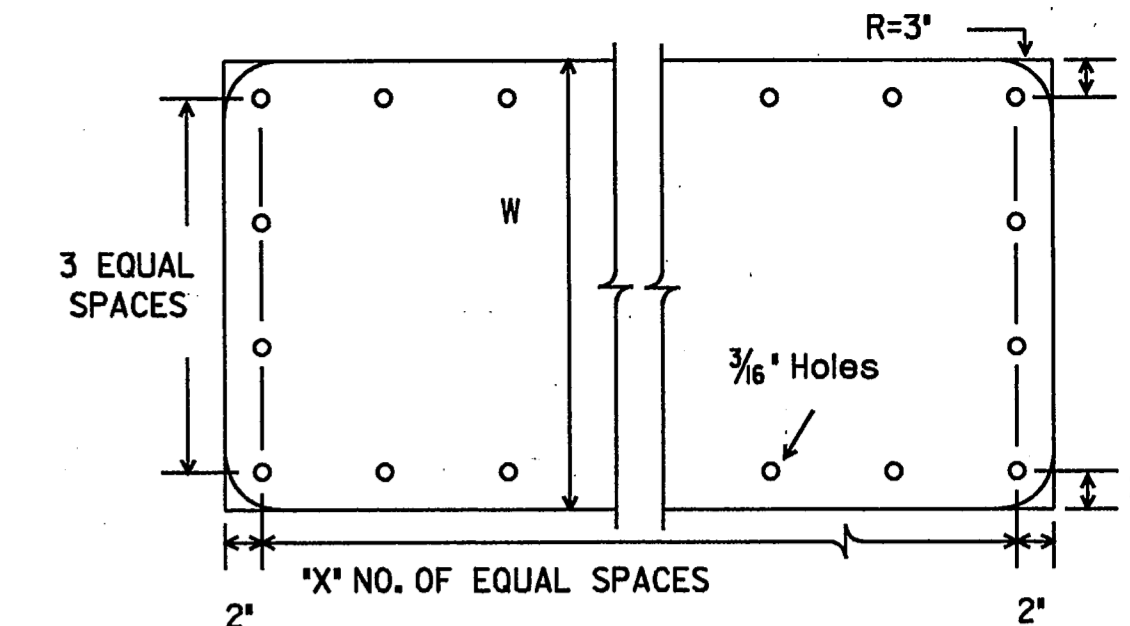


STATE ROUTE MARKERS

No. of Digits	W	X
4	24	4
4	36	5
4	48	6
3	24	3
3	36	4
3	48	5


DISCLAIMER  
 The use of this standard is governed by the "Texas Engineering Practice Act". No warranty of any kind is made by TxDOT for any purpose whatsoever. TxDOT assumes no responsibility for the conversion of this standard to other formats or for incorrect results or damages resulting from its use.

DNHLR  
 CKCW  
 DWHDN  
 CKRMT  
 DATE: 12 13 14 15 16  
 FILE: 1 2 3 4 5 6 7 8 9 10 11 12 13 14 15 16 17 18 19 20 21 22 23 24 25 26 27 28 29 30 31 32 ACC: d58hpic/usr/d580504  
 LEVELS DISPLAYED: 1 2 3 4 5 6 7 8 9 10 11 12 13 14 15 16 17 18 19 20 21 22 23 24 25 26 27 28 29 30 31 32


ARROW DIMENSION DETAILS

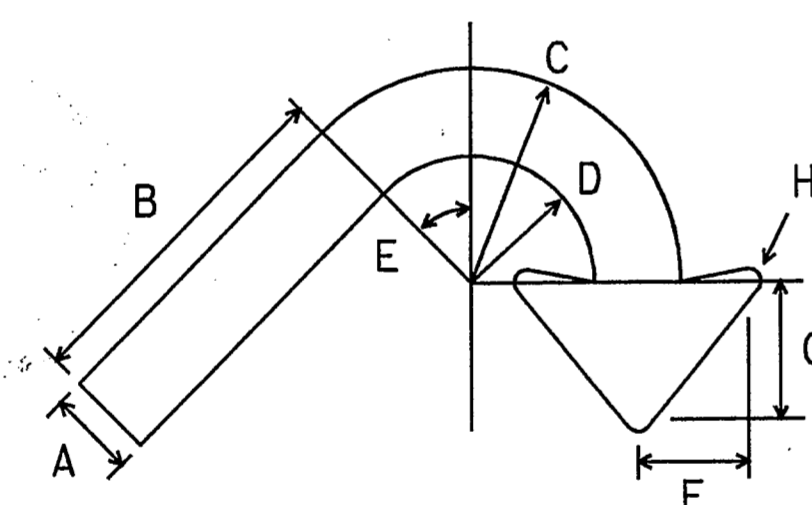


E3 and E3a

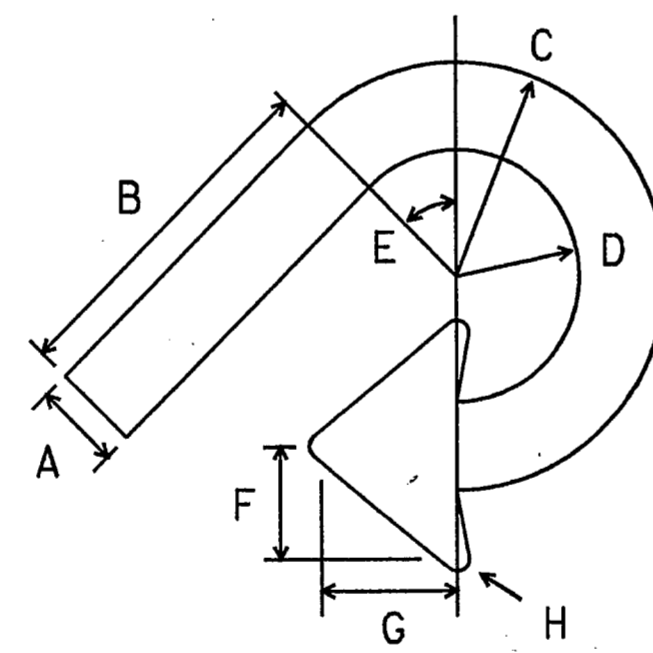


E4 and E4a

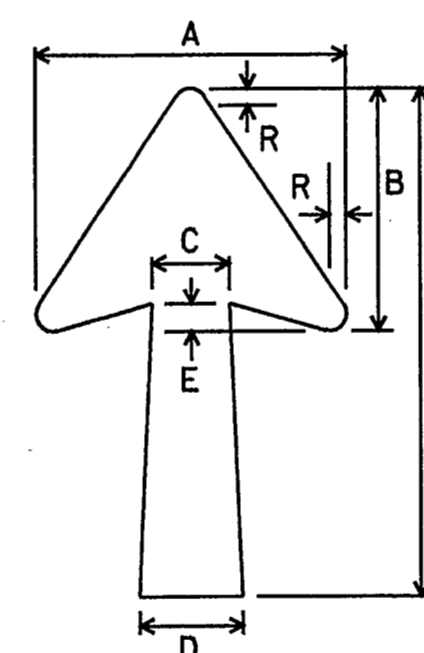

Type A or Type B

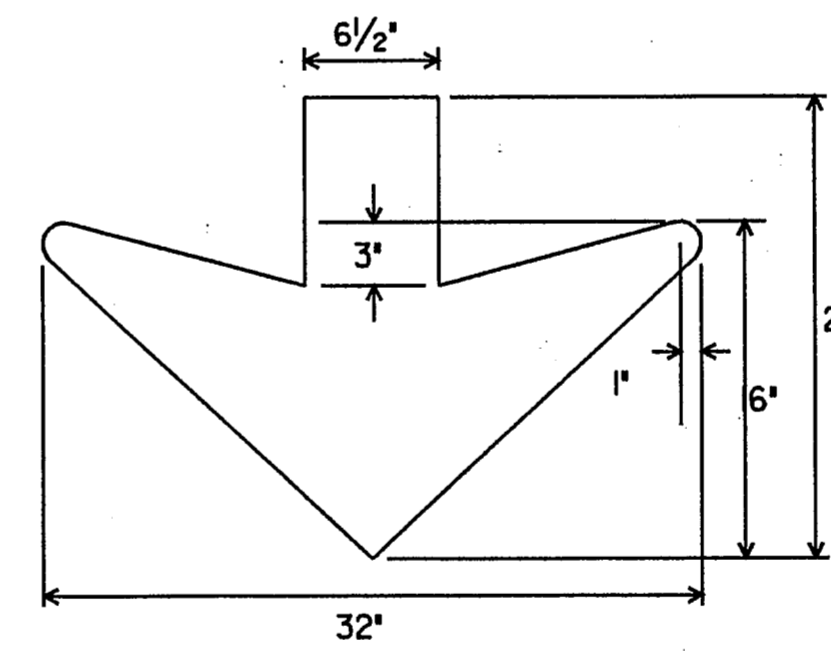

Type C

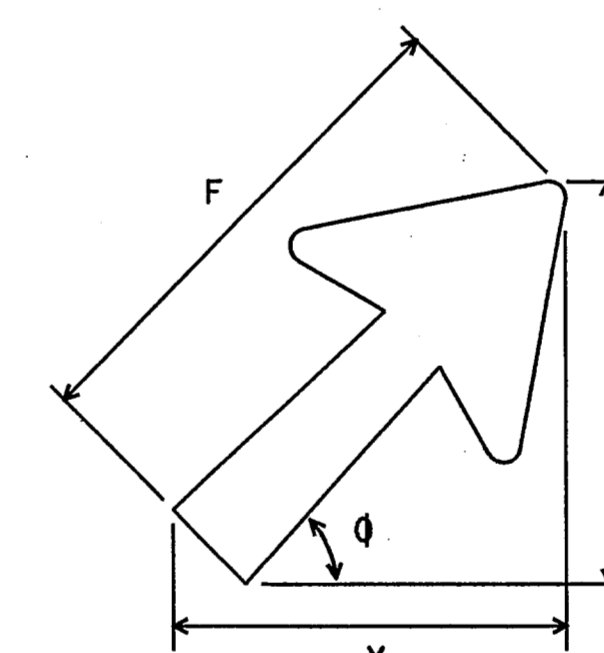


CODE	USED ON SIGN NO.	A	B	C	D	E	F	G	H
E-3 & E-4	E5-3 and E5-4	5	20	12	7	45o	6 1/2	8	3/4
E-3a & E-4a	E5-3a and E5-4a	3 1/2	14	8 1/2	5	45o	4 1/2	5 1/2	1/2

CODE	LETTER SIZE	ARROW DIMENSIONS IN INCHES												
		A	B	C	D*	E	F*	R	φ = 30°		φ = 45°		φ = 60°	
									X	Y	X	Y	X	Y
A-1	8" Caps	15 1/8	11 9/16	3 3/4	5	1 5/16	24 1/4	1 3/16	15 5/8	22 1/4	19 1/8	19 1/8	22 3/8	15 5/8
A-2	13 1/3" U.C., 10-12" Caps	18 1/4	14	4 1/2	6	1 1/2	29 1/4	3/4	18 1/2	27	23	23	27	19
A-3	16" U.C.	22 1/4	17	5 3/8	7 1/8	1 3/4	35 5/8	1	22 5/8	32 3/4	28	28	32 3/4	22 3/4
B-1	8-10" Caps	14 1/4	9 3/16	3 3/8	4 1/2	1 5/16	17 1/4	3/4	12 1/2	16 1/4	14	14	16 1/8	12 1/2
B-2	13 1/3" U.C., 12" Caps	17 1/2	11 3/4	4 3/8	5 5/8	1 1/2	20 1/4	7/8	15 1/2	19 1/8	16 5/8	16 5/8	19	15 1/2
B-3	16" U.C.	21 7/8	14 1/4	5	6 3/4	1 3/4	25	1	19 1/8	23 1/2	20 3/8	20 3/8	23 1/2	19 1/4

WHERE AN ARROW IS REQUIRED ON A GUIDE SIGN WHICH HAS A HEIGHT OF 2'-0" AND WHICH IS USUALLY ERECTED ON RAMP AND CROSSROADS AT INTERCHANGES, THE ARROW SHALL BE TYPE B-1.

\* RECOMMENDED DIMENSIONS: TAPER SHOULD BE HELD CONSTANT FOR LONGER OR SHORTER SHAFT LENGTHS.

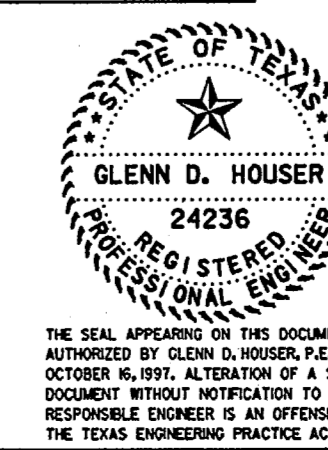

SPECIFICATION REFERENCE TABLE	
MATERIALS AND TEST SPECIFICATIONS (D-9)	D-9-710
ALUMINUM SIGN BLANKS	D-9-710
SIGN HARDWARE	D-9-7120
FLAT SURFACE REFLECTIVE SHEETING, TYPE C (HIGH SPECIFIC INTENSITY)	D-9-8300

GENERAL NOTES:

Route markers attached to guide signs shall be one piece sheet aluminum alloy conforming with Department Specification "Aluminum Signs (Type A)". Sketches shown are examples only.

Screws and washers shall be used unless otherwise noted in the plans. Screws or bolts, nuts and washers shall be stainless steel or aluminum.

Arrows shall be cut-out reflective sheeting (Type C) applied directly to sign background, or reflective sheeting (Type C) applied to one piece 0.063 inch thick sheet aluminum alloy conforming with Department Specification "Aluminum Signs (Type A)". Attachment of arrows applied to sheet aluminum alloy shall be as illustrated for sign blanks.

FINAL RECORD DRAWING

Date: 12/25/99

ISSUE DATE: 04-09-97

STANDARD PLANS  
TEXAS DEPARTMENT OF TRANSPORTATION  
Traffic Operations Division

ARROW AND ROUTE MARKER ATTACHMENT DETAILS FOR GUIDE SIGNS

IM(2)-93 (MOD.)


9-93	REVISED	STATE DISTRICT	FEDERAL REGION	FEDERAL AID PROJECT	SHEET
11-96		6			32
4-97		COUNTY	CONTROL SECTION	JOB	HIGHWAY

DISCLAIMER  
The use of this standard is governed by the "Texas Engineering Practice Act". No warranty of any kind is made by TxDOT for any purpose whatsoever. TxDOT assumes no responsibility for the conversion of this standard to other formats or for incorrect results or damages resulting from its use.

DATE: 10/11/11  
DWG: I-5  
CHK: CW  
DWG: D9-2  
CHK: MT


LEVELS DISPLAYED:  
1 2 3 4 5 6 7 8 9 10 11 12 13 14 15 16 17 18 19 20 21 22 23 24 25 26 27 28 29 30 31 32 33 34 35 36 37 38 39 40 41 42 43 44 45 46 47 48 49 50 51 52 53 54 55 56 57 58 59 60 61 62 63

DATE: 05/04/11  
ACC: d58hplc/usr/d580504  
FILE:

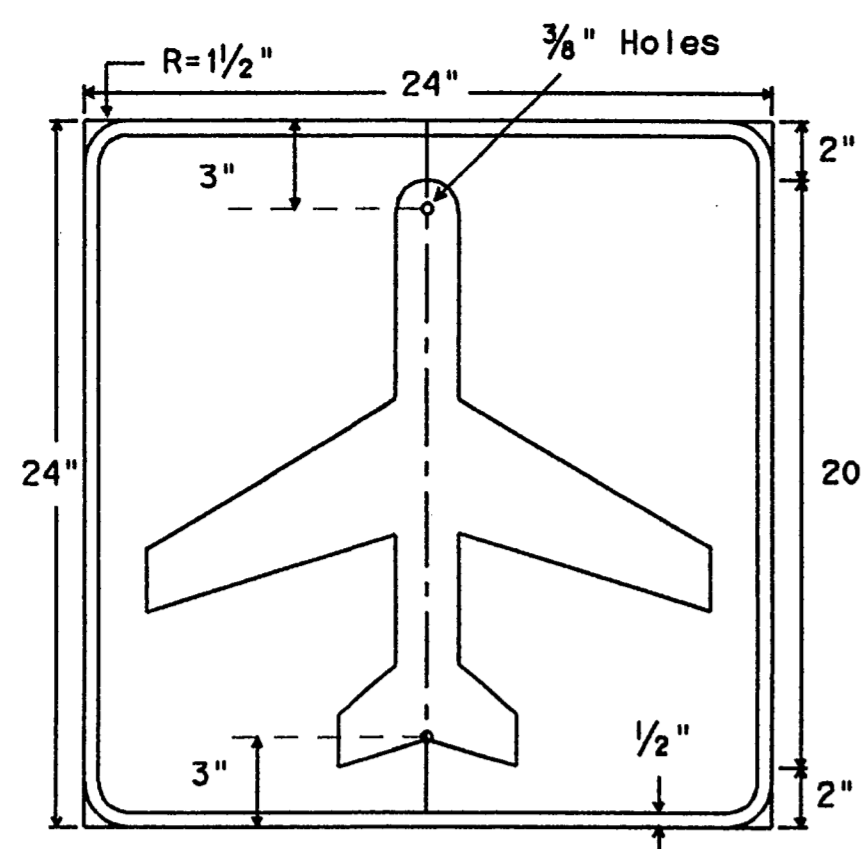


I-5  
24" X 24"

Symbol - White Reflective  
Border - White Reflective  
Background - Green Reflective

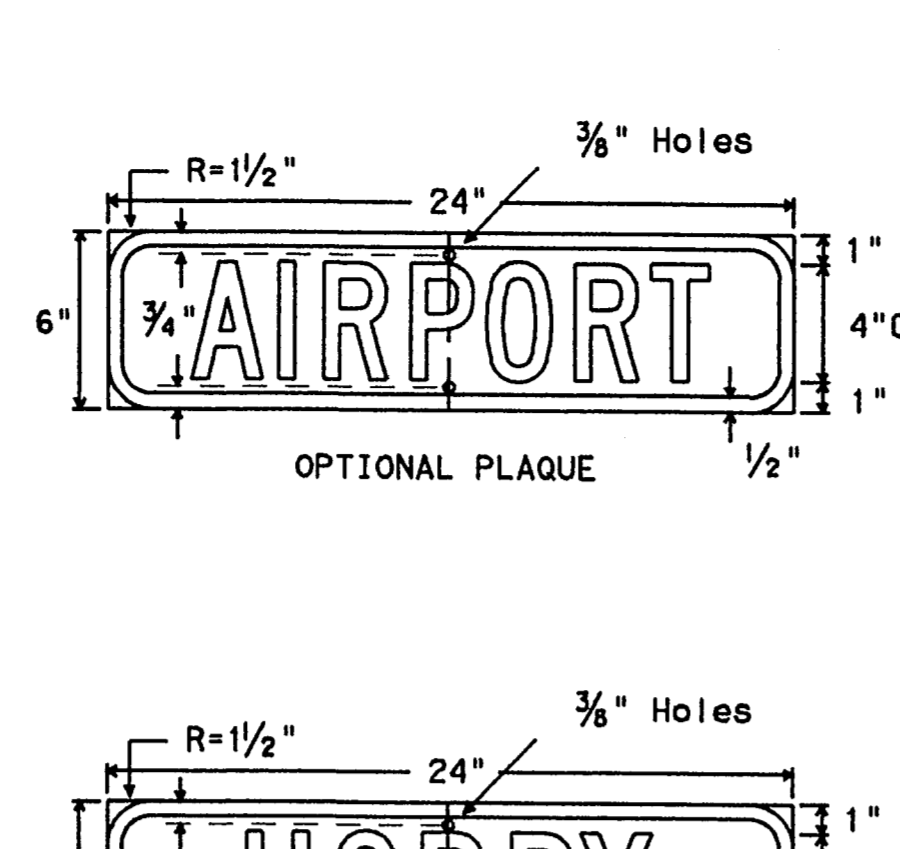


OPTIONAL PLAQUE

Symbol - White Reflective  
Border - White Reflective  
Background - Green Reflective

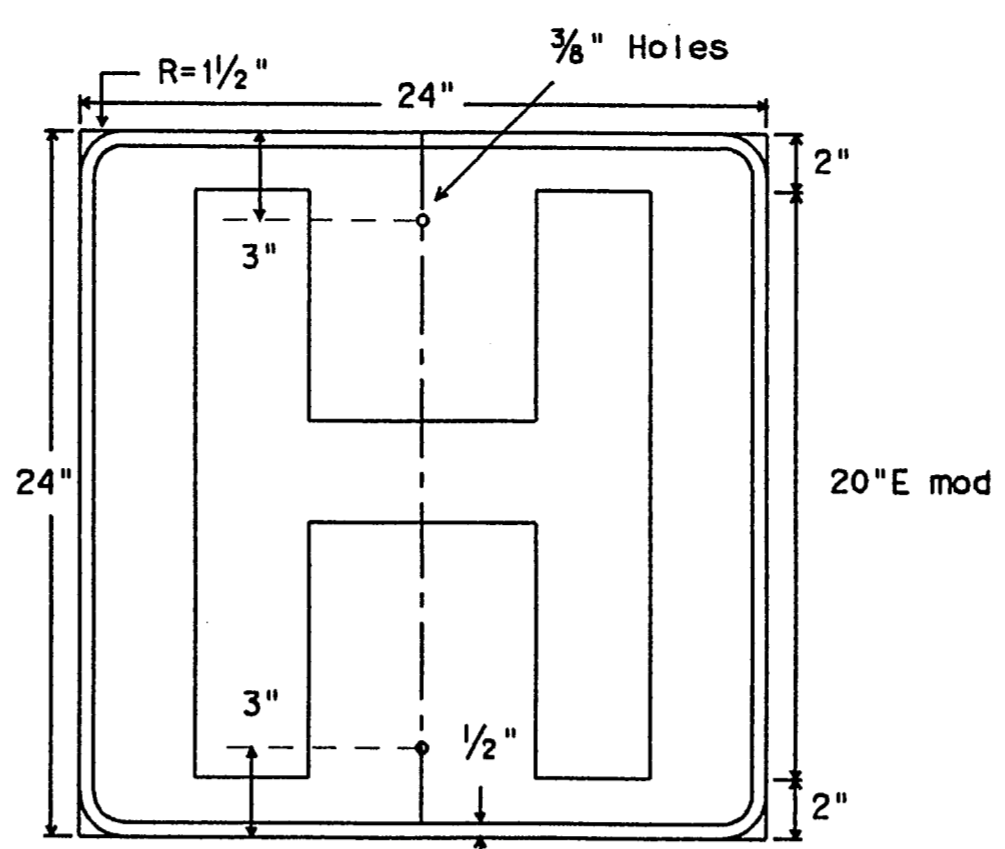


D9-2  
24" X 24"

Symbol - White Reflective  
Border - White Reflective  
Background - Blue Reflective


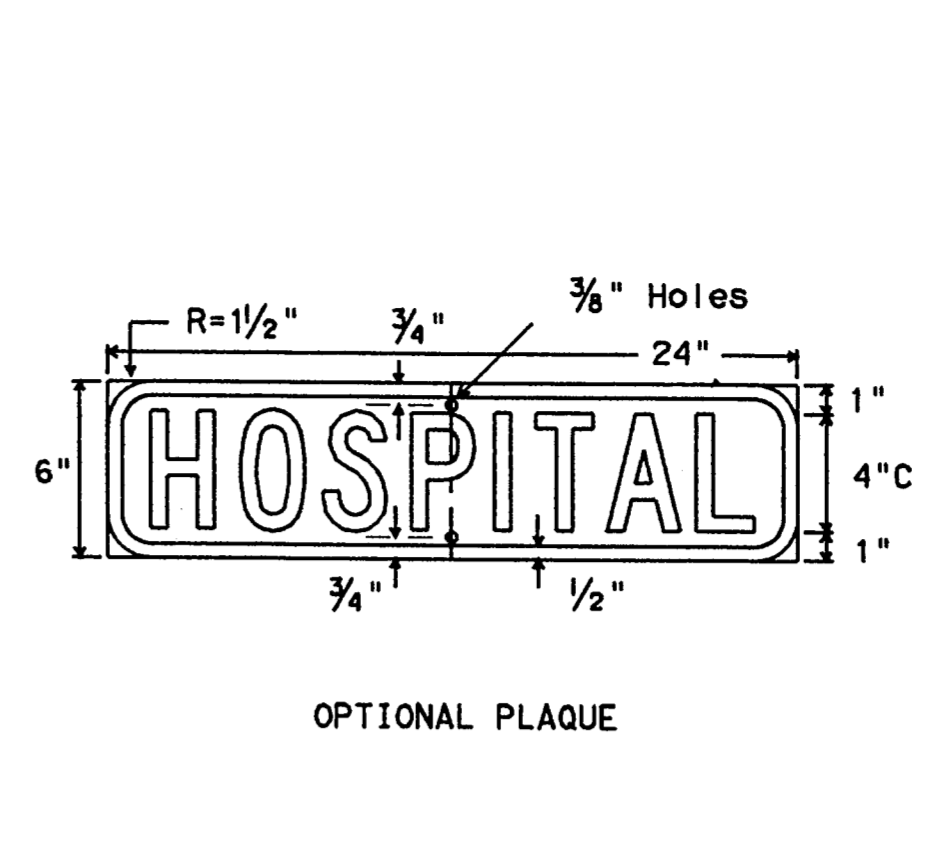


OPTIONAL PLAQUE

Symbol - White Reflective  
Border - White Reflective  
Background - Blue Reflective

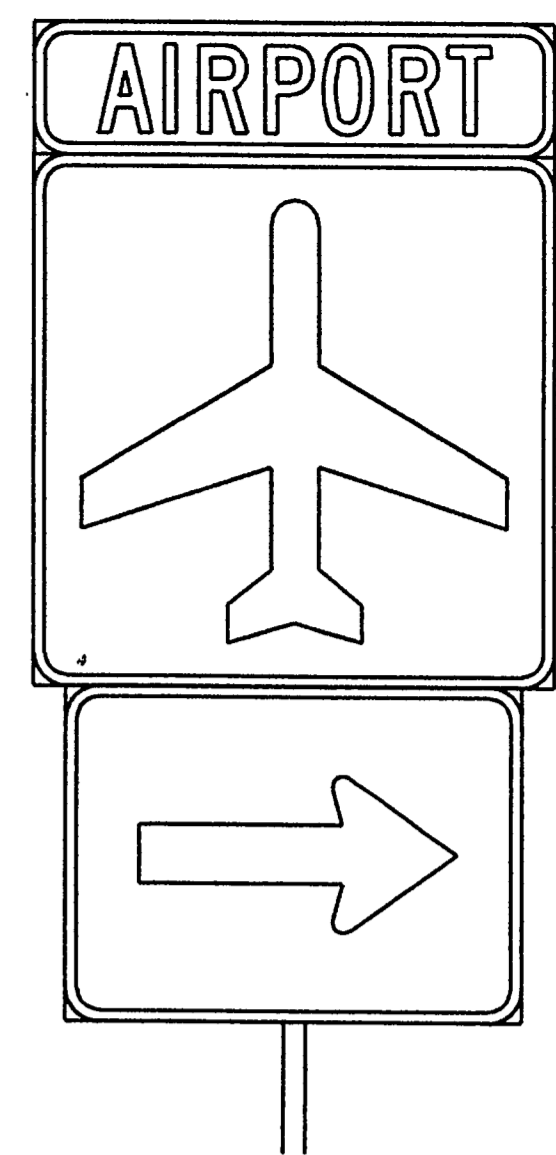


TYPICAL ASSEMBLY

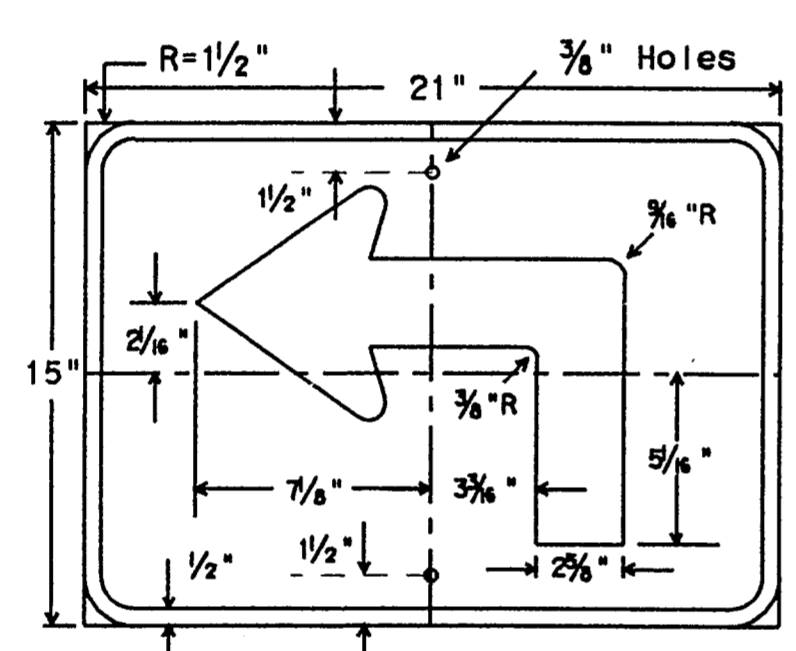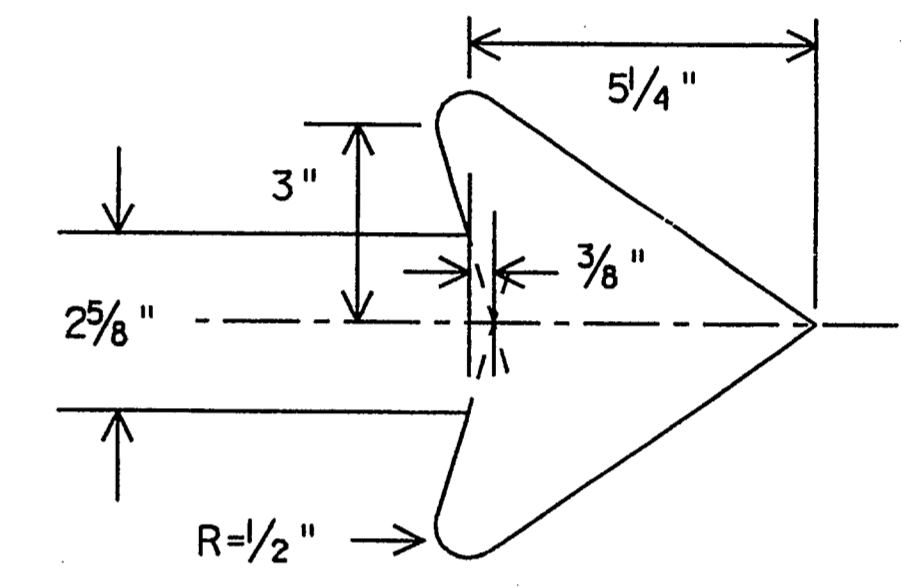


M5-1BL  
M5-1BR  
21" X 15"

Symbol - White Refl.  
Border - White Refl.  
Background - Blue Refl.

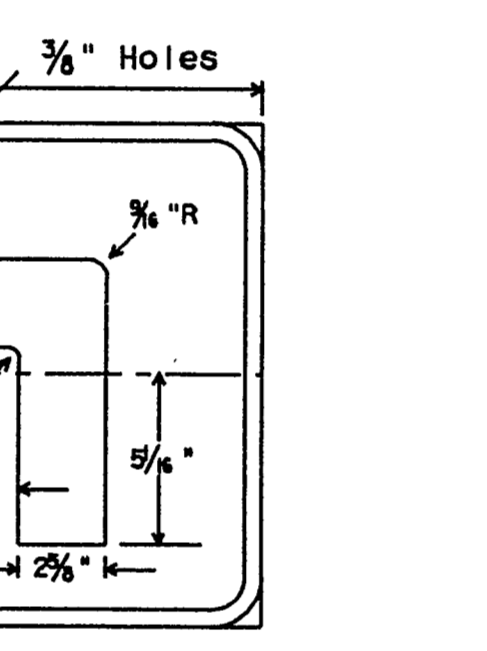


M5-1GL  
M5-1GR  
21" X 15"

Symbol - White Refl.  
Border - White Refl.  
Background - Green Refl.

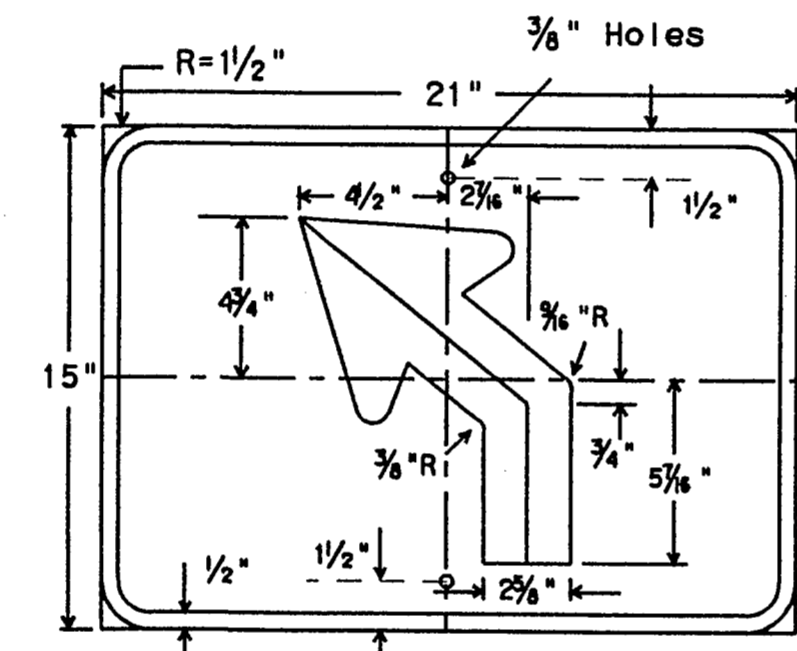


M5-2BL  
M5-2BR  
21" X 15"

Symbol - White Refl.  
Border - White Refl.  
Background - Blue Refl.

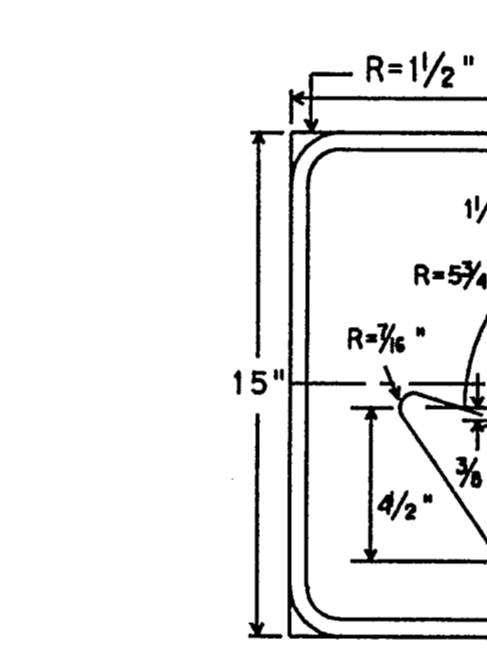


M5-2GL  
M5-2GR  
21" X 15"

Symbol - White Refl.  
Border - White Refl.  
Background - Green Refl.

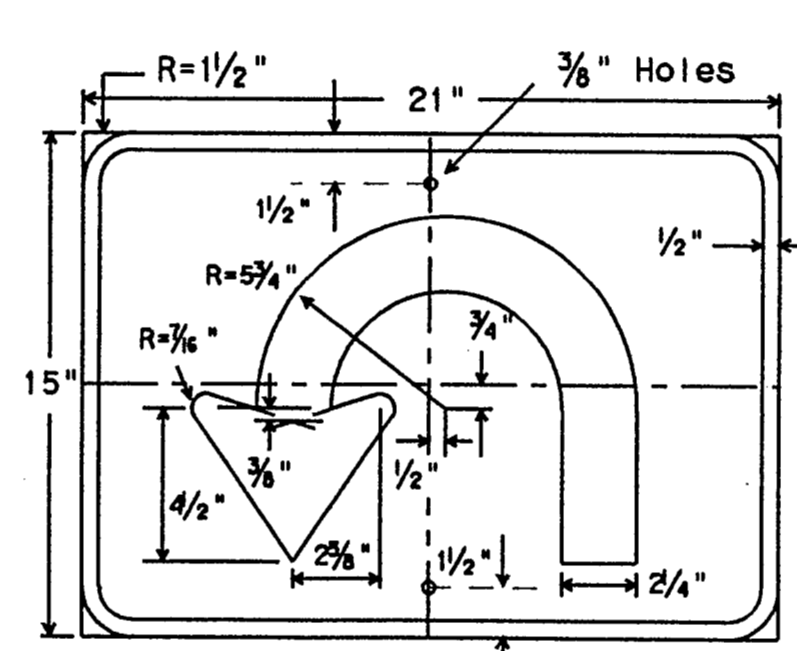


M5-3BL  
21" X 15"

Symbol - White Refl.  
Border - White Refl.  
Background - Blue Refl.

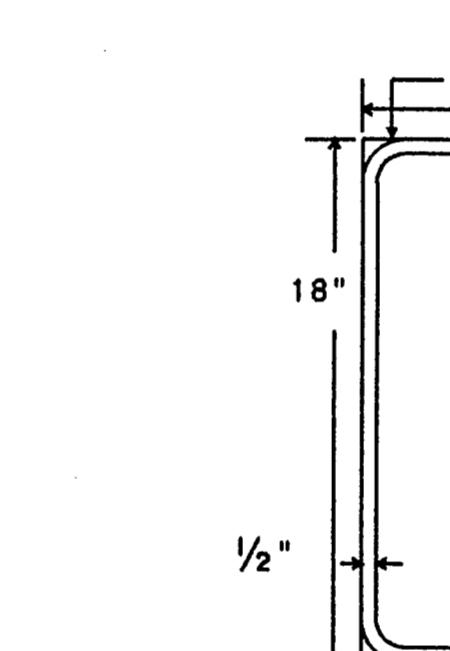


M5-3GL  
21" X 15"

Symbol - White Refl.  
Border - White Refl.  
Background - Green Refl.

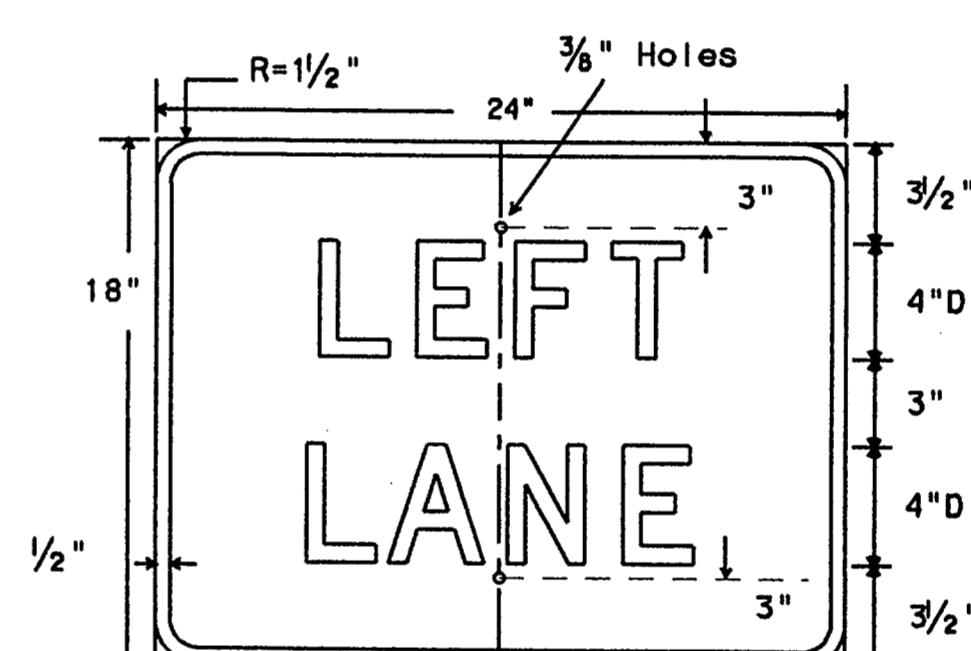


M6-8BL  
24" X 18"

Letters - White Refl.  
Border - White Refl.  
Background - Blue Refl.

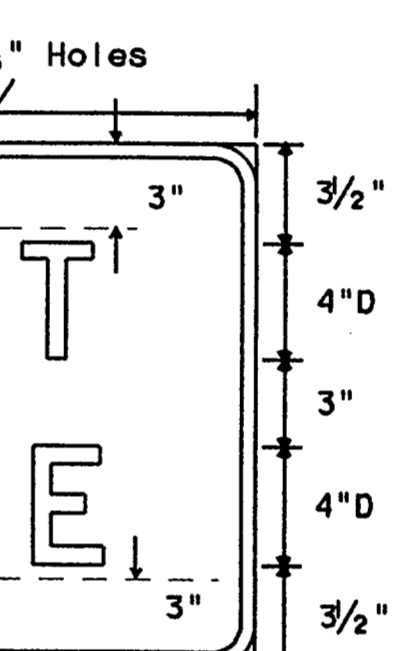


M6-8GL  
24" X 18"

Letters - White Refl.  
Border - White Refl.  
Background - Green Refl.

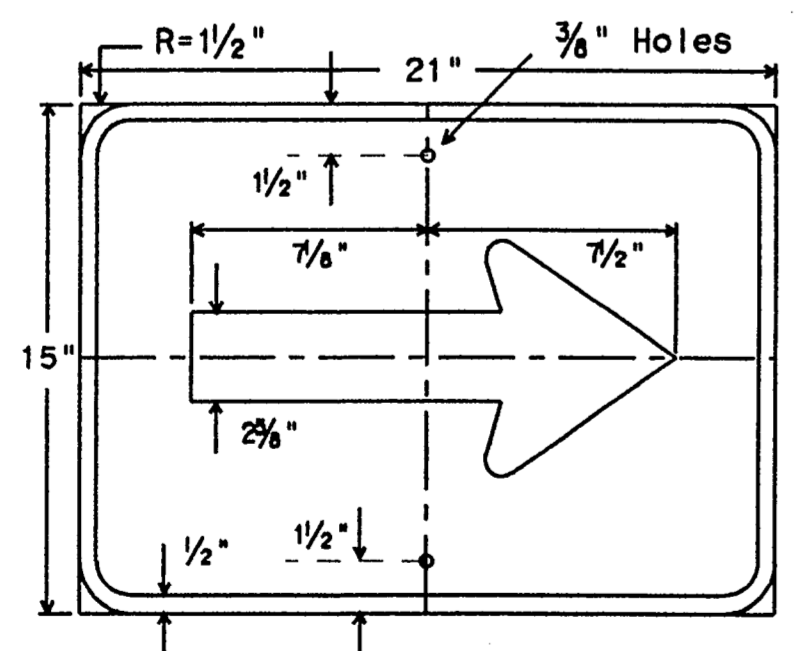


M6-1B  
21" X 15"

Symbol - White Refl.  
Border - White Refl.  
Background - Blue Refl.

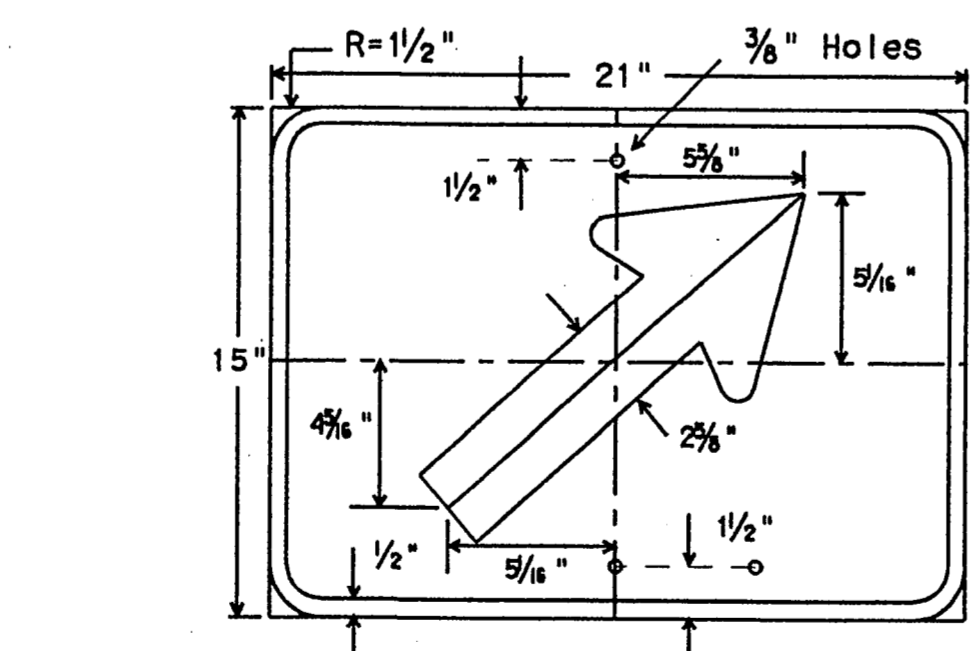


M6-1G  
21" X 15"

Symbol - White Refl.  
Border - White Refl.  
Background - Green Refl.

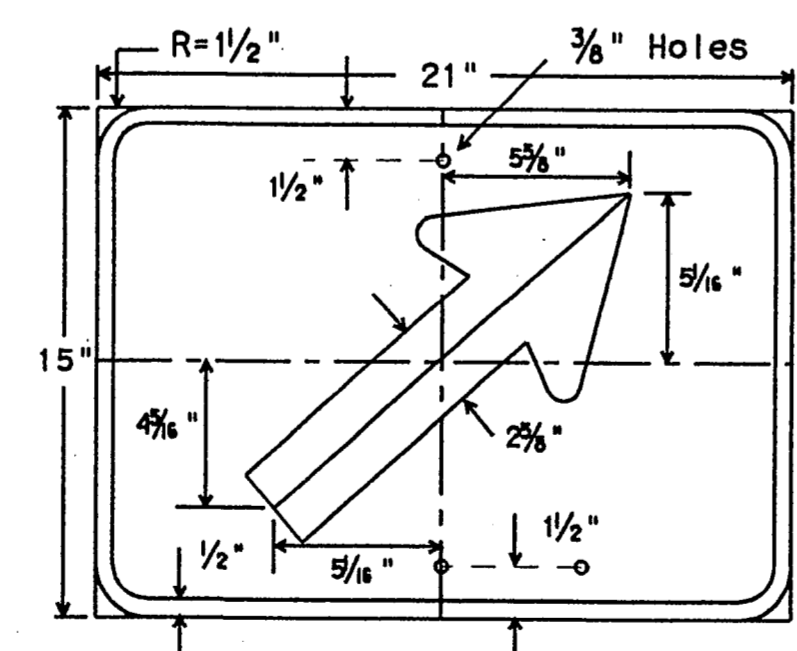


M6-2BR  
M6-2BL  
21" X 15"

Symbol - White Refl.  
Border - White Refl.  
Background - Blue Refl.

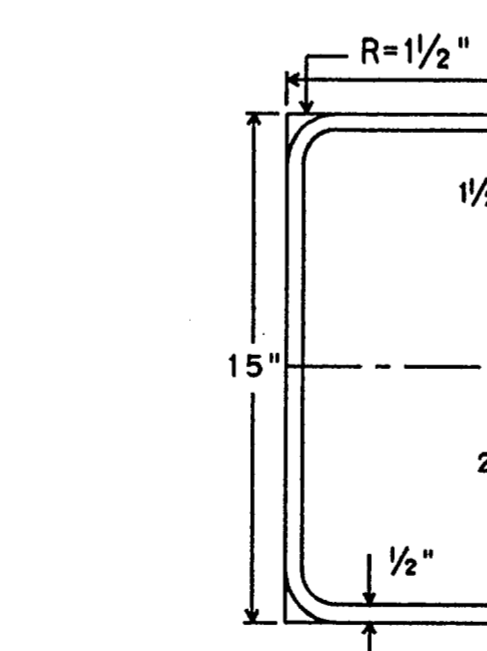


M6-2GR  
M6-2GL  
21" X 15"

Symbol - White Refl.  
Border - White Refl.  
Background - Green Refl.

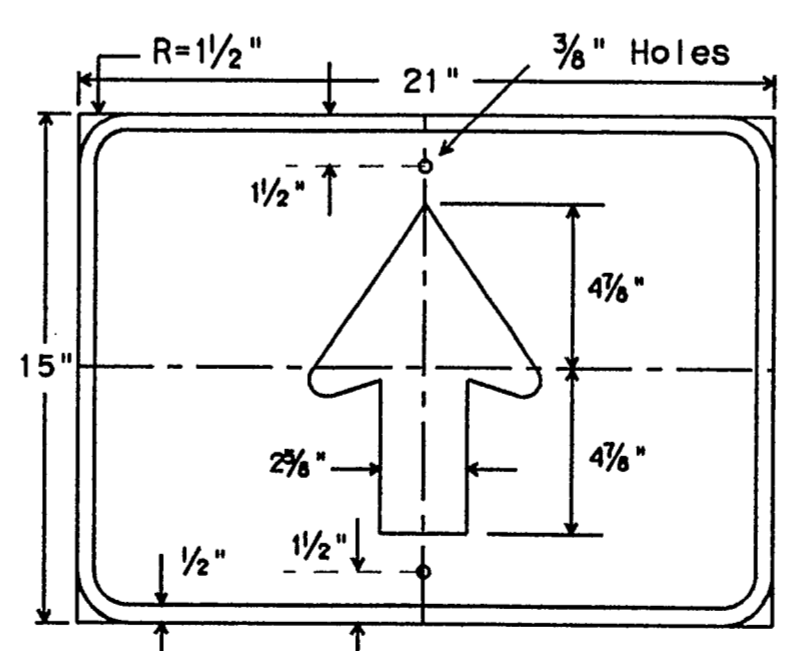


M6-3B  
21" X 15"

Symbol - White Refl.  
Border - White Refl.  
Background - Blue Refl.

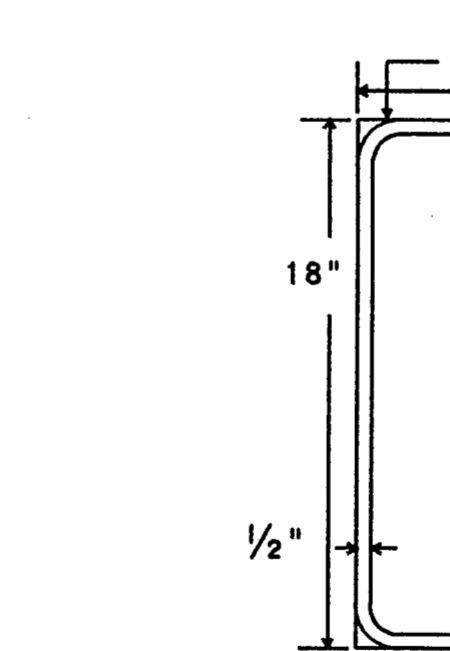


M6-3G  
21" X 15"

Symbol - White Refl.  
Border - White Refl.  
Background - Green Refl.

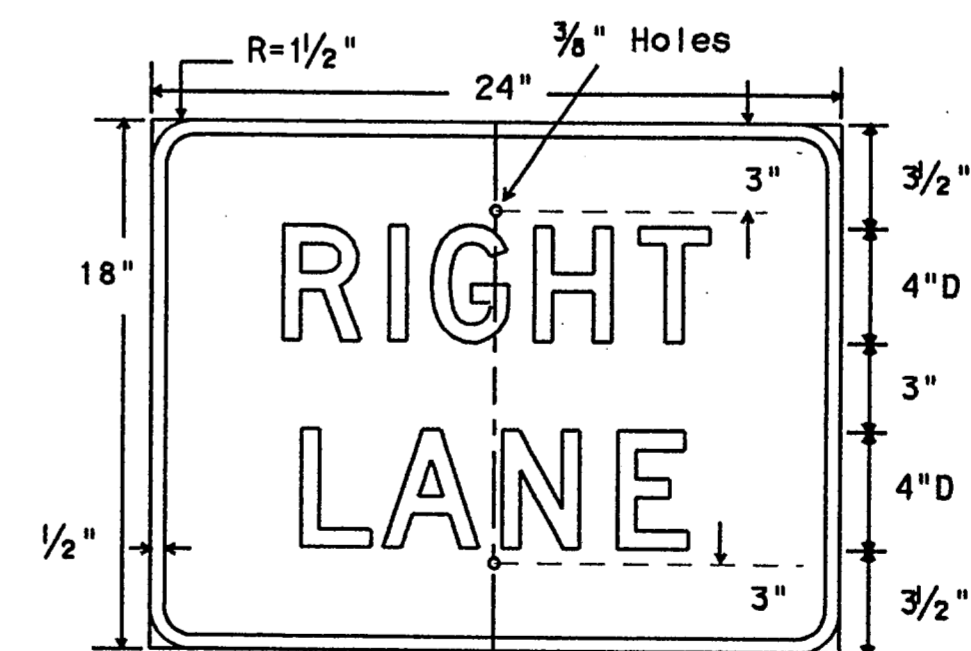

M6-8BR  
24" X 18"

Letters - White Refl.  
Border - White Refl.  
Background - Blue Refl.

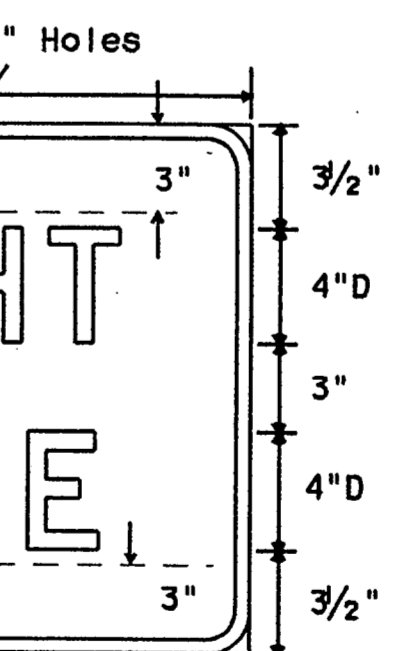

M6-8GR  
24" X 18"

Letters - White Refl.  
Border - White Refl.  
Background - Green Refl.

SPECIFICATION REFERENCE TABLE	
MATERIALS AND TESTS DIVISION SPECIFICATIONS	
ALUMINUM SIGN BLANKS	D-9-7110
REFLECTIVE SHEETING, TYPE C (HIGH SPECIFIC INTENSITY)	D-9-8300

GENERAL NOTES:

The alphabets and lateral spacing between letters and numerals shall conform with the Texas "Manual on Uniform Traffic Control Devices for Streets and Highways", latest edition, and any approved changes thereto. Lateral spacing of text shall provide a balanced appearance. All materials shall conform to Department Specifications.

Legend shall be applied by reverse screening process with transparent colored ink, cut-out white reflective sheeting applied to colored background or combination thereof. Background shall be reflective sheeting (Type C).

Sign blanks shall be 0.080 inch thick one piece sheet aluminum alloy conforming with Department Specification "Aluminum Signs (Type A)".

FINAL RECORD  
DRAWING  
Date: 12/25/99





STANDARD PLANS  
TEXAS DEPARTMENT OF TRANSPORTATION  
Traffic Operations Division

AIRPORT, HOSPITAL AND  
DIRECTIONAL MARKERS  
FOR INDEPENDENT MOUNTING

IM(5)-93


DATE: July 1990	DR: LR	CHK: CW	DW: DN	CHK: MT	REG NO: 1
9-93	REVISIONS	STATE DISTRICT	FEDERAL REGION	FEDERAL AID PROJECT	SHEET
		6			33
		COUNTY	CONTROL SECTION	JOB	HIGHWAY

**TWO LANE TWO-WAY ROADWAY**

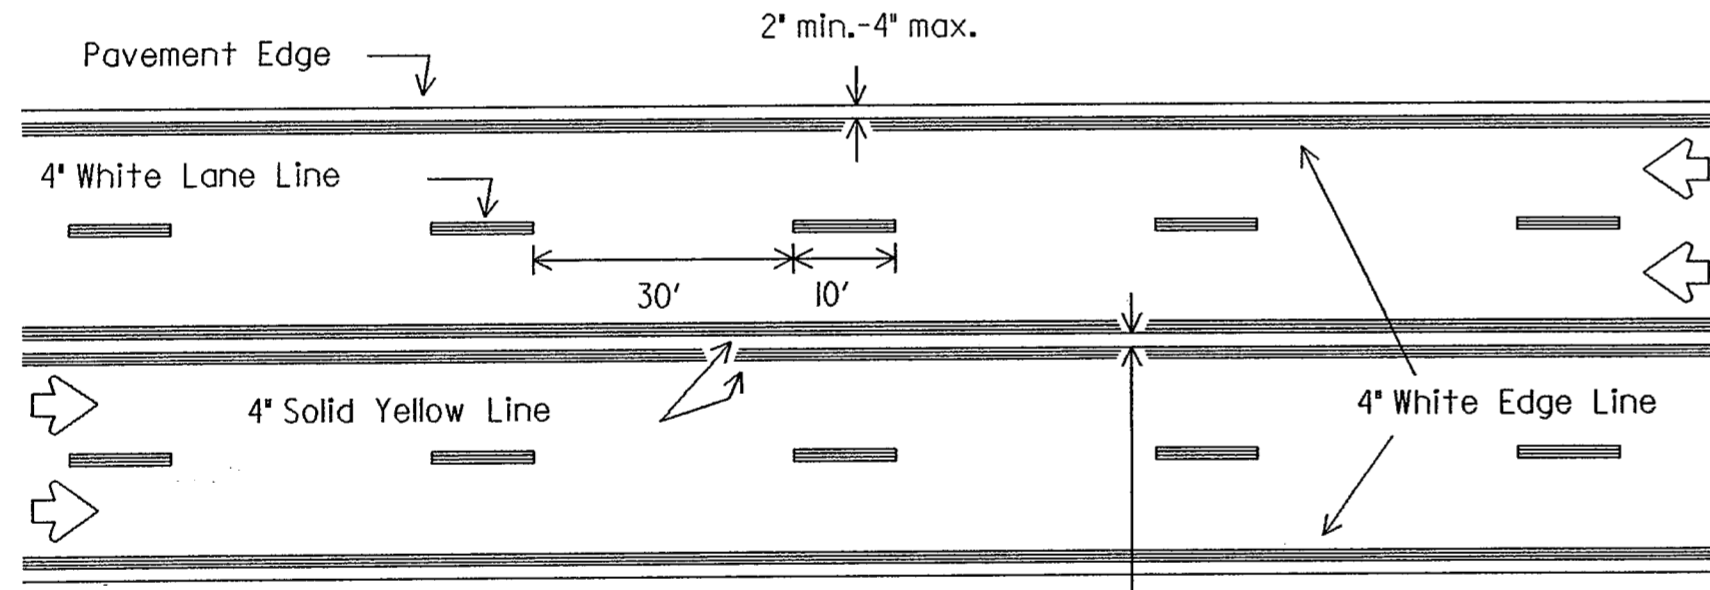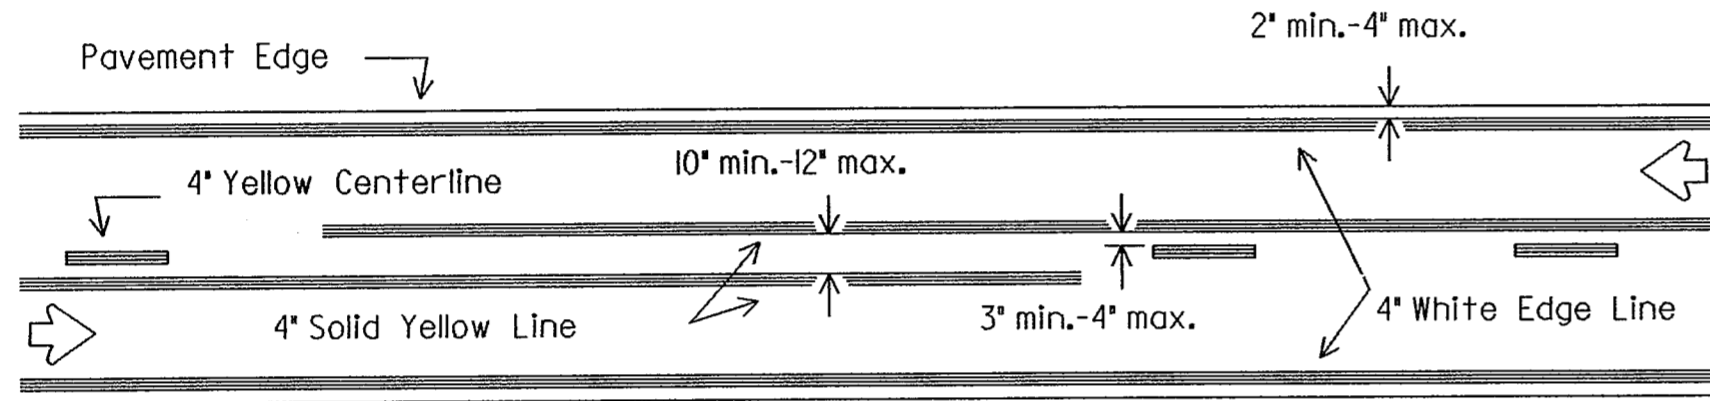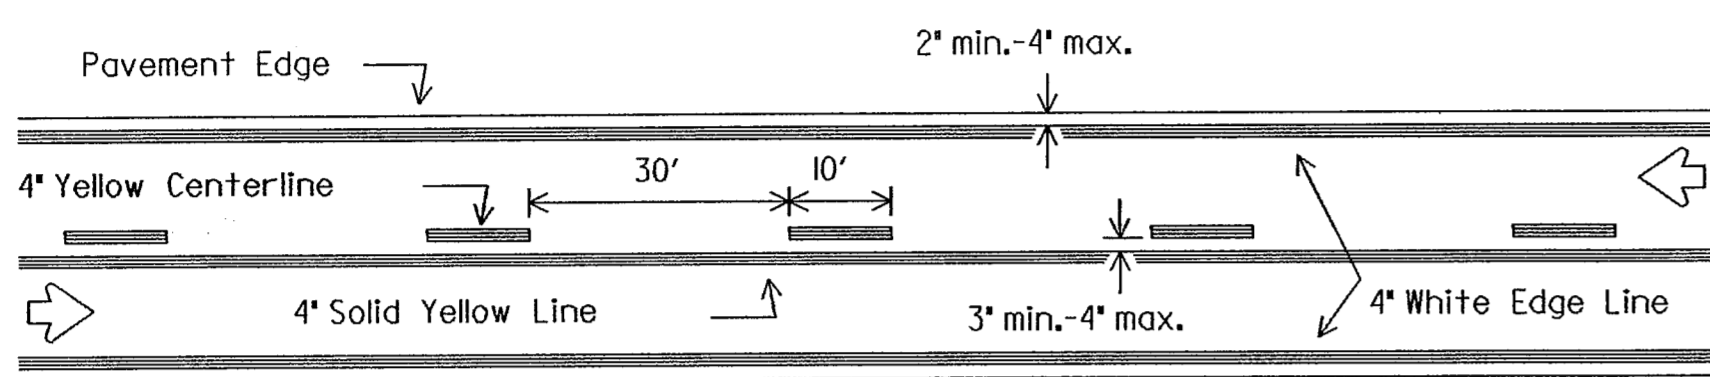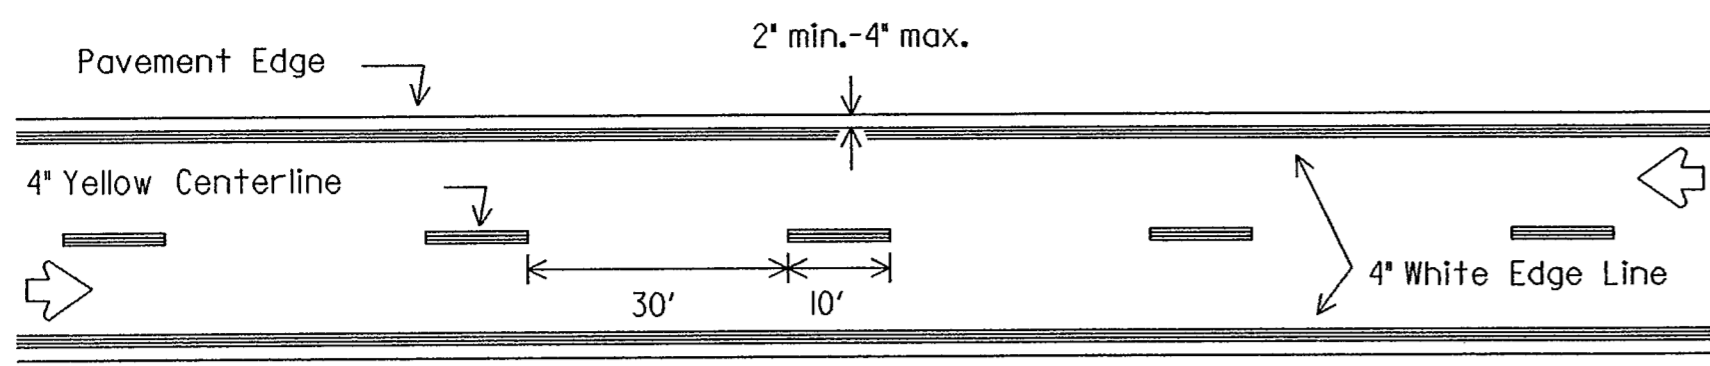


**CENTERLINE AND LANE LINES  
FOUR LANE TWO-WAY ROADWAY**


3" min.-4" usual  
12" max. (for pavement  
widths greater than  
48' only)

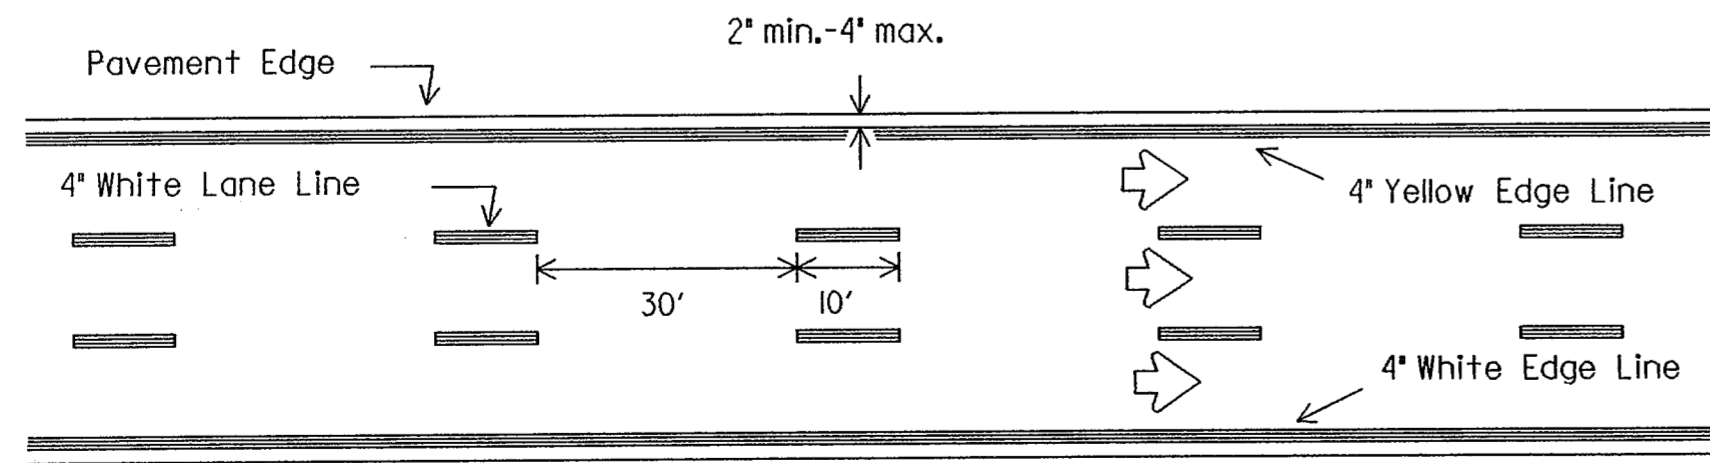

**EDGE LINE AND LANE LINES  
ONE-WAY ROADWAY**

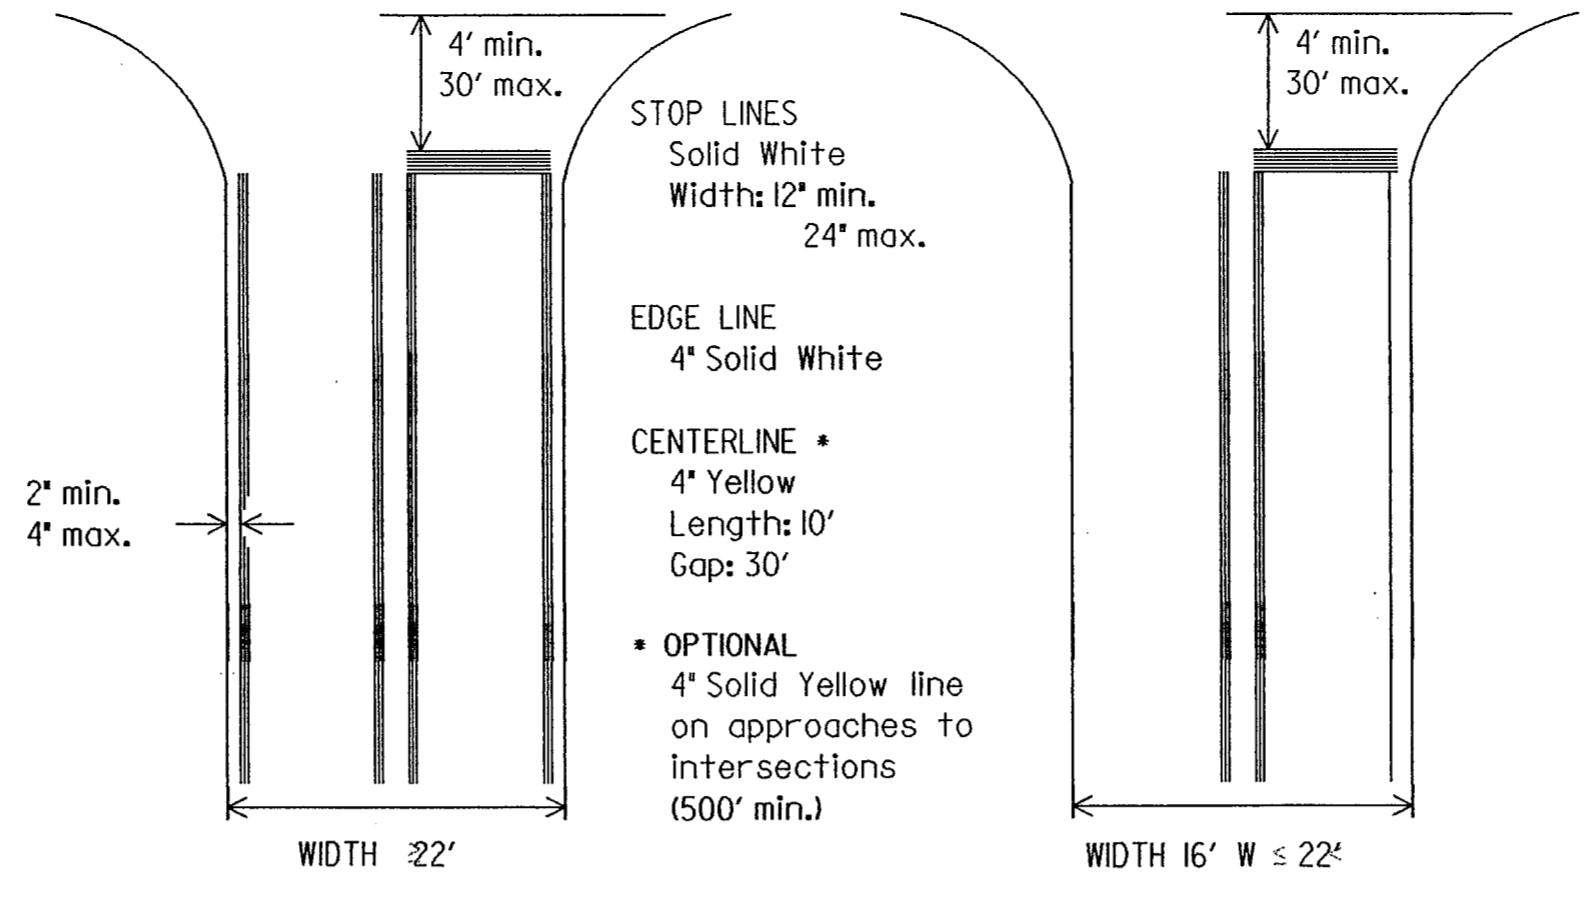


**GUIDE FOR PLACEMENT OF STOP LINES,  
EDGE LINE & CENTERLINE**

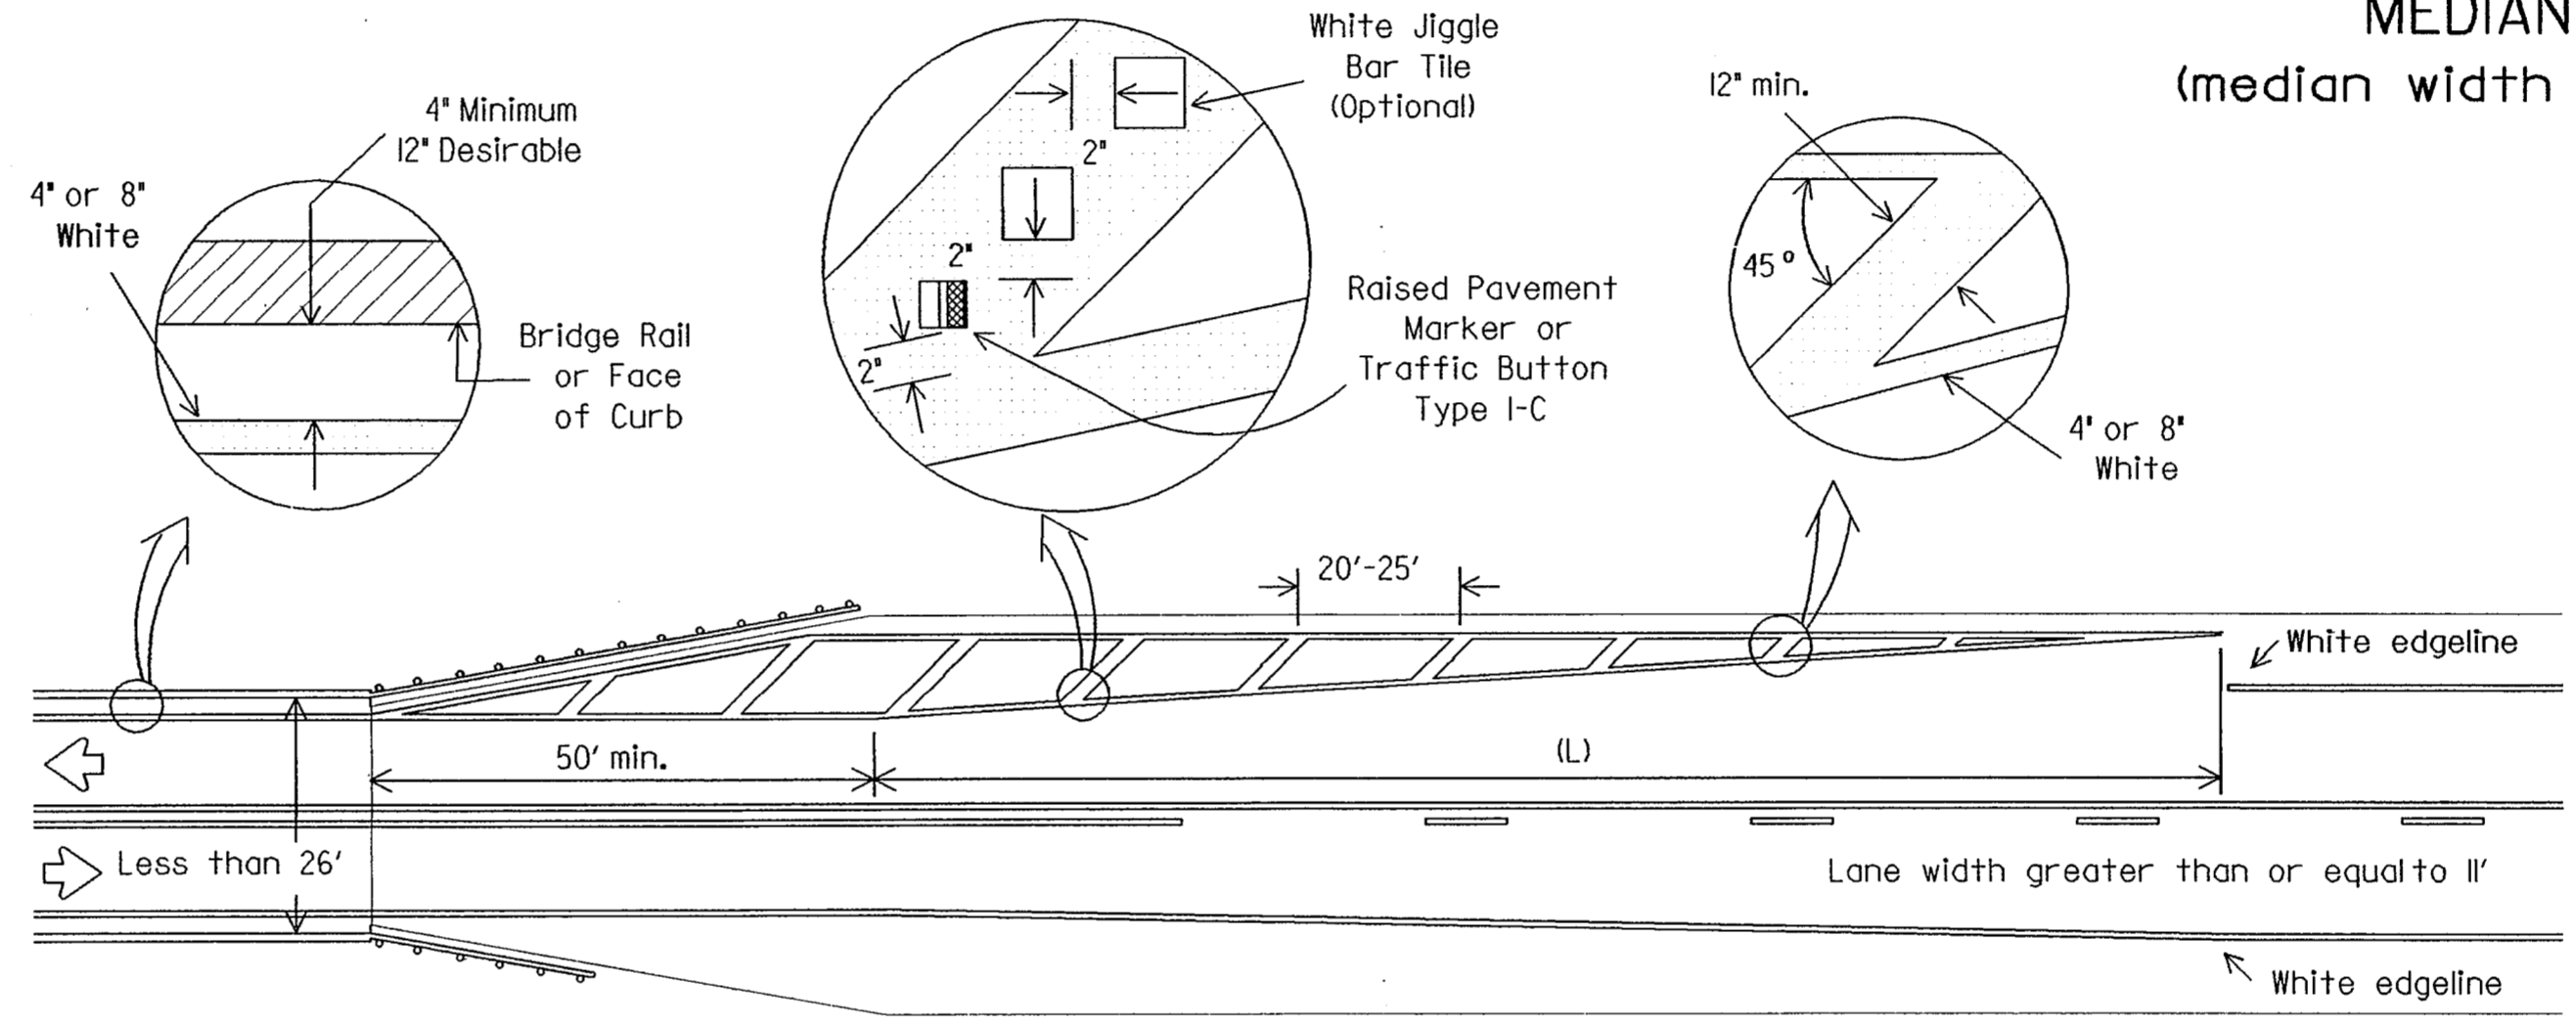


- NOTES:**
1. No-passing zone on bridge approach is optional but if used, it shall be a minimum 500 feet long.
  2. 1/2 inch crosshatching is optional. See plan quantities.
  3. For taper length (L) see Table I.

**NARROW BRIDGES (less than 26')  
TWO LANE TWO-WAY ROADWAY**

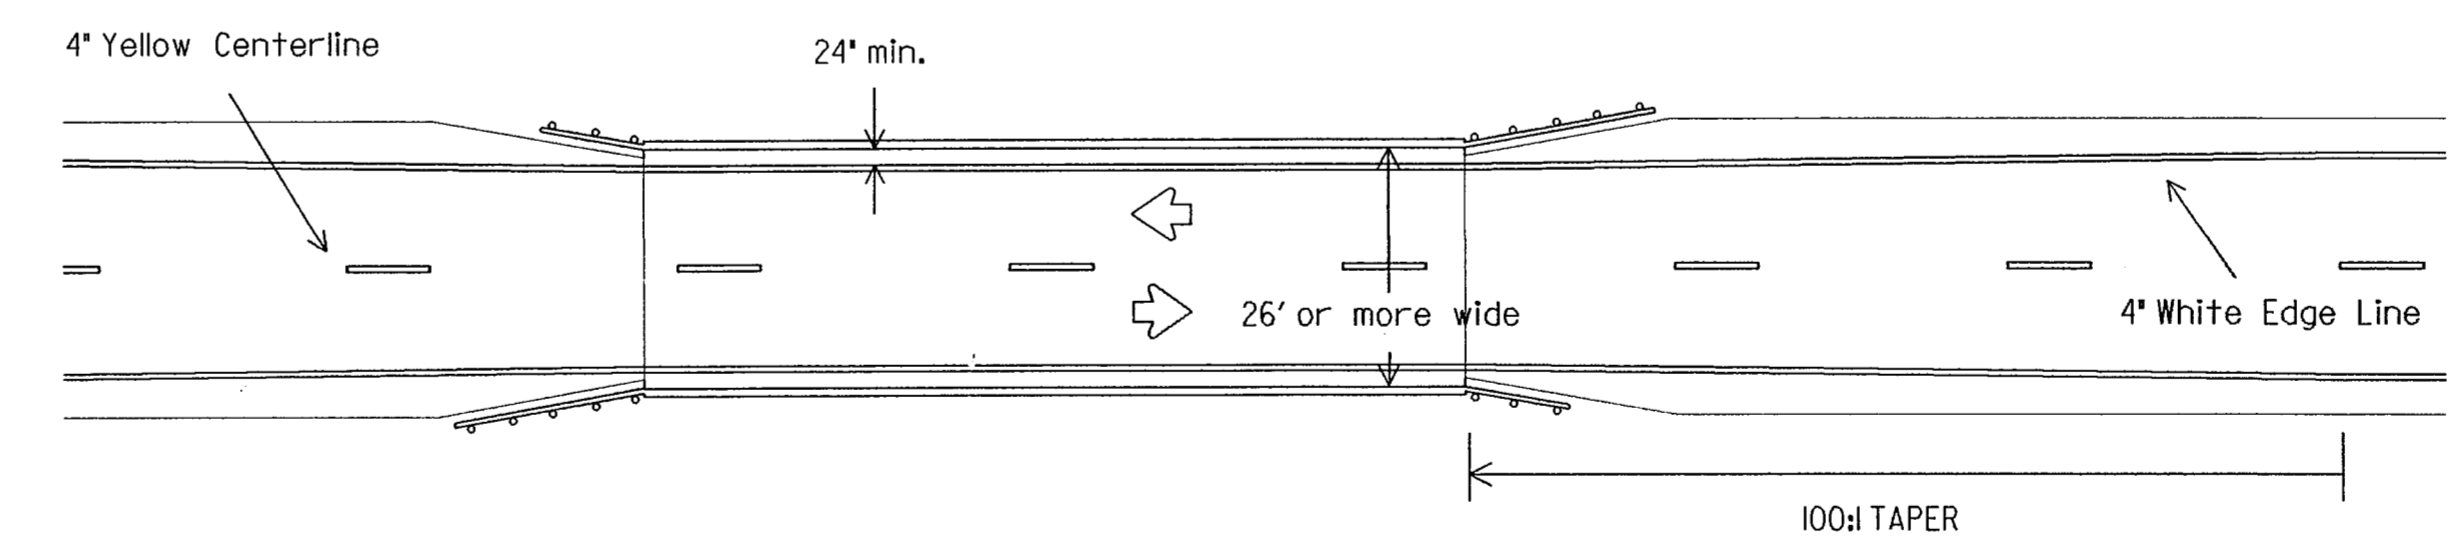

**BRIDGES (26' or greater in width)  
TWO LANE TWO-WAY ROADWAY**

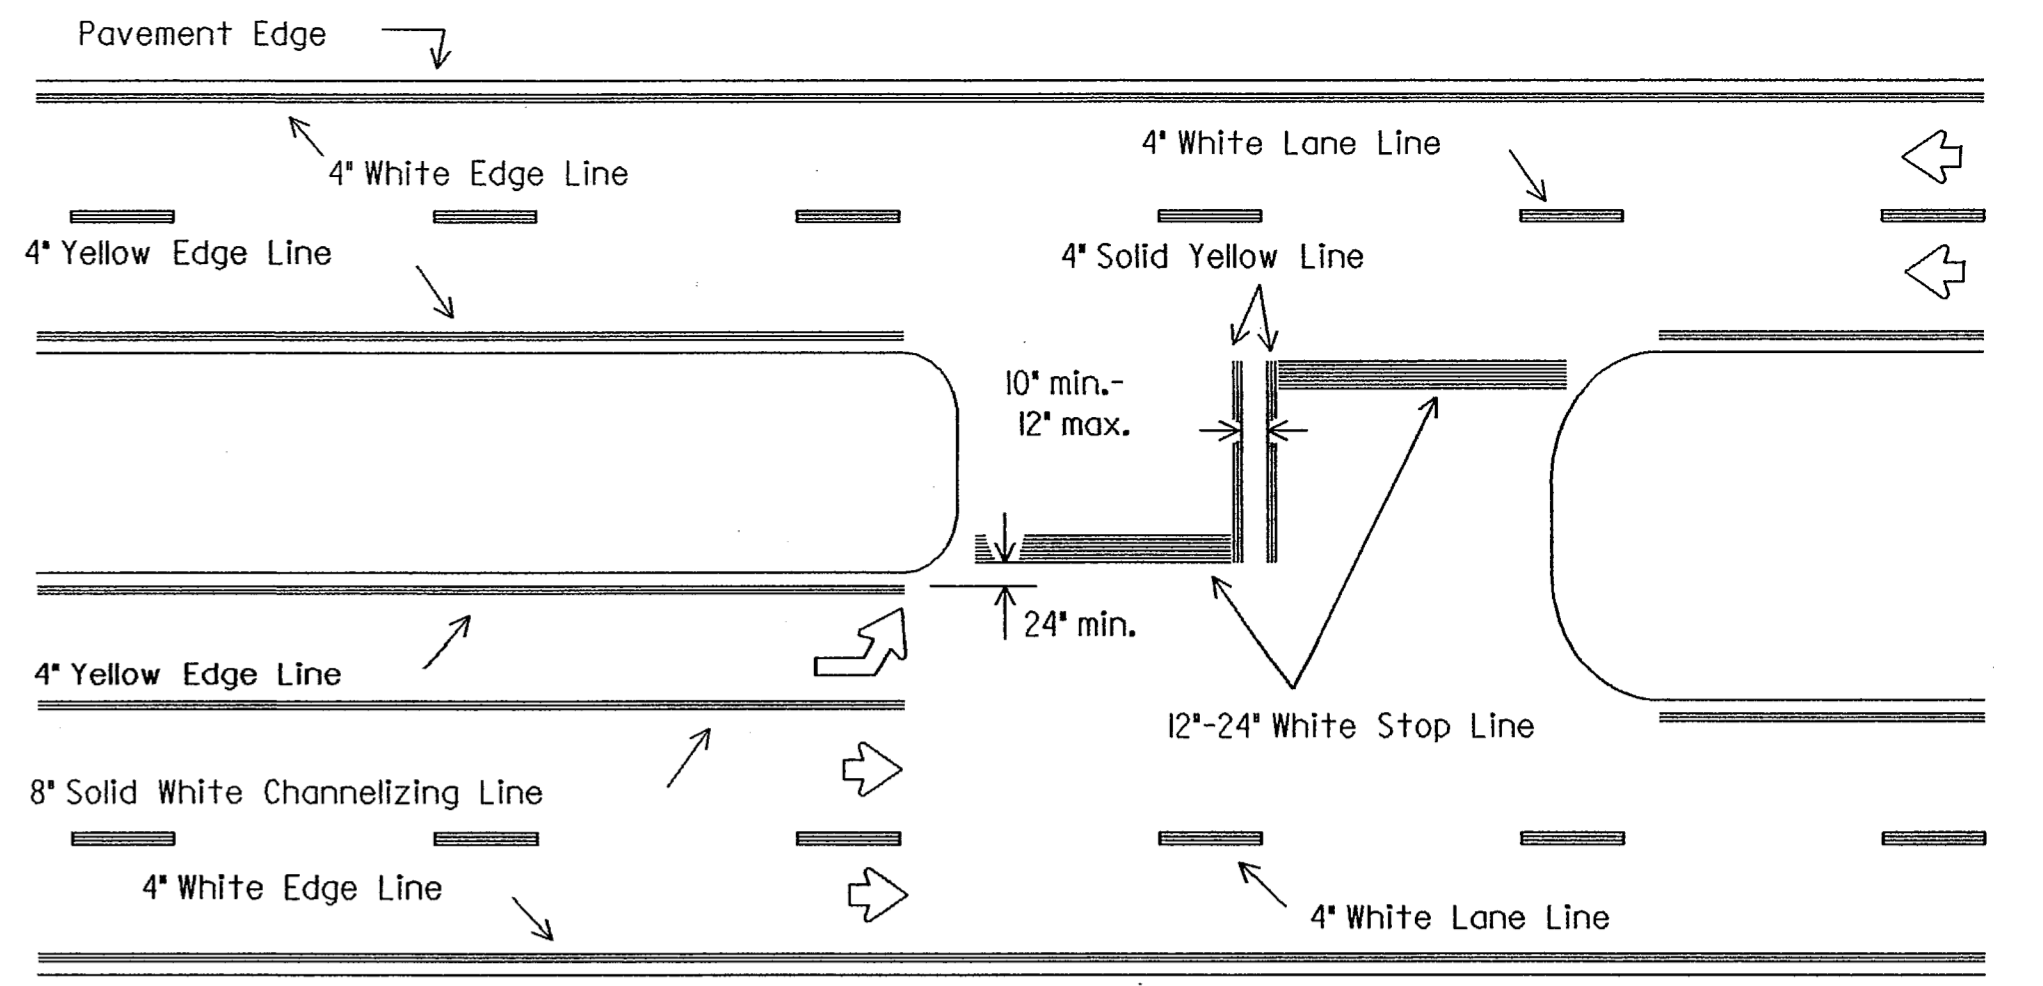

**FOUR LANE DIVIDED ROADWAY INTERSECTIONS  
MEDIAN WIDTH GREATER THAN 30 FEET  
(median width measured between crossover stop lines)**

**TABLE I  
TYPICAL TAPER LENGTH (L)**

Posted Speed*	Formula	Minimum Desirable Taper Lengths **		
		10' Offset	11' Offset	12' Offset
30	$L = \frac{WS^2}{60}$	150'	165'	180'
35		205'	225'	245'
40		265'	295'	320'
45	L=WS	450'	495'	540'
50		500'	550'	600'
55		550'	605'	660'
60		600'	660'	720'
65		650'	715'	780'

\* 85th Percentile Speed may be used on roads where traffic speeds normally exceed the posted speed limit.  
\*\* Taper lengths have been rounded.  
L=Length of Taper (FT.) W=Width of Offset (FT.)  
S=Posted Speed (MPH)

**FINAL RECORD  
DRAWING**  
Date: 12/25/99


**STANDARD PLANS  
TEXAS DEPARTMENT OF TRANSPORTATION  
Traffic Operations Division**

**TYPICAL STANDARD  
PAVEMENT MARKINGS**

PM(1)-95


ORIG. DRAW. DATE: NOV. 1978	DN: LR	CK: DN	DATE: 12/25/99	REG. NO.:
REVISIONS:	STATE DISTRICT:	FEDERAL REGION:	FEDERAL AID PROJECT:	SHEET:
2-82 7-92	6			34
11-85 8-95	COUNTY:	CONTROL SECTION:	JOB:	ROADWAY:
7-86				
4-92				

DN:LR CK:CN DW:DN CK:MT  
 DATE: ACC: d58hplc/usr/d580504  
 LEVELS DISPLAYED: 1 2 3  
 FILE:

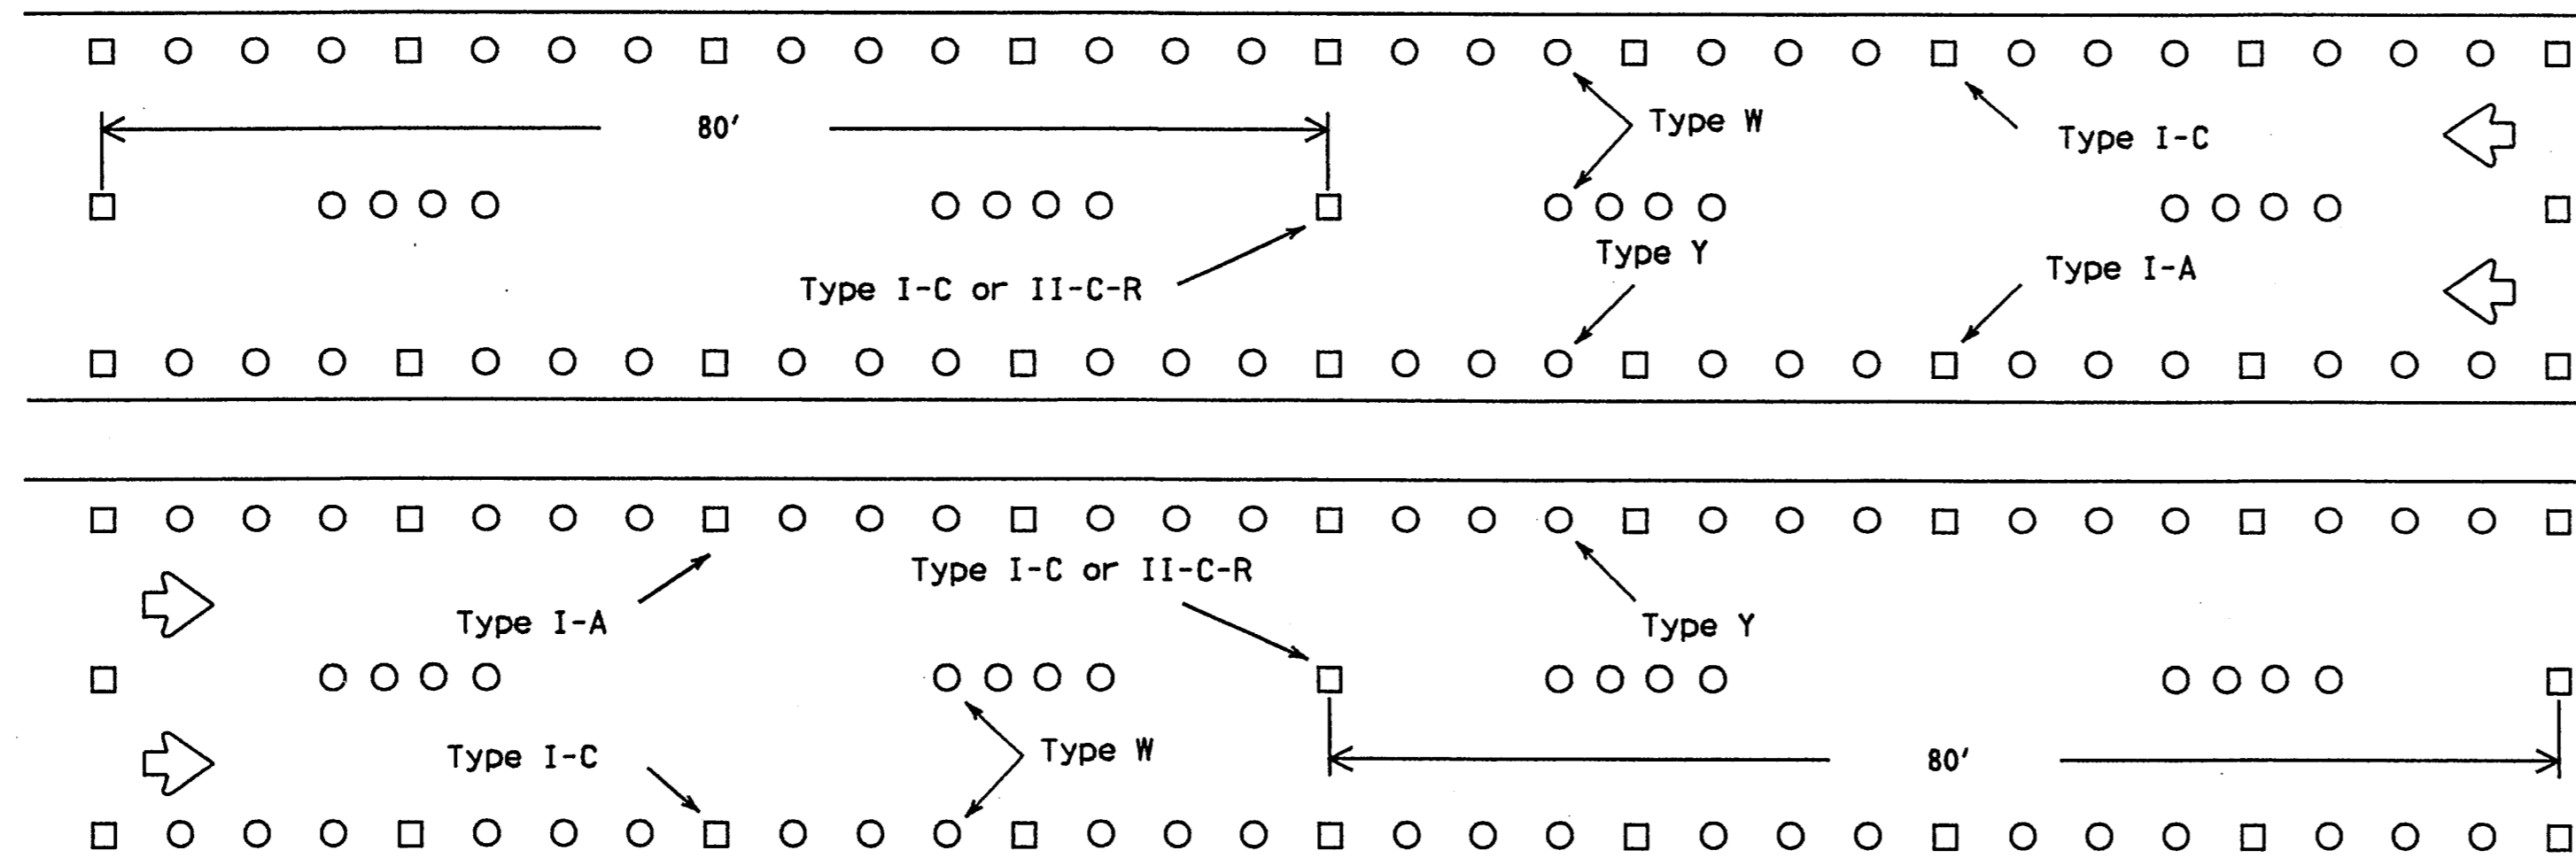

**EDGE LINES AND LANE LINES FOR DIVIDED HIGHWAYS**

Raised pavement markers Type II-C-R, clear face toward normal traffic and red face toward wrong-way traffic, shall be spaced on 80-foot centers. As required by the Engineer or shown elsewhere in the plans, Type II-C-R markers shall be placed on 40-foot centers for the below listed conditions:  
 1. Vertical curves with grades over 2 percent and less than 1000 feet long,  
 2. horizontal curves,  
 3. or continuously illuminated sections.

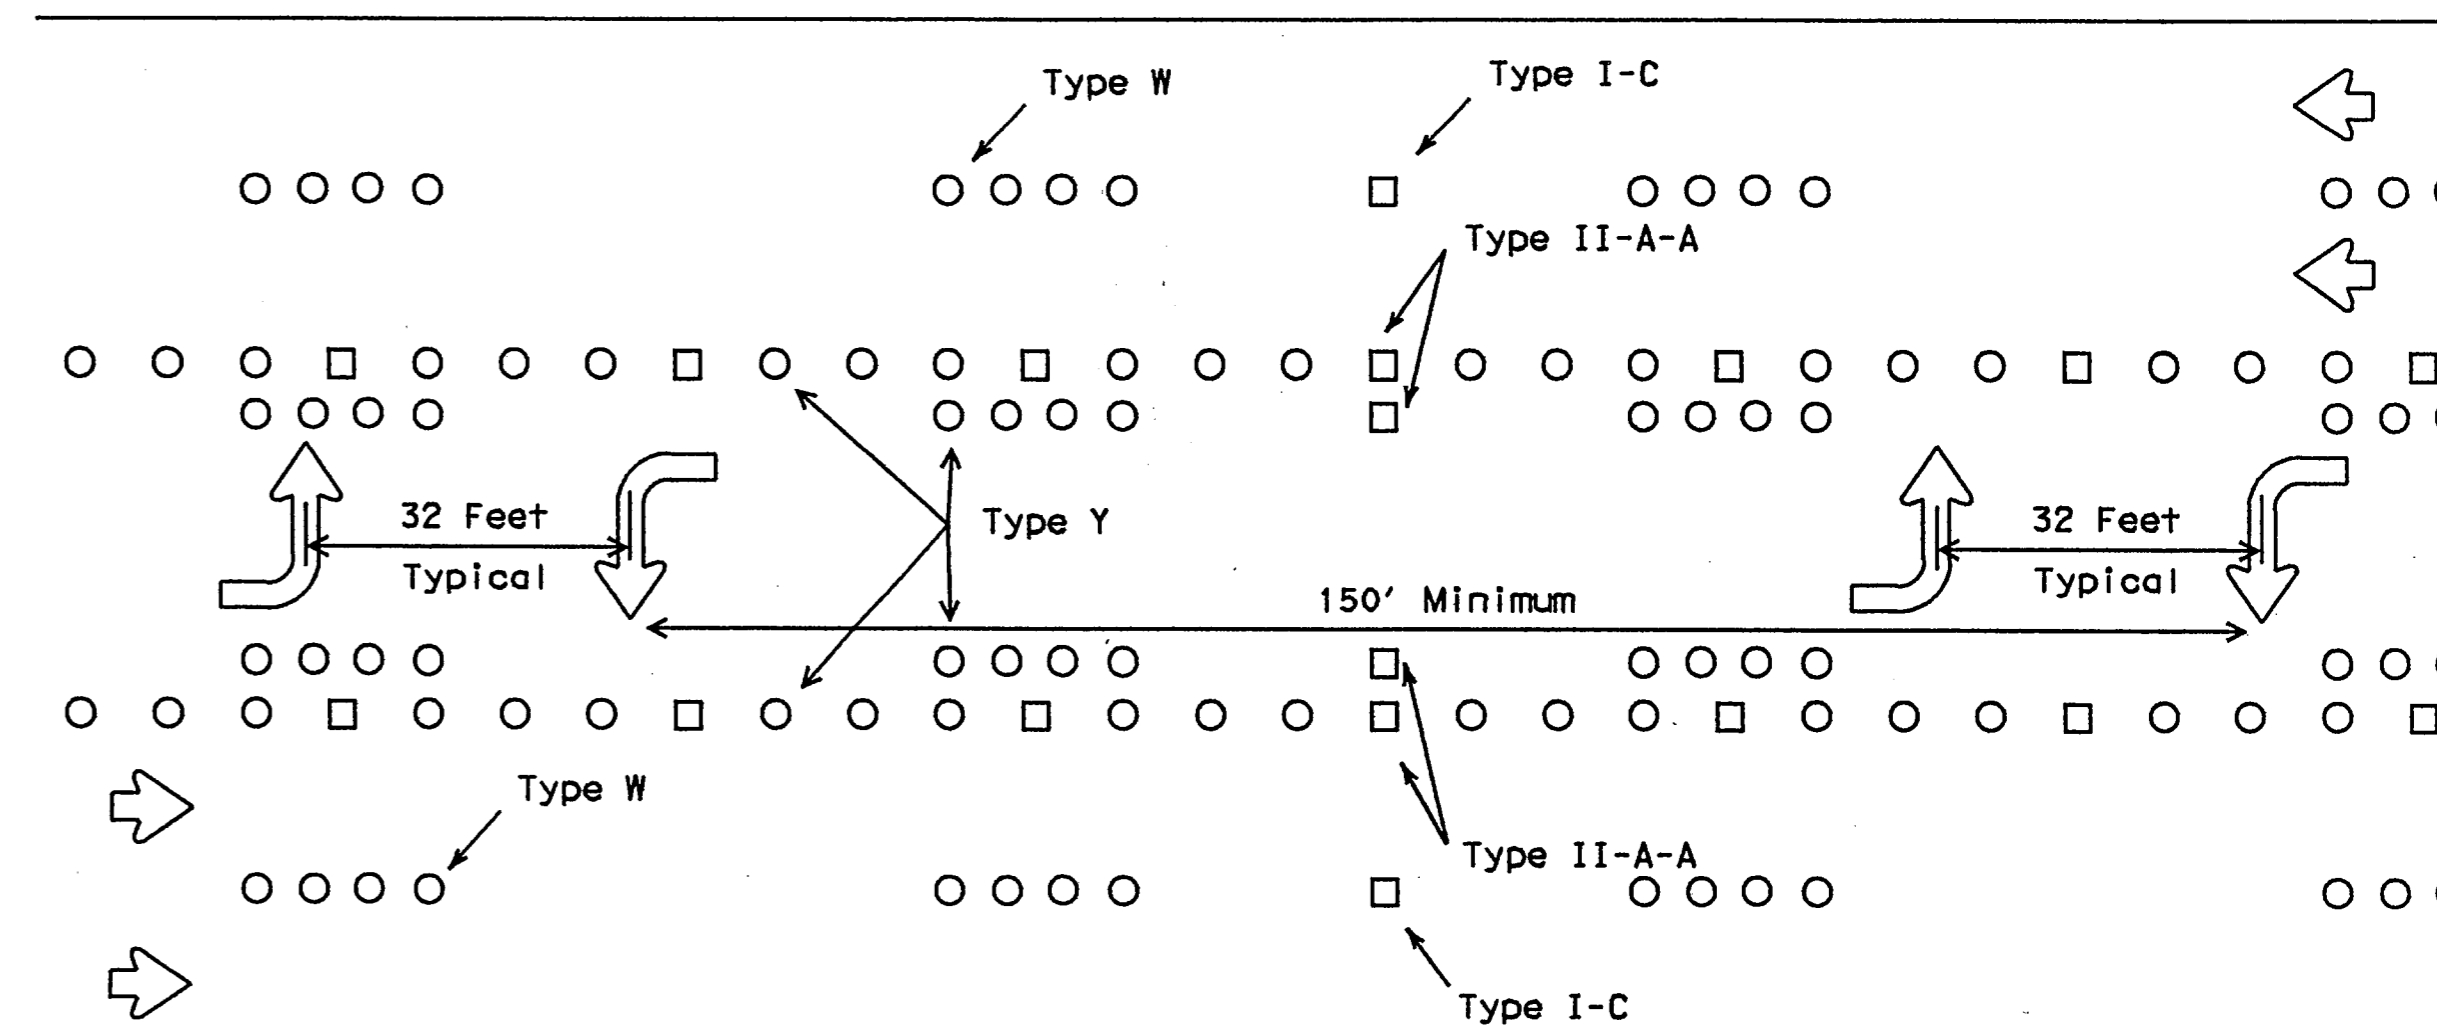


**TWO-WAY LEFT TURN LANE**

LEGEND:  
 ○ TRAFFIC BUTTON (NONREFLECTORIZED)  
 □ RAISED PAVEMENT MARKER (REFLECTORIZED)


**GENERAL NOTES:**

All raised pavement markers placed in broken lines shall be placed in line with and midway between the stripes.  
 First and last raised pavement marker in a no-passing line shall be a reflective marker.  
 On concrete pavements, the raised pavement markers should be placed to one side of the longitudinal joints.

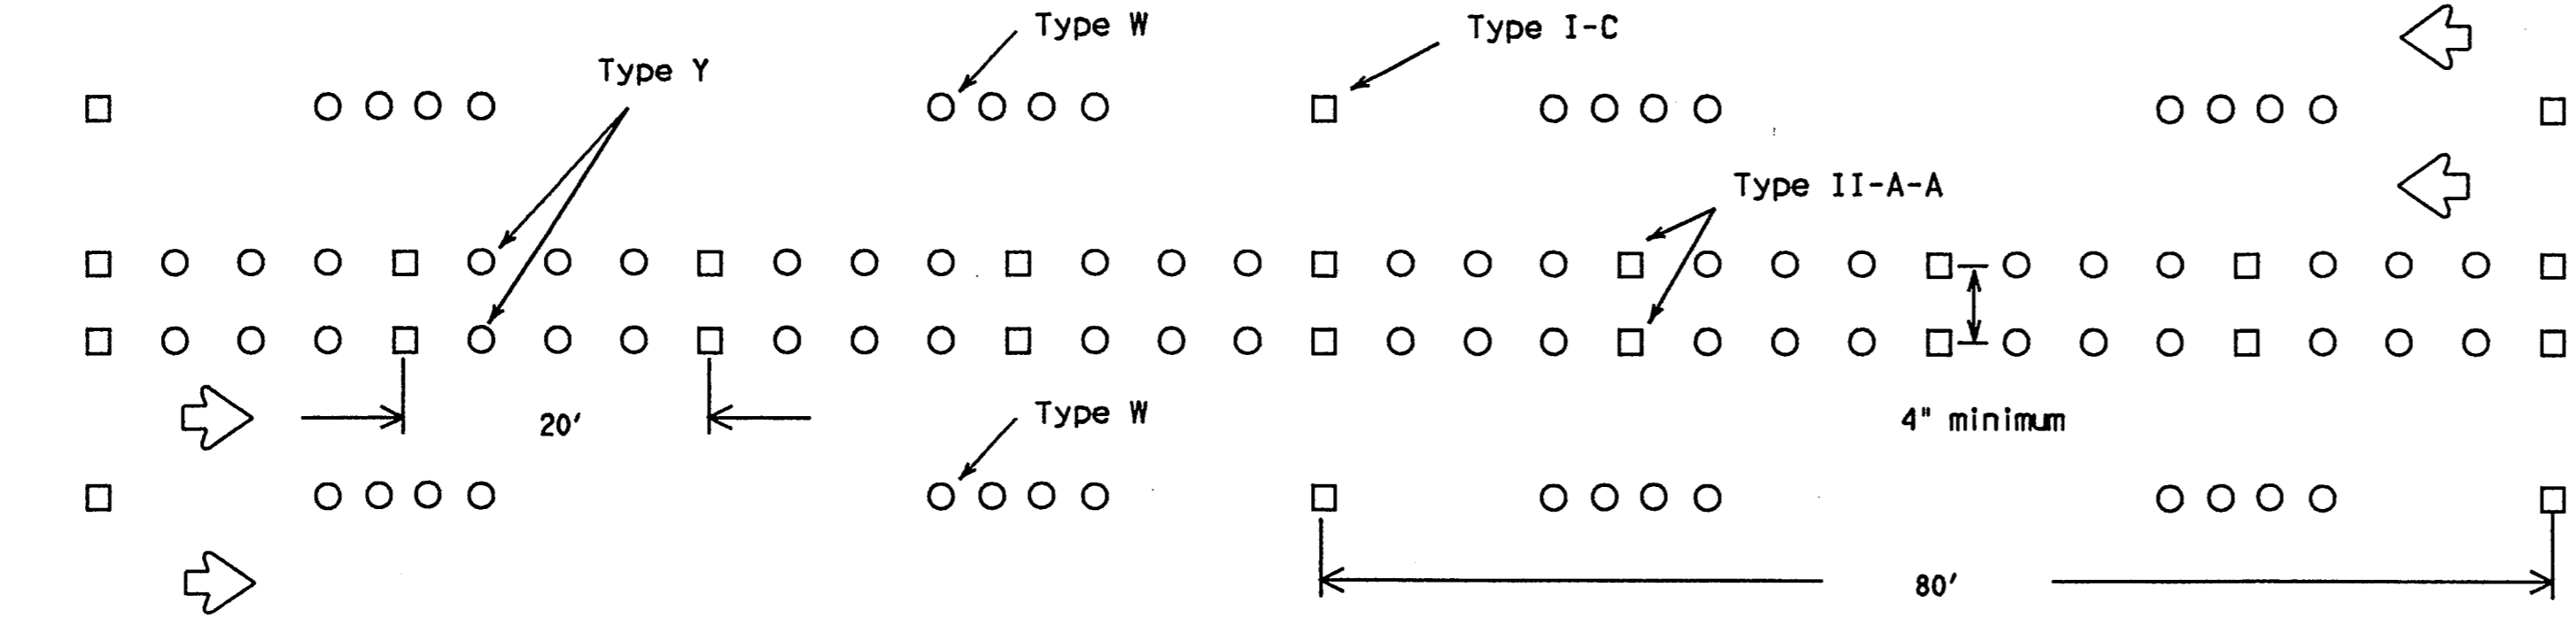


**LANE LINES & CENTERLINES FOR MULTI-LANE UNDIVIDED HIGHWAYS**

Raised pavement marker Type I-C, clear face toward normal traffic, shall be placed on 80-foot centers.

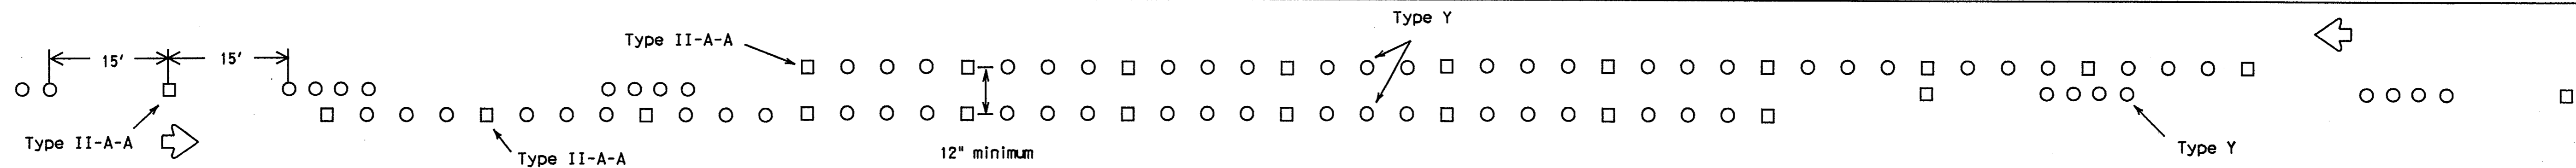

**CENTERLINE & NO-PASSING ZONE BARRIER LINES FOR TWO LANE TWO-WAY HIGHWAYS**

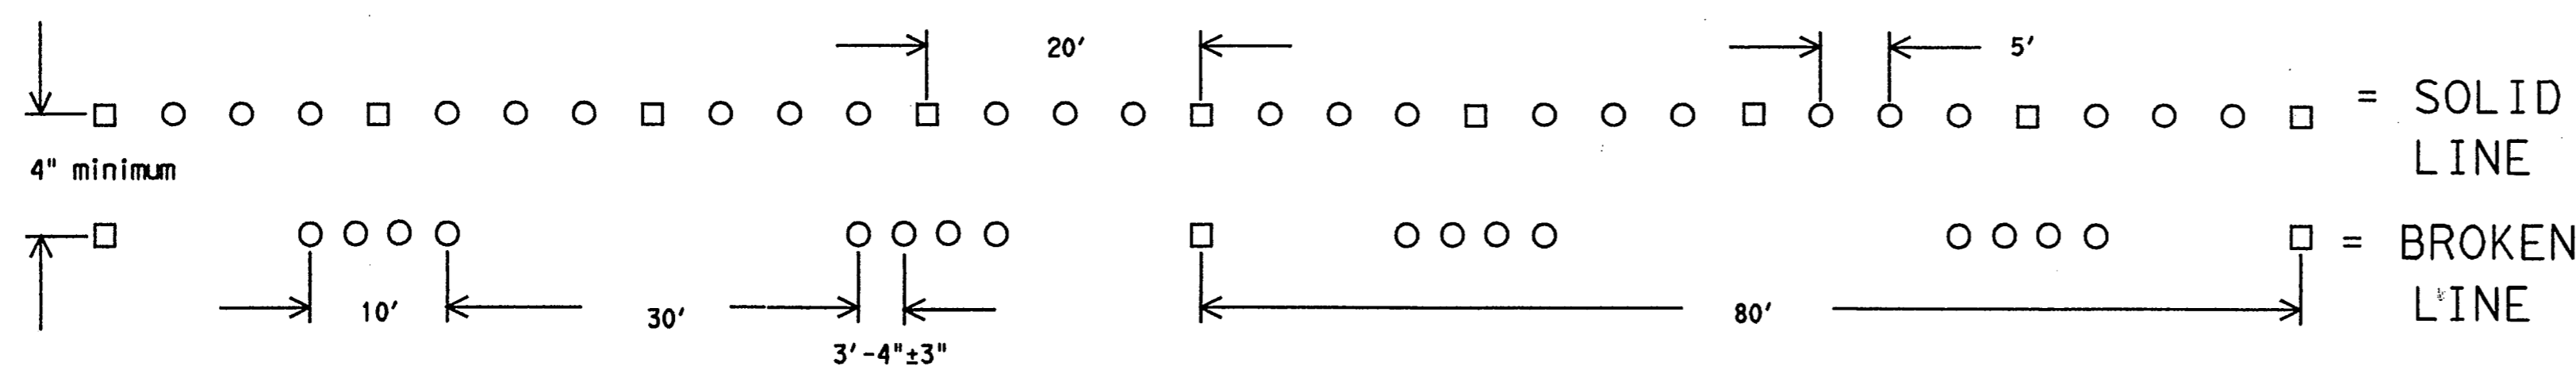

**PATTERN DETAIL**

**STANDARD PLANS**  
**TEXAS DEPARTMENT OF TRANSPORTATION**  
*Traffic Operations Division*

**TYPICAL STANDARD PAVEMENT MARKINGS**  
**RPM TO SIMULATE**  
**STANDARD PAVEMENT MARKINGS**  
**PM(3)-92**





ORIG. DRAW. DATE:	DN: L-R	CK: -	DN: - DN	CK: -	NEG. NO.:
REVISIONS	STATE DISTRICT	FEDERAL REGION	FEDERAL AID PROJECT		SHEET
2-82	6	6			35
7-86			COUNTY	CONTROL SECTION	JOB
10-86					HIGHWAY
4-92					

**FINAL RECORD DRAWING**  
 Date: 12/25/99

DN: LR  
 CK: CW  
 DW: DN  
 CK: MT

LEVELS DISPLAYED: 1 2 3 100

DATE: 12/25/99  
 ACC: d58hplc/usr/d580504  
 FILE:

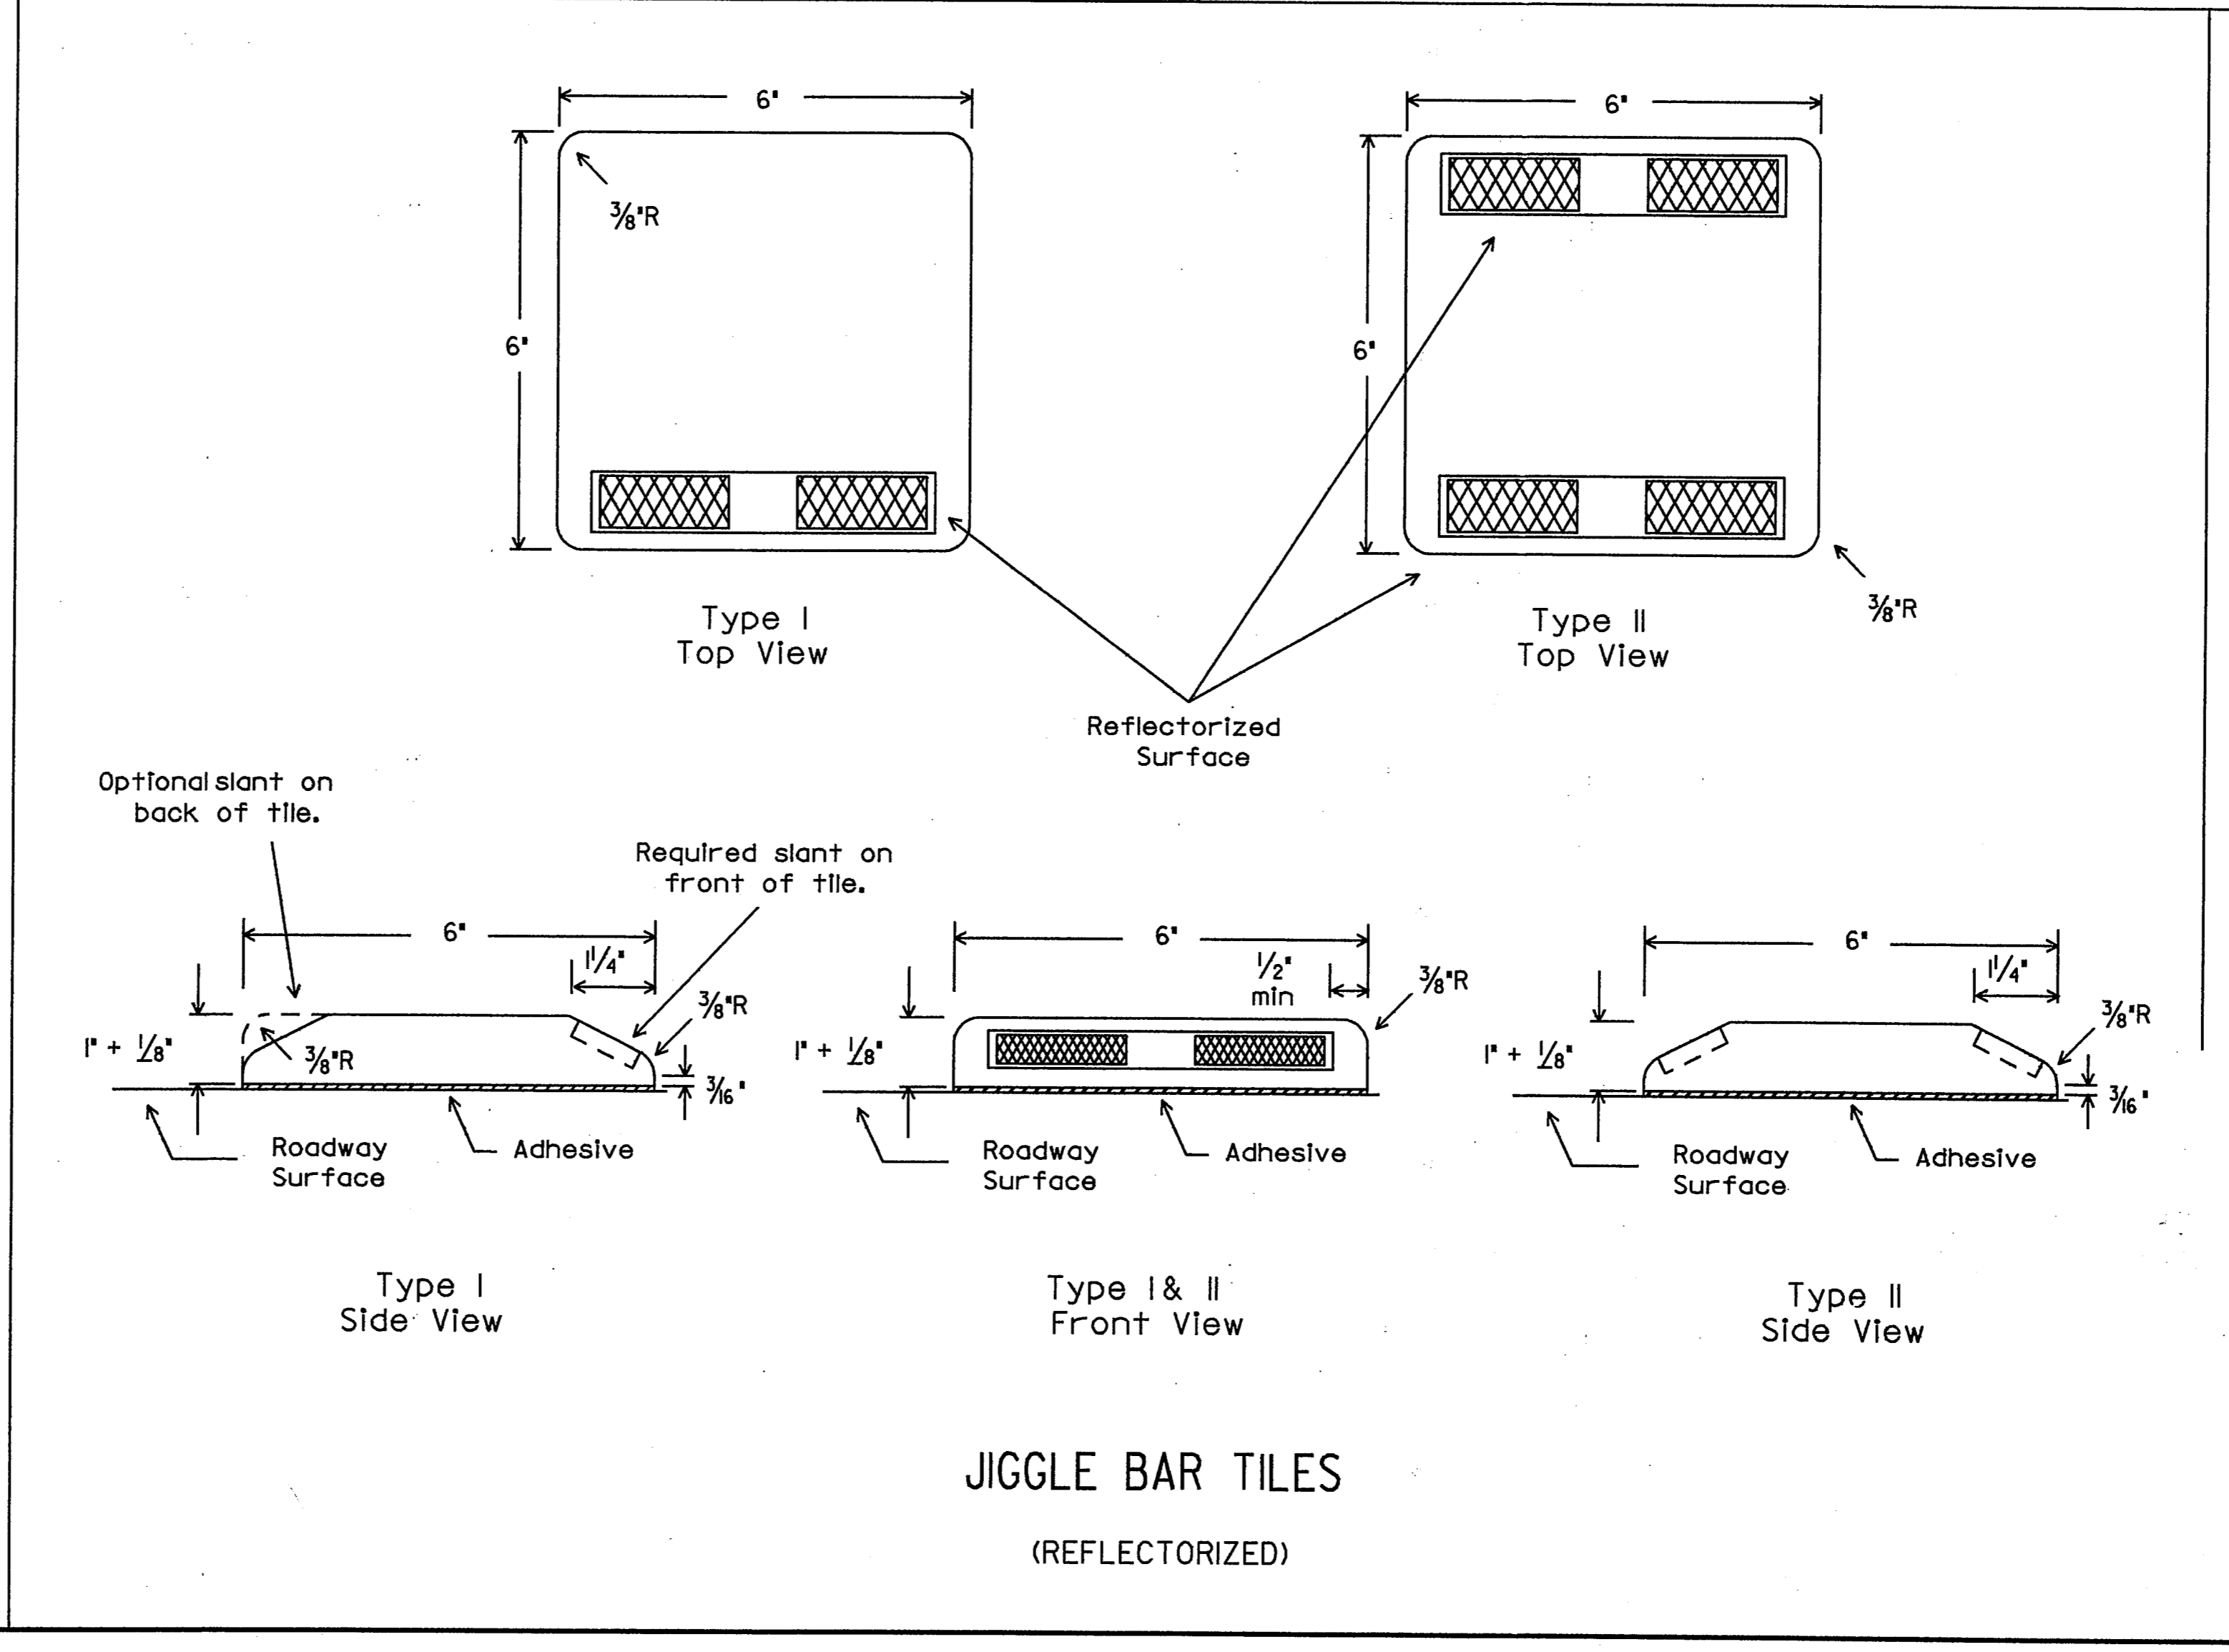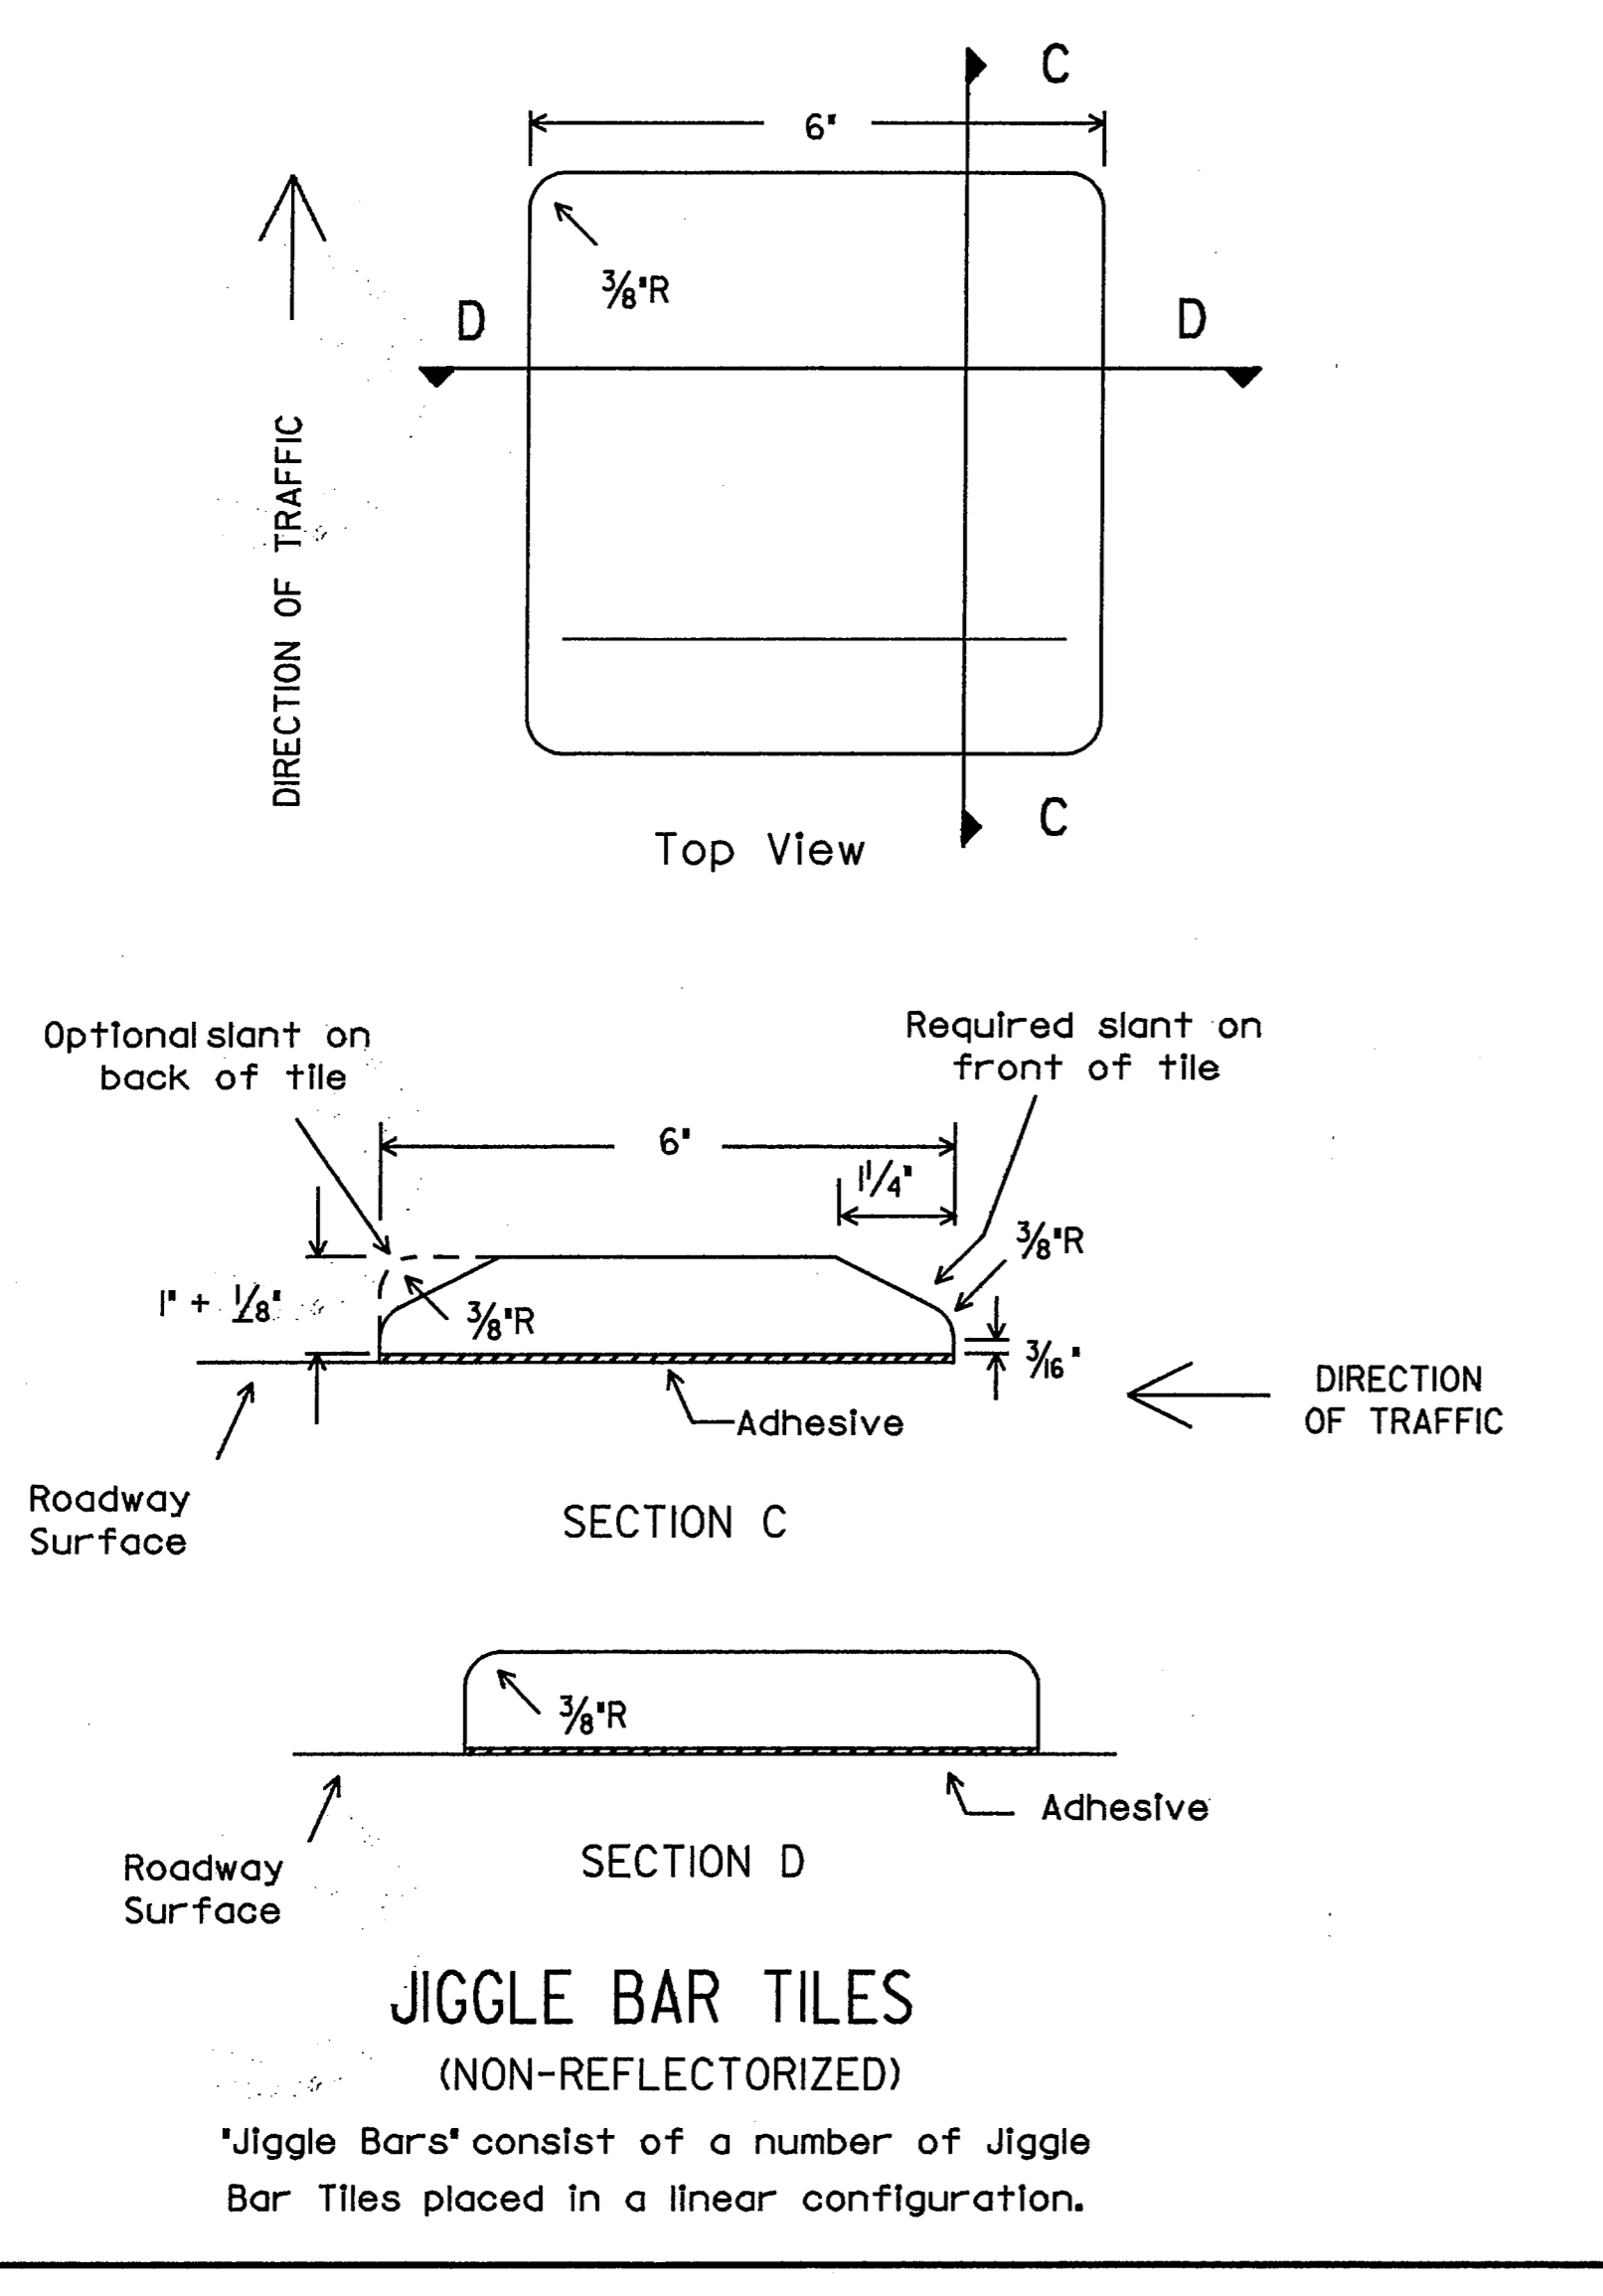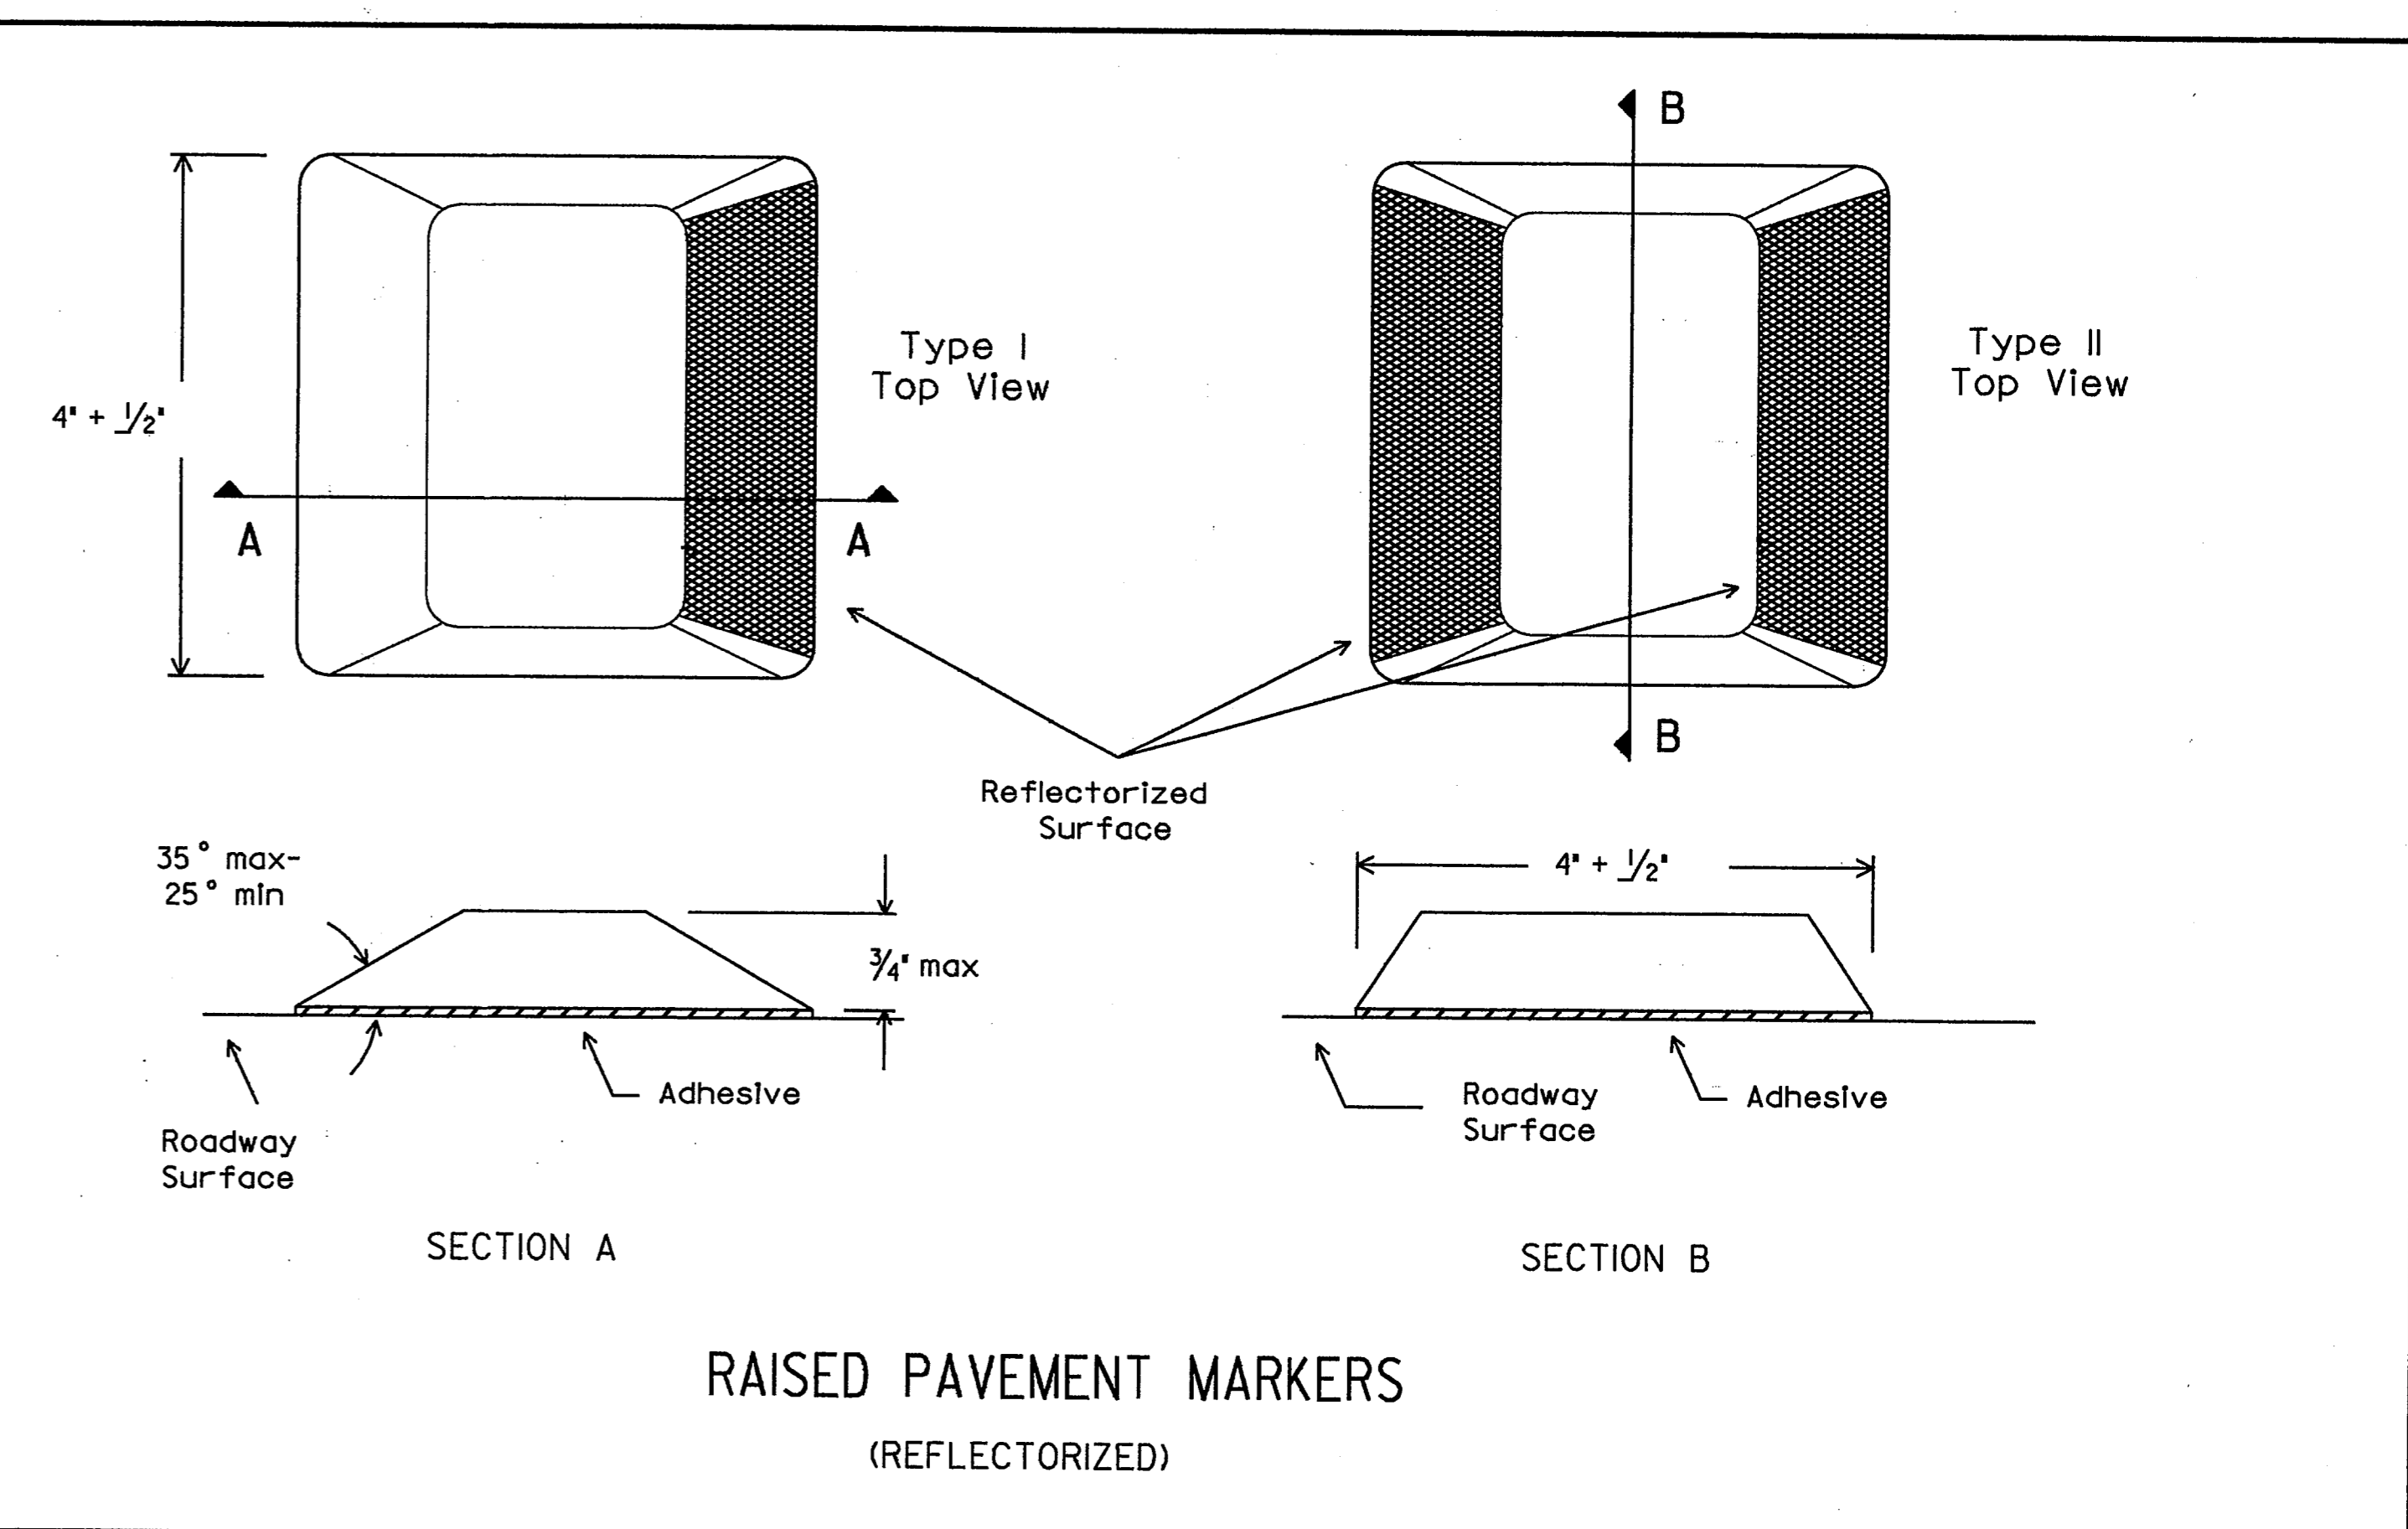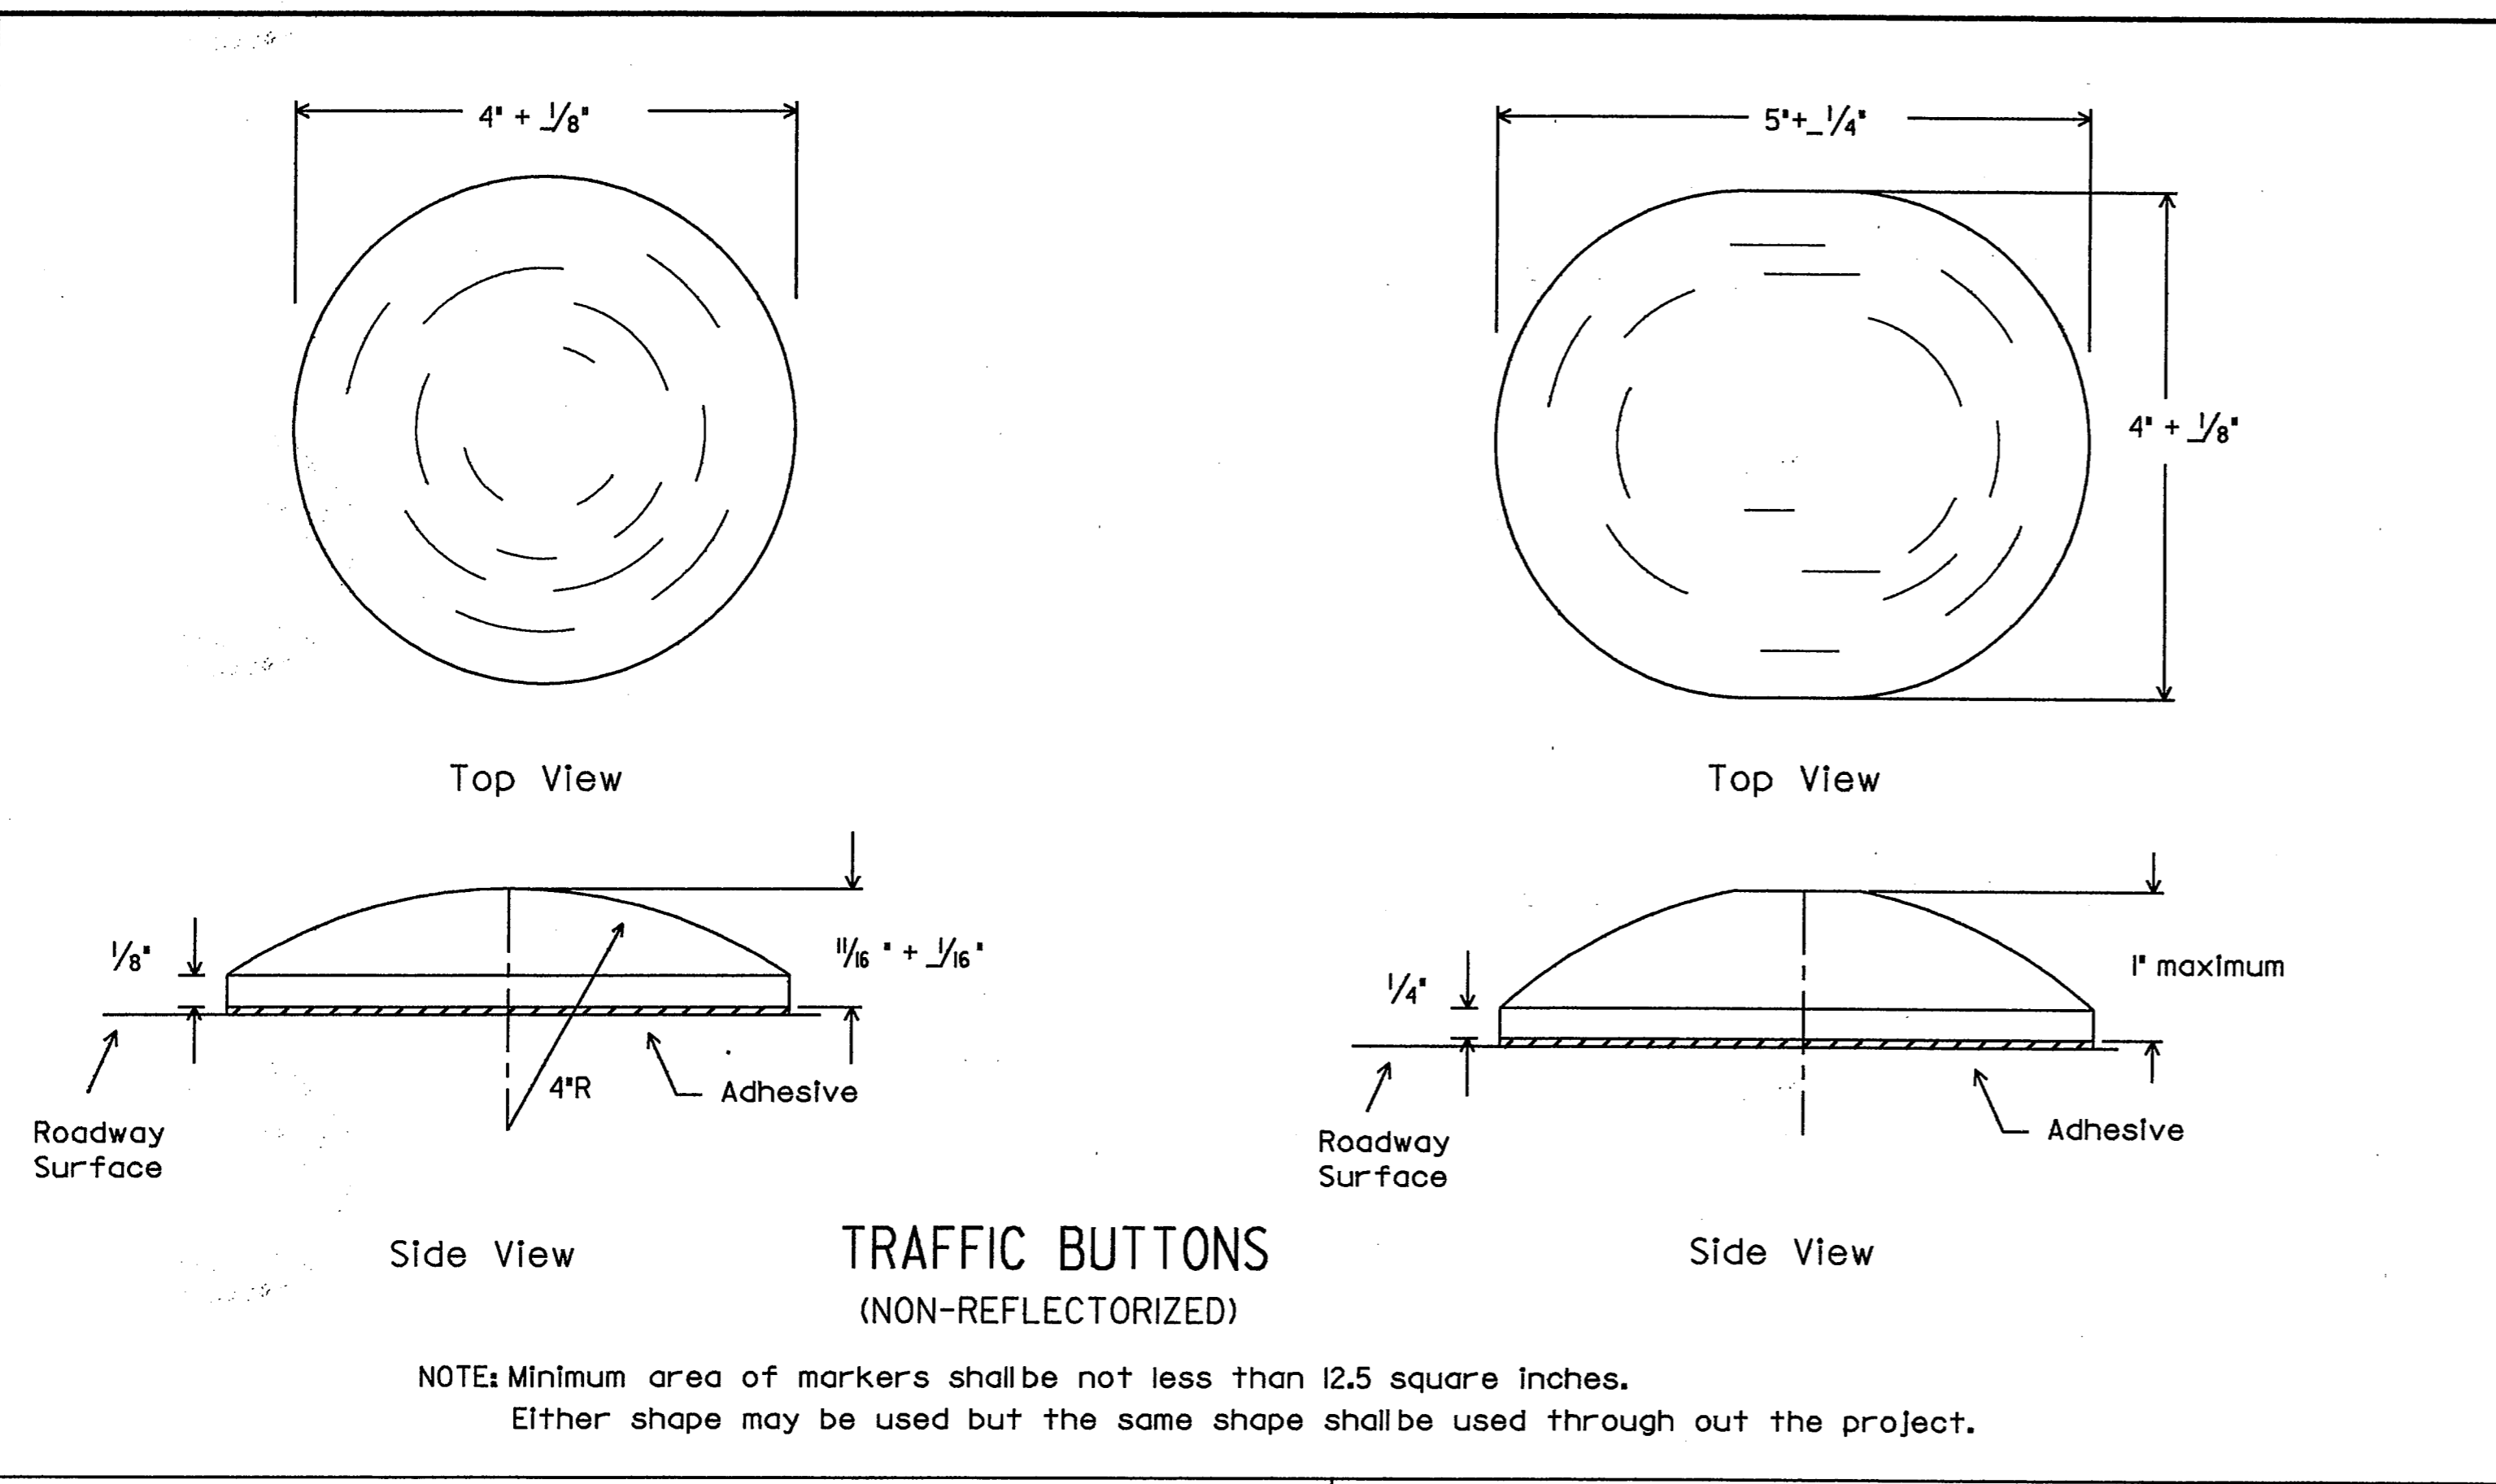

**SPECIFICATION REFERENCE TABLE**

MATERIALS AND TEST SPECIFICATIONS (D-9)	
JIGGLE BAR TILE	D-9-4100
PAVEMENT MARKERS (REFLECTORIZED)	D-9-4200
TRAFFIC BUTTONS	D-9-4300
BITUMINOUS ADHESIVE	D-9-6130

**GENERAL NOTES:**

RAISED PAVEMENT MARKERS (RPMs) MAY CONSIST OF TRAFFIC BUTTONS, PAVEMENT MARKERS AND/OR JIGGLE BAR TILES. PAVEMENT SURFACE SHALL BE PREPARED AND CLEANED SUBJECT TO APPROVAL OF THE ENGINEER BEFORE ADHESIVE AND RPMs ARE PLACED.

JIGGLE BARS SHALL BE ORIENTED PERPENDICULAR TO ROADWAY. JIGGLE BARS SHALL ALSO BE PLACED AT SUCH OTHER LOCATIONS AS SHOWN IN PLANS OR AS DIRECTED BY THE ENGINEER.

MARKERS, BUTTONS AND JIGGLE BAR TILES SHOWN ARE FOR ILLUSTRATION PURPOSES ONLY AND NOT INTENDED TO SPECIFY ANY PARTICULAR PRODUCT. ALL PAVEMENT MARKERS PROVIDED SHALL BE OF THE SAME MANUFACTURER.

ALL DIMENSIONS ARE + 1/8" UNLESS OTHERWISE NOTED.

**FINAL RECORD  
DRAWING**  
Date: 12/25/99


**STANDARD PLANS  
TEXAS DEPARTMENT OF TRANSPORTATION**  
*Traffic Operations Division*

**RAISED PAVEMENT MARKERS  
REFLECTIVE PAVEMENT MARKERS,  
TRAFFIC BUTTONS &  
JIGGLE BAR TILE  
RPM(I)-92**


ORG. DRAW. DATE: JANUARY 1981	DRW. L.R.	CR.	DN. DN.	CR.	REV. NO.
REVISIONS	STATE DISTRICT	FEDERAL REGION	FEDERAL AID PROJECT		SHEET
2-82 10-86	6	6			36
7-85 12-90			COUNTY	CONTROL SECTION	JOB
11-85 4-92					ROADWAY
7-86					

21A


LEVELS DISPLAYED  
 1 2 3 4 5 6 7 8 9 10 11 12 13 14 15 16  
 DN:LR CK:CW DW:DN CK:MT  
 DATE: 12/25/99  
 ACC: d58hplc/usr/d580504  
 FILE:

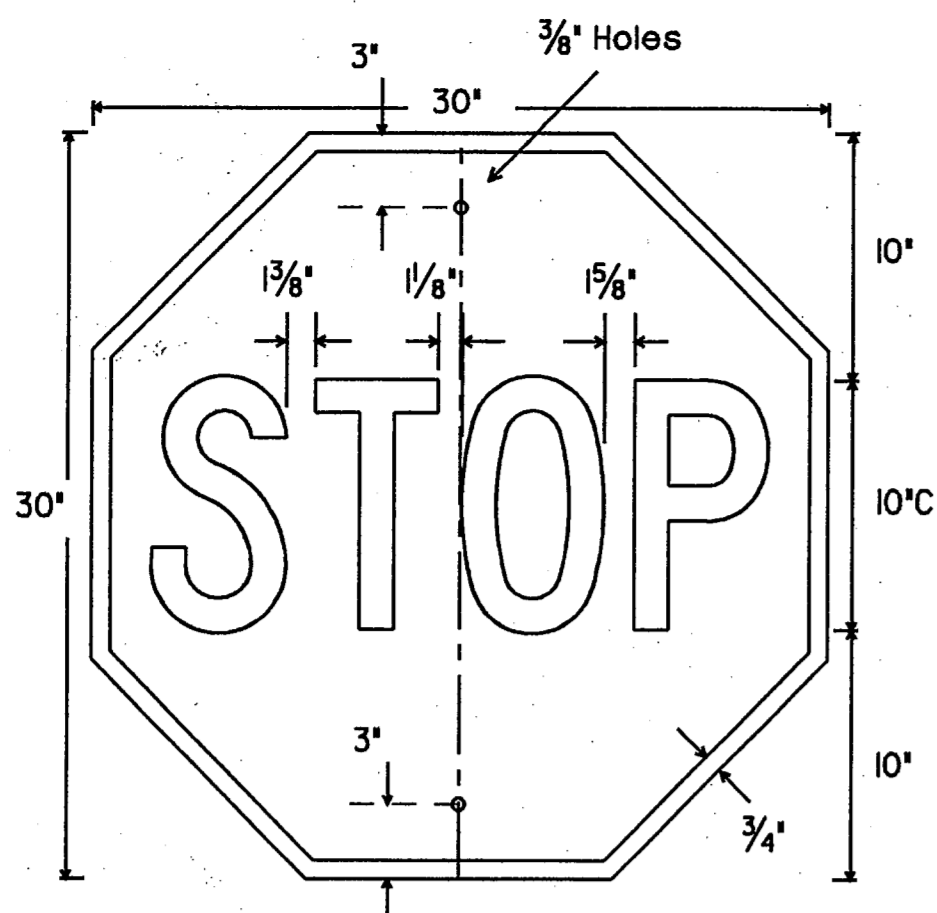


RI-1  
30" X 30"  
Letters - White Reflective  
Border - White Reflective  
Background - Red Reflective

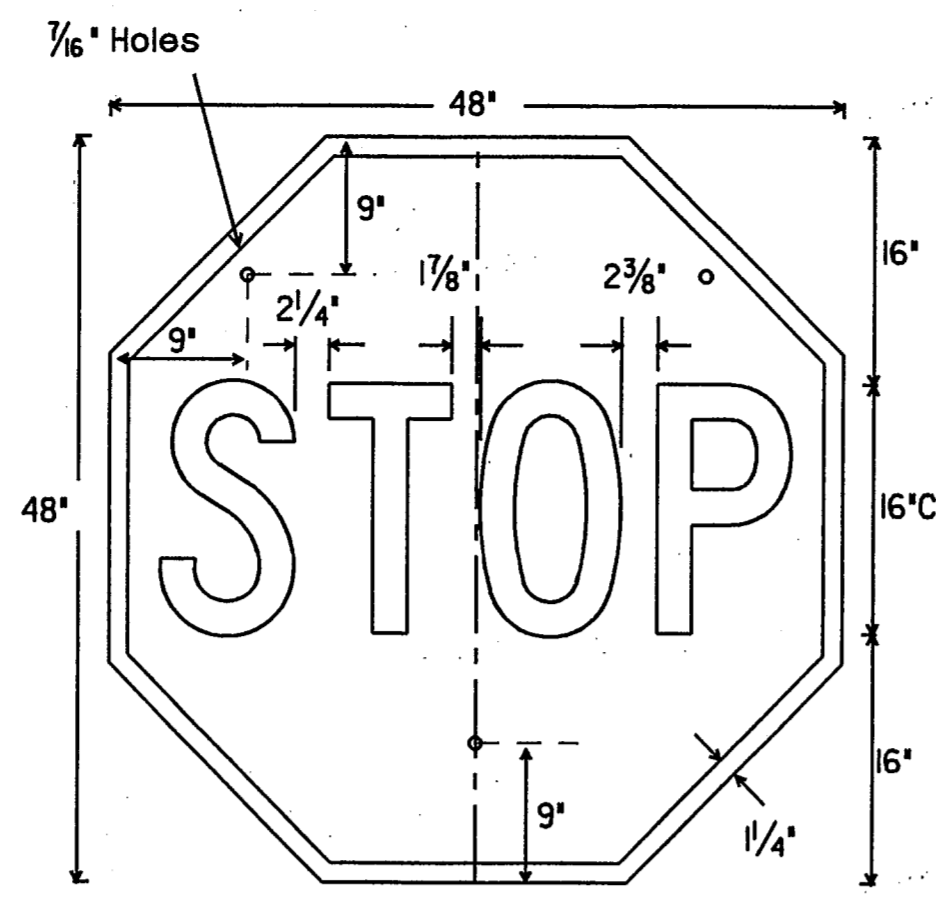


SRI-1  
48" X 48"  
Letters - White Reflective  
Border - White Reflective  
Background - Red Reflective

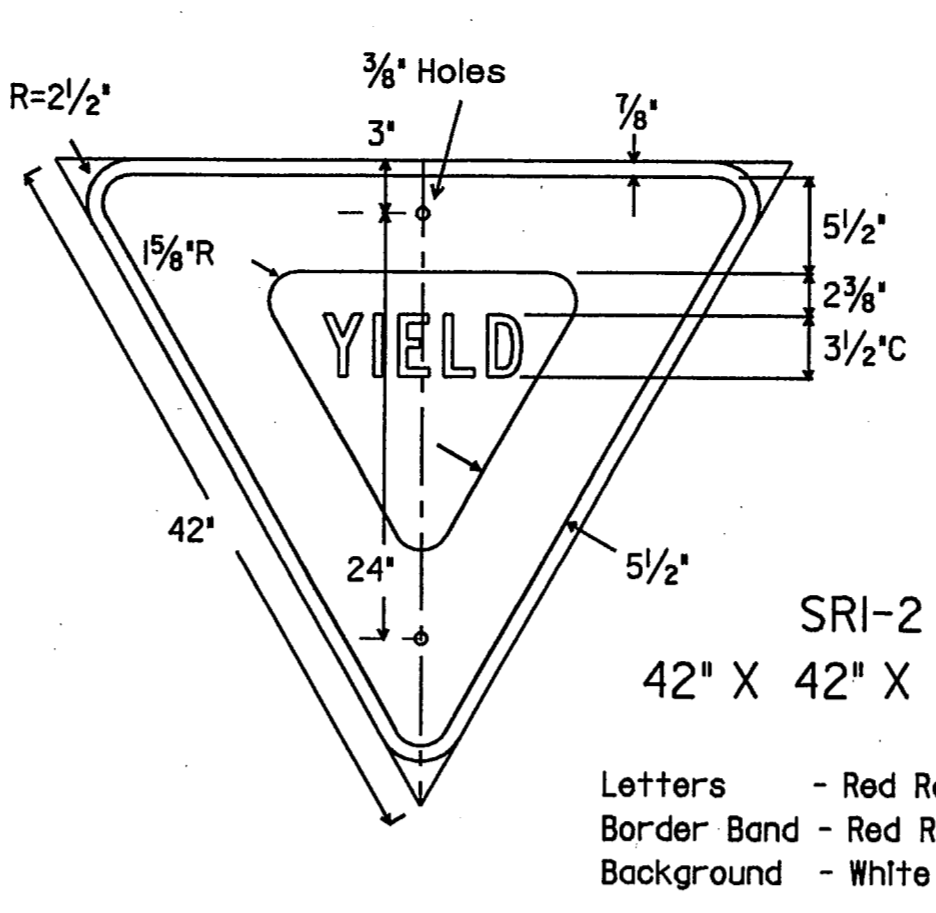


SRI-2  
42" X 42" X 42"  
Letters - Red Reflective  
Border Band - Red Reflective  
Background - White Reflective

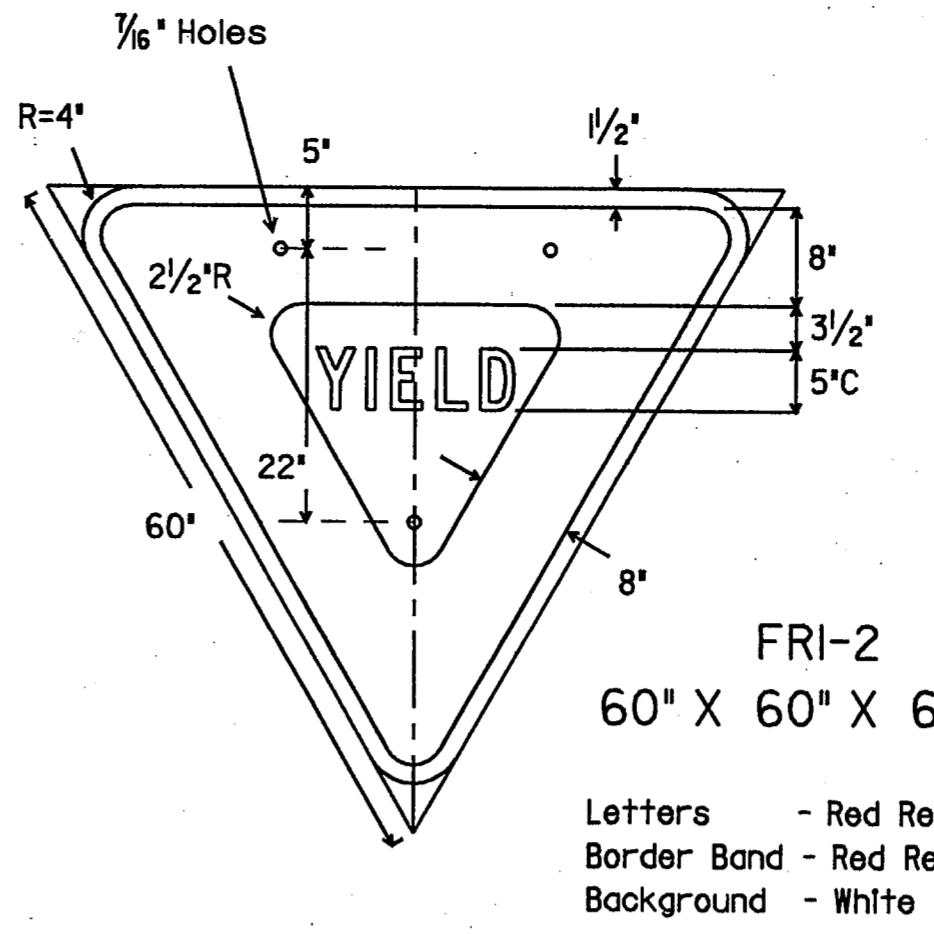


FRI-2  
60" X 60" X 60"  
Letters - Red Reflective  
Border Band - Red Reflective  
Background - White Reflective

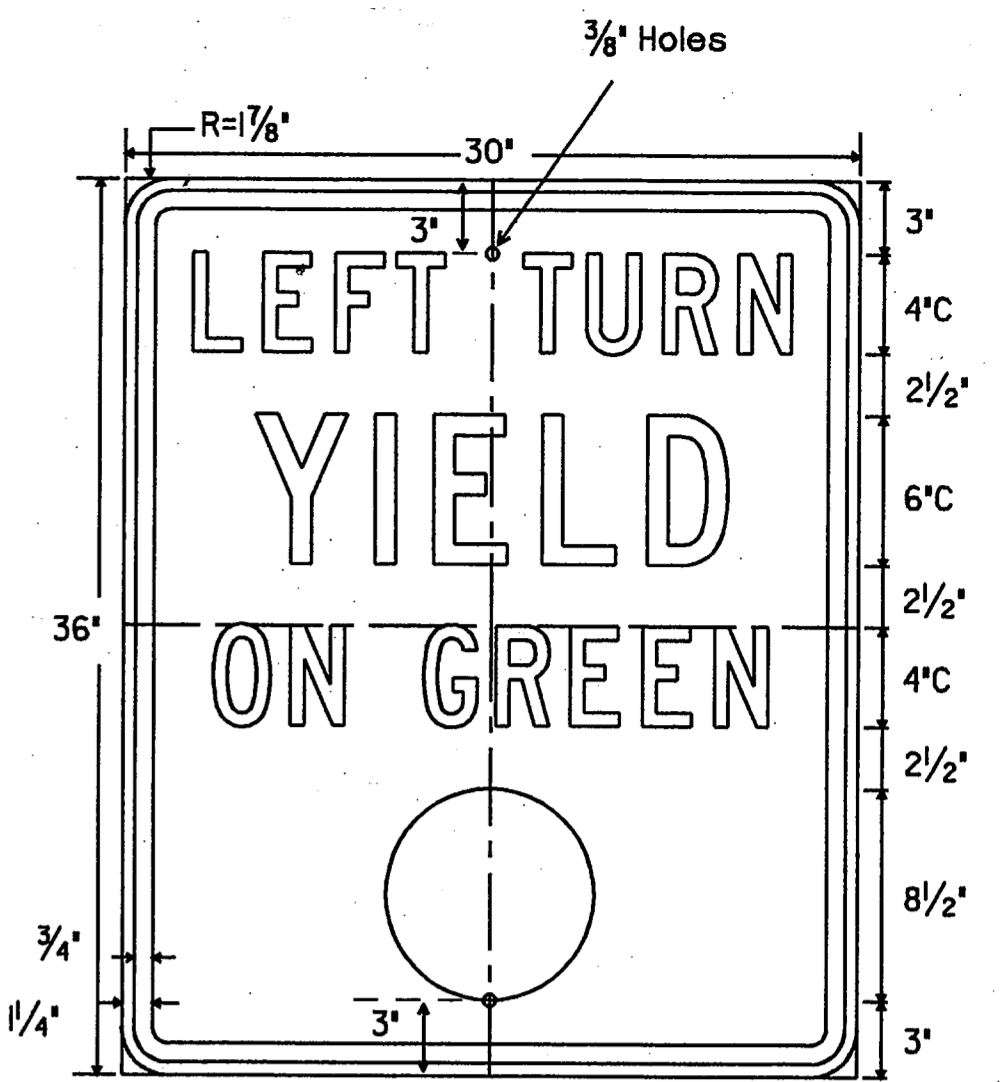


RIO-12  
36" X 36"  
Letters - Black  
Border - Black  
Circle - Green Refl.  
Background - White Refl.

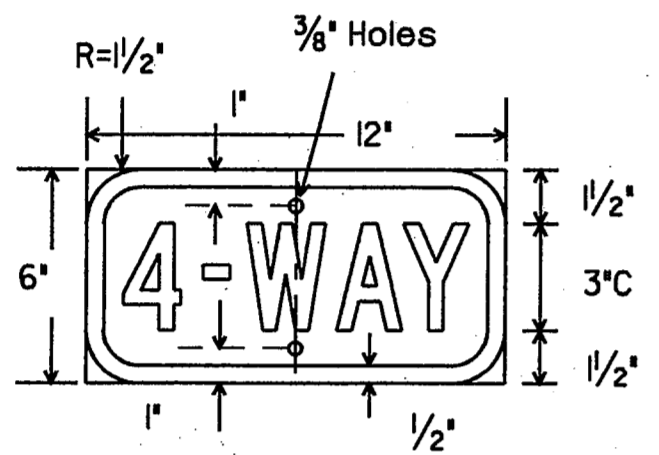


RI-3  
12" X 6"  
Letters - White Reflective  
Border - White Reflective  
Background - Red Reflective

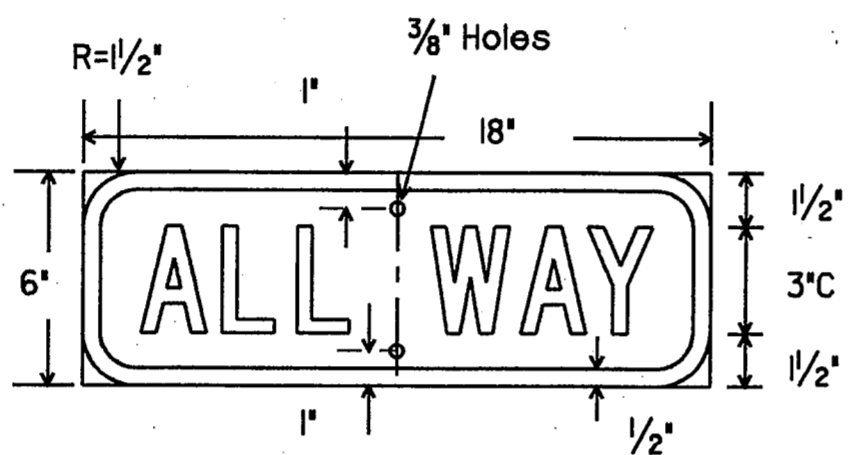


RI-4  
18" X 6"  
Letters - White Reflective  
Border - White Reflective  
Background - Red Reflective

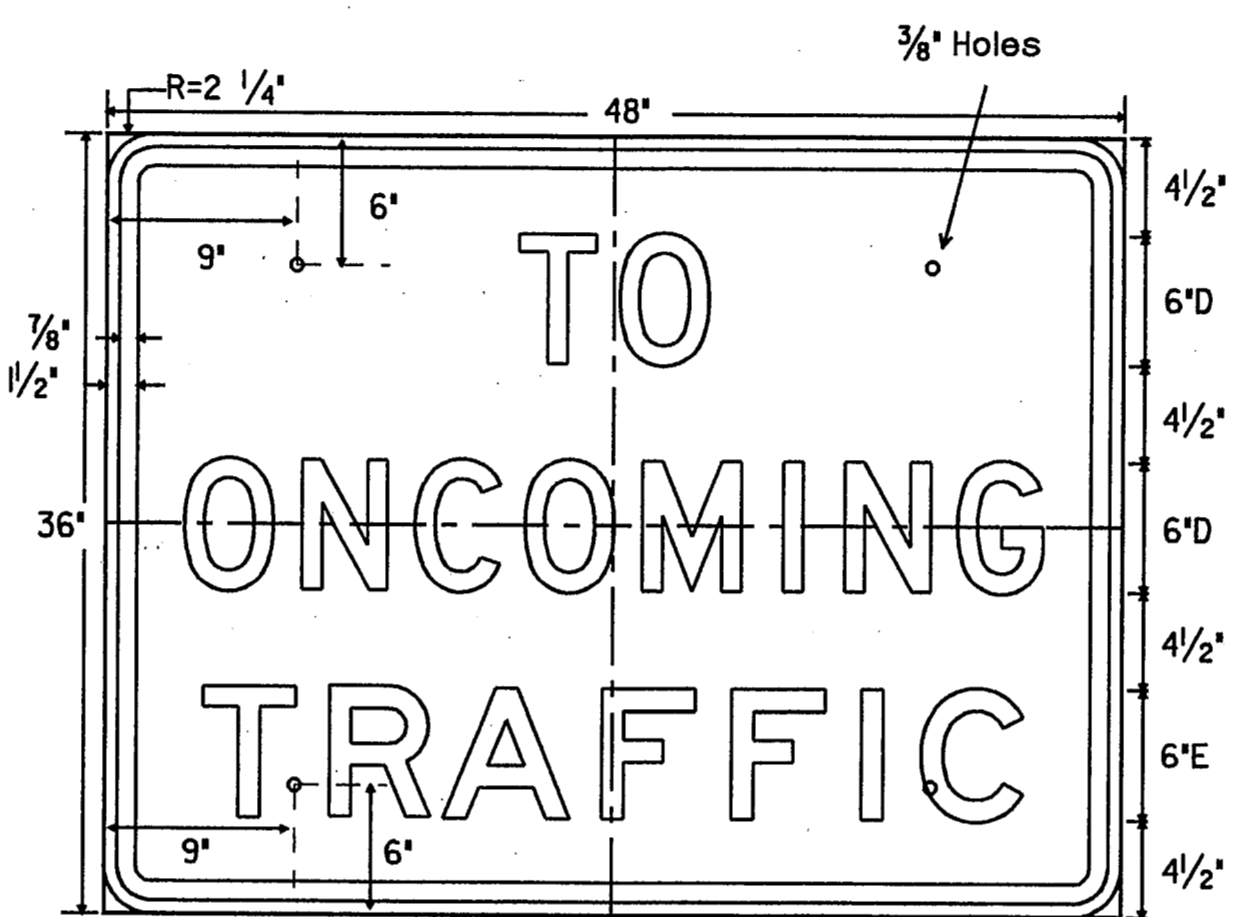


SRI-2b  
48" X 36"  
Legend - Black  
Background - White Refl.

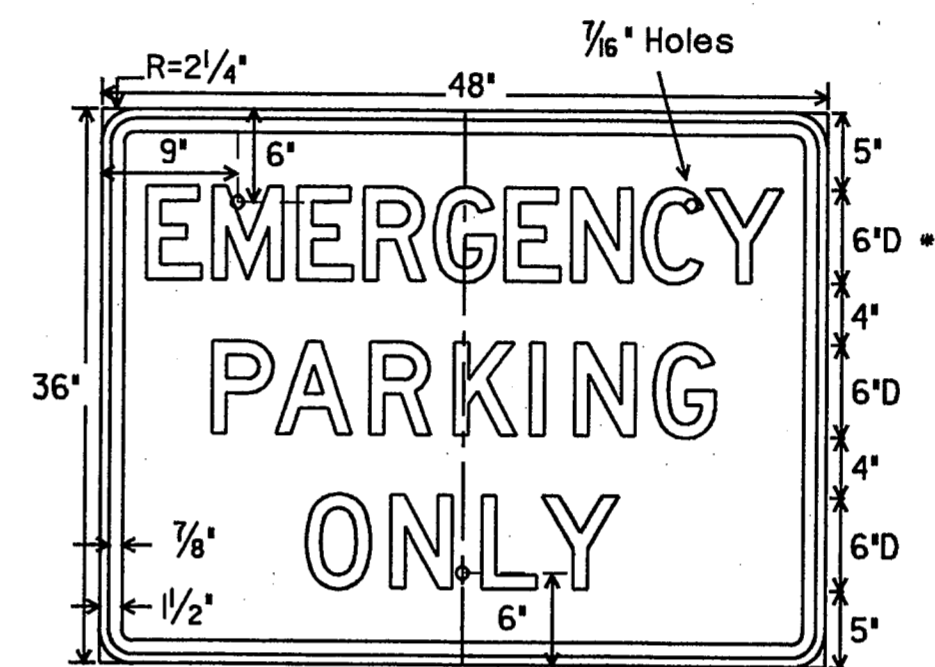


FR8-4  
48" X 36"  
Legend - Black  
Background - White Refl.  
\* reduce spacing 50%

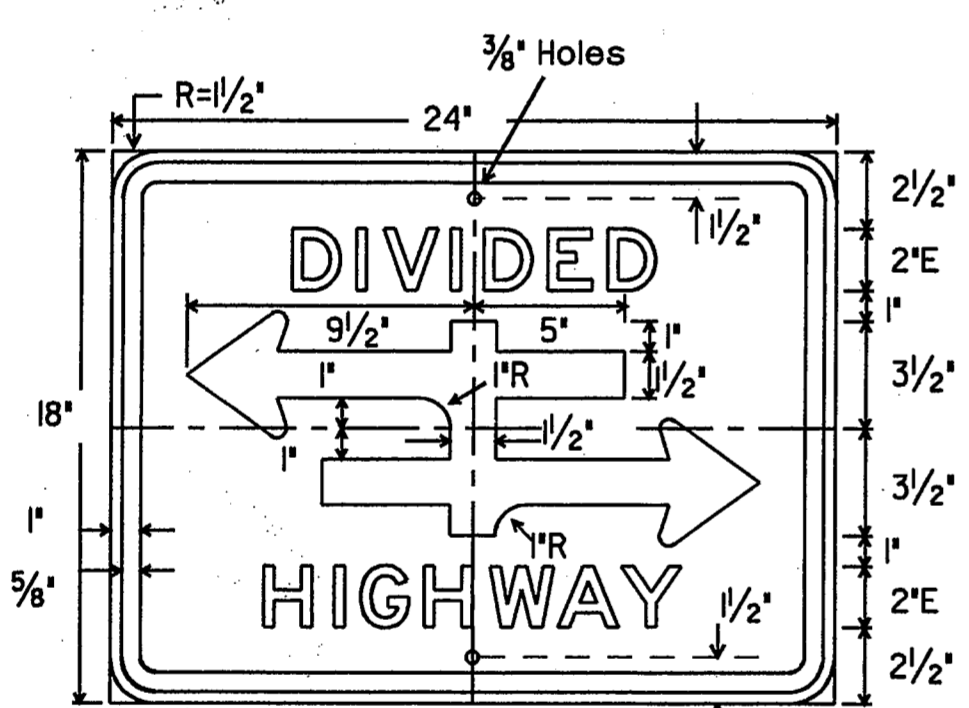


R6-3  
24" X 18"  
Legend - Black  
Background - White Refl.

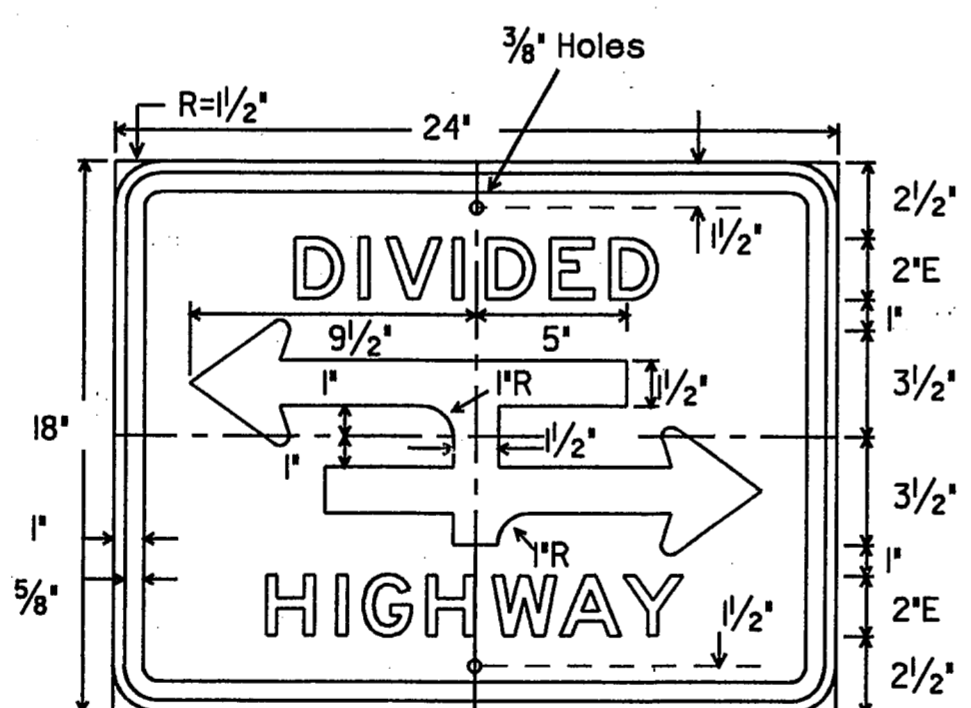

R6-3a  
24" X 18"  
Legend - Black  
Background - White Refl.

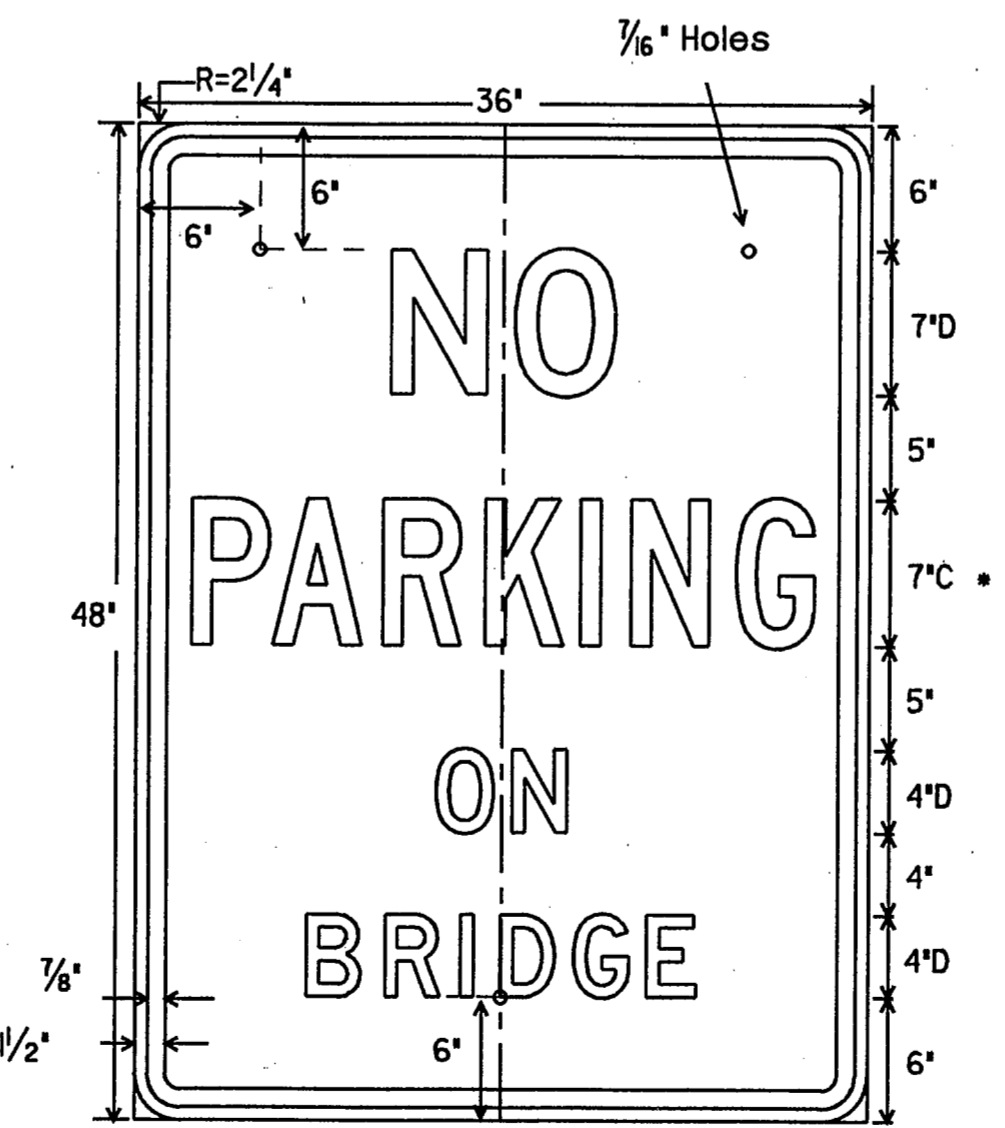

ER8-1T  
36" X 48"  
Letters - Red Reflective  
Border - Red Reflective  
Background - White Reflective  
\* reduce spacing 50%

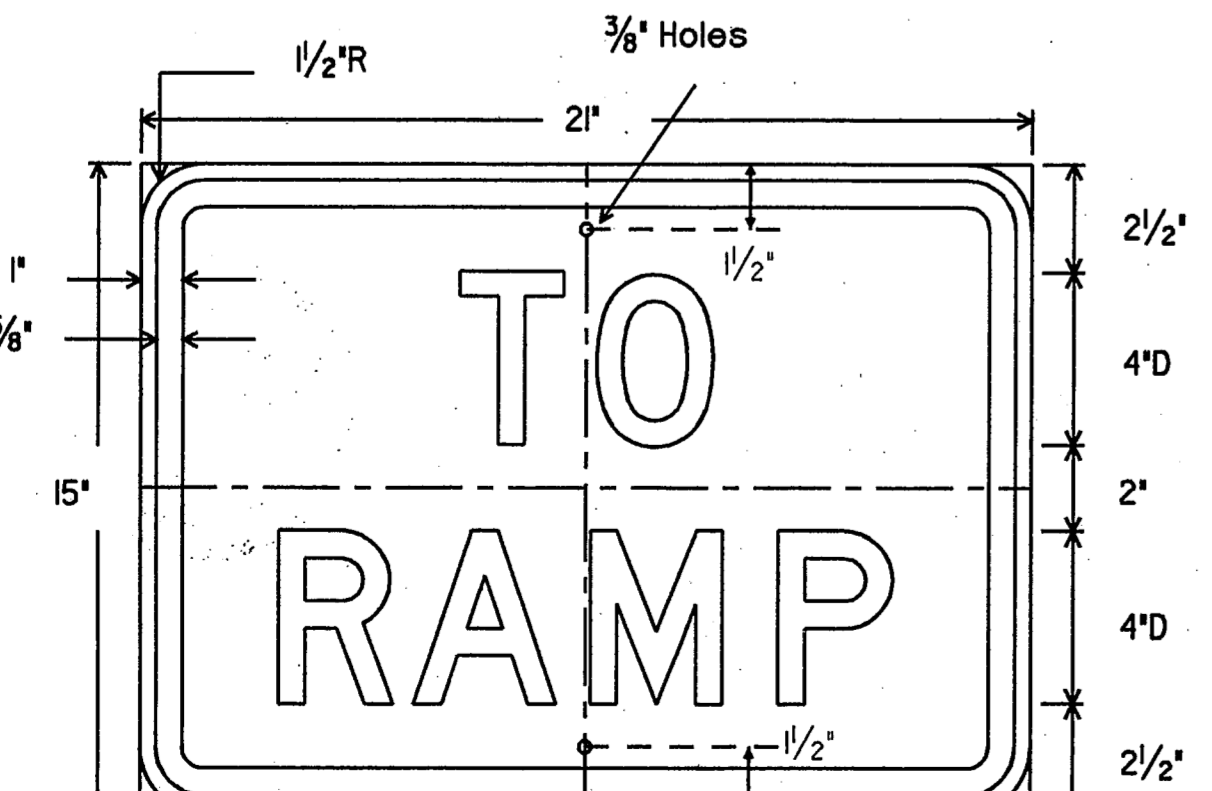


RI-2a  
21" X 15"  
Legend - Black  
Background - White Refl.

SPECIFICATION REFERENCE TABLE	
MATERIALS AND TESTS DIVISION SPECIFICATIONS	
ALUMINUM SIGN BLANKS	D-9-710 Δ
REFLECTIVE SHEETING, TYPE A (ENGINEER GRADE) (FOR BLACK AND WHITE SIGNS ON THIS SHEET)	D-9-8300
REFLECTIVE SHEETING, TYPE C (HIGH SPECIFIC INTENSITY) (FOR RED SERIES SIGNS ON THIS SHEET)	D-9-8300
VINYL NON-REFLECTIVE DECAL SHEETING	D-9-8320

GENERAL NOTES:  
The alphabets and lateral spacing between letters and numerals shall conform with the Texas 'Manual on Uniform Traffic Control Devices for Streets and Highways', latest edition, and any approved changes thereto. Lateral spacing of text shall provide a balanced appearance. All materials shall conform to Department Specifications.  
Legend (except where noted), shall be applied by screening process of black and/or transparent colored ink, cut-out black vinyl non-reflective decal sheeting, and/or reflective sheeting or combination thereof. Legend on RI-1, SRI-1, RI-3 and RI-4 shall be applied by reverse screening process with transparent colored ink or cut-out white reflective sheeting applied to colored background or combination thereof. Background shall be reflective sheeting.  
Sign blanks shall be one piece 0.080 inch thick sheet aluminum alloy Δ (Type A), unless otherwise noted elsewhere in the plans.

LEVELS DISPLAYED  
 1 2 3 4 5 6 7 8 9 10 11 12 13 14 15 16  
 DATE: \_\_\_\_\_  
 FILE: \_\_\_\_\_  
 ACC: d58mpic/usr/d580504  
 CK: CW  
 DW: DN  
 CK: MT

FINAL RECORD  
DRAWING  
Date: 12/25/99

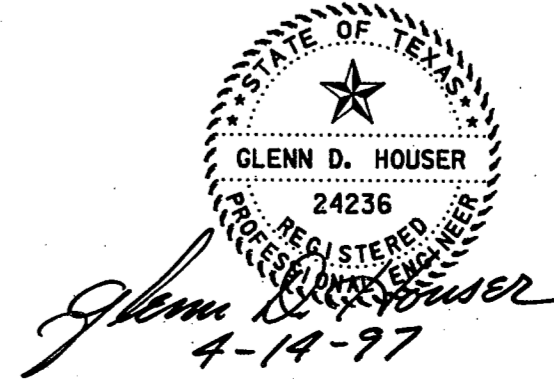

ISSUE DATE: 11-26-96

STANDARD PLANS  
TEXAS DEPARTMENT OF TRANSPORTATION  
Traffic Operations Division


REGULATORY SIGNS  
R(1)-95 (MOD.)

ORIG. DRAW. DATE: FEB. 1976	REV. NO.:	STATE DISTRICT:	FEDERAL REGION:	FEDERAL AID PROJECT:	SHEET NO.:
			6		37
COUNTY:		CONTROL SECTION:		JOB HIGHWAY:	


DN:LR  
 CK:CN  
 DW:DN  
 CK:MT

LEVELS DISPLAYED  
 DATE: 1 2 3 4 5 6 7 8 9 10 11 12 13 14 15 16


4580504  
 ACC: d58mp/c/usr/d580504  
 FILE:

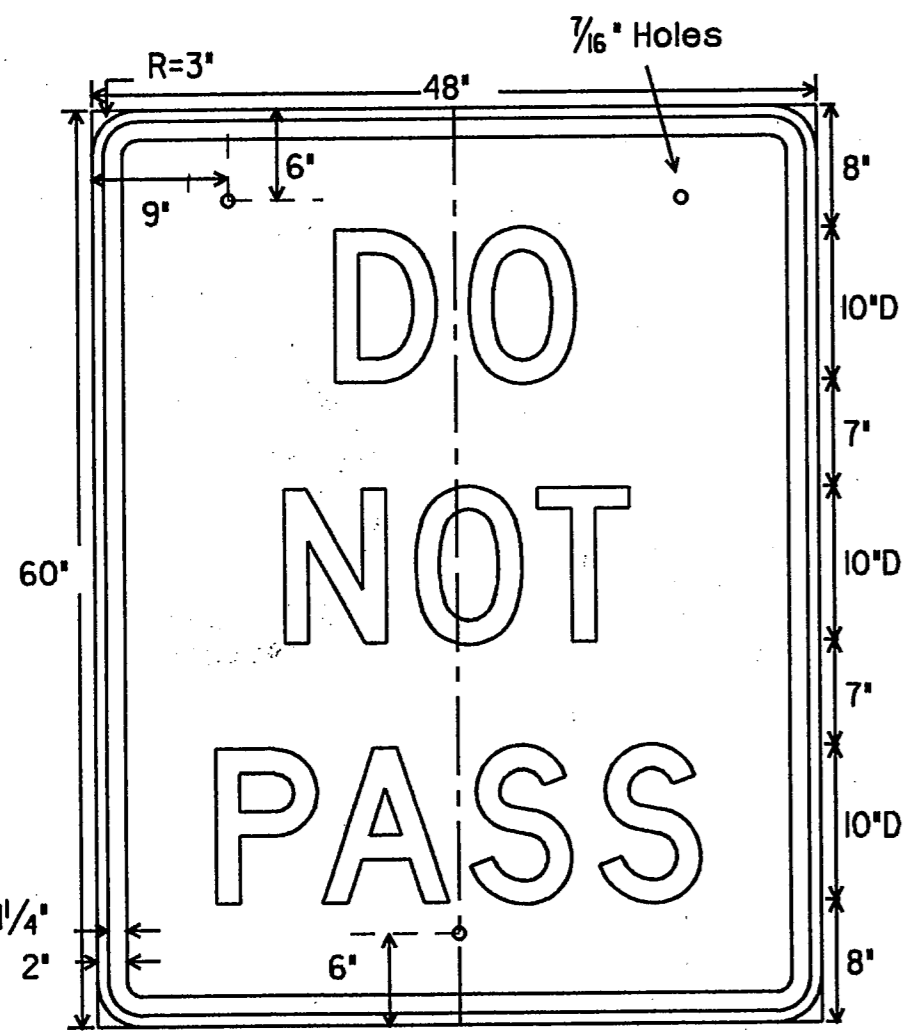


FR4-1  
48" X 60"

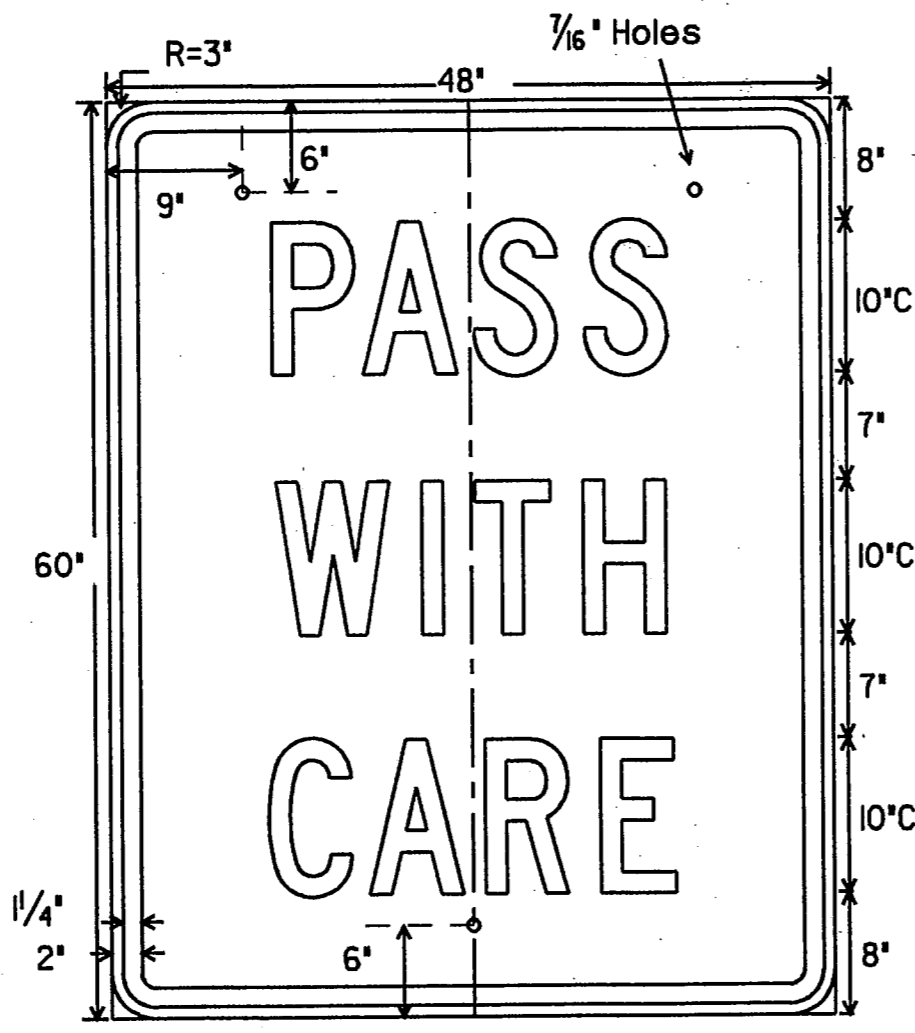


FR4-2  
48" X 60"

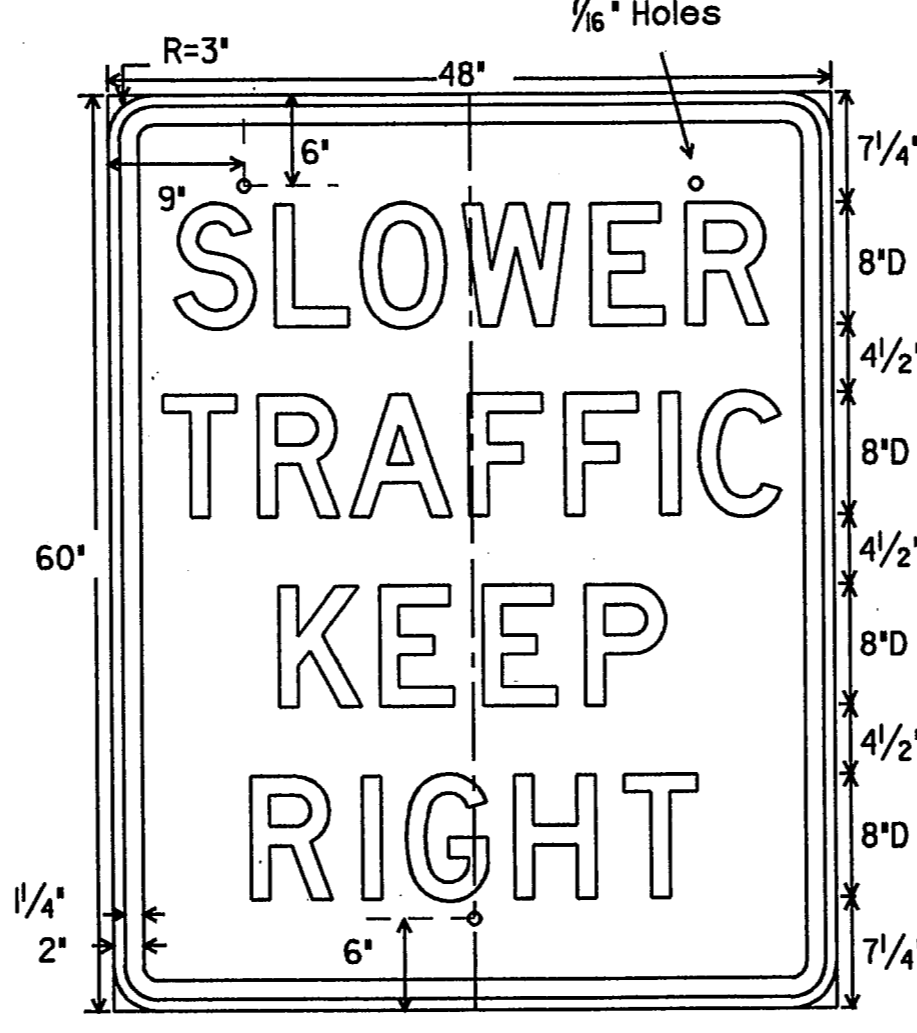


FR4-3  
48" X 60"  
\* reduce spacing 25%

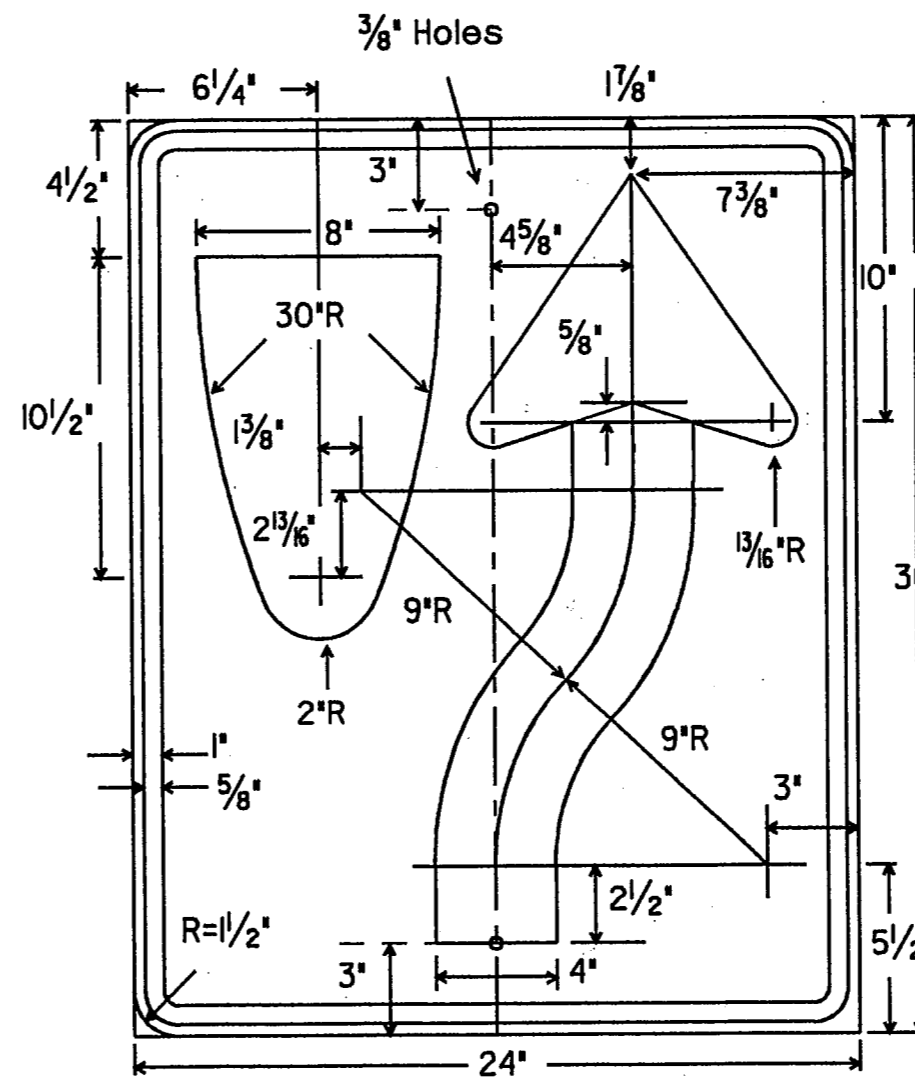


R4-7  
24" X 30"

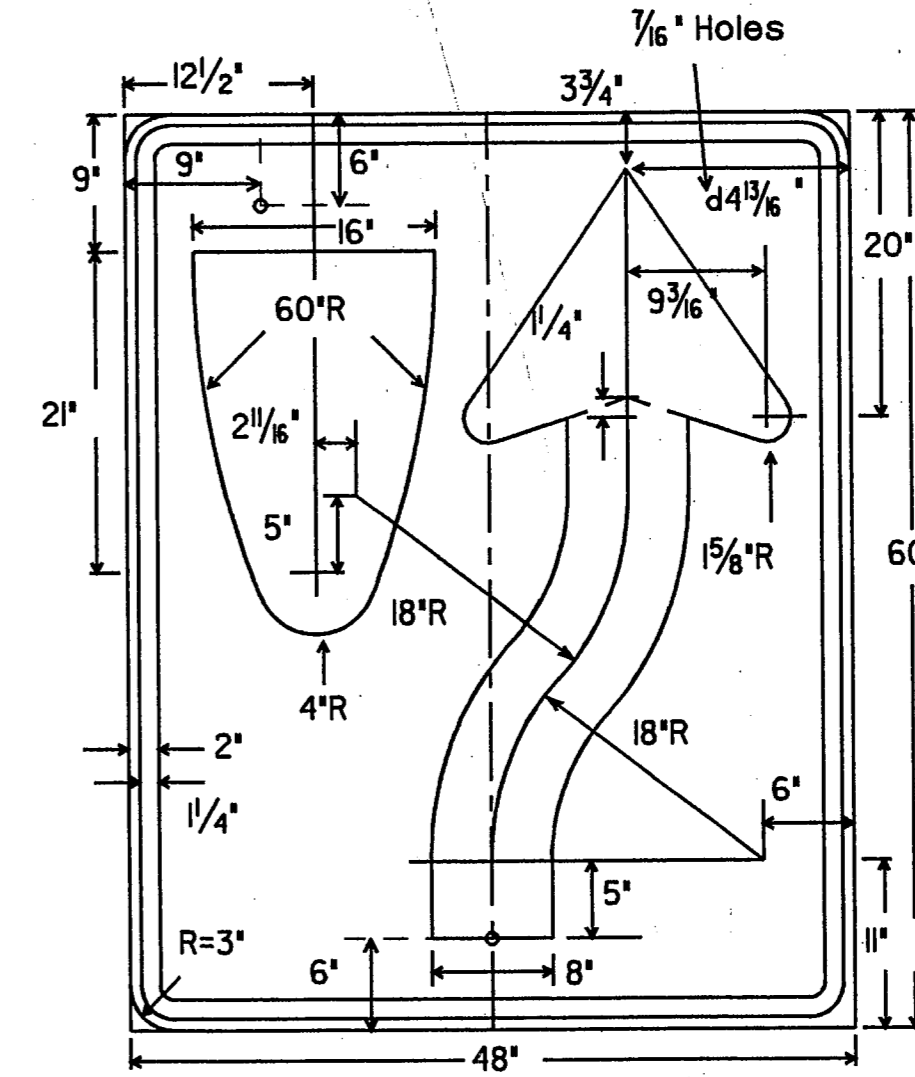

FR4-7  
48" X 60"

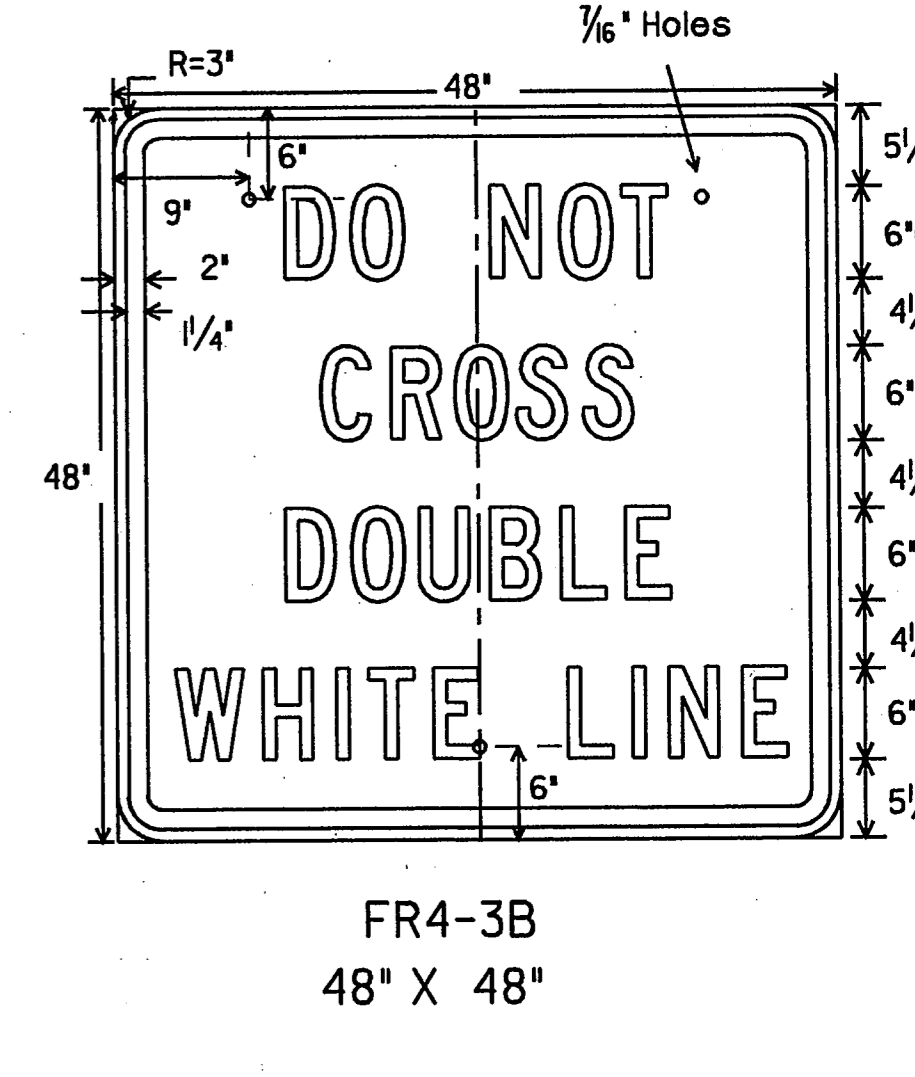


FR4-3B  
48" X 48"

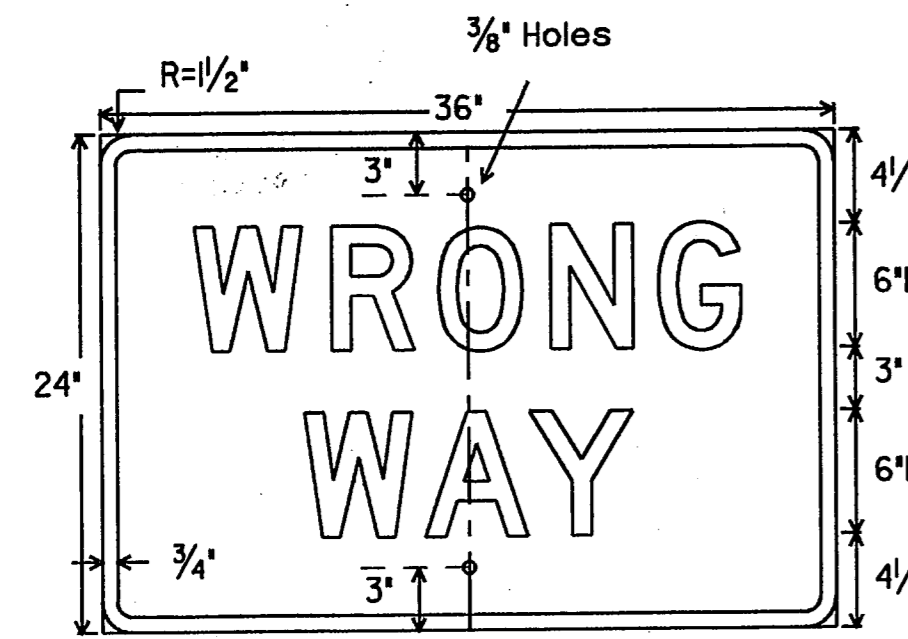


R5-1a  
36" X 24"

Letters - White Reflective  
 Border - White Reflective  
 Background - Red Reflective

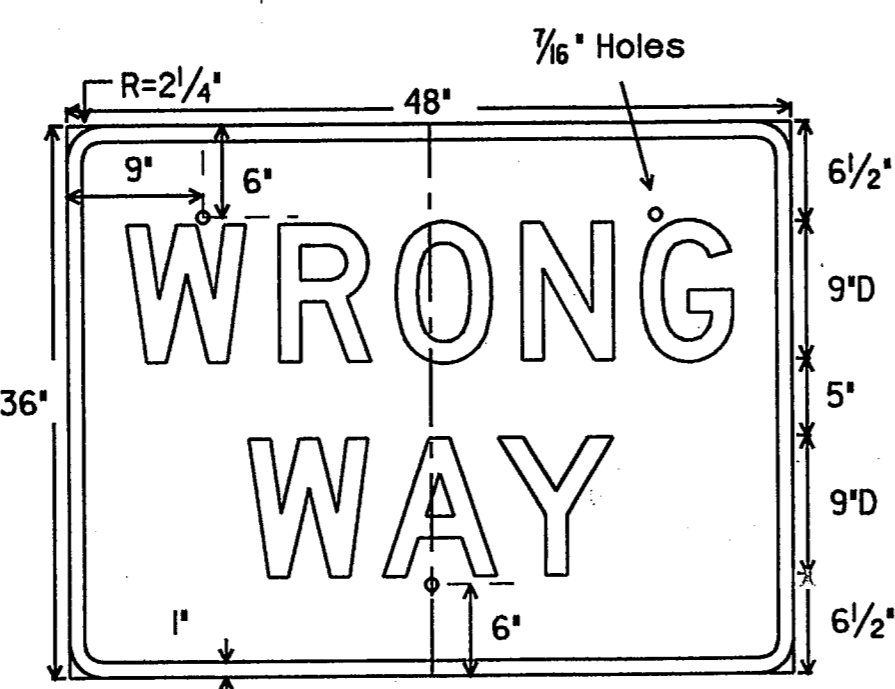


SR5-1a  
48" X 36"

Letters - White Reflective  
 Border - White Reflective  
 Background - Red Reflective

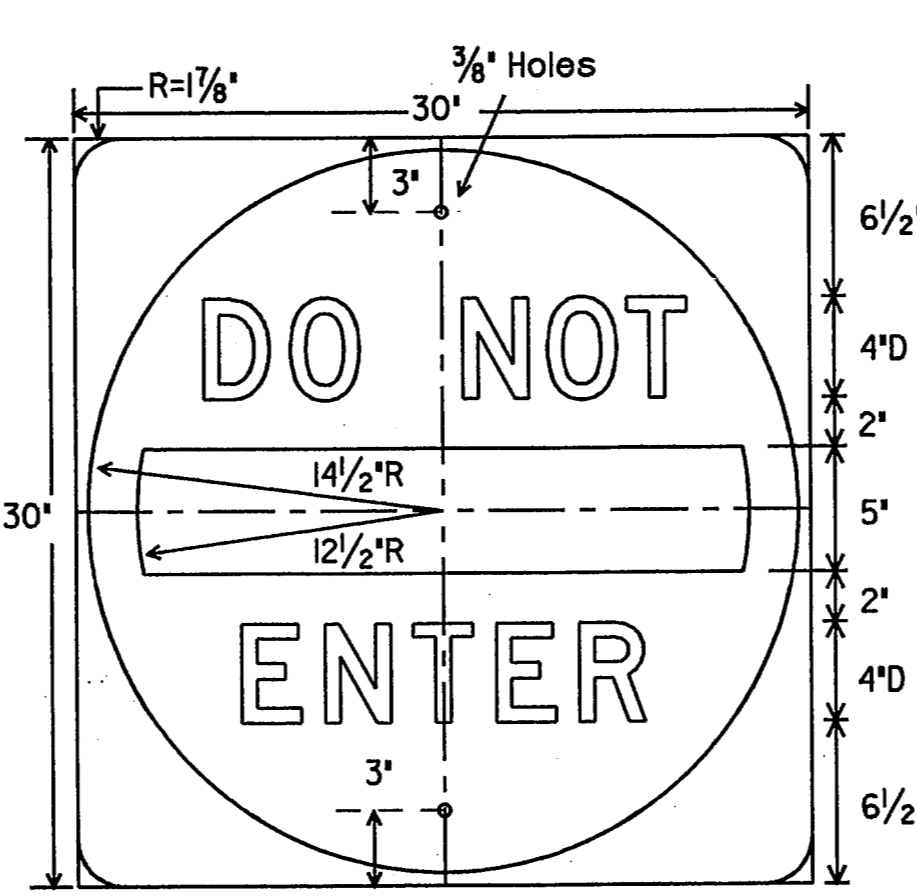


R5-1  
30" X 30"

Letters - White Reflective  
 Bar - White Reflective  
 Background - Red Reflective

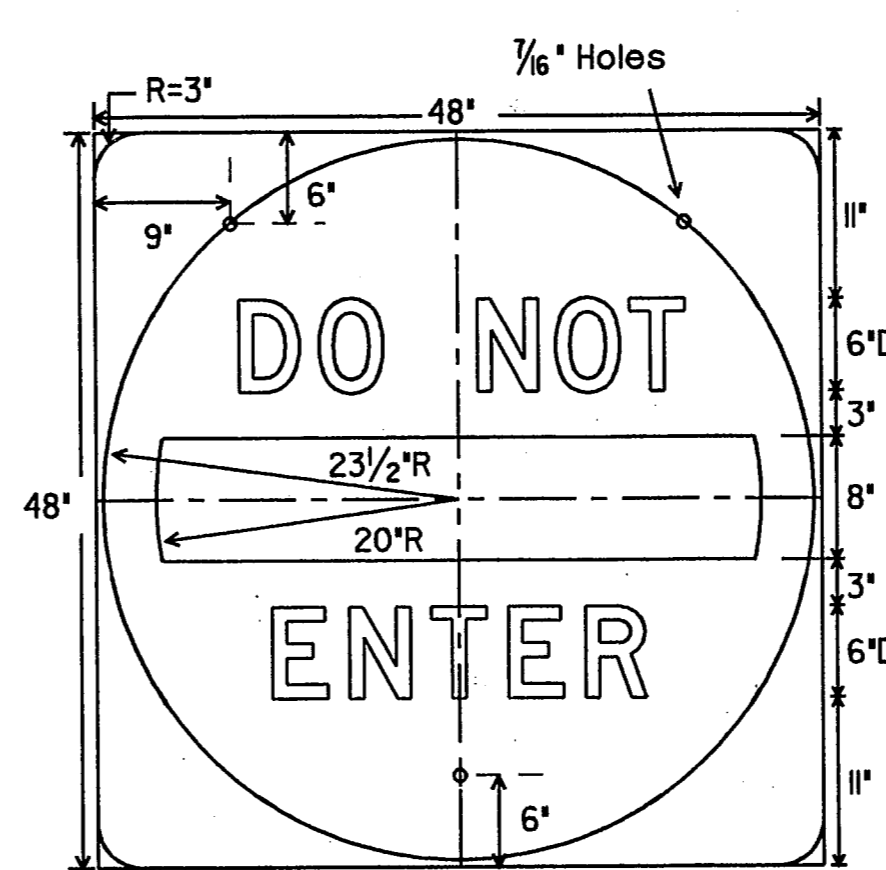


SR5-1  
48" X 48"

Letters - White Reflective  
 Bar - White Reflective  
 Background - Red Reflective

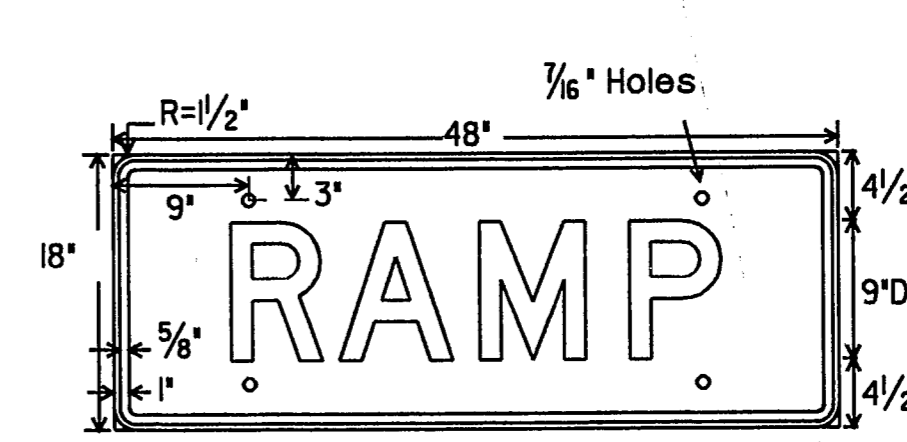

R5-1T  
48" X 18"

Letters - Red Reflective  
 Border - Red Reflective  
 Background - White Reflective

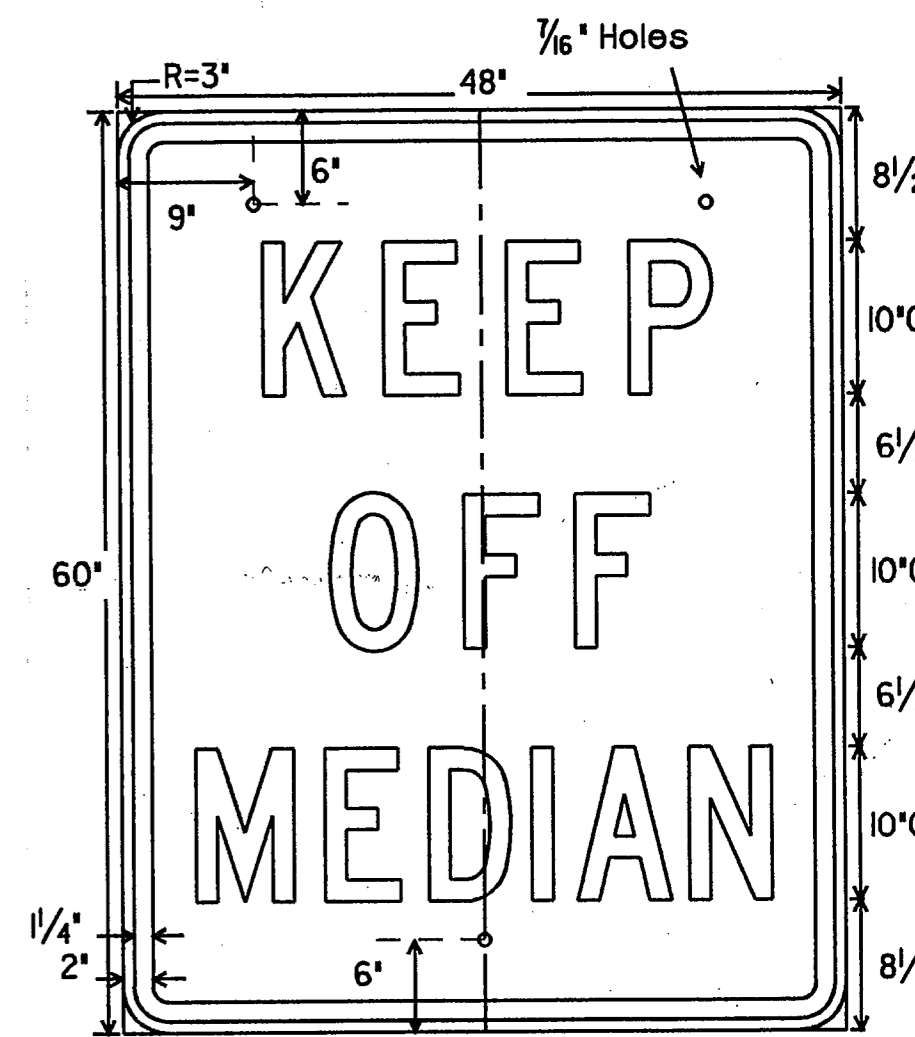

FR1-1  
48" X 60"

**SPECIFICATION REFERENCE TABLE**

MATERIALS AND TESTS DIVISION SPECIFICATIONS	D-9-710 Δ
ALUMINUM SIGN BLANKS	D-9-8300
REFLECTIVE SHEETING, TYPE A (ENGINEER GRADE) (FOR BLACK AND WHITE SIGNS ON THIS SHEET)	D-9-8300
REFLECTIVE SHEETING, TYPE C (HIGH SPECIFIC INTENSITY) (FOR RED SERIES SIGNS ON THIS SHEET)	D-9-8300
VINYL NON-REFLECTIVE DECAL SHEETING	D-9-8320


GENERAL NOTES:

The alphabets and lateral spacing between letters and numerals shall conform with the Texas Manual on Uniform Traffic Control Devices for Streets and Highways, latest edition, and any approved changes thereto. Lateral spacing of text shall provide a balanced appearance. All materials shall conform to Department Specifications.

Legend (except where noted), shall be black and applied by screening process, cut-out vinyl non-reflective decal sheeting, and/or reflective sheeting or combination thereof. Legend on R5-1, SR5-1, R5-1T, R5-1a and SR5-1a shall be applied by reverse screening process with transparent colored ink or cut-out white reflective sheeting applied to colored background or combination thereof. Background shall be reflective sheeting.


Sign blanks shall be one piece 0.080 inch thick sheet aluminum alloy (Type A), unless Δ otherwise noted elsewhere in the plans.

ISSUE DATE: 11-26-96

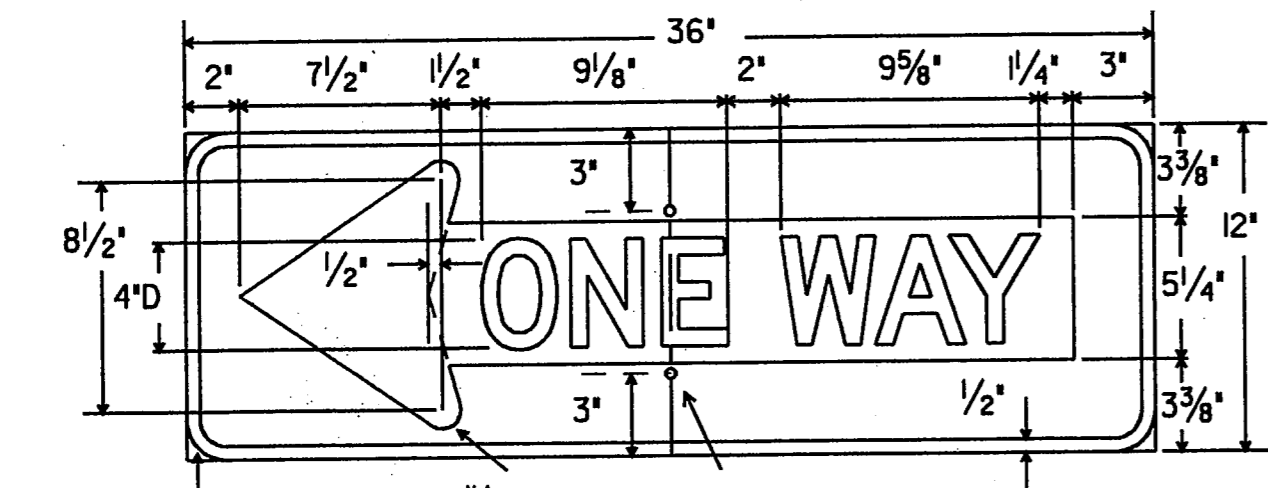


R6-1L  
36" X 12"

Letters - Black  
 Symbol - White Reflective  
 Border - White Reflective  
 Background - Black

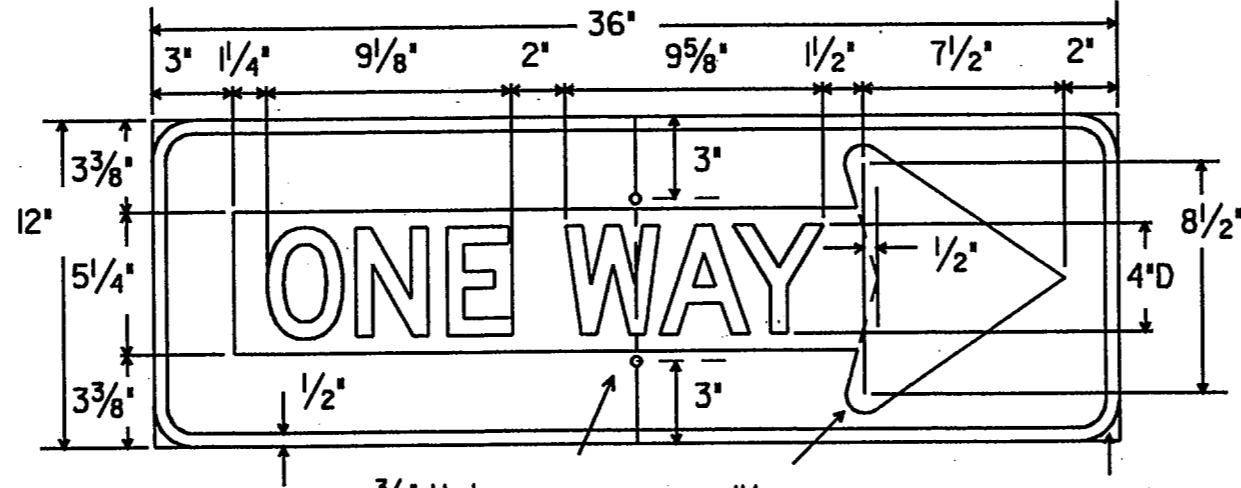


R6-1R  
36" X 12"

Letters - Black  
 Symbol - White Reflective  
 Border - White Reflective  
 Background - Black

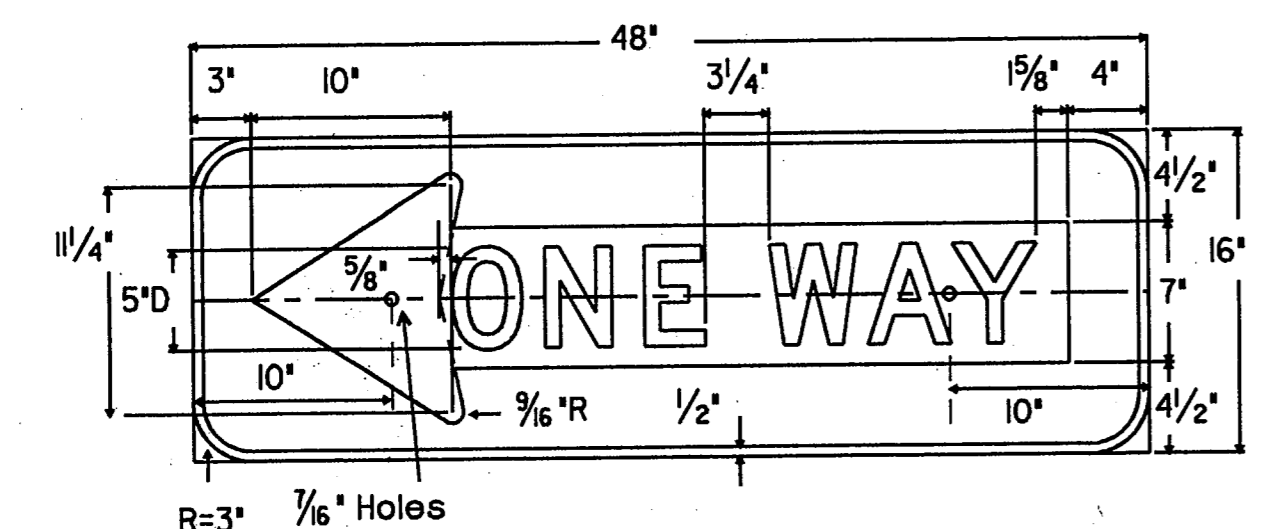

FR6-1L  
48" X 16"


Letters - Black  
 Symbol - White Reflective  
 Border - White Reflective  
 Background - Black

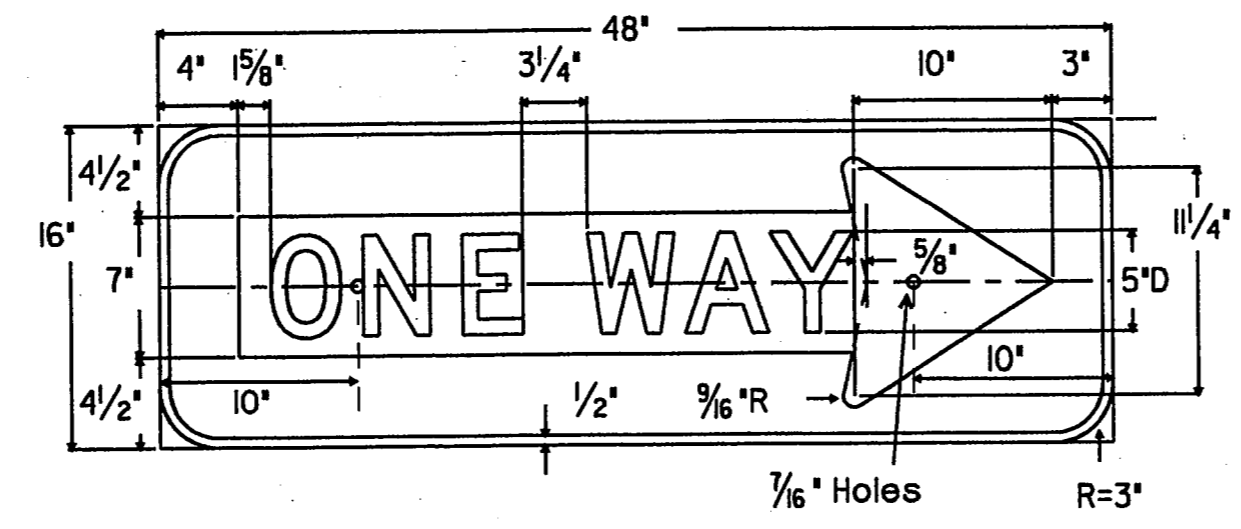

FR6-1R  
48" X 16"

Letters - Black  
 Symbol - White Reflective  
 Border - White Reflective  
 Background - Black

**FINAL RECORD DRAWING**  
 Date: 12/25/99

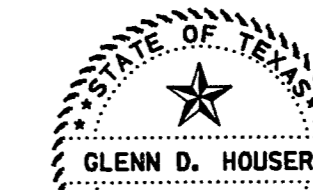


*Glenn D. Houser*  
 2-14-97

STANDARD PLANS  
 TEXAS DEPARTMENT OF TRANSPORTATION  
 Traffic Operations Division


**REGULATORY SIGNS**

R(2)- 95 (MOD.)


DATE: FEB. 1976	DW: LR	CK: DN	REG NO.: 38
REVISIONS:	STATE DISTRICT:	FEDERAL REGION:	FEDERAL AID PROJECT:
	6		
	COUNTY:	CONTROL SECTION:	JOB HIGHWAY:

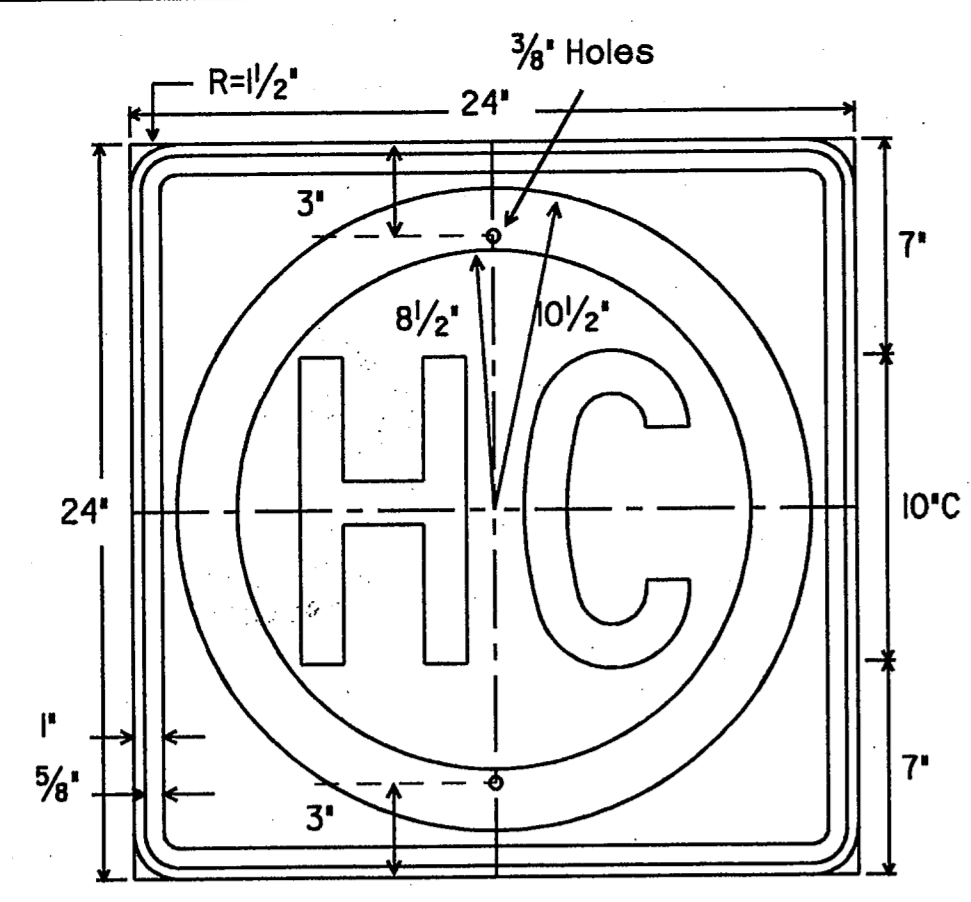


**R14-2**  
24" X 24"  
Letters - Black  
Border - Black  
Ring - Green Reflective  
Background - White Reflective

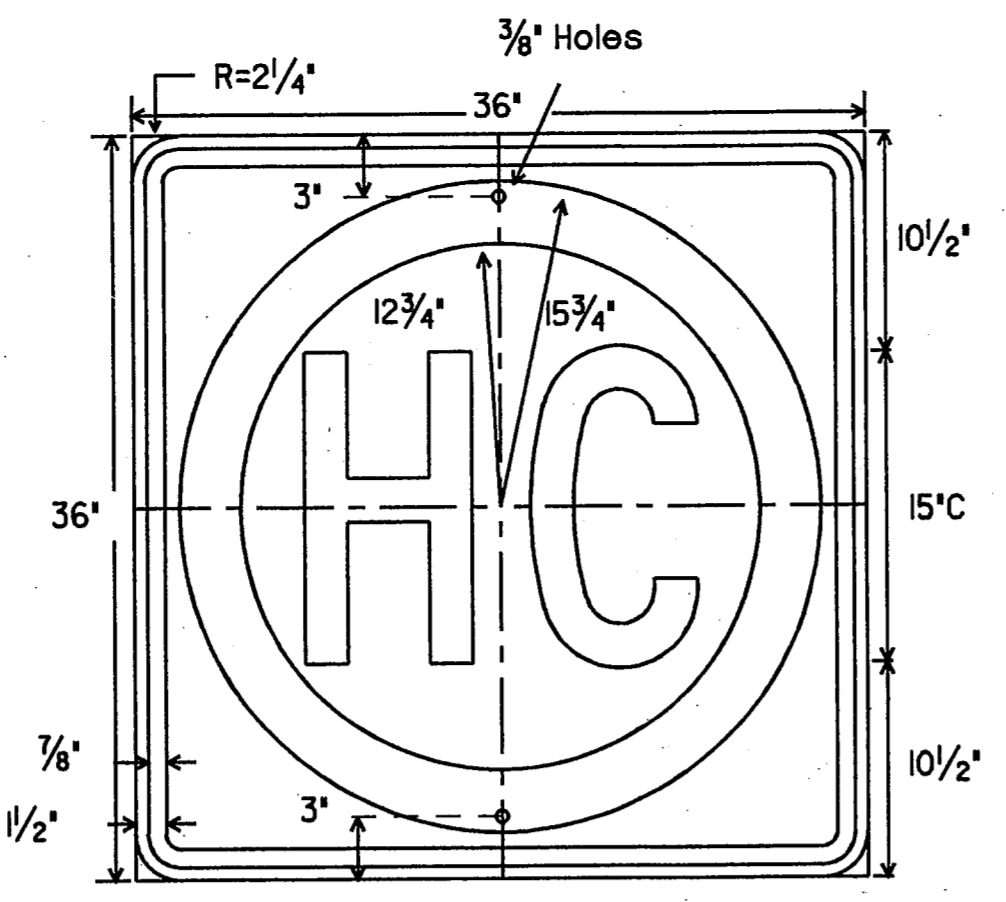


**ERI4-2**  
36" X 36"  
Letters - Black  
Border - Black  
Ring - Green Reflective  
Background - White Reflective

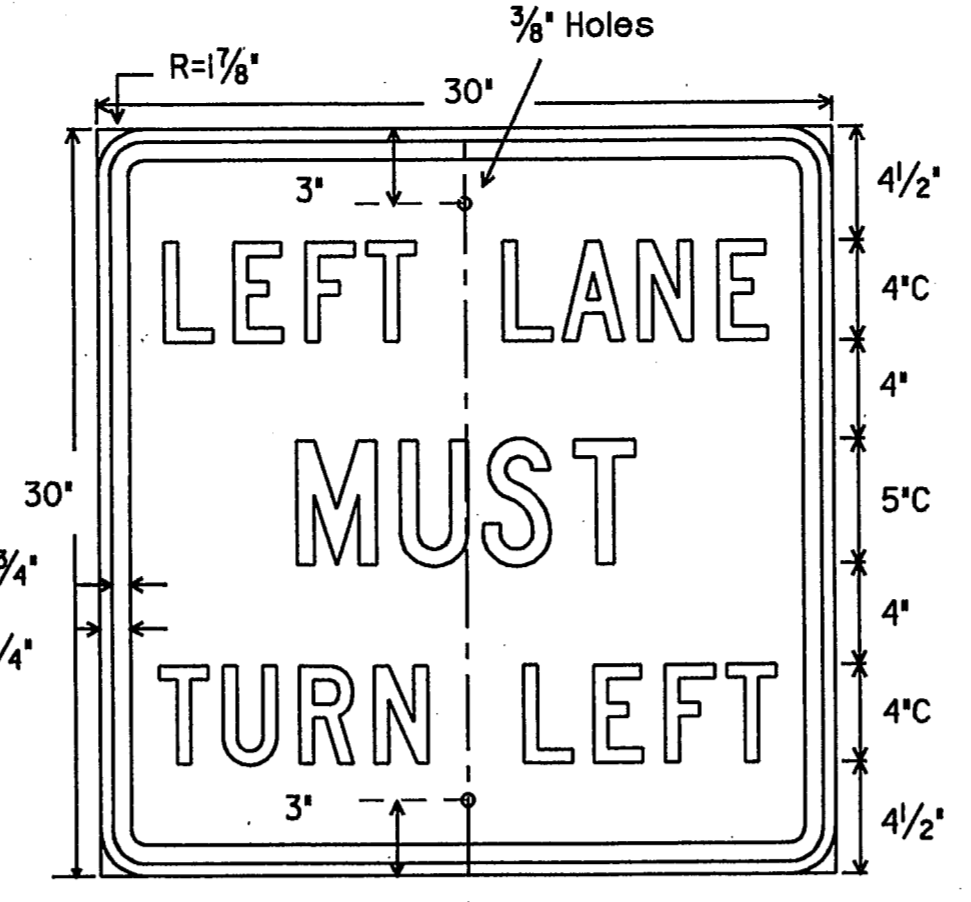


**R3-7L**  
30" X 30"  
Letters - Black  
Border - Black  
Ring - Green Reflective  
Background - White Reflective

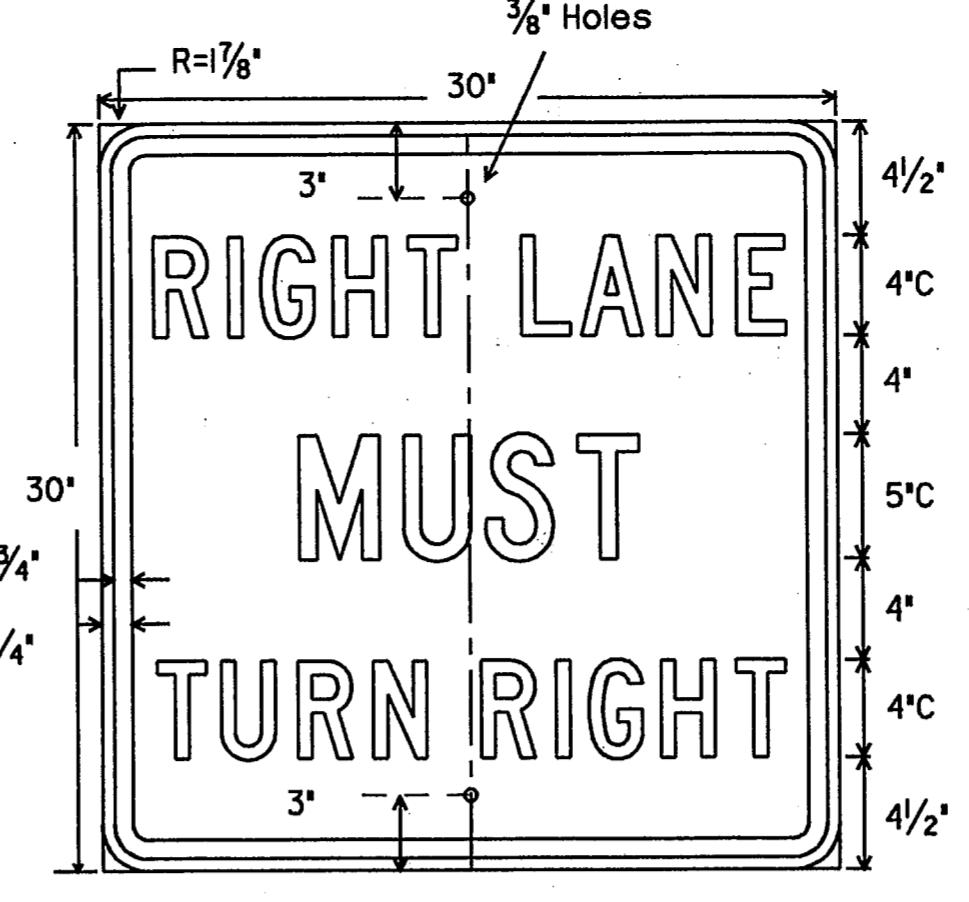


**R3-7R**  
30" X 30"  
Letters - Black  
Border - Black  
Ring - Green Reflective  
Background - White Reflective

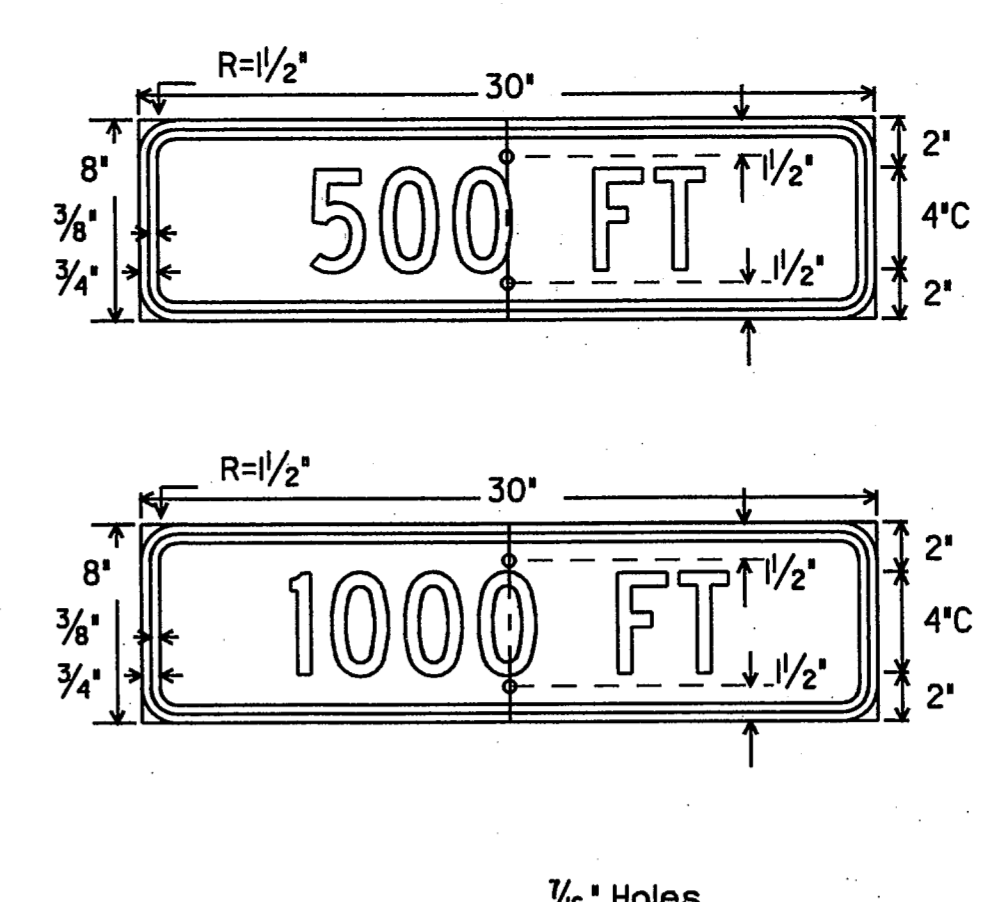


**R14-3**  
24" X 24"  
Letters - Black  
Border - Black  
Ring/Slash - Red Reflective  
Background - White Reflective

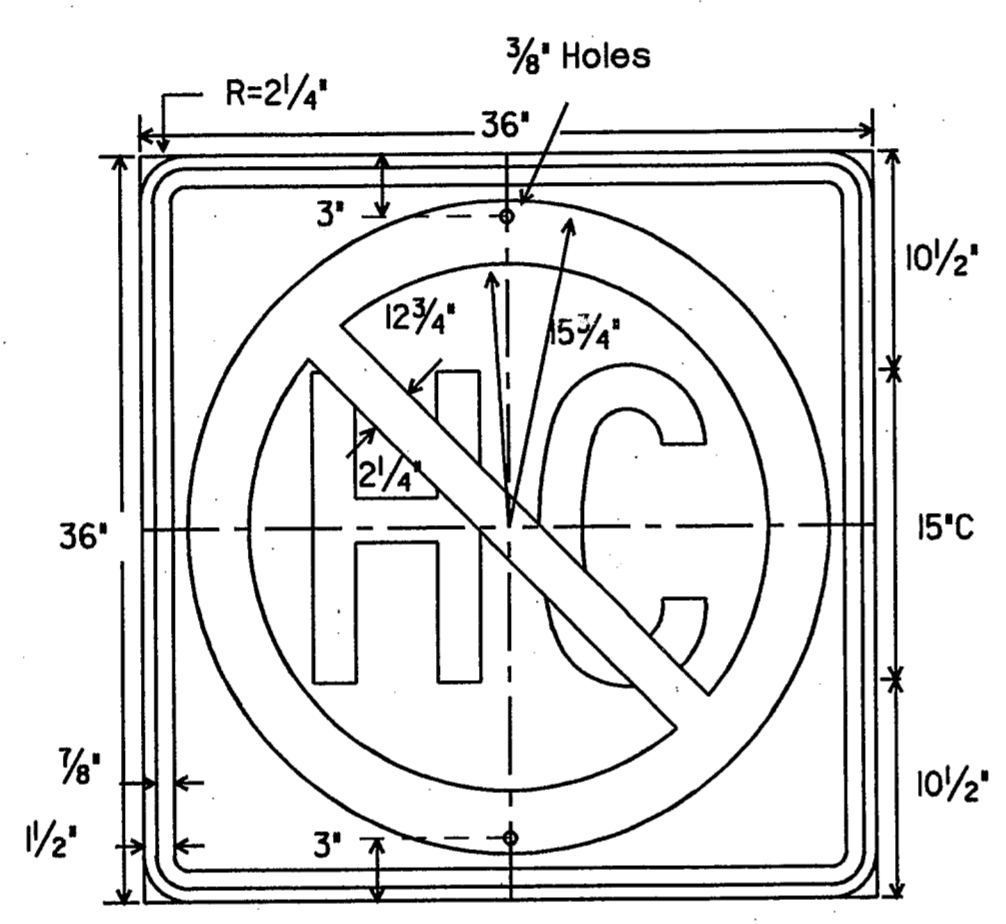


**ERI4-3**  
36" X 36"  
Letters - Black  
Border - Black  
Ring/Slash - Red Reflective  
Background - White Reflective

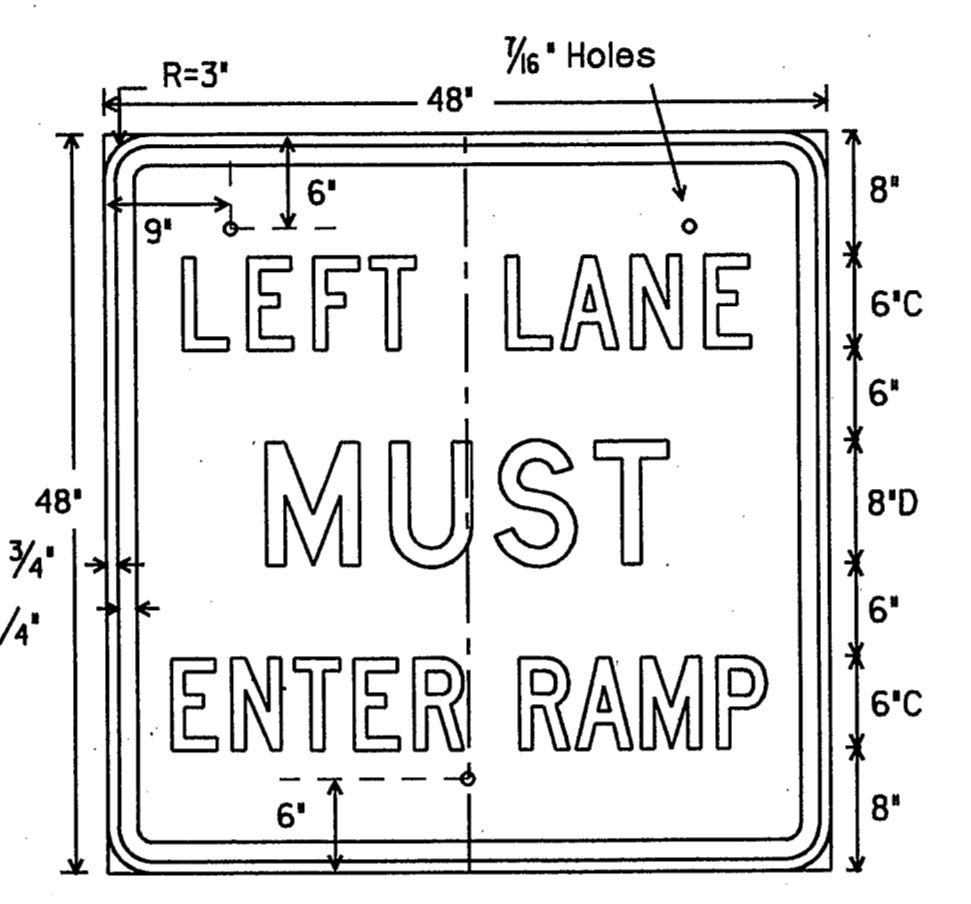


**R3-20**  
48" X 48"  
Letters - Black  
Border - Black  
Ring - Green Reflective  
Background - White Reflective

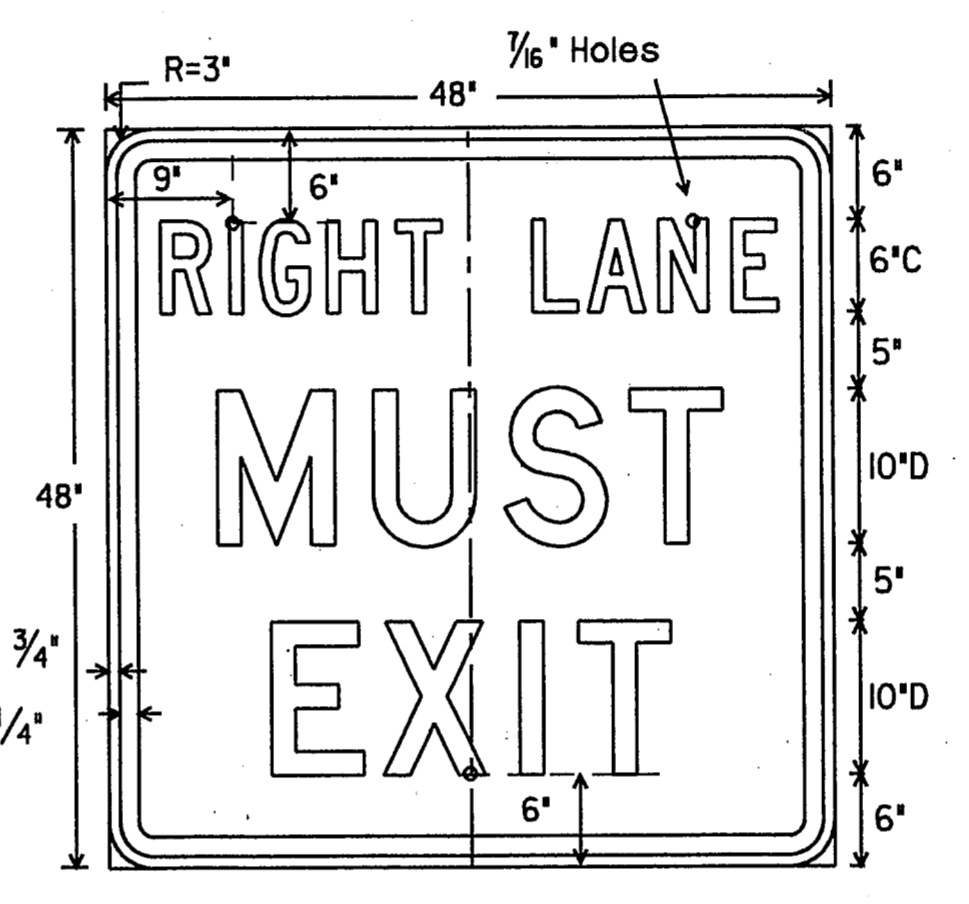


**R3-21R**  
48" X 48"  
Letters - Black  
Border - Black  
Ring - Green Reflective  
Background - White Reflective

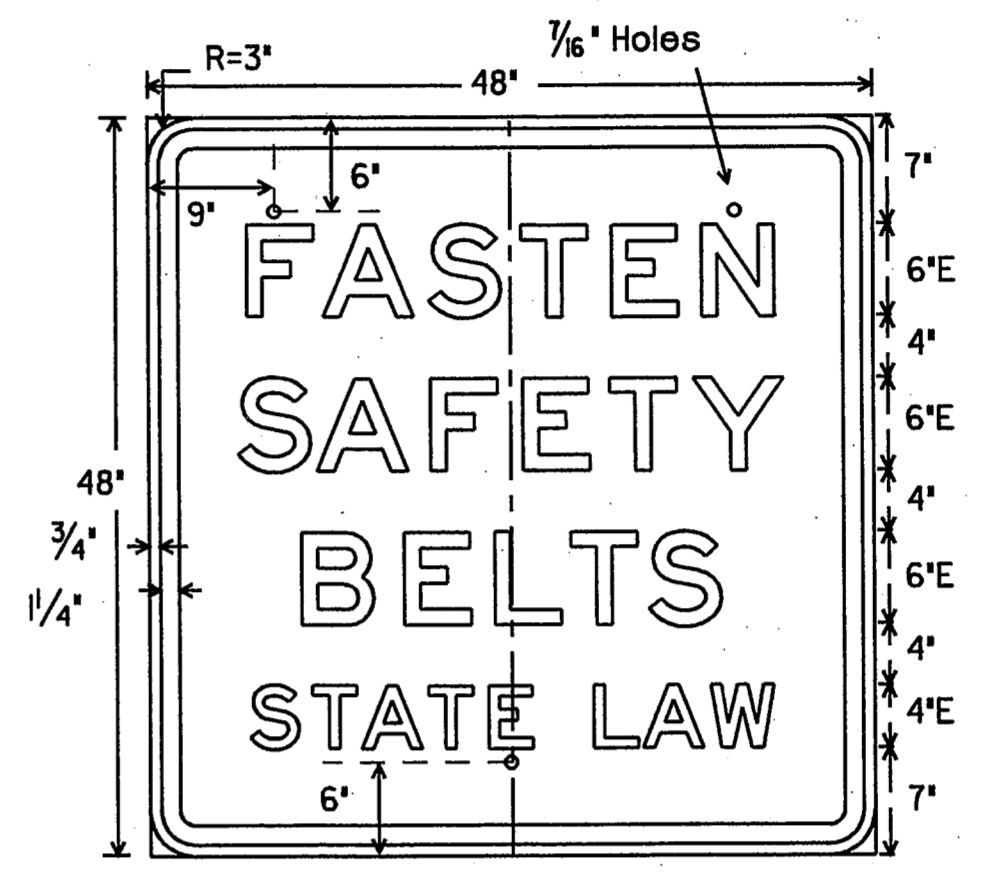

**FRI9-8**  
48" X 48"  
Letters - Black  
Arrow - Black  
Border - Black  
Circle & Diagonal - Red Reflective  
Background - White Reflective

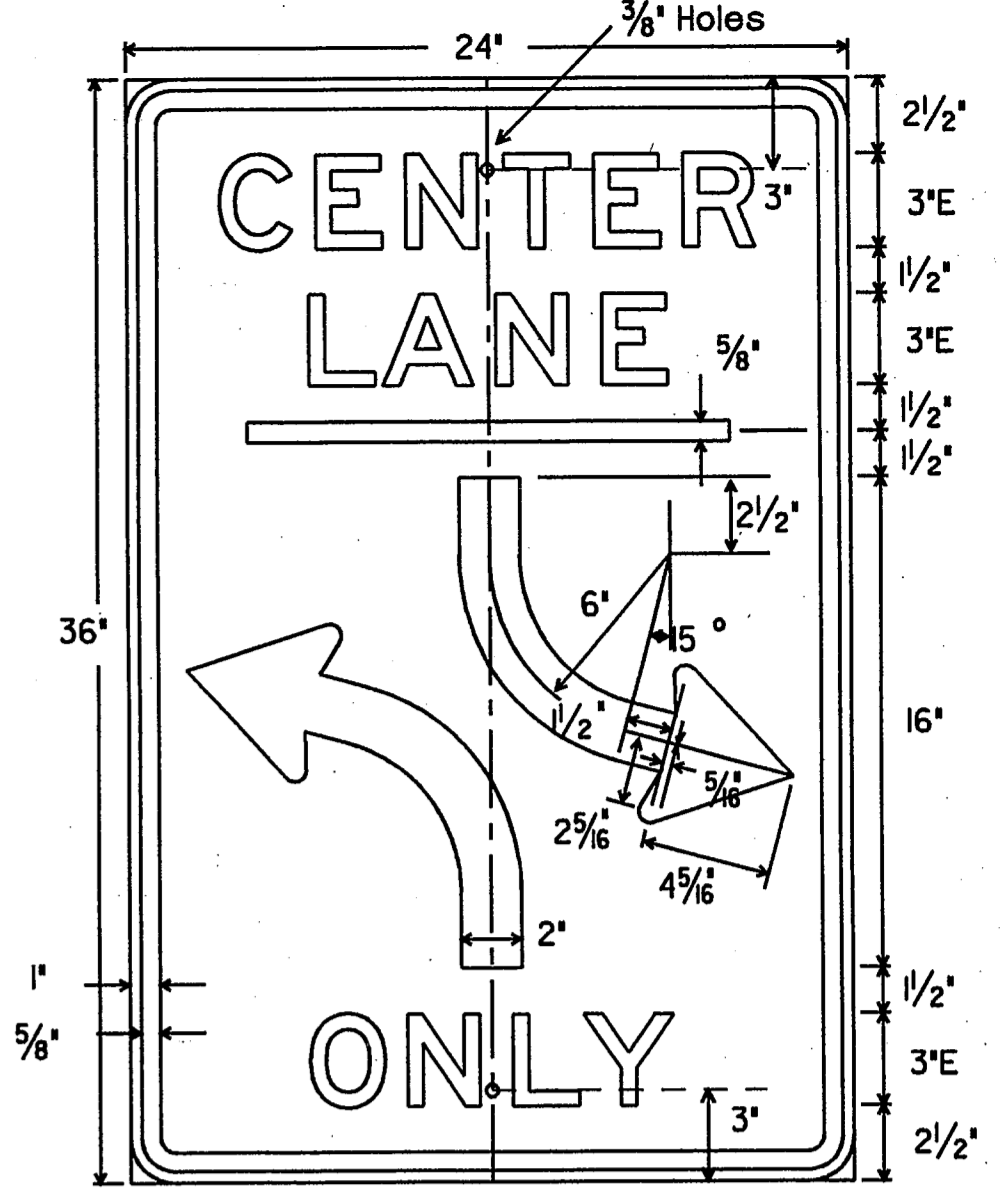



**R3-9b**  
24" X 36"  
Letters - Black  
Arrow - Black  
Border - Black  
Circle & Diagonal - Red Reflective  
Background - White Reflective

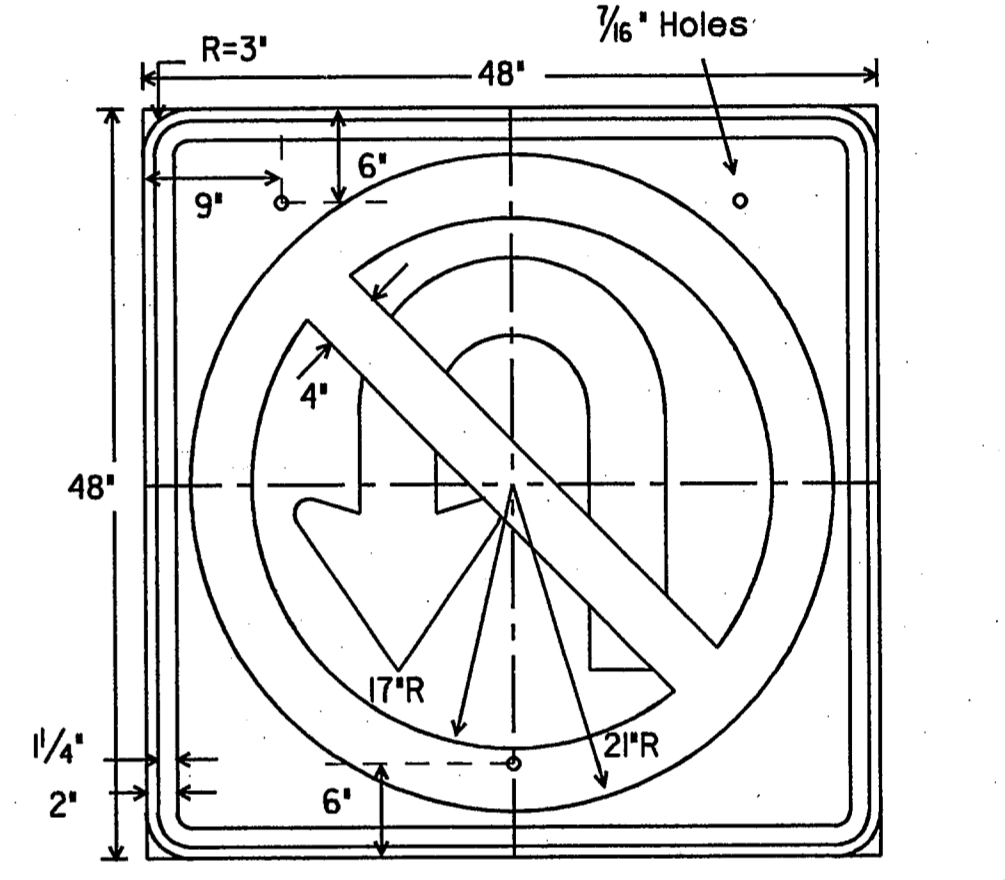


**SR3-4**  
48" X 48"  
Letters - Black  
Arrow - Black  
Border - Black  
Circle & Diagonal - Red Reflective  
Background - White Reflective

SPECIFICATION REFERENCE TABLE	
MATERIALS AND TESTS DIVISION SPECIFICATIONS	
ALUMINUM SIGN BLANKS	D-9-710 Δ
REFLECTIVE SHEETING,	
TYPE A (ENGINEER GRADE)	D-9-8300
TYPE C (HIGH SPECIFIC INTENSITY)	D-9-8300
VINYL NON-REFLECTIVE DECAL SHEETING	D-9-8320


**GENERAL NOTES:**  
The alphabets and lateral spacing between letters and numerals shall conform with the Texas 'Manual Uniform Traffic Control Devices for Streets and Highways', latest edition, and any approved changes thereto. Lateral spacing of text shall provide a balanced appearance. All materials shall conform to Department Specifications.  
Legend (except where noted), shall be applied by screening process of black and/or transparent colored ink, cut-out black vinyl/non-reflective decal sheeting and/or reflective sheeting or combination thereof. Background shall be white reflective sheeting (Type A). R14-2, ERI4-2, R14-3, ERI4-3, R3-1, R3-2 and SR3-4 signs shall use reflective sheeting (Type C).  
Sign blanks shall be one piece 0.080 inch thick sheet aluminum alloy Δ (Type A), unless otherwise noted elsewhere in the plans.

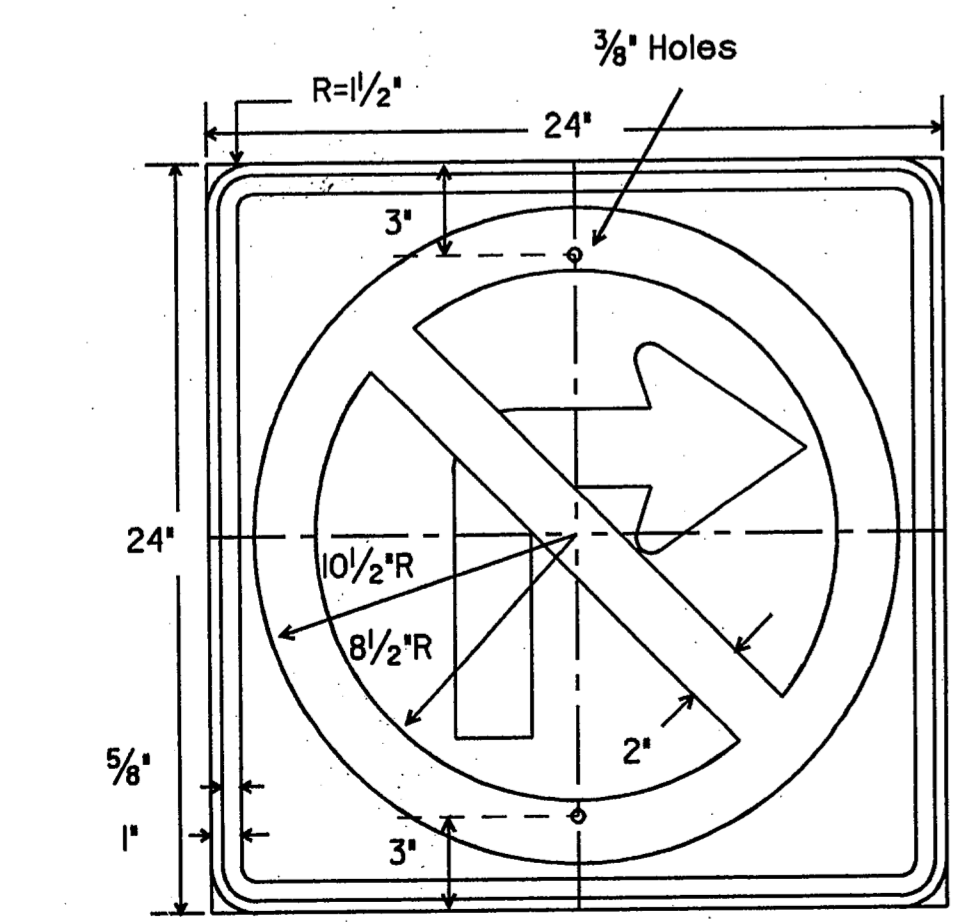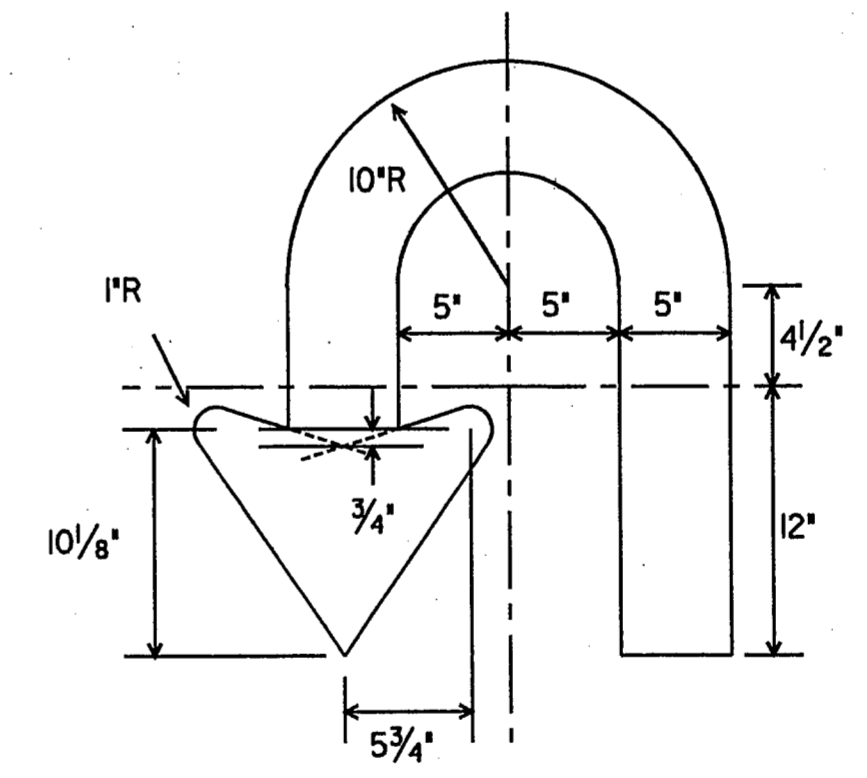

**R3-1**  
24" X 24"  
Letters - Black  
Arrow - Black  
Border - Black  
Circle & Diagonal - Red Reflective  
Background - White Reflective

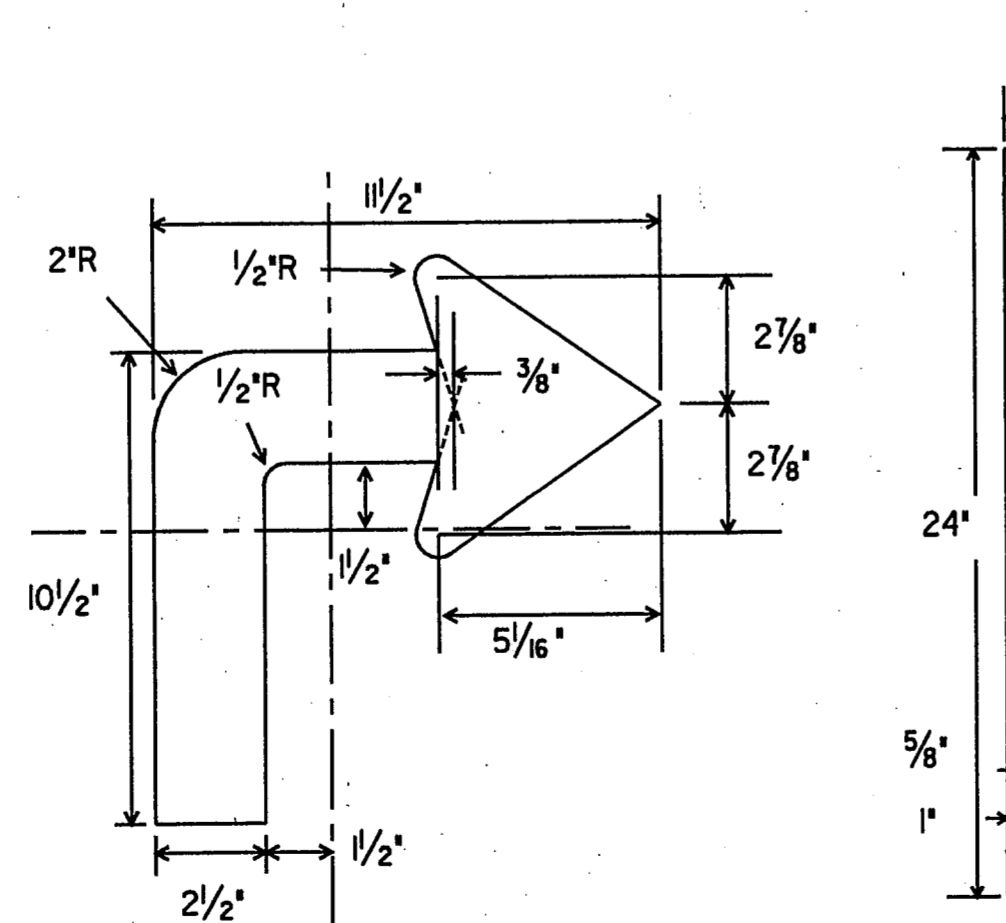


**R3-2**  
24" X 24"  
Letters - Black  
Arrow - Black  
Border - Black  
Circle & Diagonal - Red Reflective  
Background - White Reflective

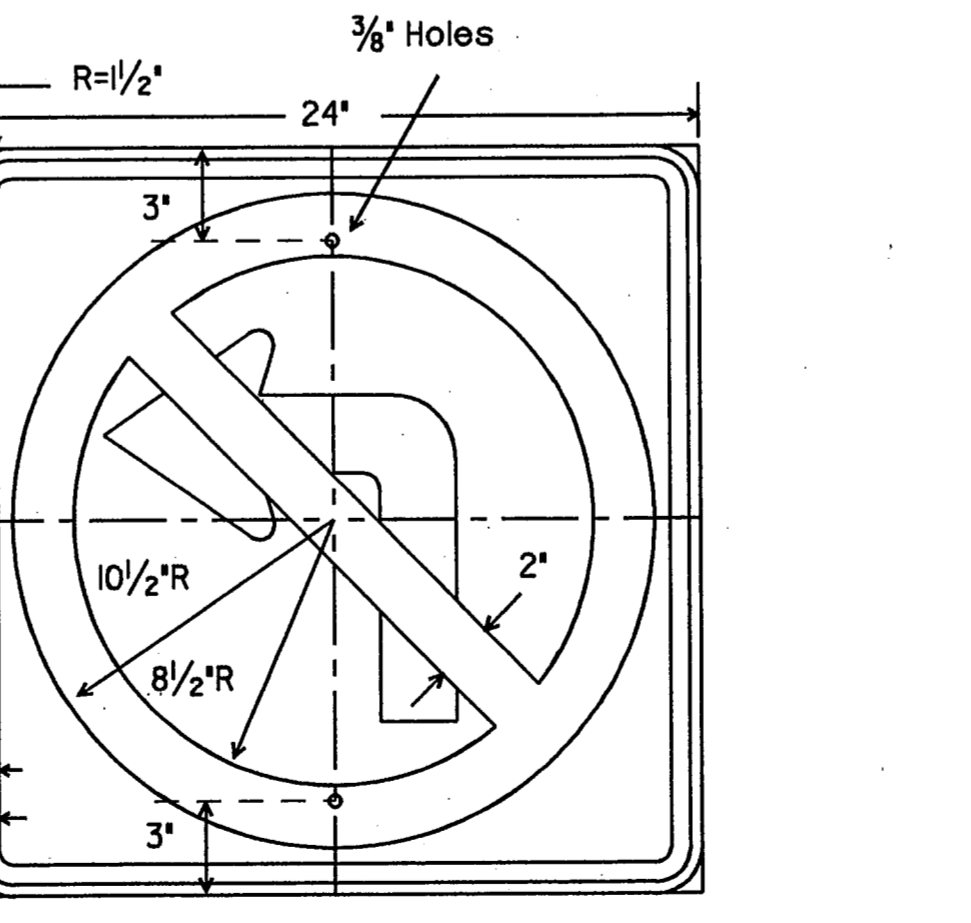

LEVELS DISPLAYED  
 1 2 3 4 5 6 7 8 9 10 11 12 13 14 15 16  
 DATE: \_\_\_\_\_  
 DWG: \_\_\_\_\_  
 CHK: \_\_\_\_\_  
 FILE: \_\_\_\_\_  
 ACC: ds8hplc/usr/d580504  
 11-26-96

**FINAL RECORD DRAWING**  
Date: 12/25/99  
ISSUE DATE: 11-26-96

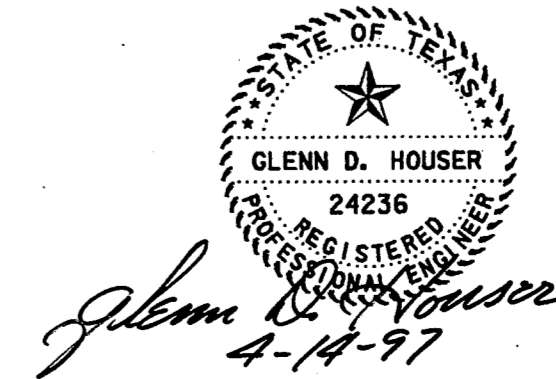

**STANDARD PLANS**  
TEXAS DEPARTMENT OF TRANSPORTATION  
Traffic Operations Division


## REGULATORY SIGNS

### R(3)-95 (MOD.)


ORG. DRAW. DATE: JULY 1990	DRG. NO.: L-R	CITY: _____	COUNTY: _____	STATE DISTRICT: _____	FEDERAL REGION: _____	FEDERAL RD PROJECT: _____	SHEET NO.: _____
8-95	11-96 Δ	6					<b>39</b>
							INCHWAY




LEVELS DISPLAYED	DATE:
1	1
2	2
3	3
40	40

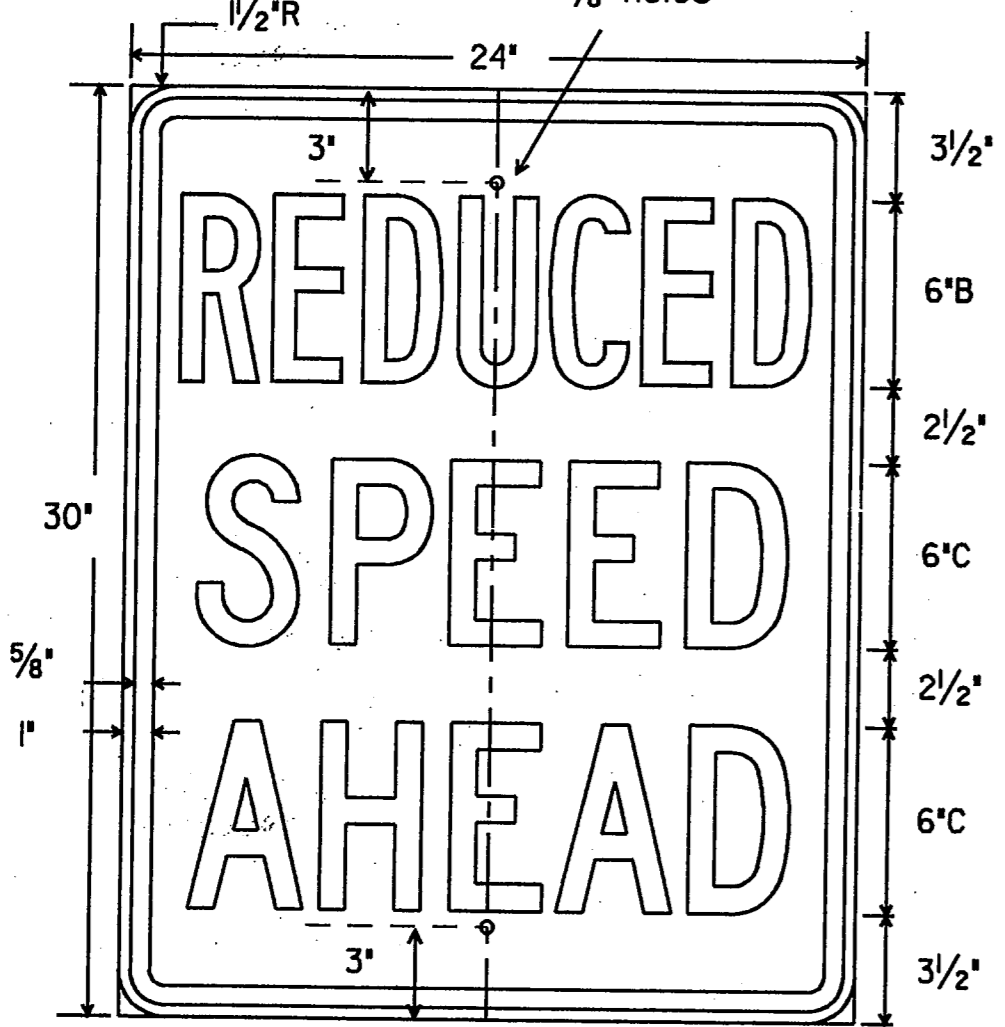

R2-5a Legend - Black Background - White Refl.  
24" X 30"

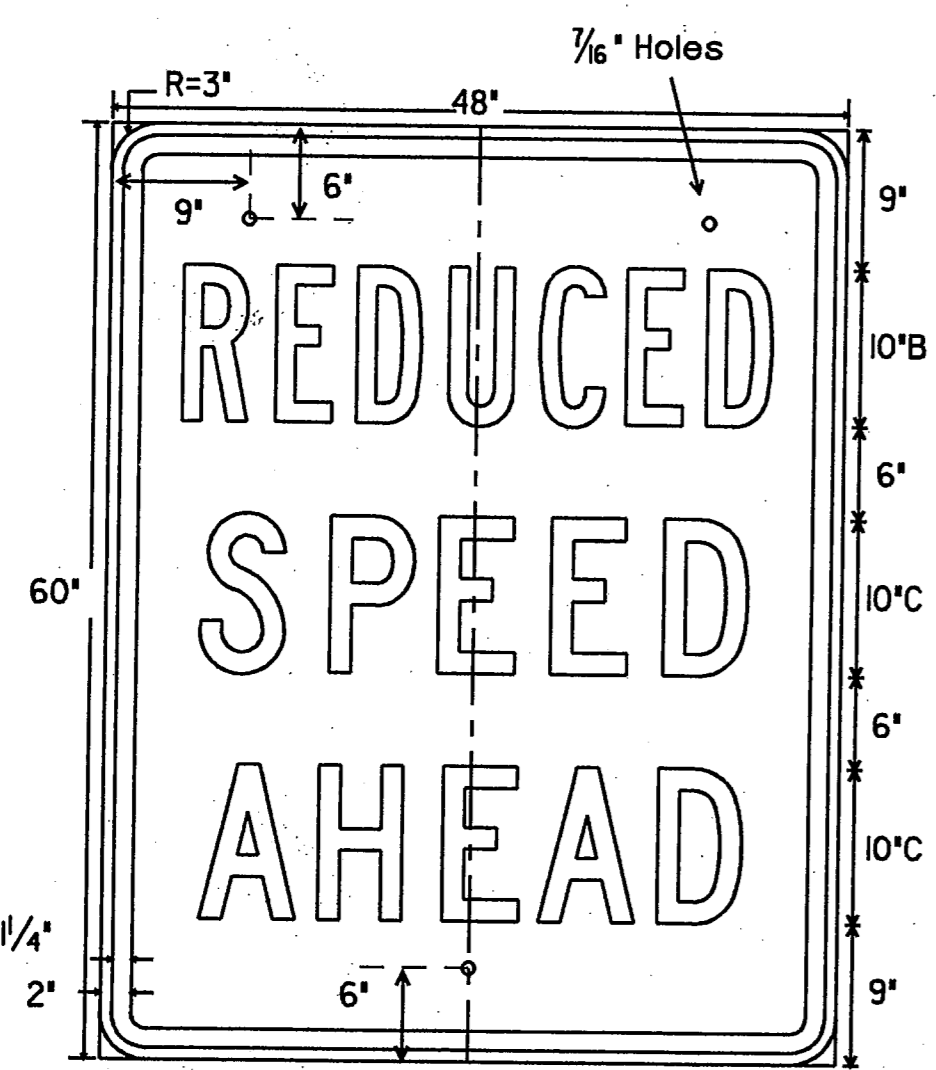


FR2-5a Legend - Black Background - White Refl.  
48" X 60"

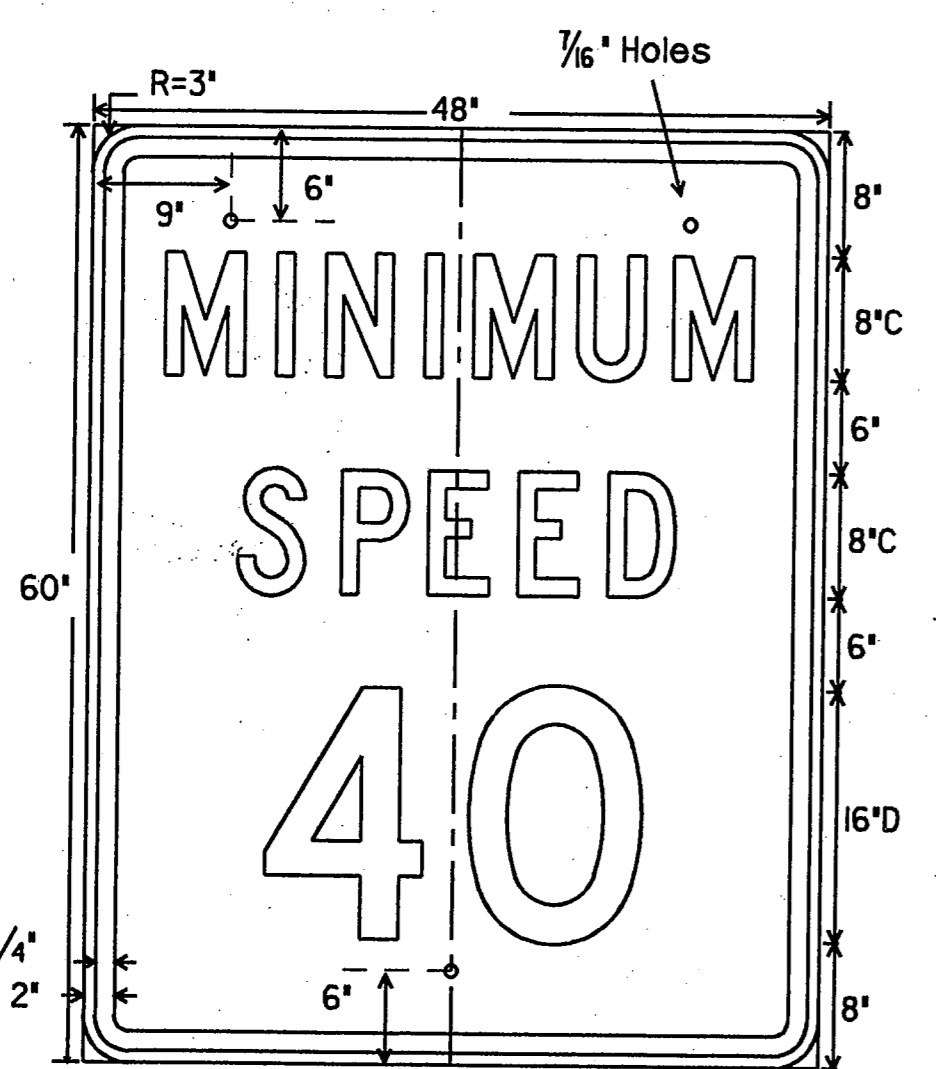


FR2-4 Legend - Black Background - White Refl.  
48" X 60"




R2-4T Legend - Black Background - White Refl.  
138" X 42"  
(For Non-Interstate Highways)

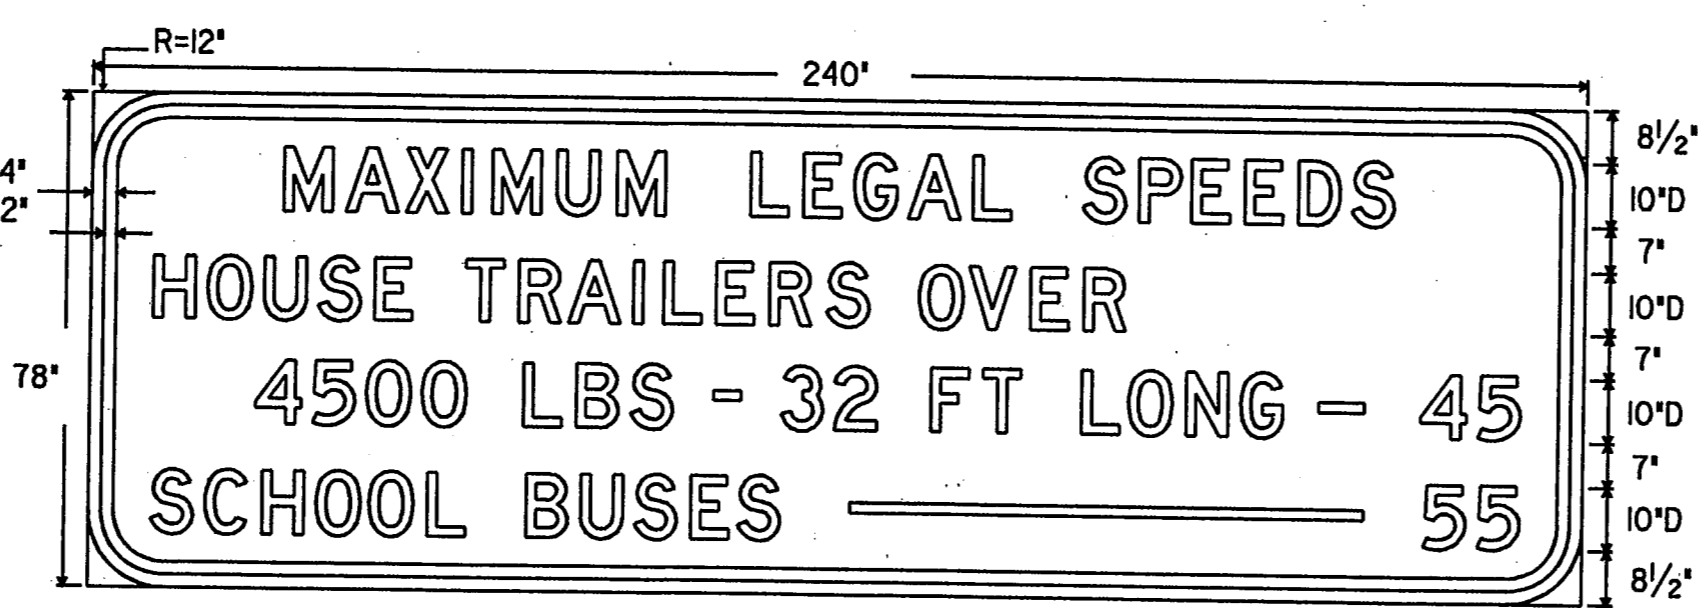


FR2-4T Legend - Black Background - White Refl.  
240" X 78"  
(For Interstate Highways Only)

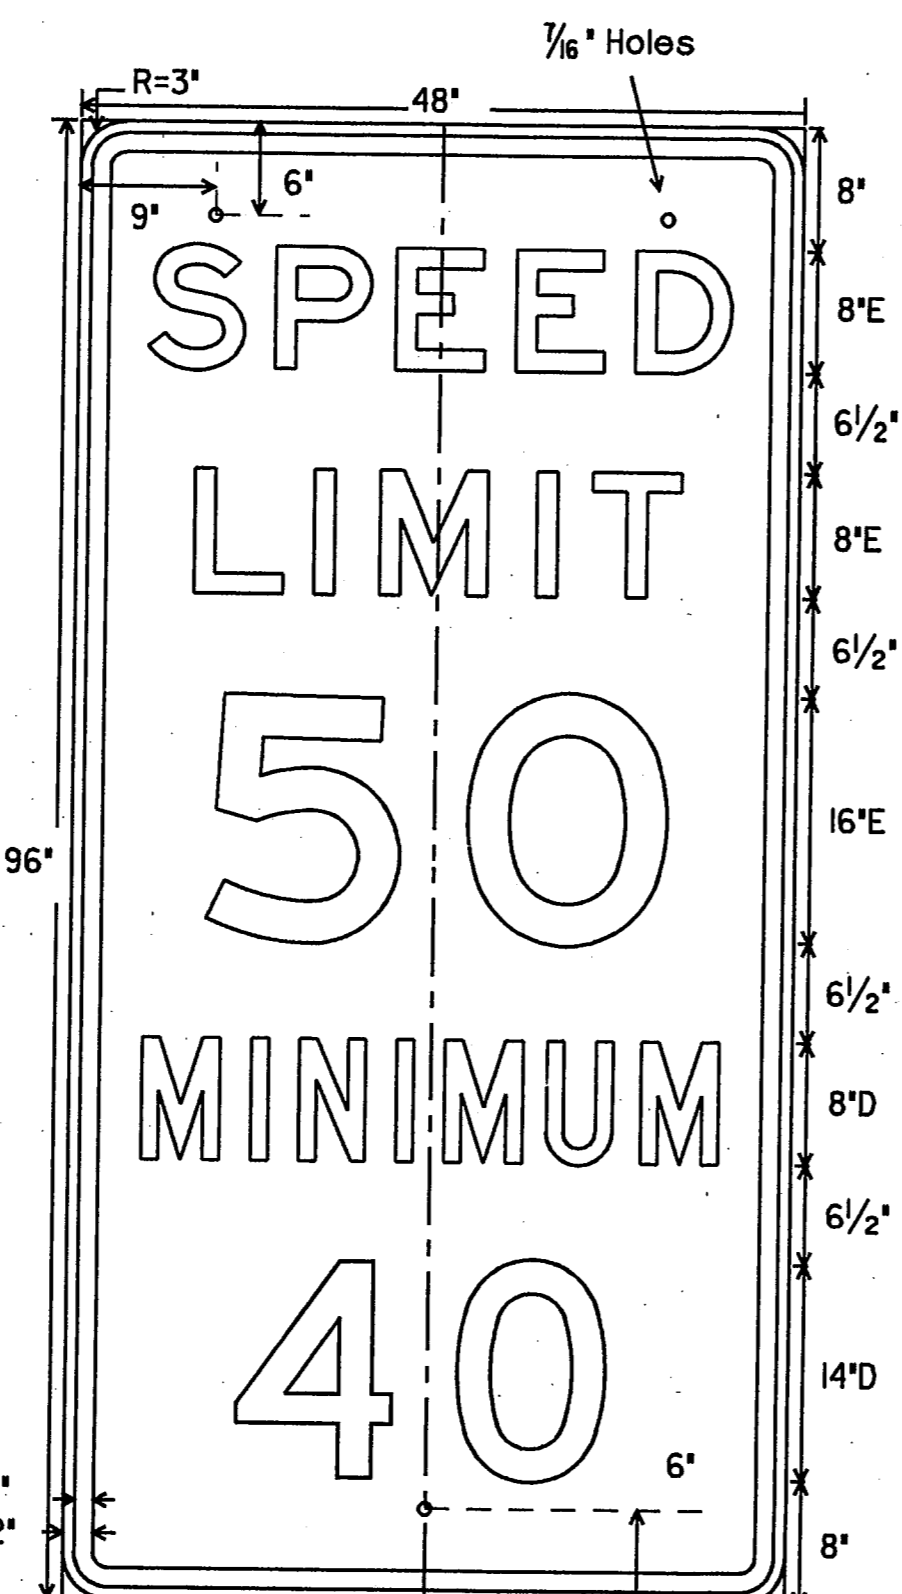


FR2-4a Legend - Black Background - White Refl.  
48" X 96"

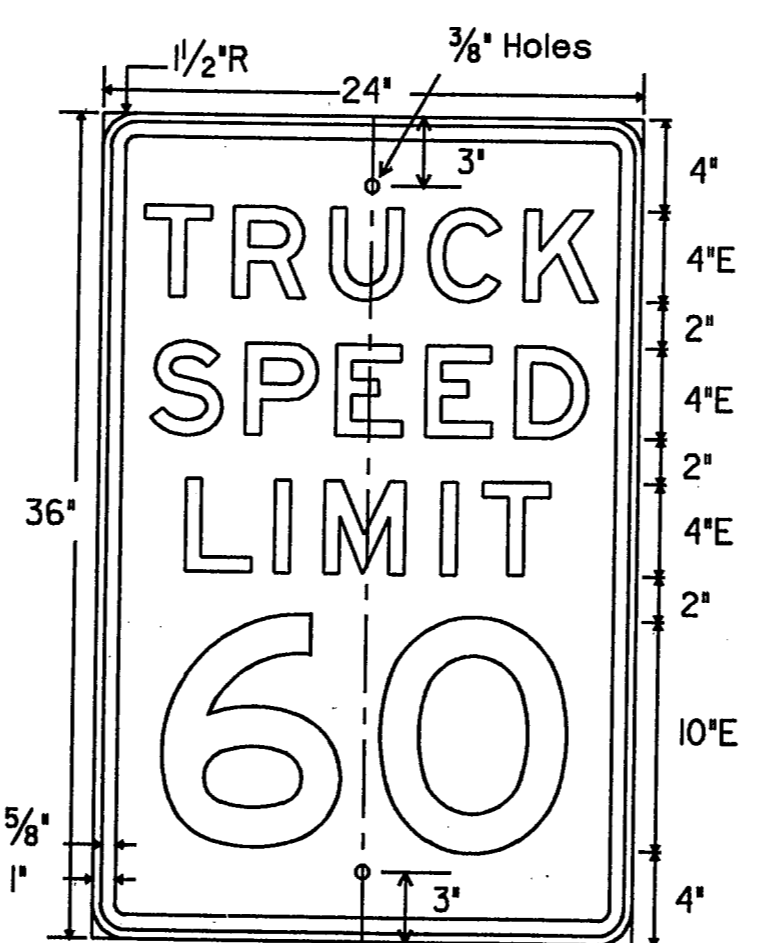


R2-2a Legend - Black Background - White Refl.  
24" X 36"

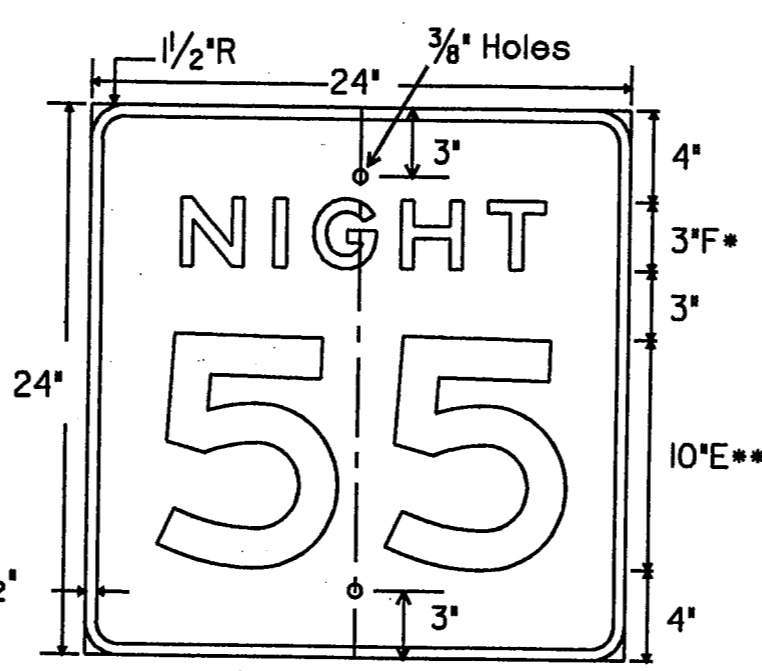


R2-3 Legend - White Refl. Background - Black  
24" X 24"

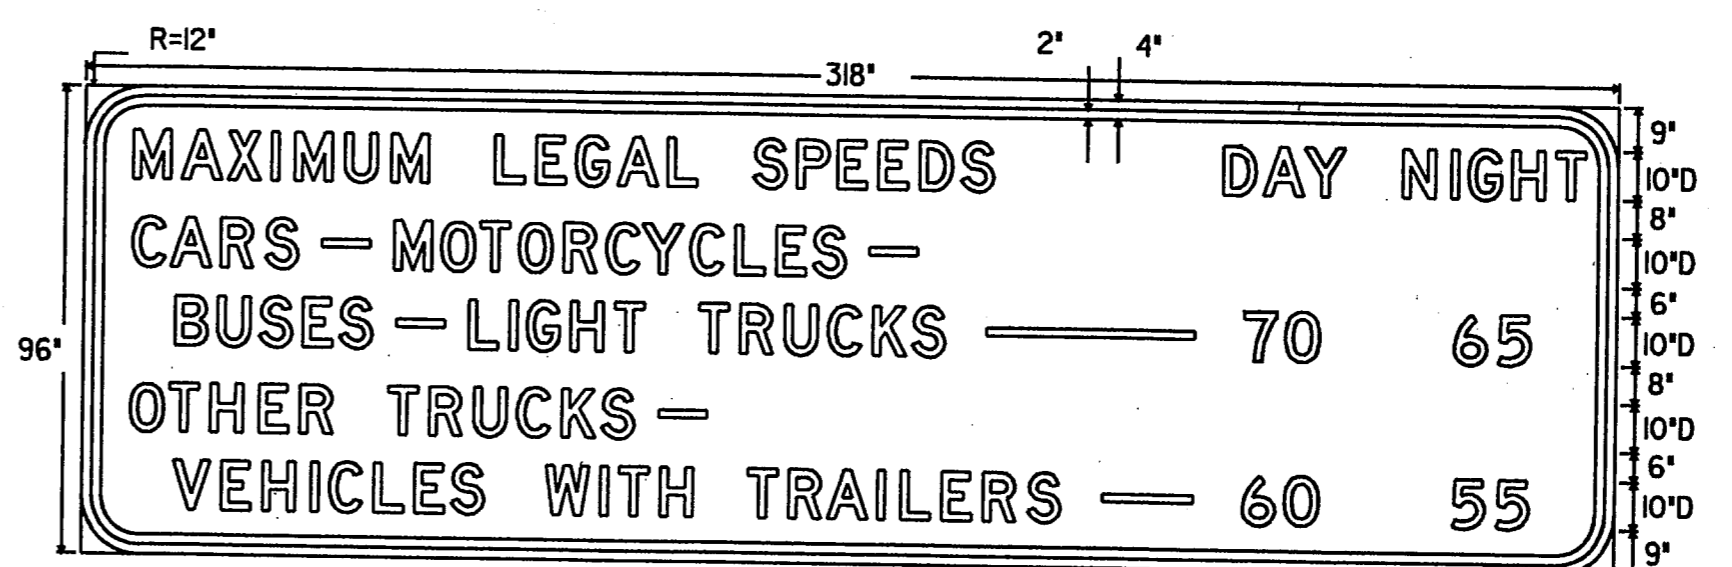

FR2-4Ta Legend - Black Background - White Refl.  
318" X 96"

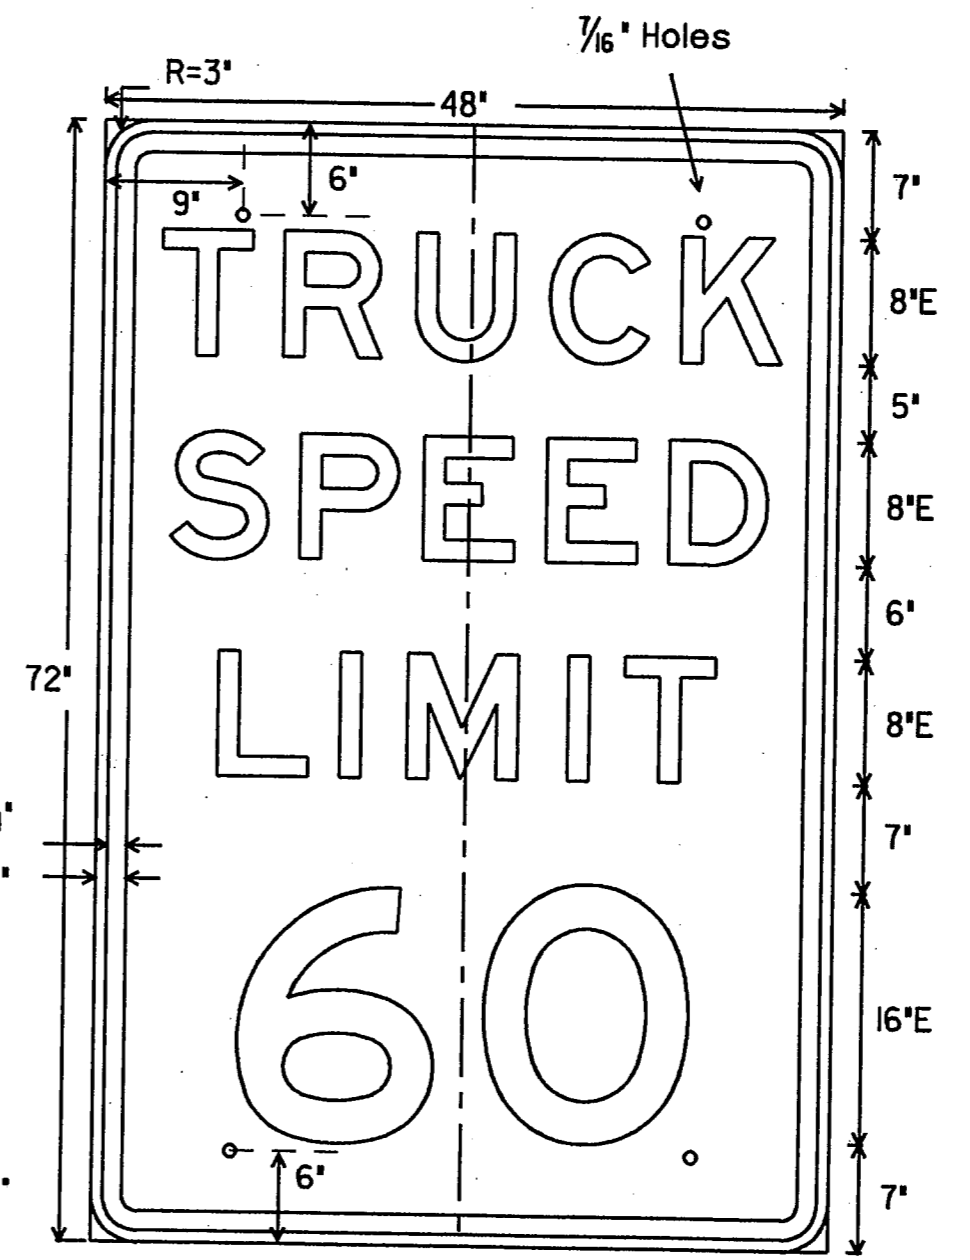


FR2-2a Legend - Black Background - White Refl.  
48" X 72"

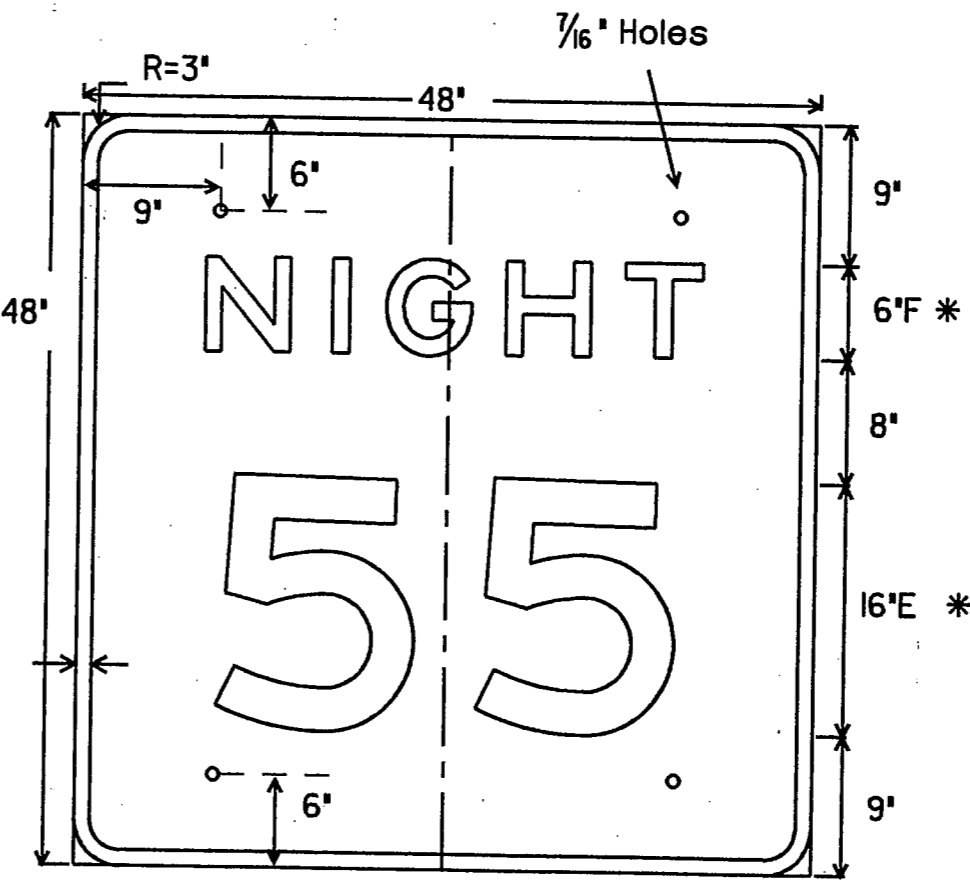


FR2-3 Legend - White Refl. Background - Black  
48" X 48"

\*\* optically space numerals about vertical centerline \* increase spacing 50%

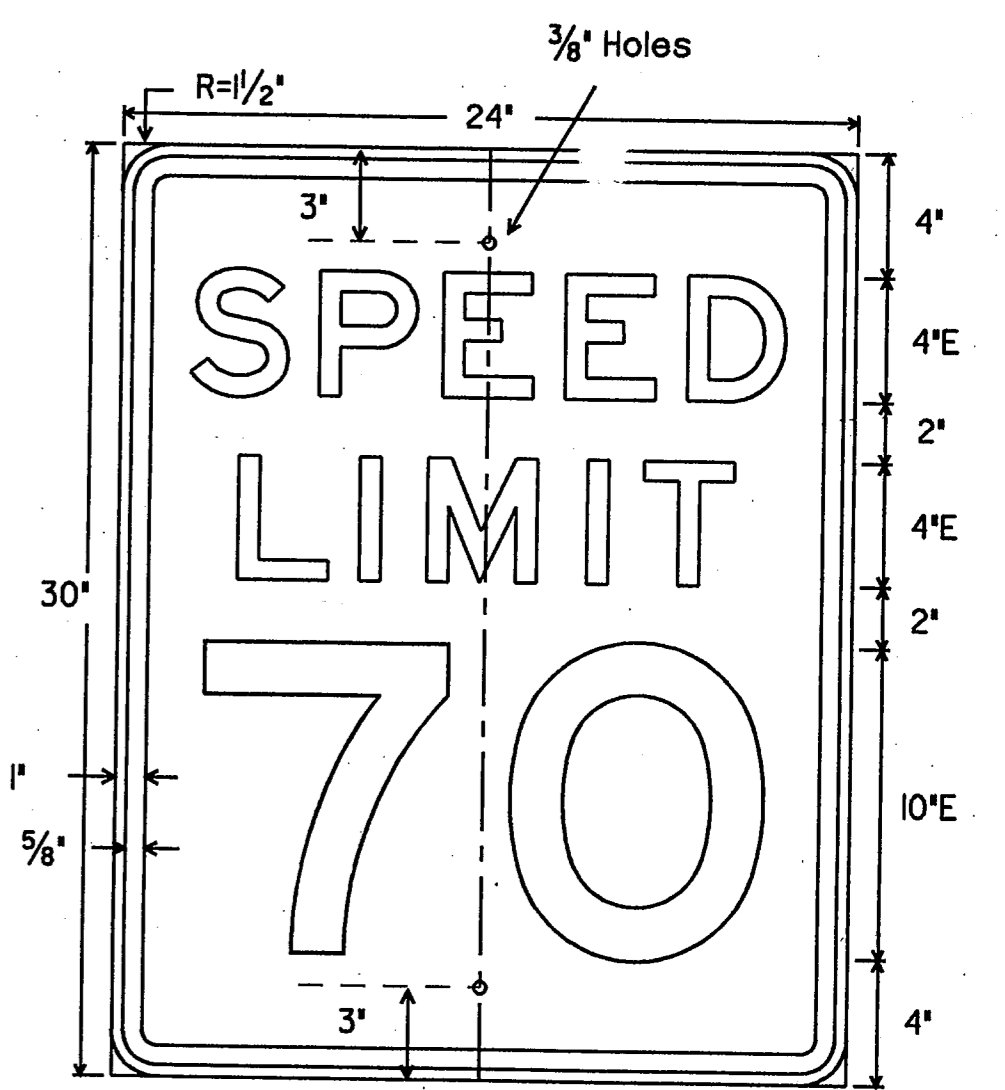

R2-1 Legend - Black Background - White Refl.  
24" X 30"

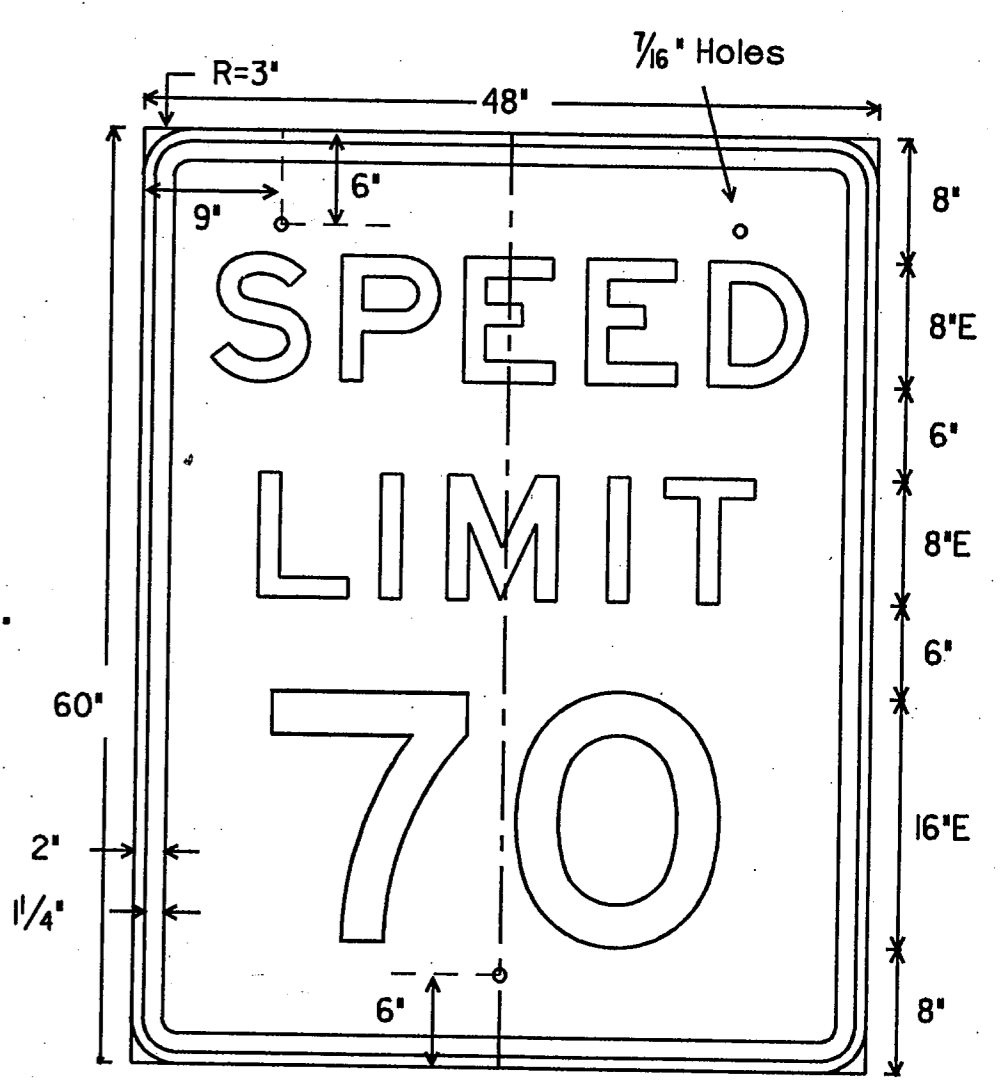

FR2-1 Legend - Black Background - White Refl.  
48" X 60"

SPECIFICATION REFERENCE TABLE	
MATERIALS AND TESTS DIVISION SPECIFICATION	
ALUMINUM SIGN BLANKS	D-9-710 Δ
REFLECTIVE SHEETING, TYPE A (ENGINEER GRADE)	D-9-8300
VINYL NON-REFLECTIVE DECAL SHEETING	D-9-8320

GENERAL NOTES:

The alphabets and lateral spacing between letters and numerals shall conform with the Texas "Manual on Uniform Traffic Control Devices for Streets and Highways", latest edition, and any approved changes thereto. Lateral spacing of text shall provide a balanced appearance. All materials shall conform to Department Specifications.  
Legend (except where noted), shall be black and applied by screening process, cut-out vinyl non-reflective decal sheeting or combination thereof. Legend on FR2-3 shall be applied by reverse screening process, cut-out black vinyl non-reflective decal sheeting and/or cut-out white reflective sheeting or combination thereof. Background shall be reflective sheeting (Type A).  
Sign blanks shall be one piece 0.080 inch thick sheet aluminum alloy (Type A), Δ unless otherwise noted elsewhere in the plans.

FINAL RECORD DRAWING  
Date: 12/25/99  
ISSUE DATE: 11-26-96




STANDARD PLANS  
TEXAS DEPARTMENT OF TRANSPORTATION  
Traffic Operations Division


REGULATORY SIGNS

R(4)-95A (MOD.)


ORG DRAW DATE: August 1995	DN: L/R	CR:	DN: DN	CR:	REG NO:
12-95					
11-96 Δ					
COUNTY					SHEET
CONTROL SECTION					40
JOB					
HIGHWAY					

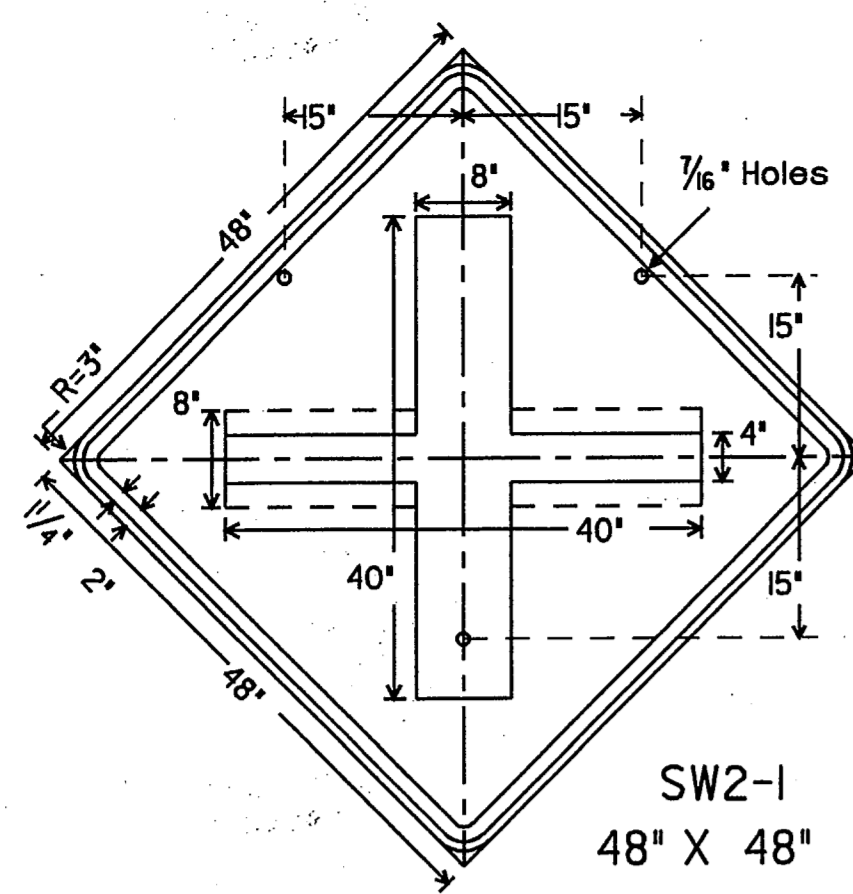


SW2-1  
48" X 48"

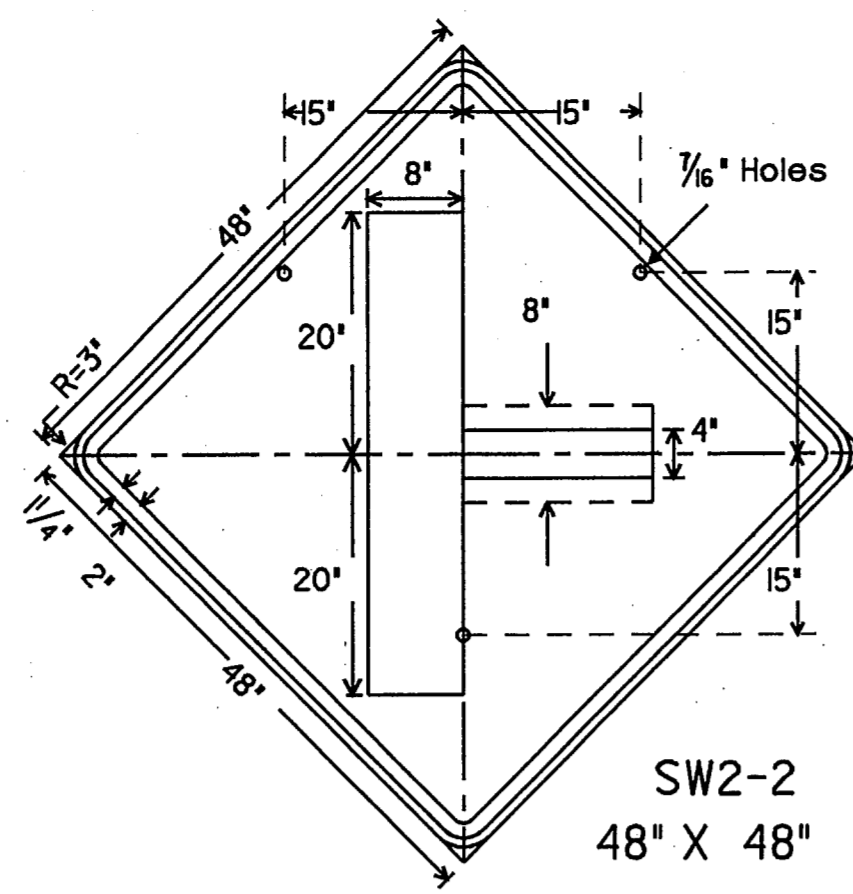


SW2-2  
48" X 48"

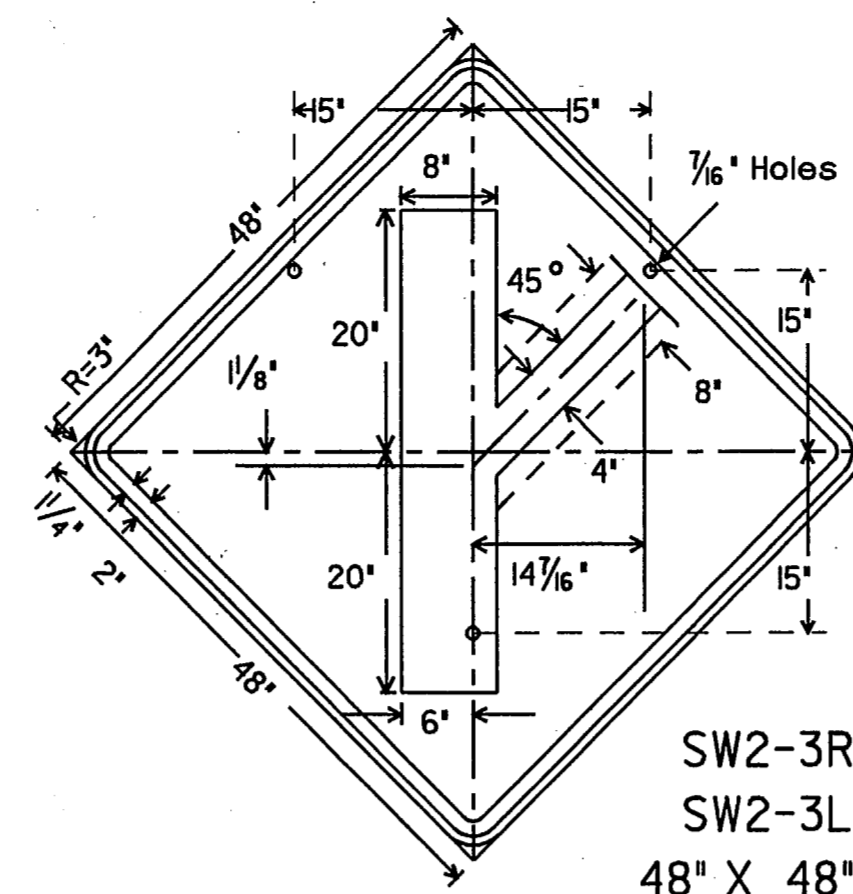


SW2-3R  
SW2-3L  
48" X 48"

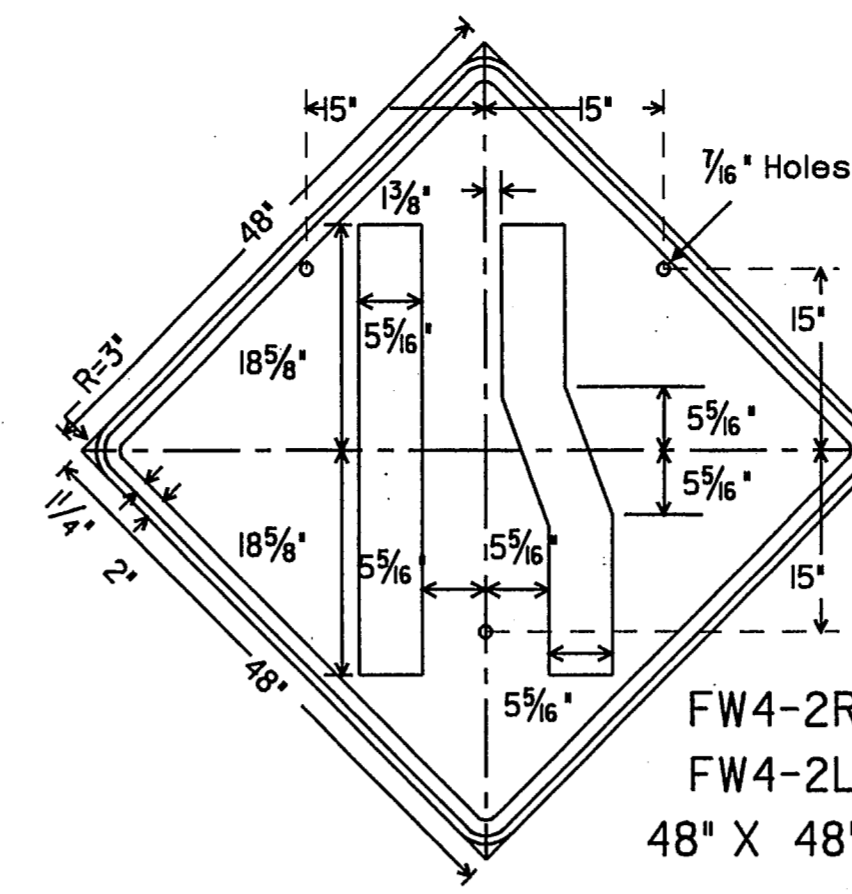


FW4-2R  
FW4-2L  
48" X 48"

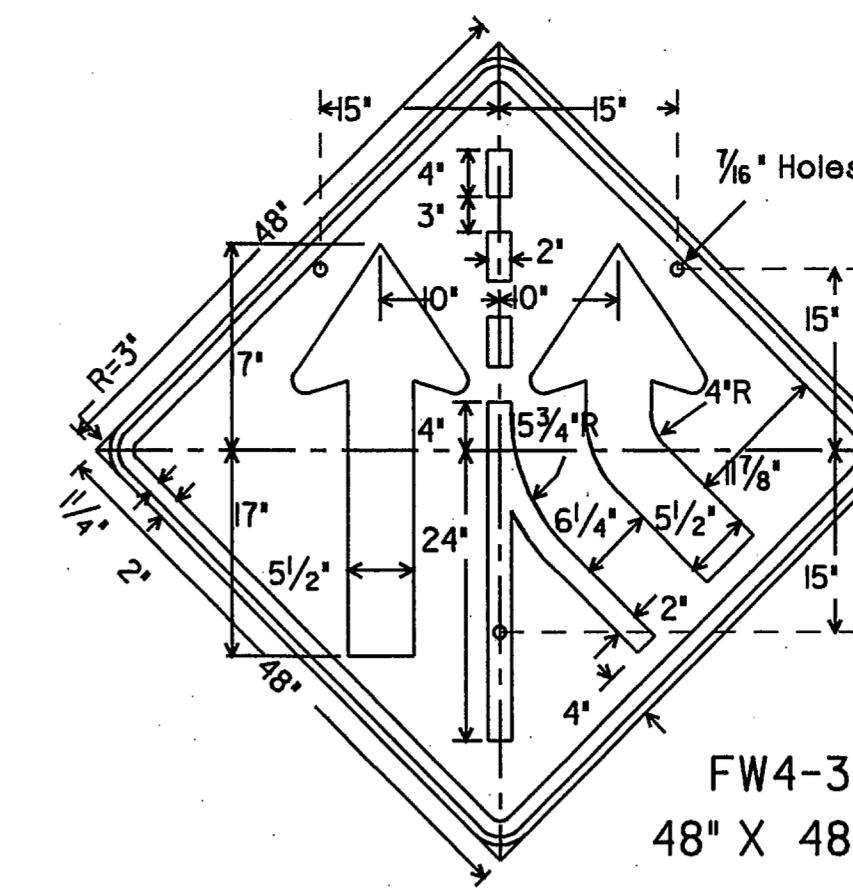


FW4-3  
48" X 48"

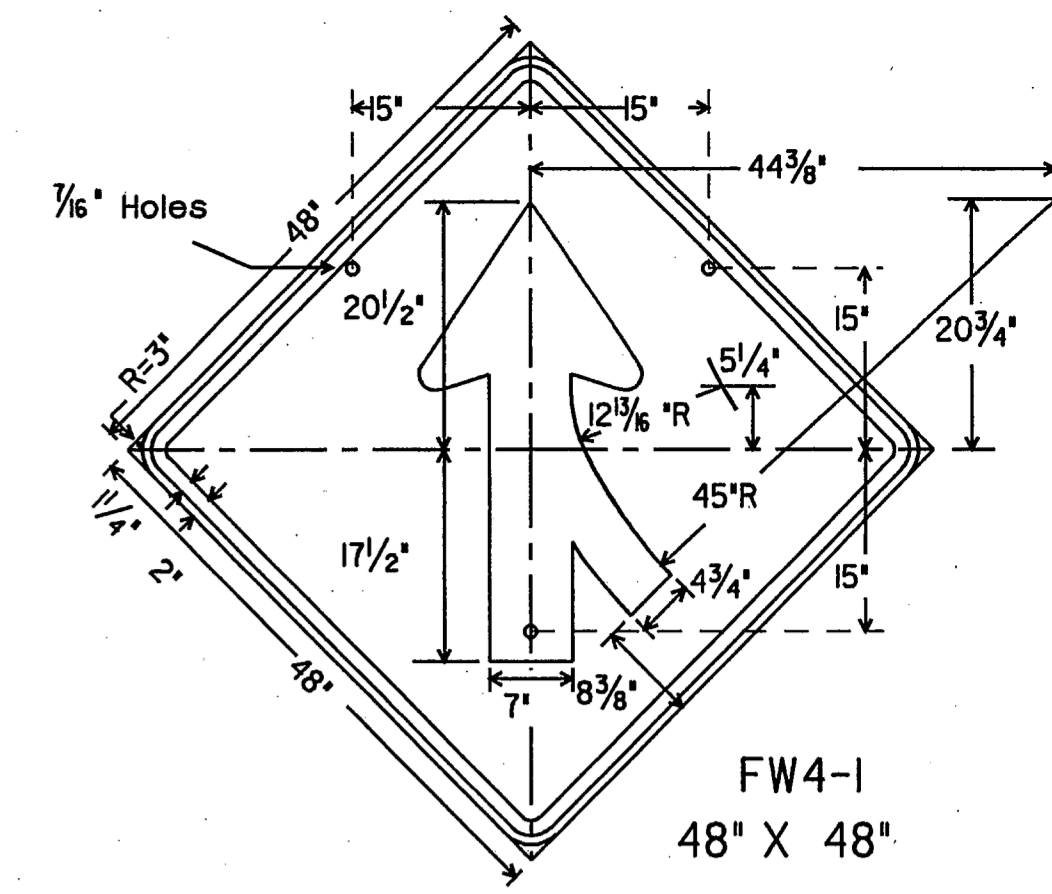


FW4-1  
48" X 48"

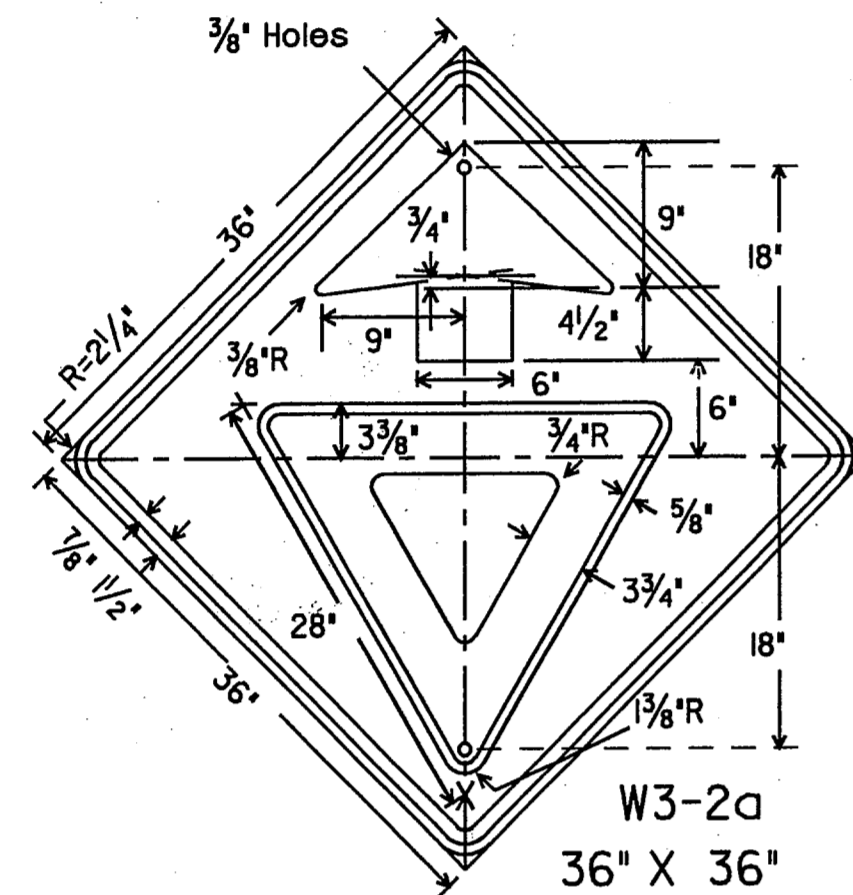


W3-2a  
36" X 36"

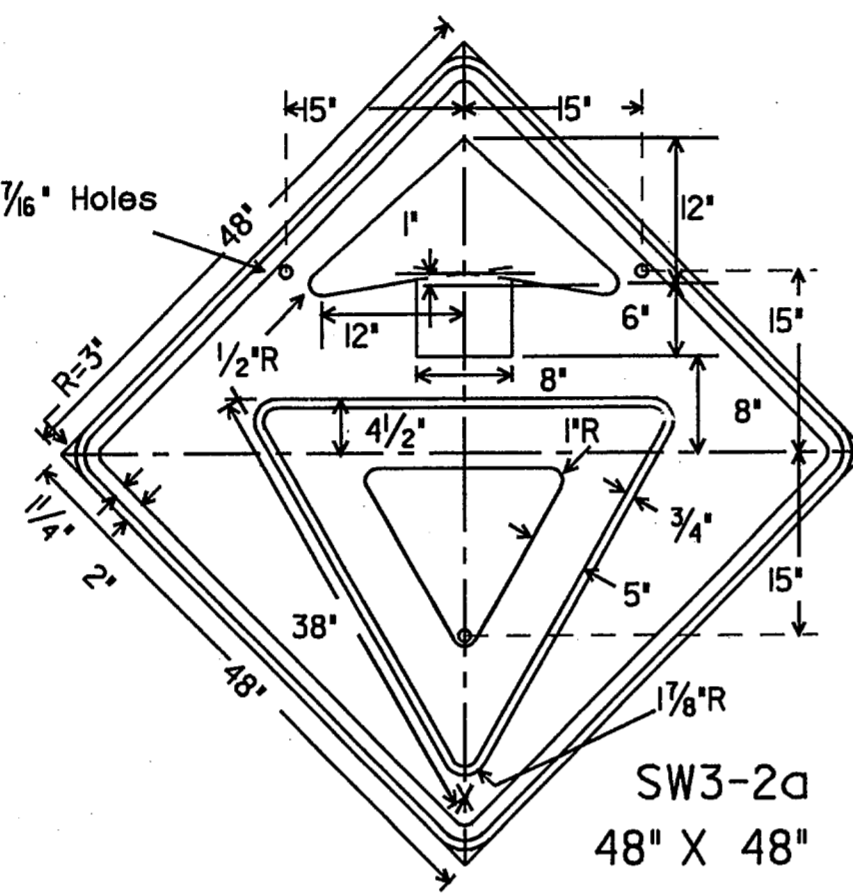


SW3-2a  
48" X 48"

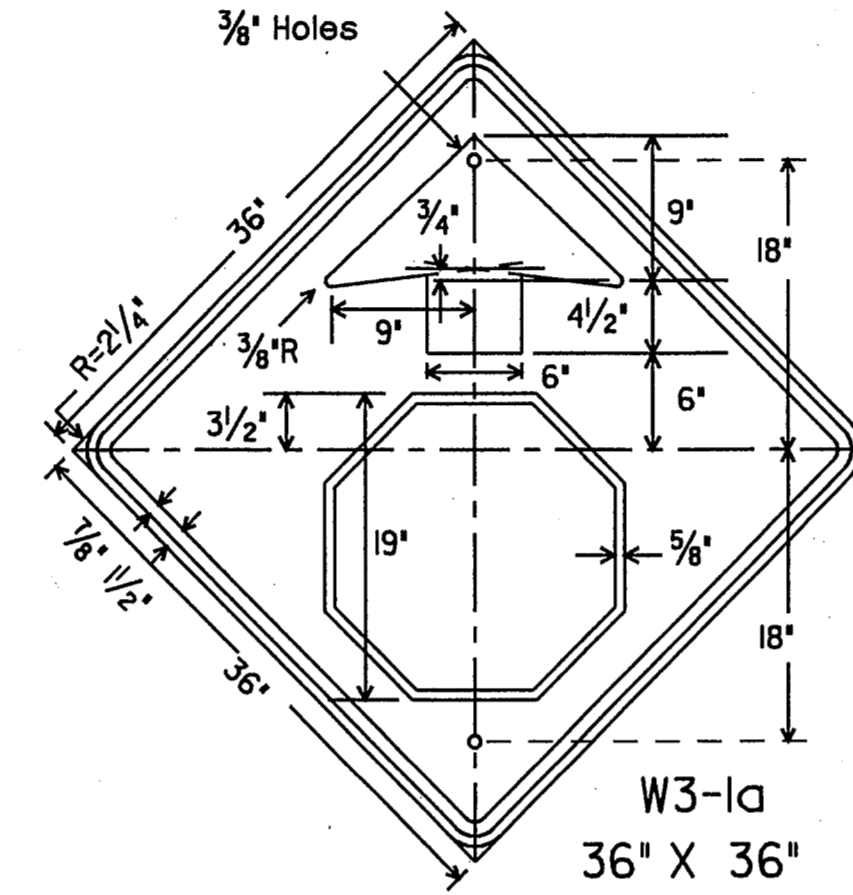


W3-1a  
36" X 36"

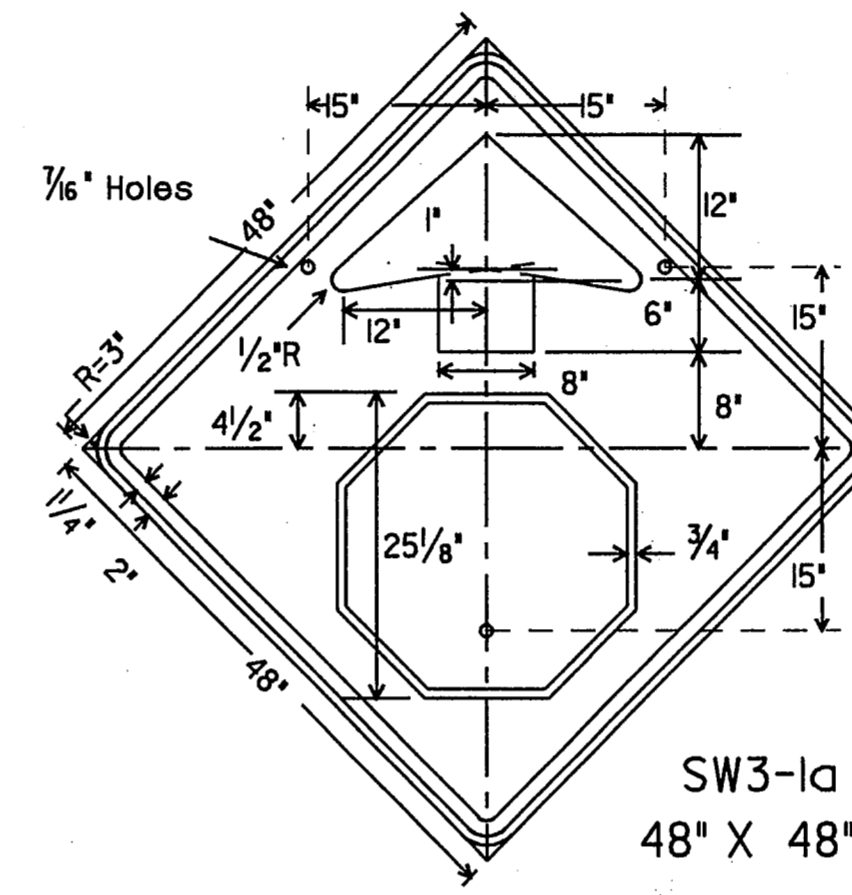

SW3-1a  
48" X 48"

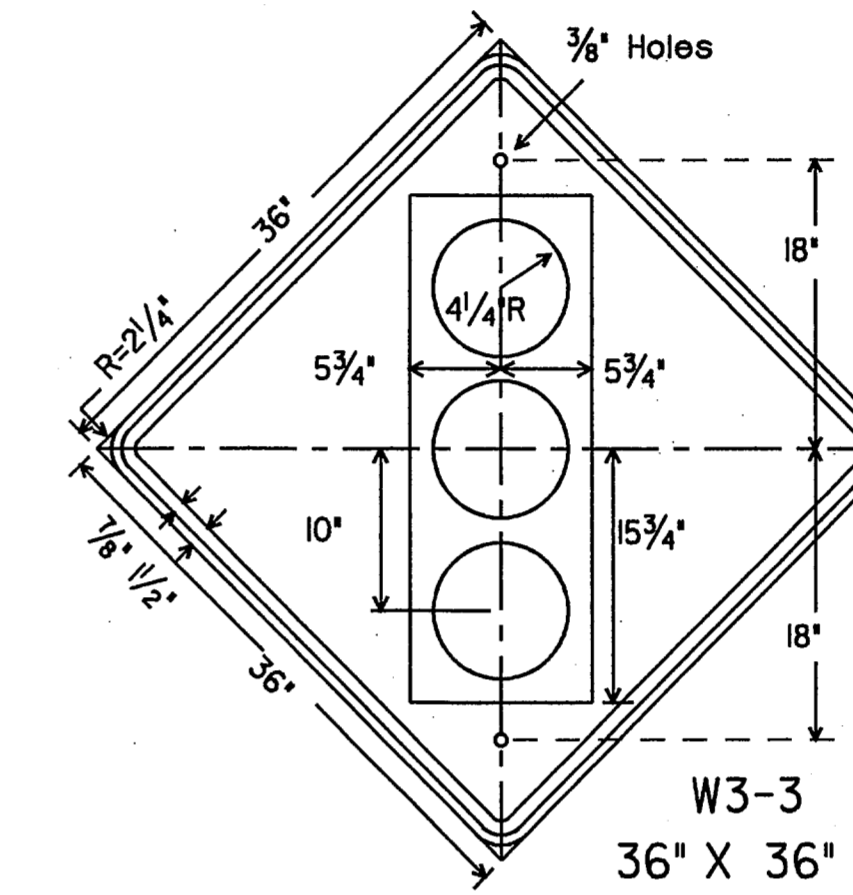


W3-3  
36" X 36"

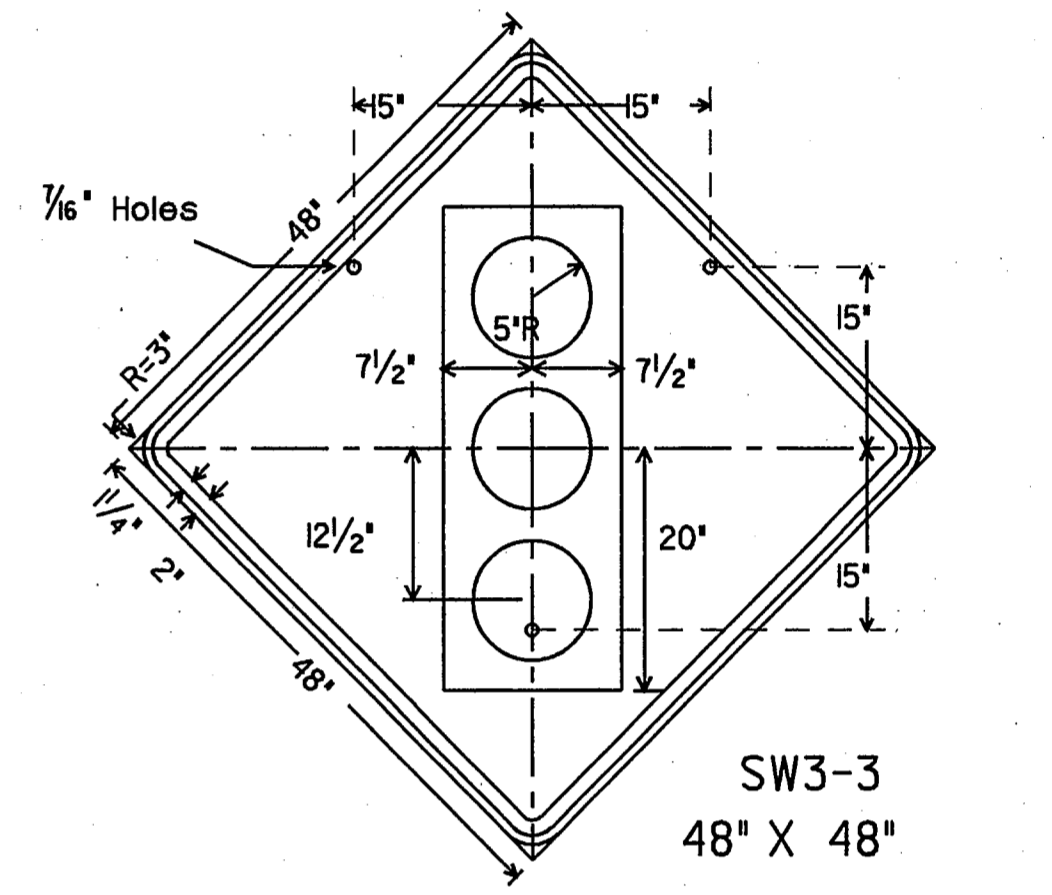


SW3-3  
48" X 48"

Border and Arrow - Black  
Symbol - Red Border Band on  
White Background (Refl)  
Background - Yellow Reflective

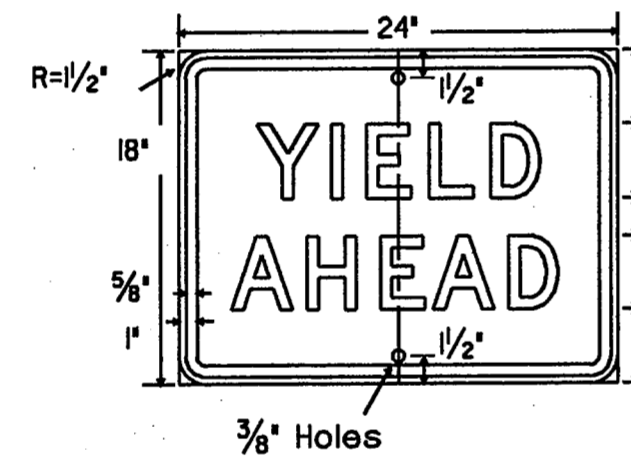

Border and Arrow - Black  
Symbol - Red Border Band on  
White Background (Refl)  
Background - Yellow Reflective


Border and Arrow - Black  
Symbol - White Border on  
Red Background (Refl)  
Background - Yellow Reflective

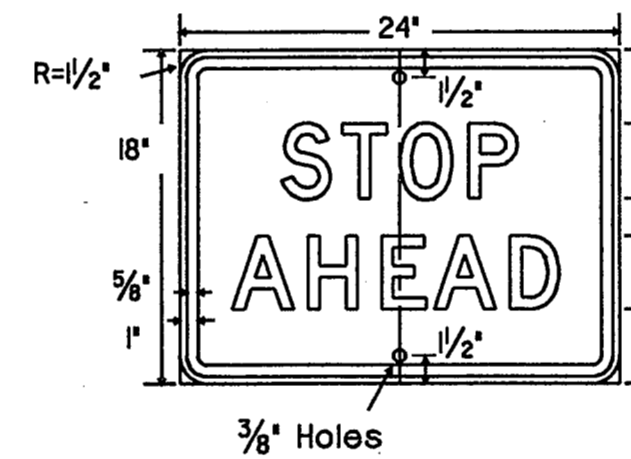


Border and Arrow - Black  
Symbol - White Border on  
Red Background (Refl)  
Background - Yellow Reflective

Symbol and Border - Black  
Top Circle - Red Reflective  
Bottom Circle - Green Reflective  
Background - Yellow Reflective


Symbol and Border - Black  
Top Circle - Red Reflective  
Bottom Circle - Green Reflective  
Background - Yellow Reflective

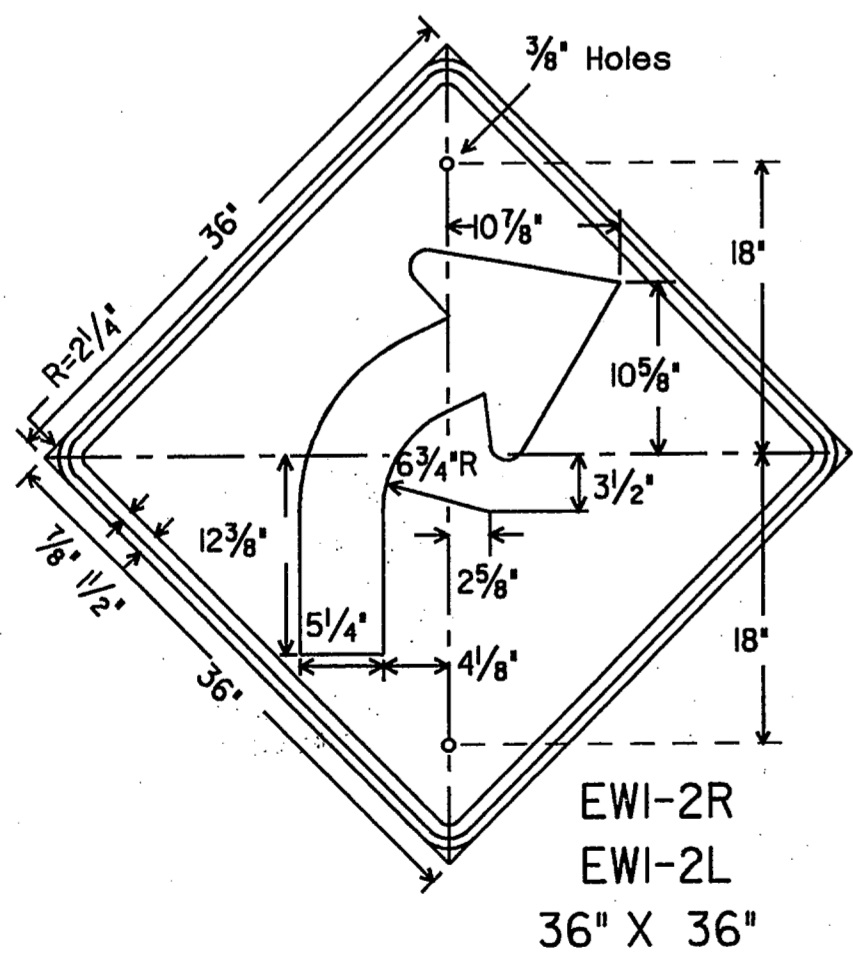


EWI-2R  
EWI-2L  
36" X 36"

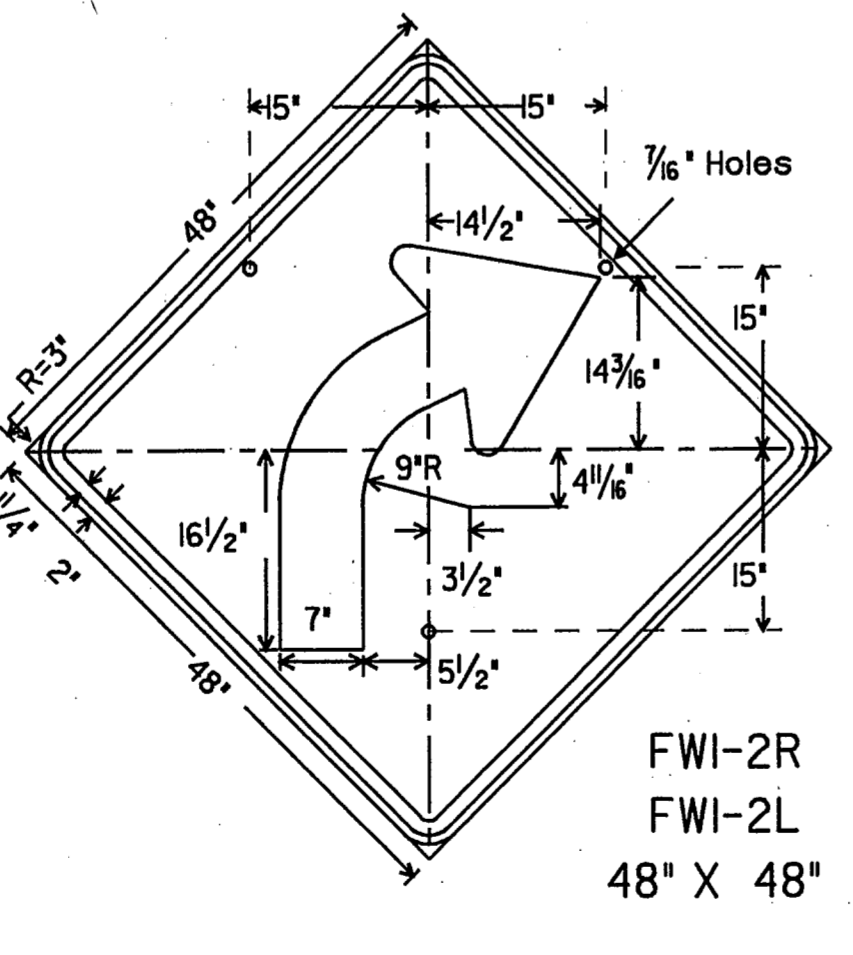

FWI-2R  
FWI-2L  
48" X 48"

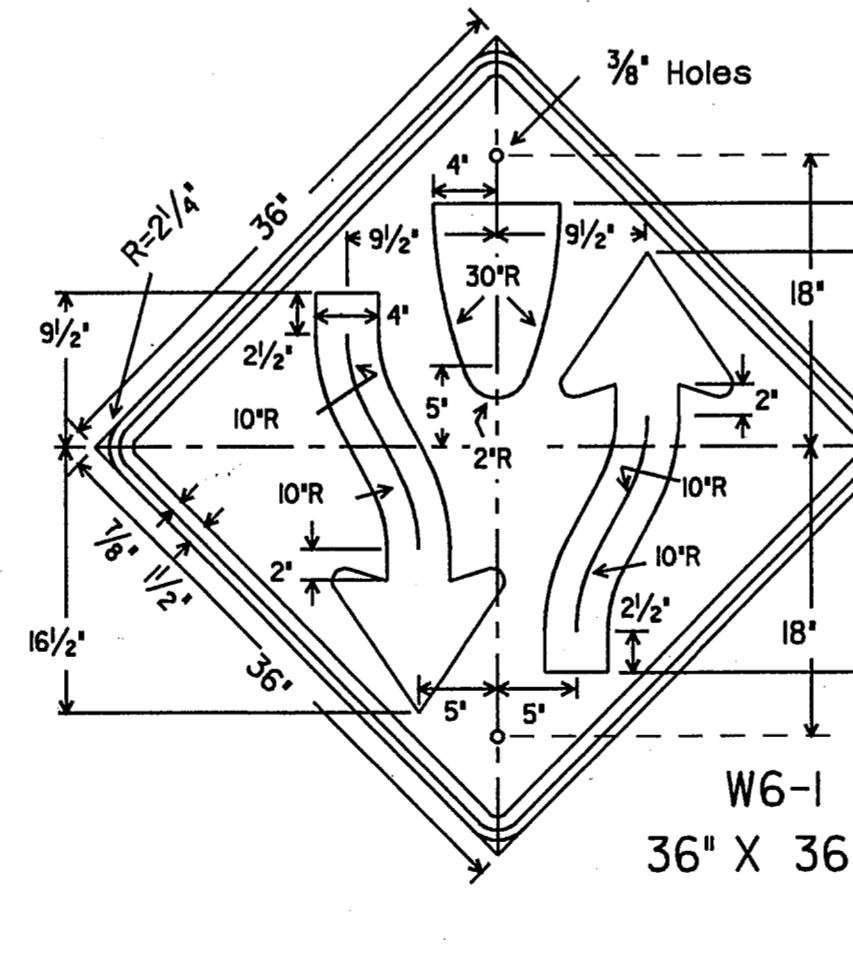

W6-1  
36" X 36"

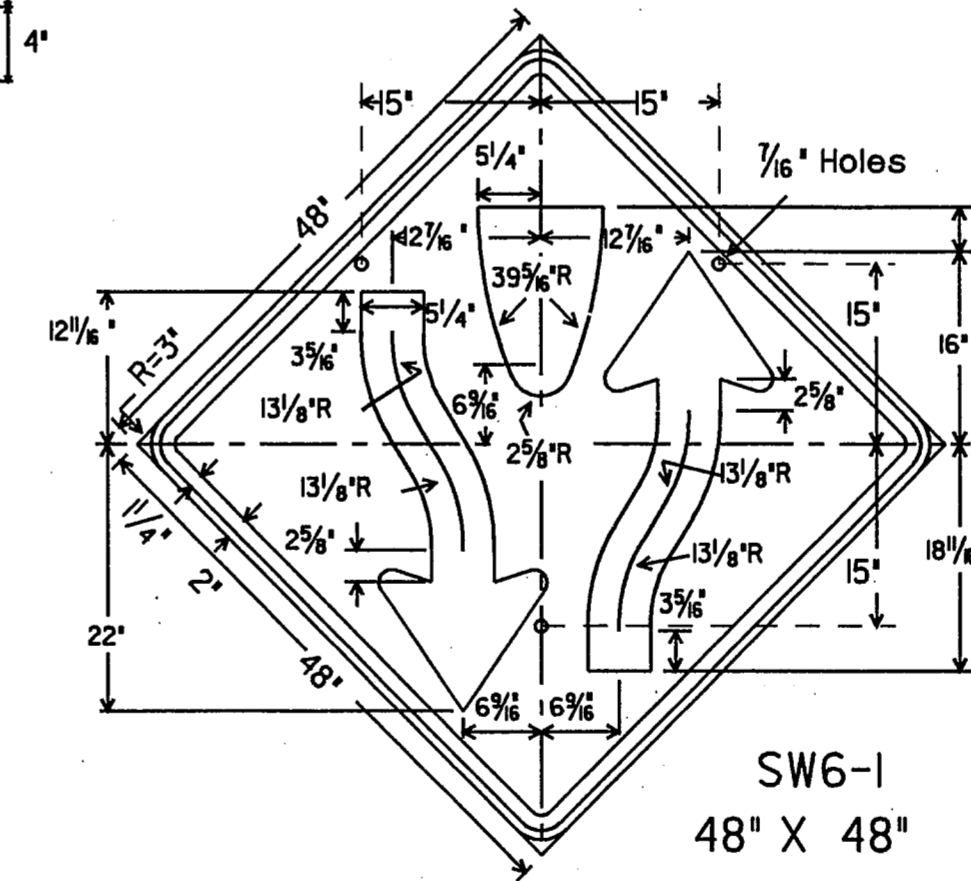

SW6-1  
48" X 48"


SPECIFICATION REFERENCE TABLE	
MATERIALS AND TESTS DIVISION SPECIFICATIONS	D-9-7110 Δ
ALUMINUM SIGN BLANKS	D-9-8300
REFLECTIVE SHEETING, TYPE C (HIGH SPECIFIC INTENSITY)	D-9-8320
VINYL NON-REFLECTIVE DECAL SHEETING	

GENERAL NOTES:

The alphabets and lateral spacing between letters and numerals shall conform with the Texas Manual Uniform Traffic Control Devices for Streets and Highways, latest edition, and any approved changes thereto. Lateral spacing of text shall provide a balanced appearance. All materials shall conform to Department Specifications. Legend (except where noted), shall be applied by screening process of black and/or transparent colored ink, cut-out black vinyl non-reflective decal sheeting and/or reflective sheeting or combination thereof. Background shall be yellow reflective sheeting (Type C). Sign blanks shall be one piece 0.080 inch thick sheet aluminum alloy (Type A), unless Δ otherwise noted elsewhere in the plans.


DINLR	DATE:
CK: CW	1 2 3 4 5 6
DW: DN	7 8 9 10 11 12 13 14 15 16
CK: MT	17 18 19 20 21 22 23 24 25 26 27 28 29 30 31 32 33 34 35 36 37 38 39 40 41 42 43 44 45 46 47 48 49 50 51 52 53 54 55 56 57 58 59 60 61 62 63

ARROWHEAD DETAILS

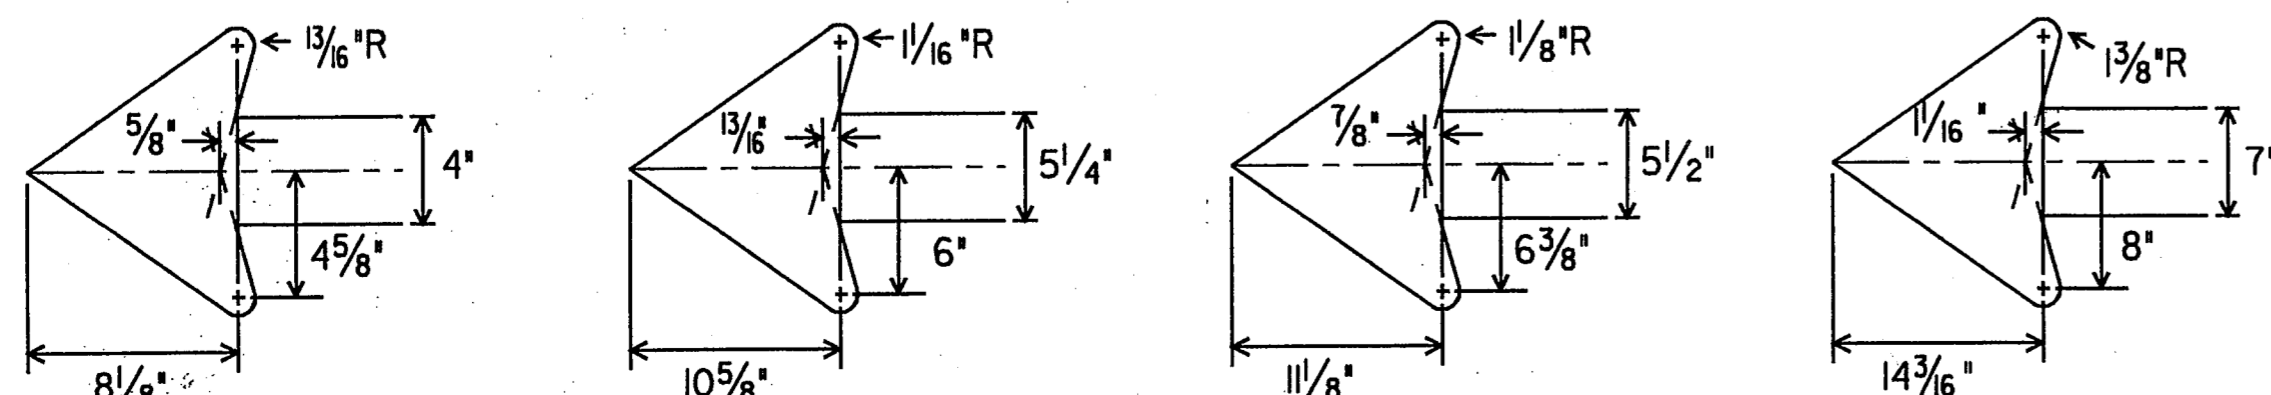

FINAL RECORD  
DRAWING  
Date: 12/25/99

ISSUE DATE: 11-26-96

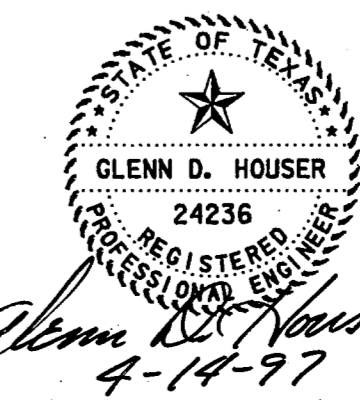



















STANDARD PLANS  
TEXAS DEPARTMENT OF TRANSPORTATION  
Traffic Operations Division

WARNING SIGNS

W(1)-95 (MOD.)

ORIG DRAW DATE:	JAN, 1981	DN- LR	CK-	DN- DN	CK-	NEG NO.:
REVISIONS		STATE DISTRICT	FEDERAL REGION	FEDERAL AID PROJECT		SHEET
		6				41
		COUNTY	CONTROL SECTION	JOB	ROADWAY	


JUN/82 CK4CW DW:FDN CK4MT  
 DATE: 05/82  
 ACC: d58hpic/usr/d580504  
 FILE: 01 02 03 04 05 06 07 08 09 10 11 12 13 14 15 16 17 18 19 20 21 22 23 24 25 26 27 28 29 30 31 32  
 33 34 35 36 37 38 39 40 41 42 43 44 45 46 47 48  
 49 50 51 52 53 54 55 56 57 58 59 60 61 62 63

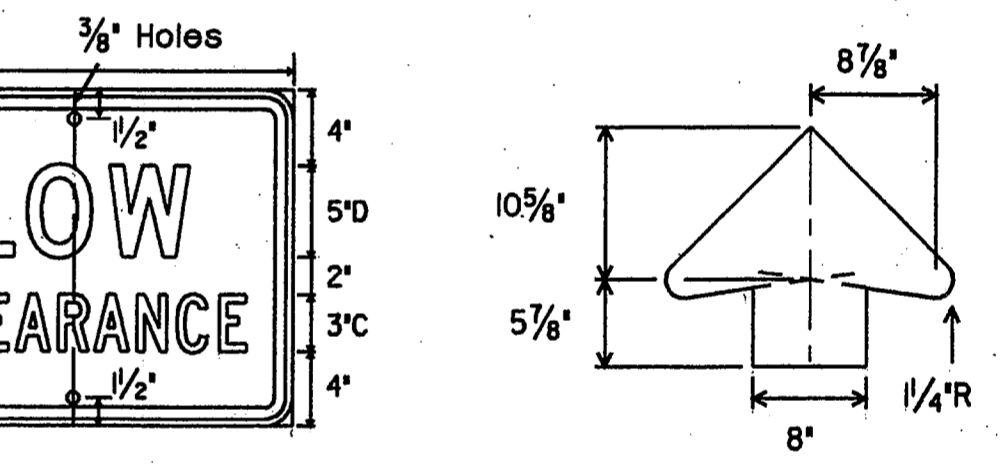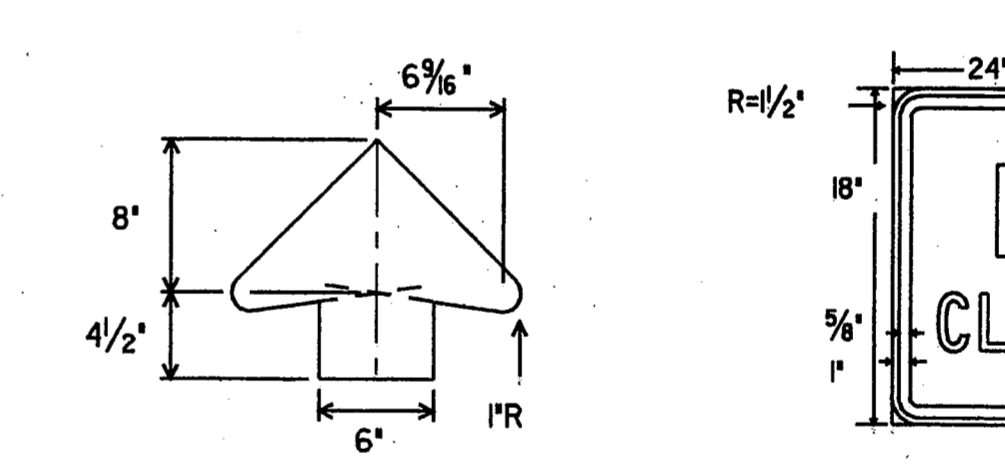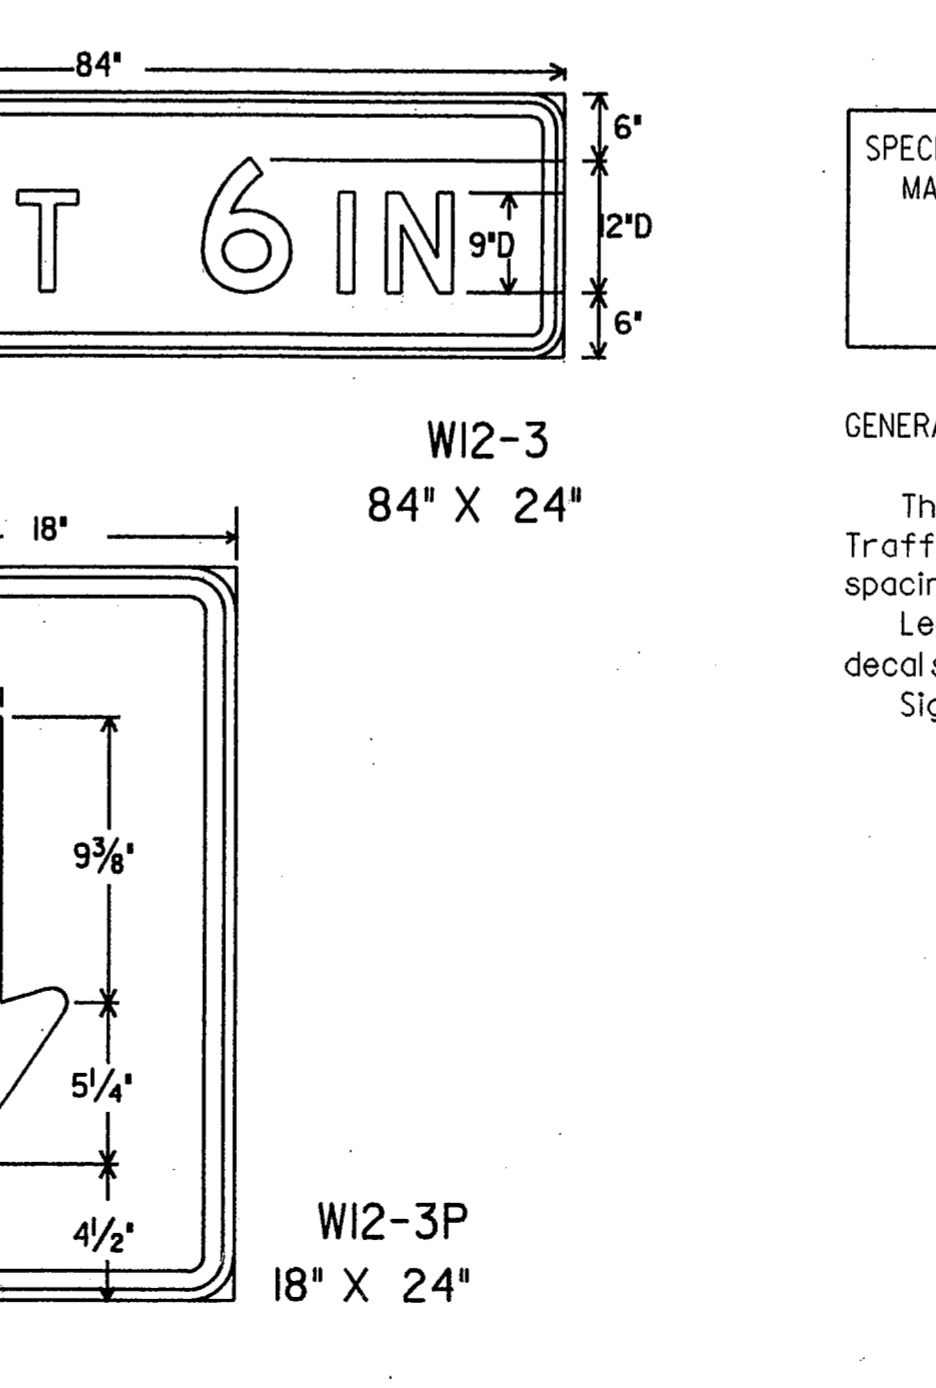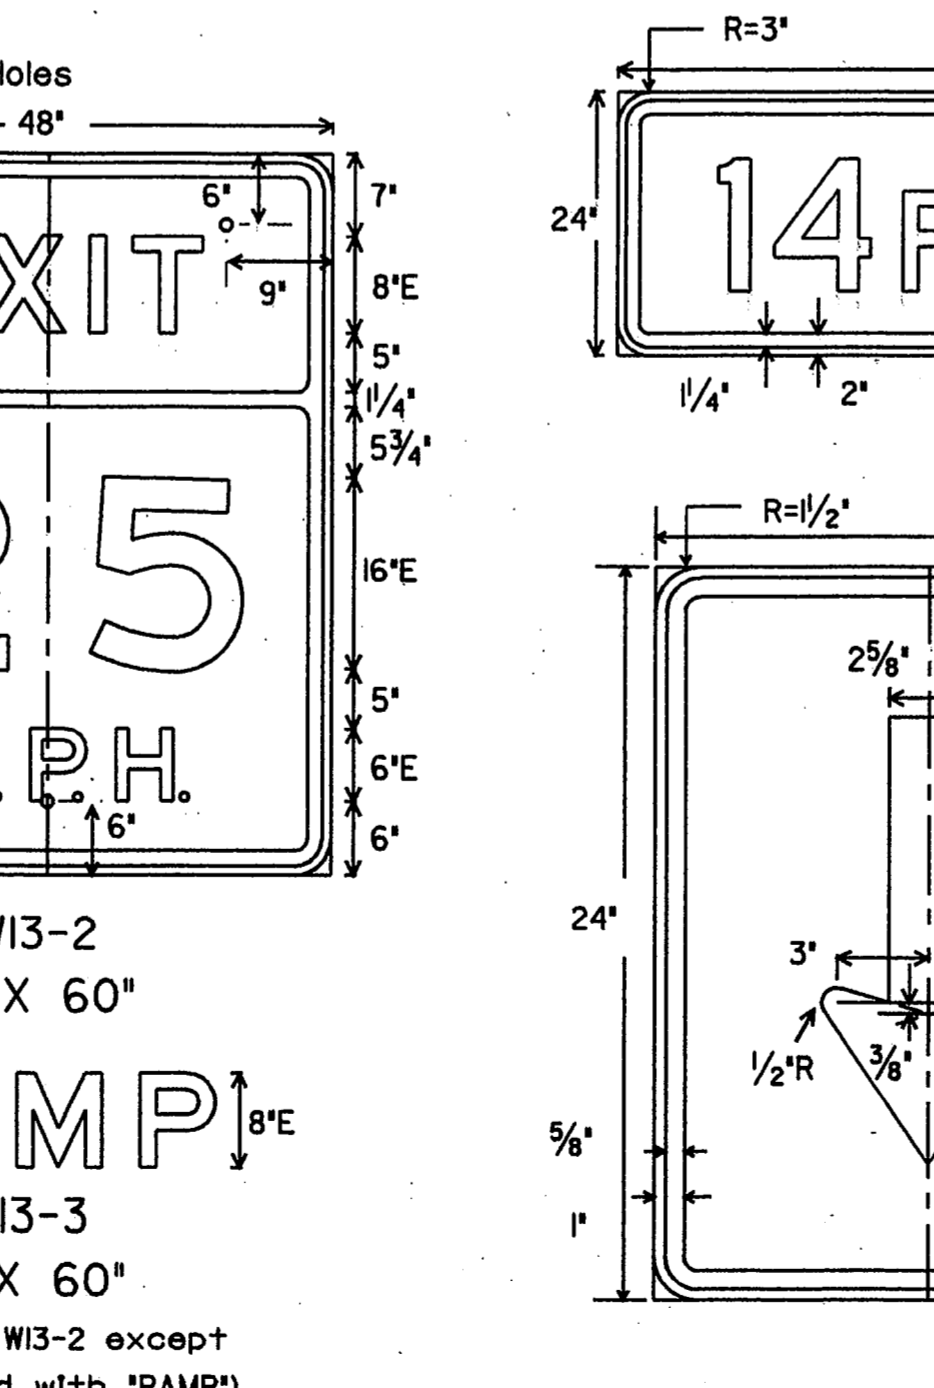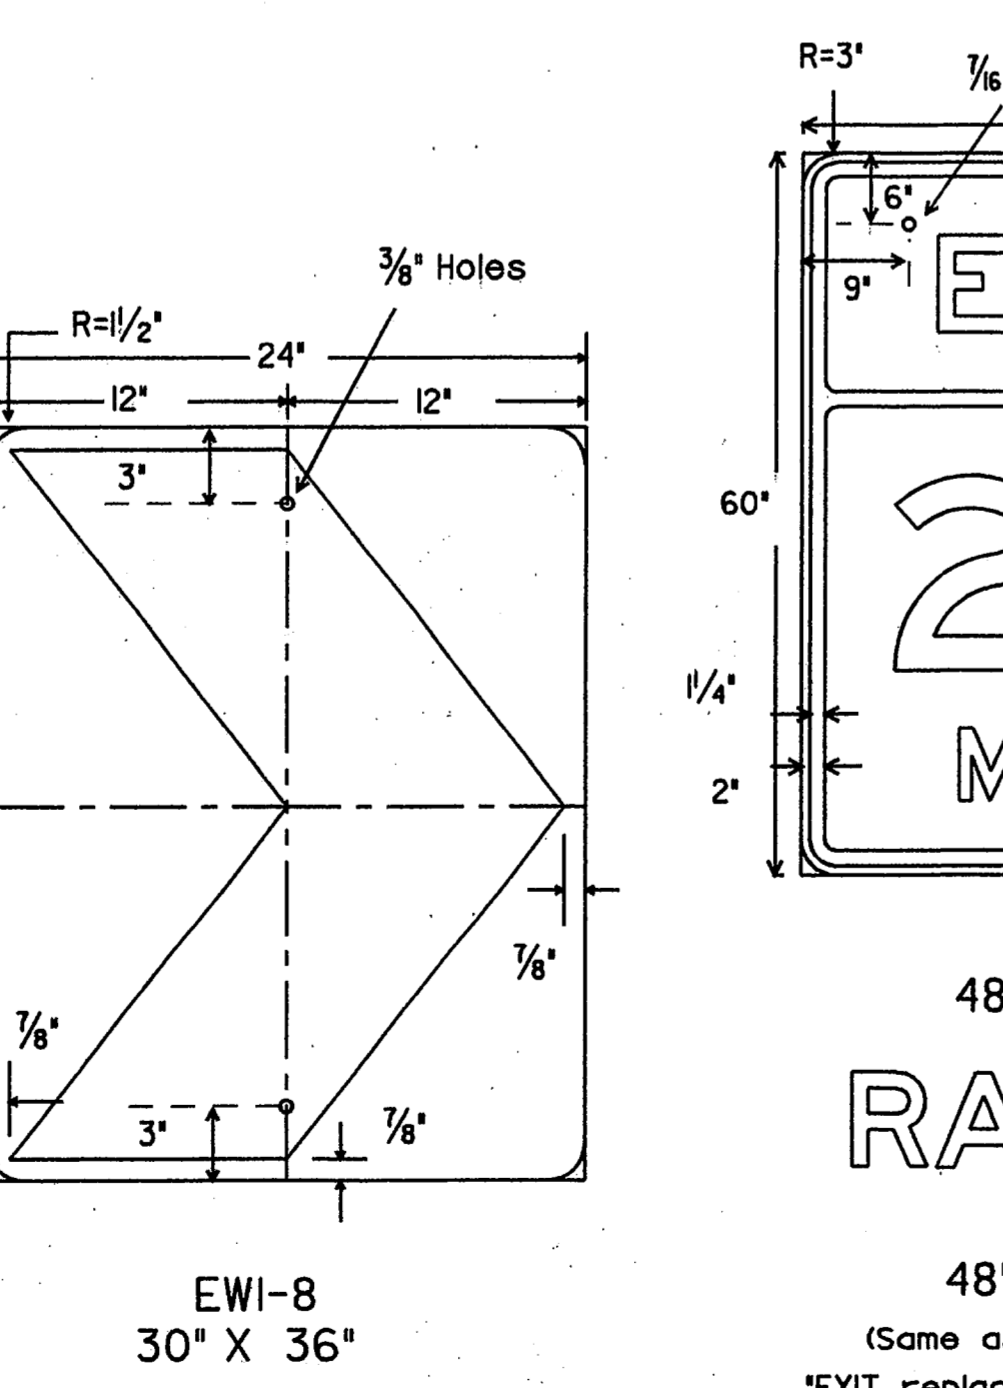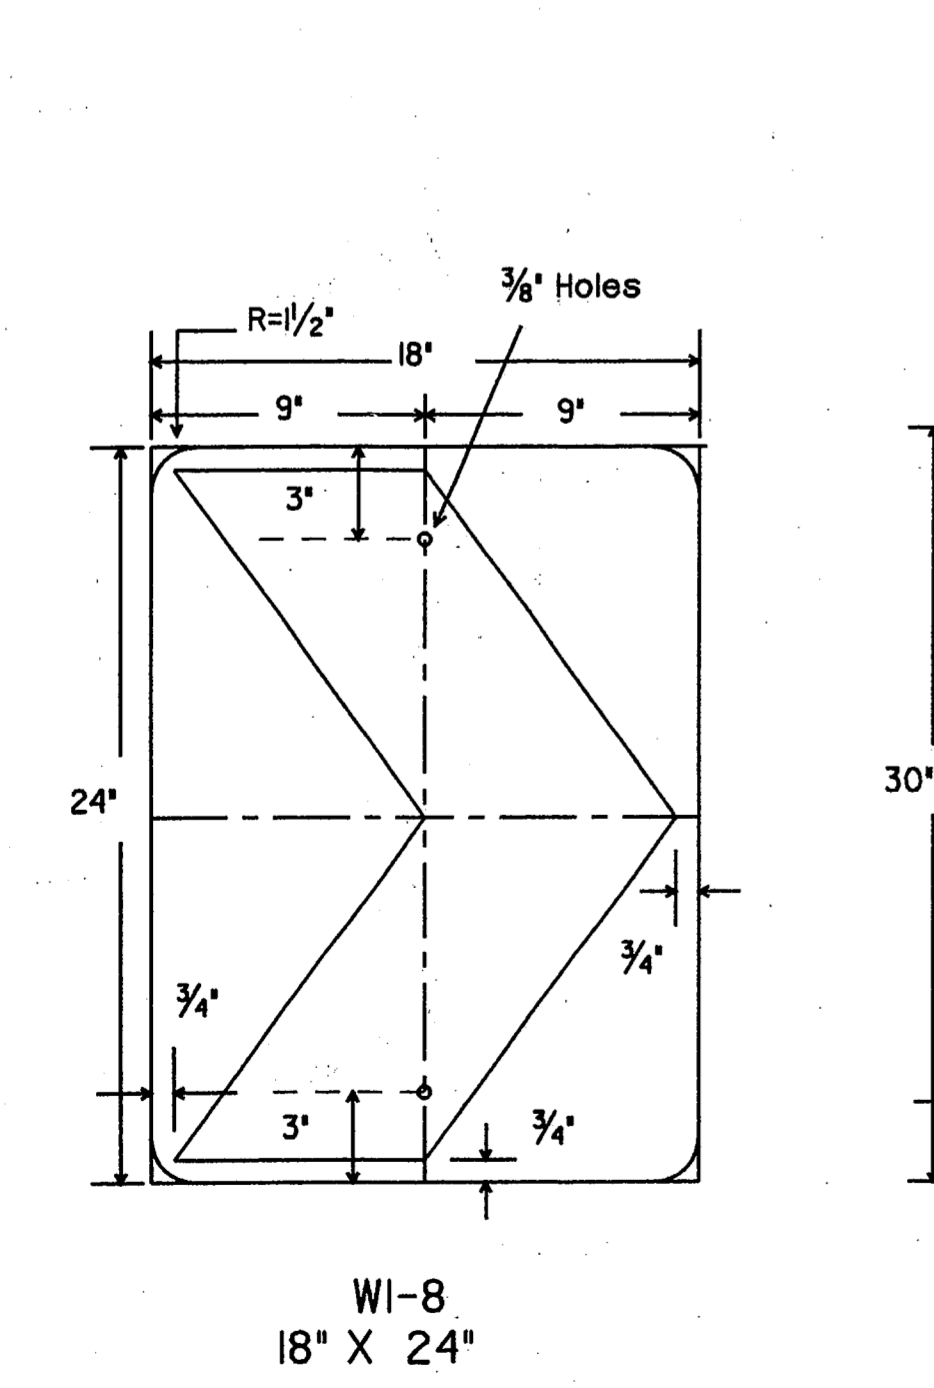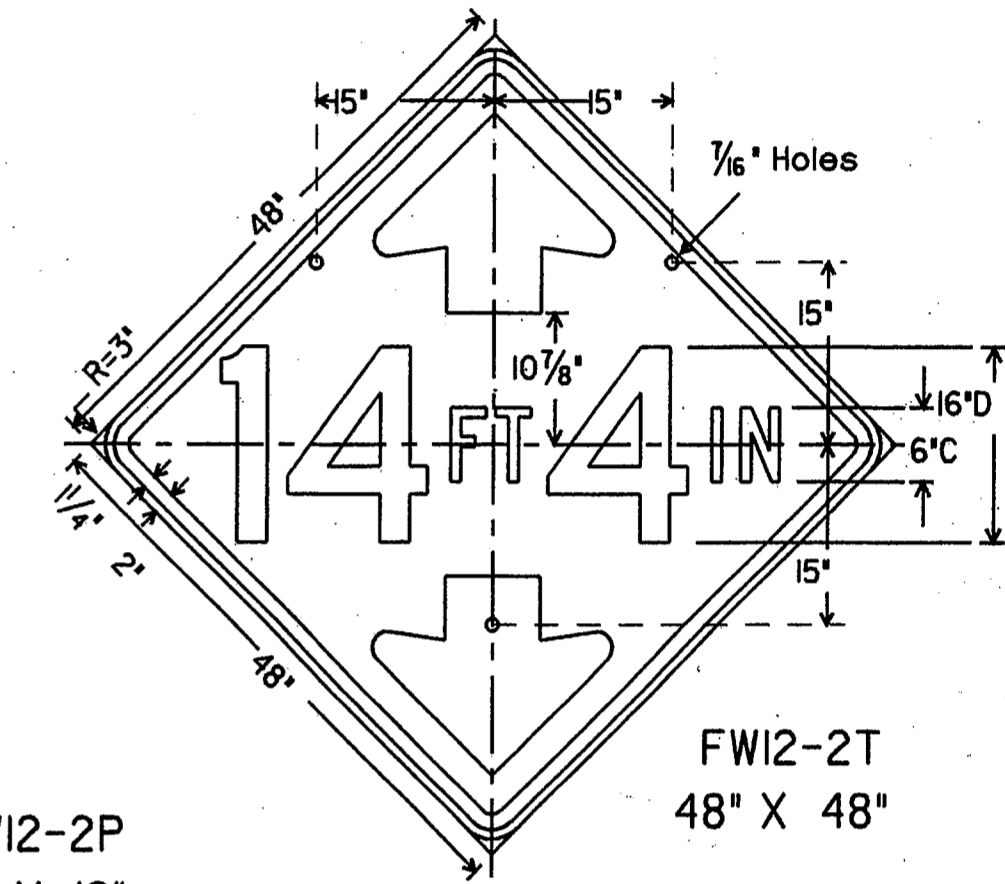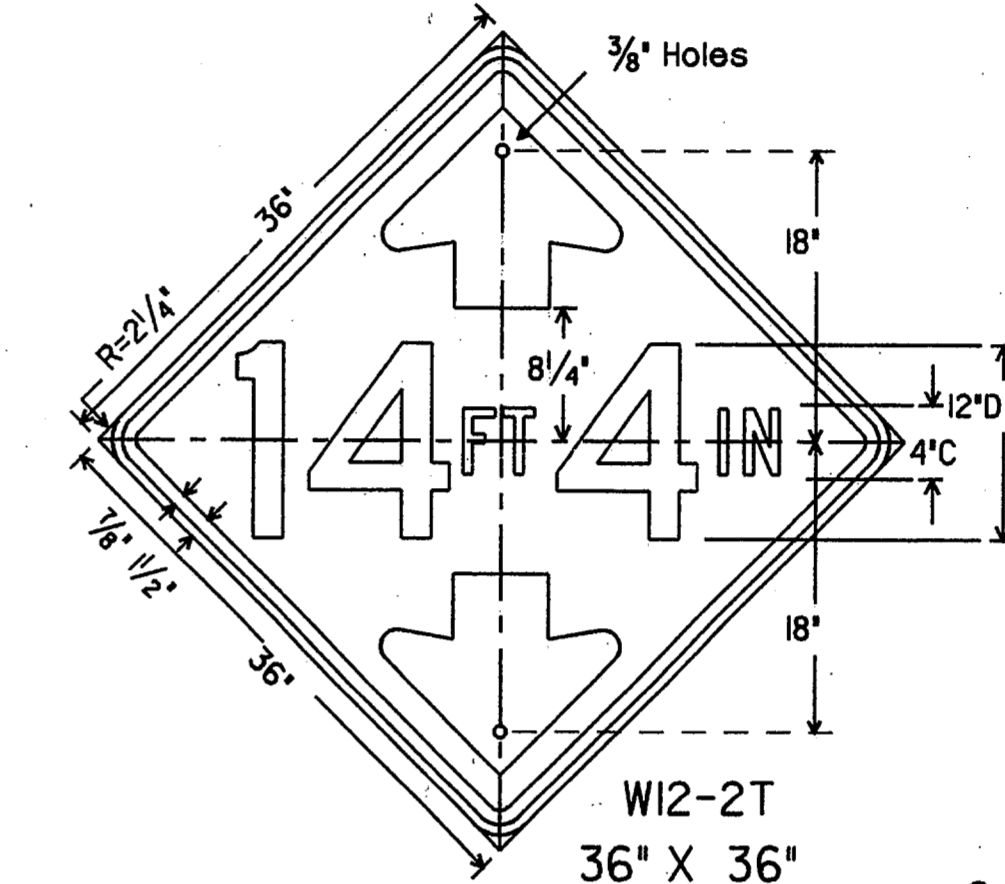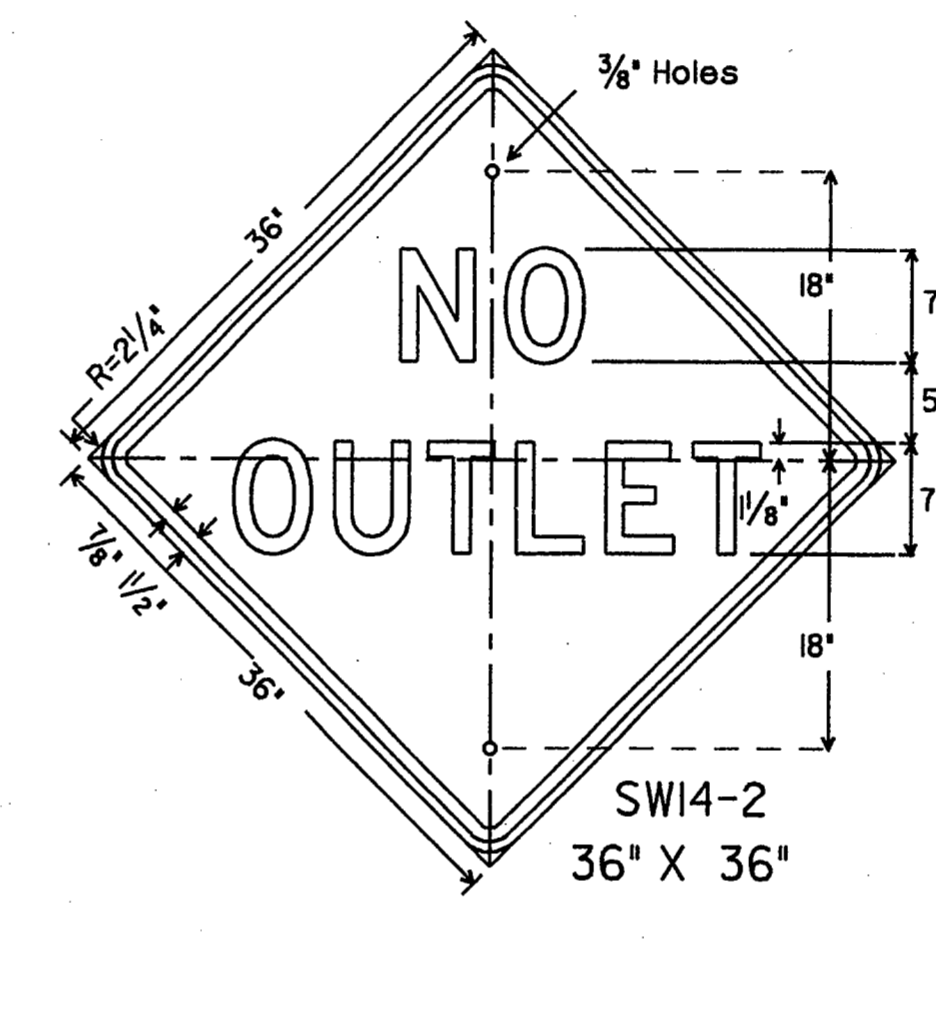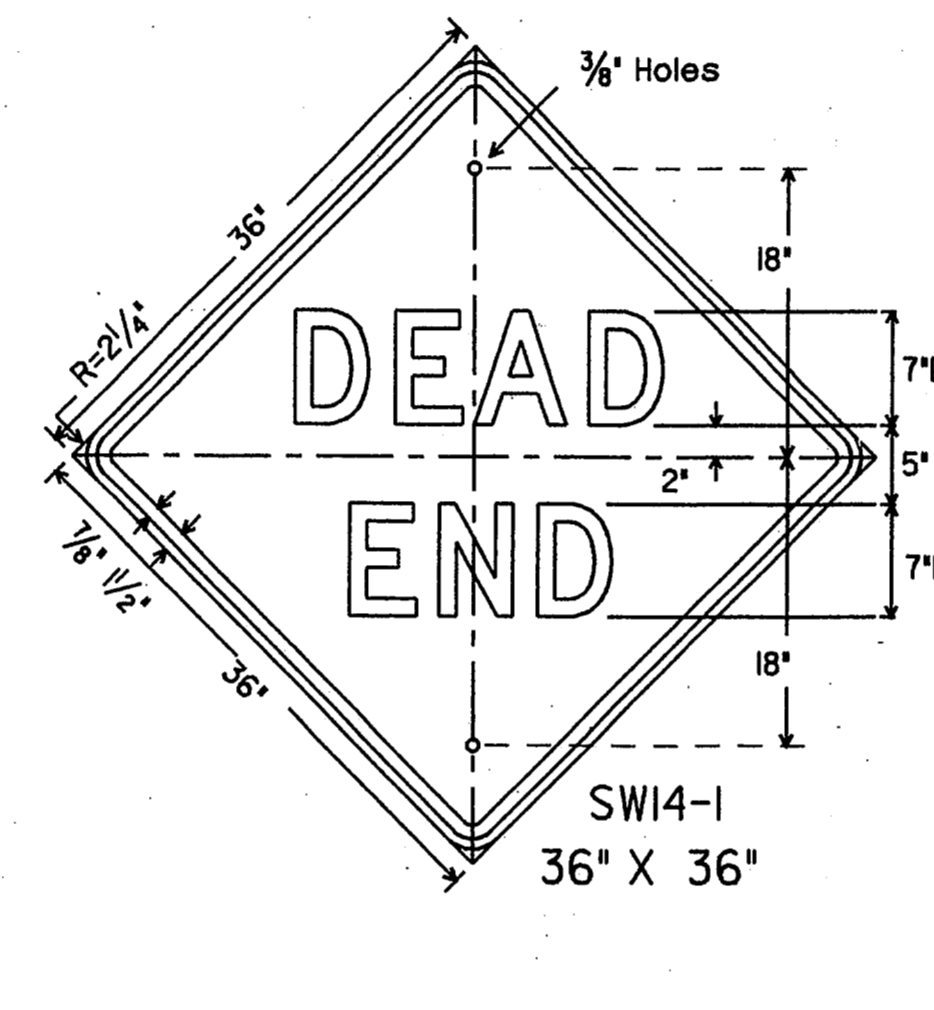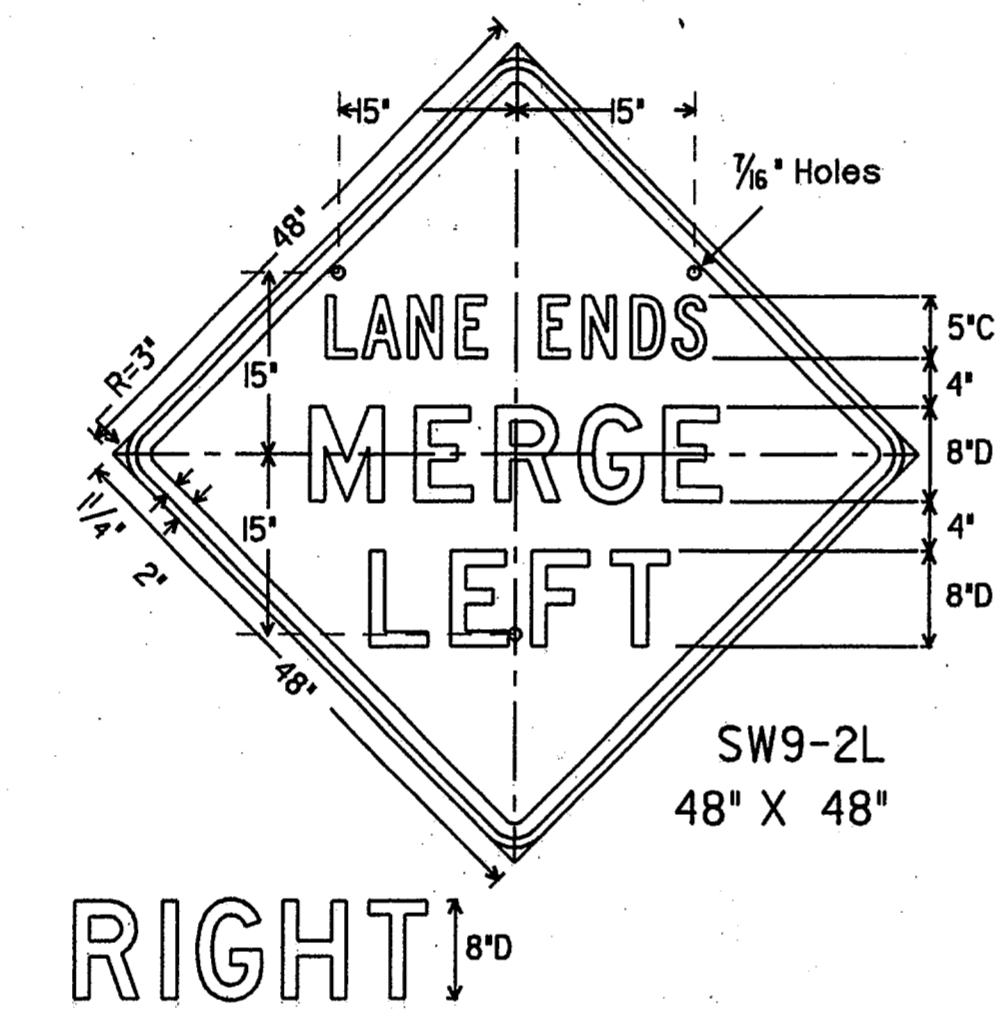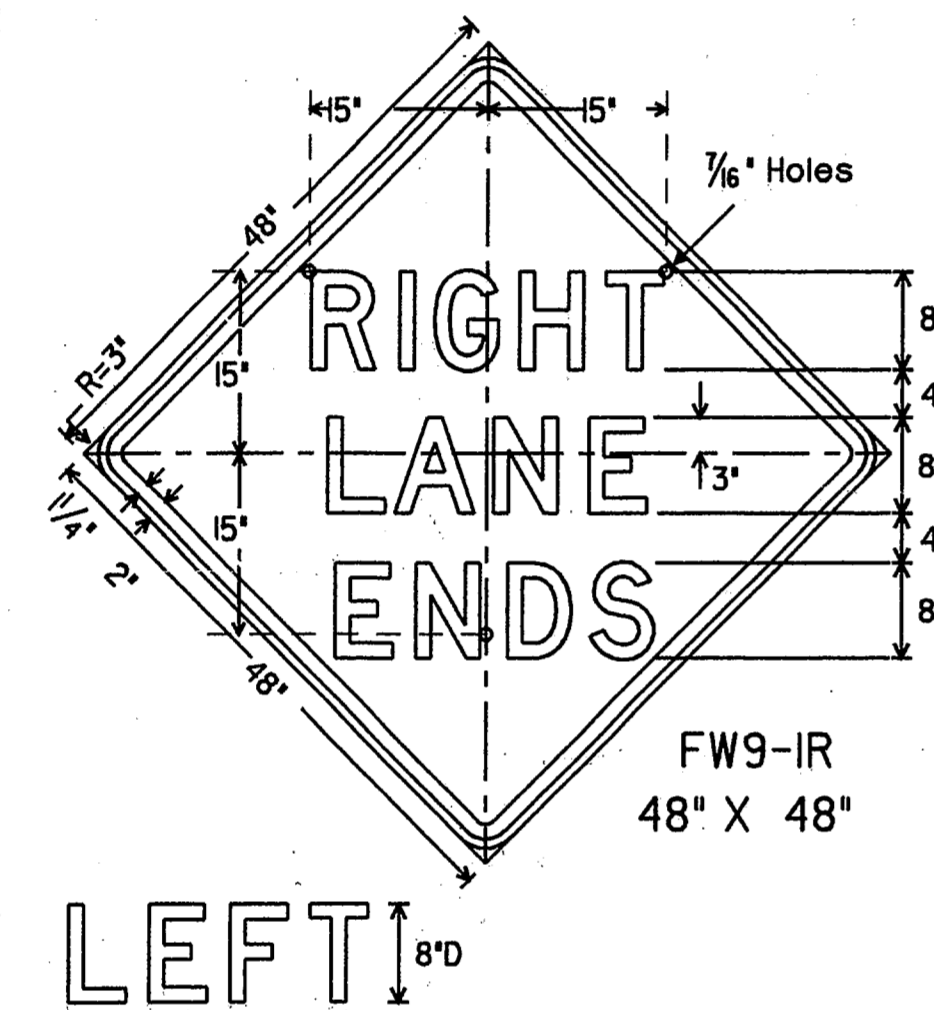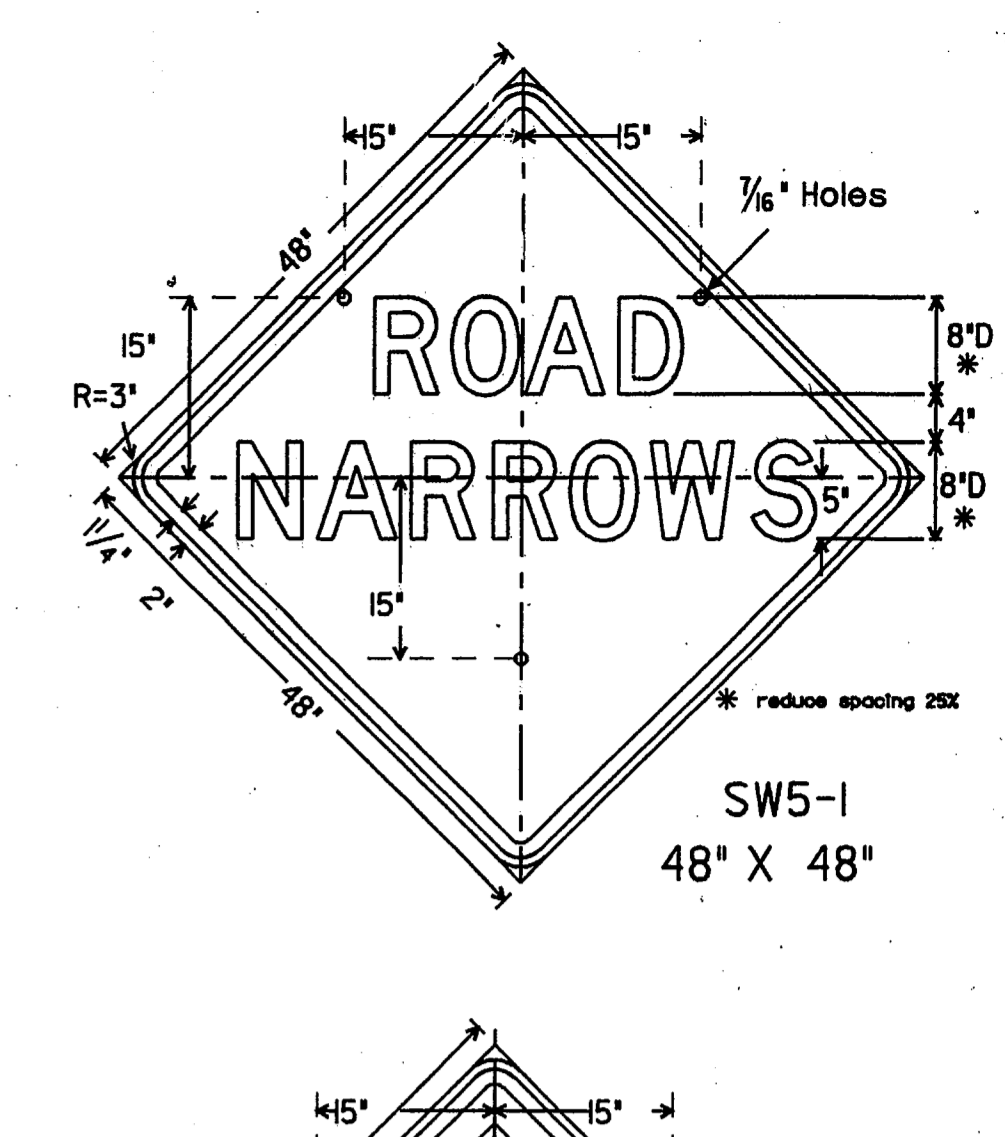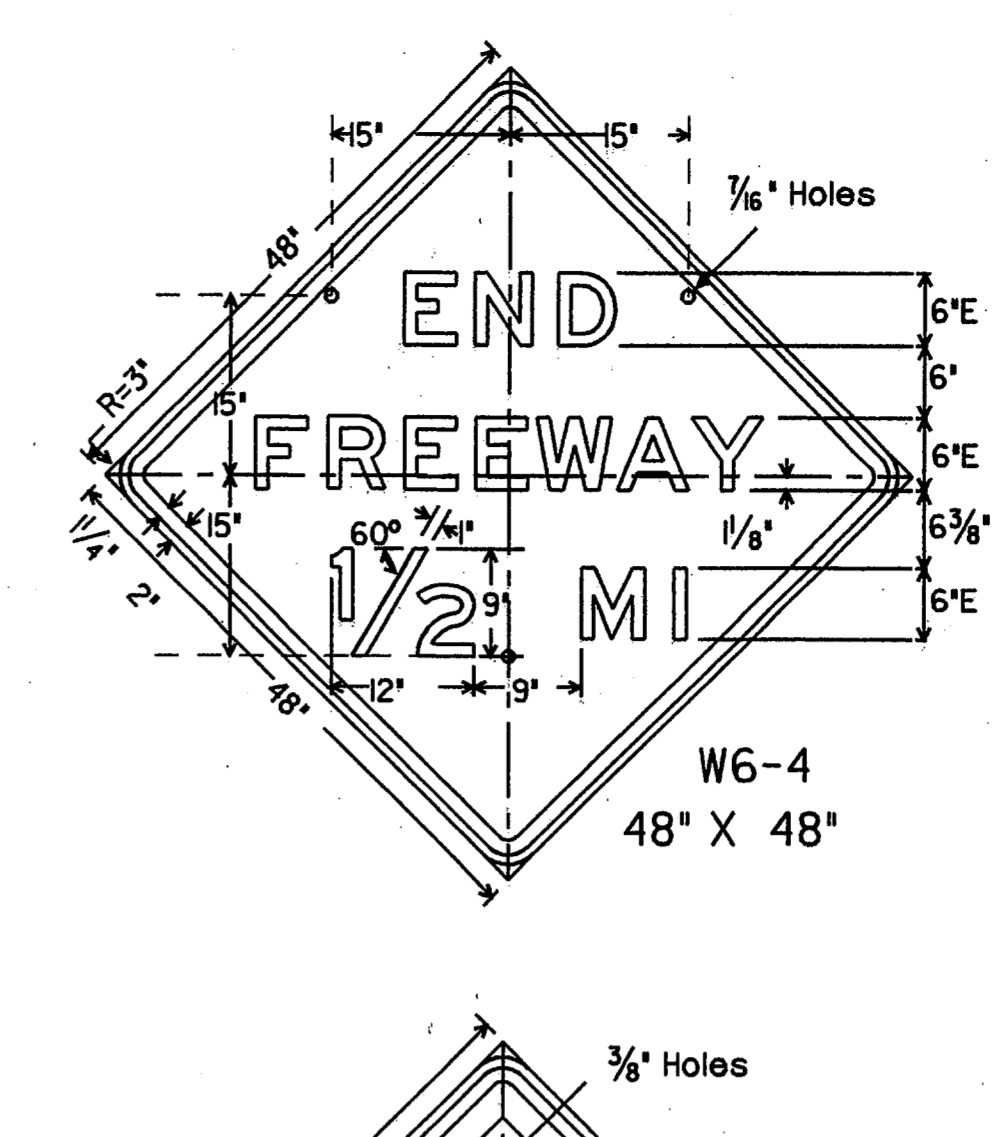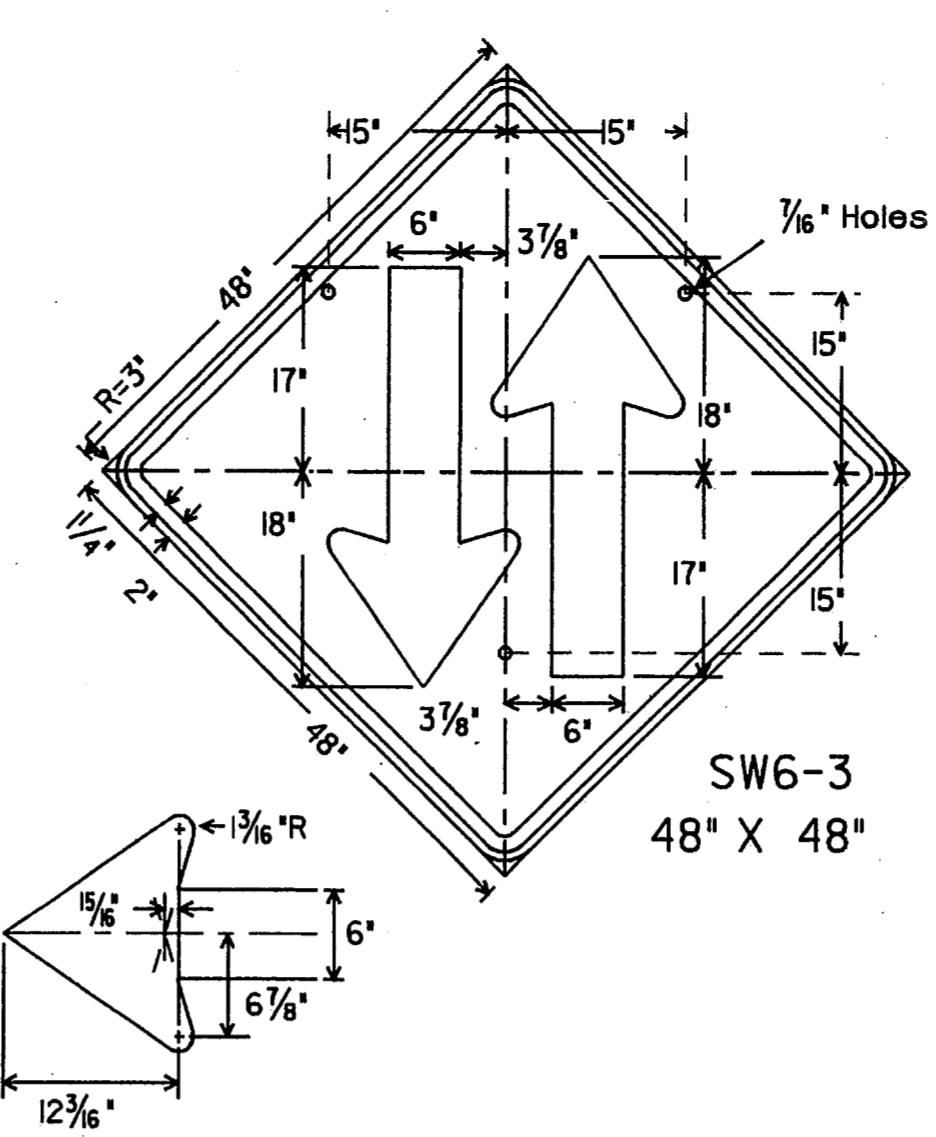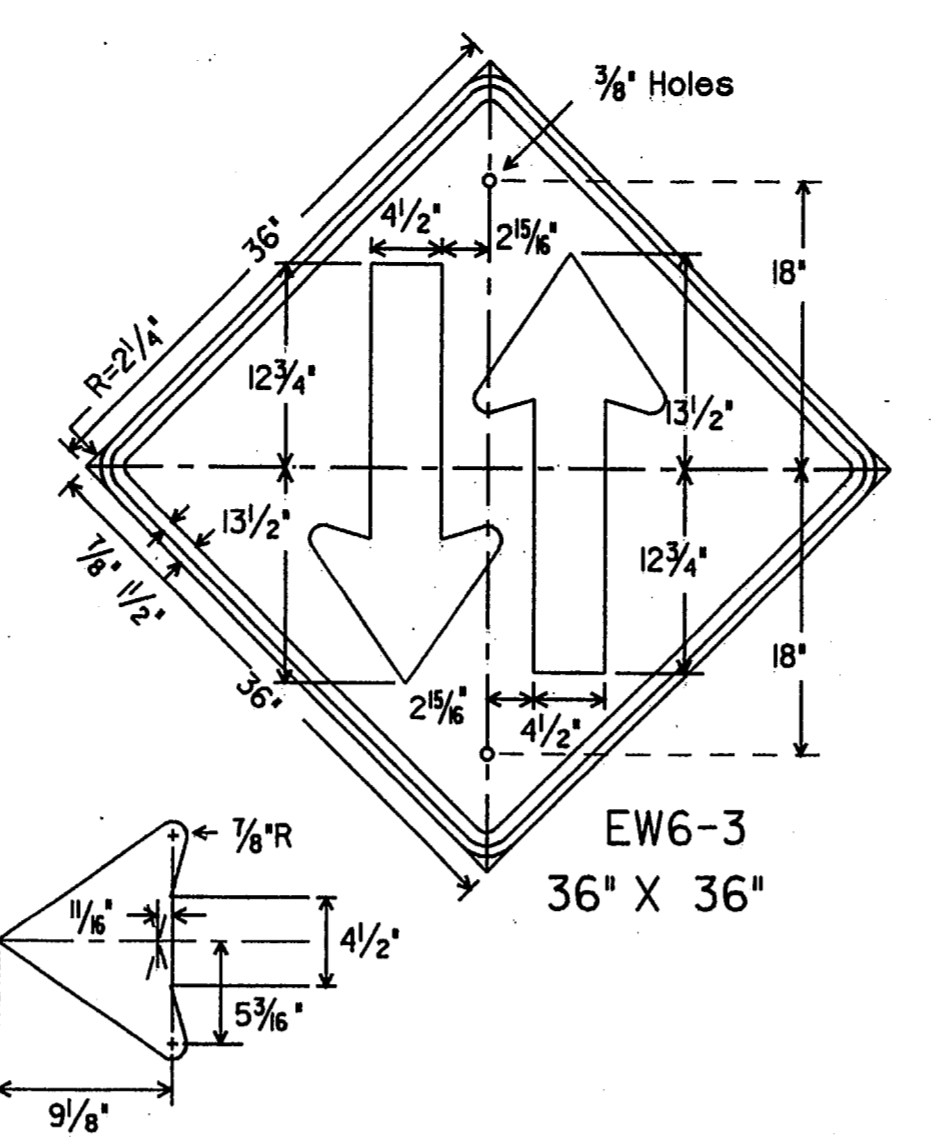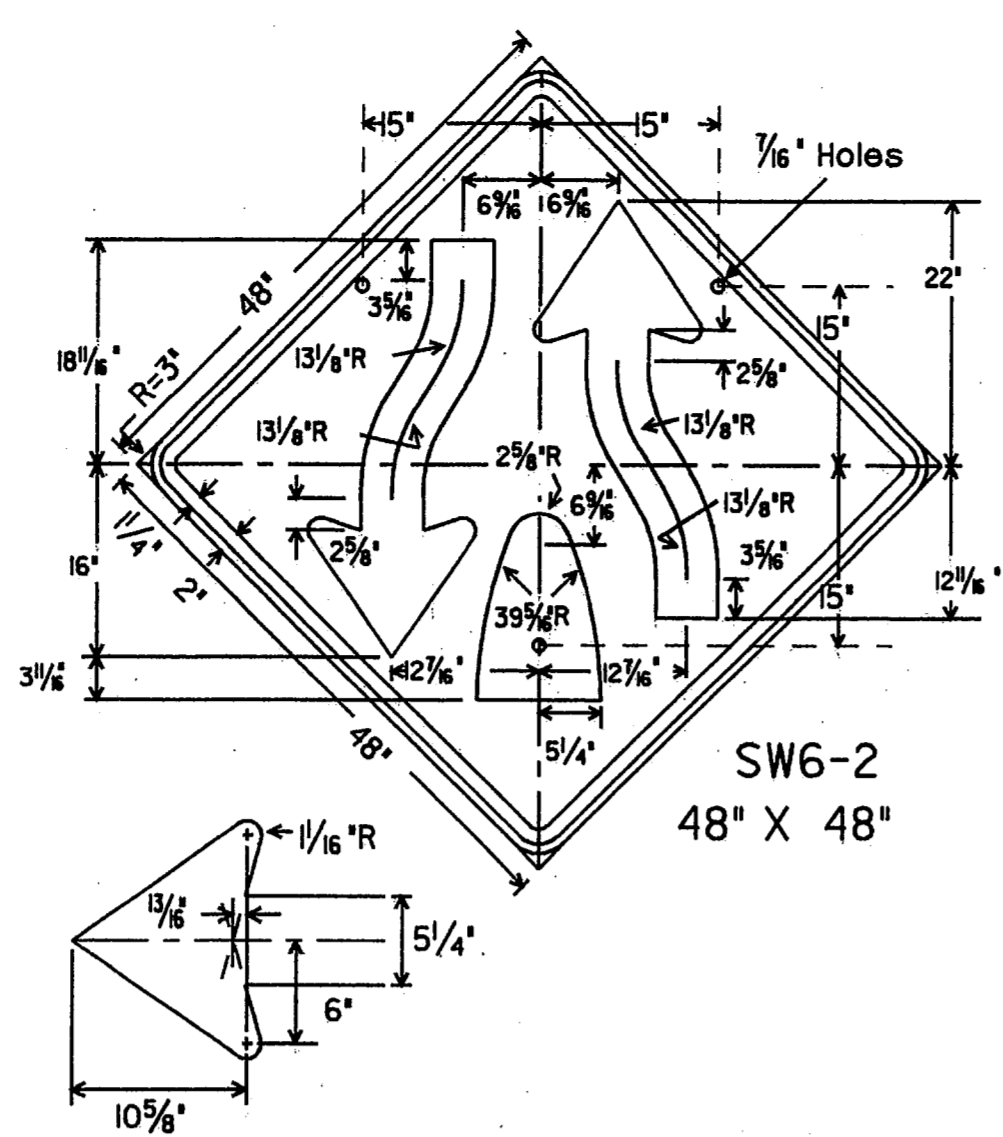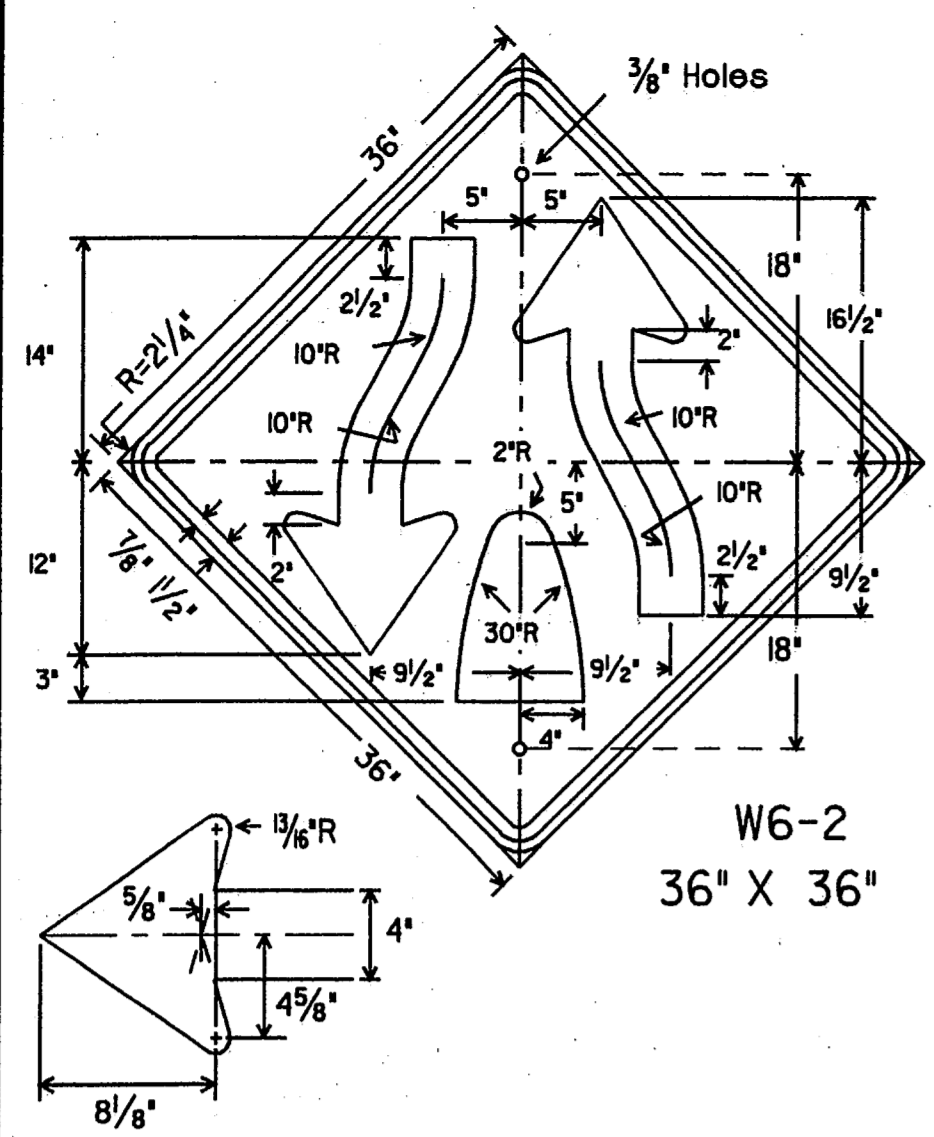

SPECIFICATION REFERENCE TABLE	
MATERIALS AND TESTS DIVISION SPECIFICATIONS	
ALUMINUM SIGN BLANKS	D-9-710 Δ
REFLECTIVE SHEETING, TYPE C (HIGH SPECIFIC INTENSITY)	D-9-8300
VINYL NON-REFLECTIVE DECAL SHEETING	D-9-8320

GENERAL NOTES:  
 The alphabets and lateral spacing between letters and numerals shall conform with the Texas 'Manual on Uniform Traffic Control Devices for Streets and Highways', latest edition, and any approved changes thereto. Lateral spacing of text shall provide a balanced appearance. All materials shall conform to Department Specifications. Legend (except where noted), shall be black and applied by screening process, cut-out, vinyl non-reflective decal sheeting or combination thereof. Background shall be yellow reflective sheeting (Type C).  
 Sign blanks shall be one piece 0.080 inch thick sheet aluminum alloy (Type A), unless otherwise noted elsewhere in the plans. Δ

FINAL RECORD  
 DRAWING  
 Date: 12/25/99  
 ISSUE DATE: 11-26-96

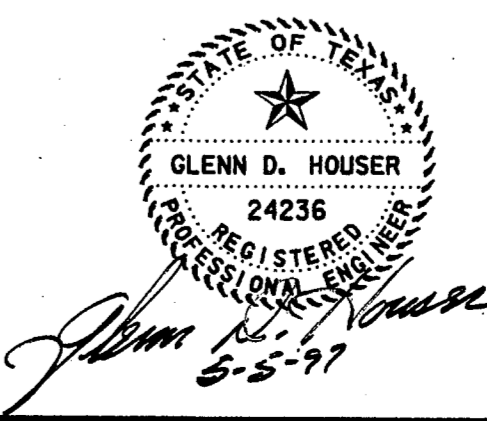


STANDARD PLANS  
 TEXAS DEPARTMENT OF TRANSPORTATION  
 Traffic Operations Division

WARNING SIGNS  
 W(2)-95 (MOD.)


ORIG. DRAW. DATE: JAN, 1981	DR: LR	CR:	DW: DN	CR:	NEG. NO.:
REVISIONS:	STATE DISTRICT:	FEDERAL REGION:	FEDERAL AID PROJECT		
1-82	6	6	COUNTY:	CONTROL SECTION:	JOB:
1-85					HIGHWAY:
7-90					
8-95					

42

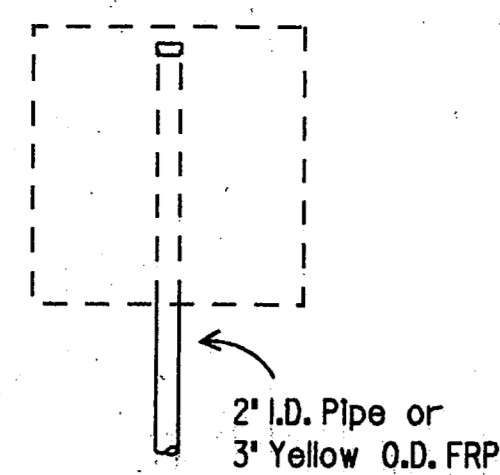


**Type A**

THIS TYPE PIPE MOUNT OR YELLOW FIBERGLASS REINFORCED PLASTIC (FRP) SUPPORT MAY BE USED FOR ANY SIGN OR COMBINATION OF SIGNS WITH THE SIGN AREAS INDICATED BELOW, EXCEPT FR6-1 AND W1-6 SIGNS (SEE TYPE D-1); MAX. OF 10 SQ. FT. FOR 2" PIPE MOUNT MAX. OF 16 SQ. FT. FOR 3" FRP MOUNT THE AREA OF THE REGULATORY OR WARNING SIGN SUPPLEMENTARY PLAQUES SHALL NOT BE USED IN DETERMINING THE ABOVE SIGN AREA.

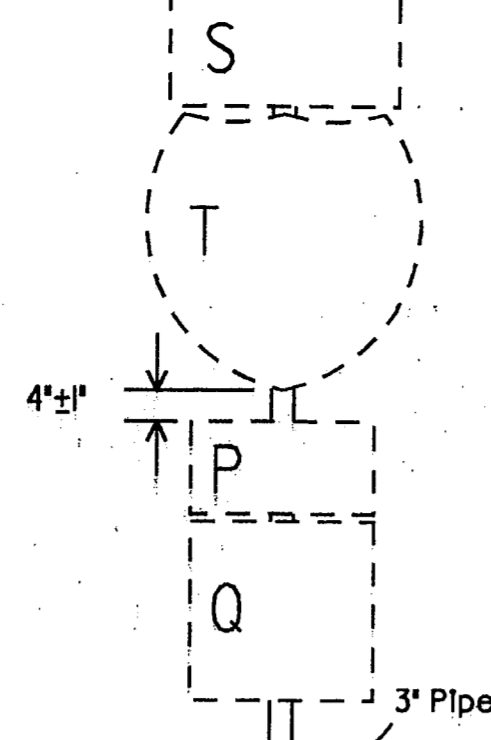

**Type A-1**

THIS TYPE PIPE MOUNT TO BE USED FOR A 36" OR 45" INTERSTATE ROUTE MARKER WITH A 24" OR 30" ROUTE MARKER ON MAIN LANES OR AS A SPECIFIED OPTIONAL SUBSTITUTE FOR TYPE B.

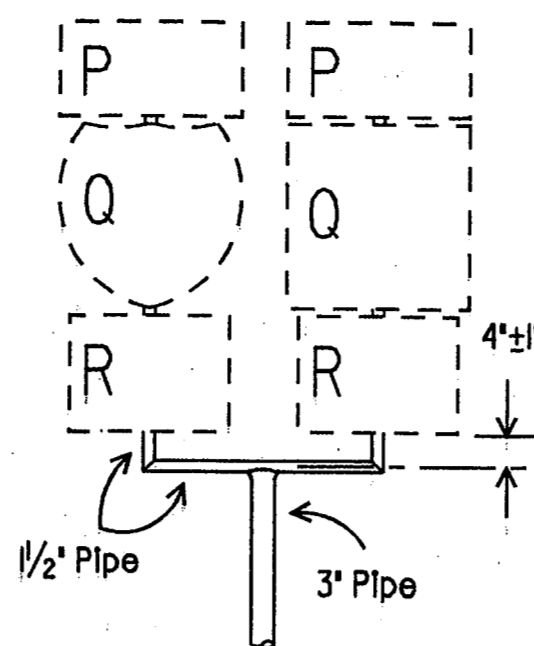

**Type B**

THIS TYPE PIPE MOUNT TO BE USED WITH 2 ROUTE MARKER ASSEMBLIES.

**Type D-1**

A = 2"φ B = 1/2"φ

NOTE: (FOR TYPE D-1)

- FOR "ONE WAY" SIGNS (FR6-1, 48" X 16"), MOUNTING CLAMPS ARE SPACED 28 INCHES APART. THE TOP OF SIGN IS 8 INCHES ABOVE CENTERLINE OF PIPE B.
- FOR "LARGE ARROW" SIGN (W1-6, 48" X 24"), MOUNTING CLAMPS ARE SPACED 30 INCHES APART.

**Type D-3**

A = 2 1/2"φ B = 1/2"φ


**Type D-2**

A = 2 1/2"φ B = 1/2"φ

**Type D-4**



A = 3"φ B = 2"φ

MOUNT TYPE	H	W	
		Min	Max
D-2	24"	n/a	8'
	30"	n/a	6'6"
D-4	24"	8'6"	12'6"
	30"	8'0"	10'6"
D-6	24"	13'0"	13'6"
	30"	10'0"	11'0"
	36"	8'6"	9'0"

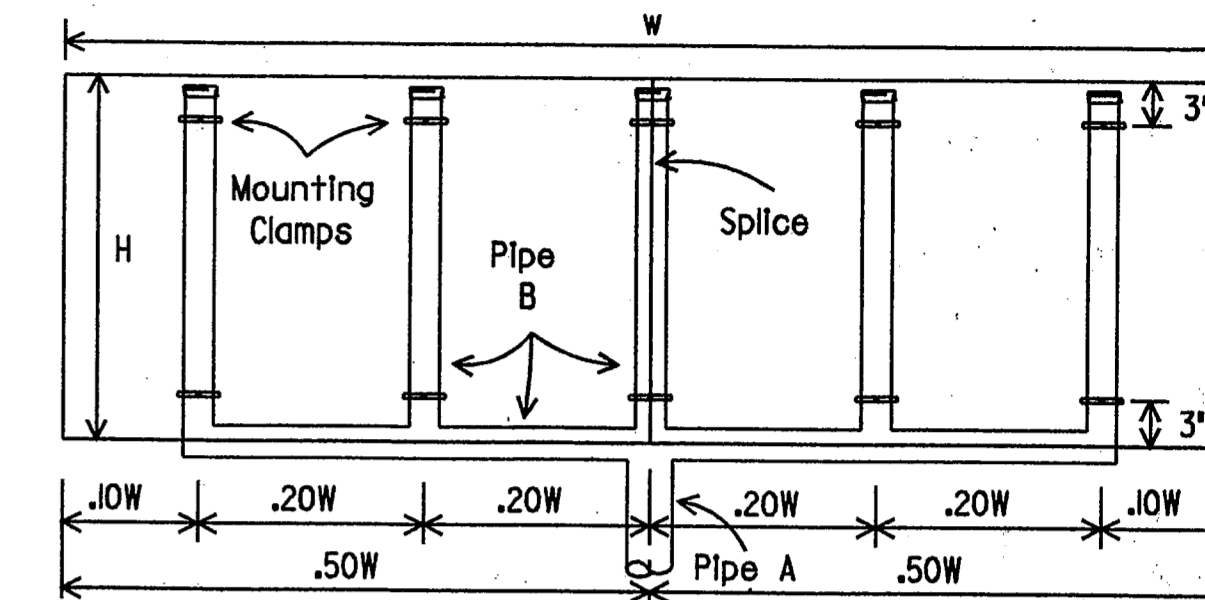

**Type D-6**


A = 3"φ B = 2"φ

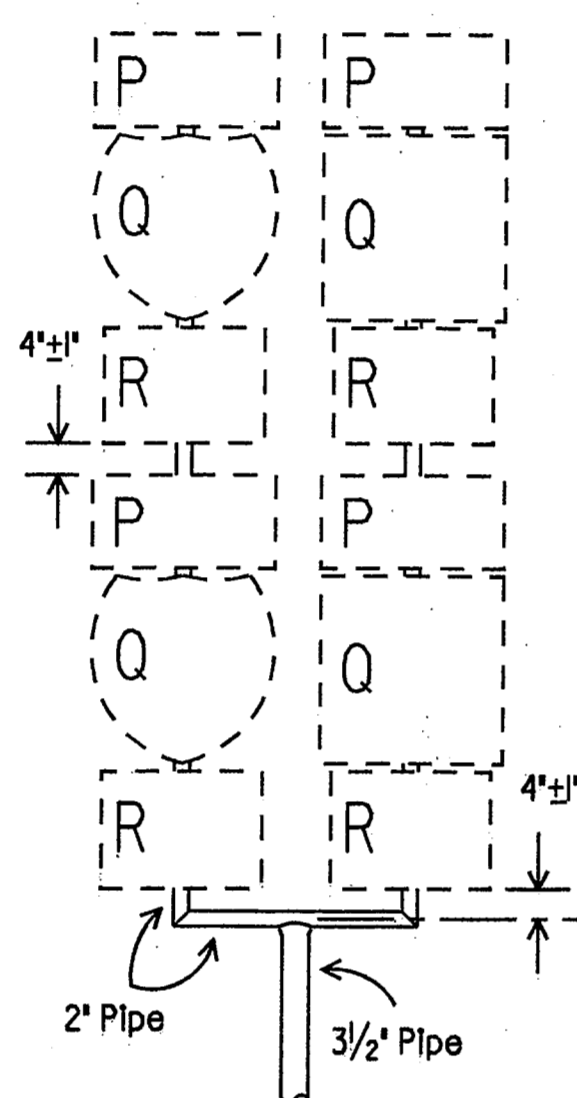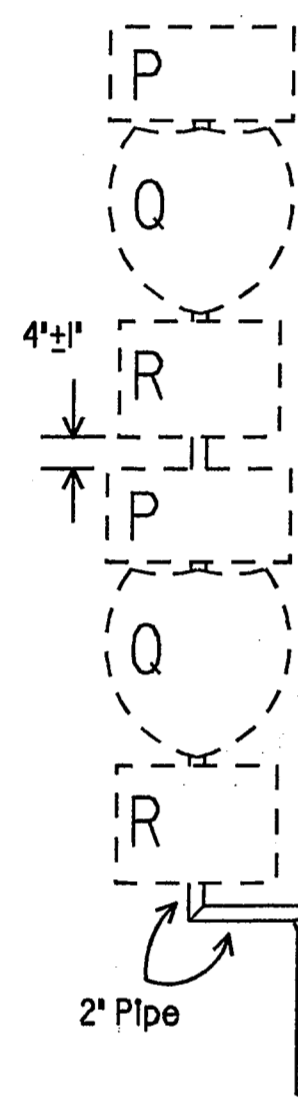

**Type C**

THIS TYPE PIPE MOUNT TO BE USED:  
1. WHEN 3 OR 4 ROUTE MARKERS ARE REQUIRED; OR  
2. FOR A 36 INCH OR 45 INCH INTERSTATE ROUTE MARKER WITH 2 OR 3 24 INCH AND/OR 30 INCH ROUTE MARKERS.

- P = 24"x12" Cardinal Direction Marker
- Q<sub>1</sub> = 24"x24" Interstate, US or State Route Marker
- Q<sub>2</sub> = 30"x24" Interstate or US Route Marker
- R = 21"x15" Direction Arrow
- S = 30"x15" Cardinal Direction Marker
- T<sub>1</sub> = 36"x36" (2) digit Interstate Route Marker
- T<sub>2</sub> = 45"x36" (3) digit Interstate Route Marker

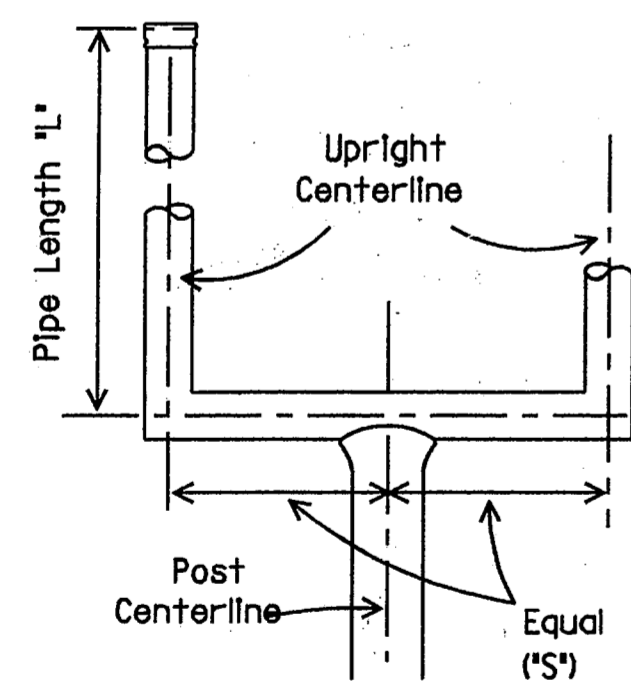

See table at right for values of 'L'


DIMENSION 'S'

DIMENSION 'S' EQUALS THE DISTANCE FROM THE CENTERLINE OF UPRIGHT TO THE CENTERLINE OF CLEARANCE BETWEEN SIGN GROUP.

S' = 1'-4 1/2" for Q<sub>1</sub>  
S' = 1'-7 1/2" for Q<sub>2</sub>

S' = 1'-10 1/2" for T<sub>1</sub>  
S' = 2'-3" for T<sub>2</sub>


Marker Combinations	'L'
2P+2Q+2R+7'	9'-1"
P+2Q+2R+7'	8'-1"
2Q+2P+7'	6'-7"
Q+R+3'	3'-6"
S+T+3'	4'-6"
P+Q+R+3'	4'-6"
P+Q+S+T+7'	7'-10"

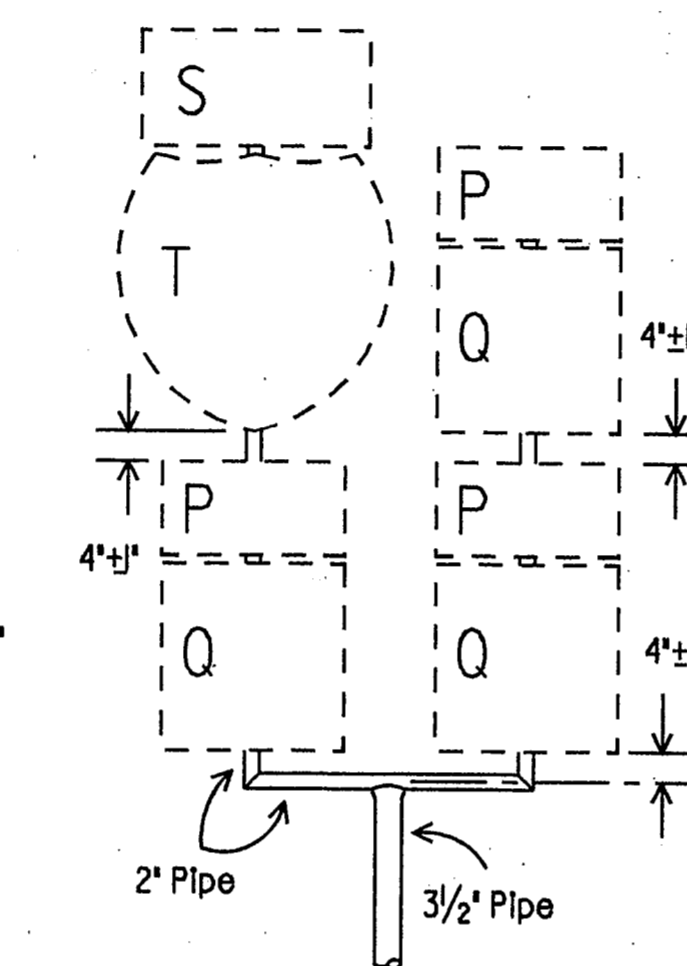

**Type F Mount**

GENERAL NOTES FOR SIGN SUPPORT TYPES A, B, C, D AND F

- TYPE A SUPPORT SHALL BE PIPE OR YELLOW FRP. FRP MOUNTS SHALL MEET DEPARTMENT SPECIFICATION D-9-4410.
- PIPE COLLAR COUPLING SHALL BE USED FOR ALL SIGNS SUPPORTED ON 2" AND 2 1/2" PIPE POSTS.
- TRIANGULAR SLIP BASE SHALL BE USED FOR SIGNS SUPPORTED ON 3" AND 3 1/2" PIPE POSTS.
- MOUNTING CLAMP, VERTICAL CLEARANCE AND LATERAL CLEARANCE DETAILS ARE SHOWN ON STANDARD SMD(I-2) (MOD.).
- WELDED PIPE MOUNT, FRICTION CAP, PIPE COLLAR COUPLING, TRIANGULAR SLIP BASE AND FOUNDATION DETAILS ARE SHOWN ON STANDARD SMD(I-3) AND SMD(I-4) (MOD.).

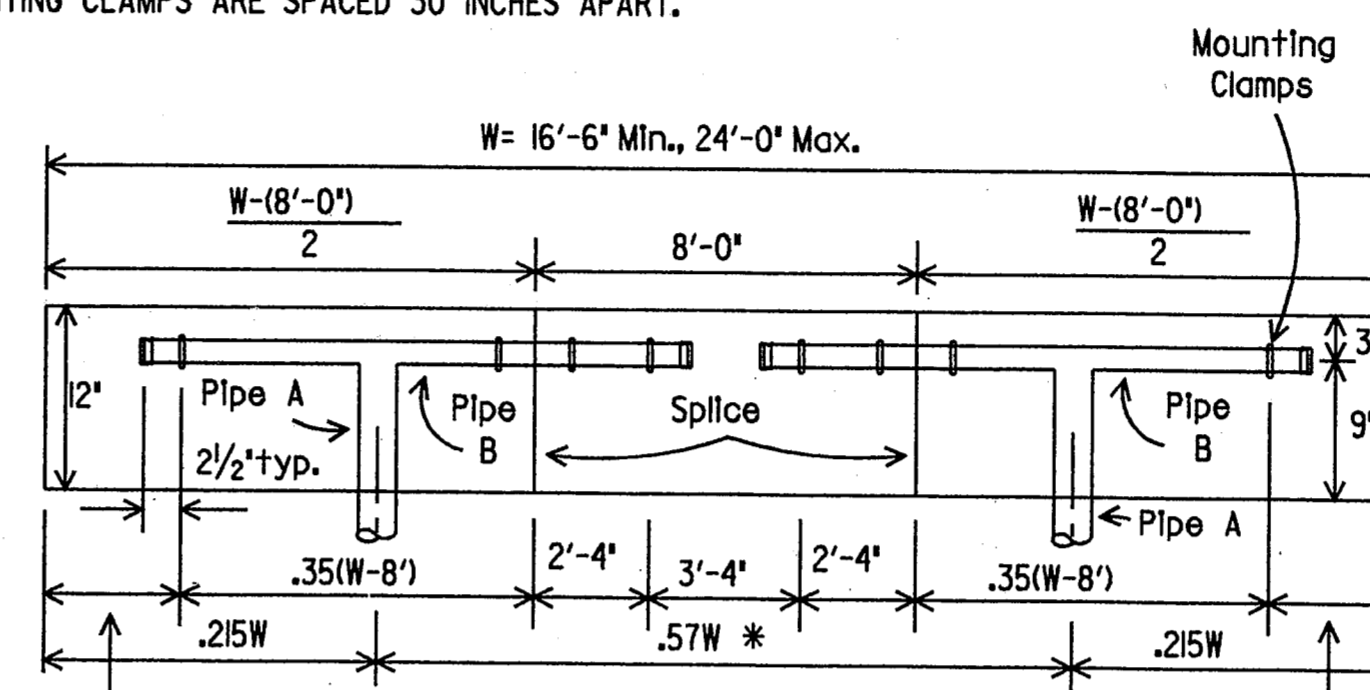

**Type D-5**

A = 2 1/2"φ B = 1/2"φ


\* POST SPACING MAY VARY ± 5% OF TOTAL SIGN WIDTH TO FIT FIELD CONDITIONS.

NOTES: (FOR TYPES D-1 THROUGH D-6)

- SPLICE PLATES REQUIRED AT SPLICE POINTS.
- THE SIGN BLANKS SHALL BE 0.080 INCH THICK SHEET ALUMINUM ALLOY (TYPE A), CONFORMING WITH DEPARTMENTAL MATERIAL SPECIFICATION D-9-7100, UNLESS OTHERWISE NOTED ELSEWHERE IN THE PLANS.

**Type F Mount Dimensions**

Type of Sign	Pipe "A"	Pipe "B"	C	D	E	F	
Regulatory Signs	SRI-1	3"φ	2"φ	39"	9"	15"	35"
	FRI-2	3"φ	2"φ	43"	21"	11"	27"
	36"X48"	3"φ	2"φ	42"	6"	12"	29"
	48"X36"	3"φ	2"φ	30"	6"	15"	35"
	48"X48"	3"φ	2"φ	42"	6"	15"	35"
Warning Signs	48"X48"	3"φ	2"φ	54"	6"	15"	35"
	48"X60"	3"φ	2"φ	54"	6"	15"	35"
School Signs	SSI-1	3"φ	2"φ	30"	6"	12"	30"
	SS2-1	3"φ	2"φ	30"	6"	12"	30"

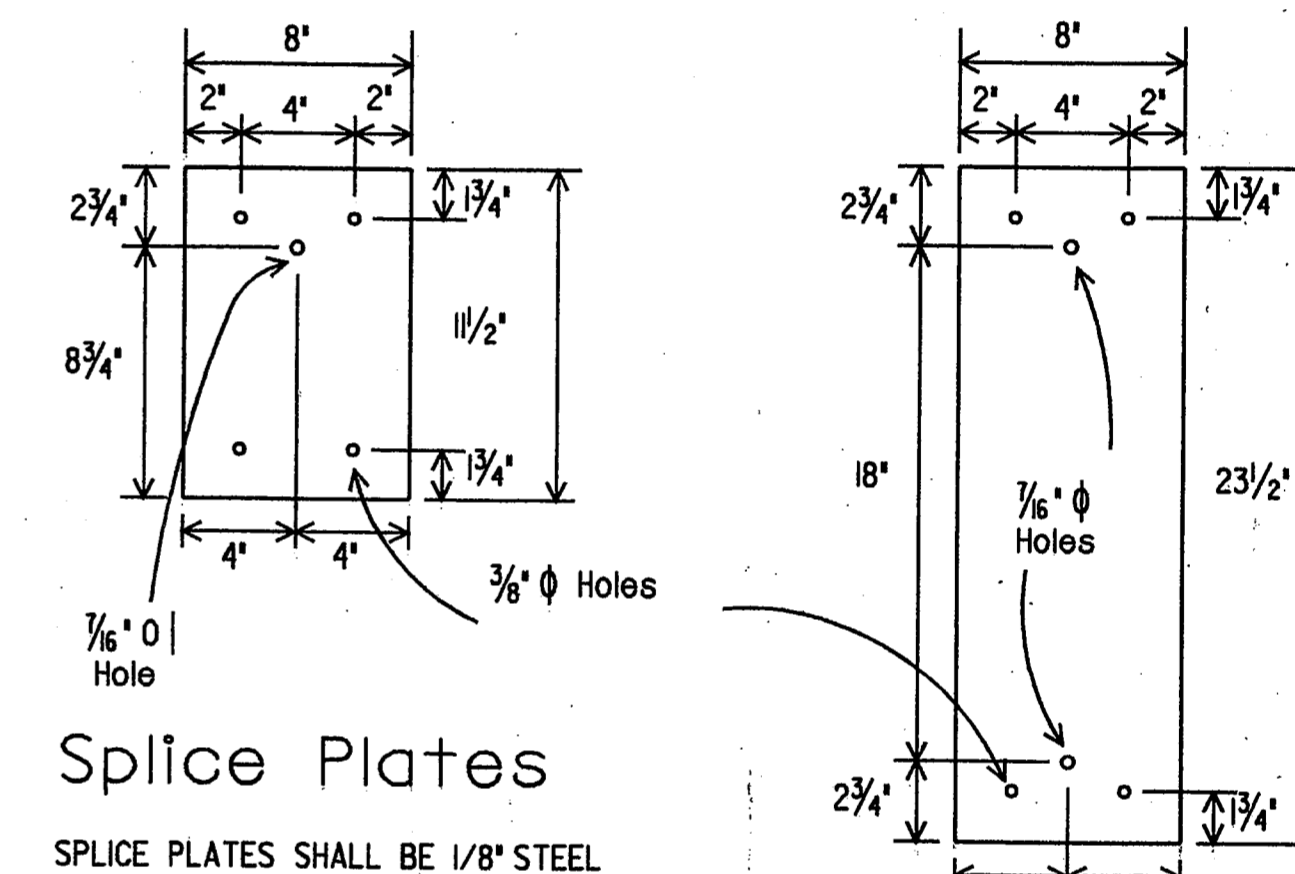

**Splice Plates**


SPLICE PLATES SHALL BE 1/8" STEEL PLATE (ASTM A36) OR 1/8" ALUMINUM PLATE (ASTM B209 ALLOY 6061-T6 OR 5052-H38). STEEL SHALL BE GALVANIZED IN ACCORDANCE WITH ASTM A123.

- INCLUDES PARENT SIGNS OF THIS SIZE WHICH HAVE SUPPLEMENTARY PLAQUE. EXAMPLE: WHEN "DO NOT ENTER" SIGN (SR5-1, 48" X 48") IS MOUNTED IN COMBINATION WITH THE "RAMP" PLAQUE (R5-1T, 48" X 18"), THE "DO NOT ENTER" IS MOUNTED AS A 48" X 48" REGULATORY SIGN AND THE "RAMP" IS MOUNTED AS A PLAQUE.
- SPEED LIMIT SIGNS FR2-2, FR2-3 AND FR2-4 ARE MOUNTED ONLY IN COMBINATION WITH "SPEED LIMIT" FR2-1 ON TYPE G MOUNT. "TRUCK SPEED LIMIT" SIGN (FR2-2A, 48" X 72") IS TO BE MOUNTED INDEPENDENTLY ON TYPE G MOUNT. SEE STANDARD SMD (TY G) FOR DETAILS. WHEN "WRONG WAY" SIGN (SR5-1A, 48" X 36") IS MOUNTED IN COMBINATION WITH "DO NOT ENTER" SIGN (SR5-1, 48" X 48"), TYPE G MOUNT IS USED.
- SCHOOL ADVANCE (SSI-1, 48" X 48") AND SCHOOL CROSSING (SS2-1, 48" X 48") SYMBOL SIGNS SHALL BE MOUNTED ON A TYPE F MOUNT.

UNCL: CK:W DW:DN CK:MT  
DATE: 12 25 99  
FILE: 1 2 3 4 5 6 7 8 9 10 11 12 13 14 15 16 17 18 19 20 21 22 23 24 25 26 27 28 29 30 31 32 33 34 35 36 37 38 39 40 41 42 43 44 45 46 47 48 49 50 51 52 53 54 55 56 57 58 59 60 61 62 63

**FINAL RECORD DRAWING**  
Date: 12/25/99

ISSUE DATE: 12-13-96

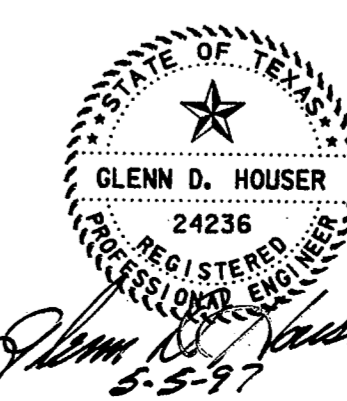

STANDARD PLANS  
TEXAS DEPARTMENT OF TRANSPORTATION  
Traffic Operations Division



**SIGN MOUNTING DETAILS-  
SMALL ROADSIDE SIGNS  
SMD(I-1)-95 (MOD.)**

ORIG DRAW DATE: August 1995  
REV: LR  
STATE DISTRICT: 6  
FEDERAL REGION: 6  
FEDERAL AID PROJECT: COUNTY CONTROL SECTION JOB HIGHWAY


11-96 Δ

SHEET 43


26A

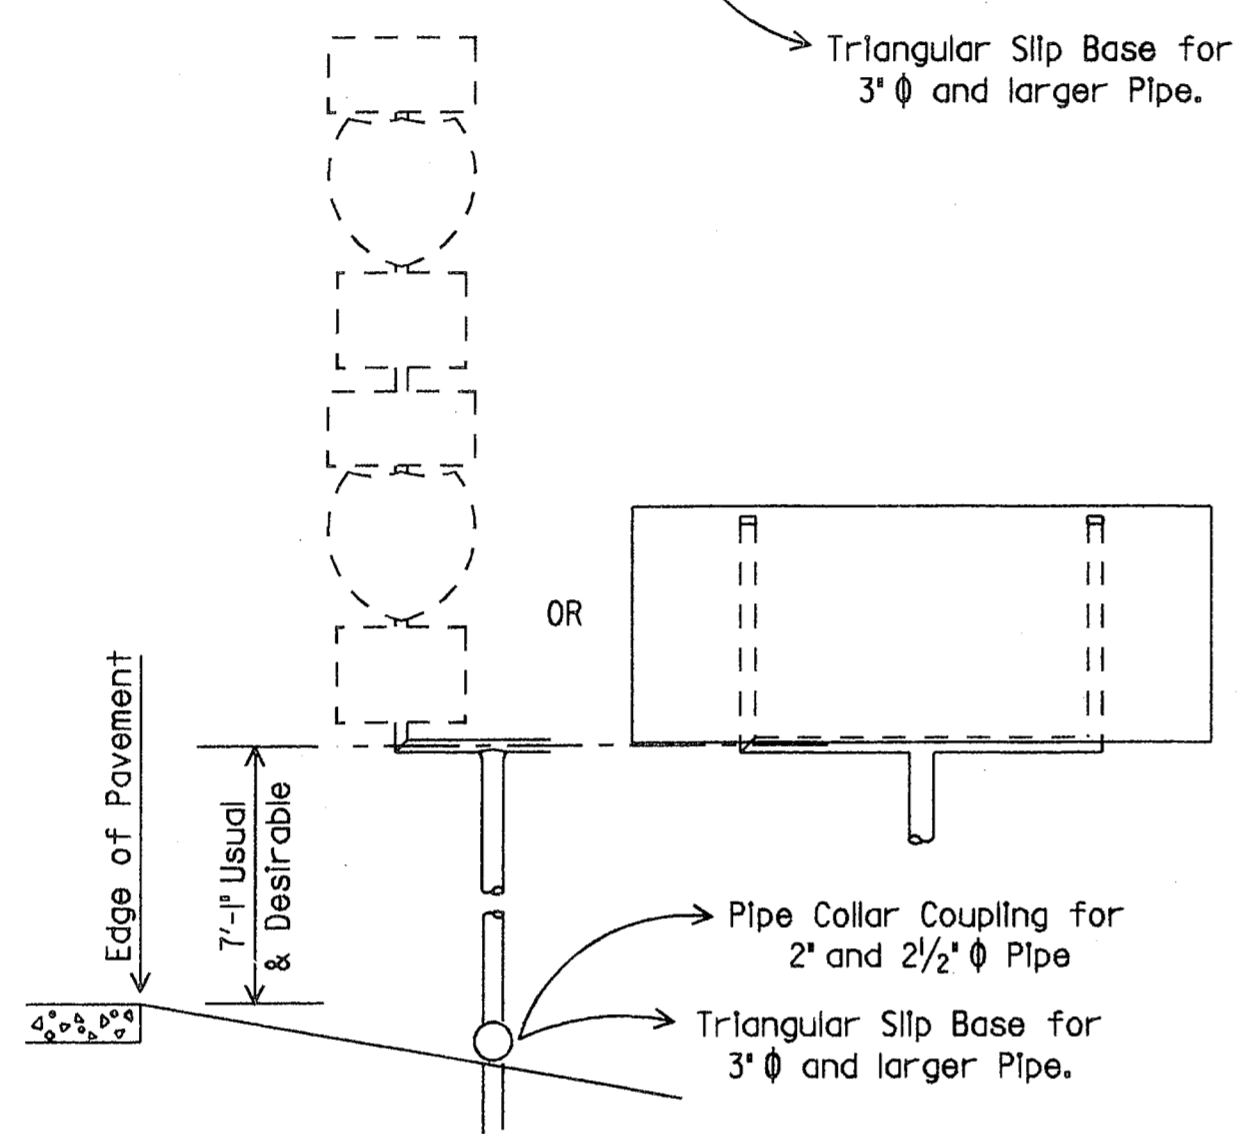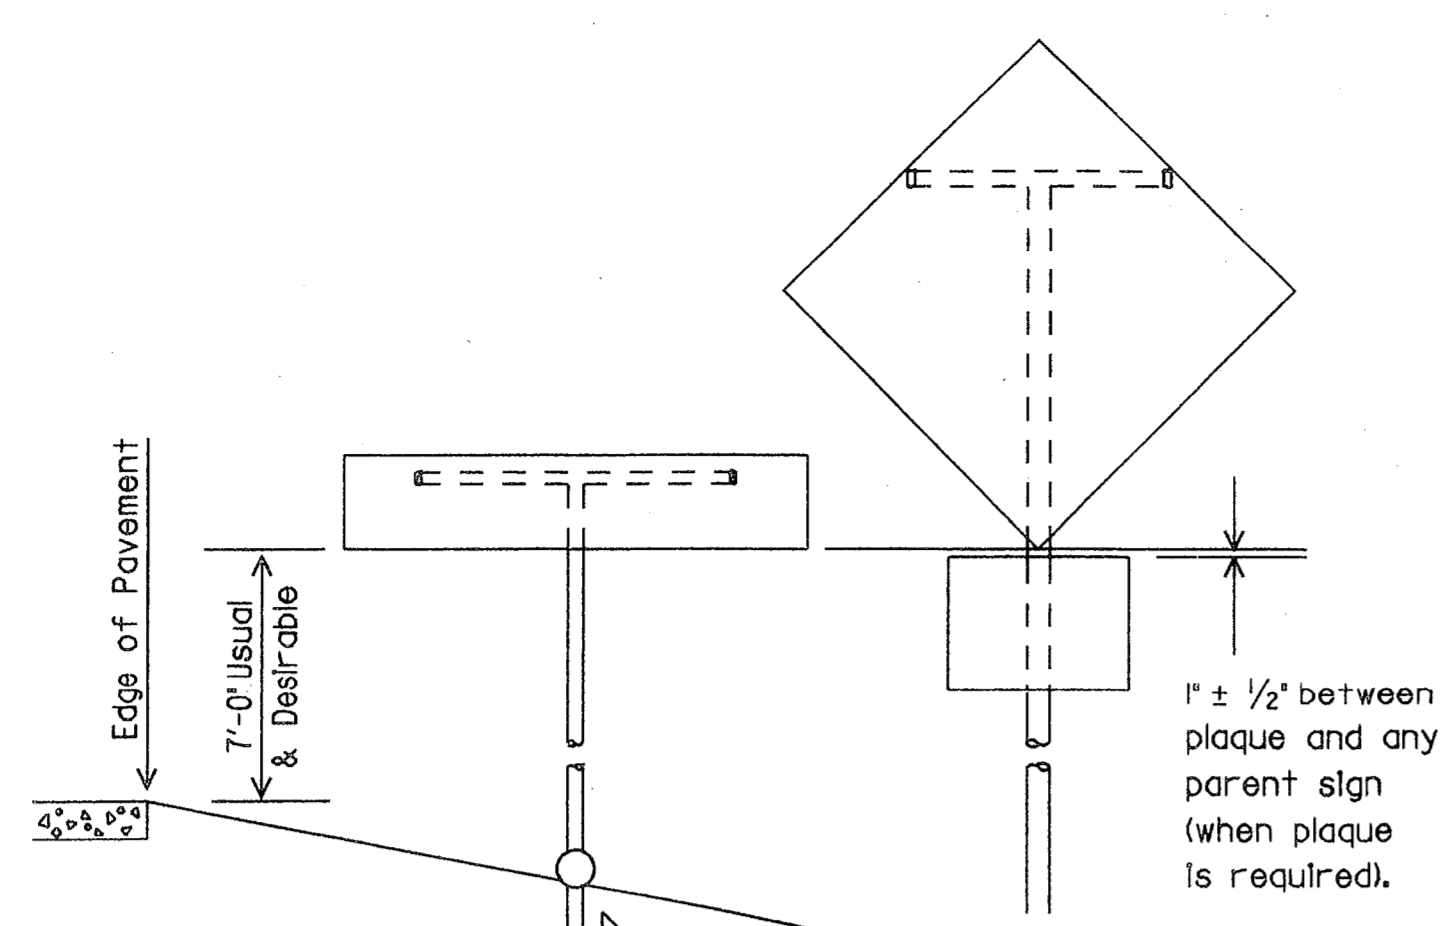


VERTICAL CLEARANCE OF SMALL SIGNS  
ALL TYPES OF ROADWAYS

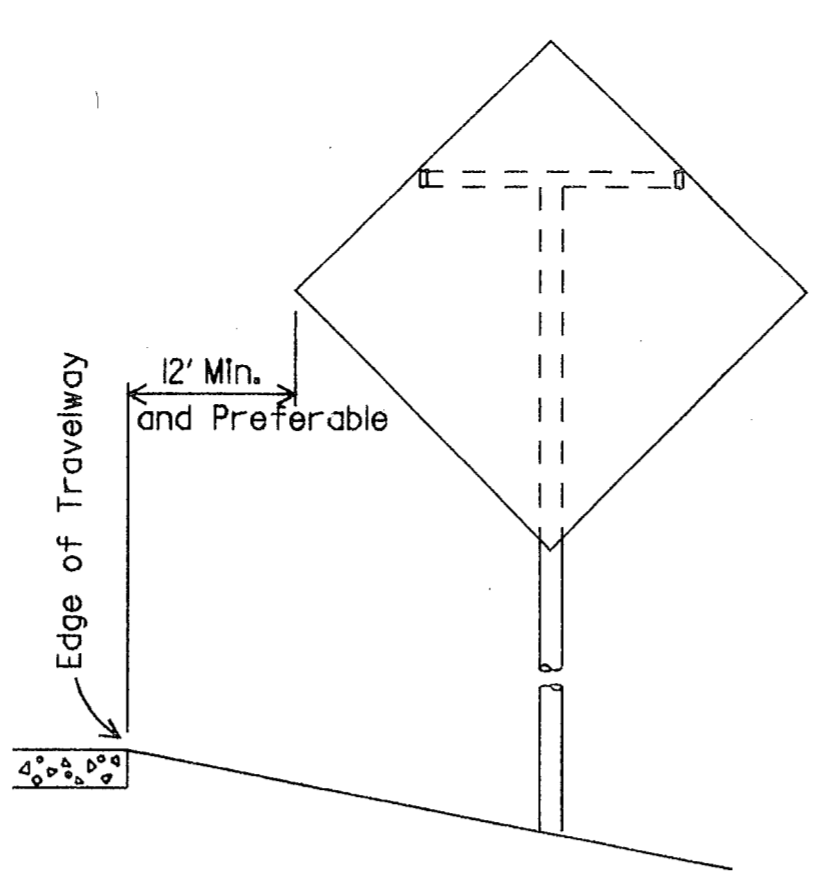


Rural Conventional Highway  
without shoulder.

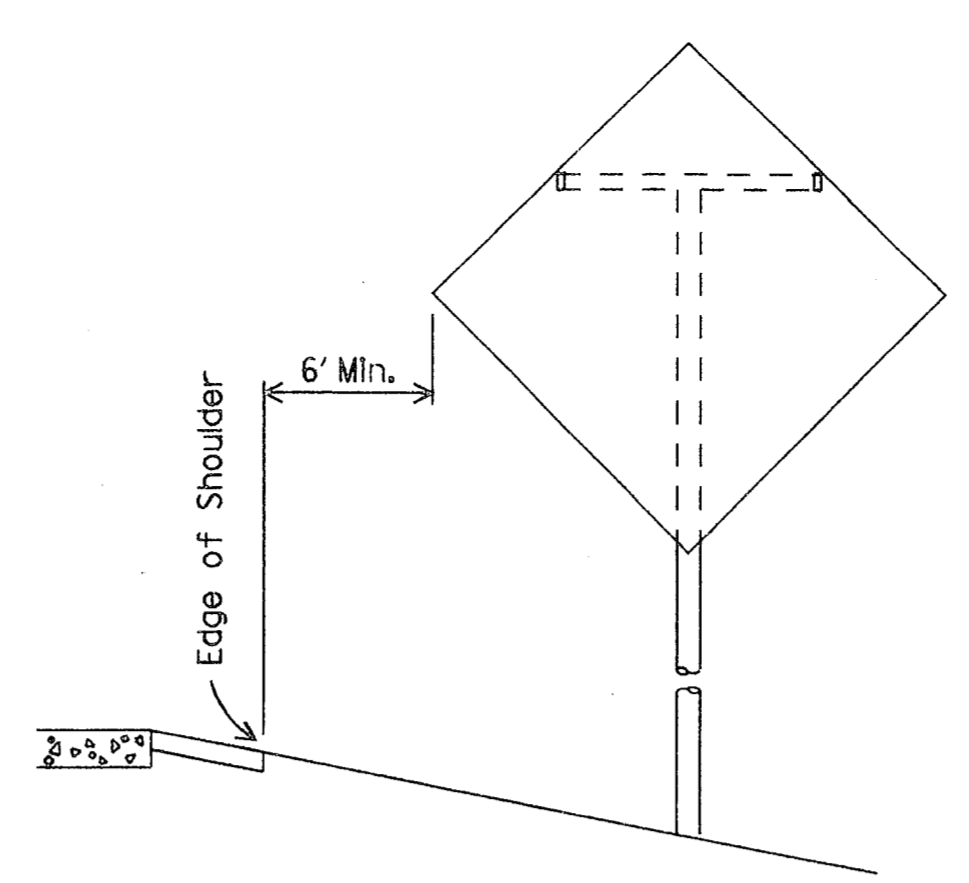

Rural Conventional Highway  
with shoulder.


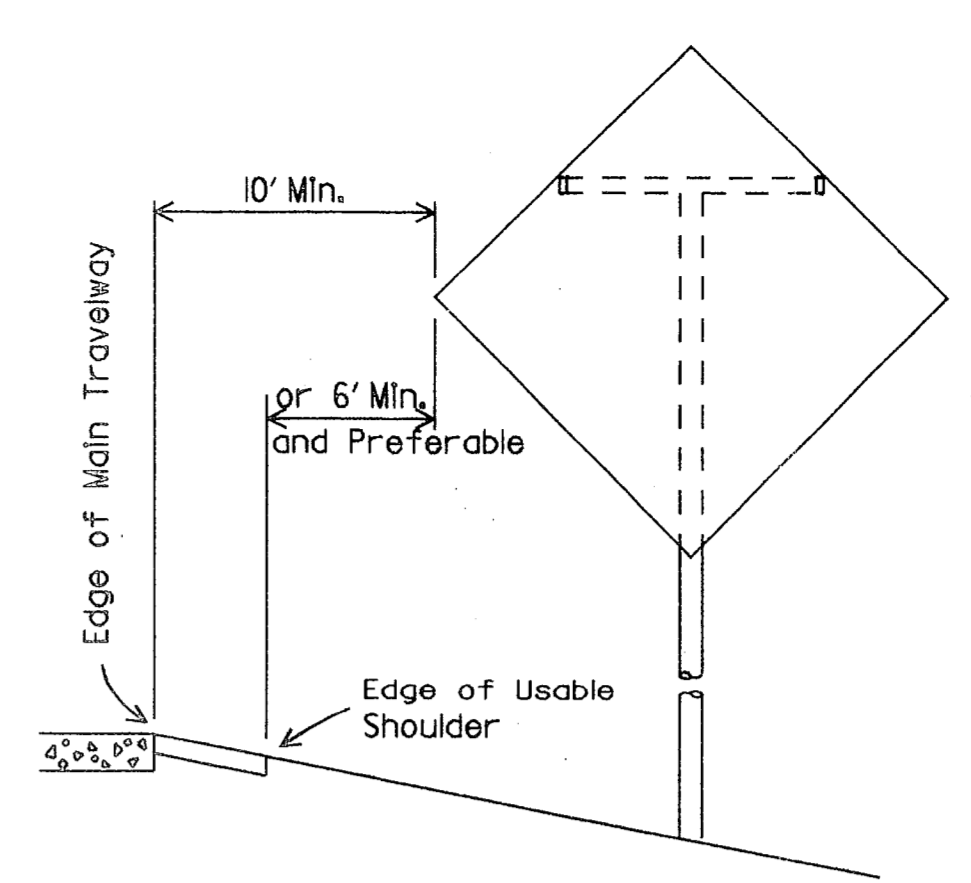


Expressways or Freeways  
without curb or with mountable curb.

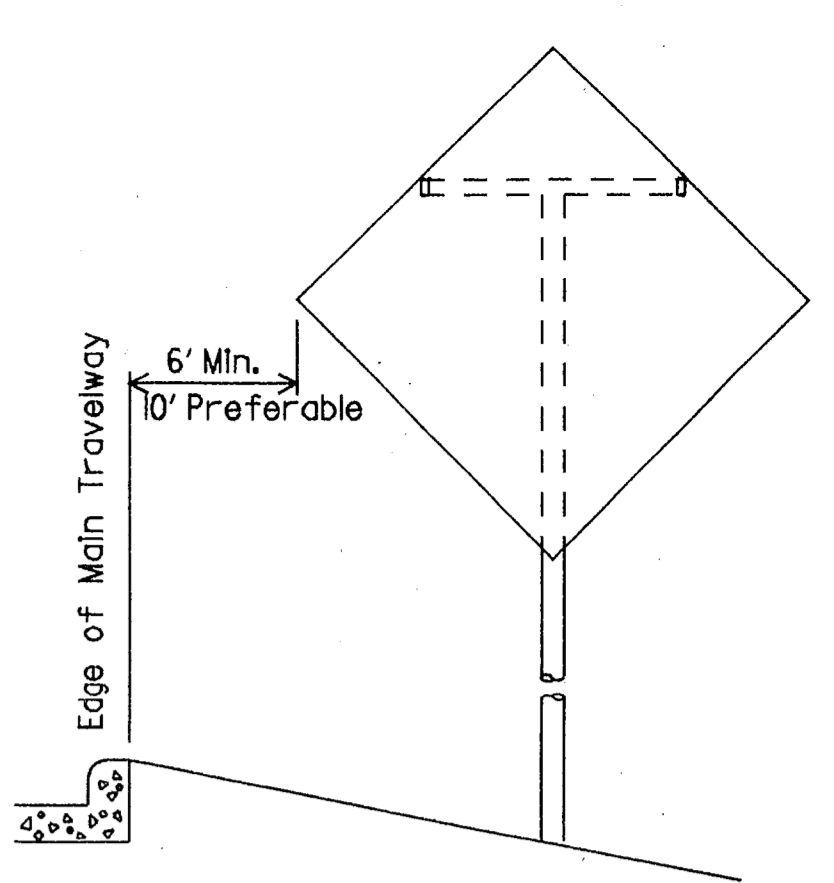


Expressways or Freeways  
with unmountable curb.

LATERAL CLEARANCE OF SMALL SIGNS  
TO THE RIGHT OR LEFT SIDE OF ROADWAY

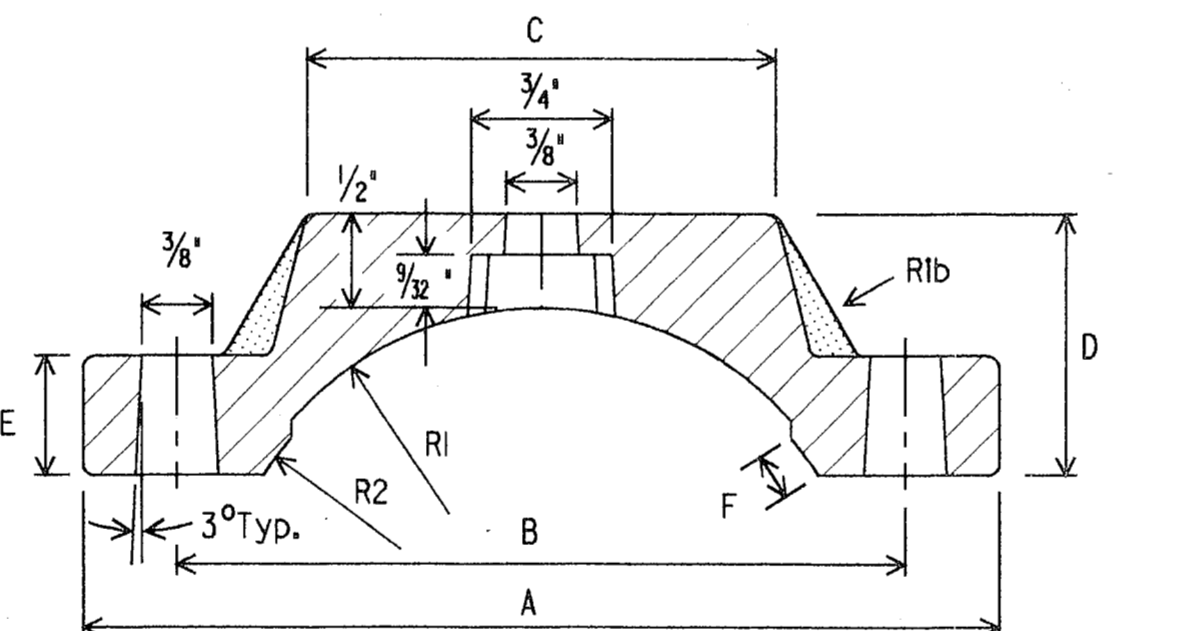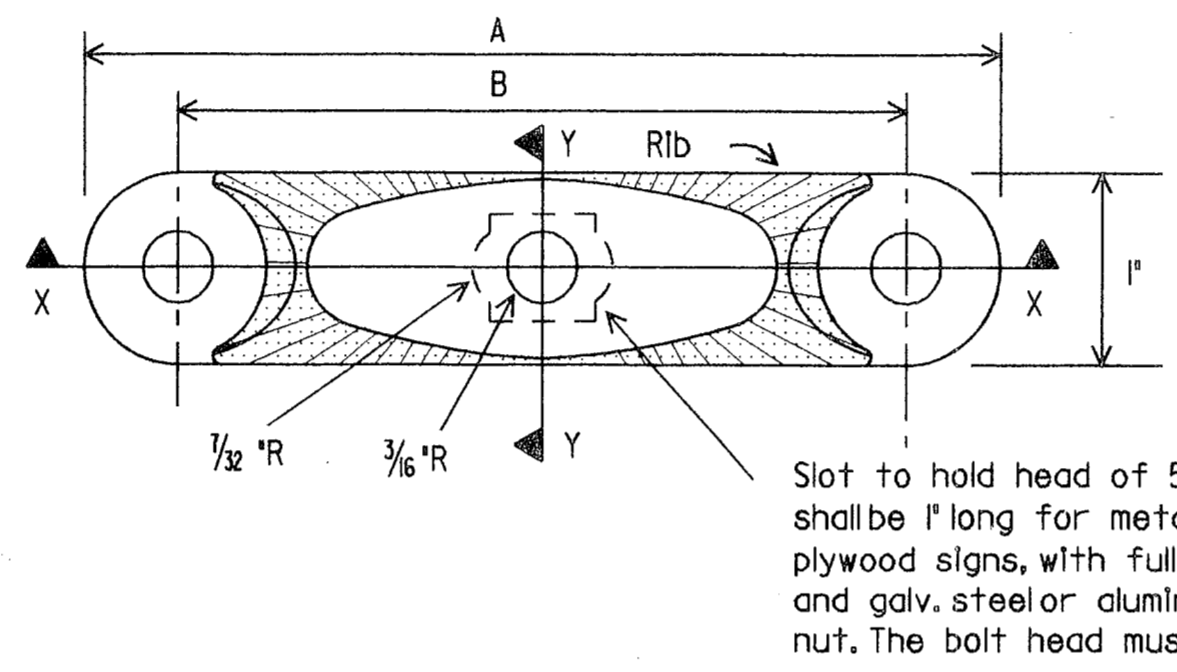

Section X-X

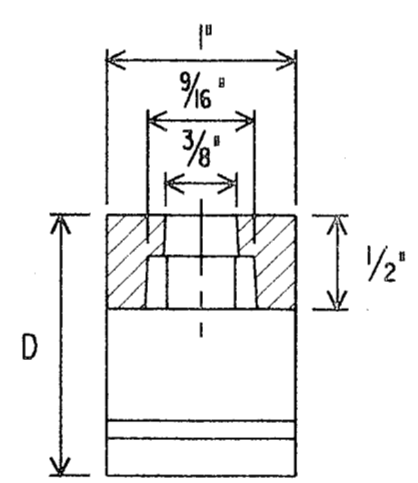

Section Y-Y

Pipe Clamp Casting

Pipe clamp casting shall be ASTM B26 or B108 aluminum alloy A444.0-T4 or 356.0-F.


All sign mounting clamp parts not made from aluminum shall be galvanized steel in conformance with ASTM A153 Class A or stainless steel.

Dimensions for Mounting Clamp

Standard Pipe Size	A	B	C	D	E	F	G	K	L	R1	R2
1/4	3 5/64	2 5/64	3/4	1 5/16	7/16	3/16	5/8	2 9/64	2 7/32	5/64	5 5/64
1/2	3 9/32	2 9/32	1	1 1/16	7/16	3/16	5/8	2 7/16	6 3/64	3/32	1 5/16
2	3 3/4	2 3/4	1 1/2	1 1/8	1/2	3/16	1	2 11/16	1 7/32	1 1/4	1 3/16
2 1/2	4 1/4	3 1/4	2	1 1/4	1/2	1/4	1	3 3/16	1 5/32	1 1/2	1 7/16
3	4 7/8	3 7/8	2 1/2	1 3/8	5/8	1/4	1	3 13/16	2 5/32	1 13/16	1 3/4

All dimensions shown are in inches.

MOUNTING CLAMP DETAILS

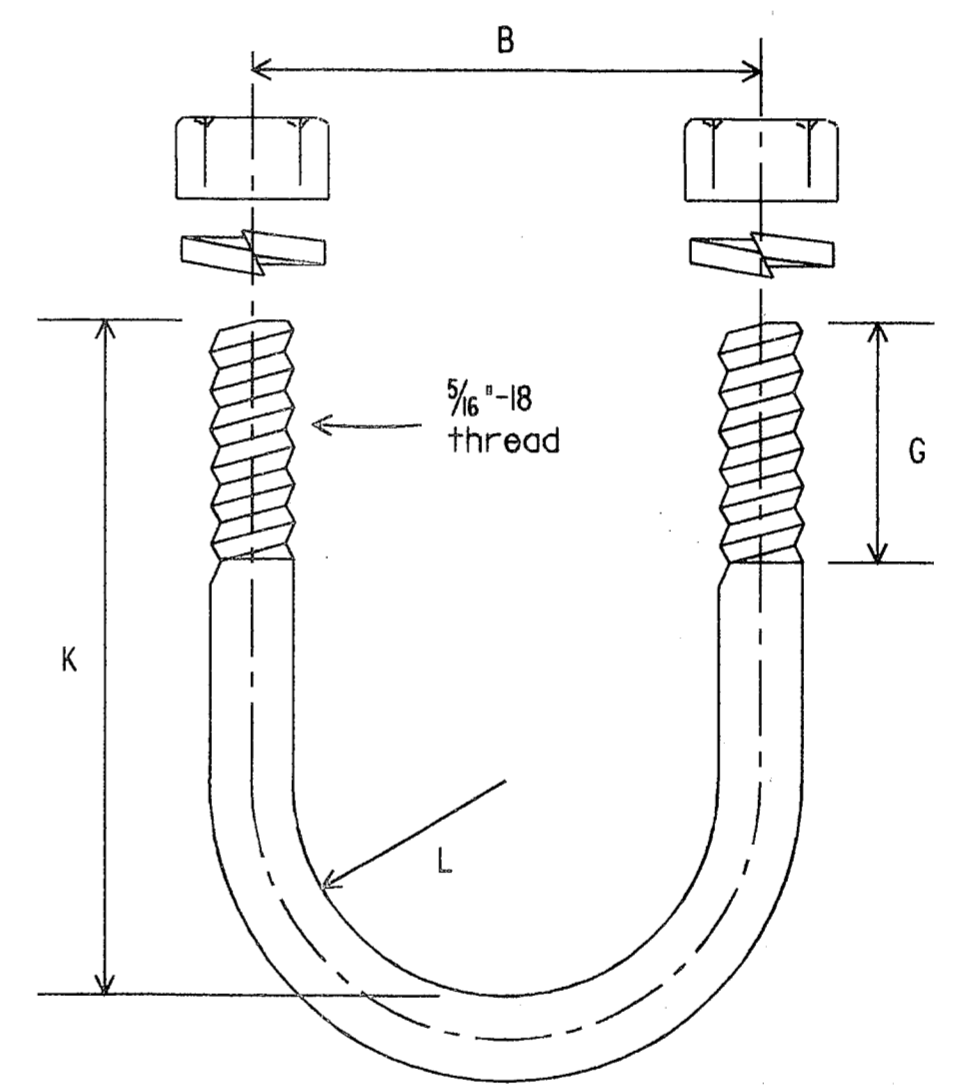


U-Bolt

U-Bolt to be made in accordance with standard manufacturing procedure. 9/32" dia. stock is permissible. American standard regular semi-finished hex. nuts and spring lockwashers.

GENERAL NOTES:

- All clearances apply to both rural and urban locations, except as noted.
- Where physical features of the roadway will permit, maximum lateral clearances are desirable. For frontage roads, ramps and other connecting roadways, lesser clearances may be used, but generally no less than six feet is recommended between the edge of the travelway and the edge of the sign. At intersections, signs should be positioned in the optimum location for viewing by traffic.
- Where necessary, the minimum allowable clearance of two feet may be used in urban locations on conventional highways.
- Where a sign is to be located behind guardrail, the allowable minimum clearance may be used, measured from the face of the guardrail to the near edge of the sign.
- Lateral clearances of signs mounted on left side of roadway are the same as shown above where space will permit.

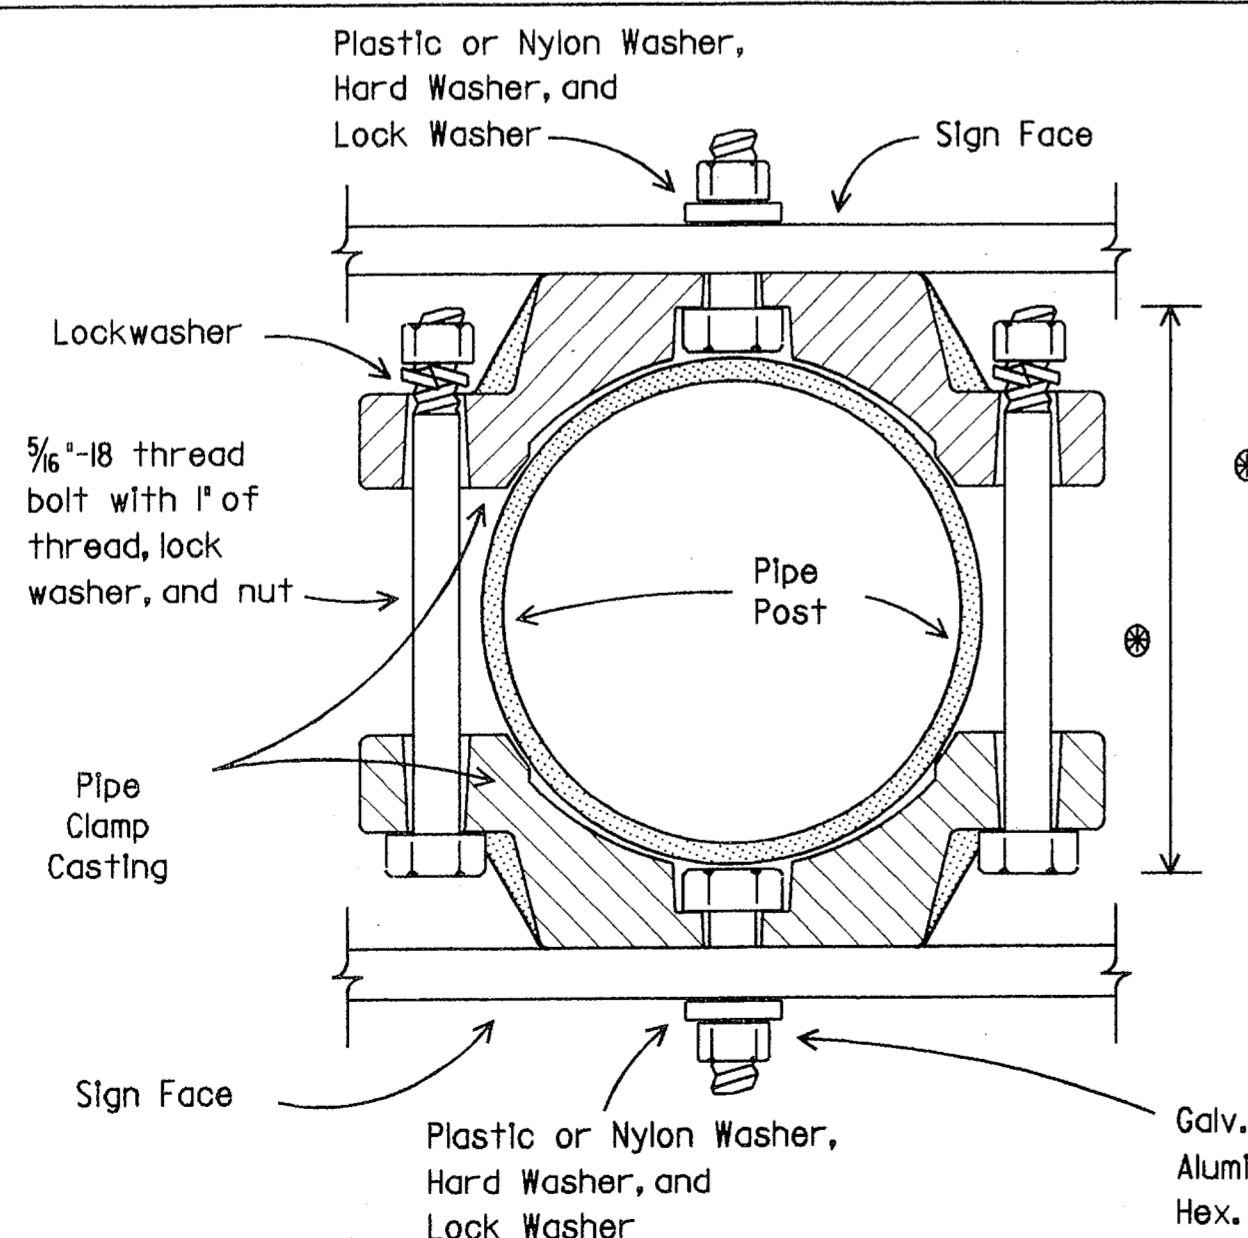

Typical Detail  
Back-to-Back Mounting of Signs

Approx. Bolt Length ~ Pipe Size


2 1/8"	1 1/4" Ø
2 3/8"	1 1/2" Ø
2 5/8"	2" Ø
2 7/8"	2 1/2" Ø
3 1/8"	3" Ø

Bolt length to be adjusted to fit field conditions.

DATE: 12/25/99  
 1 2 3 4 5 6 7 8 9 10 11 12 13 14 15 16  
 UN:HLR CK:JCW DW:DN CK:MT  
 FILE: 495051 52523 53455 54567 55568 56569 57568 58567 99526

FINAL RECORD  
DRAWING  
Date: 12/25/99

ISSUE DATE: 12-02-96

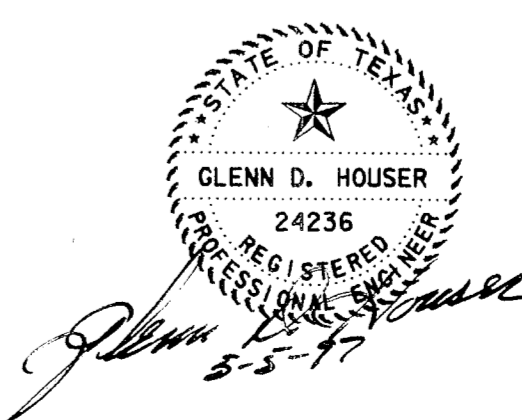

STANDARD PLANS  
TEXAS DEPARTMENT OF TRANSPORTATION  
Traffic Operations Division


SIGN MOUNTING DETAILS-  
SMALL ROADSIDE SIGNS  
SMD(1-2)-95 (MOD.)

ORIG. DRAW DATE: August 1995  
 REVISIONS: 11-96 Δ

STATE DISTRICT	FEDERAL REGION	FEDERAL AID PROJECT	SHEET
6			
COUNTY	CONTROL	SECTION	JOB


268

# TRIANGULAR SLIP BASE DETAILS

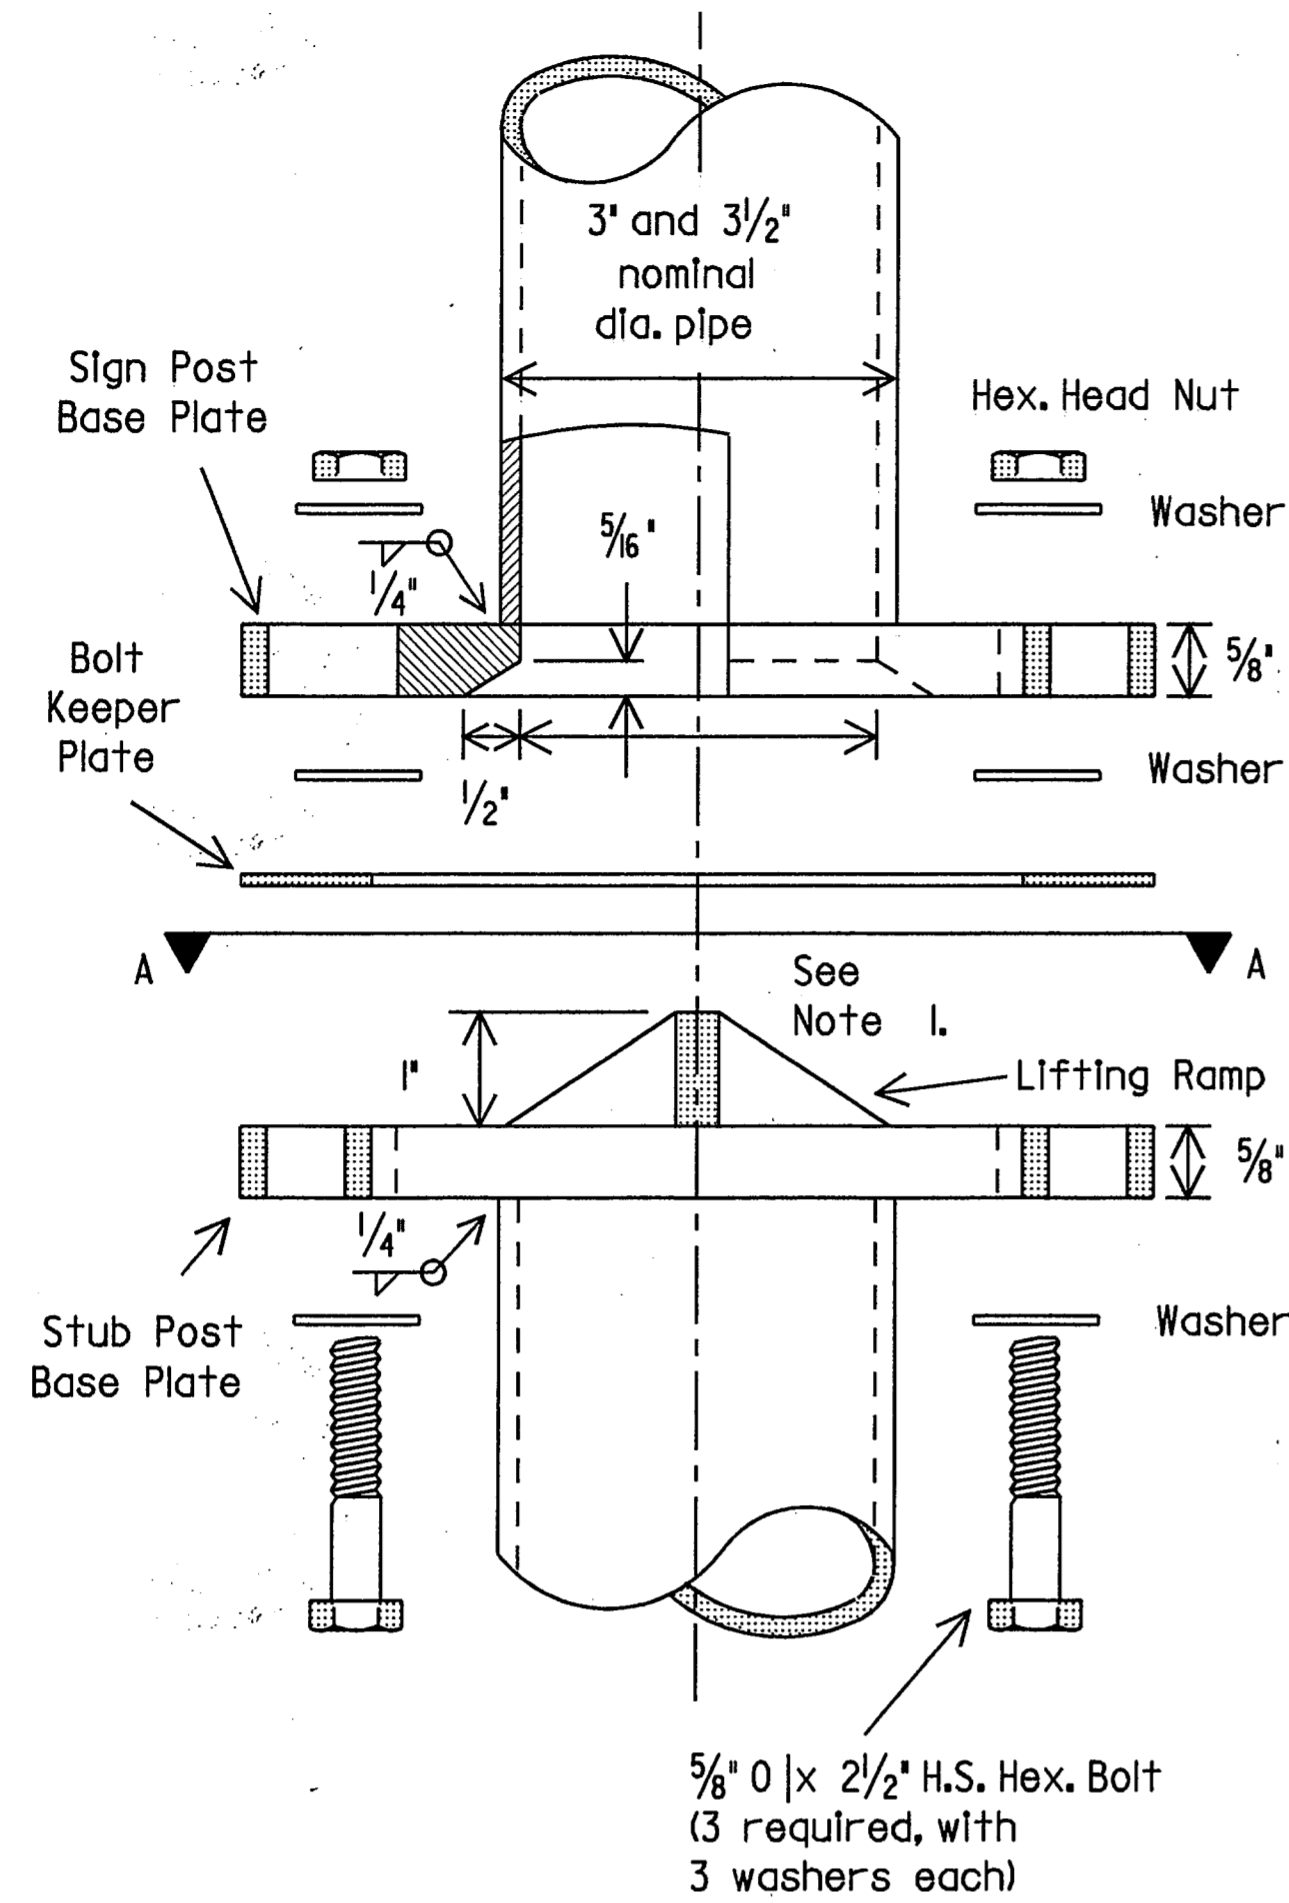

SIGN POST & STUB POST ELEVATION

The bevel end shall be tangent to the bolt hole. Any misalignment shall be corrected by grinding. Face of bevel shall be finished to a minimum smoothness of f=500.

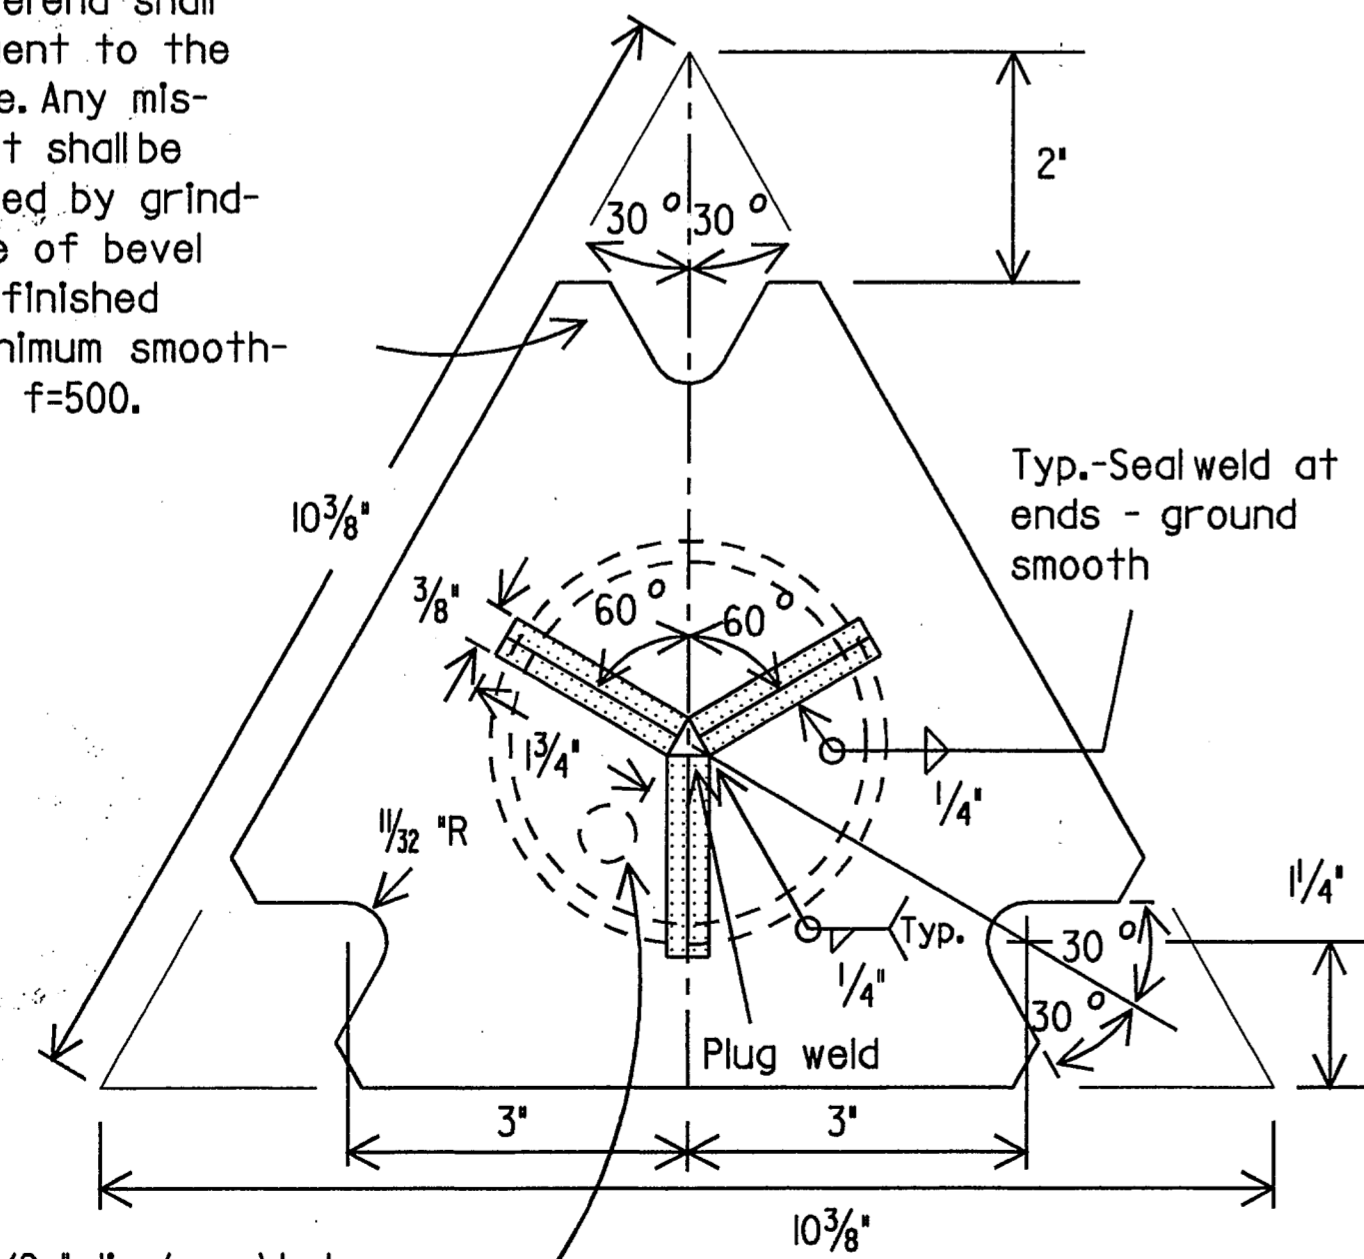

VIEW A-A

Provide 1/2" dia. (max.) hole in the Stub Post Base Plate within the inside radius of the stub post for galvanized drainage.


## TRIANGULAR SLIP BASE NOTES:

- The lifting device may consist of welded ramps or a conical shape formed into the center of the Stub Post Base Plate.
- The Sign Post Base Plate of the Triangular Slip Base shall have the same exterior dimensions as the bottom plate. The lifting device shall be a part of the Stub Post Base Plate only. A hole equal to the inside diameter of the Sign Post shall be cut through the center of the Sign Post Base Plate with the hole edge beveled as detailed.
- The Base Plates and Lifting device shall conform with the requirements of ASTM A36 or A572 Grade 50.
- All structural steel shall be galvanized in accordance with ASTM A123. The entire support shall be galvanized from the top down to a minimum depth of 6 inches into the foundation. All nuts, bolts and washers shall be galvanized in accordance with ASTM Designation: B695 Class 50 or A153 Class C or D.
- All high strength bolts shall conform to ASTM A325 (ASTM A449 may be substituted for ASTM A325 provided proper bolt head, nut and/or washer clearances are maintained). All high strength nuts shall be of such capacity as to develop the bolt strength.


## BOLTING PROCEDURE FOR ASSEMBLY OF BASE CONNECTION:

- Assemble Sign Post, Bolt Keeper Plate and Stub Post with bolts and three flat washers per bolt as shown.
- Shim as required to plumb post.
- Tighten all bolts the maximum possible with a 12 to 15 inch wrench to clean bolt threads and to bed washers and shims.
- Loosen each bolt in sequence and retighten bolts in a systematic order to the prescribed torque of 440 to 450 inch pounds or 36 to 38 foot pounds. DO NOT OVERTIGHTEN.
- To prevent nut loosening, burr threads of bolt at junction with nut using a center punch.

## WELDED PIPE MOUNT DETAILS

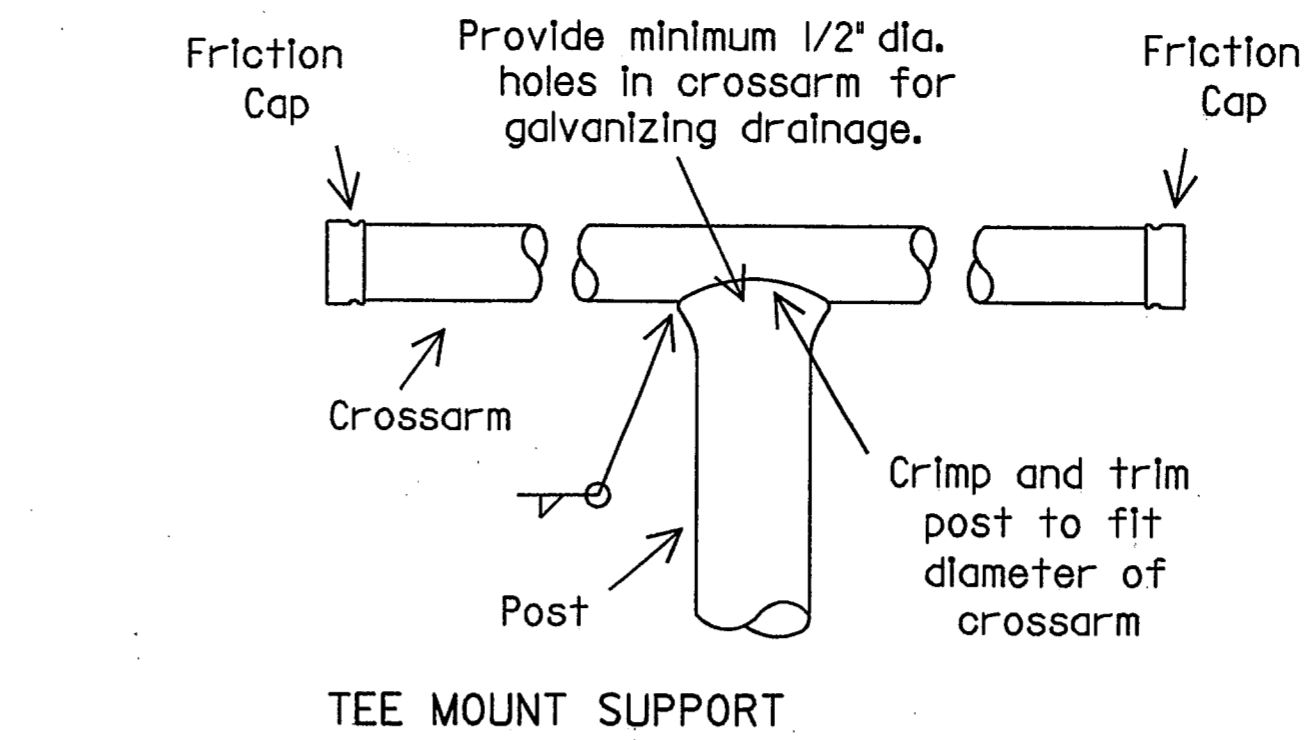


TEE MOUNT SUPPORT

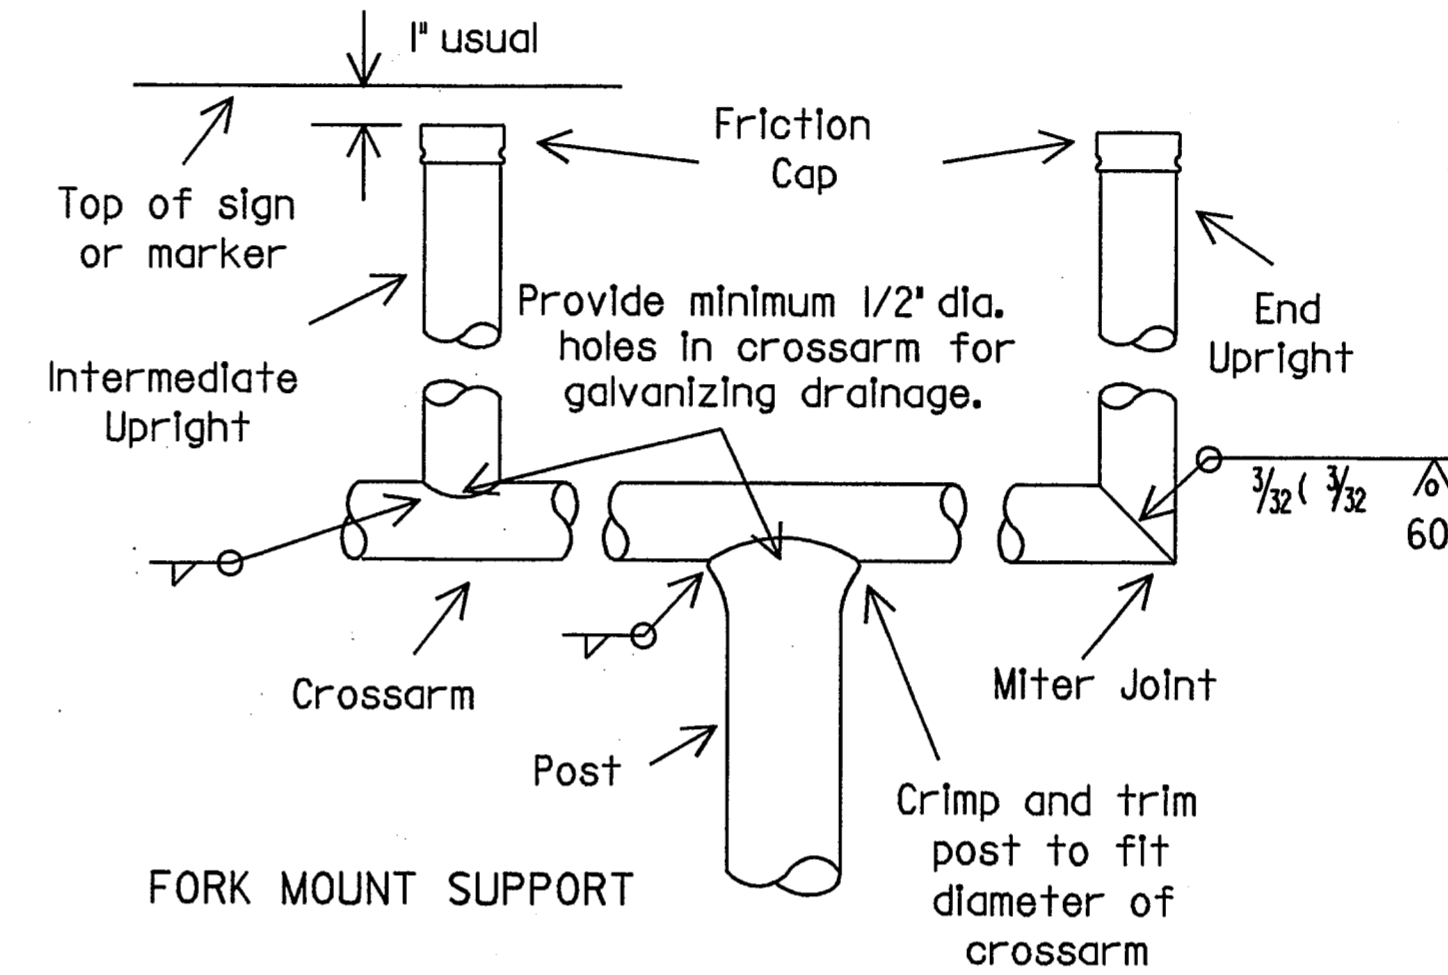

FORK MOUNT SUPPORT

The contractor at his option may furnish standard weight pipe conforming to ASTM Specification A53 Grade B, A501 or any other standard weight steel pipe. Pipe may be of either electric resistance welded or seamless type, with a minimum yield strength of 35,000 PSI and a minimum elongation of 15 percent in 2 inches. Pipe shall have outside diameters and wall thicknesses which are equivalent to or better than those specified hereon.


All pipes to be welded shall be of weldable quality.

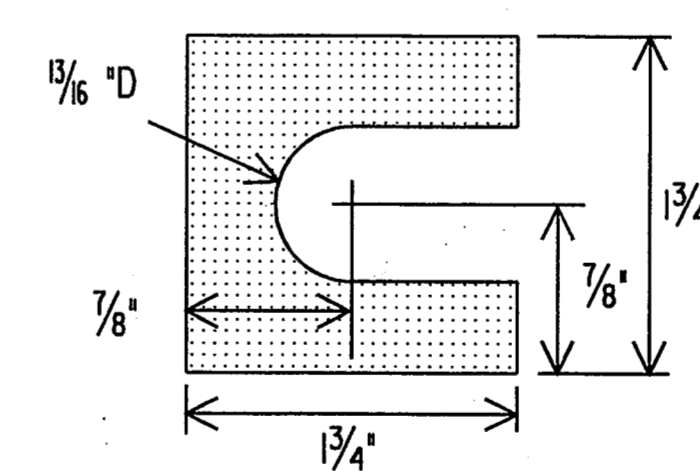

SHIM

Furnish two .012" thick and two .032" thick shims per post. Shims shall be fabricated from brass shim stock or strip conforming to ASTM B36.

## FRICITION CAP DETAIL

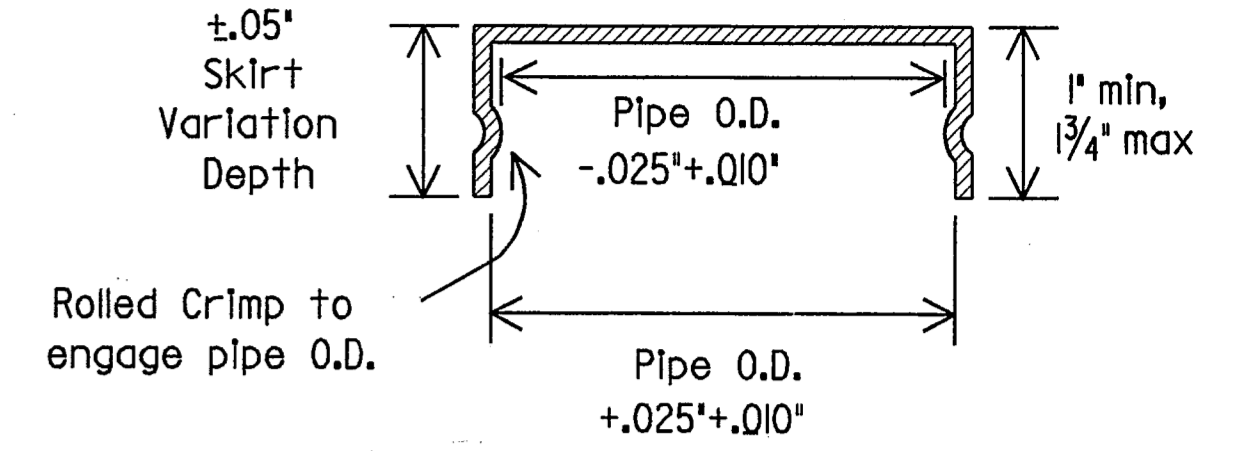

Friction caps may be manufactured from hot rolled or cold rolled steel sheets. The minimum sheet metal thickness shall be 24 gauge for all cap sizes.

The rim edges shall be reasonably straight and smooth. Caps shall be sized and formed in such a manner as to produce a drive-on friction fit and have no tendency to rock when seated on the pipe. The depth shall be sufficient to give positive protection against entrance of rainwater. They shall be free of sharp creases or indentations and show no evidence of metal fracture.

Caps shall have an electrodeposited coating of zinc in accordance with the requirements of ASTM B633 Class FE/ZN 8.

## GENERAL NOTES:

Support and design shall conform with AASHTO Standard Specifications for structural supports of Highway signs, luminaires and traffic signals with a design wind speed of 60 mph.

Steel pipe shall be galvanized in accordance to ASTM Designation A123.

FINAL RECORD  
DRAWING  
Date: 12/25/99

STANDARD PLANS  
TEXAS DEPARTMENT OF TRANSPORTATION  
Traffic Operations Division

SIGN MOUNTING DETAILS-  
SMALL ROADSIDE SIGNS  
SMD(1-3)-95



ORIG. DATE:	August 1995	DR: LR	CR:	DR: DN	CR:	REV. NO.:
REVISIONS						
STATE DISTRICT	FEDERAL REGION	FEDERAL AID PROJECT			SHEET	
6					45	
COUNTY	CONTROL	SECTION	JOB	HIGHWAY		

DATE:	12/25/99
LEVELS DISPLAYED:	1 2 3 4 5 6 7 8 9 10 11 12 13 14 15 16 17 18 19 20 21 22 23 24 25 26 27 28 29 30 31 32 33 34 35 36 37 38 39 40 41 42 43 44 45 46 47 48 49 50 51 52 53 54 55 56 57 58 59 60 61 62 63

DNLR  
CK: CW  
DW: DN  
CK: MT


DATE: 11-26-96  
FILE: 11-26-96  
DRAWING: 11-26-96  
PROJECT: 11-26-96  
JOB: 11-26-96  
SECTION: 11-26-96  
COUNTY: 11-26-96  
HIGHWAY: 11-26-96

**BREAKAWAY PIPE COLLAR COUPLING**

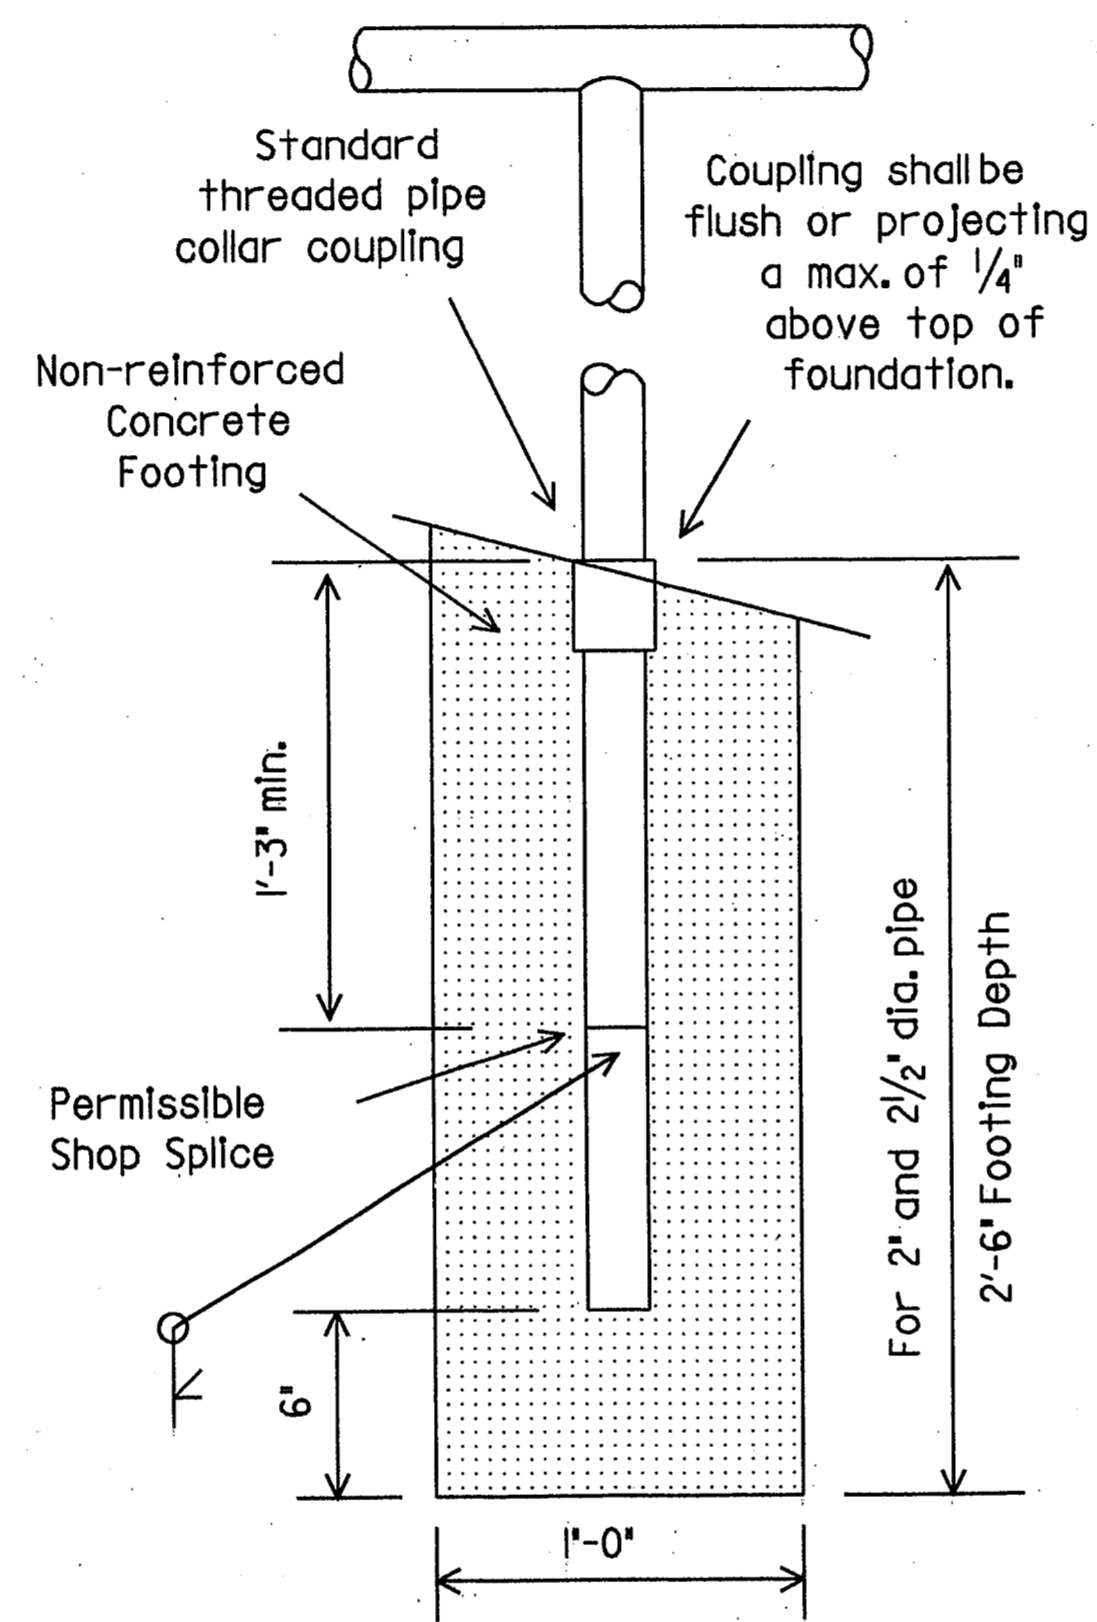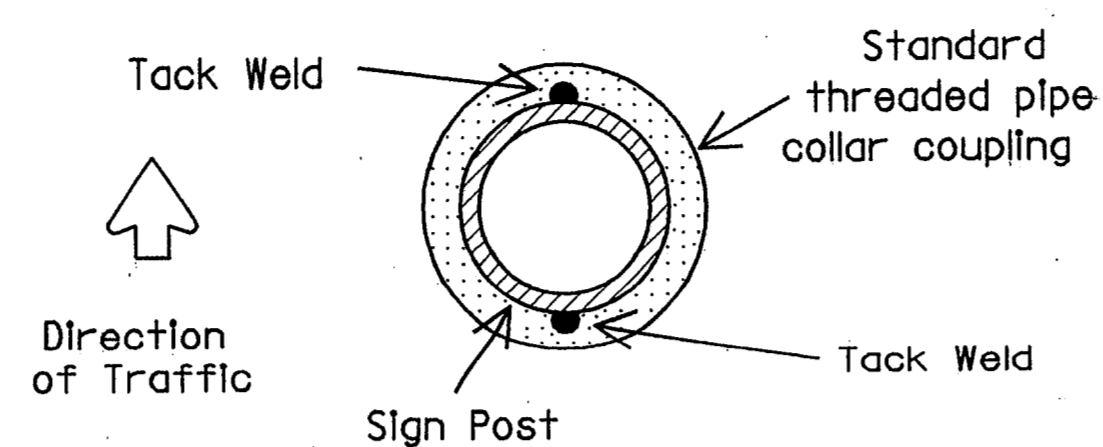


Pipe collar coupling shall be used for all signs supported on 2' and 2 1/2' diameter pipe post.

**TRIANGULAR SLIP BASE**

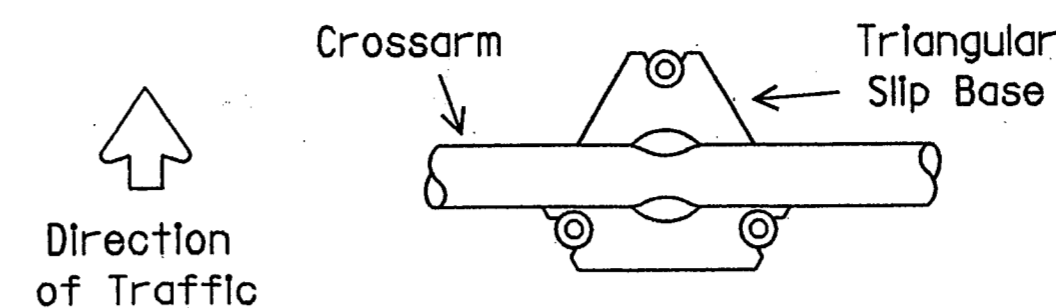

Triangular slip base shall be used for 3' and larger pipe posts. The crossarm should be parallel to one side of the triangular slip base.

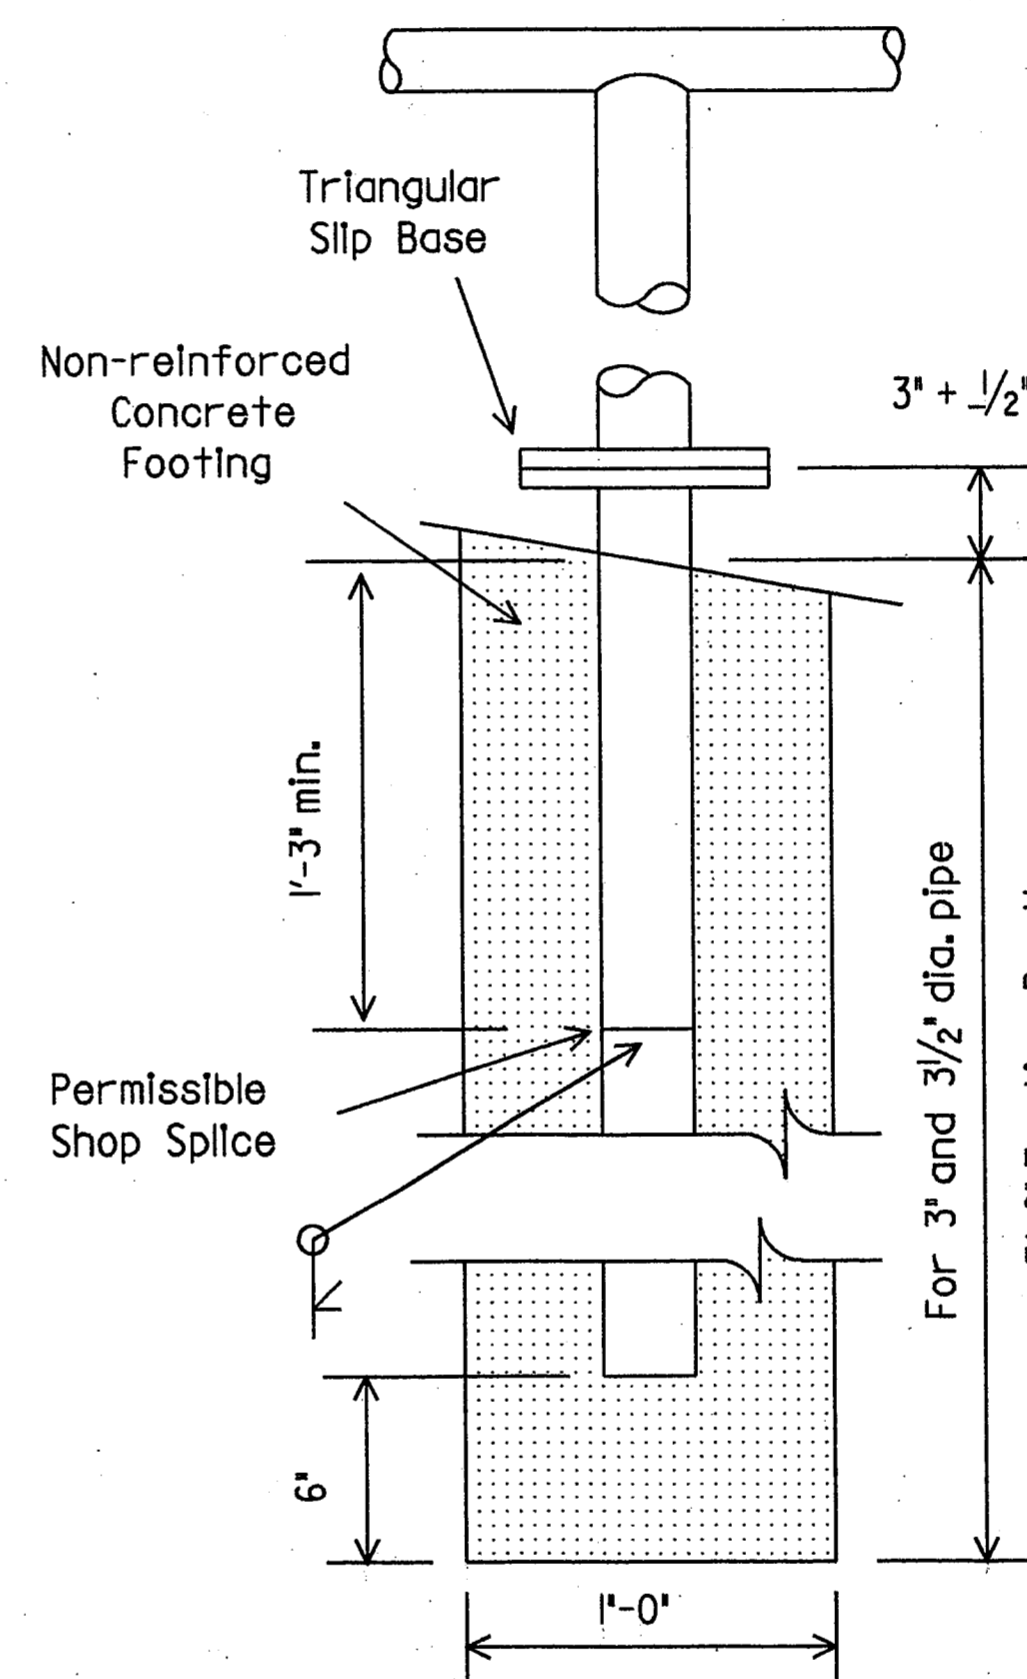

Triangular Slip Base shall be used for signs supported on 3' diameter and larger pipe posts.

**GENERAL NOTES:**


Support and design shall conform with AASHTO Standard Specifications for structural supports of Highway signs, luminaires and traffic signals with a design wind speed of 60 mph.

Steel pipe shall be galvanized in accordance to ASTM Designation A123.

Where solid rock is encountered at ground level, the foundation shall be a minimum depth of 18 inches. When solid rock is encountered below ground level, the foundation shall extend into the solid rock a minimum depth of 18 inches or provide a minimum foundation depth of 30 inches. Δ

**FINAL RECORD DRAWING**  
Date: 12/25/99


ISSUE DATE: 11-26-96

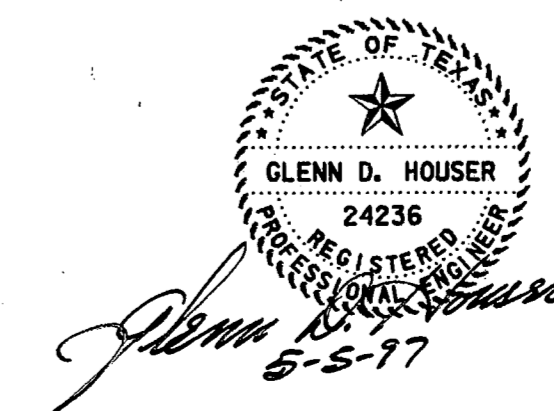


**STANDARD PLANS**  
TEXAS DEPARTMENT OF TRANSPORTATION  
Traffic Operations Division

**SMALL ROADSIDE SIGN FOUNDATION DETAILS**  
SMD(I-4)-95 (MOD.)

ORIG DRAW DATE: August 1995	DN: LR	CK: LR	DR: DN	CR: LR	REG NO: 46
REVISIONS	STATE DISTRICT	FEDERAL REGION	FEDERAL AID PROJECT		SHEET
11-96 Δ	6				46
	COUNTY	SECTION	JOB	HIGHWAY	

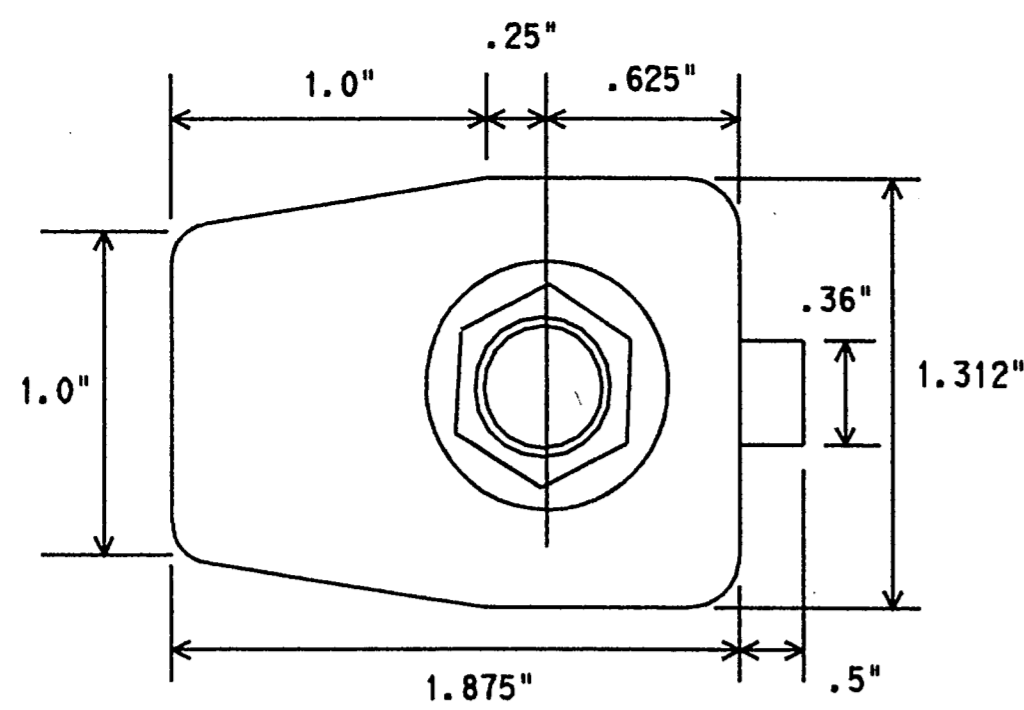


PLAN

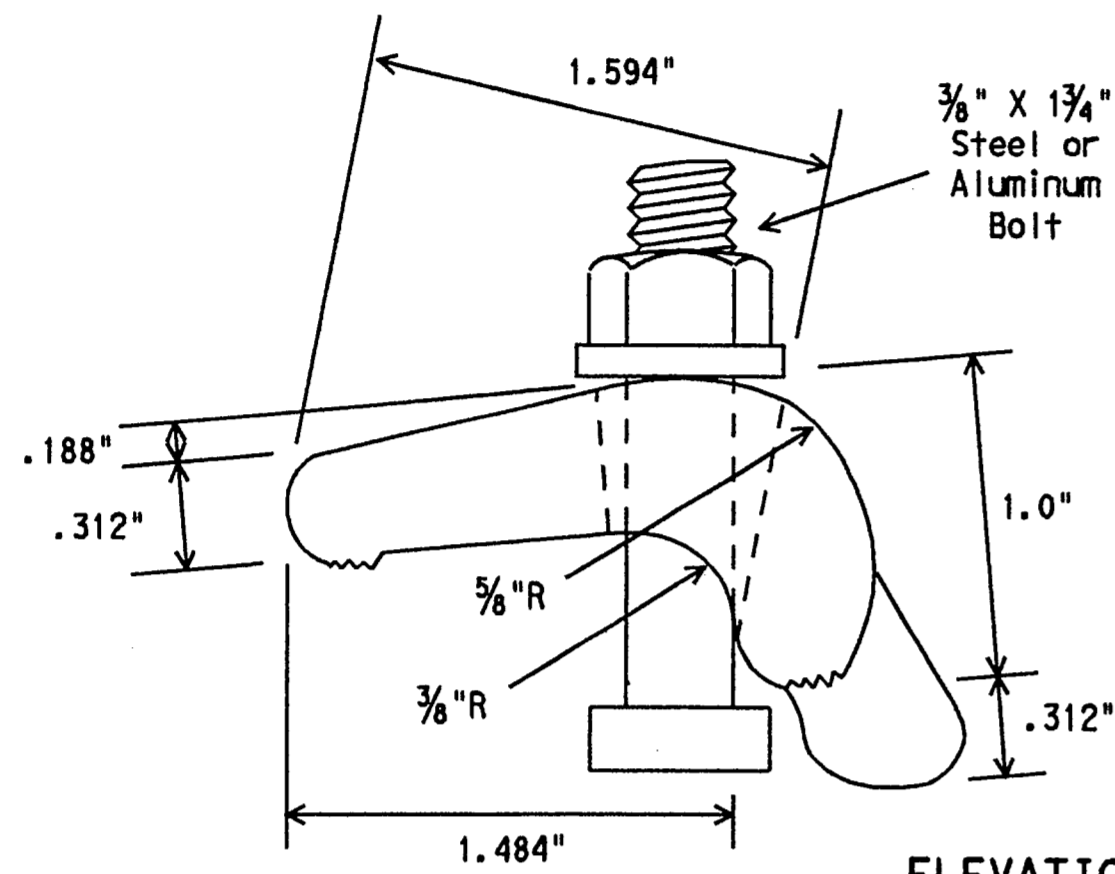


ELEVATION

ALTERNATE POST CLAMP DETAIL

NOTE: centerline of hole for 3/8" diameter squarehead bolt x 2 1/4" long with a flat washer and self-locking nut, or lock washer and hex. nut. Bolt head dimensions shall be in accordance with ANSI B 18.2.1 as referred to in the AISC Manual of steel construction. Bolt assembly shall be galvanized.

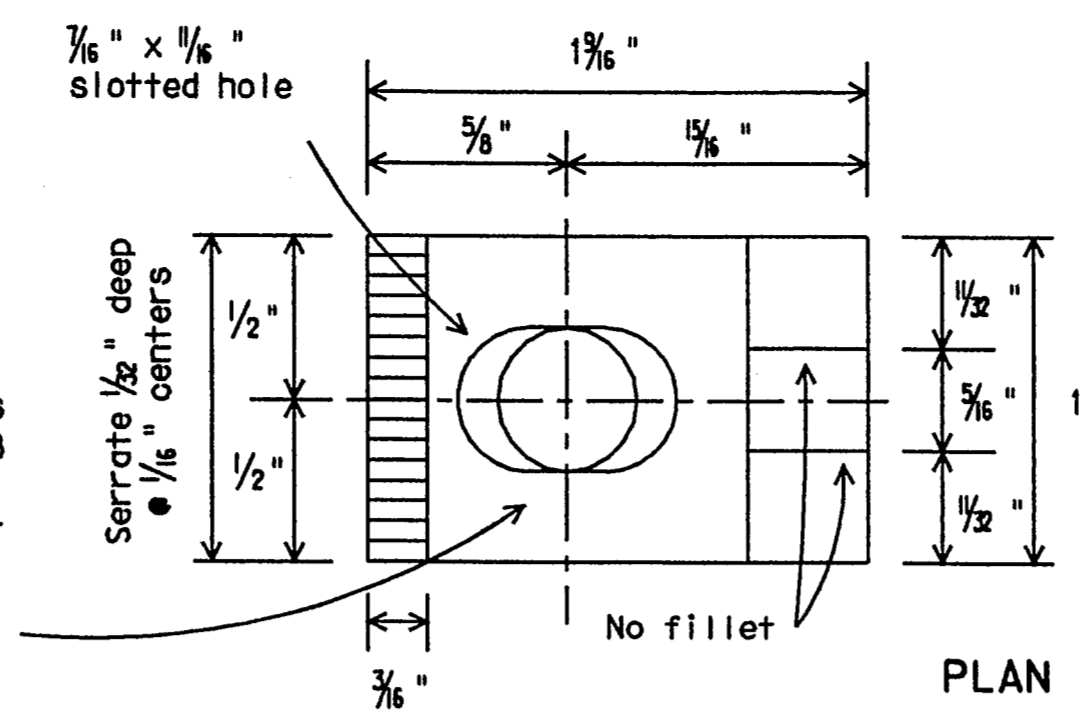


PLAN

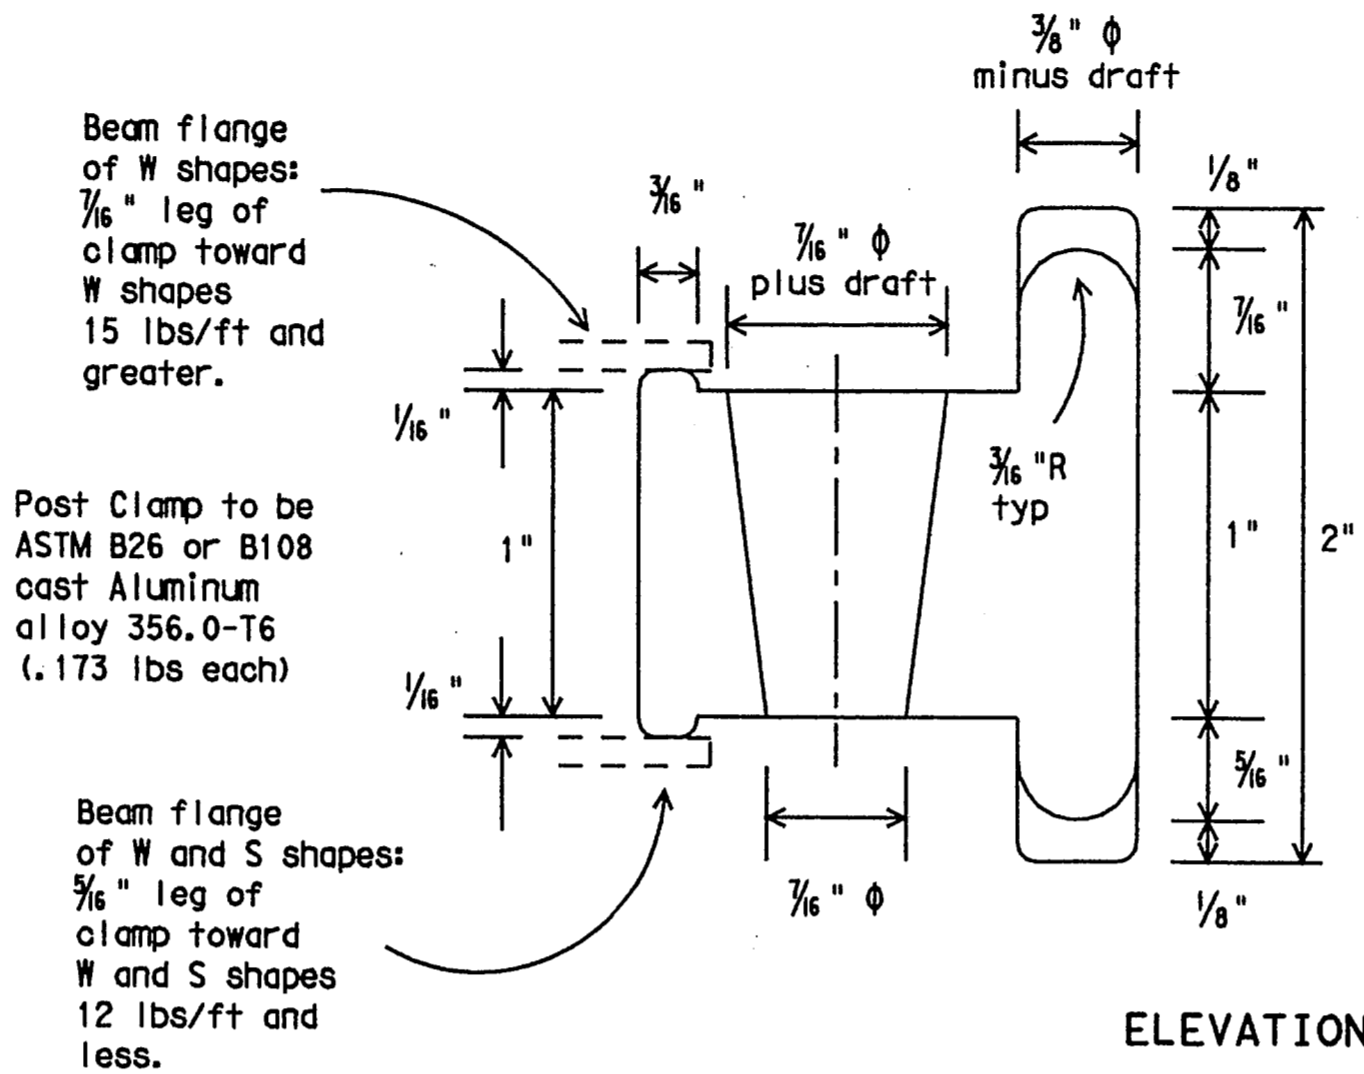

ELEVATION

POST CLAMP DETAIL

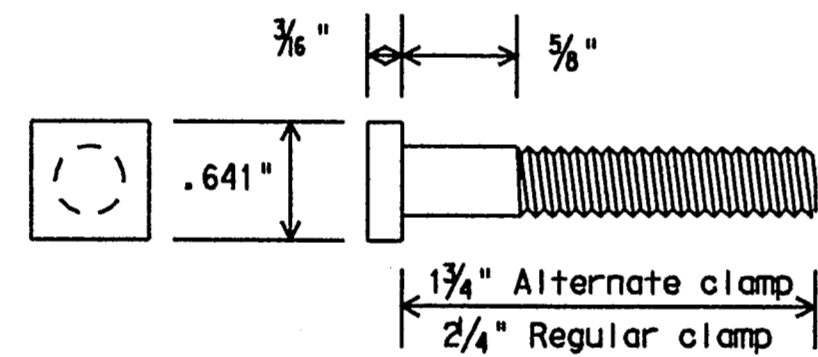


POST CLAMP BOLT DETAIL


WIND BEAM TABLES

For sign widths not in whole foot increments, select next larger sign width from tables for maximum wind beam spacing.  
 Example: Sign Code = 120, Sign Width = 14'6" → select 15' Sign Width  
 Max. Wind Beam Spacing = 3'0"

CODE

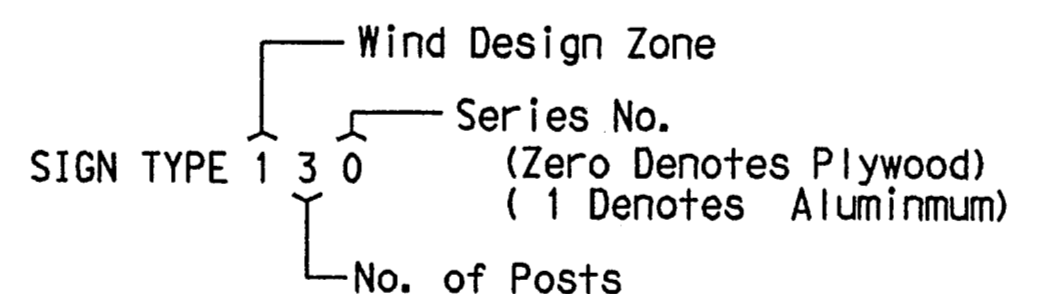

Zone	Sign Width (W)	Two Posts (120)							Three Posts (130)								
		4' thru 12'	13'	14'	15'	16'	17'	18'	19'	20'	21'	22'	23'	24'	25'	26'	27'
ZONE 1 (Types 100)	Max. Wind Beam Spacing	4'-0"	3'-8"	3'-4"	3'-0"	2'-8"	2'-4"	2'-0"	4'-0"	3'-9"	3'-6"	3'-3"	3'-0"	2'-9"	2'-6"	2'-3"	2'-0"
ZONE 2 (Types 200)	Sign Width (W)	4' thru 16'					17'	18'	19' thru 24'				25'	26'	27'	28'	
	Max. Wind Beam Spacing	4'-0"					3'-9"	3'-6"	4'-0"				3'-9"	3'-6"	3'-3"	3'-0"	
ZONE 3 (Types 300)	Sign Width (W)	4' thru 18'							19' thru 28'								
	Max. Wind Beam Spacing	4'-0"							4'-0"								

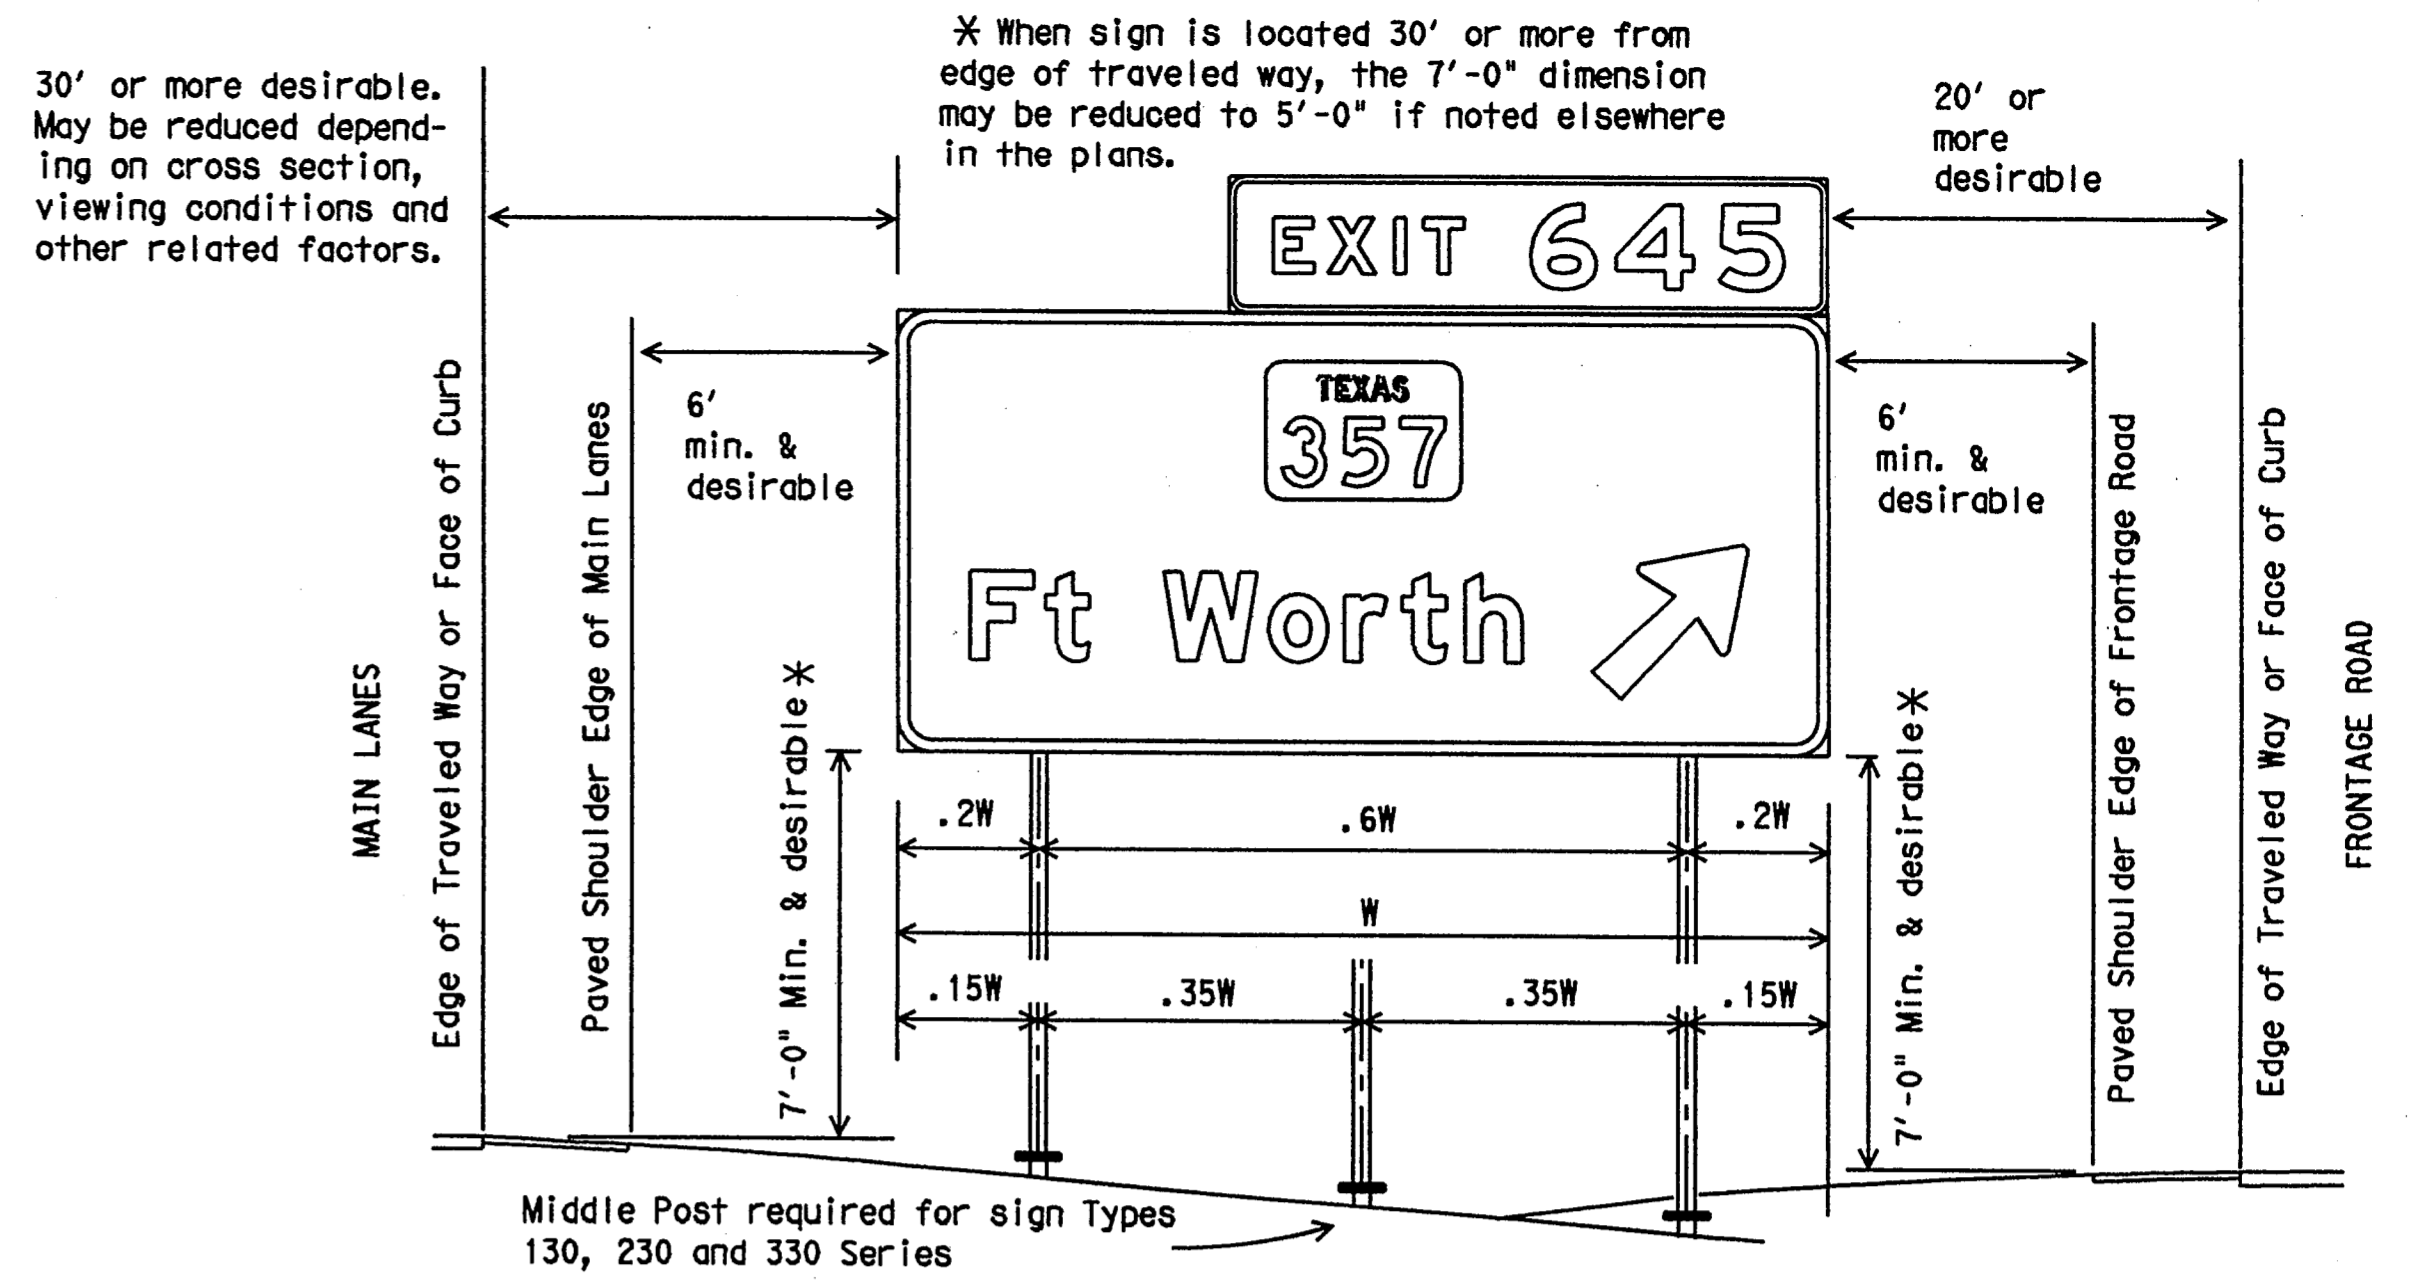


TYPICAL SIGN INSTALLATION AND LOCATION

LATERAL CLEARANCE NOTES:

Lateral clearances of signs mounted on median side of main lanes are the same as shown above where space will permit.  
 Where a sign is to be located behind guardrail, an allowable minimum clearance of two feet may be used, measured from the face of the guardrail to the near edge of sign.

POST SPACING NOTES:

Post spacing on a two post sign may vary a maximum of plus or minus 10% of total sign width to fit field conditions.  
 Post spacing on a three post sign may vary a maximum of plus 5% of total sign width to fit field conditions.

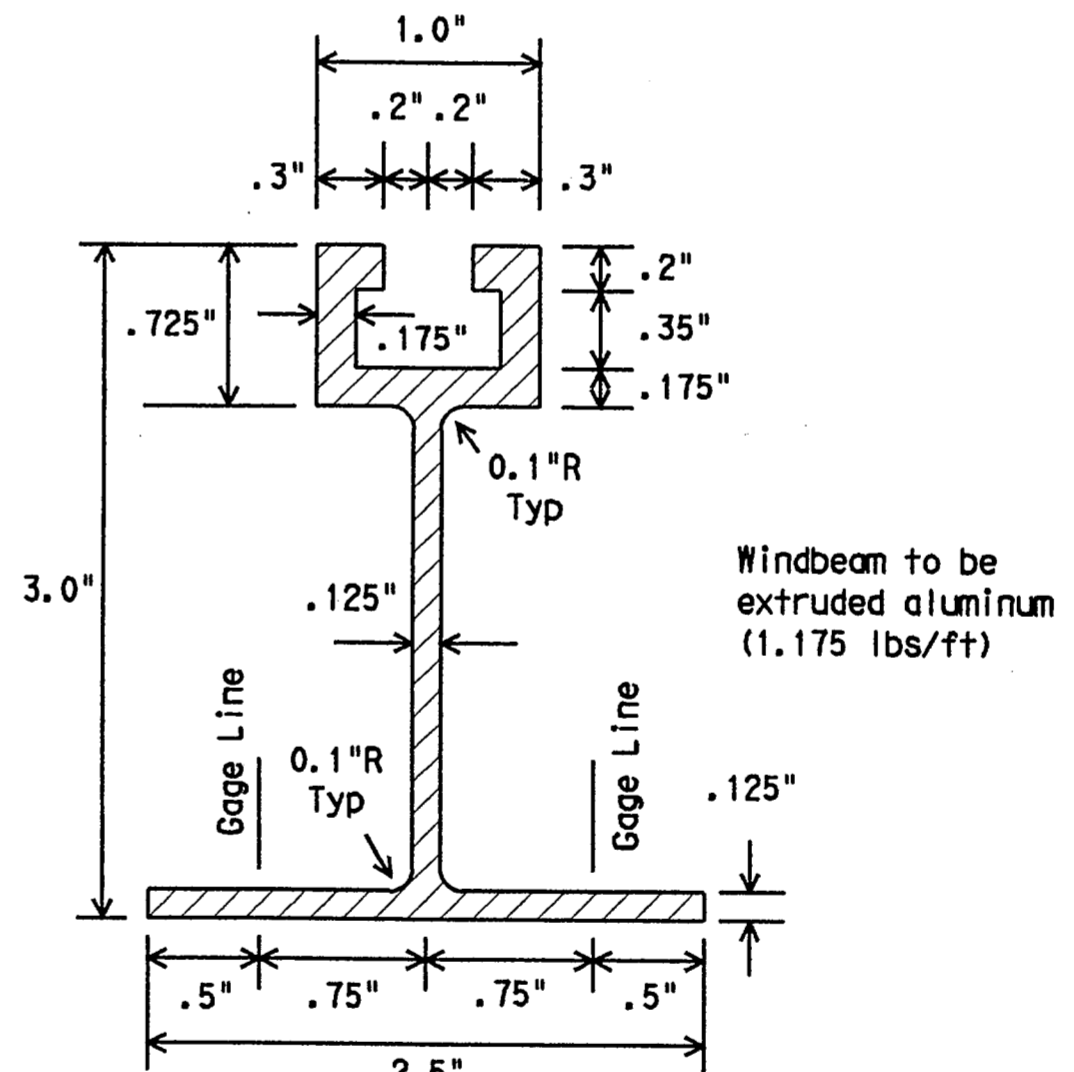

WINDBEAM CROSS SECTION

SPECIFICATION REFERENCE TABLE MATERIALS AND TESTS DIVISION SPECIFICATIONS SIGN HARDWARE D-9-7120
---

GENERAL NOTES:

- Design conforms with AASHTO Specifications for the design and construction of structural supports for highway signs.
- Materials and fabrication shall conform to the requirements of the Department material specifications.
- Structural steel shall conform to the item, "METAL FOR STRUCTURES."
- Parts shall be saw cut either before galvanizing and the galvanized cut cleaned of zinc build-up, or saw cut after galvanizing and the cut surface treated with zinc-based solder or zinc-rich paint in accordance with ASTM A780. (Cut surface will not be treated until plate is installed and all bolts fully tightened.)
- Exit number panel shall be mounted to the right hand side of the parent sign for right exits and to the left for left hand exits. The number panel shall be mounted with two uprights so its right edge is even with the right edge of the parent sign or vice-versa for left hand exits.

STANDARD PLANS  
TEXAS DEPARTMENT OF TRANSPORTATION  
Traffic Operations Division

SIGN MOUNTING DETAILS-  
LARGE ROADSIDE SIGNS  
STRUCTURE





SMD(2-1)-95

FINAL RECORD  
DRAWING  
Date: 12/25/99

ORIG. DRAW. DATE: August 1995	DRG - LR	CRK -	DRG - DN	CRK -	REG. NO. 1
REVISIONS	STATE DISTRICT	FEDERAL REGION	FEDERAL AID PROJECT	SHEET	
	6			47	
COUNTY	CONTROL	SECTION	JOB	RIGHTWAY	

DATE: 12/25/99  
 DRG - LR  
 CRK -  
 DRG - DN  
 CRK -  
 FILE: 495051525354555657585960616263  
 LEVELS DISPLAYED: 1 2 3 4 5 6 7 8 9 10 11 12 13 14 15 16  
 ACC: d58hplc/usr/d580504  
 FILE:



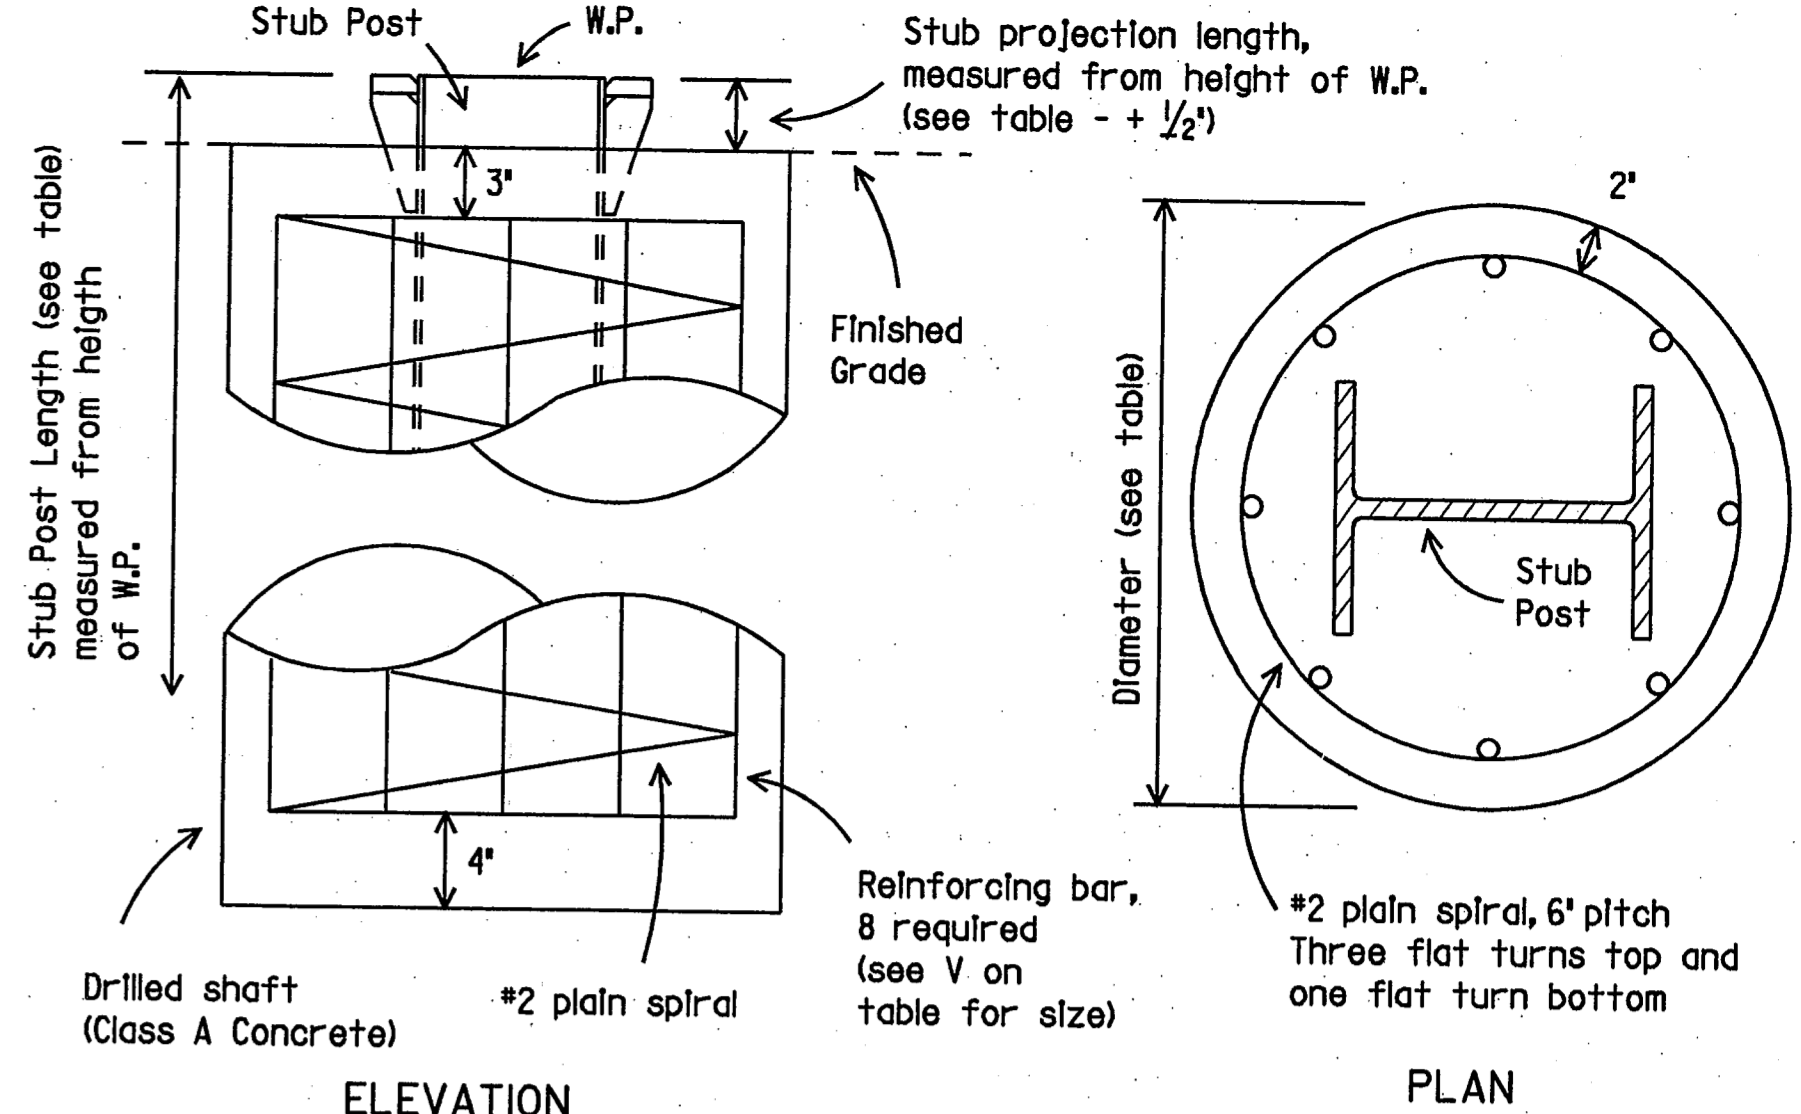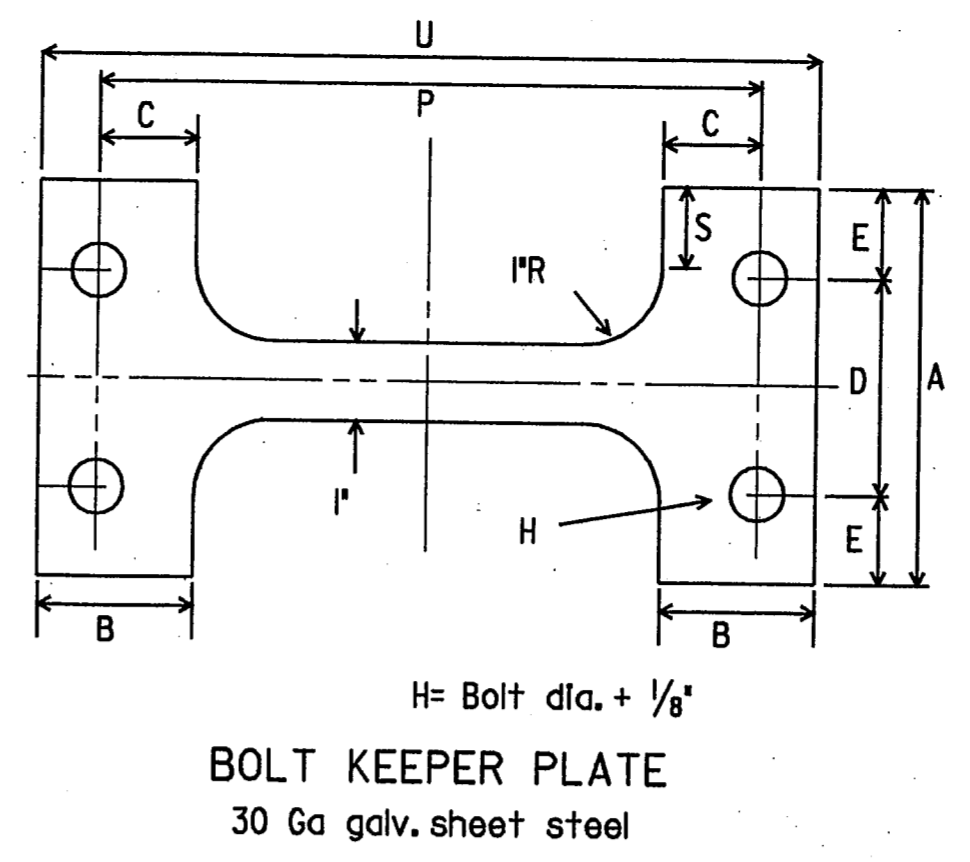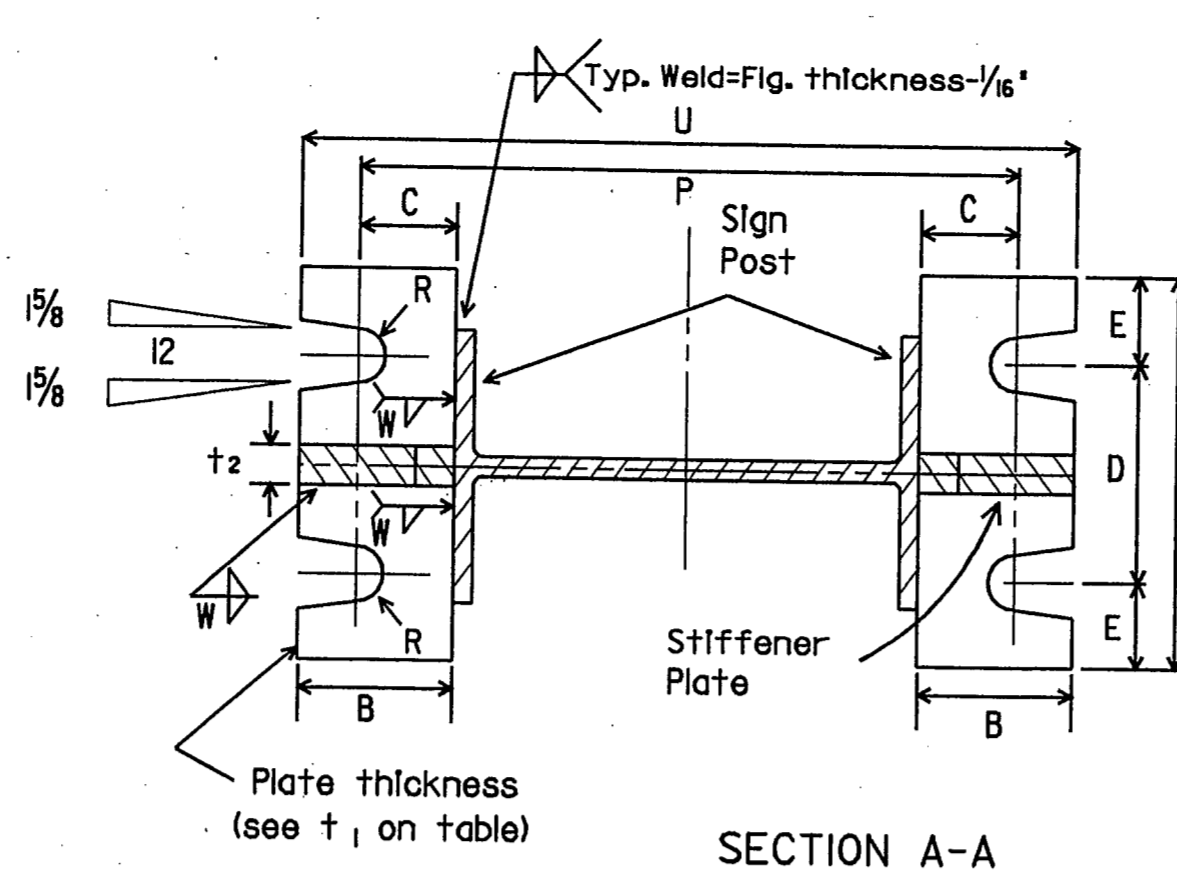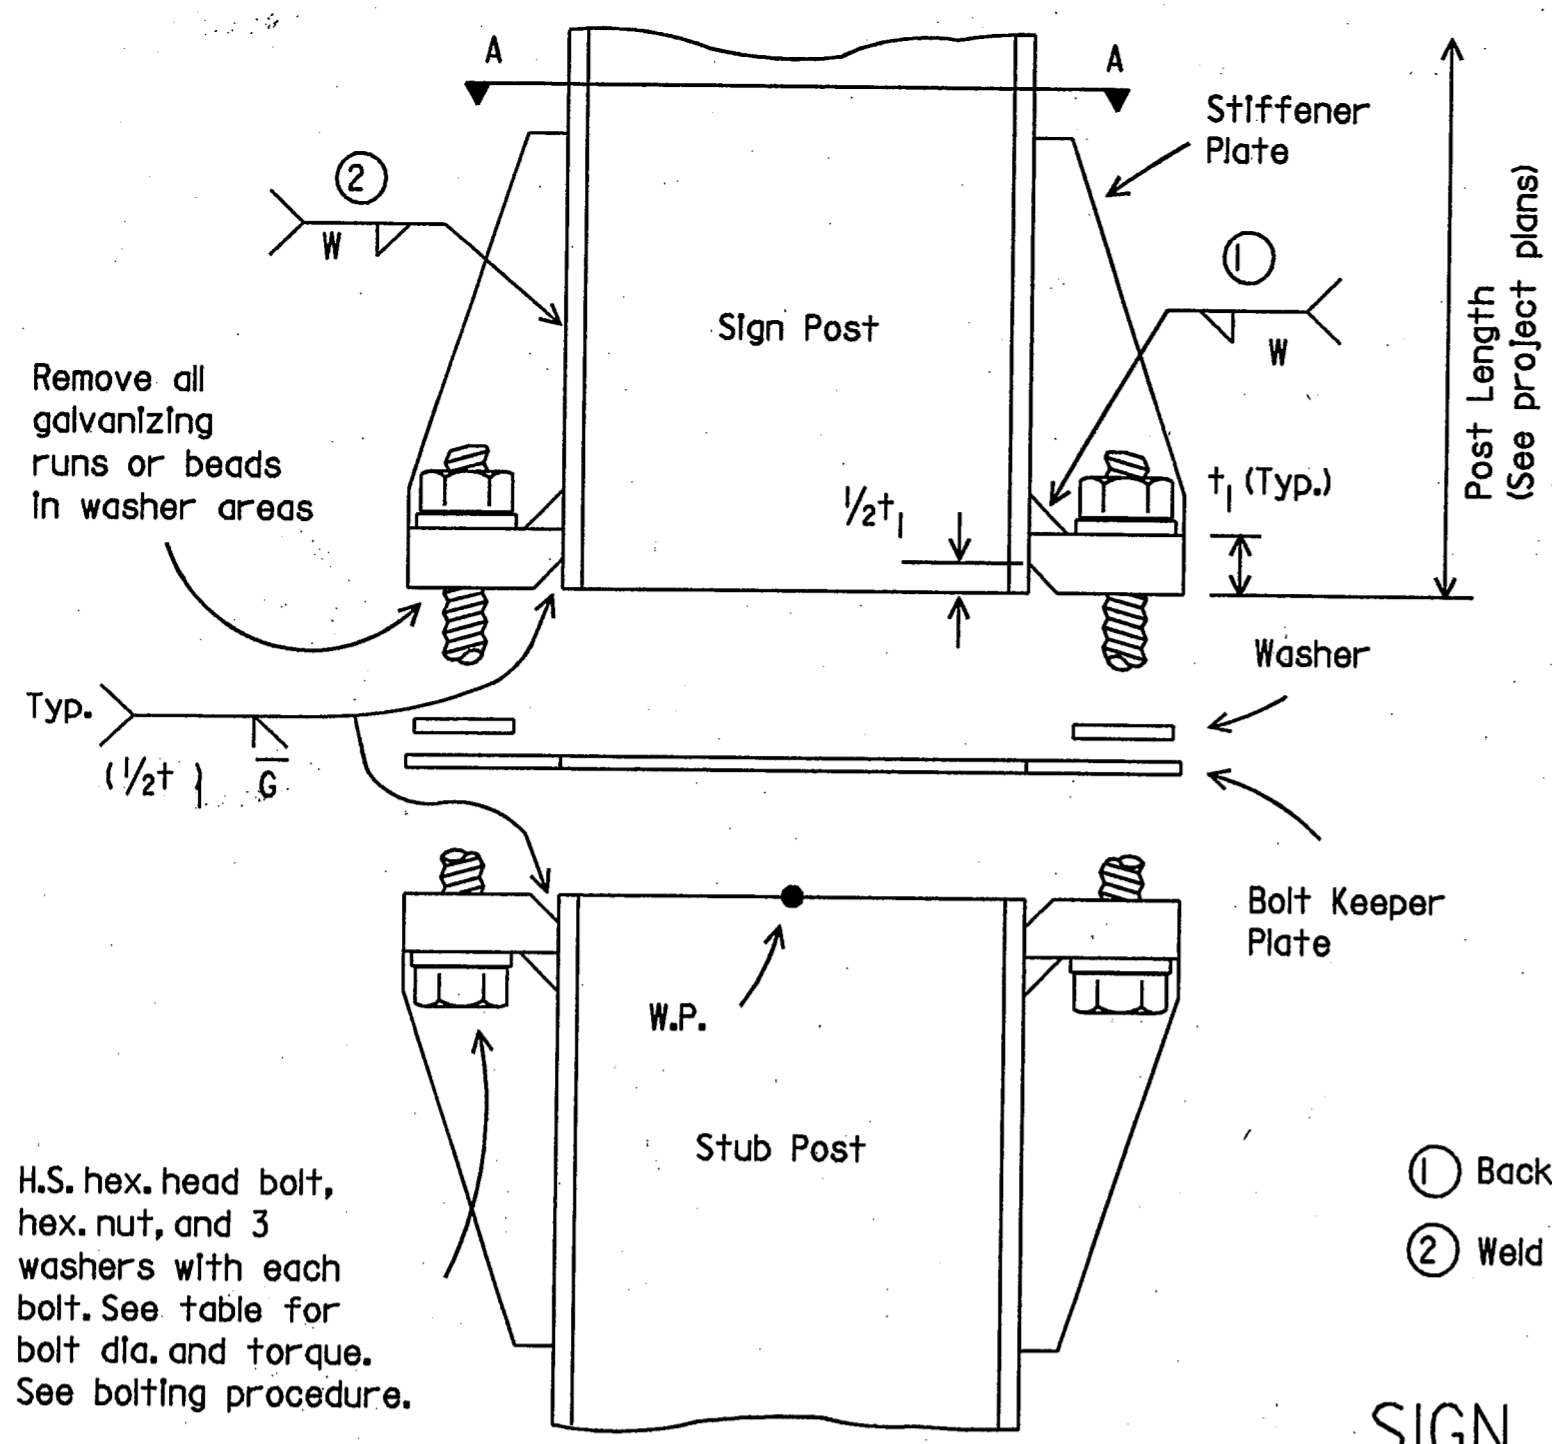


- ① Back up weld to be made before installing stiffener plate
- ② Weld W may be continued across clips to seal joint

SIGN POST AND STUB POST  
(For W Shapes)

STIFFENER PLATE DETAIL  
Steel Plate (thickness =  $t$ ) 2  
(See table for dimensions)

FOUNDATION DETAIL


SHIM DETAIL

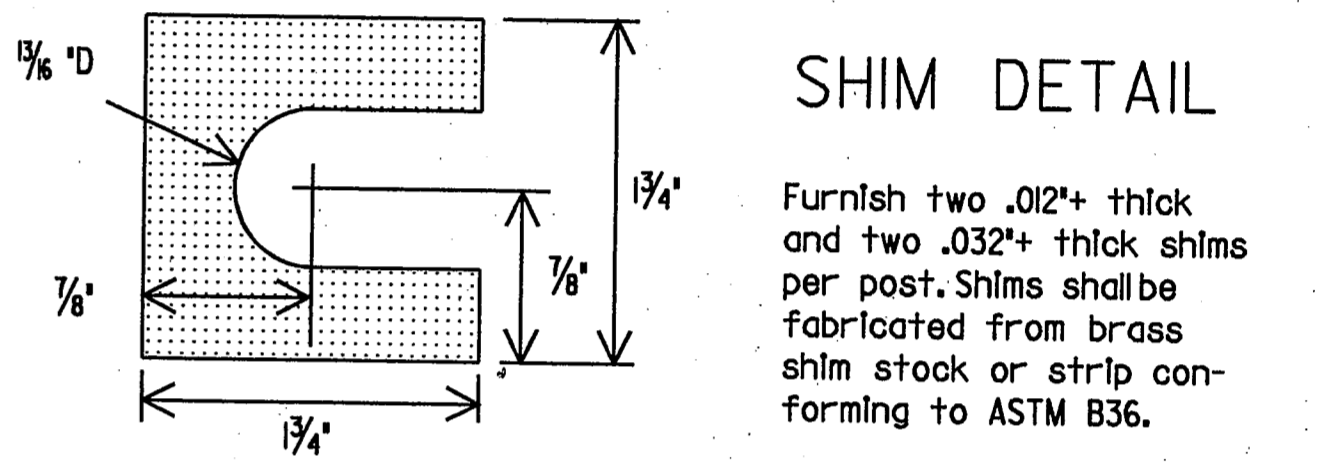

**BOLTING PROCEDURE FOR ASSEMBLY OF BASE CONNECTION:**

1. Assemble sign post, BOLT KEEPER PLATE and stub post with bolts and three flat washers per bolt as shown.
2. Shim as required to plumb post.
3. Tighten all bolts the maximum possible with a 12 to 15 inch wrench to clean bolt threads and to bed washers and shims.
4. Loosen each bolt in sequence and retighten bolts in a systematic order to the prescribed torque. Do not over-tighten.
5. To prevent nut loosening, burr threads of bolt at junction with nut using a center punch.



Dimensions Post Size	Base Connection Data Table										Perforated Fuse Plate Data Table										Bolt Keeper Data			Foundation Data					
	Bolt Size & Torque	A	B	C	D	E	$t_1$	$t_2$	W	R	F	G	J	K	M	$d_1$	$d_2$	$t_3$	Bolt Dia.	Wt. (lbs.)	Bolt length	P	S	U	Stub length	Stub projection	Dr. Shaft diameter	Bar V Size	
W6X9	5/8"Ø x 2 3/4"										4 1/4"	2"	4"	2 1/4"	1"	9/16"	3/4"	1/4"	1/2"	1.01	1 1/2"	8 3/8"		9 7/8"	2'-0"	3"		#5	
W6X12	440-450 Inch pounds	5"	2"	1 1/4"	2 3/4"	1 1/8"	3/4"	1/2"	1/4"	1 1/32"	5"	2 1/2"	6"	3 1/2"	1 1/2"	1 1/16"	1 1/4"	3/8"	5/8"	2.51	2 1/4"	8 1/2"	1"	10"	2'-0"	3"		#5	
W6X15	36-38 foot pounds										5"	2 1/2"	5 1/4"	2 3/4"	1 1/4"	1 1/16"	1 1/16"	3/8"	5/8"	2.26	2 1/4"	10 5/8"		10"	2'-6"	3"		#6	
W8X18											5 1/2"	2 1/2"	5 1/4"	2 3/4"	1 1/4"	1 1/16"	1 1/16"	3/8"	5/8"	3.35	2 1/4"	11"		12 1/8"	2'-6"	3"		#7	
W8X21	3/4"Ø x 3 1/2"										6"	3"	5 3/4"	2 3/4"	1 3/8"	1 3/16"	1 1/8"	1/2"	3/4"	4.03	2 1/4"	11"	1/2"	12 3/4"	3'-0"	2 1/2"		#8	
W10X22	740-750 Inch pounds	6"	2 1/4"	1 3/8"	3 1/2"	1 1/4"	1"	3/4"	5/16"	1 13/32"	6"	3"	5 3/4"	2 3/4"	1 3/8"	1 3/16"	1 1/8"	1/2"	3/4"	4.03	2 1/4"	12 7/8"		14 5/8"	3'-0"	2 1/2"		#9	
W10X26	62-63 foot pounds										6"	3"	6 1/2"	3 1/2"	1 5/8"	1 3/16"	1 1/16"	1/2"	3/4"	4.47	2 1/4"	15"		14 7/8"	3'-0"	2 1/2"		#10	
W12X26											6"	3"	6 1/2"	3 1/2"	1 5/8"	1 3/16"	1 1/16"	1/2"	3/4"	4.47	2 1/4"	15"		16 3/4"	3'-0"	2 1/2"		#11	
S3X5.7	1/2"Ø x 2 1/2"	See Detail Below										3 3/4"	1 1/2"	2 5/8"	1 1/2"	5/8"	9/16"	3/8"	1/4"	1/2"	0.60	1 1/2"	See Detail Below			3'-3 1/2"	3 1/2"	12"	Non-reinforced ③
S4X7.7	440-450 Inch pounds	See Detail Below										3 3/4"	1 1/2"	2 5/8"	1 1/2"	5/8"	9/16"	3/8"	1/4"	1/2"	0.60	1 1/2"	See Detail Below			3'-3 1/2"	3 1/2"	12"	Non-reinforced ③

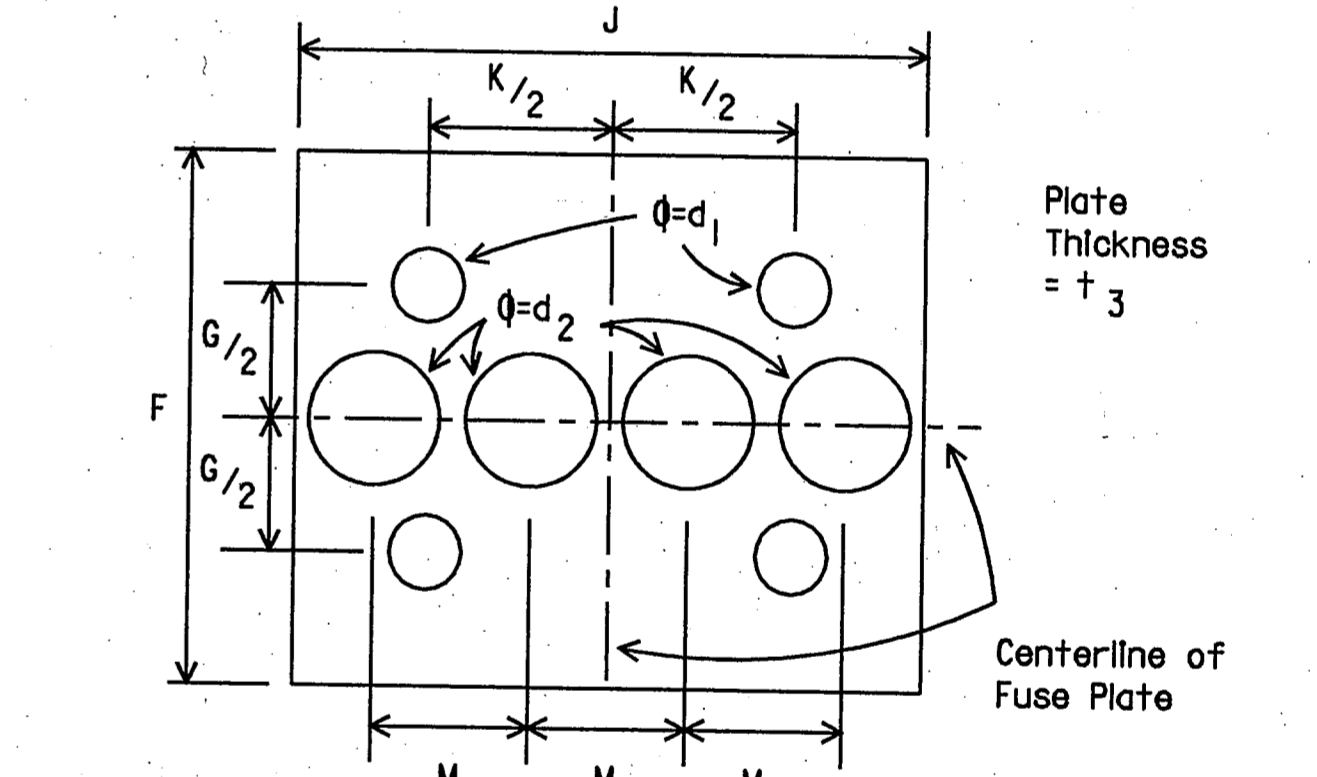


③ Foundation design shall be Type G Mount, see SMD (TY G).

PERFORATED FUSE PLATE DETAIL

Use H.S. hex head bolts, hex head nut and beveled flat washer (where req'd) under nut. All holes shall be drilled. All plate cuts shall preferably be saw cuts. However, flame cutting will be permitted provided all edges are ground. Metal projecting beyond the plane of the plate face will not be permitted. Steel fuse plates shall conform to the requirements of ASTM A36. ASTM A572 Grade 50 or ASTM A588 may be substituted for A36 at the option of the fabricator. Mill test reports shall be submitted for Fuse Plates. Steel used shall have an ultimate tensile strength not to exceed 80 KSI.

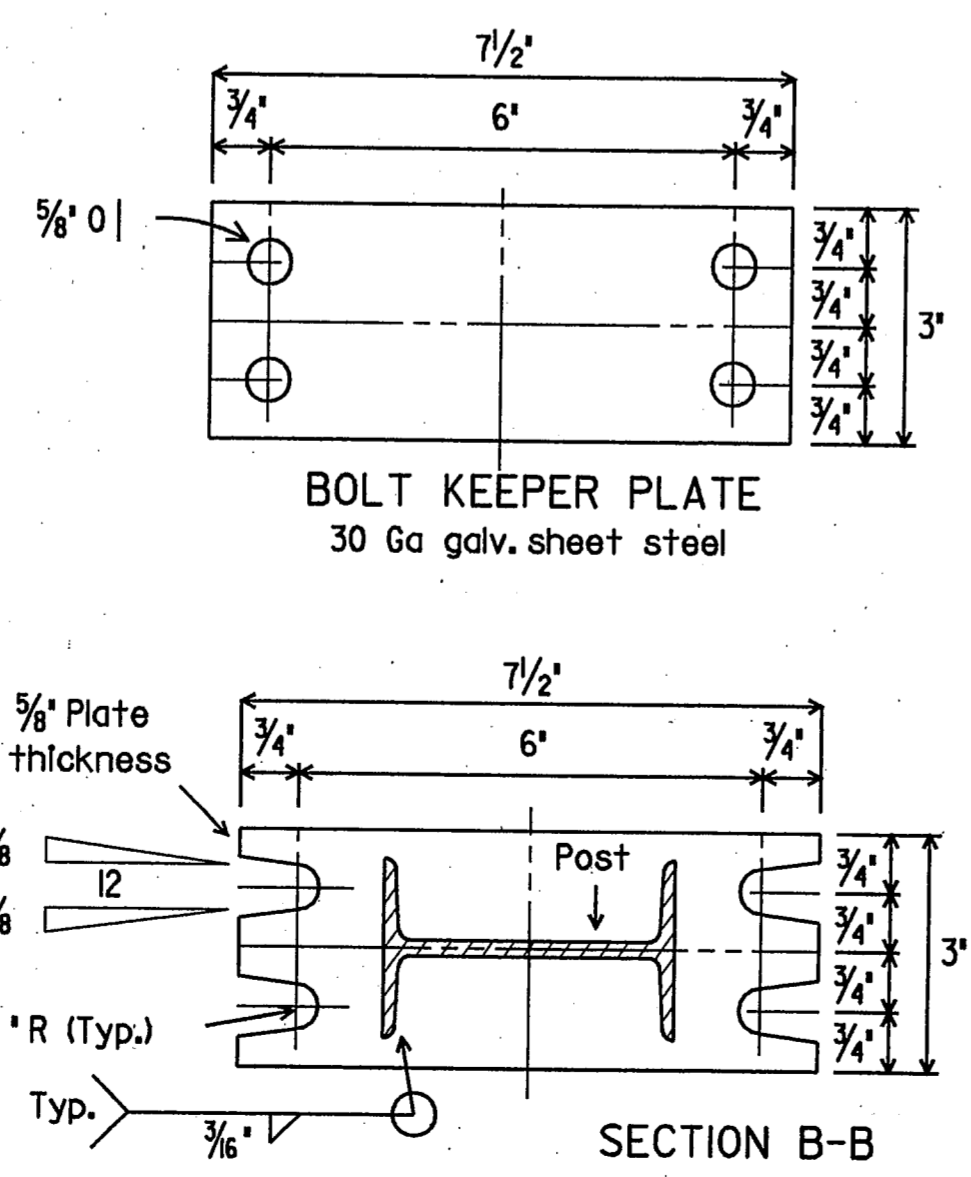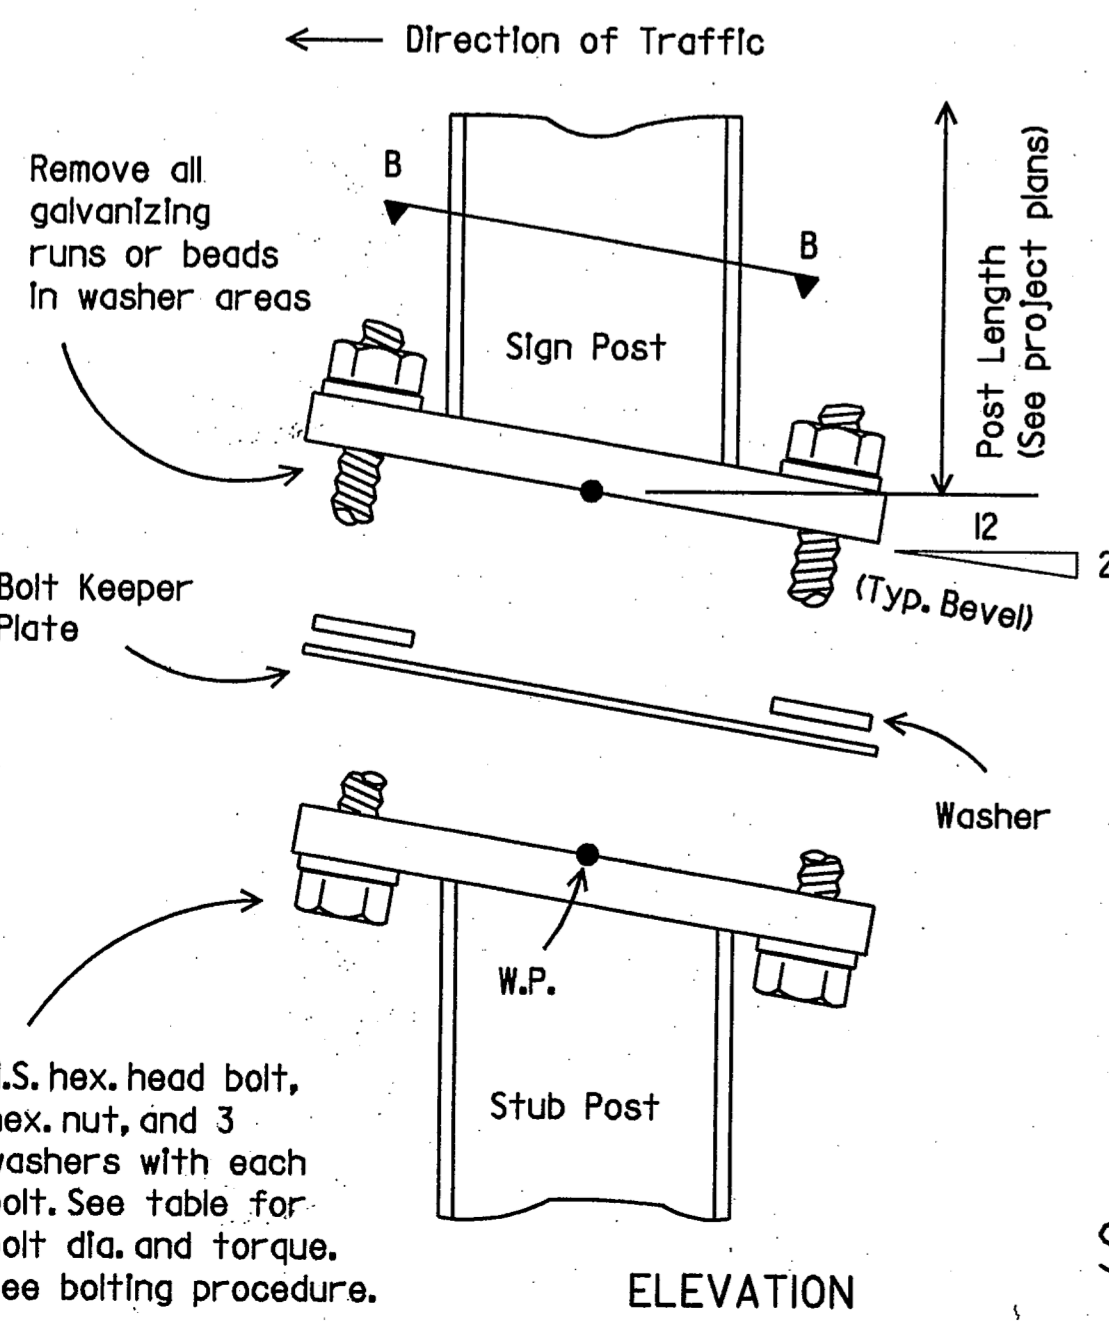

SIGN POST AND STUB POST  
(For S4X7.7 and S3X5.7)

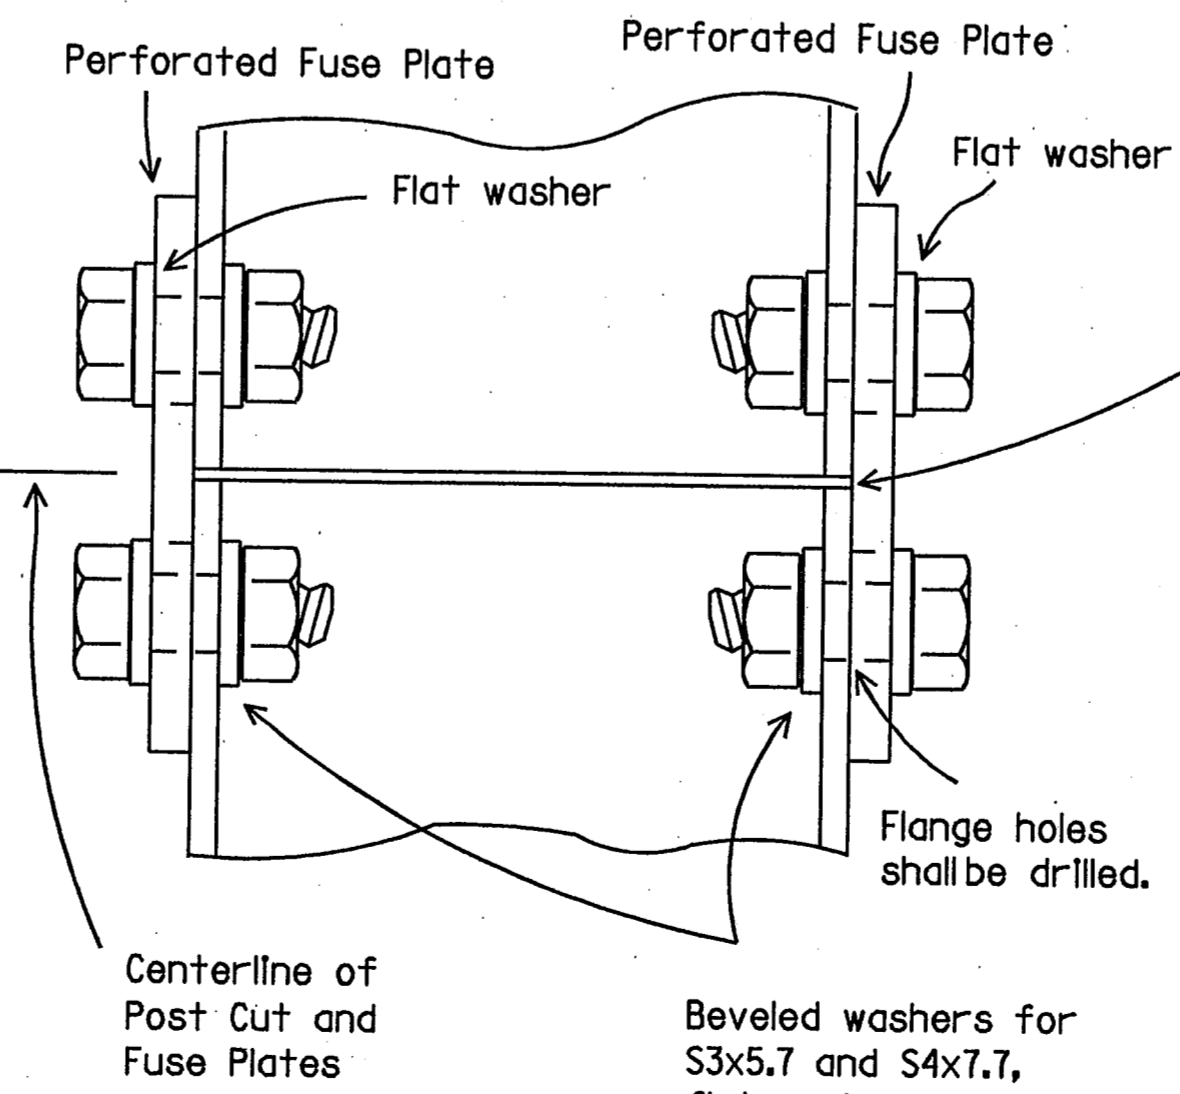

DATE: \_\_\_\_\_

FILE: \_\_\_\_\_

LEVELS DISPLAYED:

1	2	3	4	5	6	7	8	9	10	11	12	13	14	15	16
17	18	19	20	21	22	23	24	25	26	27	28	29	30	31	32
33	34	35	36	37	38	39	40	41	42	43	44	45	46	47	48
49	50	51	52	53	54	55	56	57	58	59	60	61	62	63	

DN:LR CK:CW DW:DN CK:MT

ACC: d58hpic/usr/d580504

FINAL RECORD DRAWING  
Date: 12/25/99

STANDARD PLANS  
TEXAS DEPARTMENT OF TRANSPORTATION  
Traffic Operations Division

SIGN MOUNTING DETAILS-  
LARGE ROADSIDE SIGNS  
FOUNDATION & STUB

SMD(2-2)-95


ORIG DRAW DATE: August 1995

REVISES	DATE	BY	REASON


COUNTY: \_\_\_\_\_ CONTROL: \_\_\_\_\_ SECTION: \_\_\_\_\_ JOB: \_\_\_\_\_ HIGHWAY: \_\_\_\_\_ SHEET: 48

97B


# TYPICAL ALUMINUM SIGN & EXIT PANEL ASSEMBLY DETAILS

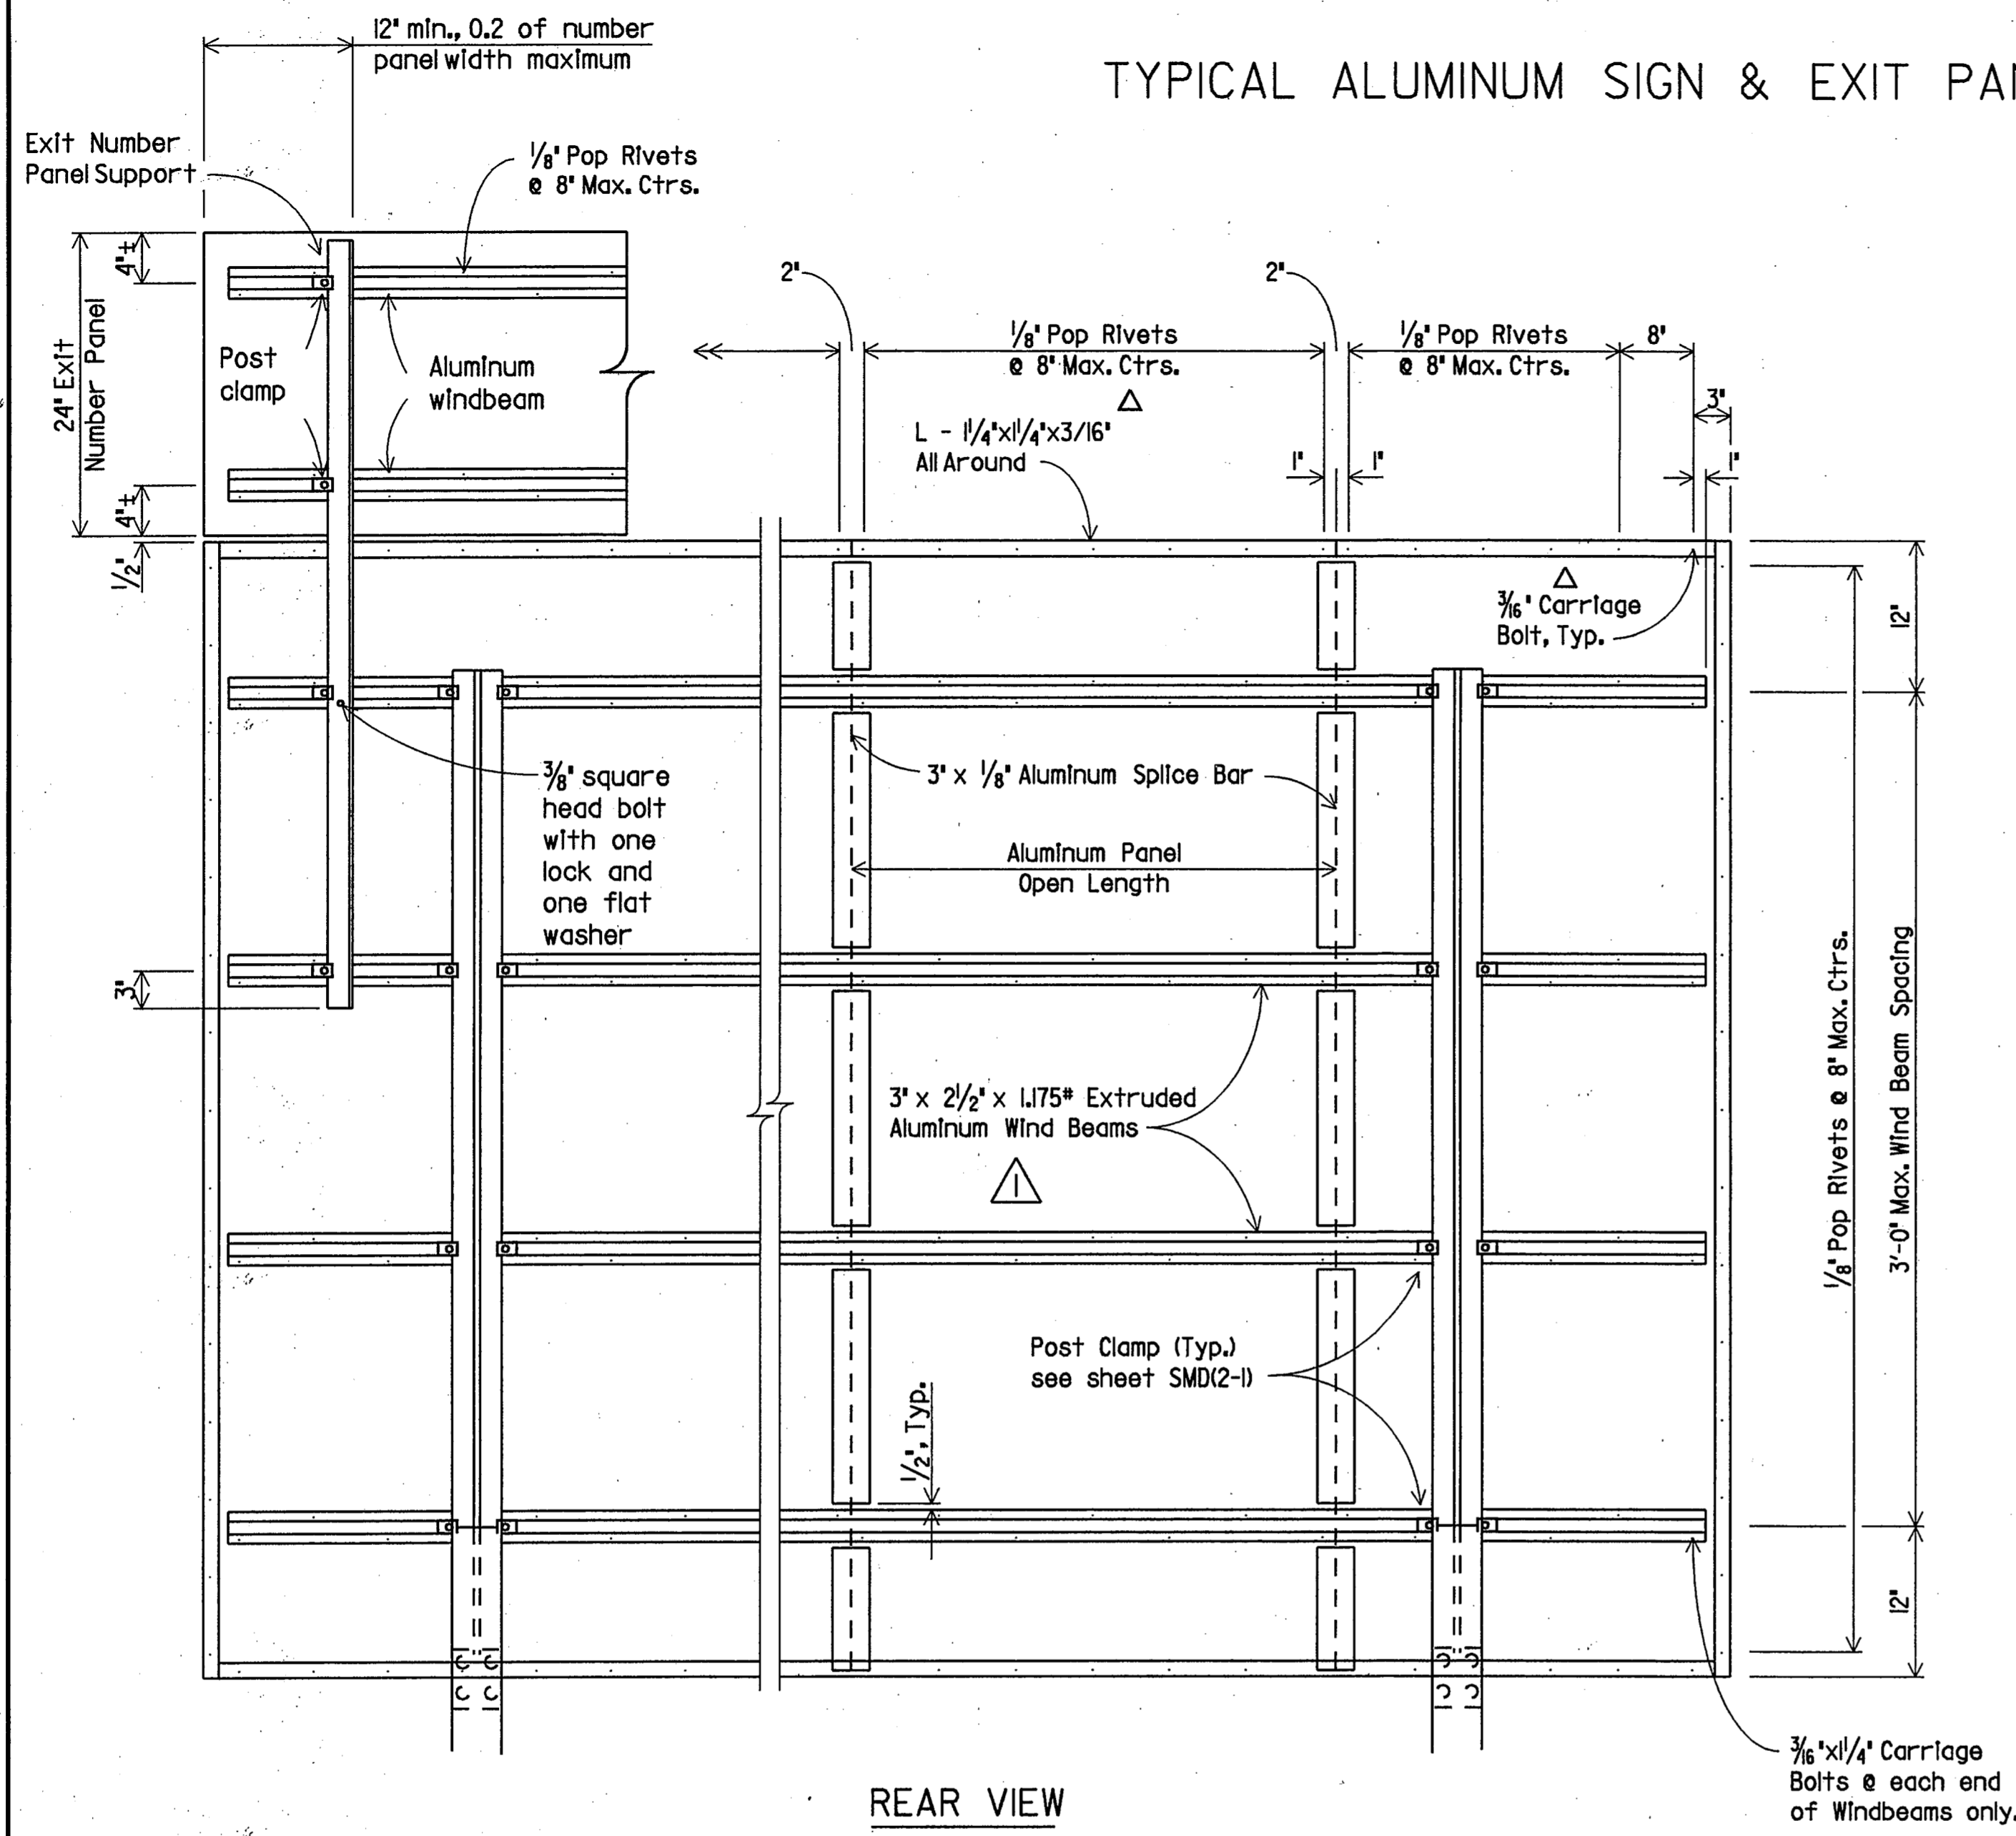

REAR VIEW

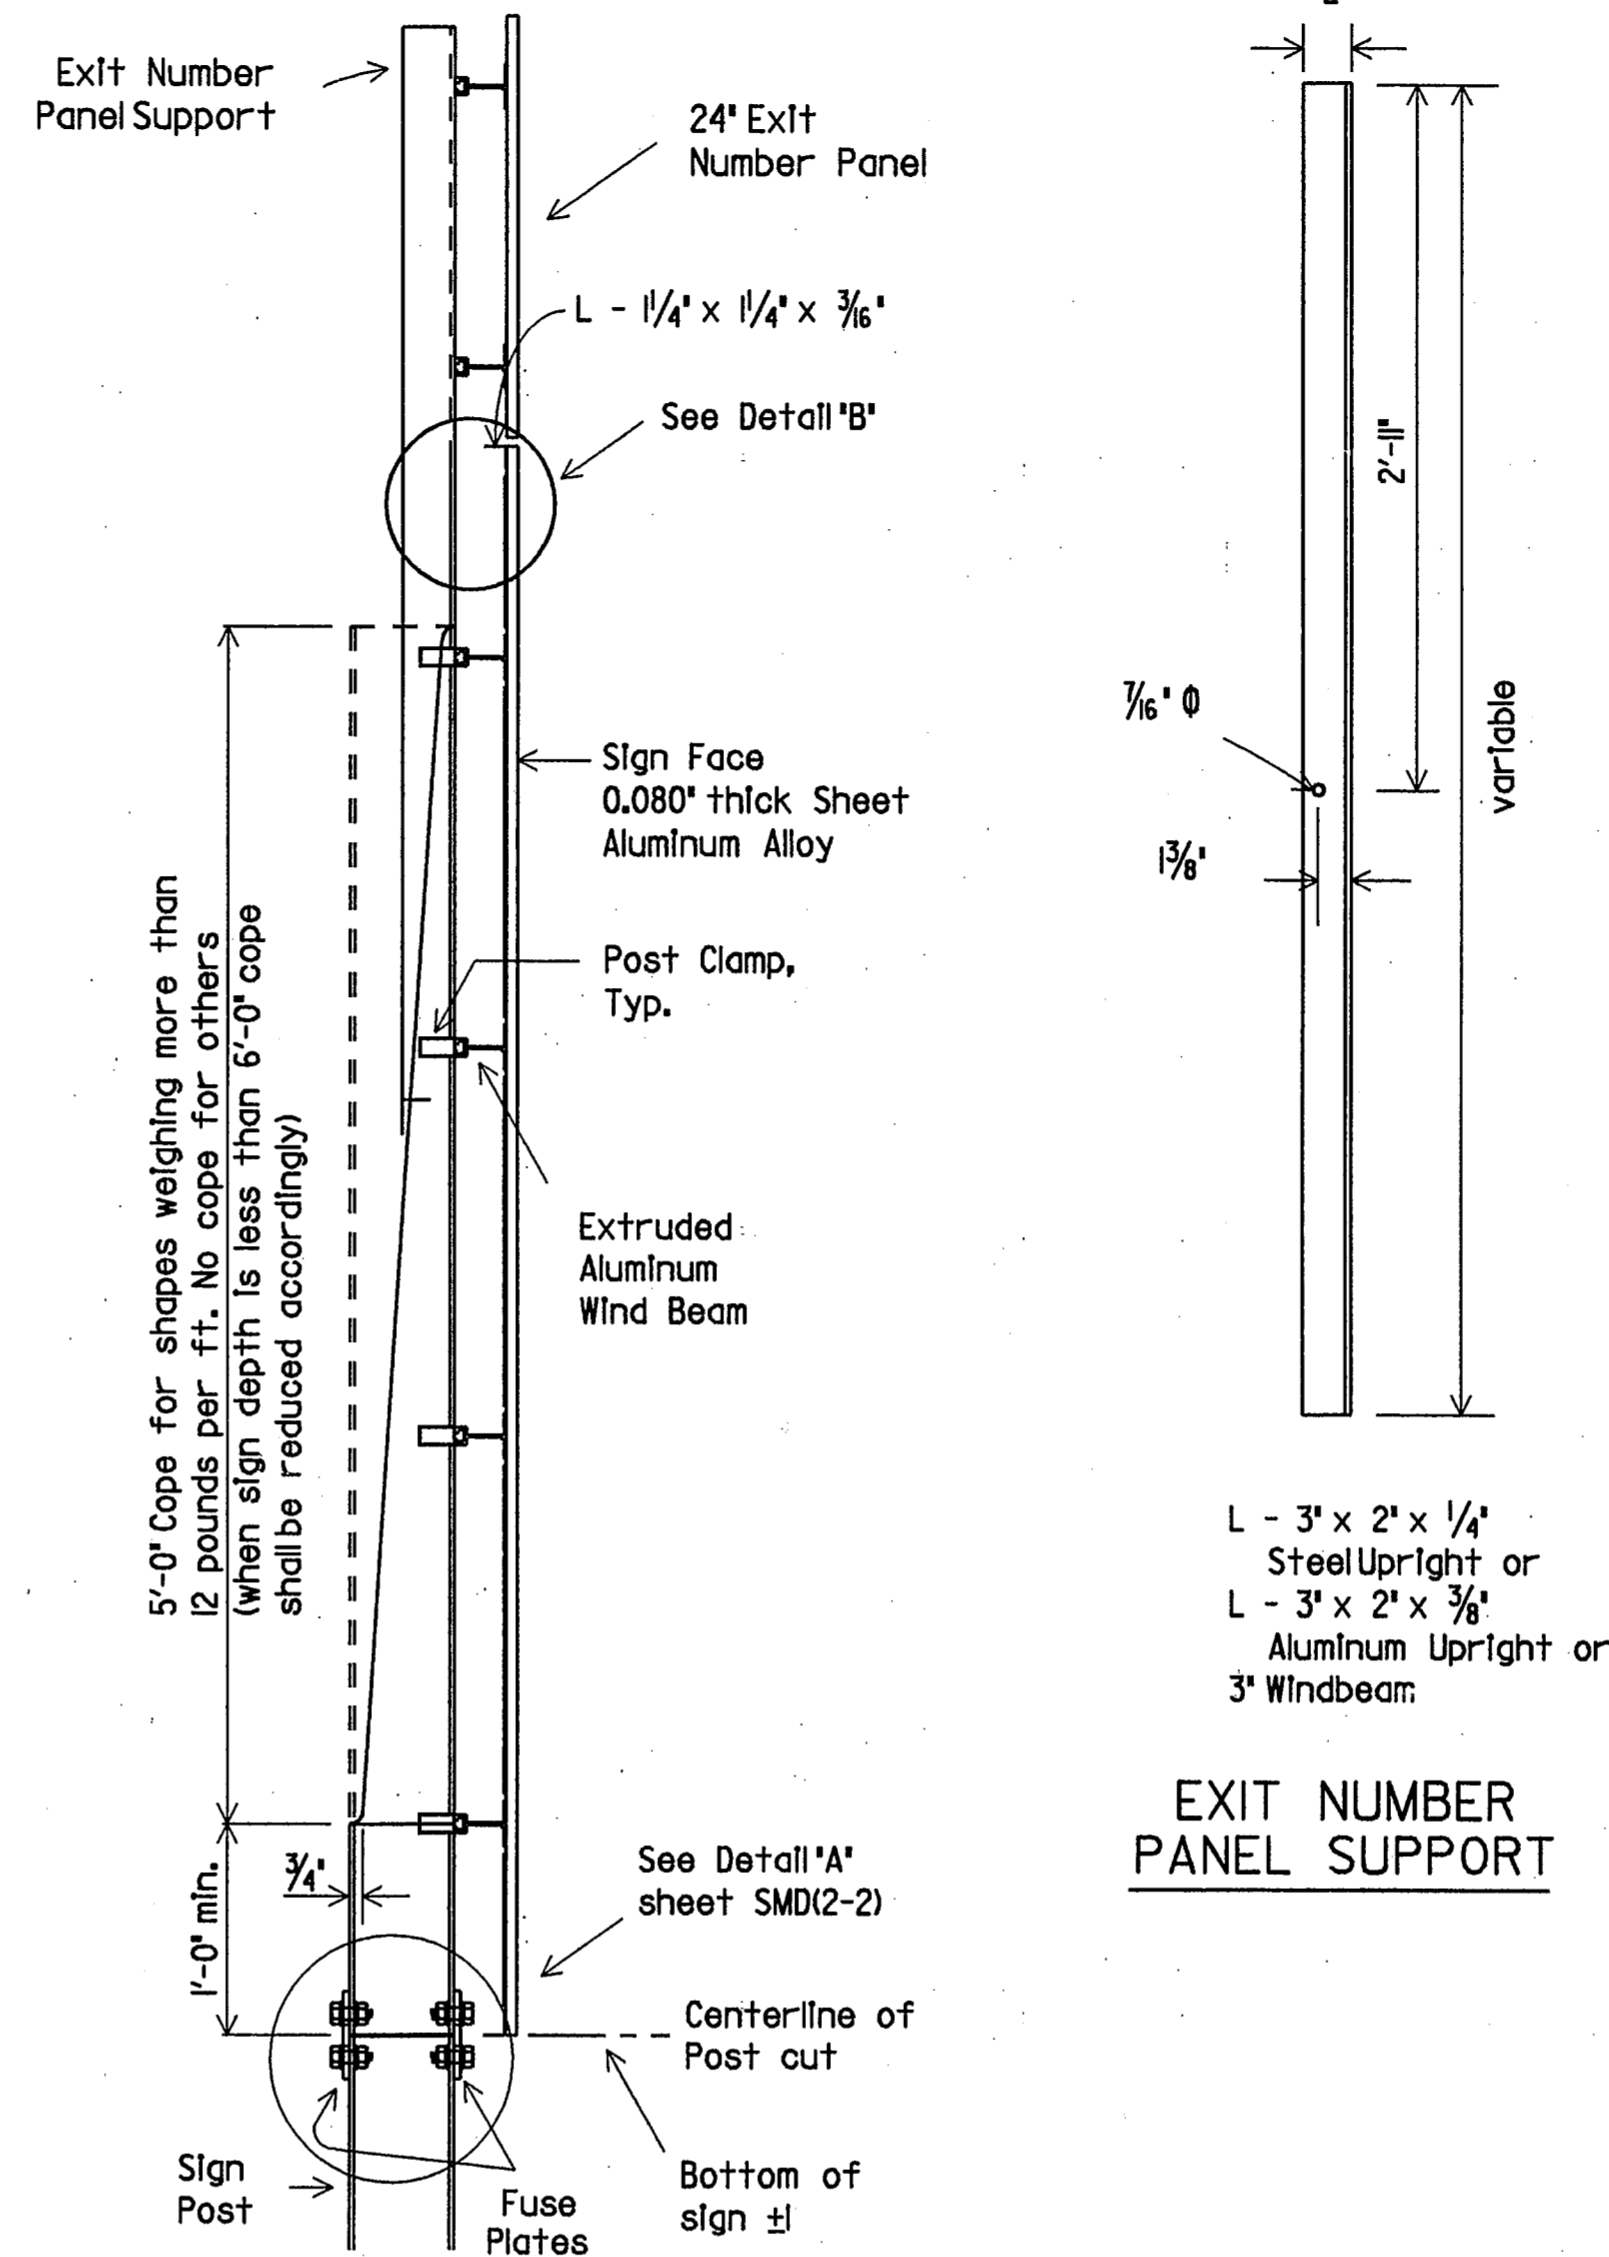

SIDE VIEW

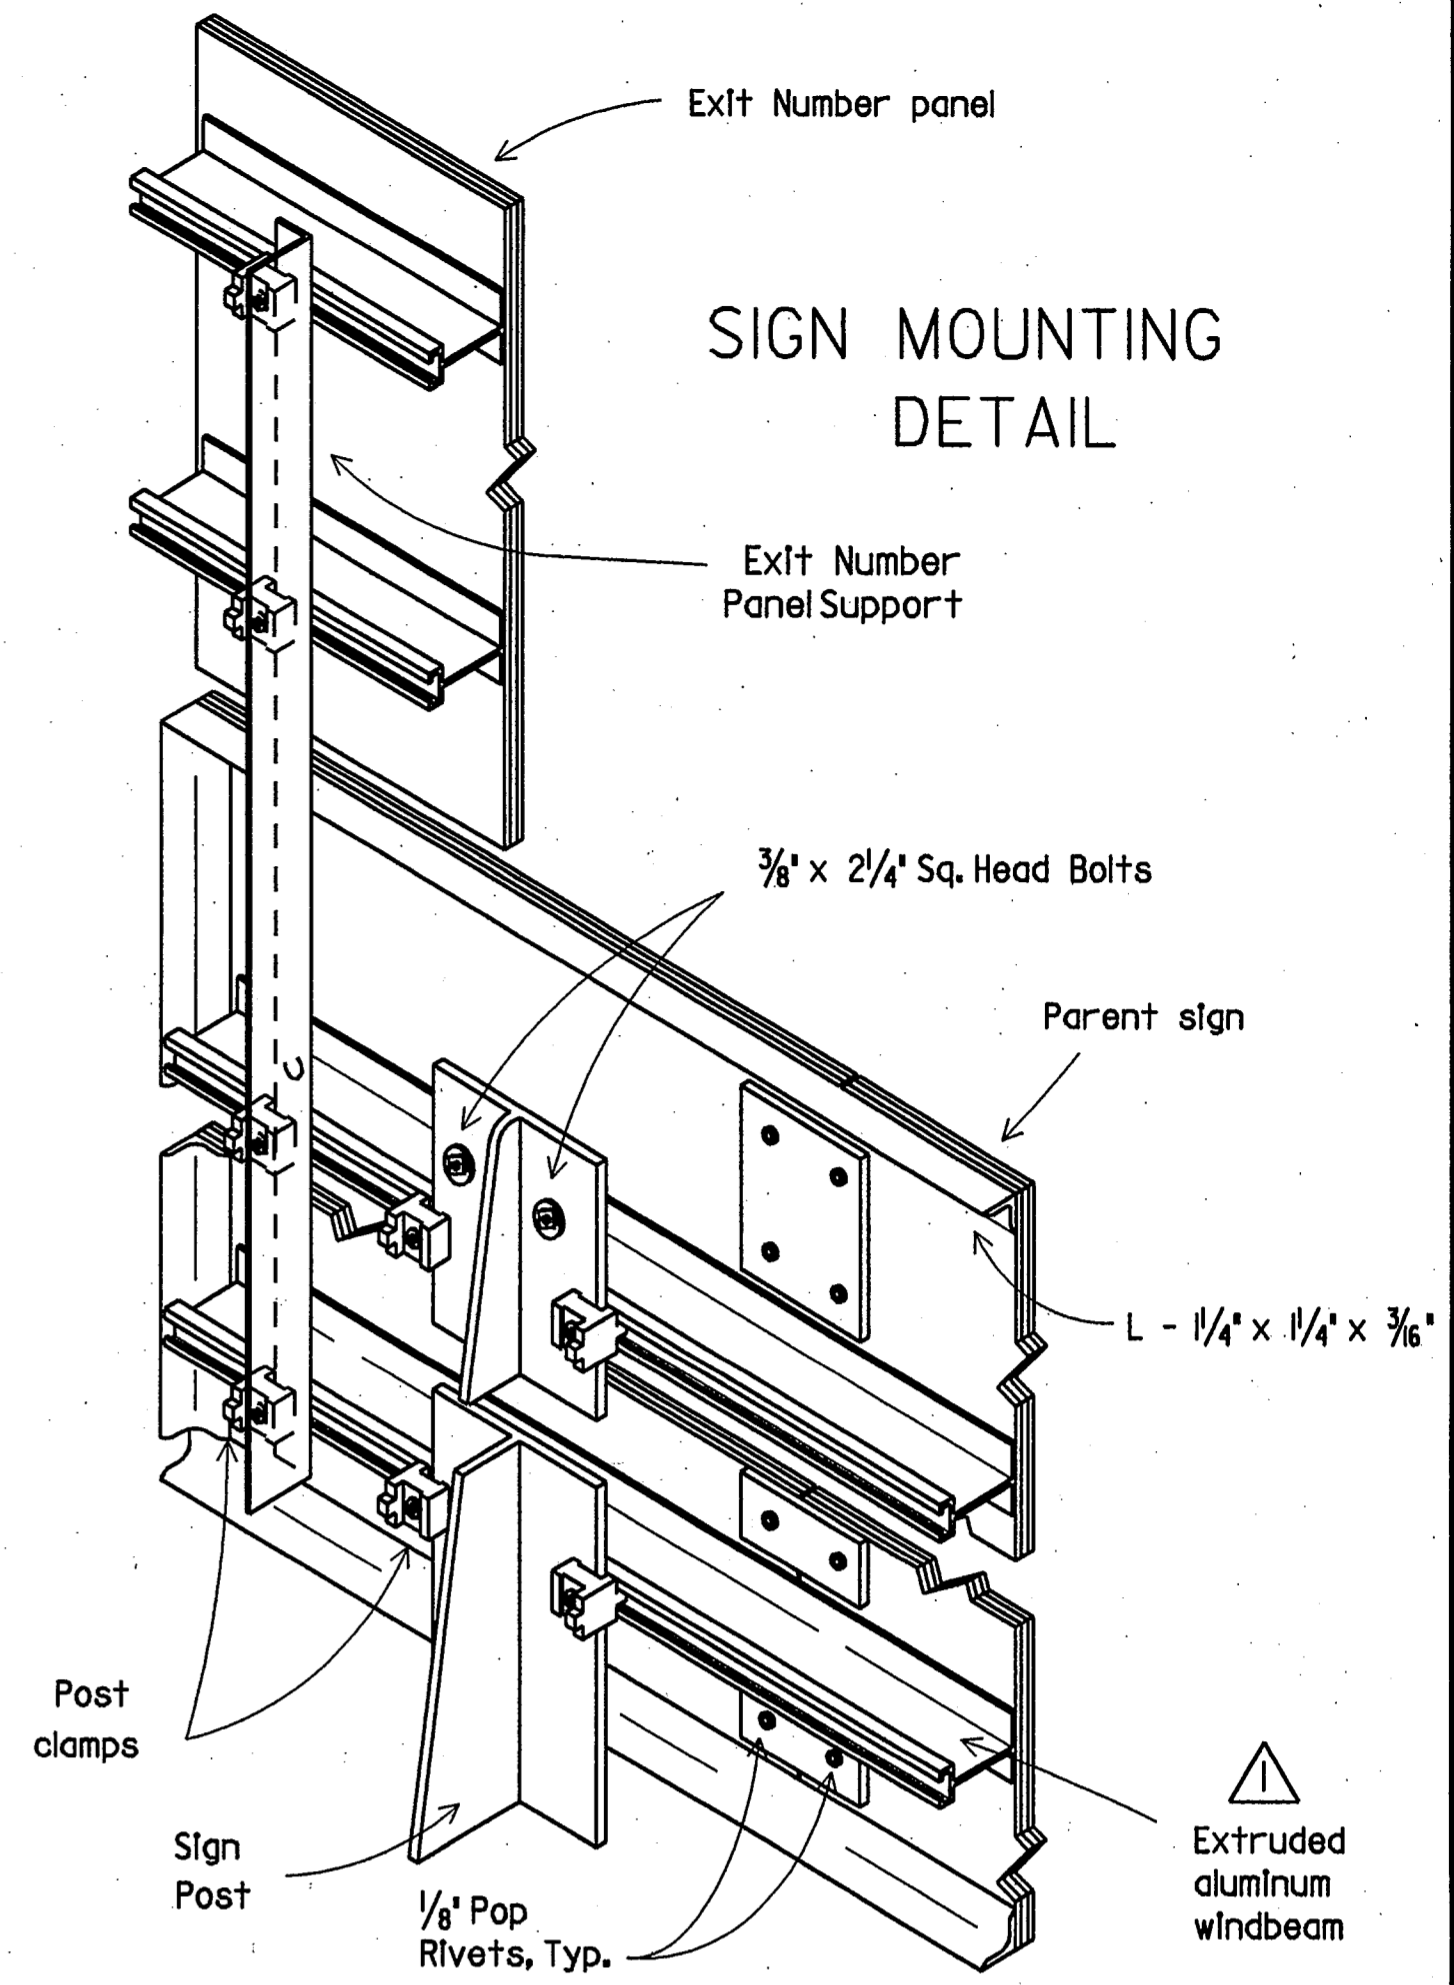


SIGN MOUNTING DETAIL

EXIT NUMBER PANEL SUPPORT

- NOTES:
1. A tolerance of plus or minus 1/4 inch will be permitted in the plan dimensions for fabrication of each single increment sign panel when necessary for squaring. A tolerance of plus or minus 1/4 inch will be permitted for each increment of a multi-increment sign panel where necessary to secure square, tight-fitting joints.
  2. Splices shall be kept to a minimum. Panels 4'x8' or larger shall be used to the maximum extent possible in the fabrication of any sign. Signs or sign sections which cannot be fabricated from at least a 4'x8' panel shall be of one piece construction.

⚠ Extruded aluminum wind beams shall be continuous with no splices. (see sheet SMD(2-1))

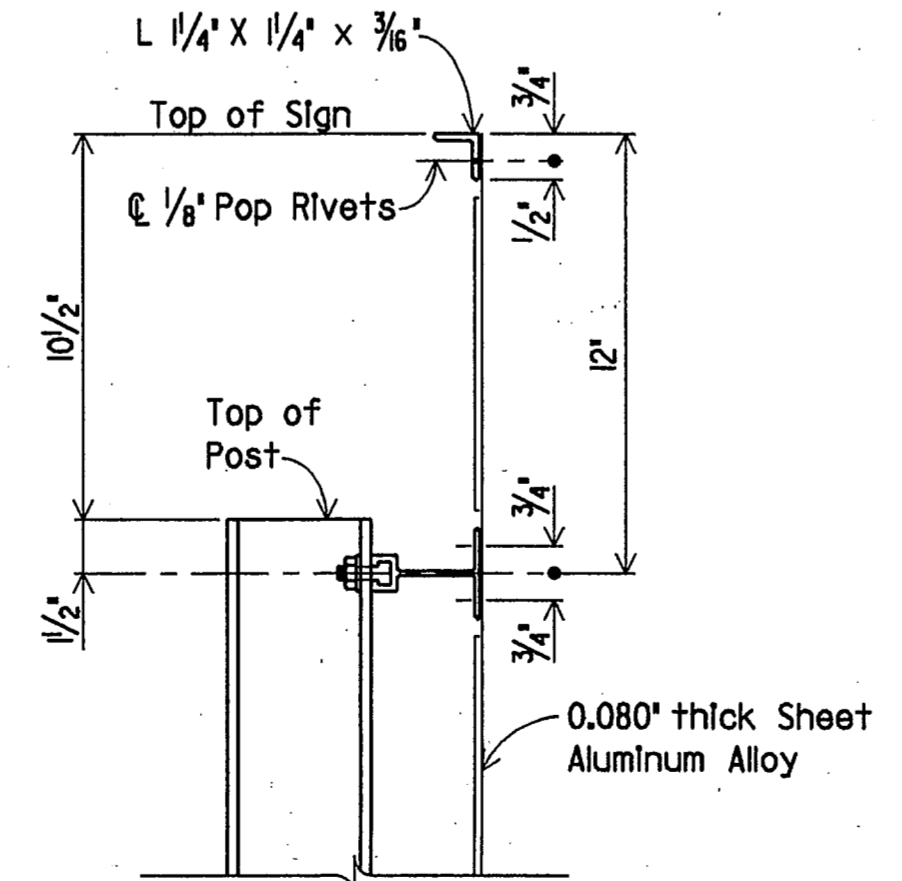

DETAIL "B"

- NOTES:
1. Exit number panel shall be mounted to the right hand side of the parent sign for right exits and to the left for left hand exits. The number panel shall be mounted with two uprights so its right edge is even with the right edge of the parent sign or vice-versa for left hand exits.
  2. Exit number panel support shall be symmetrical about number panel centerline.
  3. Exit number panel support shall be of ASTM A36 structural steel galvanized after fabrication, or ASTM B221 aluminum alloy 6061-T6.
  4. All bolts, nuts, washers and pop rivets shall be galvanized per ASTM Designation: B695 Class 50, or A153 Class C or D.
  5. When splice bars are required to fabricate the number panel, the splice bar detail as shown for the parent sign is to be used. Splice bars on number panel need not align with those on parent sign.
  6. Posts, parent sign panels and exit number panels shall comply with notes on sheets SMD(2-DIMOD.) and SMD(2-2).
  7. Signs (such as exit number panels) attached above a parent sign shall be made of the same type material as the parent sign.
  8. Exit number panel support and other connection hardware required to fasten exit number panel to parent sign shall be subsidiary to the sign blank.

DN:LR	DATE:
CK:CW	ACCC: d58mp/c/usr/d580504
DW:DN	FILE:
CK:MT	

FINAL RECORD DRAWING  
Date: 12/25/99


STATE OF TEXAS  
GLENN D. HOUSER  
24236  
7-9-97

STANDARD PLANS  
TEXAS DEPARTMENT OF TRANSPORTATION  
Traffic Operations Division

SIGN MOUNTING DETAILS-  
LARGE ROADSIDE SIGNS


SMD(2-3)-95 (MOD.)

ORG. DRAW. DATE: August 1995	DN: LR	CK: CW	DW: DN	CK: MT	NEG. NO.:
6-97Δ					
STATE DISTRICT: 6	FEDERAL REGION: 6	FEDERAL AID PROJECT:		SHEET: 49	
COUNTY:	CONTROL SECTION:	JOB:	HIGHWAY:		

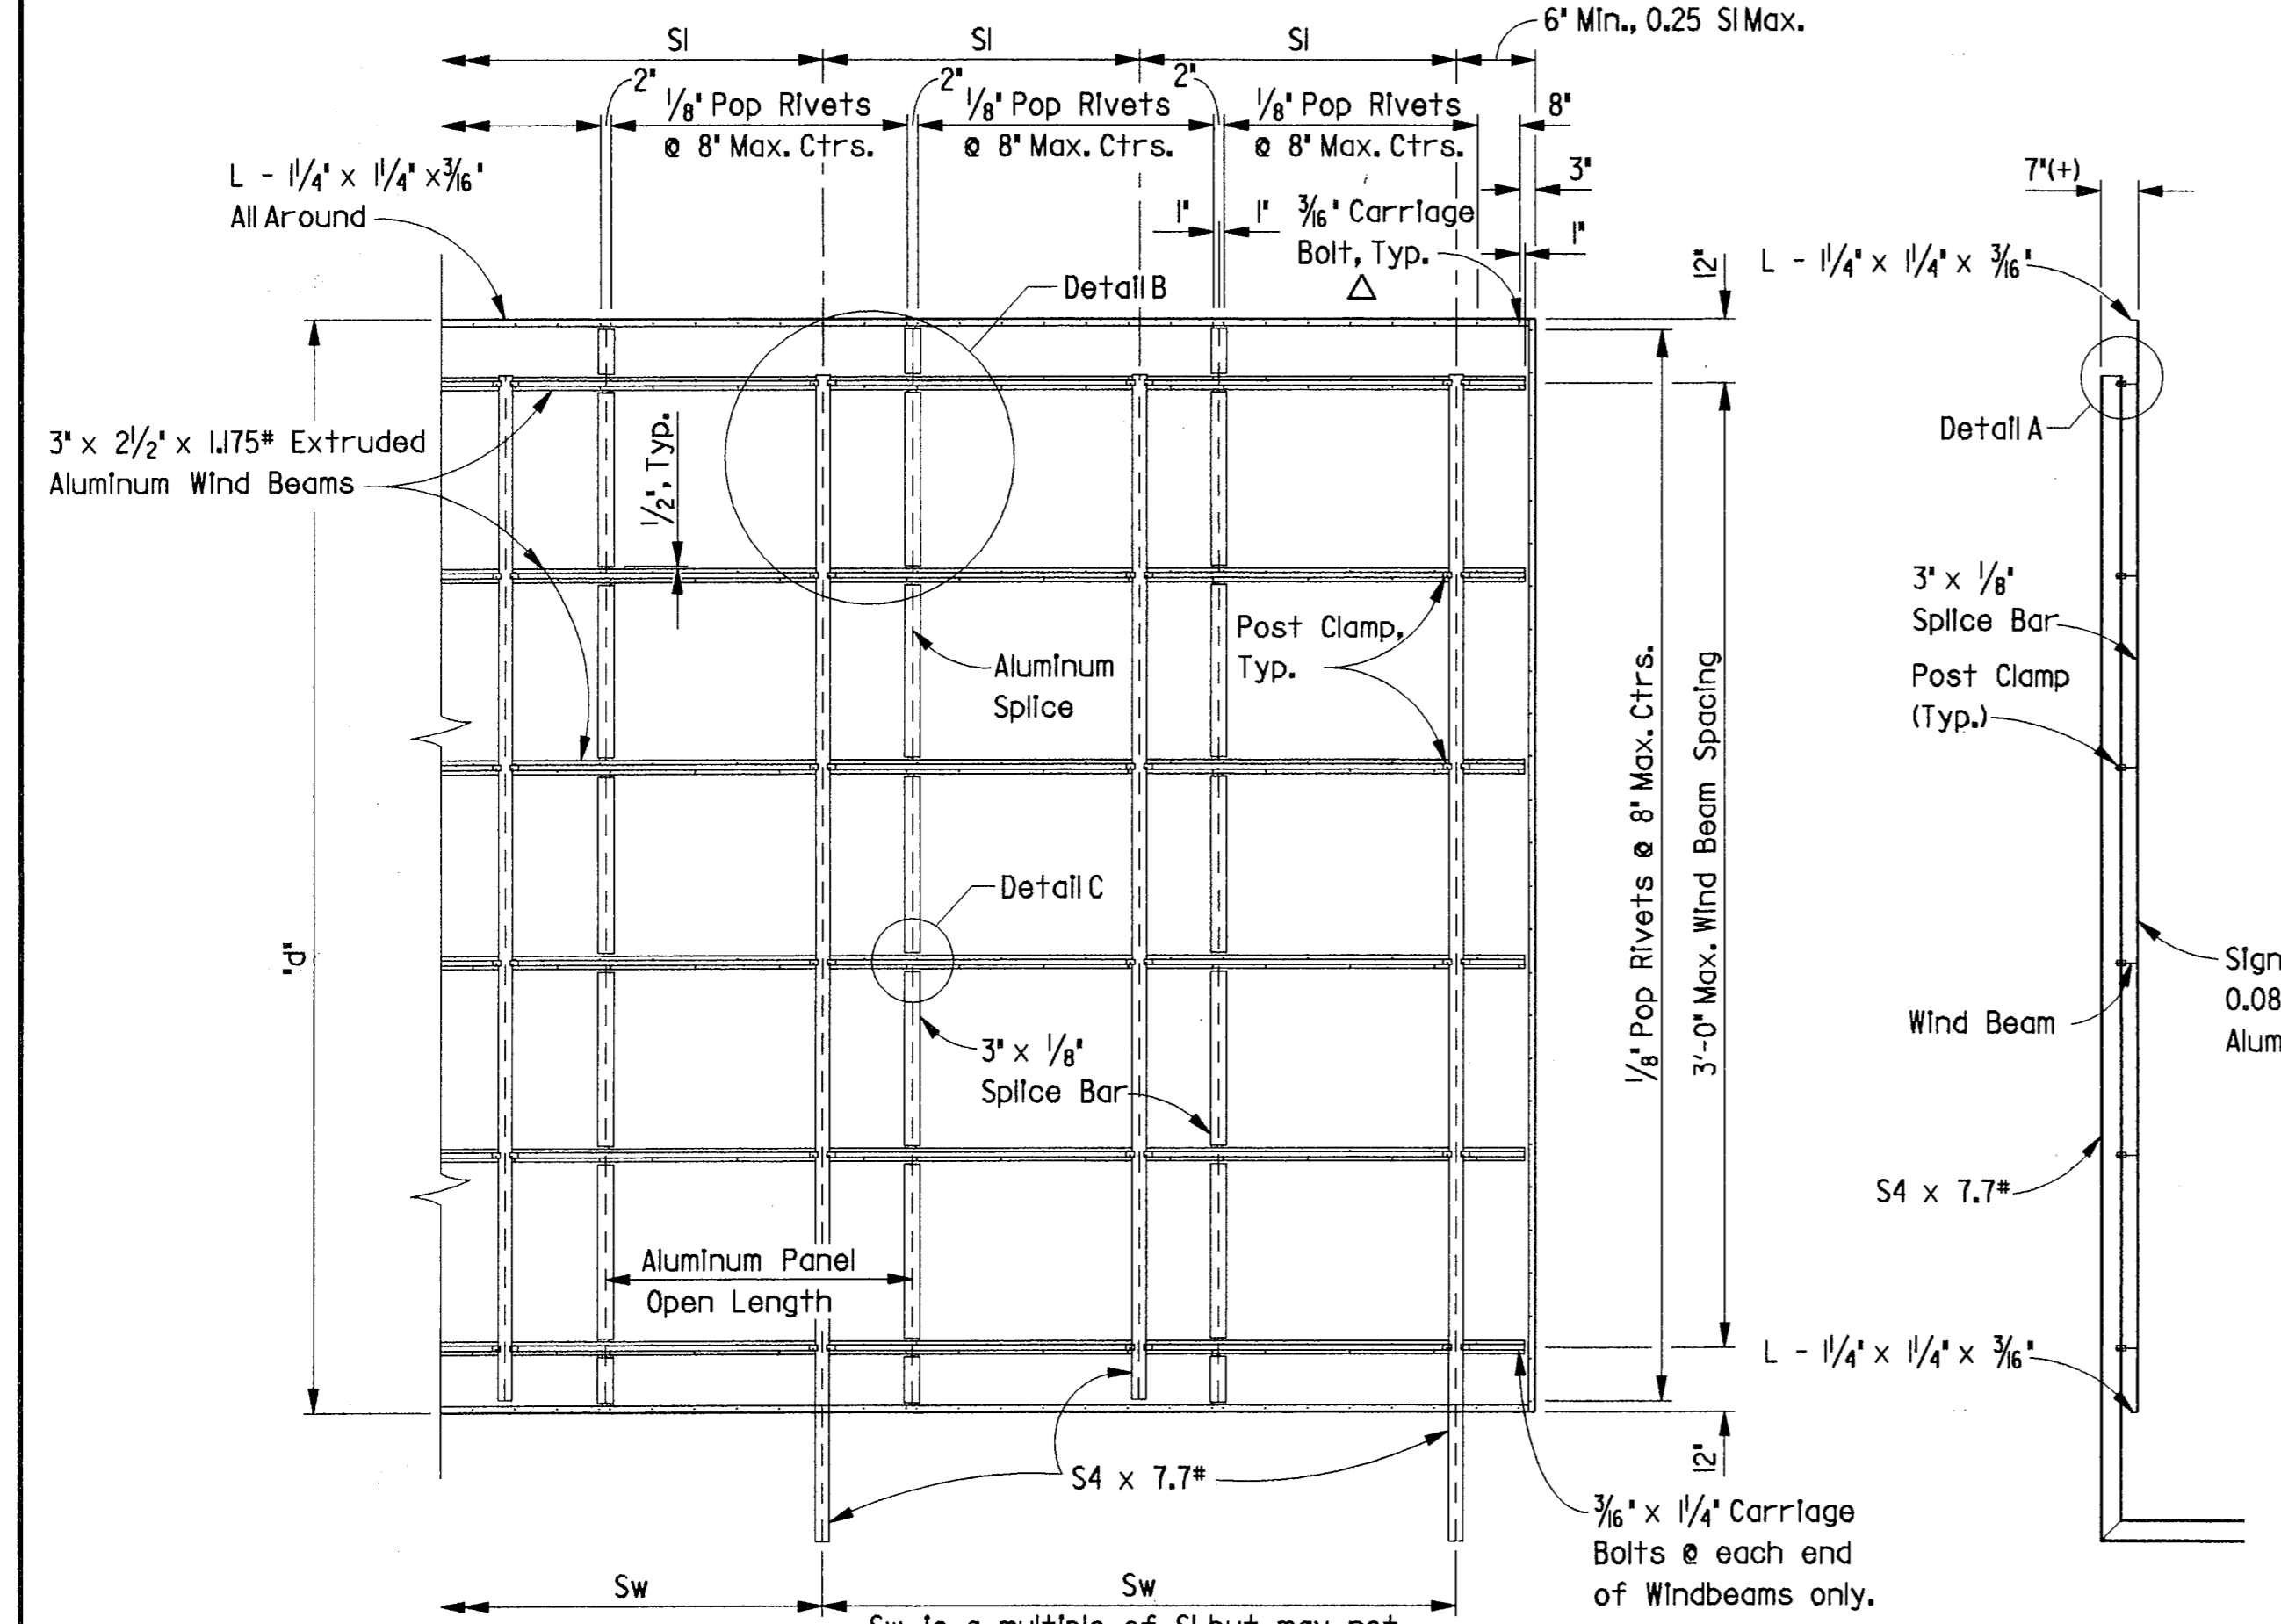


REAR VIEW  
SHEET ALUMINUM SIGNS WITH WIND BEAMS

Signs over 8.0 feet deep may have a single horizontal splice, and may be shipped in two pieces.

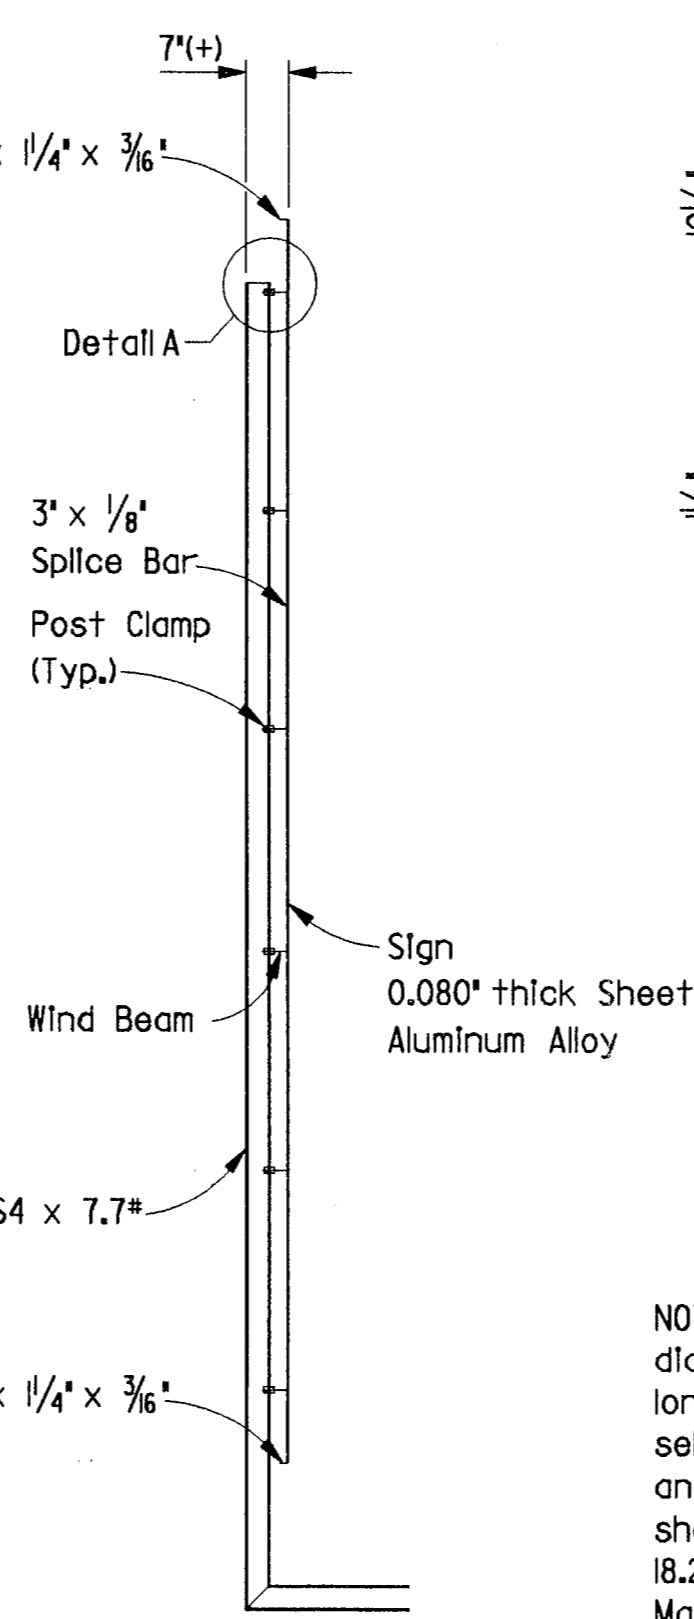


SIDE VIEW

NOTE: Centerline of hole for 3/8\"/>

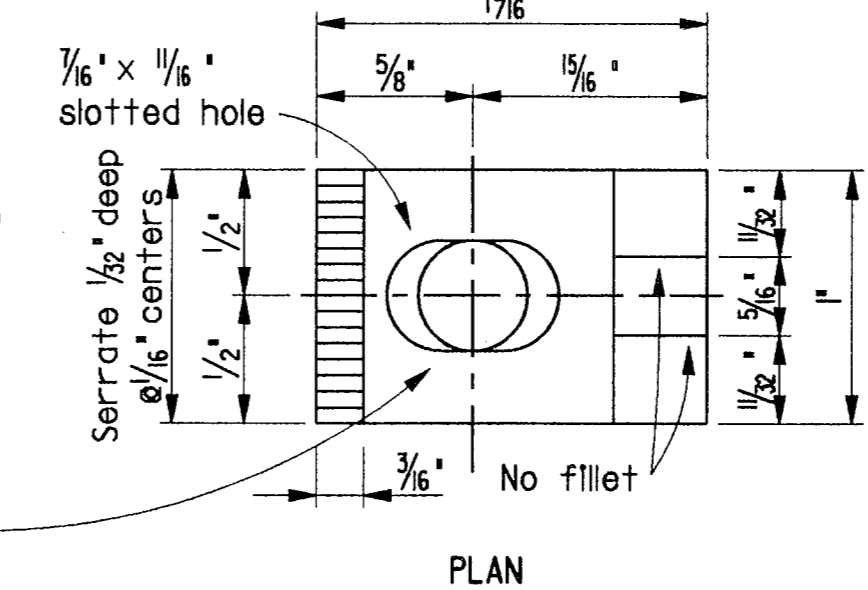

PLAN

Beam flange of W shapes: 7/16\"/>

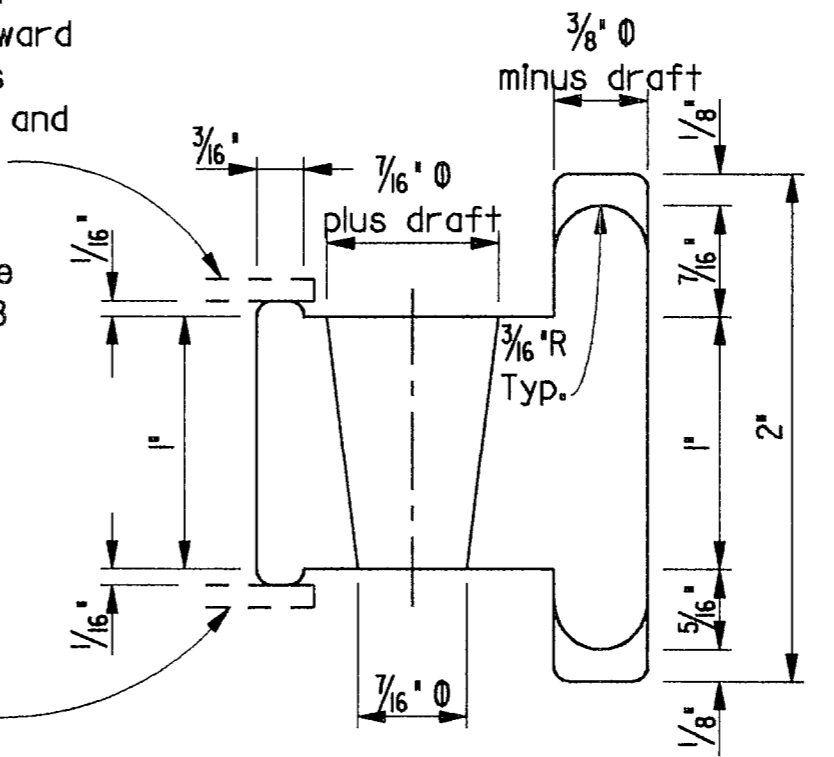


ELEVATION


Post Clamp to be ASTM B26 or B108 cast Aluminum alloy 356.0-T6 (1.73 lbs each)

Beam flange of W and S shapes: 3/8\"/>

POST CLAMP DETAIL

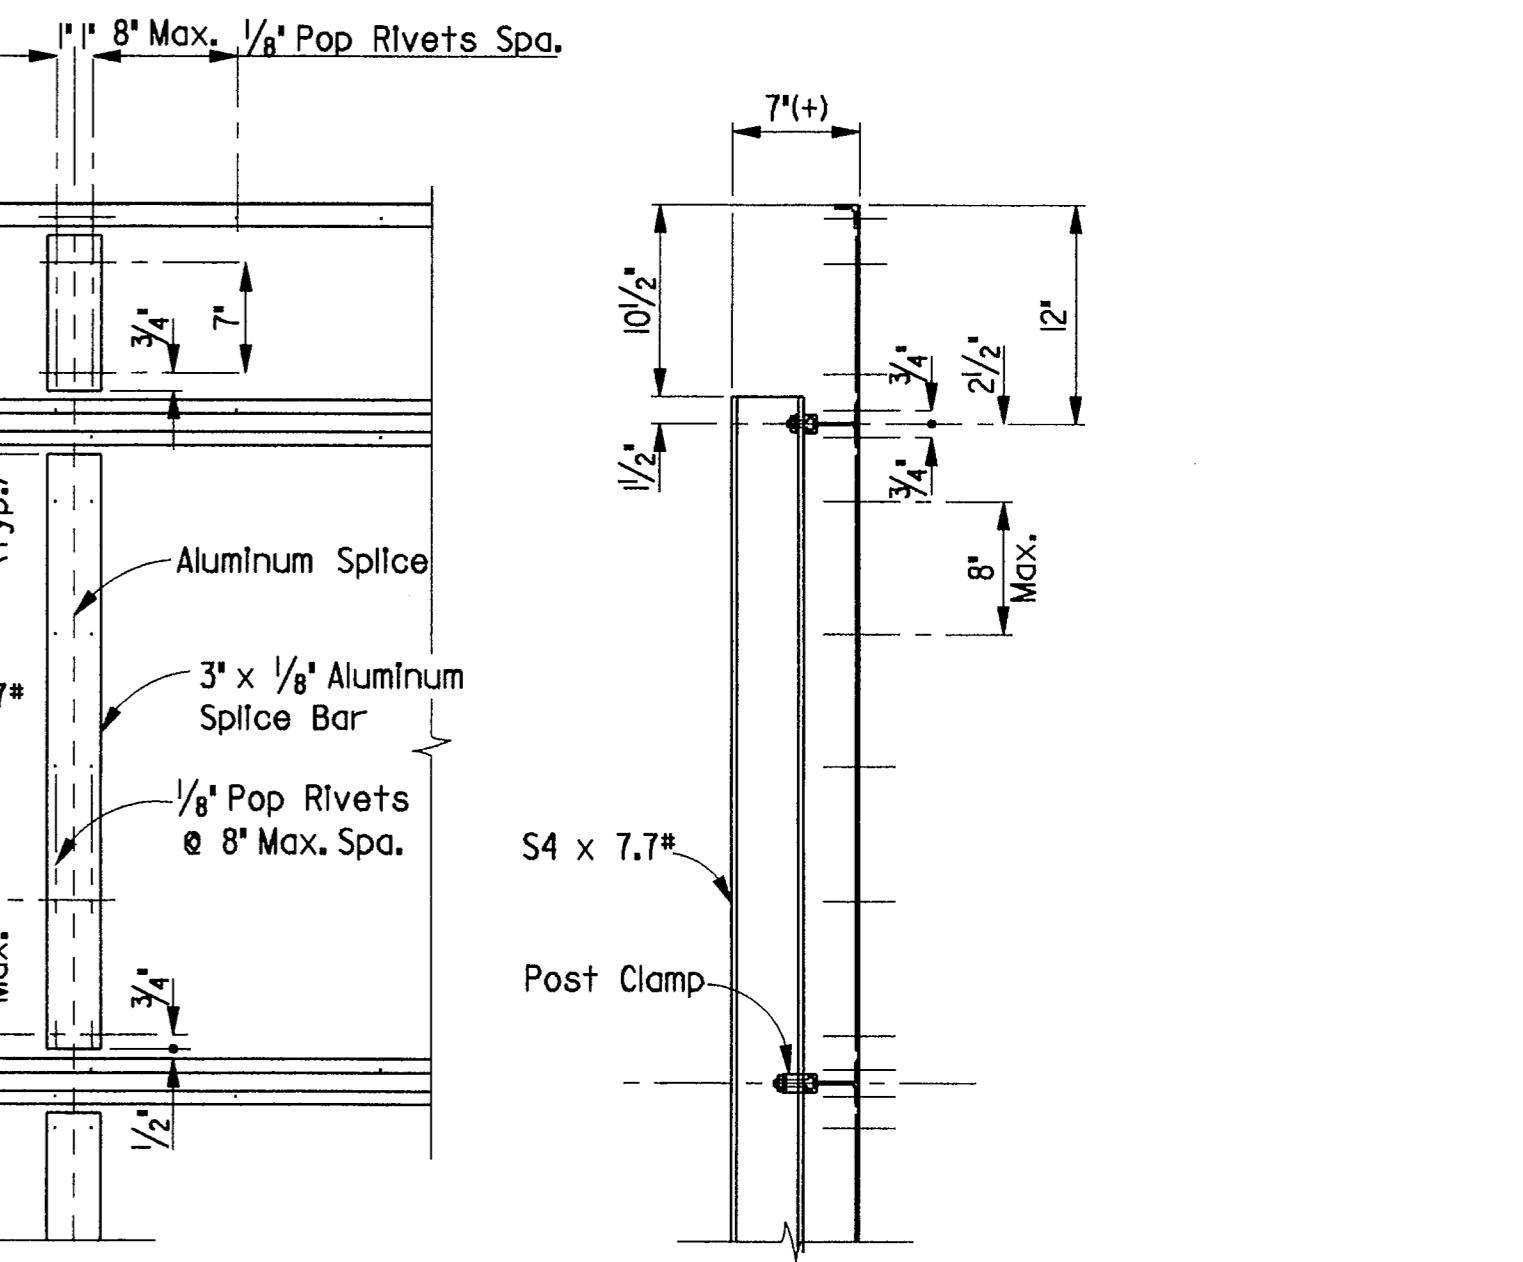


DETAIL B

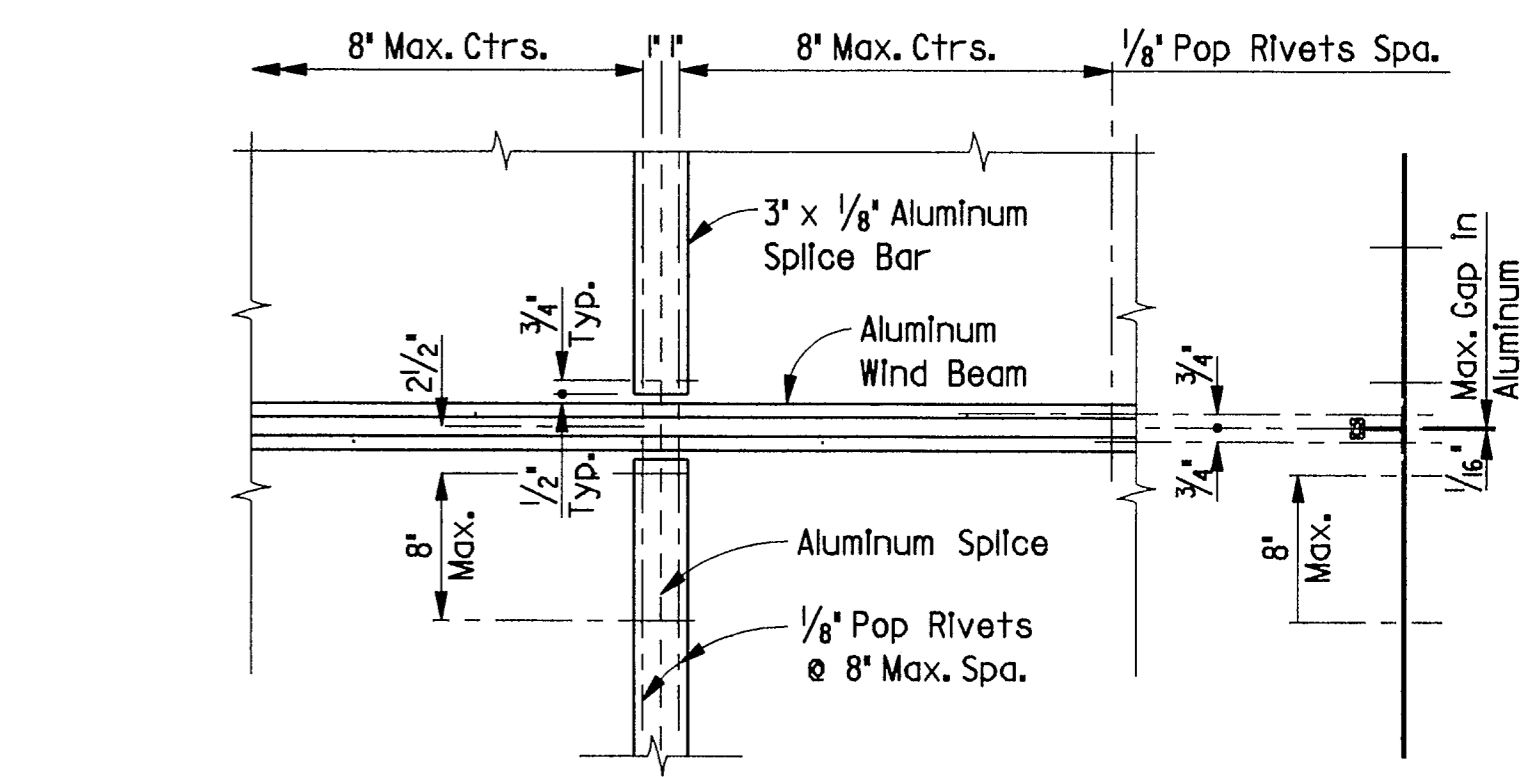


DETAIL C

POST CLAMP BOLT DETAIL


GENERAL NOTES:  
Materials, fabrication, construction and erection shall conform with the requirements of the Departments Material Specifications.  
All structural steel, bolts, nuts, washers, and pop rivets shall be galvanized after fabrication.  
Refer to Sheet SB(SWL-1) (MOD.) for details not shown.

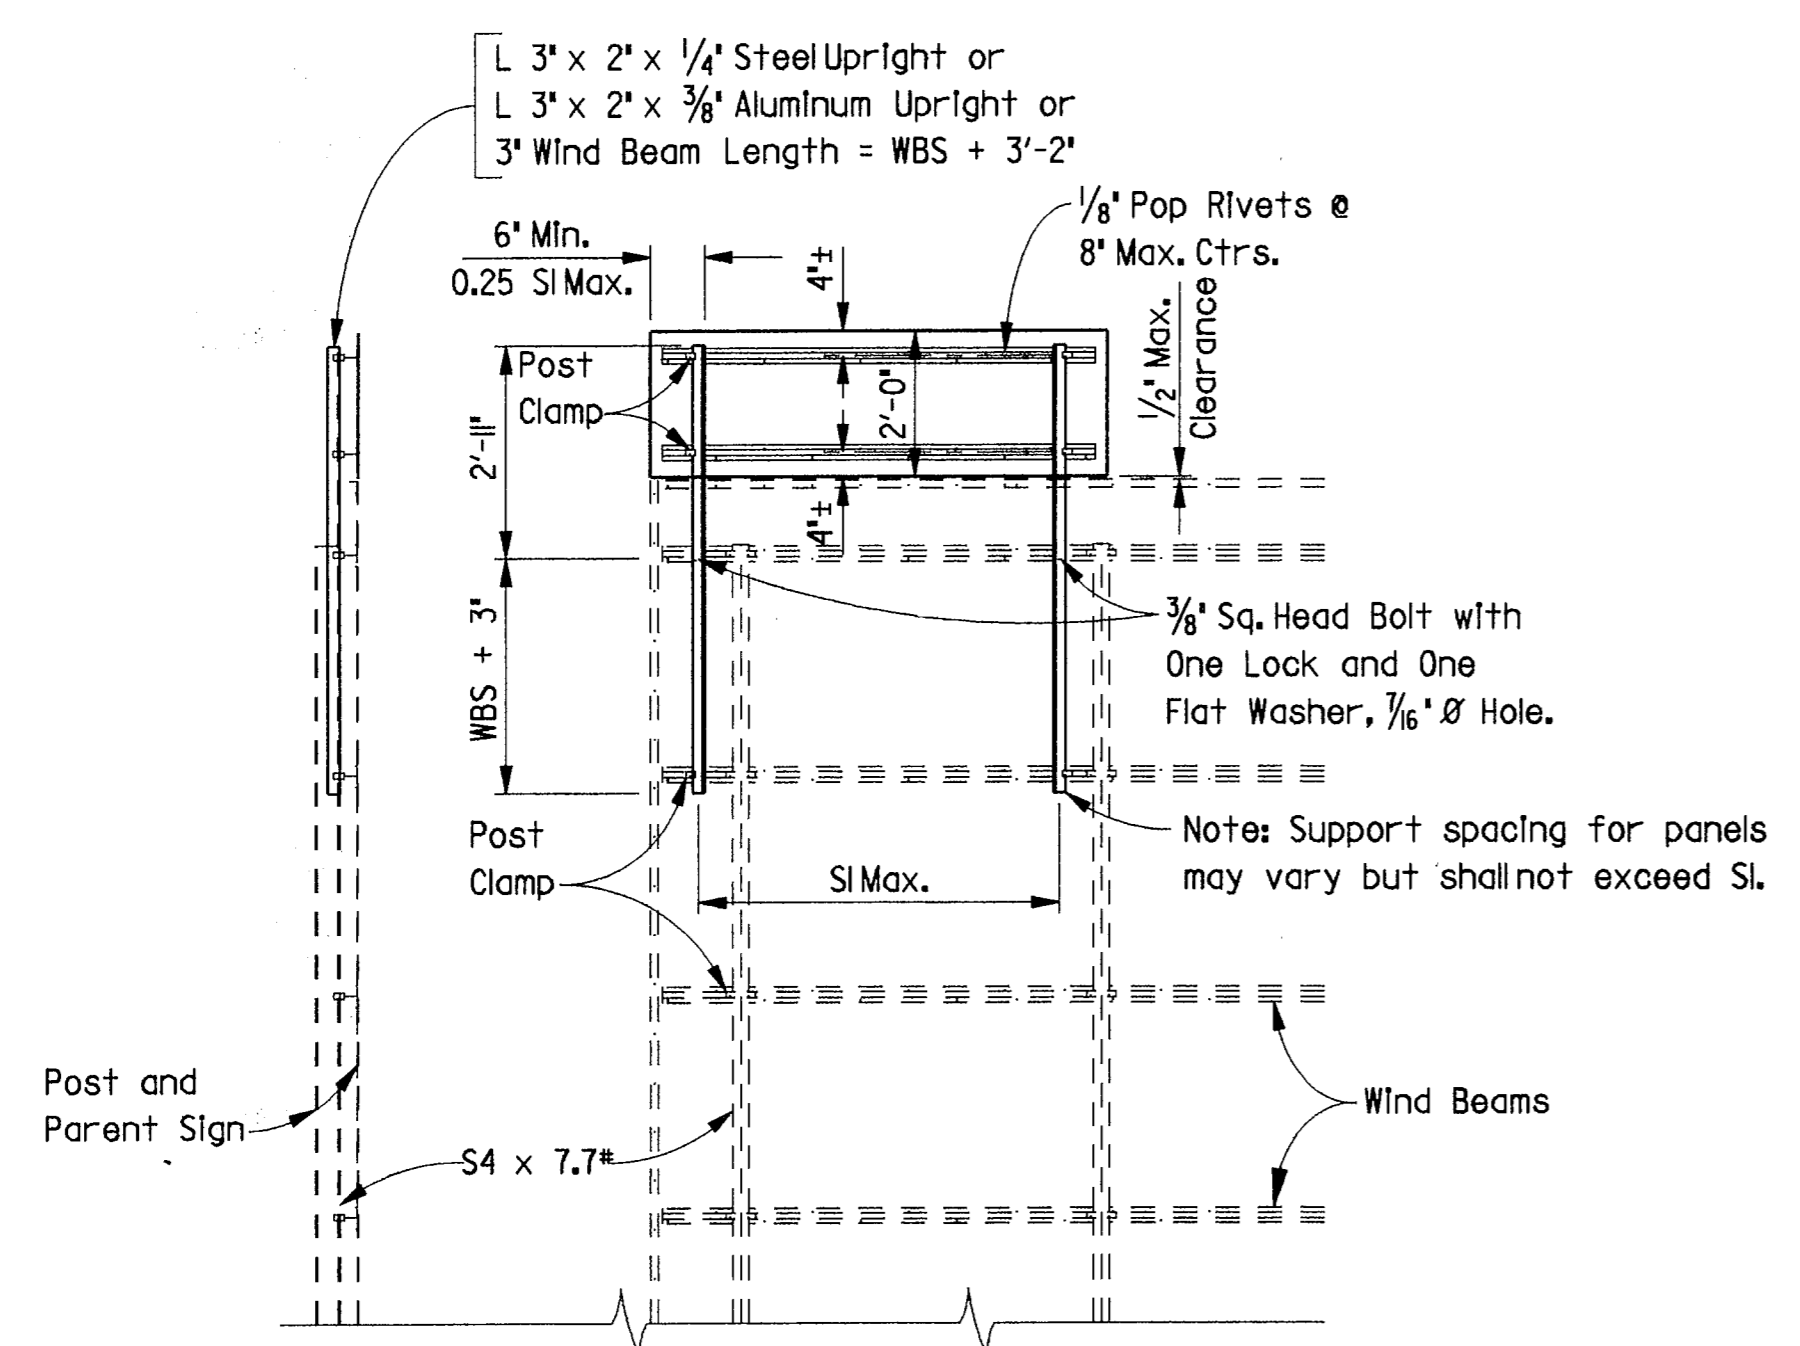

EXIT NUMBER PANEL MOUNTING DETAILS

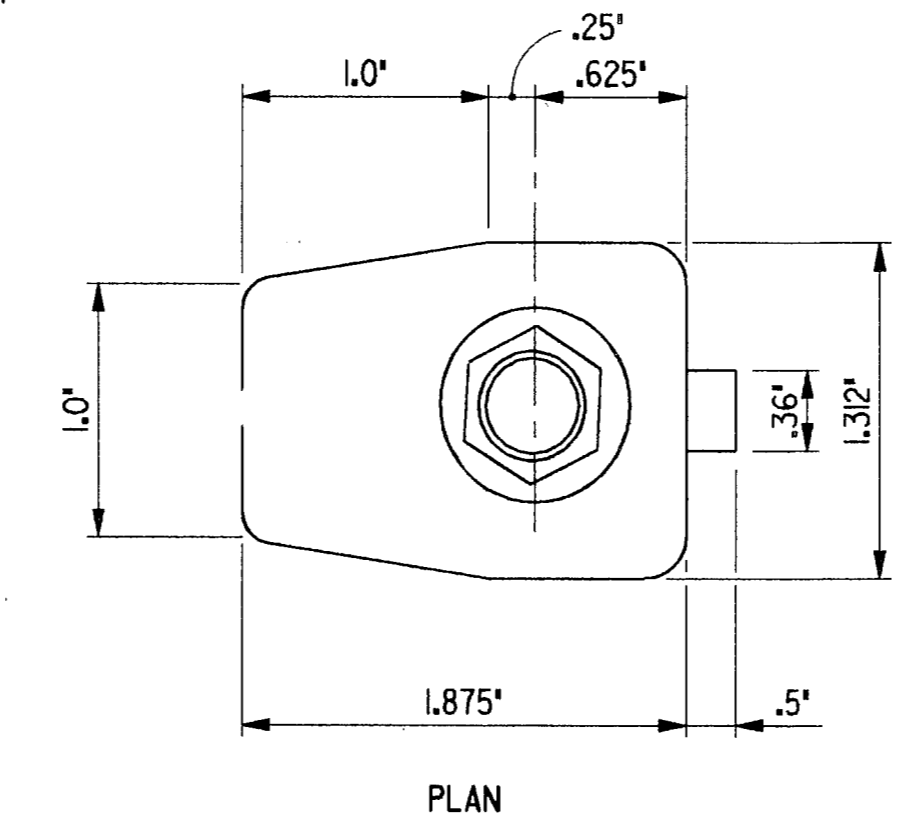


PLAN

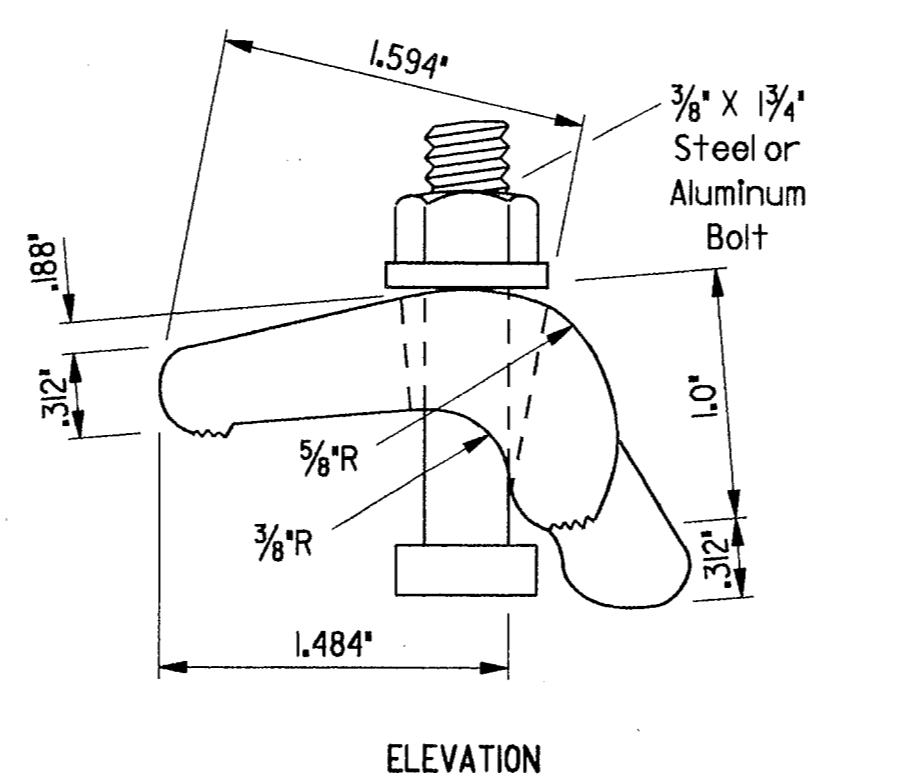

ELEVATION

ALTERNATE POST CLAMP DETAIL

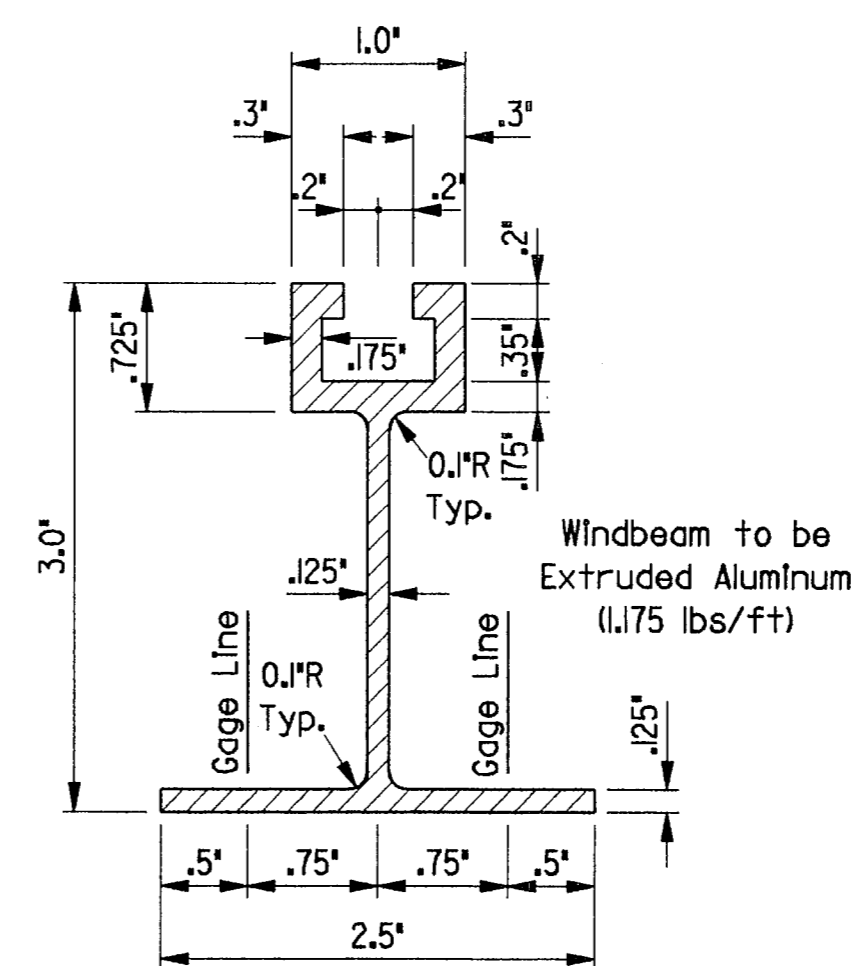


WINDBEAM CROSS SECTION

DN:LR	DATE:
CK:GW	
DW:DN	
CK:MT	
LEVELS DISPLAYED	FILE:
1 2 3 4 5 6 7 8 9 10 11 12 13 14 15 16	
17 18 19 20 21 22 23 24 25 26 27 28 29 30 31 32	
33 34 35 36 37 38 39 40 41 42 43 44 45 46 47 48	
49 50 51 52 53 54 55 56 57 58 59 60 61 62 63	

FINAL RECORD  
DRAWING  
Date: 12/25/99

ISSUE DATE: 04-09-97

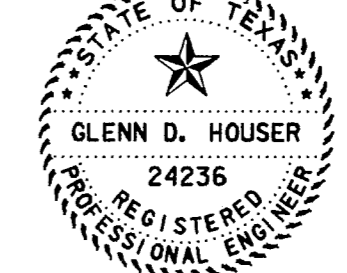


THE SEAL APPEARING ON THIS DOCUMENT WAS AUTHORIZED BY GLENN D. HOUSER, P.E. 24236 ON OCTOBER 16, 1997. ALTERATION OF A SEALED DOCUMENT WITHOUT NOTIFICATION TO THE RESPONSIBLE ENGINEER IS AN OFFENSE UNDER THE TEXAS ENGINEERING PRACTICE ACT.

STANDARD PLANS  
TEXAS DEPARTMENT OF TRANSPORTATION  
Traffic Operations Division


STRUCTURAL MOUNTING  
DETAILS FOR  
OVERHEAD SIGN BRIDGES  
SMD(P-1) (MOD.)

ORIG. DRAW. DATE:	DN:	CK:	DW:	CK:	NEG. NO.:
REVISIONS	STATE DISTRICT	FEDERAL REGION	FEDERAL AID PROJECT	SHEET	
11-96 (ALL) 4-97	6			COUNTY	CONTROL SECTION JOB HIGHWAY

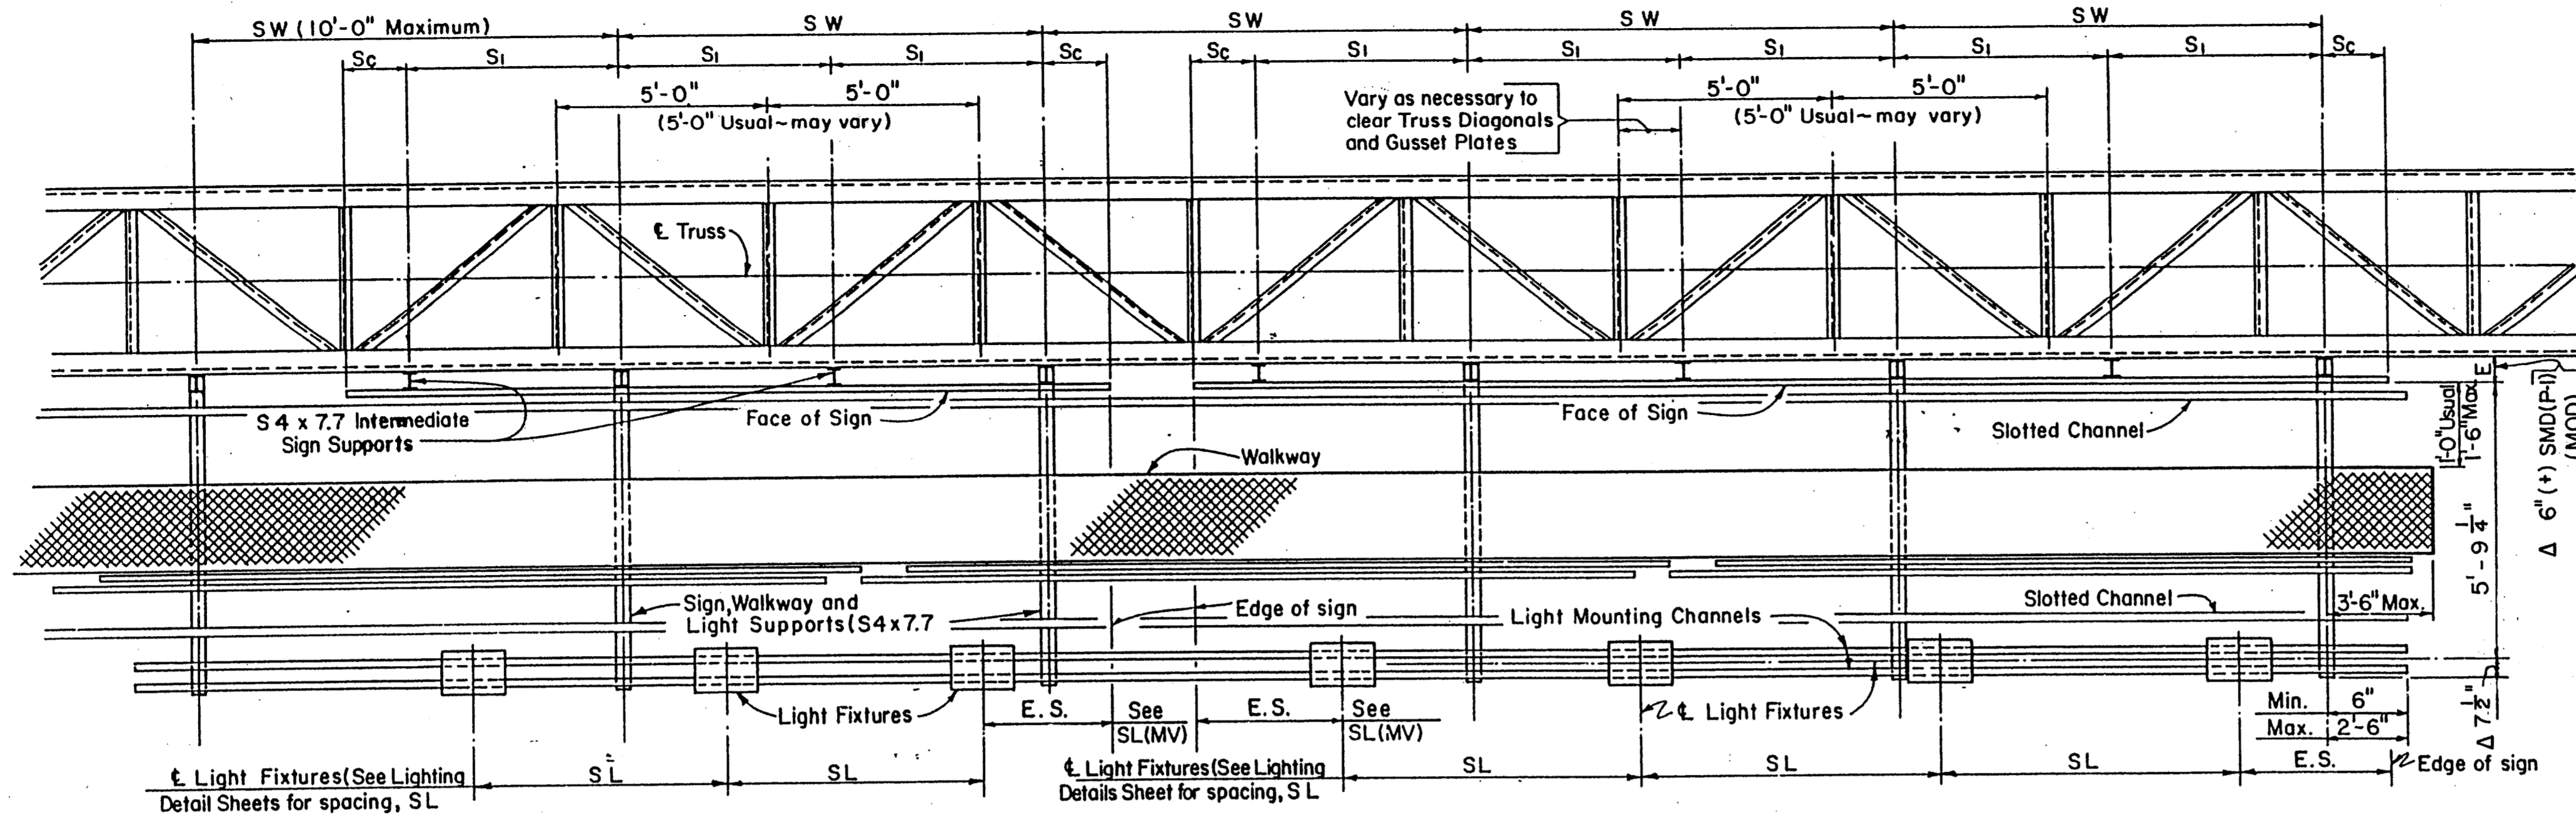

**PART PLAN**


(Showing Truss, Signs, Walkways and Lights)

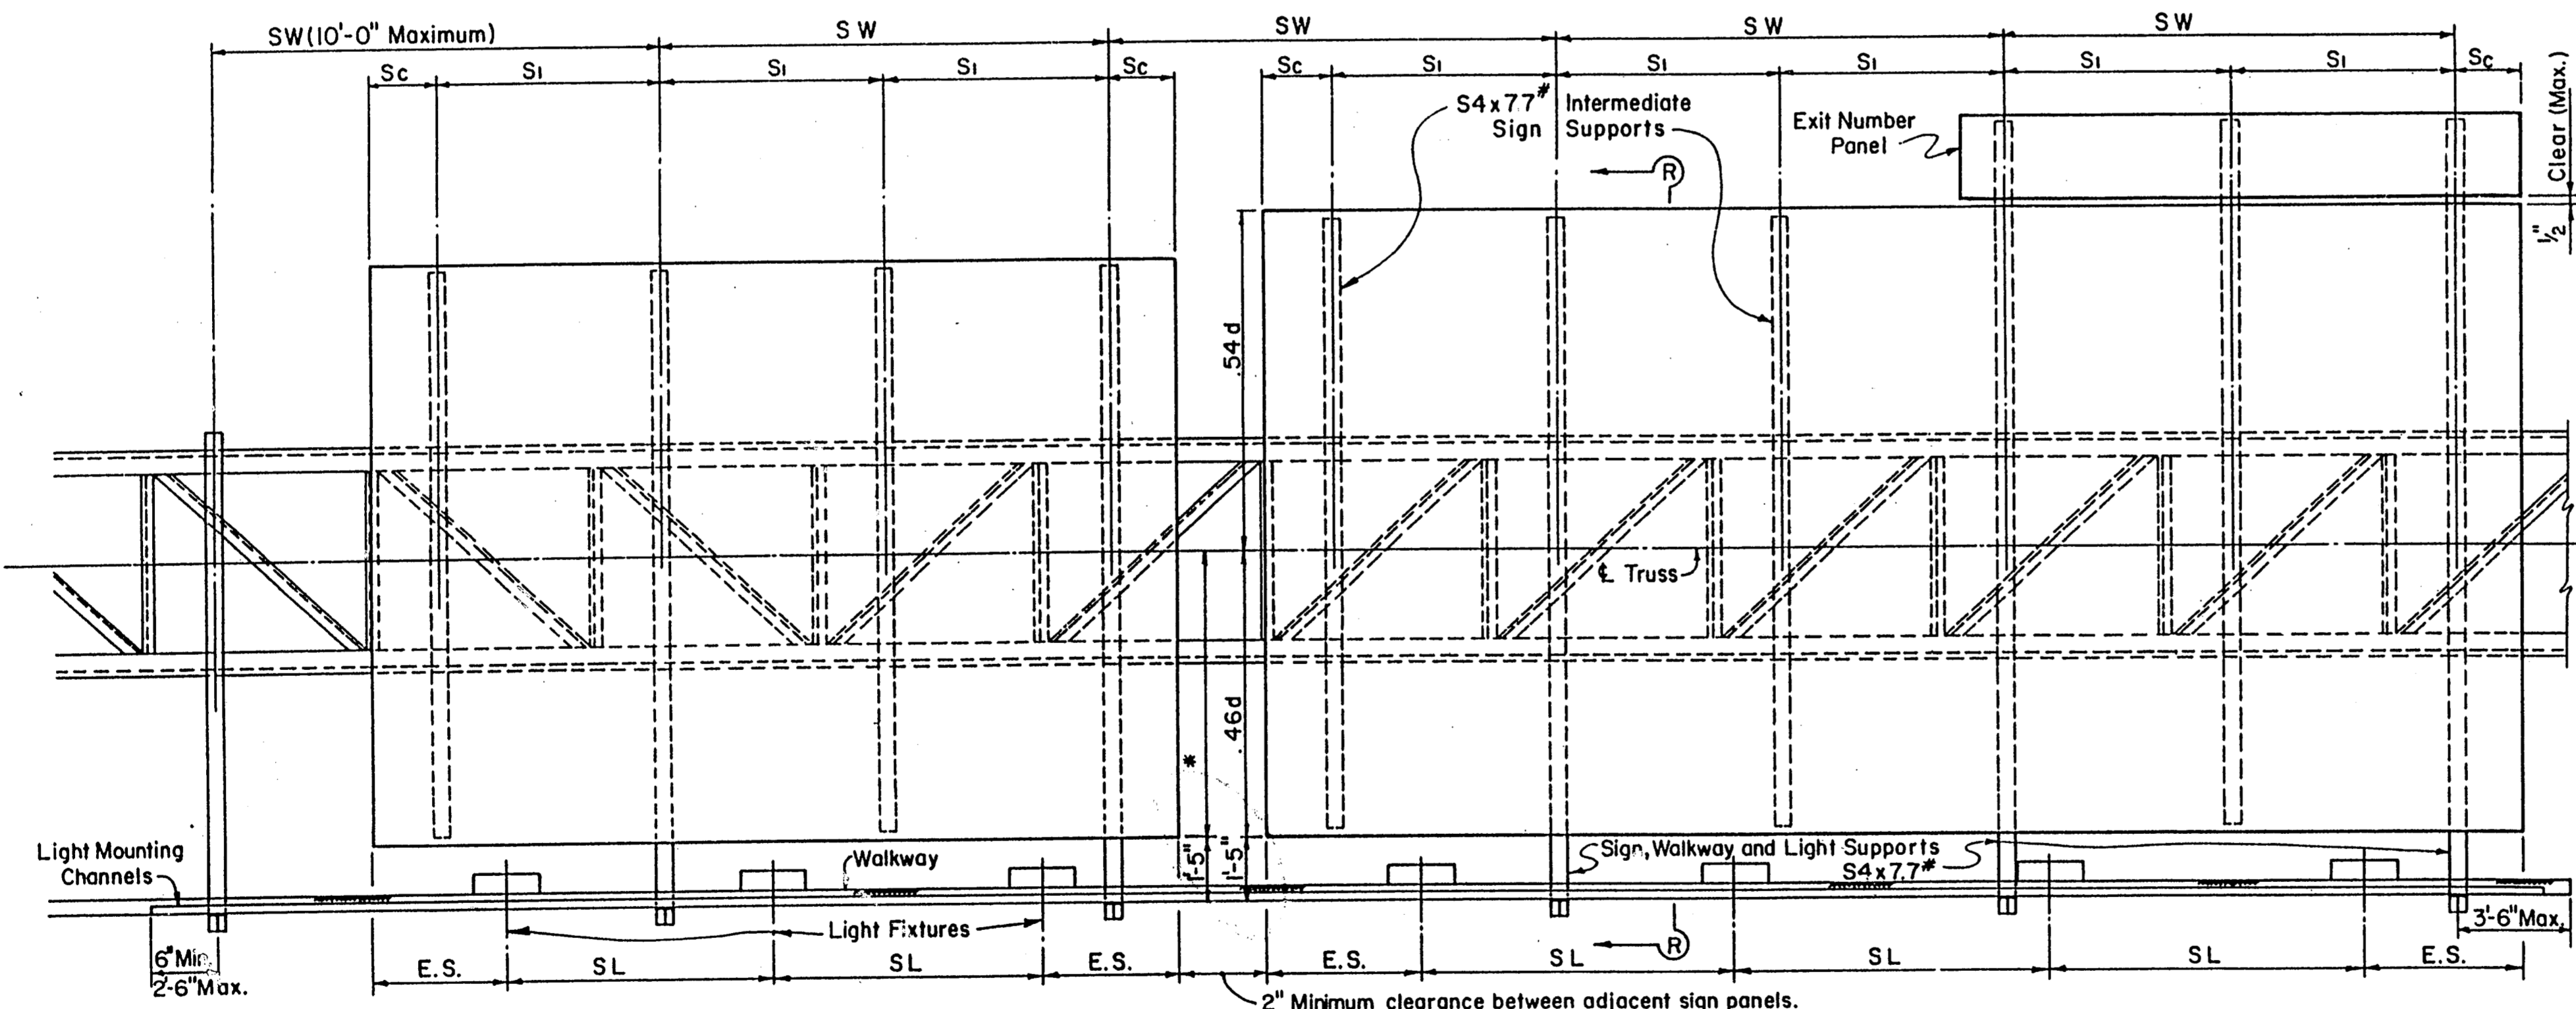

**PART ELEVATION**

\* Where signs of different depths are used, the bottom edges of all signs may be placed in line. Where this is done, all signs should be so positioned that the bottom edges are approximately 0.45 of the depth of the deepest sign below the centerline of the truss. When signs are spaced thusly, Si is determined by the deepest sign.

See Sheet SMD(P-1)(MOD) for Sign Details & Max. Spa. for S:  
Sc = 6" Minimum, .25 Si Maximum.

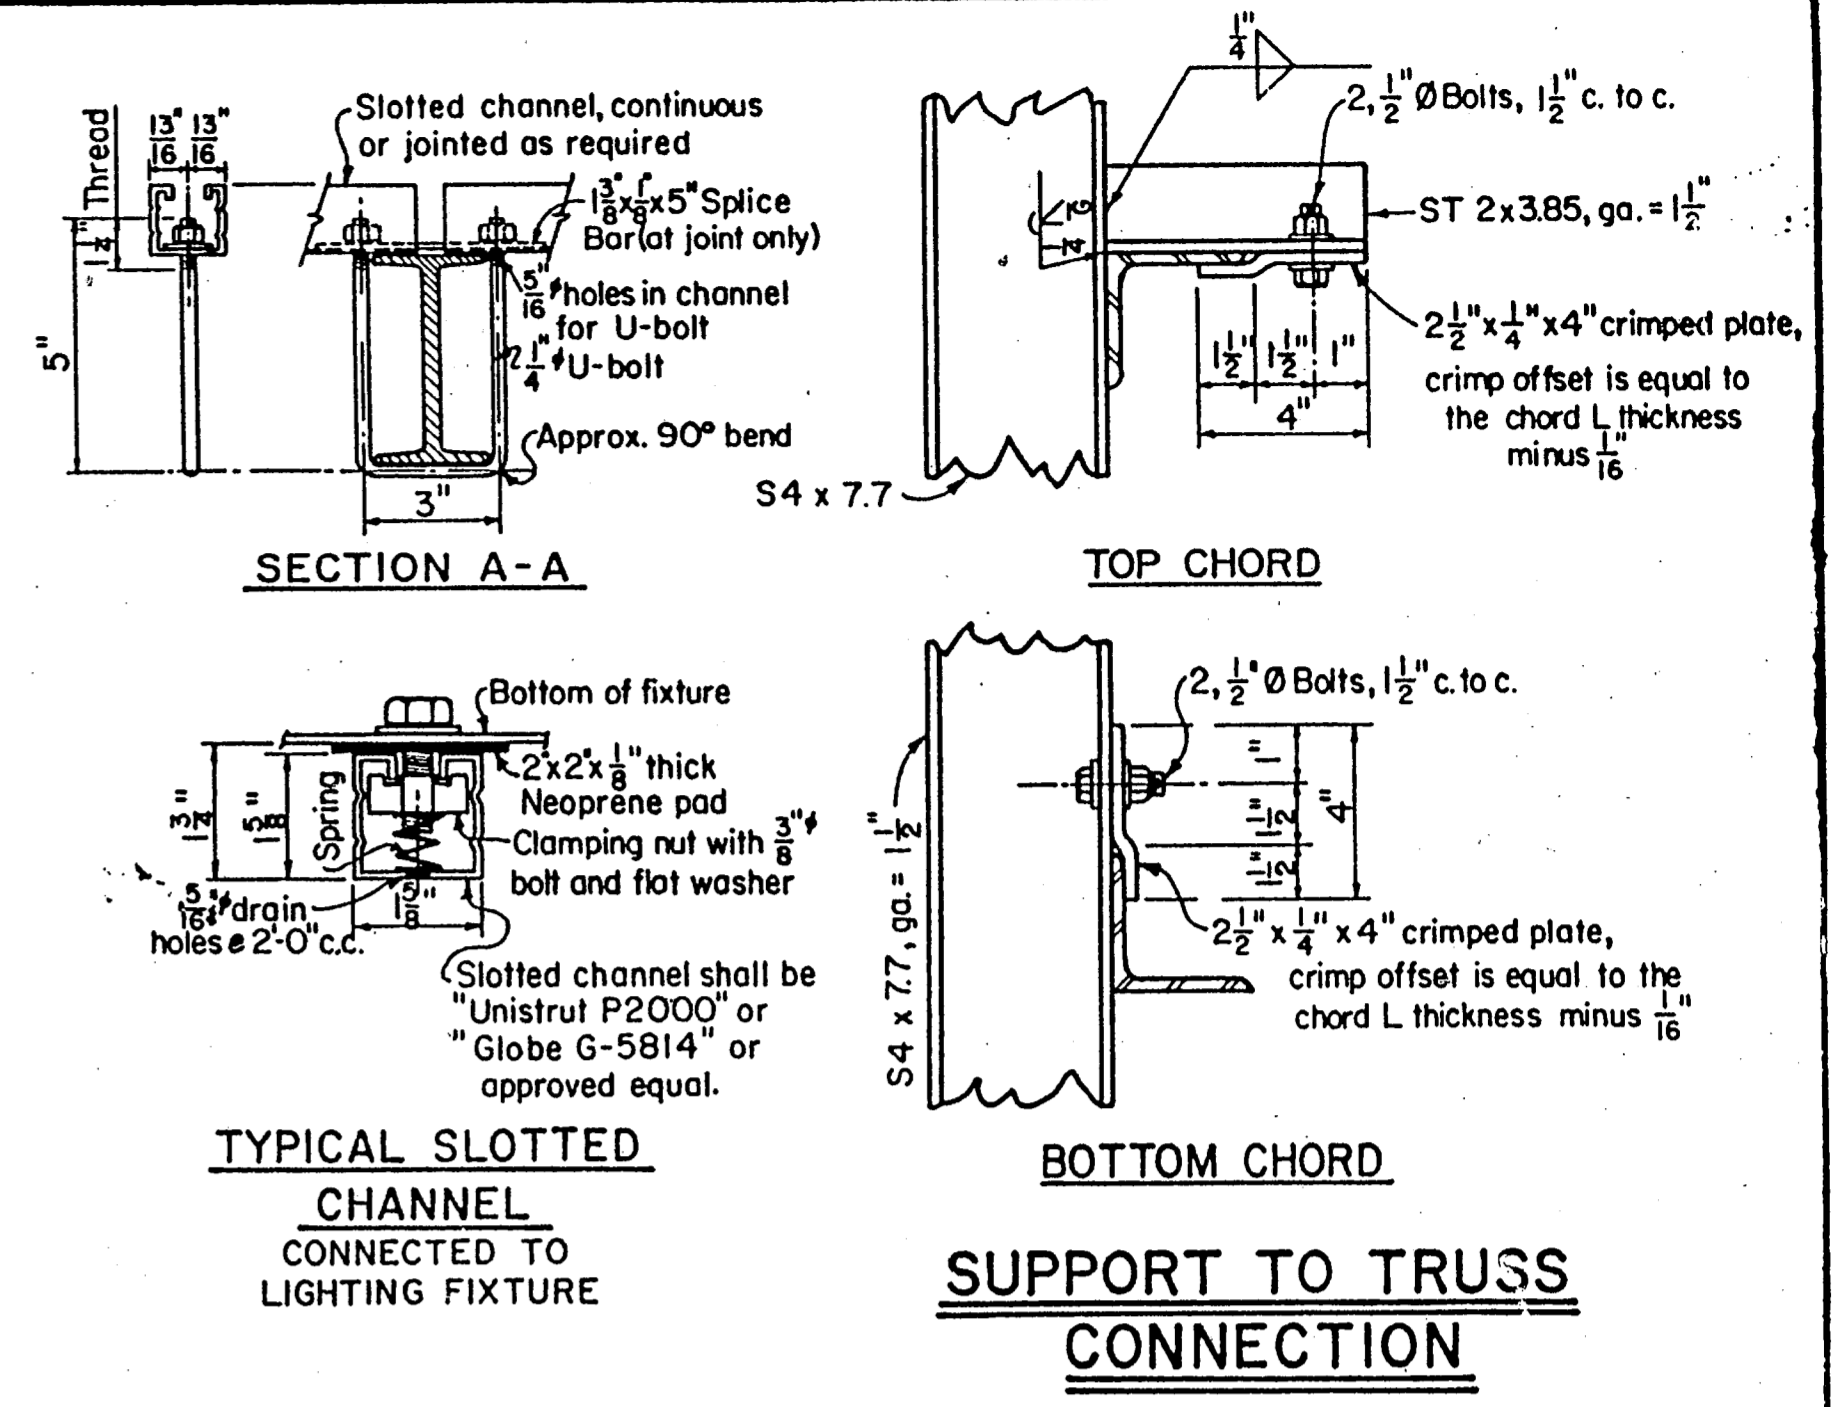

**TYPICAL SLOTTED CHANNEL CONNECTED TO LIGHTING FIXTURE**

**SUPPORT TO TRUSS CONNECTION**


NOTE: Exit Panel may be supported by sign support brackets as shown hereon, or may be supported as shown on sheet SMD(P-1)(MOD). Regardless of method used spacing of supports shall not exceed Si.

GENERAL NOTES:  
Design conforms to the AASHTO Standard Specifications for Structural Supports for Highway Signs, Luminaires and Traffic Signals.  
Materials, Fabrication, Construction and Erection shall conform with the requirements of specifications for Interstate Signing and Delineation Projects and Texas Department of Highways and Public Transportation Standard Specifications for Construction of Highways, Streets and Bridges. Structural Steel shall conform with A.S.T.M. Specification A36 unless noted otherwise.  
Bolts shall have Hexagon Heads and Nuts and conform with A.S.T.M. Specification A307.  
All parts shall be galvanized after fabrication




NOTE: WALKWAYS AND SIGN LIGHTS SHALL NOT BE PROVIDED AS A PART OF THIS PROJECT.

FINAL RECORD DRAWING  
Date: 12/25/99

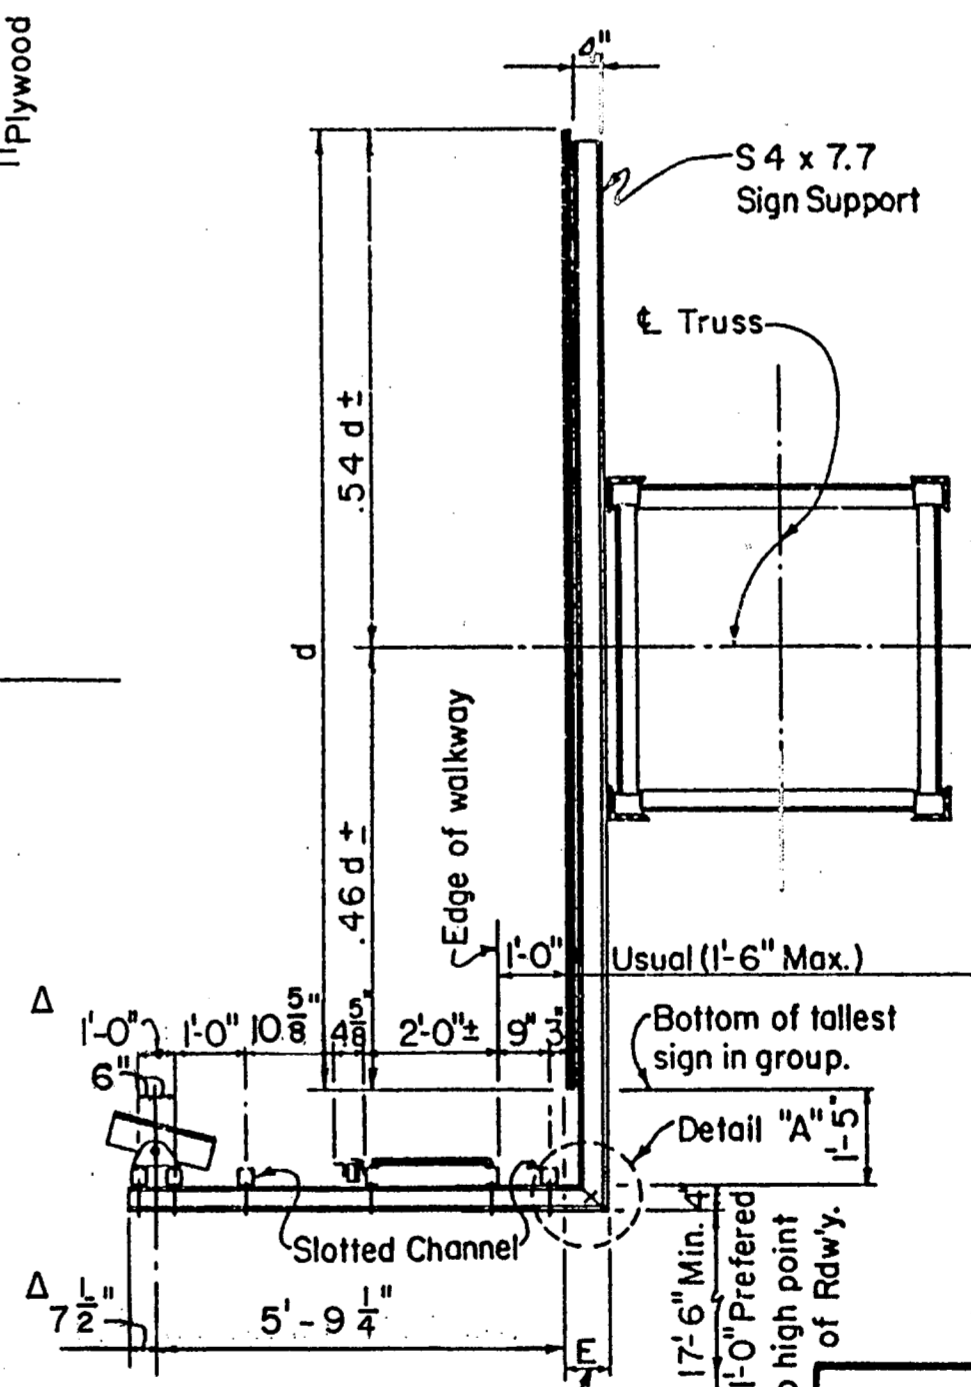

**SECTION R-R**

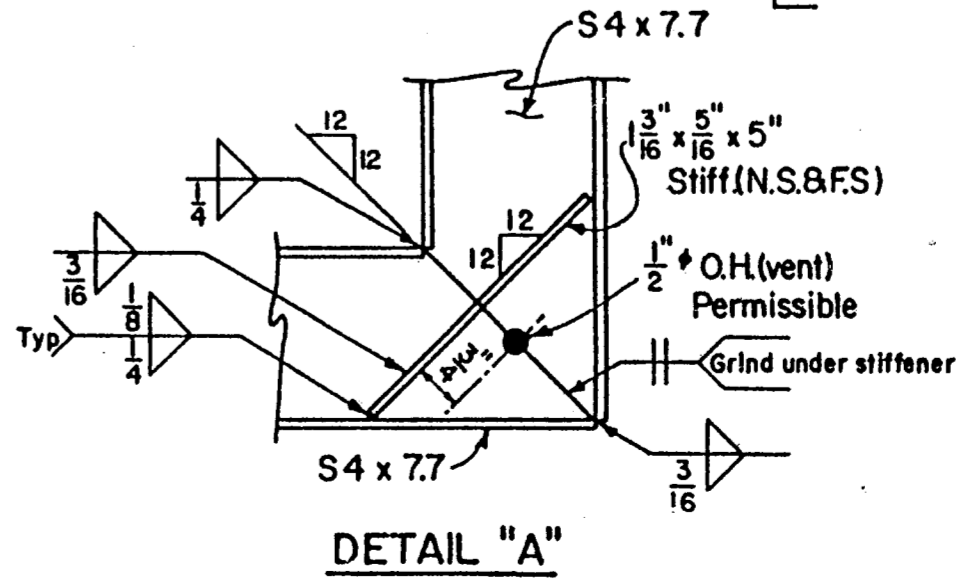

**DETAIL "A"**

STATE DEPARTMENT OF HIGHWAYS AND PUBLIC TRANSPORTATION  
**SUPPORT BRACKETS FOR SIGNS, WALKWAY & LIGHTS**  
**SB (SWL-1)(MOD.)**

ORIGINAL DRAWING DATE: 2-82	STATE FEDERAL DISTRICT REGION	FEDERAL AID PROJECT	SHEET
DR: CWC	REVISIONS	DALLAS 6	54
DR: EDS		COUNTY	CONTROL SECTION JOB HIGHWAY
DR: CWC		GOLLIN	25-4 05 029

84

DISCLAIMER  
 The use of this standard is governed by the Texas Engineering Practice Act. No warranty of any kind is made by TxDOT for any purpose whatsoever. TxDOT assumes no responsibility for the conversion of this standard to other formats or for incorrect results or damages resulting from its use.

DNHLR  
 CK:CV  
 DW:DN  
 CK:MT  
 DATE: \_\_\_\_\_  
 ACC: d58hpic/usr/d580504  
 FILE: \_\_\_\_\_  
 LEVELS DISPLAYED: 1 2 3 4 5 6 7 8 9 10 11 12 13 14 15 16 17 18 19 20 21 22 23 24 25 26 27 28 29 30 31 32 33 34 35 36 37 38 39 40 41 42 43 44 45 46 47 48 49 50 51 52 53 54 55 56 57 58 59 60 61 62 63

## GENERAL NOTES

- MINOR OPERATION is defined as those activities that will require traffic control devices to warn or direct traffic during daytime conditions. At the end of each work day, all traffic control devices should be removed from the view of motorists and no unusual conditions or potential hazards should exist that require advance warning.
- MAJOR OPERATION is defined as those activities that may effect traffic during daytime and nighttime conditions. Work activities on high speed, high volume roadways may also be considered a major operation.
- Additional details may be provided in the plans concerning sign size, type of channelization devices, sequence of work details, and required measures needed to control traffic during changes in the sequence of work.
- All distance and spacing shown on the TCP Standards are approximate.
- All traffic control devices used during nighttime shall be reflectorized, illuminated from within or externally illuminated.
- Additional information for fabrication, erection and usage of the following traffic control devices is found in the Texas Manual on Uniform Traffic Control Devices (TMUTCD) and Barricade and Construction (BC) Standards:
  - BARRICADES BC(2) and BC(3)
  - CONES BC(3)
  - DELINEATION WZ (BD)
  - DRUMS BC(3)
  - PAVEMENT MARKINGS BC(8) and BC(9)
  - SIGNS WZ (STPM) or TCP(7-1) if applicable  
BC(4), BC(5), BC(6), BC(7)

## SIGNS

- Selection of sign size should be based on Table I.
- Flashing warning lights, channelizing devices and/or flags may be required to call attention to the advance warning signs.
- The words UTILITY, SIGNAL, BRIDGE, LIGHTING, SIGN, STREET or RAMP may be substituted for ROAD in all signs where applicable.
- Advisory speed plaques, if used in conjunction with warning signs, speeds shall be determined in the field by the Engineer.
- Regulatory signs shall be mounted at 5 foot minimum mounting height for rural areas and 7 foot minimum mounting height for urban areas.
- Warning signs may be mounted on three types of supports at the minimum mounting heights as stated on BC(4):
  - Portable (1 foot)
  - Temporary (3 feet)
  - Fixed (5 feet rural, 7 feet urban)



The illustrated sign spacing (X) and distance message (500 FT, 1000 FT, 1500 FT) are based on 55 mph 85th percentile speed with distance rounded to the nearest 500 feet. For slower speeds or minor operations, the word 'AHEAD' may be used in lieu of the distance message.

## CHANNELIZING DEVICES

- The maximum spacing between channelizing devices in a taper should be approximately equal in feet to the speed limit (S).
- When channelizing devices are used to direct traffic across existing lane line or edge lines the spacing between channelizing devices shall be reduced by as much as 50%.
- Channelizing device spacing should be reduced when placed on curves, hills or next to potential hazards. At least three channelizing devices should be in view at all times.
- Lane closure taper length is equal to 'L'. Shifting taper length is equal to 1/2 L. Shoulder closure taper length is equal to 1/2 L.
- Tapers downstream from the work area are optional and when used should be 50'-100' long.
- Tapers shall be 50 feet minimum length when placed downstream of a flagger, YIELD sign or STOP sign.
- The selection of channelizing devices should be based on degree of hazard associated with the work area. The selection priority of channelizing devices, in the order of increasing hazard recognition are:
  - portable mounted delineators
  - 28" cones
  - 36" or more tubular cones
  - portable mounted vertical panels
  - 36" cones
  - Type II Barricade
  - Type I Barricade
  - plastic drums
  - MBCF, fixed or barrel mounted
  - concrete traffic barrier
- Flashing arrow panels used on two-way, two-lane roadways should flash in the caution mode.

## FLAGGER CONTROL

- Flagger shall wear orange safety vests. Flaggers should wear safety hats to provide a professional image to the motorist and to protect the head from flying objects.
- STOP/SLOW paddles shall be used as the primary method to control traffic by flaggers. The STOP/SLOW paddle minimum size is 18" x 18". Paddles may be attached to a 60 inch staff for easier handling. The larger size (24" x 24") should be attached to a 60 inch staff.
- Flags are only used to control traffic for emergency situations and the STOP/SLOW paddles are not available.
- Flaggers may carry hand held air horns to alert workers of an emergency condition.
- For one lane two-way traffic control, one or more flaggers should be used where traffic density, road conditions or motorists' sight distance justify their use. If flaggers are used, the taper should be reduced to 50 feet minimum. When flaggers are used to control traffic, the FLAGGER symbol sign (FCW20-7a) shall be used. When flaggers are used, the BE PREPARED TO STOP sign (FCW21-8) should be used. Proper spacing between signs should be maintained.
- When flaggers are used to draw attention to traffic control devices, the FLAGGER symbol sign should be used. Proper spacing should be maintained.
- When more than one flagger is used, a chief flagger should be assigned the responsibility of making decisions concerning traffic control.

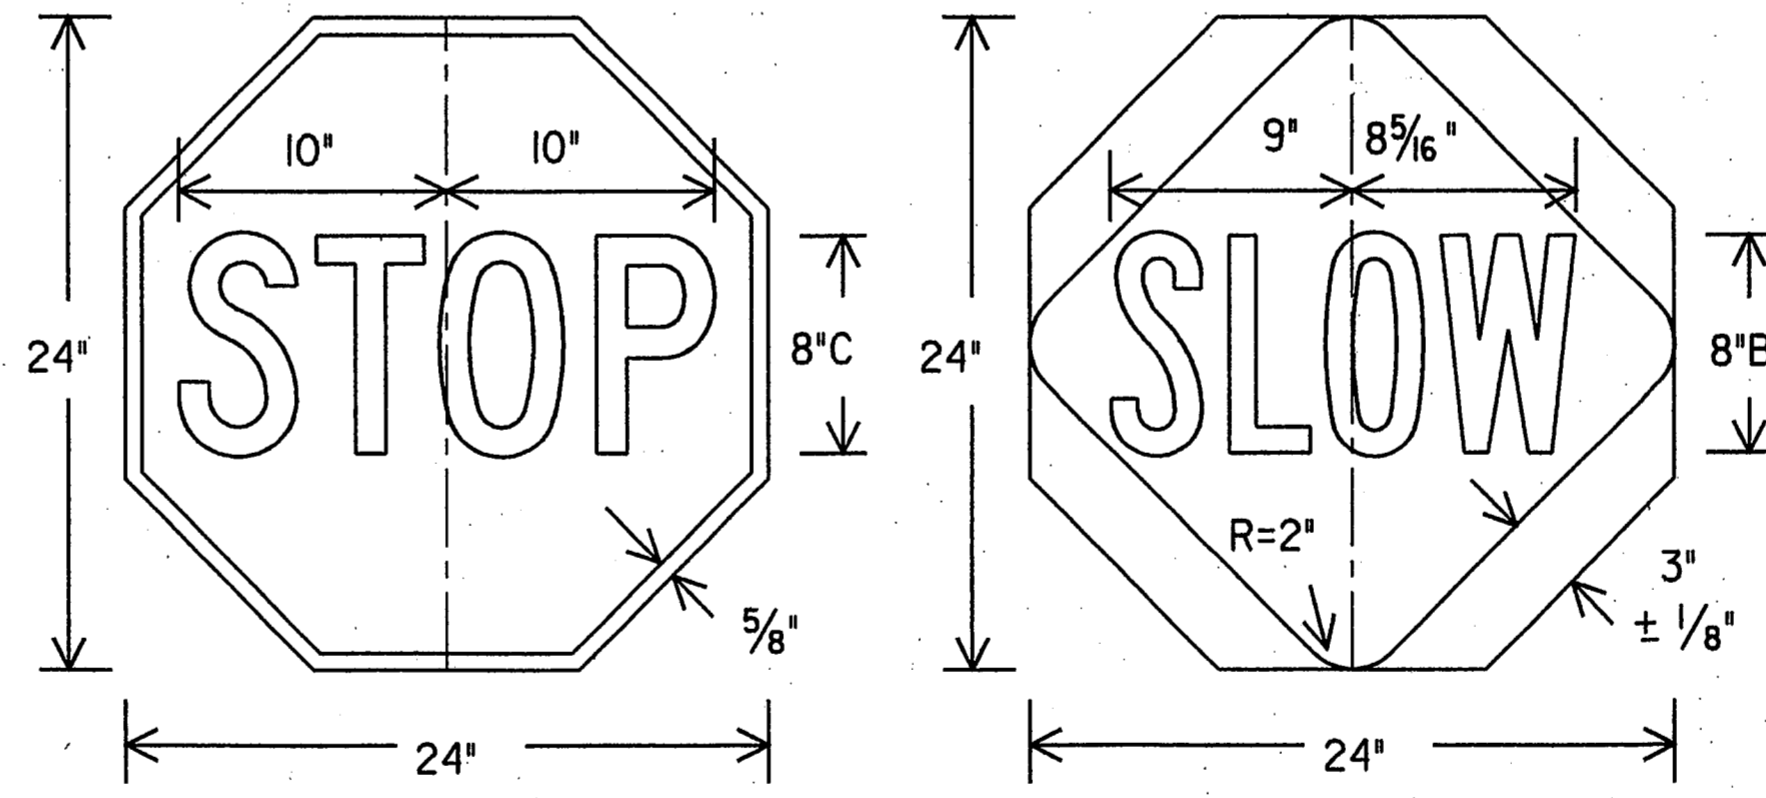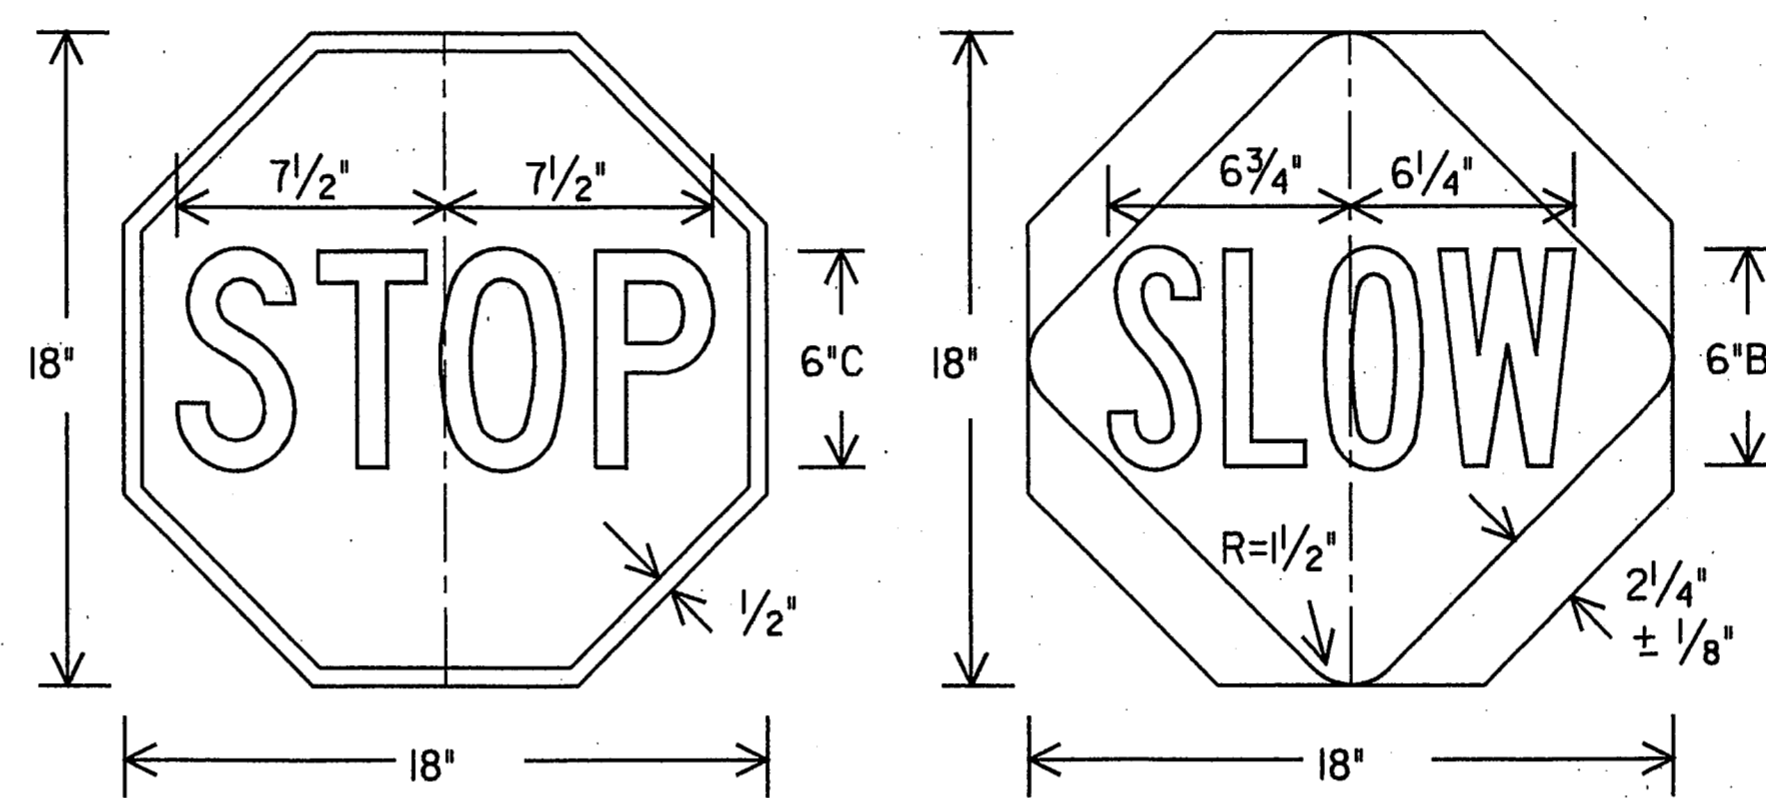

## WORKER SAFETY

- Workers exposed to traffic should wear orange safety vests.
- Work vehicles within 30 feet of the traveled way should have strobe lights or rotating beacons in use.
- When work vehicles are used to shadow the work area, the vehicle should be parked 30 feet or more from the work area, transmission in gear (or set in PARK), emergency brake set on, and front wheels turned away from work area.
- Inactive work vehicles, including workers' private vehicles, should be parked away from the work area and as close to the right-of-way line as possible.

Table I  
TYPICAL CONSTRUCTION WARNING SIGN SIZE AND SPACING

Roadway Classification	Posted Speed	Sign Spacing	Major Construction Or Major Maintenance Approach Warning Signs		Minor Construction Or Minor Maintenance Approach Warning Signs		Other Warning Signs
			Standard Inches	Minimum <sup>4</sup> Inches	Standard Inches <sup>7</sup>	Minimum <sup>4</sup> Inches <sup>7</sup>	
Conven.	30	80	48X48	36X36	30X30 or 36X36	24X24 or 30X30	30X30 or 36X36
	35	120					
	40	160					
	45	240					
	50	320					
Exp or Frwy	55	500 <sup>3</sup>	48X48	48X48	48X48*	48X48*	48X48*
	65	750 <sup>3</sup>					

▲ Minimum distance from work area to First Advance Warning sign and/or distance between each additional sign.

\* Smaller sign sizes may be used where sign designs have not been included in the 'Standard Highway Sign Design for Texas' publication.

### General Notes:

- Special or larger size signs may be used as may be necessary.
- Distance between signs should be increased as required to have 1500' advance warning.
- Distance between signs should be increased as required to have 1/2 mile or more advance warning.
- For use only on secondary roads or city streets where speeds are low.
- Only diamond shaped warning signs are indicated.
- See sign listing in TMUTCD, Appendix A for complete list of all available sign design sizes.
- Where two sizes are listed, see sign listing in TMUTCD, Appendix A for proper size.

FINAL RECORD  
DRAWING  
Date: 12/25/99

STANDARD PLANS  
TEXAS DEPARTMENT OF TRANSPORTATION  
Traffic Operations Division

## TRAFFIC CONTROL PLAN

TCP NOTES-95

ORG DRAW DATE: February, 1994	DN: LR/MT	CK: DN	CK: MT	REG NO: _____
REVISIONS	STATE DISTRICT	FEDERAL REGION	FEDERAL AID PROJECT	SHEET
8-95	6			52
COUNTY	CONTROL SECTION	JOB	HIGHWAY	



18 NORTH TEXAS TOLLWAY AUTHORITY SUPPLEMENTAL AGREEMENT FOR EXTRA WORK. PROJECT: Addison Airport Tunnel. DATE: 8/19/98. SHEET NO. 1 OF 2. CONTRACT NO. DNT-260. H.B. Zachry Company (CONTRACTOR). PO Box 53158, Grand Prairie, TX 75053 (ADDRESS).

19 NORTH TEXAS TOLLWAY AUTHORITY SUPPLEMENTAL AGREEMENT FOR EXTRA WORK. PROJECT: Addison Airport Tunnel. DATE: 7/20/98. SHEET NO. 1 OF 2. CONTRACT NO. DNT-260. H.B. Zachry Company (CONTRACTOR). PO Box 53158, Grand Prairie, TX 75053 (ADDRESS).

20 NORTH TEXAS TOLLWAY AUTHORITY SUPPLEMENTAL AGREEMENT FOR EXTRA WORK. PROJECT: Addison Airport Tunnel. DATE: 8/27/98. SHEET NO. 1 OF 1. CONTRACT NO. DNT-260. H.B. Zachry Company (CONTRACTOR). PO Box 53158, Grand Prairie, TX 75053 (ADDRESS).

21 NORTH TEXAS TOLLWAY AUTHORITY SUPPLEMENTAL AGREEMENT FOR EXTRA WORK. PROJECT: Addison Airport Tunnel. DATE: 8/27/98. SHEET NO. 1 OF 2. CONTRACT NO. DNT-260. H.B. Zachry Company (CONTRACTOR). PO Box 53158, Grand Prairie, TX 75053 (ADDRESS).

22 NORTH TEXAS TOLLWAY AUTHORITY SUPPLEMENTAL AGREEMENT FOR EXTRA WORK. PROJECT: Addison Airport Tunnel. DATE: 8/27/98. SHEET NO. 1 OF 2. CONTRACT NO. DNT-260. H.B. Zachry Company (CONTRACTOR). PO Box 53158, Grand Prairie, TX 75053 (ADDRESS).

23 NORTH TEXAS TOLLWAY AUTHORITY SUPPLEMENTAL AGREEMENT FOR EXTRA WORK. PROJECT: Addison Airport Tunnel. DATE: 10/6/98. SHEET NO. 1 OF 1. CONTRACT NO. DNT-260. H.B. Zachry Company (CONTRACTOR). PO Box 53158, Grand Prairie, TX 75053 (ADDRESS).

24 NORTH TEXAS TOLLWAY AUTHORITY SUPPLEMENTAL AGREEMENT FOR ALTERED QUANTITY AND/OR UNIT PRICES. PROJECT: Addison Airport Toll Tunnel. DATE: November 25, 1998. SHEET NO. 1 OF 1. CONTRACT NO. DNT-260. H.B. Zachry Company (CONTRACTOR). PO Box 53158, Grand Prairie, TX 75053 (ADDRESS).

25 NORTH TEXAS TOLLWAY AUTHORITY SUPPLEMENTAL AGREEMENT FOR EXTRA WORK. PROJECT: Addison Airport Tunnel. DATE: 12/31/98. SHEET NO. 1 OF 3. CONTRACT NO. DNT-260. H.B. Zachry Company (CONTRACTOR). PO Box 53158, Grand Prairie, TX 75053 (ADDRESS).

26 NORTH TEXAS TOLLWAY AUTHORITY SUPPLEMENTAL AGREEMENT FOR EXTRA WORK. PROJECT: Addison Airport Tunnel. DATE: 3/15/99. SHEET NO. 1 OF 1. CONTRACT NO. DNT-260. H.B. Zachry Company (CONTRACTOR). PO Box 53158, Grand Prairie, TX 75053 (ADDRESS).

27 NORTH TEXAS TOLLWAY AUTHORITY SUPPLEMENTAL AGREEMENT FOR EXTRA WORK. PROJECT: Addison Airport Tunnel. DATE: 3/17/99. SHEET NO. 1 OF 1. CONTRACT NO. DNT-260. H.B. Zachry Company (CONTRACTOR). PO Box 53158, Grand Prairie, TX 75053 (ADDRESS).

28 NORTH TEXAS TOLLWAY AUTHORITY SUPPLEMENTAL AGREEMENT FOR EXTRA WORK. PROJECT: Addison Airport Tunnel. DATE: 3/18/99. SHEET NO. 1 OF 2. CONTRACT NO. DNT-260. H.B. Zachry Company (CONTRACTOR). PO Box 53158, Grand Prairie, TX 75053 (ADDRESS).

29 NORTH TEXAS TOLLWAY AUTHORITY SUPPLEMENTAL AGREEMENT FOR EXTRA WORK. PROJECT: Addison Airport Tunnel. DATE: 3/18/99. SHEET NO. 2 OF 2. CONTRACT NO. DNT-260. H.B. Zachry Company (CONTRACTOR). PO Box 53158, Grand Prairie, TX 75053 (ADDRESS).

30 NORTH TEXAS TOLLWAY AUTHORITY SUPPLEMENTAL AGREEMENT FOR EXTRA WORK. PROJECT: Addison Airport Tunnel. DATE: 7/1/99. SHEET NO. 1 OF 1. CONTRACT NO. DNT-260. H.B. Zachry Company (CONTRACTOR). PO Box 53158, Grand Prairie, TX 75053 (ADDRESS).

31 NORTH TEXAS TOLLWAY AUTHORITY SUPPLEMENTAL AGREEMENT FOR EXTRA WORK. PROJECT: Addison Airport Tunnel. DATE: 7/1/99. SHEET NO. 1 OF 1. CONTRACT NO. DNT-260. H.B. Zachry Company (CONTRACTOR). PO Box 53158, Grand Prairie, TX 75053 (ADDRESS).

32 NORTH TEXAS TOLLWAY AUTHORITY SUPPLEMENTAL AGREEMENT FOR EXTRA WORK. PROJECT: Addison Airport Tunnel. DATE: 7/1/99. SHEET NO. 1 OF 1. CONTRACT NO. DNT-260. H.B. Zachry Company (CONTRACTOR). PO Box 53158, Grand Prairie, TX 75053 (ADDRESS).

33 NORTH TEXAS TOLLWAY AUTHORITY SUPPLEMENTAL AGREEMENT FOR EXTRA WORK. PROJECT: Addison Airport Tunnel. DATE: 7/1/99. SHEET NO. 1 OF 1. CONTRACT NO. DNT-260. H.B. Zachry Company (CONTRACTOR). PO Box 53158, Grand Prairie, TX 75053 (ADDRESS).

34 NORTH TEXAS TOLLWAY AUTHORITY SUPPLEMENTAL AGREEMENT FOR EXTRA WORK. PROJECT: Addison Airport Tunnel. DATE: 7/1/99. SHEET NO. 1 OF 1. CONTRACT NO. DNT-260. H.B. Zachry Company (CONTRACTOR). PO Box 53158, Grand Prairie, TX 75053 (ADDRESS).

FINAL RECORD DRAWING Date: 12/25/99. NORTH TEXAS TOLLWAY AUTHORITY ADDISON AIRPORT TUNNEL SUPPLEMENTAL AGREEMENTS 18-28. DRAWN, CHECKED, DESIGNED, DATE, SCALE, CONTRACT NO. DNT-260 SHEET OF.

PROJECT Addison Airport Tunnel
DATE 4/20/99 SUPPLEMENTAL AGREEMENT NO. 29
SHEET NO. 1 OF 3 CONTRACT NO. DNT-260
H.B. Zachry Company, Factory Construction (CONTRACTOR) PO Box 531558, Grand Prairie, TX 75053 (ADDRESS)

AGREEMENT SHALL PERTAIN TO ONLY ONE CONTRACT AND SHALL BE NUMBERED CONSECUTIVELY FOR EACH CONTRACT. AUTHORIZATION IS HEREBY REQUESTED FOR THE PERFORMANCE OF EXTRA WORK UNDER THE ABOVE CONTRACT DESCRIBED AS FOLLOWS: (ATTACH DRAWING OR SKETCHES WHERE APPLICABLE) (EXPLAIN BELOW IF REQUIRED)

Contractor proposes to install a directional arrow using reflective markers near the east bound exit. Total price for this work including traffic control is as follows:
Install Directional Arrow \$437.50
An electrical change is needed to accommodate the removal of the east & west sump for maintenance. Total cost of this change is as follows:
Electrical work for the disconnect/connect of the pumps at the east & west sump areas \$3,240.27
Additional equipment (strainers and regulators) is needed to connect the emergency generators to the natural gas pipeline. Total cost for this installation is \$2,148.05
The sign foundation for overhead sign #1 had to be reworked in order to miss water line W-1, and electrical cables. The involved reworking the steel for the raised shaft, and furnishing a concrete for the top of the drilled pier. Total cost of this operation is \$2,370.62
The material supplier, TXL, in error, put fly ash in approximately 54 CY of concrete on Keller Springs, westbound lane, south side near Addison Road. The strength of the concrete averaged 496 25 instead of 550 as required. A deduction of 30% will be made as per Item 420.25 as follows:
300 Concrete Pavement CP 8' SY (225.42) \$27.35 (\$6,165.24)
300 Concrete Pavement CP 8' SY (225.42) \$19.15 (\$4,316.59)
(\$1,848.64)

Upon completion of the driveway at Concourse Plaza West, there was water trapped on the small apron west of the driveway. It was decided to add a small apron and an inlet directly into the top of the 30" storm sewer line. Total cost of this apron, curb, and inlet is as follows:
465SP Special inlet and appurtenances LS 1 \$1,737.50 \$1,737.50

DNT-260 Supplemental Agreement No. 29 Page 2 of 3

NTTA requested a concrete pad & posts to protect the Photoelectric cells on the north side of the electrical room. Total price for this item is as follows:
Labor \$443.28
Materials \$60.75
\$504.03

While laying Storm Sewer Line B, a sanitary sewer line was encountered that required the flow line to be raised. Eleven points of 60" pipe had to be removed and re-laid at the higher elevation. Total cost is as follows:
Equipment \$1,664.56
Labor \$3,548.20
Material \$547.46
Field Engineer \$808.43
Total \$5,568.65

Contractor was asked to extend the 2 1/2" coated metal conduit, to the toll plaza from the tunnel plan termination. Total lump sum cost for this item is as follows:
Extend 2 1/2" conduit to toll plaza \$17,000.00

Several items of electrical work were increased to facilitate construction. Contractor has agreed to furnish these over runs at the original bid price as follows:
Extend 1 1/2" PVC coated conduit from plan termination to accommodate roadway lighting 140 LF @ \$13.50/LF \$1,890.00

Install pull & junction box to accommodate road lighting \$3,400.00

Extra 4" PVC coated conduit to accommodate change from electrical room to generators 440 LF @ \$44.00/LF \$19,360.00

Total this Supplemental Agreement \$57,413.26

SUBMITTED BY BROWN & ROOT, INC. I HAVE HEREBY AGREED THAT THE WORK LISTED IN THIS FOREGOING APPLICATION IS EXTRA WORK AS THE NAME IS DEFINED IN ARTICLE 4 OF THE STANDARD SPECIFICATIONS AND THAT I WILL PERFORM SAID WORK IN CONSIDERATION FOR PAYMENT AND COMPENSATION AS SPECIFIED ABOVE.
RECOMMENDED FOR APPROVAL Ginn Corporation DATE 04/20/99 CONTRACTOR H.B. Zachry Construction Corporation
APPROVAL RECOMMENDED NORTH TEXAS TOLLWAY AUTHORITY BY David S. Zachry, President, CHRY Group DATE 05/06/99
BY SURETY American Home Assurance Company DATE 05/06/99
APPROVED NORTH TEXAS TOLLWAY AUTHORITY BY Scottie Ramirez, Attorney-In-Fact DATE 05/06/99
BY DEPUTY EXECUTIVE DIRECTOR DATE

\*Signed subject to Zachry Construction Corporation Letter No. 266, dated May 10, 1999.

PROJECT Addison Airport Tunnel
DATE 6/11/99 SUPPLEMENTAL AGREEMENT NO. 30
SHEET NO. 1 OF 3 CONTRACT NO. DNT-260
H.B. Zachry Company (CONTRACTOR) PO Box 531558, Grand Prairie, TX 75053 (ADDRESS)

AGREEMENT SHALL PERTAIN TO ONLY ONE CONTRACT AND SHALL BE NUMBERED CONSECUTIVELY FOR EACH CONTRACT. AUTHORIZATION IS HEREBY REQUESTED FOR THE PERFORMANCE OF EXTRA WORK UNDER THE ABOVE CONTRACT DESCRIBED AS FOLLOWS: (ATTACH DRAWING OR SKETCHES WHERE APPLICABLE) (EXPLAIN BELOW IF REQUIRED)

There were no provisions for pane release bar on the inside of the door to the MEP room. The cost of this material is as follows:
Material \$252.45
Labor & Burden \$183.75
Total this change \$436.20

The exhaust vent near the east portal has been replaced with a keystone retaining wall. This necessitated additional excavation for the Type A Furne. Also, ramps needs to be added on both sides of the furnace, also requiring additional excavation. This added excavation is in hard Austin Chalk, and has very limited access to the usual excavating equipment. Some removal of the exhaust vent is also necessary for the ramp. Cost of this item is as follows:
Extra Ramps & Extra Excavation with rented backhoe \$5,348.71
417.87 5/8" Ribs (84 piers) @ 41.00 \$17,124.47
Total this change \$22,473.18

Water is seeping into the electrical box located at the east portal face wall. Contractor proposes to raise the box and construct a curb around the box. Total lump sum price for this change is \$471.50

The fence contractor reduced the size of the post holes, thereby reducing the amount of concrete necessary to set the fence posts. We feel that with the rock encountered, and the slow ramp ground around the posts, the fence, as required, means the intent of the specifications. However, NTTA requires a reduction in costs to offset the saving to the contractor. Total credit for concrete not used is as follows:
(\$1,650.00) Credit for reducing amount of concrete is

TOTAL THIS SUPPLEMENTAL AGREEMENT \$21,748.68

DNT-260 Supplemental Agreement No. 30 Page 2 of 2

SUBMITTED BY BROWN & ROOT, INC. I HAVE HEREBY AGREED THAT THE WORK LISTED IN THIS FOREGOING APPLICATION IS EXTRA WORK AS THE NAME IS DEFINED IN ARTICLE 4 OF THE STANDARD SPECIFICATIONS AND THAT I WILL PERFORM SAID WORK IN CONSIDERATION FOR PAYMENT AND COMPENSATION AS SPECIFIED ABOVE.
RECOMMENDED FOR APPROVAL Ginn Corporation DATE 07/06/99 CONTRACTOR H.B. Zachry Construction Corporation
APPROVAL RECOMMENDED NORTH TEXAS TOLLWAY AUTHORITY BY Ralph Wilson, Operations Mgr. DATE 07/06/99
BY SURETY American Home Assurance Company DATE 07/06/99
APPROVED NORTH TEXAS TOLLWAY AUTHORITY BY Scottie Ramirez, Attorney-In-Fact DATE 07/06/99
BY DEPUTY EXECUTIVE DIRECTOR DATE

PROJECT Addison Airport Tunnel
DATE 8/16/99 SUPPLEMENTAL AGREEMENT NO. 31
SHEET NO. 1 OF 3 CONTRACT NO. DNT-260
H.B. Zachry Company (CONTRACTOR) PO Box 531558, Grand Prairie, TX 75053 (ADDRESS)

AGREEMENT SHALL PERTAIN TO ONLY ONE CONTRACT AND SHALL BE NUMBERED CONSECUTIVELY FOR EACH CONTRACT. AUTHORIZATION IS HEREBY REQUESTED FOR THE PERFORMANCE OF EXTRA WORK UNDER THE ABOVE CONTRACT DESCRIBED AS FOLLOWS: (ATTACH DRAWING OR SKETCHES WHERE APPLICABLE) (EXPLAIN BELOW IF REQUIRED)

In January, 1998, a rock slide occurred near the east portal of the Addison Airport Tunnel. At the time, the amount of clean up was difficult to estimate, and it was decided to do the clean up by Force Account. All major work has been paid by signed union prices. The amount of time added to the contract has now been established as 27 calendar days. This is the time that the completion of the contract was actually delayed by the rock slide. Even though the clean up occurred over several weeks, other work was being accomplished at the same time. Charges for project overhead have been gathered and are summarized below. Charges for the clean up items are also summarized. Paid invoices have been delivered to substantiate these charges, and are on file in the project records. Payroll records are a part of these proofs of expenditures. The summaries are as listed:

Table with columns: Labor, Equipment, Misc., Project office overhead, Subtotal, OMSD Home Office Overhead, Profit @ 5.33%, Total Overhead. Total: \$54,453.73

Table with columns: Direct cost, Profit, Total. Total: \$30,445.33

DNT-260 Supplemental Agreement No. 31 Page 2 of 2

Table with columns: Materials & Supplies, S/C & Hauling, Total Removal Costs. Total: \$68,210.40

TOTAL THIS SUPPLEMENTAL AGREEMENT \$122,668.13

SUBMITTED BY BROWN & ROOT, INC. I HAVE HEREBY AGREED THAT THE WORK LISTED IN THIS FOREGOING APPLICATION IS EXTRA WORK AS THE NAME IS DEFINED IN ARTICLE 4 OF THE STANDARD SPECIFICATIONS AND THAT I WILL PERFORM SAID WORK IN CONSIDERATION FOR PAYMENT AND COMPENSATION AS SPECIFIED ABOVE.
RECOMMENDED FOR APPROVAL Ginn Corporation DATE 9/13/99 CONTRACTOR H.B. Zachry Construction Corporation
APPROVAL RECOMMENDED NORTH TEXAS TOLLWAY AUTHORITY BY Ralph Wilson, Operations Mgr. DATE 9/13/99
BY SURETY American Home Assurance Company DATE 9/13/99
APPROVED NORTH TEXAS TOLLWAY AUTHORITY BY Scottie Ramirez, Attorney-In-Fact DATE 9/13/99
BY DEPUTY EXECUTIVE DIRECTOR DATE

PROJECT Addison Airport Tunnel
DATE 9/29/99 SUPPLEMENTAL AGREEMENT NO. 32
SHEET NO. 1 OF 2 CONTRACT NO. DNT-260
Zachry Construction Company (CONTRACTOR) PO Box 531558, Grand Prairie, TX 75053 (ADDRESS)

AGREEMENT SHALL PERTAIN TO ONLY ONE CONTRACT AND SHALL BE NUMBERED CONSECUTIVELY FOR EACH CONTRACT. AUTHORIZATION IS HEREBY REQUESTED FOR THE PERFORMANCE OF EXTRA WORK UNDER THE ABOVE CONTRACT DESCRIBED AS FOLLOWS: (ATTACH DRAWING OR SKETCHES WHERE APPLICABLE) (EXPLAIN BELOW IF REQUIRED)

The plans provide for cast iron grates over the trench drains. These were installed, and have proven to be undesirable due to excess breakage. NTTA requests that steel grates be installed in lieu of the cast iron grates. The cost of this is as follows:

Table with columns: Labor, Supplies, Equipment (per shift), Materials, Estimated Total. Total: \$9,516.28

\* If more than one shift is required, an additional price of \$170.00 will be paid to the contractor for equipment.

The Town of Addison has requested covers over the fire connectors inside the tunnel. Cost to add 9 covers is as follows:

Table with columns: Materials & Supplies, Labor & Equipment (\$170.00 per shift), Estimate 3 shifts, Estimated Total. Total: \$3,955.21

\* Number of shifts to be paid are the actual number of shifts that it takes to do the work.

Estimated Total, This Supplemental Agreement \$33,471.47

DNT-260 Supplemental Agreement No. 32 Page 2 of 2

SUBMITTED BY BROWN & ROOT, INC. I HAVE HEREBY AGREED THAT THE WORK LISTED IN THIS FOREGOING APPLICATION IS EXTRA WORK AS THE NAME IS DEFINED IN ARTICLE 4 OF THE STANDARD SPECIFICATIONS AND THAT I WILL PERFORM SAID WORK IN CONSIDERATION FOR PAYMENT AND COMPENSATION AS SPECIFIED ABOVE.
RECOMMENDED FOR APPROVAL Ginn Corporation DATE 10/19/99 CONTRACTOR Zachry Construction Corporation
APPROVAL RECOMMENDED NORTH TEXAS TOLLWAY AUTHORITY BY Ralph Wilson, Operations Mgr. DATE 10/19/99
BY SURETY American Home Assurance Company DATE 10/19/99
APPROVED NORTH TEXAS TOLLWAY AUTHORITY BY Scottie Ramirez, Attorney-In-Fact DATE 10/19/99
BY DEPUTY EXECUTIVE DIRECTOR DATE

FINAL RECORD DRAWING Date: 12/25/99

Revision table with columns: NO., REVISION, BY, DATE. Title: NORTH TEXAS TOLLWAY AUTHORITY ADDISON AIRPORT TUNNEL SUPPLEMENTAL AGREEMENTS 29-32. Contract No. DNT-260 SHEET OF.



**ZACHRY-MONTEREY**  
**REQUEST FOR INFORMATION**  
**ADDISON AIRPORT TUNNEL - JOB #9080.01**

RFI No. **111**  
 Date **05/12/97**

Subcontractor (if applicable): \_\_\_\_\_

Subject: Membrane Lining - Inspection of wire strands  
 Drw/Spec. No.: Special Spec 4103-3.1.D.

Reply Req'd By: D. Hubenk  
 Distribution List: Jim Roskie - Monterey  
 Job 9080.01 - 005

Problem: \_\_\_\_\_

The above referenced section requires "inspection of the shotcrete lining and bend all wire strands which provide so that they are parallel to the shotcrete surface and will not damage or puncture the synthetic membrane." Experience with this method is that it is theoretical but not practical. The rough and piercing texture of the fiber shotcrete does not provide adequate protection of the membrane liner.

Possible rework or extra work involved with this RFI?  Y  N  
 Delays in project execution involved with this RFI?  Y  N  
 Estimate of time spent evaluating, finding alternate solution to RFI? Engineering: \_\_\_\_\_ Hrs  
 Surveying Crew: \_\_\_\_\_ Hrs  
 Other: \_\_\_\_\_ Hrs

Proposed Solution by Contractor By: \_\_\_\_\_ (Date: \_\_\_\_\_) (Reviewed By: \_\_\_\_\_)

We propose to overexcavate 2" to 4" to allow for placing an additional 1" of fiberless shotcrete. The additional excavation and concrete for the tunnel liner will be at no cost to the owner. The additional 1" of fiberless shotcrete will require approximately 255 CY @ \$235.00/CY = \$123,375.00.  
 Please request issuance of a change order for fiberless shotcrete for membrane protection.

Response by Construction Management: \_\_\_\_\_

Solution By: \_\_\_\_\_ (Date: \_\_\_\_\_) (Reviewed by: \_\_\_\_\_) (Date: \_\_\_\_\_)

**ZACHRY-MONTEREY**  
**REQUEST FOR INFORMATION**  
**ADDISON AIRPORT TUNNEL - JOB #9080.01**

RFI No. **111B**  
 Date **05/20/97**

Subcontractor (if applicable): \_\_\_\_\_

Subject: Membrane Lining - Inspection of wire strands  
 Drw/Spec. No.: Special Spec 4103-3.1.D.

Reply Req'd By: D. Hubenk  
 Distribution List: Jim Roskie - Monterey  
 Job 9080.01 - 005B

Problem: \_\_\_\_\_

The above referenced section requires "inspection of the shotcrete lining and bend all wire strands which provide so that they are parallel to the shotcrete surface and will not damage or puncture the synthetic membrane." Experience with this method is that it is theoretical but not practical. The rough and piercing texture of the fiber shotcrete does not provide adequate protection of the membrane liner.

Possible rework or extra work involved with this RFI?  Y  N  
 Delays in project execution involved with this RFI?  Y  N  
 Estimate of time spent evaluating, finding alternate solution to RFI? Engineering: \_\_\_\_\_ Hrs  
 Surveying Crew: \_\_\_\_\_ Hrs  
 Other: \_\_\_\_\_ Hrs

Proposed Solution by Contractor By: \_\_\_\_\_ (Date: \_\_\_\_\_) (Reviewed By: \_\_\_\_\_)

We propose to overexcavate 2" to 4" to allow for placing an additional 1" of fiberless shotcrete. The additional excavation and concrete for the tunnel liner will be at no cost to the owner. The additional 1" of fiberless shotcrete will require approximately 255 CY @ \$235.00/CY = \$123,375.00.  
 Please request issuance of a change order for fiberless shotcrete for membrane protection.

Response by Construction Management: \_\_\_\_\_

Solution By: \_\_\_\_\_ (Date: \_\_\_\_\_) (Reviewed by: \_\_\_\_\_) (Date: \_\_\_\_\_)

**ZACHRY-MONTEREY**  
**REQUEST FOR INFORMATION**  
**ADDISON AIRPORT TUNNEL - JOB #9080.01**

RFI No. **110**  
 Date **05/12/97**

Subcontractor (if applicable): \_\_\_\_\_

Subject: Membrane Lining - Rebar Reinforcement  
 Drw/Spec. No.: Special Spec 4103-3.1.L

Reply Req'd By: D. Hubenk  
 Distribution List: Jim Roskie - Monterey  
 Job 9080.01 - 004

Problem: \_\_\_\_\_

The above referenced section specifies rebar reinforcement to be supported by the liner. Recent discussions with the manufacturer indicate this design is "not adequate to support the rebar reinforcement." This design has been implemented, without success, on other tunnel projects supplied by the manufacturer.

Possible rework or extra work involved with this RFI?  Y  N  
 Delays in project execution involved with this RFI?  Y  N  
 Estimate of time spent evaluating, finding alternate solution to RFI? Engineering: \_\_\_\_\_ Hrs  
 Surveying Crew: \_\_\_\_\_ Hrs  
 Other: \_\_\_\_\_ Hrs

Proposed Solution by Contractor By: \_\_\_\_\_ (Date: \_\_\_\_\_) (Reviewed By: \_\_\_\_\_)

We recommend using epoxy rock anchors as shown in the attached drawing. This system has been implemented successfully on other tunnel projects and a similar system was utilized on the DART tunnel. There will be no cost to implement this rock anchor system. Please request issuance of a change order for the recommended system.

Response by Construction Management: \_\_\_\_\_

Solution By: \_\_\_\_\_ (Date: \_\_\_\_\_) (Reviewed by: \_\_\_\_\_) (Date: \_\_\_\_\_)

**H. B. ZACHRY COMPANY**  
**REQUEST FOR INFORMATION**  
**ADDISON AIRPORT TUNNEL**

RFI No. **109**  
 Date **12-May-97**

Subcontractor (if applicable): \_\_\_\_\_

Subject: Natural Gas Line Crossing @ Dooley Road  
 Drw/Spec. No.: As Supplied

Reply Req'd By: \_\_\_\_\_  
 Distribution List: Brown & Root  
 Remanance  
 Majed Linnam  
 Lene Star Gas

Problem: \_\_\_\_\_

There are no horizontal or vertical layouts for the proposed Lene Star Gas line that crosses our utilities at Dooley Rd. We need to explore the options as soon as possible.

Possible rework or extra work involved with this RFI?  Y  N  
 Delays in project execution involved with this RFI?  Y  N  
 Estimate of time spent evaluating, finding alternate solution to RFI? Engineering: \_\_\_\_\_ Hrs  
 Surveying Crew: \_\_\_\_\_ Hrs  
 Other: \_\_\_\_\_ Hrs

Proposed Solution by Contractor By: \_\_\_\_\_ (Date: 5/13/97) (Reviewed By: \_\_\_\_\_)

Attached are two alternatives:  
 1. H. B. Zachry believes this option would be safer and simpler because it requires a shallow ditch.  
 2. Requires a deep trench. This solution still is acceptable to H. B. Zachry Co.

Both options should allow for the construction of our utilities.

Response by Construction Management: \_\_\_\_\_

Solution By: \_\_\_\_\_ (Date: \_\_\_\_\_) (Reviewed by: \_\_\_\_\_) (Date: \_\_\_\_\_)

**H. B. ZACHRY COMPANY**  
**REQUEST FOR INFORMATION**  
**ADDISON AIRPORT TUNNEL**

RFI No. **108**  
 Date **12-May-97**

Subcontractor (if applicable): \_\_\_\_\_

Subject: Shaking & Relocation of Telephone Line @ Dooley Road  
 Drw/Spec. No.: C33

Reply Req'd By: \_\_\_\_\_  
 Distribution List: Majed Linnam  
 Thomas Kelley  
 Majed Linnam  
 Remanance

Problem: \_\_\_\_\_

No existing telephone line is shown on the western side of Dooley Road on sheet C33 (Existing Utilities). In actuality, a telephone line is located in that particular area of the project (Just off of existing west side curb). This RFI is to request that the line be relocated as soon as possible so that utility construction can proceed without any further delays. This phone line was encountered on Saturday 5/10/97 by a Remanance crew, and we are currently waiting for any damage assessment by Southwestern Bell Telephone. Your prompt attention to this matter is greatly appreciated.

Possible rework or extra work involved with this RFI?  Y  N  
 Delays in project execution involved with this RFI?  Y  N  
 Estimate of time spent evaluating, finding alternate solution to RFI? Engineering: \_\_\_\_\_ Hrs  
 Surveying Crew: \_\_\_\_\_ Hrs  
 Other: \_\_\_\_\_ Hrs

Proposed Solution by Contractor By: \_\_\_\_\_ (Date: \_\_\_\_\_) (Reviewed By: \_\_\_\_\_)

Response by Construction Management: \_\_\_\_\_

Solution By: \_\_\_\_\_ (Date: \_\_\_\_\_) (Reviewed by: \_\_\_\_\_) (Date: \_\_\_\_\_)

**H. B. ZACHRY COMPANY**  
**REQUEST FOR INFORMATION**  
**ADDISON AIRPORT TUNNEL**

RFI No. **107**  
 Date **05/12/97**

Subcontractor (if applicable): \_\_\_\_\_

Subject: Utility Locations at Keller-Springs Rd (West Side)  
 Drw/Spec. No.: Attached

Reply Req'd By: \_\_\_\_\_  
 Distribution List: Bill Leach  
 Majed Linnam  
 Job File

Problem: \_\_\_\_\_

The narrow easement along the north side of Keller-Springs Road (W) does not allow room for placement of all utilities (third party & contract) according to plans. The NW remaining wall footings fall very close to the proposed water line location in some areas.

Possible rework or extra work involved with this RFI?  Y  N  
 Delays in project execution involved with this RFI?  Y  N  
 Estimate of time spent evaluating, finding alternate solution to RFI? Engineering: \_\_\_\_\_ Hrs  
 Surveying Crew: \_\_\_\_\_ Hrs  
 Other: \_\_\_\_\_ Hrs

Proposed Solution by Contractor By: \_\_\_\_\_ (Date: 05/12/97) (Reviewed By: C.Terrana)

In the area adjacent to the parking lot, we propose to locate the T.U. electric poles approximately 1 foot from the back of the parking lot curb. As per the attached drawings, we also propose to move the gas and water lines closer to the curb to avoid the footings. We will return to the original utility locations (see RFI 103) in the area once space allows.

Response by Construction Management: \_\_\_\_\_

Solution By: \_\_\_\_\_ (Date: \_\_\_\_\_) (Reviewed by: \_\_\_\_\_) (Date: \_\_\_\_\_)

**ZACHRY-MONTEREY**  
**REQUEST FOR INFORMATION**  
**ADDISON AIRPORT TUNNEL - JOB #9080.01**

RFI No. **106**  
 Date **05/06/97**

Subcontractor (if applicable): \_\_\_\_\_

Subject: Shotcrete Strength  
 Drw/Spec. No.: Special Spec 4102-1.1.C.1.

Reply Req'd By: D. Hubenk  
 Distribution List: Jim Roskie - Monterey  
 Job 9080.01 - 003

Problem: \_\_\_\_\_

The above referenced section specifies a design strength for the shotcrete of 3,500 psi. Section 1.2.D.7.1.1. and Section 1.2.D.7.1.1. and Section 3.1.A.8.a. reference 28 day strength of 4,000 psi. Please advise.

Possible rework or extra work involved with this RFI?  Y  N  
 Delays in project execution involved with this RFI?  Y  N  
 Estimate of time spent evaluating, finding alternate solution to RFI? Engineering: \_\_\_\_\_ Hrs  
 Surveying Crew: \_\_\_\_\_ Hrs  
 Other: \_\_\_\_\_ Hrs

Proposed Solution by Contractor By: \_\_\_\_\_ (Date: \_\_\_\_\_) (Reviewed By: \_\_\_\_\_)

Response by Construction Management: \_\_\_\_\_

Under section 1.2.D.7.1.1. there is a remark which states the 28 day strength differs from the design strength due to more favorable conditions under preconstruction testing. This coupled with section 1.1.C. tells me that the design strength is as stated in the special specification of 4102 at 3500psi and the 28 day strength is 4000psi.

This should clear up any questions you may have. I have several no bid's listed at H. B. Zachry as well as several no bid's listed at \_\_\_\_\_.

Solution By: \_\_\_\_\_ (Date: 6/2/97) (Reviewed by: \_\_\_\_\_) (Date: 6/2/97)

**ZACHRY-MONTEREY**  
**REQUEST FOR INFORMATION**  
**ADDISON AIRPORT TUNNEL - JOB #9080**

RFI No. **105**  
 Date **05/06/97**

Subcontractor (if applicable): \_\_\_\_\_

Subject: Instrumentation  
 Drw/Spec. No.: Special Spec 4104-2.10.A.

Reply Req'd By: D. Hubenk  
 Distribution List: Jim Roskie - Monterey  
 Job 9080.01 - 002

Problem: \_\_\_\_\_

The above referenced section specifies to provide roof leveling pins in the crown of the tunnel. The pin shall be equipped with a built-in or cross hair target suitable for measuring changes in elevation of the target either optically or with a laser leveling instrument. The target and instrument shall be capable of indicating deflections at the crown of the tunnel within a tolerance of +/- 0.005 inch. Should this read +/- 0.005 feet? Please advise.

Possible rework or extra work involved with this RFI?  Y  N  
 Delays in project execution involved with this RFI?  Y  N  
 Estimate of time spent evaluating, finding alternate solution to RFI? Engineering: \_\_\_\_\_ Hrs  
 Surveying Crew: \_\_\_\_\_ Hrs  
 Other: \_\_\_\_\_ Hrs

Proposed Solution by Contractor By: \_\_\_\_\_ (Date: \_\_\_\_\_) (Reviewed By: \_\_\_\_\_)

CONCRETE STRENGTH AT 7.0 DAYS FROM \_\_\_\_\_

Response by Construction Management: \_\_\_\_\_

Solution By: \_\_\_\_\_ (Date: \_\_\_\_\_) (Reviewed by: \_\_\_\_\_) (Date: \_\_\_\_\_)

**ZACHRY-MONTEREY**  
**REQUEST FOR INFORMATION**  
**ADDISON AIRPORT TUNNEL - JOB #9080.01**

RFI No. **104**  
 Date **05/06/97**

Subcontractor (if applicable): \_\_\_\_\_

Subject: Tunnel Shotcrete Test Specimen  
 Drw/Spec. No.: Special Spec 4102-3.1.A.1.

Reply Req'd By: D. Hubenk  
 Distribution List: Jim Roskie - Monterey  
 Job 9080.01 - 001

Problem: \_\_\_\_\_

The above referenced section specifies to furnish three-inch diameter core test specimens with minimum length of six inches. It is assumed that the core sample in the Type I tunnel will consist of a core that is three inches of shotcrete and three inches of rock since the Type I tunnel requires three inches of shotcrete. Please advise.

Possible rework or extra work involved with this RFI?  Y  N  
 Delays in project execution involved with this RFI?  Y  N  
 Estimate of time spent evaluating, finding alternate solution to RFI? Engineering: \_\_\_\_\_ Hrs  
 Surveying Crew: \_\_\_\_\_ Hrs  
 Other: \_\_\_\_\_ Hrs

Proposed Solution by Contractor By: \_\_\_\_\_ (Date: \_\_\_\_\_) (Reviewed By: \_\_\_\_\_)

Response by Construction Management: \_\_\_\_\_

Solution By: \_\_\_\_\_ (Date: \_\_\_\_\_) (Reviewed by: \_\_\_\_\_) (Date: \_\_\_\_\_)

**H. B. ZACHRY COMPANY**  
**REQUEST FOR INFORMATION**  
**ADDISON AIRPORT TUNNEL**

RFI No. **103**  
 Date **MAY 05 1997**

Subcontractor (if applicable): \_\_\_\_\_

Subject: Location of Gas Line, Water Line, and Radial  
 Drw/Spec. No.: \_\_\_\_\_

Reply Req'd By: \_\_\_\_\_  
 Distribution List: Jim Gardner  
 Lene Star Gas  
 TV Survey

Problem: \_\_\_\_\_

Indicate location of the gas line, water line, and radial line on surveyed data by Brown & Root.

The existing line of all easement line  
 Gas Line  
 Water Line  
 All these lines are located on the west side, north of rd of Keller Springs adjacent to Business Parking lot.

Possible rework or extra work involved with this RFI?  Y  N  
 Delays in project execution involved with this RFI?  Y  N  
 Estimate of time spent evaluating, finding alternate solution to RFI? Engineering: \_\_\_\_\_ Hrs  
 Surveying Crew: \_\_\_\_\_ Hrs  
 Other: \_\_\_\_\_ Hrs

Proposed Solution by Contractor By: \_\_\_\_\_ (Date: \_\_\_\_\_) (Reviewed By: \_\_\_\_\_)

Response by Construction Management: \_\_\_\_\_

Solution By: \_\_\_\_\_ (Date: \_\_\_\_\_) (Reviewed by: \_\_\_\_\_) (Date: \_\_\_\_\_)

**H. B. ZACHRY COMPANY**  
**REQUEST FOR INFORMATION**  
**ADDISON AIRPORT TUNNEL**

RFI No. **102**  
 Date **APR 23 1997**

Subcontractor (if applicable): Zachry/Monterey

Subject: Roadway along profile error  
 Drw/Spec. No.: 6.19

Reply Req'd By: \_\_\_\_\_  
 Distribution List: J.D. Martin  
 Ross Hovorka  
 Majed Linnam

Problem: \_\_\_\_\_

Please look at attached memo for discrepancy notes.

The profile information on sheets C-19 and C-20 is incorrect. The slope from PVI station 5+50 to PVI station 11+25 calculates 6.113%, not 6.461% as shown on the drawings. We need to bring this to the owners attention so that these two sheets can be revised.

Thanks,  
 Jerry

Possible rework or extra work involved with this RFI?  Y  N  
 Delays in project execution involved with this RFI?  Y  N  
 Estimate of time spent evaluating, finding alternate solution to RFI? Engineering: \_\_\_\_\_ Hrs  
 Surveying Crew: \_\_\_\_\_ Hrs  
 Other: \_\_\_\_\_ Hrs

Proposed Solution by Contractor By: \_\_\_\_\_ (Date: \_\_\_\_\_) (Reviewed By: \_\_\_\_\_)

Response by Construction Management: \_\_\_\_\_

Solution By: \_\_\_\_\_ (Date: \_\_\_\_\_) (Reviewed by: \_\_\_\_\_) (Date: \_\_\_\_\_)

**H. B. ZACHRY COMPANY**  
**REQUEST FOR INFORMATION**  
**ADDISON AIRPORT TUNNEL**

RFI No. **101**  
 Date **04/21/97**

Subcontractor (if applicable): \_\_\_\_\_

Subject: Payment Process/Deadlines  
 Drw/Spec. No.: Item 9. Measurement and Payment

Reply Req'd By: \_\_\_\_\_  
 Distribution List: Tommy Kelly  
 Bobby Kemp  
 Pete Davis

Problem: \_\_\_\_\_

The payment process/schedule is not clearly defined. Monthly estimate closing has been established to be the last Saturday of each month but, the process that follows this closing has not been formulated and accepted by all involved parties. Additionally, the method of payment to H. B. Zachry Company from the Texas Turnpike Authority has not been established.

Possible rework or extra work involved with this RFI?  Y  N  
 Delays in project execution involved with this RFI?  Y  N  
 Estimate of time spent evaluating, finding alternate solution to RFI? Engineering: \_\_\_\_\_ Hrs  
 Surveying Crew: \_\_\_\_\_ Hrs  
 Other: \_\_\_\_\_ Hrs

Proposed Solution by Contractor By: \_\_\_\_\_ (Date: 04/21/97) (Reviewed By: James Gardner)

This Proposal suggests that after the closing day of each month, H.B. Zachry representatives and Brown & Root representatives will review the monthly estimate and submit for payment to the Texas Turnpike Authority by Friday of the next week. The Texas Turnpike Authority will then have 15 days to pay H.B. Zachry Company for the work completed and submitted in the monthly estimate. The preferred method of payment to H. B. Zachry Company is a direct deposit transaction which can be set up upon approval of this RFI.

Response by Construction Management: \_\_\_\_\_

Solution By: \_\_\_\_\_ (Date: \_\_\_\_\_) (Reviewed by: \_\_\_\_\_) (Date: \_\_\_\_\_)

**FINAL RECORD DRAWING**  
 Date: 12/25/99

Missing RFI # 24

NO.	REVISION	BY	DATE
NORTH TEXAS TOLLWAY AUTHORITY ADDISON AIRPORT TUNNEL			
RFI# 101 - 111			
DRAWN _____	DATE _____	DESIGNED _____	DATE _____
CHECKED _____	DATE _____	SCALE _____	DATE _____
CONTRACT NO. DNT-260		SHEET _____ OF _____	

H. B. ZACHRY COMPANY REQUEST FOR INFORMATION ADDISON AIRPORT TUNNEL 127B

Subcontractor (if applicable): Renaissance

Subject: Conflict between 60" storm sewer and existing 8" sanitary

Problem: This is an additive to RFI 127. Additional info required by HDR.

Response by Construction Management: REINFORCED GRADE STA. 6200 TO STA. 1180 ON 45' WIDE ON ATTACHED MANHOLES. (SEE RFI 127) NO NEW DUGS TO BE ISSUED.

H. B. ZACHRY COMPANY REQUEST FOR INFORMATION ADDISON AIRPORT TUNNEL 126

Subcontractor (if applicable): Renaissance Contractors

Subject: S.W. Bell vault / water line

Problem: S.W. Bell contractor installed a vault behind the curb along the east side of Midway Rd. to the south of the intersection with Keller Springs Rd. In order to stay within their ROW, the contractor installed vault where it will now interfere with the placement of the water line (A) shown on the plans.

Response by Construction Management: CONTRACTOR'S SUGGESTED ALTERNATE APPROVED TO BE ACCEPTABLE. THIS SUGGESTION WILL LEAD TO BE DETERMINED IN THE FUTURE. NO NEW DUGS TO BE ISSUED. CHANGE TO AS-BUILT.

H. B. ZACHRY COMPANY REQUEST FOR INFORMATION ADDISON AIRPORT TUNNEL 125

Subcontractor (if applicable): Renaissance

Subject: Existing concrete caused duct protrudes into line at Doolley Road

Problem: Existing concrete caused duct protrudes into line at Doolley Road. The difference in elevation between the bottom of the duct and the top of the pavement varies, it reaches a maximum of 6.5 inches (the maximum being higher). H. B. Zachry has the exact location of the duct as surveyed in the field. Please advise.

Response by Construction Management: LEAD TO DUCT DUCTS OF CONC. WERE FOUND TO BE ACCEPTABLE. THIS SUGGESTION WILL LEAD TO BE DETERMINED IN THE FUTURE. NO NEW DUGS TO BE ISSUED. CHANGE TO AS-BUILT.

H. B. ZACHRY COMPANY REQUEST FOR INFORMATION ADDISON AIRPORT TUNNEL 124

Subcontractor (if applicable): Renaissance

Subject: Interference between pipe placement at Lane B and Doolley Road

Problem: There are two discontinuities between the pipe support footing at line B. 1. The top of reinforcement elevation at the western end of the structure provides into the time & CTR at Doolley Road. As shown on the drawing attached, the elevation of the southern edge is at around 634.32. The top of asphalt elevation at Doolley Rd. is 7' 11" higher. Doolley calls for 6" of curb, 6" of CTR and 4 1/4" of Asphalt. The bottom of subgrade at that location would be around 633.37. 2. The ratio and elevation (Flow line of 60" RCP) are off. The pipe alignment intersects the CL of tunnel alignment at Sta. 4+14.4 at a P.I. elevation of 635.56 (see 635.85).

Response by Construction Management: AS SHOWN ON THE DRAWING ATTACHED, THE ELEVATION OF THE SOUTHERN EDGE IS AT AROUND 634.32. THE TOP OF ASPHALT ELEVATION AT DOOLEY RD. IS 7' 11" HIGHER. DOOLEY CALLS FOR 6" OF CURB, 6" OF CTR AND 4 1/4" OF ASPHALT. THE BOTTOM OF SUBGRADE AT THAT LOCATION WOULD BE AROUND 633.37. THE RATIO AND ELEVATION (FLOW LINE OF 60" RCP) ARE OFF. THE PIPE ALIGNMENT INTERSECTS THE CL OF TUNNEL ALIGNMENT AT STA. 4+14.4 AT A P.I. ELEVATION OF 635.56 (SEE 635.85).

H. B. ZACHRY COMPANY REQUEST FOR INFORMATION ADDISON AIRPORT TUNNEL 123

Subcontractor (if applicable): Renaissance

Subject: Instrumentation relocations

Problem: The instrumentation locations shown in the plans will create problems with taxiway traffic during installation and while monitoring during the tunneling operation.

Response by Construction Management: RELOCATE THE INSTRUMENTS TO MINIMIZE ANY OBSTRUCTIONS, SAFETY HAZARDS AND/OR INCONVENIENCES TO BOTH AIRPORT TRAFFIC AND MASTER'S OPERATIONS. PLEASE ADVISE OF ACCEPTABLE ALTERNATE LOCATIONS.

H. B. ZACHRY COMPANY REQUEST FOR INFORMATION ADDISON AIRPORT TUNNEL 123B

Subcontractor (if applicable): Zachry/Monterey

Subject: Summary of as-built instrument locations

Problem: For your request, Zachry/Monterey, if providing a summary of all the instrument locations that have moved, along with the reason for moving them. The summary was provided by Zachry/Monterey's subcontractor, MAS-TEK engineering, who installed all the geotechnical instruments in the project.

ZACHRY-MONTEREY REQUEST FOR INFORMATION ADDISON AIRPORT TUNNEL - JOB #9080.01 122

Subcontractor (if applicable): Renaissance

Subject: Conflict in alignment of Sanitary Sewer 'A' and existing concrete ductbank

Problem: An existing electrical ductbank is not located as shown in plans. It runs instead, directly over the top of proposed Sanitary sewer line 'A' for approximately 35 feet.

Response by Construction Management: HOW HAS RENAISSANCE CONTRACTOR'S SUGGESTION TO MOVE PROBLEM WITH WATER DISTRIBUTION AND GAS LINE WITH PROBLEM? SUGGESTION: IF WATER LINE AND SANITARY SEWER ARE SEPARATE, THEN THERE IS NO PROBLEM. IF THEY ARE TOGETHER, THEN THERE IS A PROBLEM. THIS IS A QUESTION TO BE ANSWERED BY RENAISSANCE CONTRACTOR. NO NEW DUGS TO BE ISSUED. CHANGE TO AS-BUILT.

ZACHRY-MONTEREY REQUEST FOR INFORMATION ADDISON AIRPORT TUNNEL - JOB #9080.01 121

Subcontractor (if applicable): Renaissance

Subject: Control of Materials

Problem: Section 6.2 of the above referenced Special Provision states "Design, sampling, and testing, including professional quality control efforts in general, will be performed by engineering testing laboratories. Such services will be provided at the direction and expense of the Authority, except as may be specified for Item 441 and SP, "Steel Structures". An exception to the above is the requirement that the Contractor develop all Portland cement concrete and hot mix asphalt concrete designs and prepare and analyze trial and hot bit batches of the different designs as appropriate, as directed by the Engineer, entirely at its expense. Item 5.5 of the TxDOT Blue Book states "...plans shall govern over standard and special specifications, and special provisions shall govern over both standard and special specifications and plans. It has been brought to our attention that the shotcrete testing during construction is the responsibility of the Contractor. The above referenced Special Provision and General Requirement indicate to us that the required designs and trial testing is the expense of the Contractor and the required testing during construction is the expense of the Authority, therefore, we plan to use Mas-Tek Engineering & Associates to provide the design and trial tests at our expense and expect the construction testing to be at the Authority's expense.

ZACHRY-MONTEREY REQUEST FOR INFORMATION ADDISON AIRPORT TUNNEL - JOB #9080.01 120

Subcontractor (if applicable): Renaissance

Subject: Generator and Transformer Pad Conflict

Problem: Attached is a sketch (not to scale) which shows a new power pole (#2) in conflict with Emergency Generator Pad #1.

Response by Construction Management: HOW HAS RENAISSANCE CONTRACTOR'S SUGGESTION TO MOVE PROBLEM WITH WATER DISTRIBUTION AND GAS LINE WITH PROBLEM? SUGGESTION: IF WATER LINE AND SANITARY SEWER ARE SEPARATE, THEN THERE IS NO PROBLEM. IF THEY ARE TOGETHER, THEN THERE IS A PROBLEM. THIS IS A QUESTION TO BE ANSWERED BY RENAISSANCE CONTRACTOR. NO NEW DUGS TO BE ISSUED. CHANGE TO AS-BUILT.

ZACHRY-MONTEREY REQUEST FOR INFORMATION ADDISON AIRPORT TUNNEL - JOB #9080.01 119

Subcontractor (if applicable): Renaissance

Subject: Borehole Extensometer Installation

Problem: Attached is a letter from the above referenced subcontractor indicating their schedule for the installation of borehole extensometers BEX-1 and BEX-2. They plan to install these on July 20 beginning at 4:00 a.m. and will complete both in the 4 hour window provided by the Addison Airport. The alternate date for installation is July 27. Please note that these dates are contingent upon receiving an approval of the instrumentation submittal on or before July 20, 1997.

H. B. ZACHRY COMPANY REQUEST FOR INFORMATION ADDISON AIRPORT TUNNEL 118

Subcontractor (if applicable): Renaissance

Subject: Conflict in location of San. Sewer 'A' manholes & Gas line

Problem: In this area where the gas line, sanitary line and water line are all squeezed into a narrow slot, there appears to be room to move the two sanitary manholes on either side of new Doolley Rd. directly to the North. Moving the manholes (and the connecting sewer pipe) 4 feet to the north would eliminate having to build the 4' diameter manholes directly alongside an active gas line. This short distance would change the slope of the sanitary pipe slope so slightly, that adjusting manhole elevations probably would not be necessary. Also, there appears to be adequate room for the sanitary line to still pass under the storm sewer in this same area, if moved.

ZACHRY-MONTEREY REQUEST FOR INFORMATION ADDISON AIRPORT TUNNEL - JOB #9080.01 117

Subcontractor (if applicable): Renaissance

Subject: Instrumentation

Problem: \*\*\* SEE ATTACHED \*\*\*

ZACHRY COMPANY REQUEST FOR INFORMATION ADDISON AIRPORT TUNNEL 116

Subcontractor (if applicable): Renaissance

Subject: REINFORCED BATHING PLANT REQUEST

Problem: THE REINFORCED BATHING PLANT IS PROPOSED TO BE LOCATED AT THE END OF THE TUNNEL. THE PLANT WILL BE USED FOR BATHING ONLY. A MIXER TRUCK WILL BE PROVIDED TO MIX AND TRANSPORT THE SHOTCRETE TO THE PLANT. THE PLANT WILL BE USED FOR BATHING ONLY. ALL OTHER NON-FIBERED SHOTCRETE WILL BE SUPPLIED FROM A COMMERCIAL PLANT AND PLACED ONLY DURING THE DAY SHIFT.

ZACHRY-MONTEREY REQUEST FOR INFORMATION ADDISON AIRPORT TUNNEL - JOB #9080.01 115

Subcontractor (if applicable): Renaissance

Subject: Shotcrete - Proportioning and Mixing

Problem: The above referenced section specifies to have aggregate and cement proportioned by an approved batching plant based on weight.

Response by Construction Management: WE RECOMMEND USING A VOLUMETRIC BATCHING PLANT. THE PLANT WE PROPOSE TO USE IS A MODEL RPM3-18. ATTACHED IS A DESCRIPTION AND LAYOUT OF THE PLANT AND POINTS WHERE THIS TYPE OF PLANT HAS BEEN USED. THE ACTUAL PLANT WE PROPOSE TO USE WAS USED ON THE SUPER COLLIDER PROJECT IN WAXAHACHIE, TEXAS AND ON A UDOT PROJECT.

H. B. ZACHRY COMPANY REQUEST FOR INFORMATION ADDISON AIRPORT TUNNEL 114

Subcontractor (if applicable): Renaissance

Subject: Layout/dimensioning discrepancy @ Pipe Culvert 2

Problem: Offset Stationing (84.59 ft. Right of Sta 33+37.58) for the end of Pipe Culvert 2 as detailed on sheet C46, does not correspond to the 242.59 ft. length of pipe dimensioned on sheet C48 when laid out in field.

H. B. ZACHRY COMPANY REQUEST FOR INFORMATION ADDISON AIRPORT TUNNEL 113

Subcontractor (if applicable): Renaissance

Subject: Right Of Way and Easement location

Problem: H. B. Zachry Co. needs clarifications on exact location of ROW & Easement Lines.

H. B. ZACHRY COMPANY REQUEST FOR INFORMATION ADDISON AIRPORT TUNNEL 112

Subcontractor (if applicable): Renaissance

Subject: Right Of Way and Easement location

Problem: The rock directly below the storm sewer support (Line B) is possibly weathered and/or fractured. The rock anchors that we install through this rock to support the pipe and tunnel arch may not serve their purpose if eroded and tested as planned.

FINAL RECORD DRAWING Date: 12/25/99

NO.	REVISION	BY	DATE

NORTH TEXAS TOLLWAY AUTHORITY ADDISON AIRPORT TUNNEL

RFI# 112 - 127B

DRAWN \_\_\_\_\_ DATE \_\_\_\_\_ DESIGNED \_\_\_\_\_ DATE \_\_\_\_\_  
CHECKED \_\_\_\_\_ DATE \_\_\_\_\_ SCALE \_\_\_\_\_

CONTRACT NO. DNT-260 SHEET OF

**ZACHRY-MONTEREY REQUEST FOR INFORMATION ADDISON AIRPORT TUNNEL - JOB #9080.01** RFI# 140  
Subcontractor (if applicable): ZACHRY MONTEREY  
Subject: Bore for Bleedair Conduit on Addison Road  
Problem: Sheet C25 of 166 indicates boring 2 1/4" x 4" conduits in Addison Road. The existing pull box on the southeast corner is located in Addison Road. Please advise us on the actual location of this bore so that we can make arrangements for bore pits and receiving pits.

**B. ZACHRY COMPANY REQUEST FOR INFORMATION ADDISON AIRPORT TUNNEL** RFI# 139  
Subcontractor (if applicable): ZACHRY MONTEREY  
Subject: Rock bolts on NW walls  
Problem: On sheet S24, Detail 1, there is a 6" diameter barbed rebar for the rock bolt anchorage. This bar is part of a 10' x 10' grid. The rebar is to be installed in the rock face. Please advise on the location of this rebar and if it is to be installed in the rock face or if it is to be installed in the concrete.

**ZACHRY-MONTEREY REQUEST FOR INFORMATION ADDISON AIRPORT TUNNEL - JOB #9080.01** RFI# 138  
Subcontractor (if applicable): ZACHRY MONTEREY  
Subject: Tape Extensometers  
Problem: Tape extensometers in the Type 2 excavation cannot be installed as required in the specification. Within 24 hours after excavation has exposed the individual reference point location for the staggered sequencing of Type 2 excavation. Each location in the Type 2 excavation will be exposed for more than 24 hours before the eye bolts can be embedded and the gauge can set up which contradicts the specification of taking an initial reading within 24 hours. Any subsequent seem to be meaningless without a proper initial reading.

**H. B. ZACHRY COMPANY REQUEST FOR INFORMATION ADDISON AIRPORT TUNNEL** RFI# 139B  
Subcontractor (if applicable): ZACHRY MONTEREY  
Subject: Rock bolts on PW walls  
Problem: RFI 139 requested the barbed diameters, whether the 6" on the plan or the 1 1/2" diameter needed for the approved rock bolt/nut/washer combination would be used. The RFI also asked if the rock bolts are to be post-tensioned or are simply drilled. Sheet S86 of the plan shows a plate to be positioned 6" off the excavated rock face for embedding within the closure pour. Tensioning of the anchor would require the plate to be directly against the face of rock.

**H. B. ZACHRY COMPANY REQUEST FOR INFORMATION ADDISON AIRPORT TUNNEL** RFI# 137  
Subcontractor (if applicable): ZACHRY MONTEREY  
Subject: Completion of East Portal RW before Type II excav.  
Problem: At Station 26+25, it is required that the East Portal Retaining Wall be completed and backfilled before the Type II excavation and support begins. We would like for our tunneling operation to begin without delay, and feel that the completion construction of the wall as required is not necessary to begin tunneling.

**H. B. ZACHRY COMPANY REQUEST FOR INFORMATION ADDISON AIRPORT TUNNEL** RFI# 136  
Subcontractor (if applicable): RENAISSANCE  
Subject: Bleeding irrigation system not shown in drawings  
Problem: Irrigation system for 40000 area adjacent to building on the south side of the intersection of Doolittle Road and Keller Springs has been removed by Renaissance pipe crew. The crew had to remove the irrigation system in order to build the storm sewer line A, and Sanitary line B. The system is located inside of the basement line, and some even inside the RCW line. It is not shown anywhere in the plans and has never been relocated before the start of construction.

**H. B. ZACHRY COMPANY REQUEST FOR INFORMATION ADDISON AIRPORT TUNNEL** RFI# 135  
Subcontractor (if applicable): RENAISSANCE  
Subject: Machine location on sanitary line C, interfere with slope  
Problem: Sheet C13 calls for the 4" top soil sand/loam/grading slope to be at 3 to 1. The bottom of the slope starts 2' from the edge of the type A wall. The top of the slope is at 3' from the RCW line. Machine location on sanitary line C, RFI 135 shows to be at the top of the slope on sheet C13. As laid out on the field, in order to achieve the 3 to 1 slope, the top of the slope will be located much further than shown in the proposed drawing (towards the north). That will be a problem because the machine will be located on the middle of the slope, and will be interfering with the slope. In order to have the top of the slope line as shown in the drawing, we will have to go with a 2 to 1 slope instead. That slope may be too steep for maintaining the grass at a later date.

**H. B. ZACHRY COMPANY REQUEST FOR INFORMATION ADDISON AIRPORT TUNNEL** RFI# 134  
Subcontractor (if applicable): MAJED LIMAM  
Subject: Three geotechnical instruments on the wall of footing counter  
Problem: Instrument 15, SRP, and 16 were installed as shown on the contract drawings. Please look at attached drawing showing the interference between the east portal retaining wall footing counter and the instruments. The worst case instrument is with the 16 located at 14. 25+15, 2' right of CL of Tunnel. 15 is right at the edge of the footing. Existing ground elevation at this location is around 636.7. 15 and SRP are also close to the footing (4' 3" respectively). The bottom elevation of the footing is at 629.22. This will generate a 7 to 8 ft excavation to build the footing. Sloping will be required on the excavation due to the nature of the ground at that location. The two instruments will interfere with the sloping and excavation of the footing. Please advise.

**REQUEST FOR INFORMATION ADDISON AIRPORT TUNNEL - JOB #9080.01** RFI# 133  
Subcontractor (if applicable): MAJED LIMAM  
Subject: Rock Bolt Pattern on the S.E. Wall  
Problem: Plan sheet T130 of 166 show the bottom rock bolt as being three feet (3') above the excavation line for the asphalt shoulder. It is not clear whether the pattern should be parallel to the shoulder excavation line or parallel to the unreinforced Austin Chalk line. The Austin Chalk line parallels the above gutter line.

**H. B. ZACHRY COMPANY REQUEST FOR INFORMATION ADDISON AIRPORT TUNNEL** RFI# 132  
Subcontractor (if applicable): RENAISSANCE  
Subject: Two 18" existing storm drains not shown in the Contract Drawings  
Problem: Renaissance subcontractor, Austin Chalk & Rock, excavated 2 lines of 18" RCP storm sewer while excavating the trench and collected:  
1. Number of the lines of pipe is shown on the Contract Drawing. One line appears to drain the area over the dumpster, and the other drains the parking lot area on the airport. Please locate any existing storm sewer lines in the area of the excavation. Please look at the attached drawing for an approximate location. The two pipes have not been laid out by our surveyors.

**H. B. ZACHRY COMPANY REQUEST FOR INFORMATION ADDISON AIRPORT TUNNEL** RFI# 132B  
Subcontractor (if applicable): RENAISSANCE  
Subject: Additional information on RFI 132  
Attached are elevations requested by Brown & Root on Culvert 1, South Junction Box.

**ZACHRY-MONTEREY REQUEST FOR INFORMATION ADDISON AIRPORT TUNNEL - JOB #9080.01** RFI# 131  
Subcontractor (if applicable): ZACHRY MONTEREY  
Subject: Drain Material for S.E. Wall Shores  
Problem: The above referenced drawing does not address drainage between the shorecrete and excavated wall. We anticipate water will be trapped between the wall and the shorecrete without an escape route. Please advise us on whether or not precautions are required.

**H. B. ZACHRY COMPANY REQUEST FOR INFORMATION ADDISON AIRPORT TUNNEL** RFI# 130  
Subcontractor (if applicable): MAJED LIMAM  
Subject: Concrete cure time for cap beam on DS type RW  
Problem: Note 12 on sheet S24 states that the concrete cure for the cap beam shall be a minimum of 14 days before commencing excavation for the fascia wall. H. B. Zachry has two concrete related to this point:  
1. What is the expected concrete strength after 14 days of cure. It is ambiguous from the note what actual strength is intended.  
2. H. B. Zachry requests the use of extra concrete test beams for the above referenced cure based on DS type walls. After achieving the required strength, H. B. Zachry Co. plans to proceed with excavation on the west side.  
Please give this matter immediate attention. Excavation on the west side before on the actual path to our project, as shown on our schedule.

**H. B. ZACHRY COMPANY REQUEST FOR INFORMATION ADDISON AIRPORT TUNNEL** RFI# 129  
Subcontractor (if applicable): MAJED LIMAM  
Subject: POWER POLE/REINFORCING WALL EXCAV. CONFLICT  
Problem: TWO OF THE POWER POLES RECENTLY INSTALLED ALONG THE TEMPORARY EASEMENT FOR SUPPLYING ELECTRICITY TO THE HANGARS HAVE BEEN FOUND TO BE VERY CLOSE TO THE PROPOSED FOOTINGS FOR THE N.E. RETAINING WALLS. THE ATTACHED DRAWING SHOWS THAT AT LEAST ONE OF THE POLES IS ONLY 4 FT. FROM THE EDGE OF A FOOTING THAT IS 9 FT. DEEP. THE POWER COMPANY WAS ASKED TO INSTALL THE POLES AS FAR AS POSSIBLE FROM THE EXCAVATION BUT WE WERE INFORMED THAT IT IS UNSAFE TO ALLOW ANY POWER WIRES TO PASS DIRECTLY OVER ANY HANGARS.

**H. B. ZACHRY COMPANY REQUEST FOR INFORMATION ADDISON AIRPORT TUNNEL** RFI# 129B  
Subcontractor (if applicable): MAJED LIMAM  
Subject: Additional information on RFI 129  
Problem: Retaining wall excavation, power pole location conflict. Attached is additional information requested by Brown & Root. Attached are dimensions, locations, for three power poles on the east side by the hangars.

**H. B. ZACHRY COMPANY REQUEST FOR INFORMATION ADDISON AIRPORT TUNNEL** RFI# 128  
Subcontractor (if applicable): RENAISSANCE CONSTRUCTION  
Subject: Traffic Plan & Culvert Installation @ Keller Springs & Addison  
Problem: 1. The traffic plan calls for traffic barrier where barrels could be used. 2. The suggested construction sequence calls for the box culvert to be built across Keller Springs in two phases. This could be done in one phase with better results. The pipe culvert that crosses further to the west on Keller Springs is built during one phase.

**H. B. ZACHRY COMPANY REQUEST FOR INFORMATION ADDISON AIRPORT TUNNEL** RFI# 127  
Subcontractor (if applicable): MAJED LIMAM  
Subject: Conflict between 60" storm sewer B and existing 8" sanitary  
Problem: Pipe crew encountered existing sanitary sewer (8") conflicting with the 60" storm sewer line B. As shown on the two pictures attached, the 8" sanitary is crossing the 60" and protrudes in the way of the connection between the existing 60" and line B. The flow line of line B at the location shown on the picture (about 27' from the sanitary) is 621.61'. At the connection area, the flow line of the 60" old RCP is 620.97'. The top elevation of the sanitary at the intersection with line B alignment is 622.07'. Line B will have to go up (counter the flow) by 0.99' in order to avoid the sanitary sewer.

**FINAL RECORD DRAWING**  
Date: 12/25/99

**NORTH TEXAS TOLLWAY AUTHORITY**  
**ADDISON AIRPORT TUNNEL**

RFI# 127 - 140

NO.	REVISION	BY	DATE

DRAWN \_\_\_\_\_ DATE \_\_\_\_\_ DESIGNED \_\_\_\_\_ DATE \_\_\_\_\_  
CHECKED \_\_\_\_\_ DATE \_\_\_\_\_ SCALE \_\_\_\_\_  
CONTRACT NO. DNT-260 SHEET OF

H. B. ZACHRY COMPANY REQUEST FOR INFORMATION ADDISON AIRPORT TUNNEL. Subcontractor (if applicable): RECO. Originator: Majed Lamm. Subject: Modifications of RECO existing wall design to expedite approval. Problem: H. B. Zachry intends to revert to the original design in order to construct the 48" shaft shafts (with no embedded plates) in the present panels. Response by Construction Management: THIS IS NOT THE INTENT OF THE CONTRACT...

H. B. ZACHRY COMPANY REQUEST FOR INFORMATION ADDISON AIRPORT TUNNEL. Subcontractor (if applicable): ZACHRY/MONTEREY. Originator: Majed Lamm. Subject: Drill shaft elevations on SW wall/West panel wall. Problem: On sheet 579, the West panel retaining wall detail shows an elevation to the top of the wall bottom of shaft elevations as shown on sheet 579. Response by Construction Management: THE 3 IN. BENTONITE WALL PANELS ARE TO BE INSTALLED AS SHOWN ON SHEET 579...

H. B. ZACHRY COMPANY REQUEST FOR INFORMATION ADDISON AIRPORT TUNNEL. Subcontractor (if applicable): Renaissance. Originator: Majed Lamm. Subject: Removal of water vaults and meters not shown on plans. Problem: Sheet 584 specifies the removal and resetting of 2 existing water vaults from an area north of Line B between stations 1400 and 2400 to Line B. Response by Construction Management: THE 3 IN. BENTONITE WALL PANELS ARE TO BE INSTALLED AS SHOWN ON SHEET 579...

H. B. ZACHRY COMPANY REQUEST FOR INFORMATION ADDISON AIRPORT TUNNEL. Subcontractor (if applicable): Renaissance. Originator: Majed Lamm. Subject: Expansion joint use in DS retaining wall cap beams. Problem: The approved cap beam design for the DS retaining walls does not include any form of expansion joint material between beam sections. Response by Construction Management: THE 3 IN. BENTONITE WALL PANELS ARE TO BE INSTALLED AS SHOWN ON SHEET 579...

H. B. ZACHRY COMPANY REQUEST FOR INFORMATION ADDISON AIRPORT TUNNEL. Subcontractor (if applicable): Renaissance. Originator: Majed Lamm. Subject: ROW at Keller Springs - Addison intersection. Problem: On sheet C31, at the northwest corner of the intersection of Keller Springs and Addison Roads, the existing right of way runs north-south. Response by Construction Management: THE 3 IN. BENTONITE WALL PANELS ARE TO BE INSTALLED AS SHOWN ON SHEET 579...

ZACHRY-MONTEREY REQUEST FOR INFORMATION ADDISON AIRPORT TUNNEL - JOB #9080.01. Subcontractor (if applicable): RECO. Originator: Majed Lamm. Subject: Weir Pump Pit. Problem: The above referenced sheets do not provide an elevation for the pumps in the weir pit. Response by Construction Management: SHEET DRAWING 584T 597 FOR SOME OF THE EQUIPMENT...

ZACHRY-MONTEREY REQUEST FOR INFORMATION ADDISON AIRPORT TUNNEL - JOB #9080.01. Subcontractor (if applicable): RECO. Originator: Majed Lamm. Subject: N B Wall Lighting. Problem: Contractor requires 5-8V Fluorescent lighting. The plans indicate "Typical Lighting" for the above referenced wall with a 1" diameter anchor bolt. Response by Construction Management: THE 3 IN. BENTONITE WALL PANELS ARE TO BE INSTALLED AS SHOWN ON SHEET 579...

H. B. ZACHRY COMPANY REQUEST FOR INFORMATION ADDISON AIRPORT TUNNEL. Subcontractor (if applicable): ZACHRY/MONTEREY. Originator: Majed Lamm. Subject: DS type RW Wall Lighting, LWI Wall Lightings (West Side). Problem: On their response to RFI 147, HDR covered the lighting for all the RW on the east side. Response by Construction Management: THE 3 IN. BENTONITE WALL PANELS ARE TO BE INSTALLED AS SHOWN ON SHEET 579...

H. B. ZACHRY COMPANY REQUEST FOR INFORMATION ADDISON AIRPORT TUNNEL. Subcontractor (if applicable): Renaissance. Originator: Majed Lamm. Subject: Constructability Problem on the RW Retaining Walls. Problem: The bottom row rock bolts on the RW type wall (NB RW) cause a constructability problem. Response by Construction Management: THE 3 IN. BENTONITE WALL PANELS ARE TO BE INSTALLED AS SHOWN ON SHEET 579...

ZACHRY COMPANY REQUEST FOR INFORMATION ADDISON AIRPORT TUNNEL. Subcontractor (if applicable): Renaissance. Originator: Majed Lamm. Subject: Rock Subgrade. Problem: A considerable amount of the subgrade under the roadway leading into the tunnel from east and west, will be in solid rock. Response by Construction Management: THE 3 IN. BENTONITE WALL PANELS ARE TO BE INSTALLED AS SHOWN ON SHEET 579...

ZACHRY COMPANY REQUEST FOR INFORMATION ADDISON AIRPORT TUNNEL. Subcontractor (if applicable): Renaissance. Originator: Majed Lamm. Subject: Lines Trench Subgrade on Rock. Problem: On its response to RFI 149 B and Root directed H. B. Zachry to overexcavate the rock to the bottom of subgrade elevation. Response by Construction Management: THE 3 IN. BENTONITE WALL PANELS ARE TO BE INSTALLED AS SHOWN ON SHEET 579...

H. B. ZACHRY COMPANY REQUEST FOR INFORMATION ADDISON AIRPORT TUNNEL. Subcontractor (if applicable): RECO. Originator: Majed Lamm. Subject: Bars 507 vs. 407. Problem: Sheet 586, detail 1 and the bar bending diagram requires a #4 bar with a 17" leg. Response by Construction Management: THE 3 IN. BENTONITE WALL PANELS ARE TO BE INSTALLED AS SHOWN ON SHEET 579...

ZACHRY COMPANY REQUEST FOR INFORMATION ADDISON AIRPORT TUNNEL. Subcontractor (if applicable): RECO. Originator: Majed Lamm. Subject: LWI drainage mechanism into gravel drain. Problem: H. B. Zachry proposes to do away with the drainage mat shown on sheet 593, and extend the weep holes to drain directly into the gravel drain behind the FW panels. Response by Construction Management: THE 3 IN. BENTONITE WALL PANELS ARE TO BE INSTALLED AS SHOWN ON SHEET 579...

ZACHRY COMPANY REQUEST FOR INFORMATION ADDISON AIRPORT TUNNEL - JOB #9080.01. Subcontractor (if applicable): ZACHRY/MONTEREY. Originator: Majed Lamm. Subject: Pull Tests on Installed Rock Bolts. Problem: Section 3.4 of the above referenced specifications requires 10 of the first 100 installed rock bolts and 1 per 100 of the remaining installed rock bolts are to be pulled tested. Response by Construction Management: THE 3 IN. BENTONITE WALL PANELS ARE TO BE INSTALLED AS SHOWN ON SHEET 579...

H. B. ZACHRY COMPANY REQUEST FOR INFORMATION ADDISON AIRPORT TUNNEL. Subcontractor (if applicable): Renaissance. Originator: Majed Lamm. Subject: Inadequate drainage into Y inlet and grate inlet on Line A Storm Sewer. Problem: Based upon field observations during rains (approx 2-3 inches) the last two days, it appears the provisions shown in the plans are inadequate for draining the "Access Easement" (around Sta. 7+10, Centerline Project) into the "Y" inlet. Response by Construction Management: THE 3 IN. BENTONITE WALL PANELS ARE TO BE INSTALLED AS SHOWN ON SHEET 579...

ZACHRY-MONTEREY REQUEST FOR INFORMATION ADDISON AIRPORT TUNNEL - JOB #9080.01. Subcontractor (if applicable): Renaissance. Originator: Majed Lamm. Subject: Storm Drain Crossing Tunnel. Problem: Sheet C33 of 166 indicates an existing 42" storm drain crossing the tunnel at approximately station Sta 13+30. Response by Construction Management: THE 3 IN. BENTONITE WALL PANELS ARE TO BE INSTALLED AS SHOWN ON SHEET 579...

H. B. ZACHRY COMPANY REQUEST FOR INFORMATION ADDISON AIRPORT TUNNEL. Subcontractor (if applicable): Renaissance. Originator: Majed Lamm. Subject: Discrepancy between "Typical Sections" and "Roadway Plan & Profile" sheets. Problem: Sheet C9 of contract drawings shows the island to extend all the way to station 6+15.00 on the roadway pavement section. Response by Construction Management: THE 3 IN. BENTONITE WALL PANELS ARE TO BE INSTALLED AS SHOWN ON SHEET 579...

FINAL RECORD DRAWING Date: 12/25/99. NORTH TEXAS TOLLWAY AUTHORITY ADDISON AIRPORT TUNNEL. RF# 141 - 155. DRAWN: DATE, CHECKED: DATE, DESIGNED: DATE, SCALE, SHEET OF, CONTRACT NO. DNT-260.

REQUEST FOR INFORMATION ADDISON AIRPORT TUNNEL - JOB #9080.01 170

Subcontractor (if applicable): Originator: D. Hubnak

Subject: Concrete in Tunnel

Problem: The plans do not make any provision for shear prestressing between the concrete footer block and the concrete walkway.

Proposed Solution by Contractor By: Date: Reviewed By: Date:

Response by Construction Management: H.B. ZACHRY COMPANY

H. B. ZACHRY COMPANY REQUEST FOR INFORMATION ADDISON AIRPORT TUNNEL 169

Subcontractor (if applicable): Originator: J. Gardner

Subject: Water Line W-4 from Hanger Road

Problem: To tie into the existing 20" water main beneath Addison with proposed line W-4, will require extensive traffic control and the possibility of night work.

Proposed Solution by Contractor By: Date: Reviewed By: Date:

Response by Construction Management: H.B. ZACHRY COMPANY

H. B. ZACHRY COMPANY REQUEST FOR INFORMATION ADDISON AIRPORT TUNNEL 168

Subcontractor (if applicable): Originator: Wayne Crabtree

Subject: Existing Parking Lot Drainage After Roadway & Drive Built

Problem: A top of the existing concrete parking lot right of CL sta. 34+25 to sta. 35+90 was done. We have discovered that once the construction of the new driveway and the driveway curb are completed, this area would not drain as the plans indicate.

Proposed Solution by Contractor By: Date: Reviewed By: Date:

Response by Construction Management: H.B. ZACHRY COMPANY

H. B. ZACHRY COMPANY REQUEST FOR INFORMATION ADDISON AIRPORT TUNNEL 168A

Subcontractor (if applicable): Originator: Wayne Crabtree

Subject: Existing Parking Lot Drainage After Roadway & Drive Built

Problem: The drainage of the parking lot right of CL sta. 34+25 to sta. 35+90 is now blocked by the newly constructed Keller Springs pavement and the new driveway.

Proposed Solution by Contractor By: Date: Reviewed By: Date:

Response by Construction Management: H.B. ZACHRY COMPANY

H. B. ZACHRY COMPANY REQUEST FOR INFORMATION ADDISON AIRPORT TUNNEL 167

Subcontractor (if applicable): Originator: Majed Limam

Subject: Security Fence @ Airport Taxiway by Foot

Problem: Due to the fence failure, H. B. Zachry Co. had to remove a portion of the security chain link fence and relocate the chain link fence to the location shown in this drawing.

Proposed Solution by Contractor By: Date: Reviewed By: Date:

Response by Construction Management: H.B. ZACHRY COMPANY

H. B. ZACHRY COMPANY REQUEST FOR INFORMATION ADDISON AIRPORT TUNNEL 166

Subcontractor (if applicable): Originator: Majed Limam

Subject: Retention Pile at Airport Taxiway by Foot

Problem: Attached is a roadway pavement curb design that was handled over to H. B. Zachry by Brown & Root's resident engineer.

Proposed Solution by Contractor By: Date: Reviewed By: Date:

Response by Construction Management: H.B. ZACHRY COMPANY

H. B. ZACHRY COMPANY REQUEST FOR INFORMATION ADDISON AIRPORT TUNNEL 165

Subcontractor (if applicable): Originator: Majed Limam

Subject: Existing Elevation @ Hangers & Long Shots Parking Lot

Problem: Attached is drawing reflecting existing elevation at the "Long Shots" parking lot area and the hangers in the proximity.

Proposed Solution by Contractor By: Date: Reviewed By: Date:

Response by Construction Management: H.B. ZACHRY COMPANY

H. B. ZACHRY COMPANY REQUEST FOR INFORMATION ADDISON AIRPORT TUNNEL 165A

Subcontractor (if applicable): Originator: Majed Limam

Subject: Existing Elevation @ Hanger Area Additional Info

Problem: Attached is additional elevation info for the hangers area north of Keller Springs. This is extra information requested by Brown & Root to solve drainage problems in the area.

Proposed Solution by Contractor By: Date: Reviewed By: Date:

Response by Construction Management: H.B. ZACHRY COMPANY

ZACHRY-MONTEREY REQUEST FOR INFORMATION ADDISON AIRPORT TUNNEL - JOB #9080.01 164

Subcontractor (if applicable): Originator: D. Hubnak

Subject: Concrete in Tunnel

Problem: The plans indicate a section of the concrete footer block is to be placed in the area under the tunnel liner concrete.

Proposed Solution by Contractor By: Date: Reviewed By: Date:

Response by Construction Management: H.B. ZACHRY COMPANY

REQUEST FOR INFORMATION ADDISON AIRPORT TUNNEL - JOB #9080.01 163

Subcontractor (if applicable): Originator: D. Hubnak

Subject: Concrete in Tunnel

Problem: The plans and spec section regarding the concrete footer block and walkway do not indicate any type of joint or joint pattern.

Proposed Solution by Contractor By: Date: Reviewed By: Date:

Response by Construction Management: H.B. ZACHRY COMPANY

REQUEST FOR INFORMATION ADDISON AIRPORT TUNNEL - JOB #9080.01 162

Subcontractor (if applicable): Originator: D. Hubnak

Subject: Concrete in Tunnel

Problem: The above referenced drawing indicates the footer block and walkway are to be fiber reinforced.

Proposed Solution by Contractor By: Date: Reviewed By: Date:

Response by Construction Management: H.B. ZACHRY COMPANY

ZACHRY-MONTEREY REQUEST FOR INFORMATION ADDISON AIRPORT TUNNEL - JOB #9080.01 161

Subcontractor (if applicable): Originator: D. Hubnak

Subject: Vent Fans - Tunnel Ventilation System

Problem: Our Submittal No. 7100-023 in reference to the above specification was returned to " furnish as noted".

Proposed Solution by Contractor By: Date: Reviewed By: Date:

Response by Construction Management: H.B. ZACHRY COMPANY

H. B. ZACHRY COMPANY REQUEST FOR INFORMATION ADDISON AIRPORT TUNNEL 160

Subcontractor (if applicable): Originator: Majed Limam

Subject: Elevation @ Existing Parking Lot

Problem: As requested by Brown & Root, we are attaching the contours of the existing parking lot south of the junction box.

Proposed Solution by Contractor By: Date: Reviewed By: Date:

Response by Construction Management: H.B. ZACHRY COMPANY

H. B. ZACHRY COMPANY REQUEST FOR INFORMATION ADDISON AIRPORT TUNNEL 159

Subcontractor (if applicable): Originator: J. Gardner

Subject: Rock Downs @ East Face

Problem: Drawing does not correctly depict area where fabric rock dowels and the tunnel excavation meet.

Proposed Solution by Contractor By: Date: Reviewed By: Date:

Response by Construction Management: H.B. ZACHRY COMPANY

H. B. ZACHRY COMPANY REQUEST FOR INFORMATION ADDISON AIRPORT TUNNEL 158

Subcontractor (if applicable): Originator: D. Hubnak

Subject: Filter fabric in Existing Wall Backfill

Problem: There is nothing to prevent the granular backfill material behind the retaining wall from percolating into the gravel material beneath it.

Proposed Solution by Contractor By: Date: Reviewed By: Date:

Response by Construction Management: H.B. ZACHRY COMPANY

H. B. ZACHRY COMPANY REQUEST FOR INFORMATION ADDISON AIRPORT TUNNEL 157

Subcontractor (if applicable): Originator: D. Hubnak

Subject: Sand filter material for underdrain

Problem: The plans don't specify type of filter material to be used for pipe underdrain.

Proposed Solution by Contractor By: Date: Reviewed By: Date:

Response by Construction Management: H.B. ZACHRY COMPANY

H. B. ZACHRY COMPANY REQUEST FOR INFORMATION ADDISON AIRPORT TUNNEL 156

Subcontractor (if applicable): Originator: Majed Limam

Subject: Discrepancy in the exact location of the Profile Grade Line

Problem: Sheet C9 shows the PGL to be located at the bottom of the 4" nodian riprap pavement, and on top of the CTB.

Proposed Solution by Contractor By: Date: Reviewed By: Date:

Response by Construction Management: H.B. ZACHRY COMPANY

FINAL RECORD DRAWING Date: 12/25/99

NORTH TEXAS TOLLWAY AUTHORITY ADDISON AIRPORT TUNNEL

RFI# 156 - 170

NO.	REVISION	BY	DATE

DRAWN DATE DESIGNED DATE  
CHECKED DATE SCALE

CONTRACT NO. DNT-260 SHEET OF

H. B. ZACHRY COMPANY REQUEST FOR INFORMATION ADDISON AIRPORT TUNNEL 171

Subcontractor (if applicable): N.A. Originator: Majed Limam

Subject: Requested info on Rockledge

Problem: Attached please find the requested survey of the eastern end of the rockledge. The survey was performed at the request of Brown & Root. Survey includes location of rock bolts as well as edge of fault location.

Proposed Solution by Contractor By: Date: Reviewed By: Date:

H. B. ZACHRY COMPANY REQUEST FOR INFORMATION ADDISON AIRPORT TUNNEL 172

Subcontractor (if applicable): J. L. Steel Originator: Majed Limam

Subject: Payment grades at the intersection of Addison & Kellers

Problem: Attached please find a layout of Addison Road 'tie in' to Kellers Springs Rd. new pavement. The layout was performed at the request of Brown & Root and the City of Addison representatives, after a potential 'flat area' was discovered by H. B. Zachry Co.

Proposed Solution by Contractor By: Date: Reviewed By: Date:

ZACHRY-MONTEREY REQUEST FOR INFORMATION ADDISON AIRPORT TUNNEL - JOB #9080.01 173

Subcontractor (if applicable): N.A. Originator: D. Hubensk

Subject: #1 Fire Main

Problem: The above referenced sheets show the #1 fire main to bend at a specified elevation immediately outside of the tunnel. The slope going into the tunnel is shown as 0.00% but does not indicate how far into the tunnel it goes.

Proposed Solution by Contractor By: Date: Reviewed By: Date:

ZACHRY-MONTEREY REQUEST FOR INFORMATION ADDISON AIRPORT TUNNEL - JOB #9080.01 174

Subcontractor (if applicable): N.A. Originator: D. Hubensk

Subject: #1 Fire Main

Problem: The above referenced sheet shows a cross-section detail the #1 fire main to be installed off of the ground in the footer block. The detail does not indicate this dimension.

Proposed Solution by Contractor By: Date: Reviewed By: Date:

ZACHRY-MONTEREY REQUEST FOR INFORMATION ADDISON AIRPORT TUNNEL - JOB #9080.01 175

Subcontractor (if applicable): N.A. Originator: D. Hubensk

Subject: Keyway

Problem: Brown & Root's letter HRZ 420 dated March 20, 1998 states that a keyway will be provided at each intentional or unintentional break in the continuous pour of the concrete footer block in lieu of installing a keyway every 50'. We agree with this method but request a waiver to this method at each of the drain boxes on the south wall footer block.

Proposed Solution by Contractor By: Date: Reviewed By: Date:

H. B. ZACHRY COMPANY REQUEST FOR INFORMATION ADDISON AIRPORT TUNNEL 176

Subcontractor (if applicable): N.A. Originator: Wayne Crabtree

Subject: Existing water line 'W-3' in conflict with I-1 wall drillshaft

Problem: I-1 wall 'W-3' was placed at 10' from the centerline of the tunnel and I-1 wall 'W-3' was placed at 10' from the centerline of the tunnel. I-1 wall 'W-3' was placed at 10' from the centerline of the tunnel. I-1 wall 'W-3' was placed at 10' from the centerline of the tunnel.

Proposed Solution by Contractor By: Date: Reviewed By: Date:

H. B. ZACHRY COMPANY REQUEST FOR INFORMATION ADDISON AIRPORT TUNNEL 177

Subcontractor (if applicable): N.A. Originator: Majed Limam

Subject: L Bar for Cut & Cover Footing

Problem: The L Bars need to be trench drain for the cut and cover footing, were short cut on the bent end.

Proposed Solution by Contractor By: Date: Reviewed By: Date:

H. B. ZACHRY COMPANY REQUEST FOR INFORMATION ADDISON AIRPORT TUNNEL 178

Subcontractor (if applicable): N.A. Originator: Majed Limam

Subject: Water Stop Configuration at the Intersection of Cut & Cover and DS RW

Problem: The N.W. RW being pre cast girth. H. B. Zachry proposes to use the Type C Water Stop (See Detail 101). The Type C water stop would be installed on both the Cut & Cover back wall and DS back of panel. A continuous pour will cover both waterproofs at the corner between the two structures. This solution would be also valid for the Southwest Corner of the Cut & Cover structure. Look at attached drawing for more details.

Proposed Solution by Contractor By: Date: Reviewed By: Date:

ZACHRY-MONTEREY REQUEST FOR INFORMATION ADDISON AIRPORT TUNNEL - JOB #9080.01 179

Subcontractor (if applicable): N.A. Originator: D. Hubensk

Subject: Grouting - Flow meters

Problem: The above referenced specification requires a meter to measure the amount of mixing water and a meter to determine the amount of grout injected.

Proposed Solution by Contractor By: Date: Reviewed By: Date:

ZACHRY-MONTEREY REQUEST FOR INFORMATION ADDISON AIRPORT TUNNEL - JOB #9080.01 180

Subcontractor (if applicable): N.A. Originator: D. Hubensk

Subject: Electrical Conduits into Electrical Room

Problem: The electrical conduits feeding into the electrical room from the commercial source and the emergency generators take up a great deal of space as they cross the roadway leading into the room as shown in Attachment 1. Attachment 2 shows a configuration in which all conduits will fit but may not allow the concrete for the slab/foot to encase the conduit. Attachment 3 shows a layout per National Electrical Code which indicates the conduits will fit outside the limits of the slab/foot.

Proposed Solution by Contractor By: Date: Reviewed By: Date:

H. B. ZACHRY COMPANY REQUEST FOR INFORMATION ADDISON AIRPORT TUNNEL 181

Subcontractor (if applicable): J. L. Steel Originator: Majed Limam

Subject: L Bars top short at Cut & Cover Deck

Problem: L Bars 100% in 100% in the deck of the Cut & Cover are supposed to have 3' clearance. As it stands, the bars are protruding around 1" - 10" from the top of wall (conjunction joint between wall and deck). According to drawings that distance should be 2" - 3". See attached Fig. 1.

Proposed Solution by Contractor By: Date: Reviewed By: Date:

H. B. ZACHRY COMPANY REQUEST FOR INFORMATION ADDISON AIRPORT TUNNEL 182

Subcontractor (if applicable): N.A. Originator: Majed Limam

Subject: Construction Joint at Cut & Cover Deck

Problem: H. B. Zachry Co. proposes to use a construction joint at the tie in between the cut & cover deck and the tunnel liner. The construction joint at the deck will be done monolithically with the last remaining liner pour. Tunnel forms would be pushed outside the portal a certain distance, enough to pour the rest of the cut & cover. (See Fig. 1.)

Proposed Solution by Contractor By: Date: Reviewed By: Date:

H. B. ZACHRY COMPANY REQUEST FOR INFORMATION ADDISON AIRPORT TUNNEL 182A

Subcontractor (if applicable): N.A. Originator: Majed Limam

Subject: Construction Joint at Cut & Cover Deck

Problem: As discussed in RFI 182, Zachry is requesting the use of a construction joint at the tie in between the cut & cover and the tunnel liner. The remaining pour at the deck will be done monolithically with the last liner pour.

Proposed Solution by Contractor By: Date: Reviewed By: Date:

H. B. ZACHRY COMPANY REQUEST FOR INFORMATION ADDISON AIRPORT TUNNEL 182C

Subcontractor (if applicable): N.A. Originator: Majed Limam

Subject: Construction Joint at Cut & Cover Deck

Problem: See proposal.

Proposed Solution by Contractor By: Date: Reviewed By: Date:

H. B. ZACHRY COMPANY REQUEST FOR INFORMATION ADDISON AIRPORT TUNNEL 182D

Subcontractor (if applicable): N.A. Originator: Majed Limam

Subject: Construction Joint at Cut & Cover Deck

Problem: See proposal.

Proposed Solution by Contractor By: Date: Reviewed By: Date:

H. B. ZACHRY COMPANY REQUEST FOR INFORMATION ADDISON AIRPORT TUNNEL 183

Subcontractor (if applicable): N.A. Originator: Majed Limam

Subject: Construction Joint at Cut & Cover Deck

Problem: See proposal.

Proposed Solution by Contractor By: Date: Reviewed By: Date:

H. B. ZACHRY COMPANY REQUEST FOR INFORMATION ADDISON AIRPORT TUNNEL 184

Subcontractor (if applicable): N.A. Originator: Majed Limam

Subject: Block out for 20" Discharge Pump Interferes with rebar at Wump

Problem: The flow line of the 20" discharge pump is shown to be 58.5' on sheet P147. The flow line of the 20" discharge pump is shown to be 58.5' on sheet P147. The flow line of the 20" discharge pump is shown to be 58.5' on sheet P147.

Proposed Solution by Contractor By: Date: Reviewed By: Date:

FINAL RECORD DRAWING Date: 12/25/99

NO.	REVISION	BY	DATE

NORTH TEXAS TOLLWAY AUTHORITY ADDISON AIRPORT TUNNEL

RFI# 171 - 184

DRAWN	DATE	DESIGNED	DATE
CHECKED	DATE	SCALE	DATE

CONTRACT NO. DNT-260 SHEET OF

**H. B. ZACHRY COMPANY**  
REQUEST FOR INFORMATION  
ADDISON AIRPORT TUNNEL

RFI No. 185  
Date: 17-Aug-98

Subcontractor (if applicable):  
Originator: Majed Luman  
Reply Read By: 31-Aug-98

Subject: Blockouts in Sump Deck  
Draw/Spec. No.:  
Distribution List:  
Problem:

A formwork support system is needed when removing super studs from underneath deck pour at the west sump.

Possible rework or extra work involved with this RFI?  N  
Delays in project execution involved with this RFI?  N  
Estimate of time spent evaluating, finding alternate solution to RFI?  N

Proposed Solution by Contractor By: \_\_\_\_\_ Date: \_\_\_\_\_ Reviewed By: \_\_\_\_\_ Date: \_\_\_\_\_

H. B. Zachry Co. proposes to leave around sixteen 4" diameter blockouts in the deck pour of the West Sump structure. These blockouts are necessary in removing the panel forms after the pour. Zachry plans to run cables through openings and use a crane to support the panels while the super studs are removed. Holes will be patched at a later date, after completion of form removal.

Response by Construction Management:  
Date: \_\_\_\_\_ Reviewed by: \_\_\_\_\_

Solution By: \_\_\_\_\_ Date: \_\_\_\_\_ Reviewed by: \_\_\_\_\_ Date: \_\_\_\_\_

**H. B. ZACHRY COMPANY**  
REQUEST FOR INFORMATION  
ADDISON AIRPORT TUNNEL

RFI No. 185C  
Date: 27-Aug-98

Subcontractor (if applicable):  
Originator: Majed Luman  
Reply Read By: ASAP

Subject: Blockouts in Sump Deck  
Draw/Spec. No.: T113, T119  
Distribution List:  
Problem:

This is a further clarification to RFI 185B. The locations of the four blockouts are shown on RFI 185B. Zachry intends to drive cables through the blockouts to support deck forms when shoring towers are dismantled. So the blockouts would be placed around the reinforcing. A 4" diameter PVC pipe would be used as forming material. After pour, cure time, and removal of forms, the blockouts would be patched with grout (water-cement ratio of 1).

Possible rework or extra work involved with this RFI?  Y  
Delays in project execution involved with this RFI?  Y  
Estimate of time spent evaluating, finding alternate solution to RFI?  Y

Proposed Solution by Contractor By: \_\_\_\_\_ Date: \_\_\_\_\_ Reviewed By: \_\_\_\_\_ Date: \_\_\_\_\_

Response by Construction Management:  
Date: \_\_\_\_\_ Reviewed by: \_\_\_\_\_

Solution By: \_\_\_\_\_ Date: \_\_\_\_\_ Reviewed by: \_\_\_\_\_ Date: \_\_\_\_\_

**H. B. ZACHRY COMPANY**  
REQUEST FOR INFORMATION  
ADDISON AIRPORT TUNNEL

RFI No. 186  
Date: 31-Aug-98

Subcontractor (if applicable): J. L. Steel  
Originator: Majed Luman  
Reply Read By: ASAP

Subject: Exact shape of 342 bars @ Electrical Room  
Draw/Spec. No.: T113, T119  
Distribution List:  
Problem:

Sheet T119 shows a type 108 for rebar # 342. Sheet T113 shows the bars 342 to connect the deck of the Electrical Room to the walls. The bend on the bars as delivered and as shown in the plate is too wide. Zachry had to rebar the bars as shown on the attached drawing.

Possible rework or extra work involved with this RFI?  Y  
Delays in project execution involved with this RFI?  Y  
Estimate of time spent evaluating, finding alternate solution to RFI?  Y

Proposed Solution by Contractor By: Majed Luman Date: \_\_\_\_\_ Reviewed By: \_\_\_\_\_ Date: \_\_\_\_\_

Response by Construction Management:  
Date: \_\_\_\_\_ Reviewed by: \_\_\_\_\_

Solution By: \_\_\_\_\_ Date: \_\_\_\_\_ Reviewed by: \_\_\_\_\_ Date: \_\_\_\_\_

**H. B. ZACHRY COMPANY**  
REQUEST FOR INFORMATION  
ADDISON AIRPORT TUNNEL

RFI No. 187  
Date: 07-Sep-98

Subcontractor (if applicable): NA  
Originator: Majed Luman  
Reply Read By: ASAP

Subject: Rail in the cut & cover structure  
Draw/Spec. No.:  
Distribution List:  
Problem:

Zachry proposes to use the same configuration rail used inside the tunnel when building the rail in the cut & cover. Consistency in the rail design is the main reason for the request. Please refer to Submittal 185, submitted by Zachry/Montery for design details.

Possible rework or extra work involved with this RFI?  N  
Delays in project execution involved with this RFI?  N  
Estimate of time spent evaluating, finding alternate solution to RFI?  N

Proposed Solution by Contractor By: \_\_\_\_\_ Date: \_\_\_\_\_ Reviewed By: \_\_\_\_\_ Date: \_\_\_\_\_

Response by Construction Management:  
Date: \_\_\_\_\_ Reviewed by: \_\_\_\_\_

Solution By: \_\_\_\_\_ Date: \_\_\_\_\_ Reviewed by: \_\_\_\_\_ Date: \_\_\_\_\_

**H. B. ZACHRY COMPANY**  
REQUEST FOR INFORMATION  
ADDISON AIRPORT TUNNEL

RFI No. 188  
Date: 10/14/98

Subcontractor (if applicable): NA  
Originator: George James  
Reply Read By: ASAP

Subject: Blockouts in the East Sump Walls  
Draw/Spec. No.:  
Distribution List:  
Problem:

H. B. Zachry Company proposes to use square blockouts connecting to the sump, instead of the round ones.

Possible rework or extra work involved with this RFI?  N  
Delays in project execution involved with this RFI?  N  
Estimate of time spent evaluating, finding alternate solution to RFI?  N

Proposed Solution by Contractor By: \_\_\_\_\_ Date: \_\_\_\_\_ Reviewed By: \_\_\_\_\_ Date: \_\_\_\_\_

Response by Construction Management:  
Date: \_\_\_\_\_ Reviewed by: \_\_\_\_\_

Solution By: \_\_\_\_\_ Date: \_\_\_\_\_ Reviewed by: \_\_\_\_\_ Date: \_\_\_\_\_

**H. B. ZACHRY COMPANY**  
REQUEST FOR INFORMATION  
ADDISON AIRPORT TUNNEL

RFI No. 189  
Date: 10/27/98

Subcontractor (if applicable): J. L. Steel  
Originator: Zachry  
Reply Read By: B.A. HDR, NTA

Subject: Substitution of Normal Asphalt for 6" of Coarse Concrete Aggregate in base  
Draw/Spec. No.: Sheet C12  
Distribution List:  
Problem:

The stability of the proposed 17 inch (average) thick layer of coarse aggregate below the concrete paving inside the tunnel is questionable. Sheet C12 shows the cross-section detail design. The narrow available width inside the tunnel will force loaded ready mix trucks to pass within a couple feet of the set paving forms while placing paving concrete. There may be a tendency for the gravel to 'blow' or displace under repeated and heavy, moving tire load. Additionally, the vibration and bouncing action of the Clay-type screen has also been mentioned as a factor that could lead to grade-problems with the paving forms sitting on crushed gravel.

Possible rework or extra work involved with this RFI?  N  
Delays in project execution involved with this RFI?  Y  
Estimate of time spent evaluating, finding alternate solution to RFI?  Y

Proposed Solution by Contractor By: HBZ Date: 10/27/98 Reviewed By: J. Gardner

Response by Construction Management:  
Date: \_\_\_\_\_ Reviewed by: \_\_\_\_\_

Solution By: \_\_\_\_\_ Date: \_\_\_\_\_ Reviewed by: \_\_\_\_\_ Date: \_\_\_\_\_

**ZACHRY-MONTEREY**  
REQUEST FOR INFORMATION  
ADDISON AIRPORT TUNNEL - JOB #9080.01

RFI No. 190  
Date: 10/14/98

Subcontractor (if applicable): B.M. 704  
Originator: D. Hubert  
Reply Read By: 11/13/98

Subject: Communications Additions  
Draw/Spec. No.:  
Distribution List:  
Problem:

The drawings for the security cameras on the east end of the tunnel were not embedded into the tunnel concrete due to use drawings for these conduits not being complete before the start of the tunnel cast.

Possible rework or extra work involved with this RFI?  Y  
Delays in project execution involved with this RFI?  N  
Estimate of time spent evaluating, finding alternate solution to RFI?  Y

Proposed Solution by Contractor By: \_\_\_\_\_ Date: \_\_\_\_\_ Reviewed By: \_\_\_\_\_ Date: \_\_\_\_\_

Response by Construction Management:  
Date: \_\_\_\_\_ Reviewed by: \_\_\_\_\_

Solution By: \_\_\_\_\_ Date: \_\_\_\_\_ Reviewed by: \_\_\_\_\_ Date: \_\_\_\_\_

**ZACHRY-MONTEREY**  
REQUEST FOR INFORMATION  
ADDISON AIRPORT TUNNEL - JOB #9080.01

RFI No. 191  
Date: 10/30/98

Subcontractor (if applicable): HBZ  
Originator: D. Hubert  
Reply Read By: 11/13/98

Subject: Communications Additions  
Draw/Spec. No.:  
Distribution List:  
Problem:

The drawings indicate four each 1-1/4" inner ducts inside of the 4" conduit. Four each 1-1/4" inner ducts will not fit in a 4" conduit.

Possible rework or extra work involved with this RFI?  Y  
Delays in project execution involved with this RFI?  N  
Estimate of time spent evaluating, finding alternate solution to RFI?  Y

Proposed Solution by Contractor By: \_\_\_\_\_ Date: \_\_\_\_\_ Reviewed By: \_\_\_\_\_ Date: \_\_\_\_\_

Response by Construction Management:  
Date: \_\_\_\_\_ Reviewed by: \_\_\_\_\_

Solution By: \_\_\_\_\_ Date: \_\_\_\_\_ Reviewed by: \_\_\_\_\_ Date: \_\_\_\_\_

**H. B. ZACHRY COMPANY**  
REQUEST FOR INFORMATION  
ADDISON AIRPORT TUNNEL

RFI No. 192  
Date: 11/17/98

Subcontractor (if applicable): J. L. Steel  
Originator: HBZ/Zachry Co./J. Steel  
Reply Read By: Bower & Rose

Subject: Discrepancies in pavement joint layout  
Draw/Spec. No.: C27A  
Distribution List:  
Problem:

Sheet C27-A has numerous paving joint layout discrepancies. The north-edge of the paving has a 3 ft. break in alignment at Station 6+00. Also, every joint, except along the Project Control Line, is mismatched at Station 6+00. See Attachment A.

Possible rework or extra work involved with this RFI?  N  
Delays in project execution involved with this RFI?  Y  
Estimate of time spent evaluating, finding alternate solution to RFI?  Y

Proposed Solution by Contractor By: HBZ/Zachry Co./J. Steel Date: 11/17/98 Reviewed By: J. Gardner

Response by Construction Management:  
Date: \_\_\_\_\_ Reviewed by: \_\_\_\_\_

Solution By: \_\_\_\_\_ Date: \_\_\_\_\_ Reviewed by: \_\_\_\_\_ Date: \_\_\_\_\_

**H. B. ZACHRY COMPANY**  
REQUEST FOR INFORMATION  
ADDISON AIRPORT TUNNEL

RFI No. 193  
Date: 30-Nov-98

Subcontractor (if applicable): NA  
Originator: Majed Luman  
Reply Read By: ASAP

Subject: Conflict between LWI Footing @ SW RW and Type 'C' Inlet  
Draw/Spec. No.: C42, S79  
Distribution List:  
Problem:

Type 'C' inlet at station 7+97.34.5 RT is in conflict with the LWI type wall footing, bay 48. The flow line of the inlet is at elevation 609.00. The top of the LWI footing at station 611. The bottom elevation of the LWI footing on bay 48 is 609.5'. The top of footing elevation is 611. Accordingly, the pipe is in conflict with the footing at that location. Please see attached drawing.

Possible rework or extra work involved with this RFI?  Y  
Delays in project execution involved with this RFI?  Y  
Estimate of time spent evaluating, finding alternate solution to RFI?  Y

Proposed Solution by Contractor By: \_\_\_\_\_ Date: \_\_\_\_\_ Reviewed By: \_\_\_\_\_ Date: \_\_\_\_\_

Response by Construction Management:  
Date: \_\_\_\_\_ Reviewed by: \_\_\_\_\_

Solution By: \_\_\_\_\_ Date: \_\_\_\_\_ Reviewed by: \_\_\_\_\_ Date: \_\_\_\_\_

FINAL RECORD  
DRAWING  
Date: 12/25/99

NO.	REVISION	BY	DATE
NORTH TEXAS TOLLWAY AUTHORITY ADDISON AIRPORT TUNNEL			
RFI# 185 - 193			
DRAWN _____ DATE _____		DESIGNED _____ DATE _____	
CHECKED _____ DATE _____		SCALE _____	
CONTRACT NO. DNT-260 SHEET _____ OF _____			

**Brown & Root**  
 16610 Dallas Parkway, Suite 2200 / Dallas, TX 75248  
 December 18, 1998  
 LETTER NO.: HBZ 260-552  
 SUBJECT FILE CODE: 765.10  
 H. B. Zachry Company  
 PO Box 1004  
 Addison, Texas 75001-1004  
 REF: Addison Airport Toll Tunnel  
 DNT-260  
 Attention: Mr. James Gardner  
 SUBJECT: Underdrain along Southeast "Shotcrete" Retaining Wall (RFI-194, EAR-26)

Dear Mr. Gardner:  
 In formal response to H. B. Zachry's RFI-194 dated 7 December 1998, Brown & Root instructs you to install pipe underdrains along the Southeast "Shotcrete" Retaining Wall according to the attached plan and section sketches. Brown & Root has considered the possible conflict of a future "face-wall" footing, the lighting power line (signing, Pavement Marking, and Illumination Plans (DNT-205) Contract Drawing Sheets #1, 2, & 23), the replace video communications conduits (Contract Drawing Sheet E156 - Note 1-3), and the pavement curb (Contract Drawing Sheets C-24 & C-25). Therefore, place the underdrains as close as possible to the shotcrete wall. Install the underdrains according to the instructions in RFI-157 and Pipe Underdrains Special Provision Item 556. Backfill with Cement Treated Base as shown on the section sketch between the wall and the pavement curb only.

The North Texas Tollway Authority intends not to issue revised Contract Drawing Sheets C-24 & C-25. Therefore, H. B. Zachry shall make the pipe underdrain additions to their as-bid Contract Drawings.  
 Brown & Root considers that the pipe underdrain additions and the cement treated base usage to be a quantity increase change to the Contract. If acceptable to H. B. Zachry, the added underdrains will be paid at the Pipe Underdrain Item 556 & SP bid prices for 6-in. pipe roadway and slope underdrains. The cement treated base will be paid at the Cement Treated Base Item 276 bid price for 6-in. thickness times two, for the two lifts of 6-in. cement treated base.

RFI-194 Services  
 194

**H. B. ZACHRY COMPANY**  
**REQUEST FOR INFORMATION**  
**ADDISON AIRPORT TUNNEL**  
 Subcontractor (if applicable): N/A  
 Originator: Majed Luman  
 Reply Read By: ASAP  
 Distribution List: Bill Leach, George James, Majed Luman  
 Problem: Rock bolts in east portal of tunnel  
 Draw/Spec. No.: T130  
 Possible rework or extra work involved with this RFI?  N  Y  
 Delays in project execution involved with this RFI?  N  Y  
 Estimate of time spent evaluating, finding alternate solution to RFI? Engineering: 0 Hrs, Surveying Crew: 0 Hrs, Other: 0 Hrs  
 Proposed Solution by Contractor By: [Signature] Date: 1/2/99 Reviewed By: [Signature]  
 Response by Construction Management: [Handwritten notes]

**REQUEST FOR INFORMATION**  
**ADDISON AIRPORT TUNNEL**  
 Subcontractor (if applicable): Zachry/Monterey  
 Originator: HB Zachry Co.  
 Reply Read By: Zachry/Monterey  
 Distribution List: Bill Leach, Majed Luman  
 Problem: Sump Bracing  
 Draw/Spec. No.: P148  
 Possible rework or extra work involved with this RFI?  N  Y  
 Delays in project execution involved with this RFI?  N  Y  
 Estimate of time spent evaluating, finding alternate solution to RFI? Engineering: 1 Hrs, Surveying Crew: 0 Hrs, Other: 0 Hrs  
 Proposed Solution by Contractor By: HB Zachry Co. Date: 12/29/98 Reviewed By: J. Gardner  
 Response by Construction Management: [Handwritten notes]

**ZACHRY CONSTRUCTION CORP.**  
**REQUEST FOR INFORMATION**  
**ADDISON AIRPORT TUNNEL**  
 Subcontractor (if applicable): S&J Electrical  
 Originator: Zachry Const. Corp.  
 Reply Read By: S&J Electrical  
 Distribution List: Bill Leach, Majed Luman  
 Problem: Overhead Sign #1 and #2  
 Draw/Spec. No.: DNT-205, Sheets 8, 10, 13 and 14  
 Possible rework or extra work involved with this RFI?  N  Y  
 Delays in project execution involved with this RFI?  N  Y  
 Estimate of time spent evaluating, finding alternate solution to RFI? Engineering: 1 Hrs, Surveying Crew: 1 Hrs, Other: 0 Hrs  
 Proposed Solution by Contractor By: HB Zachry Co. Date: 01/2/99 Reviewed By: J. Gardner  
 Response by Construction Management: [Handwritten notes]

**H. B. ZACHRY COMPANY**  
**REQUEST FOR INFORMATION**  
**ADDISON AIRPORT TUNNEL**  
 Subcontractor (if applicable): S&J  
 Originator: Majed Luman  
 Reply Read By: ASAP  
 Distribution List: George James, S&J  
 Problem: Overhead Sign #1 interfering with existing utilities  
 Draw/Spec. No.: Sheet # 8, 13  
 Possible rework or extra work involved with this RFI?  N  Y  
 Delays in project execution involved with this RFI?  N  Y  
 Estimate of time spent evaluating, finding alternate solution to RFI? Engineering: 1 Hrs, Surveying Crew: 1 Hrs, Other: 2 Hrs  
 Proposed Solution by Contractor By: Majed Luman Date: 2/9/99 Reviewed By: [Signature]  
 Response by Construction Management: [Handwritten notes]

**ZACHRY CONSTRUCTION CORP.**  
**REQUEST FOR INFORMATION**  
**ADDISON AIRPORT TUNNEL**  
 Subcontractor (if applicable): S&J Electrical (Sign and Illumination Sub)  
 Originator: Zachry Const. Corp.  
 Reply Read By: ASAP  
 Distribution List: [Blank]  
 Problem: Location of proposed Light Poles along north edge of Keller Springs  
 Draw/Spec. No.: SP&I Plans - sheet 18  
 Possible rework or extra work involved with this RFI?  N  Y  
 Delays in project execution involved with this RFI?  N  Y  
 Estimate of time spent evaluating, finding alternate solution to RFI? Engineering: 1 Hrs, Surveying Crew: 1 Hrs, Other: 0 Hrs  
 Proposed Solution by Contractor By: Zachry Const. Corp. Date: 1/19/99 Reviewed By: J. Gardner  
 Response by Construction Management: [Handwritten notes]

**H. B. ZACHRY COMPANY**  
**REQUEST FOR INFORMATION**  
**ADDISON AIRPORT TUNNEL**  
 Subcontractor (if applicable): S&J Electric  
 Originator: Majed Luman  
 Reply Read By: ASAP  
 Distribution List: Chapp, George James  
 Problem: Exact height of wall mounted roadway illumination signs  
 Draw/Spec. No.: Sheet 20, DNT-193  
 Possible rework or extra work involved with this RFI?  N  Y  
 Delays in project execution involved with this RFI?  N  Y  
 Estimate of time spent evaluating, finding alternate solution to RFI? Engineering: 0 Hrs, Surveying Crew: 0 Hrs, Other: 0 Hrs  
 Proposed Solution by Contractor By: [Signature] Date: 1/19/99 Reviewed By: J. Gardner  
 Response by Construction Management: [Handwritten notes]

**H. B. ZACHRY COMPANY**  
**REQUEST FOR INFORMATION**  
**ADDISON AIRPORT TUNNEL**  
 Subcontractor (if applicable): S&J  
 Originator: Majed Luman  
 Reply Read By: ASAP  
 Distribution List: George James, S&J  
 Problem: Relocation of sign # 40  
 Draw/Spec. No.: Sheet 10, DNT 260 Signage Plans  
 Possible rework or extra work involved with this RFI?  N  Y  
 Delays in project execution involved with this RFI?  N  Y  
 Estimate of time spent evaluating, finding alternate solution to RFI? Engineering: 0 Hrs, Surveying Crew: 0 Hrs, Other: 0 Hrs  
 Proposed Solution by Contractor By: [Signature] Date: 1/2/99 Reviewed By: [Signature]  
 Response by Construction Management: [Handwritten notes]

**H. B. ZACHRY COMPANY**  
**REQUEST FOR INFORMATION**  
**ADDISON AIRPORT TUNNEL**  
 Subcontractor (if applicable): S&J, ZM  
 Originator: Majed Luman  
 Reply Read By: ASAP  
 Distribution List: George James, S&J, ZM  
 Problem: Ground pull box behind West Portal RW and conduits  
 Draw/Spec. No.: Sheet 13, DNT 260, Sheet 1129, DNT 260  
 Possible rework or extra work involved with this RFI?  N  Y  
 Delays in project execution involved with this RFI?  N  Y  
 Estimate of time spent evaluating, finding alternate solution to RFI? Engineering: 1 Hrs, Surveying Crew: 1 Hrs, Other: 0 Hrs  
 Proposed Solution by Contractor By: [Signature] Date: 1/2/99 Reviewed By: [Signature]  
 Response by Construction Management: [Handwritten notes]

**FINAL RECORD**  
**DRAWING**  
 Date: 12/25/99

NO.	REVISION	BY	DATE
NORTH TEXAS TOLLWAY AUTHORITY ADDISON AIRPORT TUNNEL			
RFI# 194 - 201			
DRAWN	DATE	DESIGNED	DATE
CHECKED	DATE	SCALE	
CONTRACT NO. DNT-260 SHEET OF			





REQUEST FOR INFORMATION ADDISON AIRPORT TUNNEL - PROJECT (DNT-260) 919

Contractor/Subcontractor: H.B. Zachry / BLANSSANCE

Subject: TUNNEL AND SUMP UNDERDRAIN PROBLEMS

Problem: THE UNDERDRAIN HOLES FOR THE OUTSIDE OF THE TUNNEL ARE LOCATED ON THE EAST AND WEST SIDES OF THE TUNNEL. THE HOLES ARE LOCATED ABOUT 10 FEET FROM THE TUNNEL WALLS. THE HOLES ARE LOCATED ON THE EAST AND WEST SIDES OF THE TUNNEL. THE HOLES ARE LOCATED ON THE EAST AND WEST SIDES OF THE TUNNEL. THE HOLES ARE LOCATED ON THE EAST AND WEST SIDES OF THE TUNNEL.

Response by Designer or other Organization: IF THE CONTRACTOR IS INTERESTED IN THE UNDERDRAIN HOLES, THEY ARE LOCATED ON THE EAST AND WEST SIDES OF THE TUNNEL. THE HOLES ARE LOCATED ON THE EAST AND WEST SIDES OF THE TUNNEL. THE HOLES ARE LOCATED ON THE EAST AND WEST SIDES OF THE TUNNEL.

REQUEST FOR INFORMATION ADDISON AIRPORT TUNNEL - PROJECT (DNT-260) 920

Contractor/Subcontractor: H.B. Zachry / RANNEY-MONTAGNY

Subject: TUNNEL ROAD GRAB

Problem: THE LOWEST ELEVATION OF TUNNEL PAVEMENT IS AT APPROXIMATELY STA 22+2.0 (DRAWING SHEET C-22).

Response by Designer or other Organization: THIS PROBLEM CAME TO MY ATTENTION THE LAST PLACEMENT OF PANEL CONCRETE PAVEMENT AND THE TUNNEL DRAIN.

REQUEST FOR INFORMATION ADDISON AIRPORT TUNNEL - PROJECT (DNT-260) 921

Contractor/Subcontractor: H.B. Zachry / BLANSSANCE / J.L. STEEL

Subject: TYPICAL INVERTS (CONCRETE GATE SET)

Problem: THE TYPICAL INVERT WITH SET ELEVATIONS DO NOT MATCH THE UNDERDRAIN SYSTEM AND THE UNDERDRAIN SYSTEM DOES NOT MATCH THE UNDERDRAIN SYSTEM.

Response by Designer or other Organization: THE TYPICAL INVERT WITH SET ELEVATIONS DO NOT MATCH THE UNDERDRAIN SYSTEM AND THE UNDERDRAIN SYSTEM DOES NOT MATCH THE UNDERDRAIN SYSTEM.

REQUEST FOR INFORMATION ADDISON AIRPORT TUNNEL - PROJECT (DNT-260) 922

Contractor/Subcontractor: H.B. Zachry / BLANSSANCE

Subject: OUTFALL OF UNDERDRAIN SYSTEM

Problem: THE UNDERDRAIN SYSTEM SHOWN ON DRAWING C-20 APPEARS TO HAVE NO OUTFALL UNLESS DONE BY THE CONTRACTOR.

Response by Designer or other Organization: THE UNDERDRAIN SYSTEM SHOWN ON DRAWING C-20 APPEARS TO HAVE NO OUTFALL UNLESS DONE BY THE CONTRACTOR.

REQUEST FOR INFORMATION ADDISON AIRPORT TUNNEL - PROJECT (DNT-260) 923

Contractor/Subcontractor: H.B. Zachry / RANNEY-MONTAGNY

Subject: TUNNEL SUMP DISCHARGE LINE - VALVE

Problem: SHOULD THE BURN GATE VALVE SHOWN ON THIS CONTRACT DRAWING BE 10" AND 10" OR AN 8" IN DIAMETER VALVE INSTEAD?

Response by Designer or other Organization: THE GATE VALVE IS IN THE MAIN DISCHARGE LINE FROM THE TUNNEL SUMP.

REQUEST FOR INFORMATION ADDISON AIRPORT TUNNEL - PROJECT (DNT-260) 924

Contractor/Subcontractor: H.B. Zachry

Subject: (Mechanical) Use of Levee and Underdrain

Problem: NEED CLARIFICATION FOR Sump and Underdrain (Mechanical) Between STA 10+0 TO STA 12+00 Behind North Curb, (Line 0, Area Around) Parking Lot 2 to the South-East Corner of Midway & Keller Spans.

Response by Designer or other Organization: 3:1 SLOPE OR GREATER, USE SUMPING, DRAINAGE, AND/OR UNDERDRAIN SYSTEMS AS SHOWN ON SET. SEE COMMENTS TO SET SHEET C-10 FOR SUMPING, DRAINAGE, AND/OR UNDERDRAIN SYSTEMS AS SHOWN ON SET.

REQUEST FOR INFORMATION ADDISON AIRPORT TUNNEL - PROJECT (DNT-260) 924A

Contractor/Subcontractor: H.B. Zachry

Subject: (Mechanical) Use of Levee and Underdrain

Problem: NEED CLARIFICATION FOR Sump and Underdrain (Mechanical) Between STA 10+0 TO STA 12+00 Behind North Curb, (Line 0, Area Around) Parking Lot 2 to the South-East Corner of Midway & Keller Spans.

Response by Designer or other Organization: 3:1 SLOPE OR GREATER, USE SUMPING, DRAINAGE, AND/OR UNDERDRAIN SYSTEMS AS SHOWN ON SET.

REQUEST FOR INFORMATION ADDISON AIRPORT TUNNEL - PROJECT (DNT-260) 925

Contractor/Subcontractor: H.B. Zachry

Subject: CONCRETE GUTTER (TYP)

Problem: THE PAVEMENT IS A 5" WIDE GUTTER (CONCRETE) FROM STA 24+25 TO STA 30+60 ON STREET C-22.

Response by Designer or other Organization: THE PAVEMENT IS A 5" WIDE GUTTER (CONCRETE) FROM STA 24+25 TO STA 30+60 ON STREET C-22.

REQUEST FOR INFORMATION ADDISON AIRPORT TUNNEL - PROJECT (DNT-260) 926A

Contractor/Subcontractor: H.B. Zachry

Subject: SAFETY DOOR

Problem: THE DOOR TO THE OUTSIDE OF THE ELECTRICAL MECH ROOM DOES NOT HAVE FULL RELEASE HARDWARE.

Response by Designer or other Organization: THE DOOR TO THE OUTSIDE OF THE ELECTRICAL MECH ROOM DOES NOT HAVE FULL RELEASE HARDWARE.

REQUEST FOR INFORMATION ADDISON AIRPORT TUNNEL - PROJECT (DNT-260) 927

Contractor/Subcontractor: H.B. Zachry / RANNEY-MONTAGNY

Subject: RECTANGULAR PLATE QUANTITIES

Problem: REQUESTING QUANTITIES FOR RECTANGULAR PLATE QUANTITIES.

Response by Designer or other Organization: REQUESTING QUANTITIES FOR RECTANGULAR PLATE QUANTITIES.

NO.	REVISION	BY	DATE
NORTH TEXAS TOLLWAY AUTHORITY ADDISON AIRPORT TUNNEL			
RFI# 919 - 927			
DRAWN _____ DATE _____ DESIGNED _____ DATE _____ CHECKED _____ DATE _____ SCALE _____			
CONTRACT NO. DNT-260 SHEET _____ OF _____			

FINAL RECORD  
DRAWING  
Date: 12/25/99