


2 Enlarged Vault Detail
Scale: 1/8" = 1'-0"

SUBMITTAL REVIEW	
<input type="checkbox"/> NO EXCEPTIONS TAKEN	<input type="checkbox"/> REVISE AND RESUBMIT
<input type="checkbox"/> MAKE CORRECTIONS NOTED	<input type="checkbox"/> SUBMIT SPECIFIED TEST
CHECKING IS ONLY FOR GENERAL COMPLIANCE WITH THE DESIGN CONCEPTS OF THE PROJECT AND GENERAL COMPLIANCE WITH THE INFORMATION IN THE CONTRACT DOCUMENTS. ANY ACTION SHOWN ABOVE IS SUBJECT TO THE REQUIREMENTS OF THE PLANS AND SPECIFICATIONS. CONTRACTOR IS RESPONSIBLE FOR DIMENSIONS WHICH SHALL BE FABRICATED AND CORRELATED AT THE JOB SITE. FABRICATOR'S PROCESSES AND TECHNIQUES OF CONSTRUCTION, COORDINATION OF HIS WORK WITH THAT OF OTHER TRADES, AND THE SATISFACTORY PERFORMANCE OF HIS WORK.	
TOWN OF ADDISON P.O. BOX 9010 ADDISON, TX 75001	
BY <i>David K. Libre</i>	DATE 9/13/17

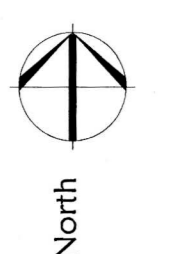

1 Site Utilities Plan Revised
Scale: 1" = 20'-0"

RECEIVED SEP 13 2017

LIBRE.Ventures LLC
Architectural Services

2400 Louisiana Boulevard NE
Albuquerque, New Mexico 87110
tele no. 505.348.3513
richard@Libre.Ventures

SWRe/DAC Building Addition
15920 Addison Road
Addison, Texas 75001
Plan Review & Permit
7 Sept. 2016


Revised Site Utilities Plan

SU.101




15920 Addison

COPYRIGHT NOTICE ALL RIGHTS RESERVED
These drawings and specifications shall remain the property of the ARCHITECT and shall not be used for any other projects without the written consent of the ARCHITECT. These documents are not to be reproduced, changed or copied in any form or manner without the written consent of the ARCHITECT.

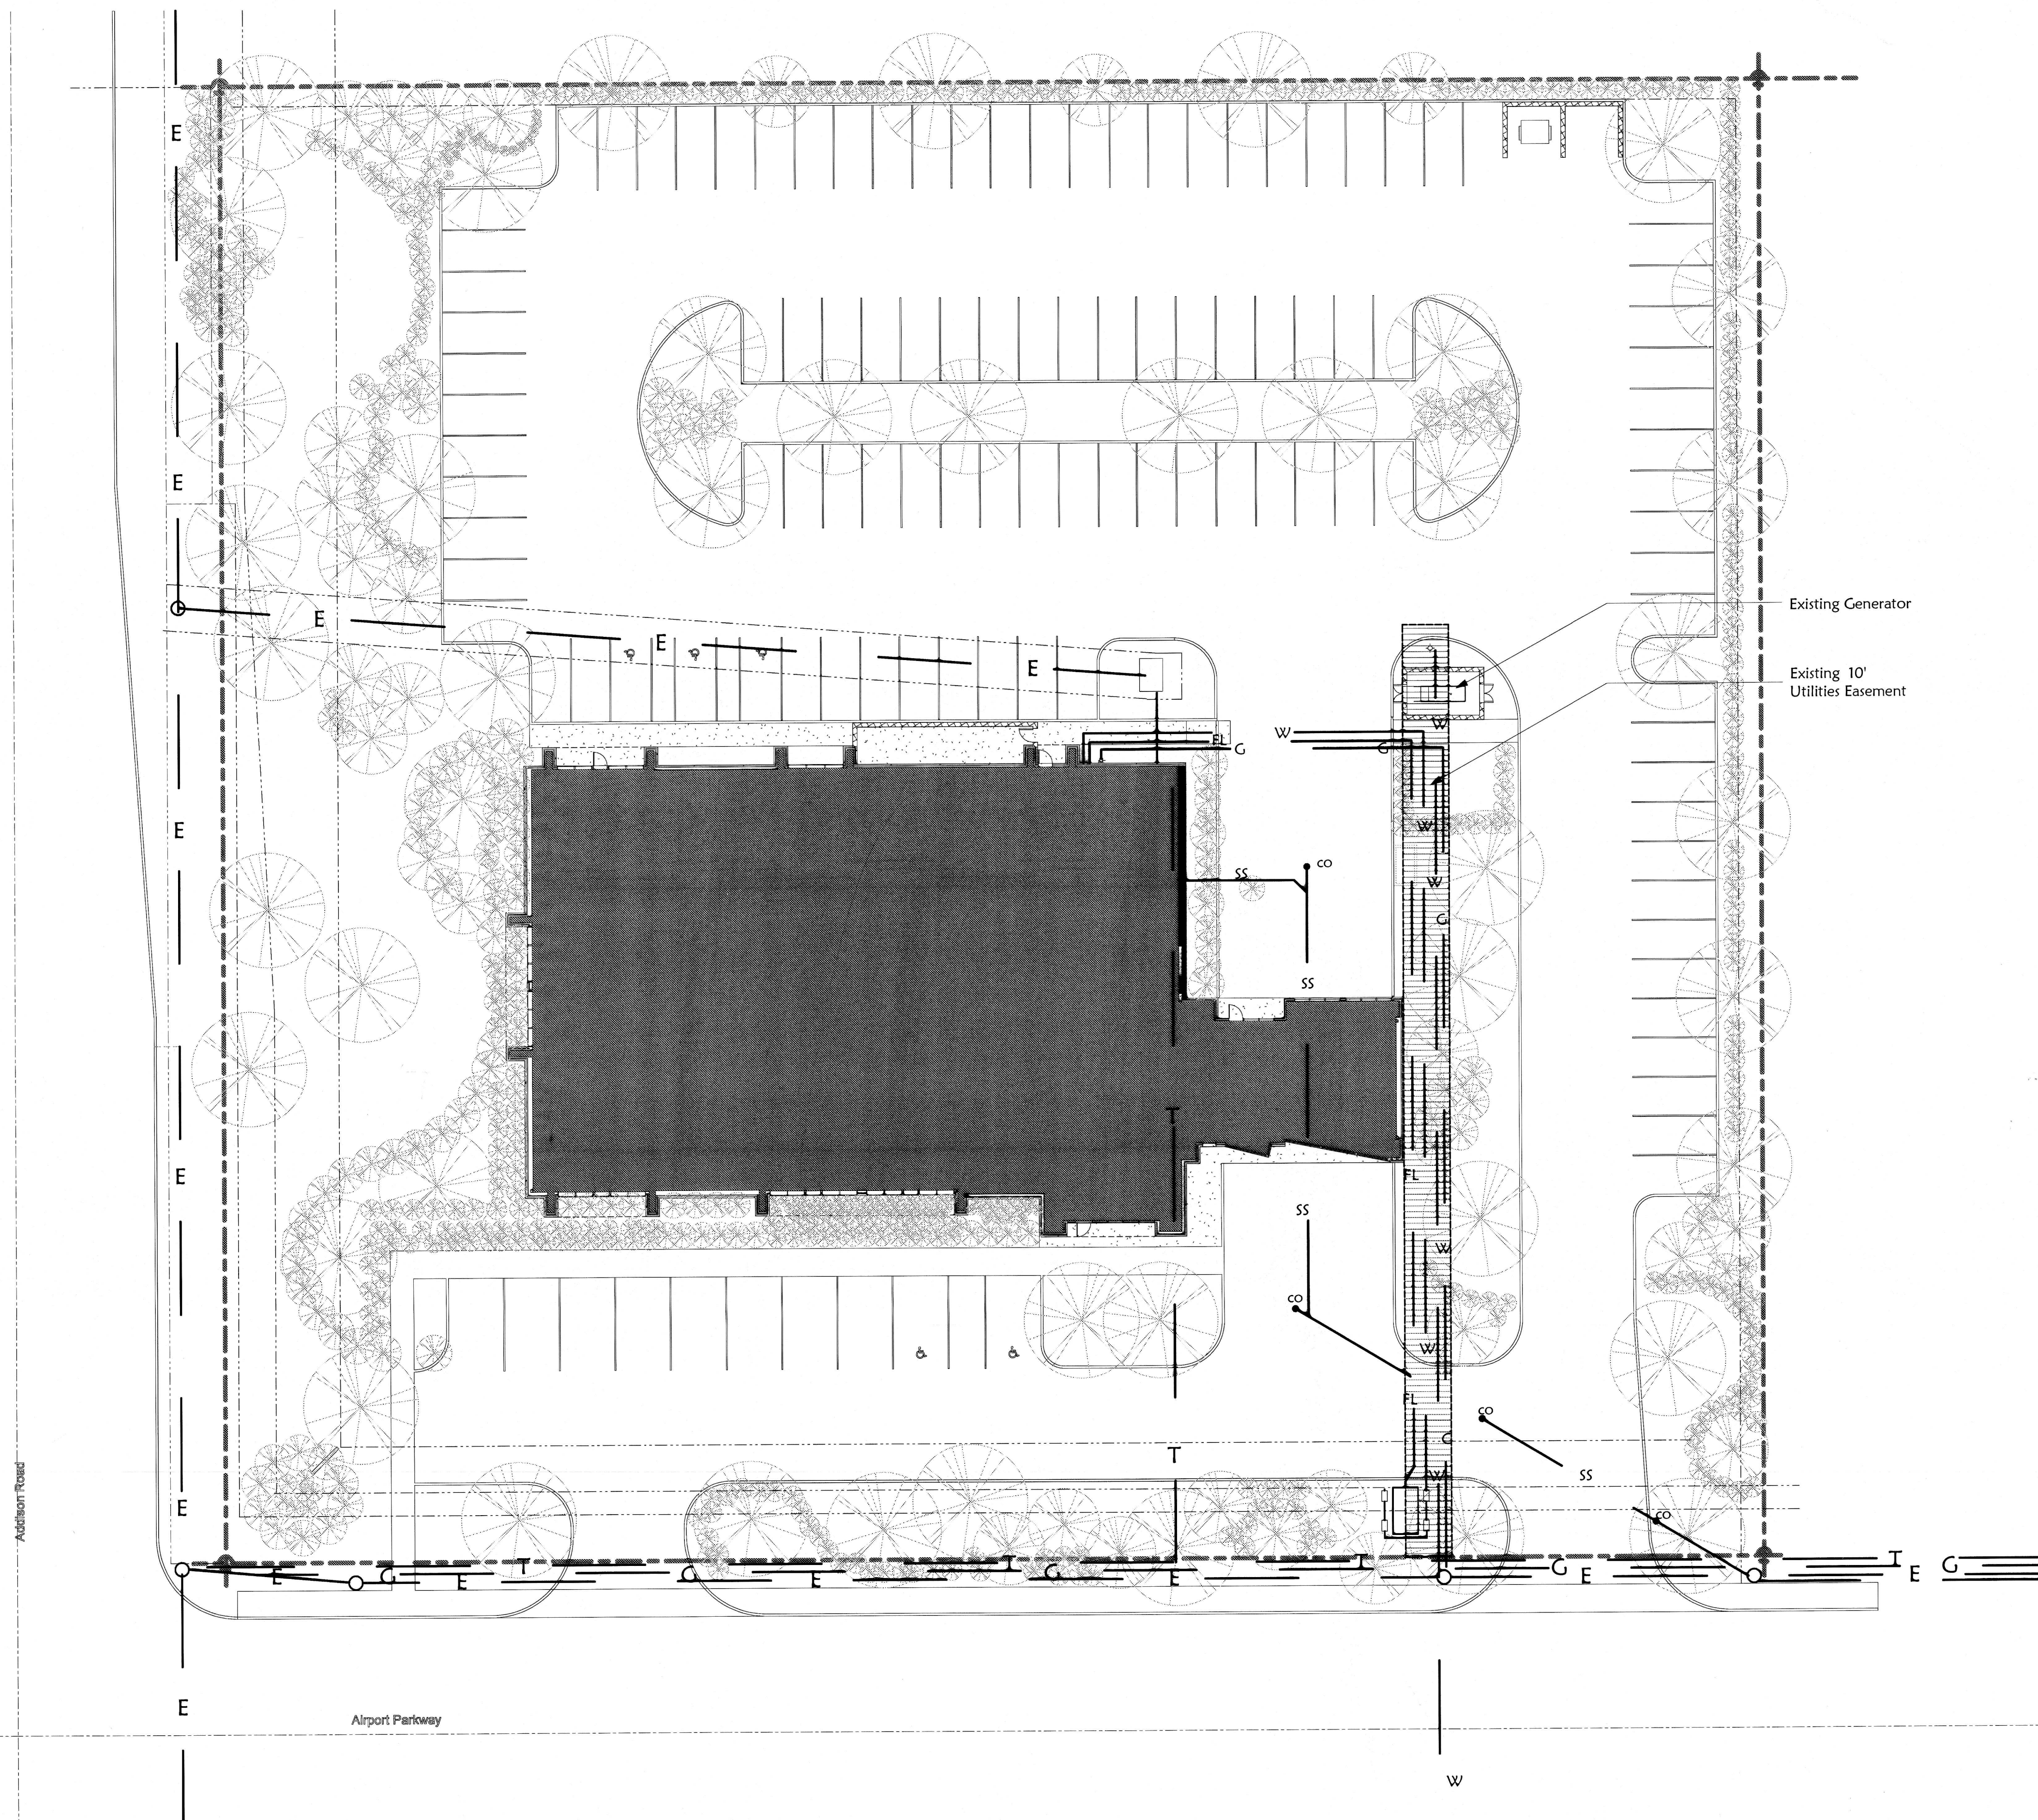

APPROVED FOR CONSTRUCTION
 Town of Addison
 Infrastructure Operations And Services Department
 APPROVED BY: *[Signature]*
 DATE: 7/3/17
 16801 Westgrove Dr. Addison, TX 75001 (972)450-2871

All responsibility for the adequacy of these plans remains with the Engineer who prepared them. In approving these plans, the Town of Addison makes no representation of adequacy of the work of the Design Engineer.

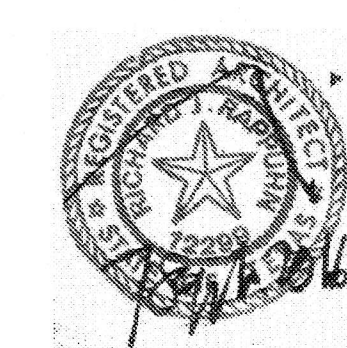

LIBRE.Ventures LLC
 Architectural Services
 2400 Louisiana Boulevard NE
 Albuquerque, New Mexico 87110
 tele no. 505.348.3513
 richard@Libre.Ventures



SWRe/DAC Building Addition
 15920 Addison Road
 Addison, Texas 75001
 Plan Review & Permit
 7 Sept. 2016

Existing Site Utilities Plan **SU.100**

North
 1 Existing Site Utilities Plan
 Scale: 1" = 20'-0"

15920 ADDISON RD

COPYRIGHT NOTICE ALL RIGHTS RESERVED
 These drawings and specifications shall remain the property of the ARCHITECT and shall not be used for any other projects without the written consent of the ARCHITECT. These documents are not to be reproduced, changed or copied in any form or manner whatsoever. Nor are they to be assigned to any third party without first obtaining the written permission and consent of the ARCHITECT.

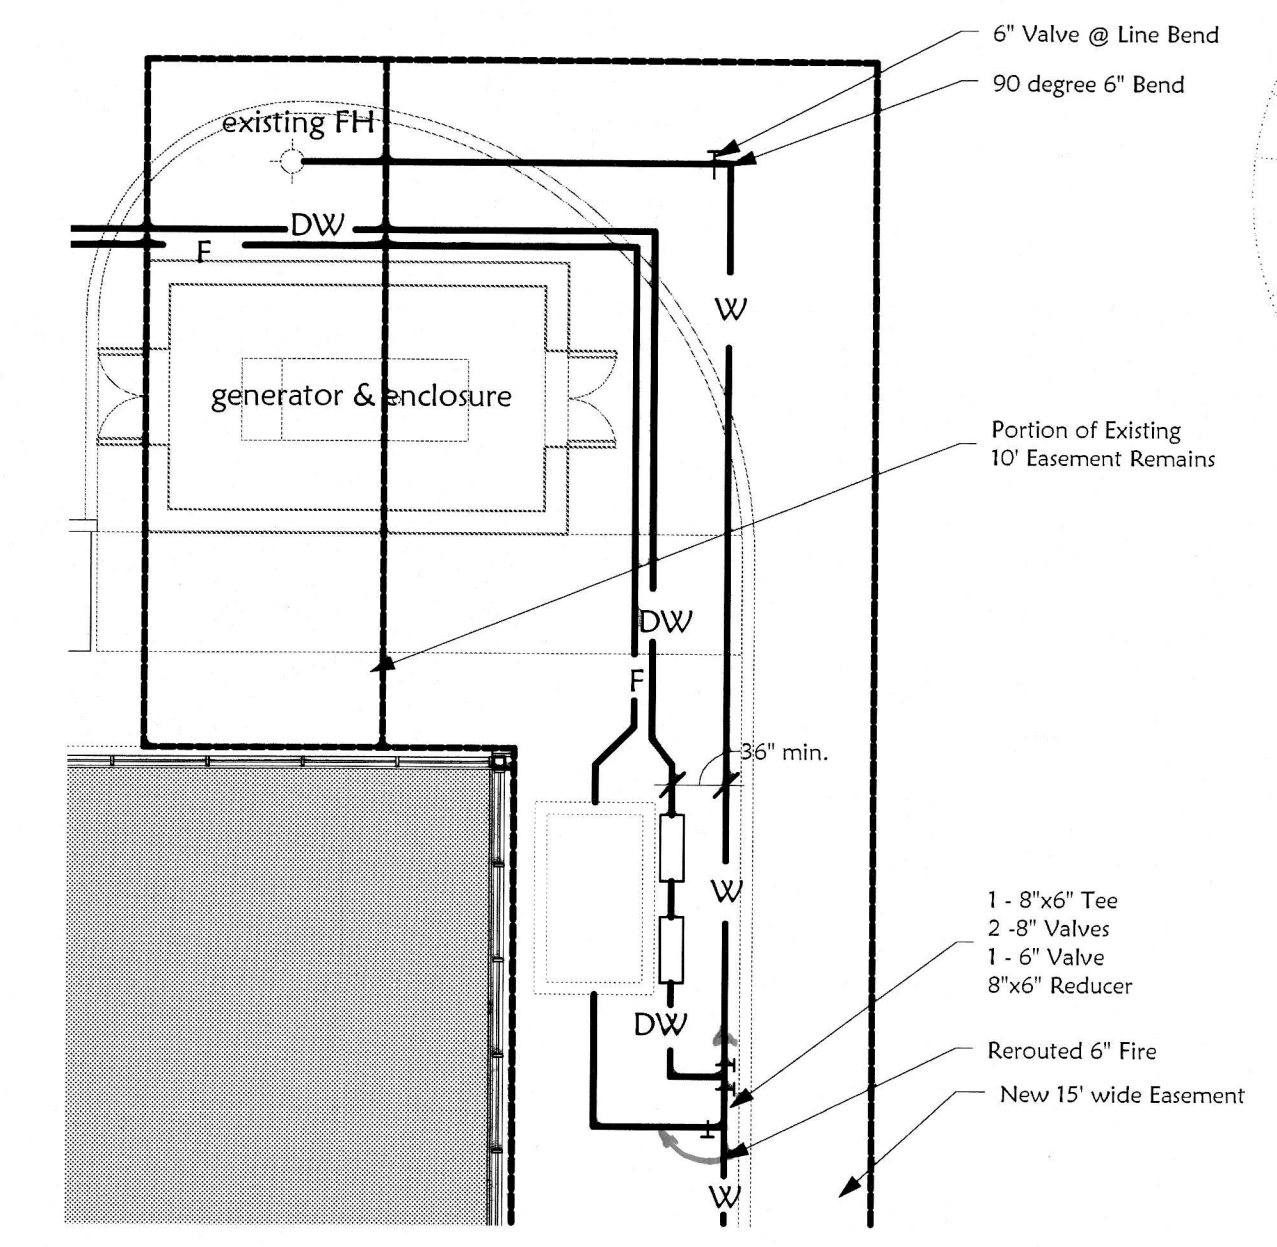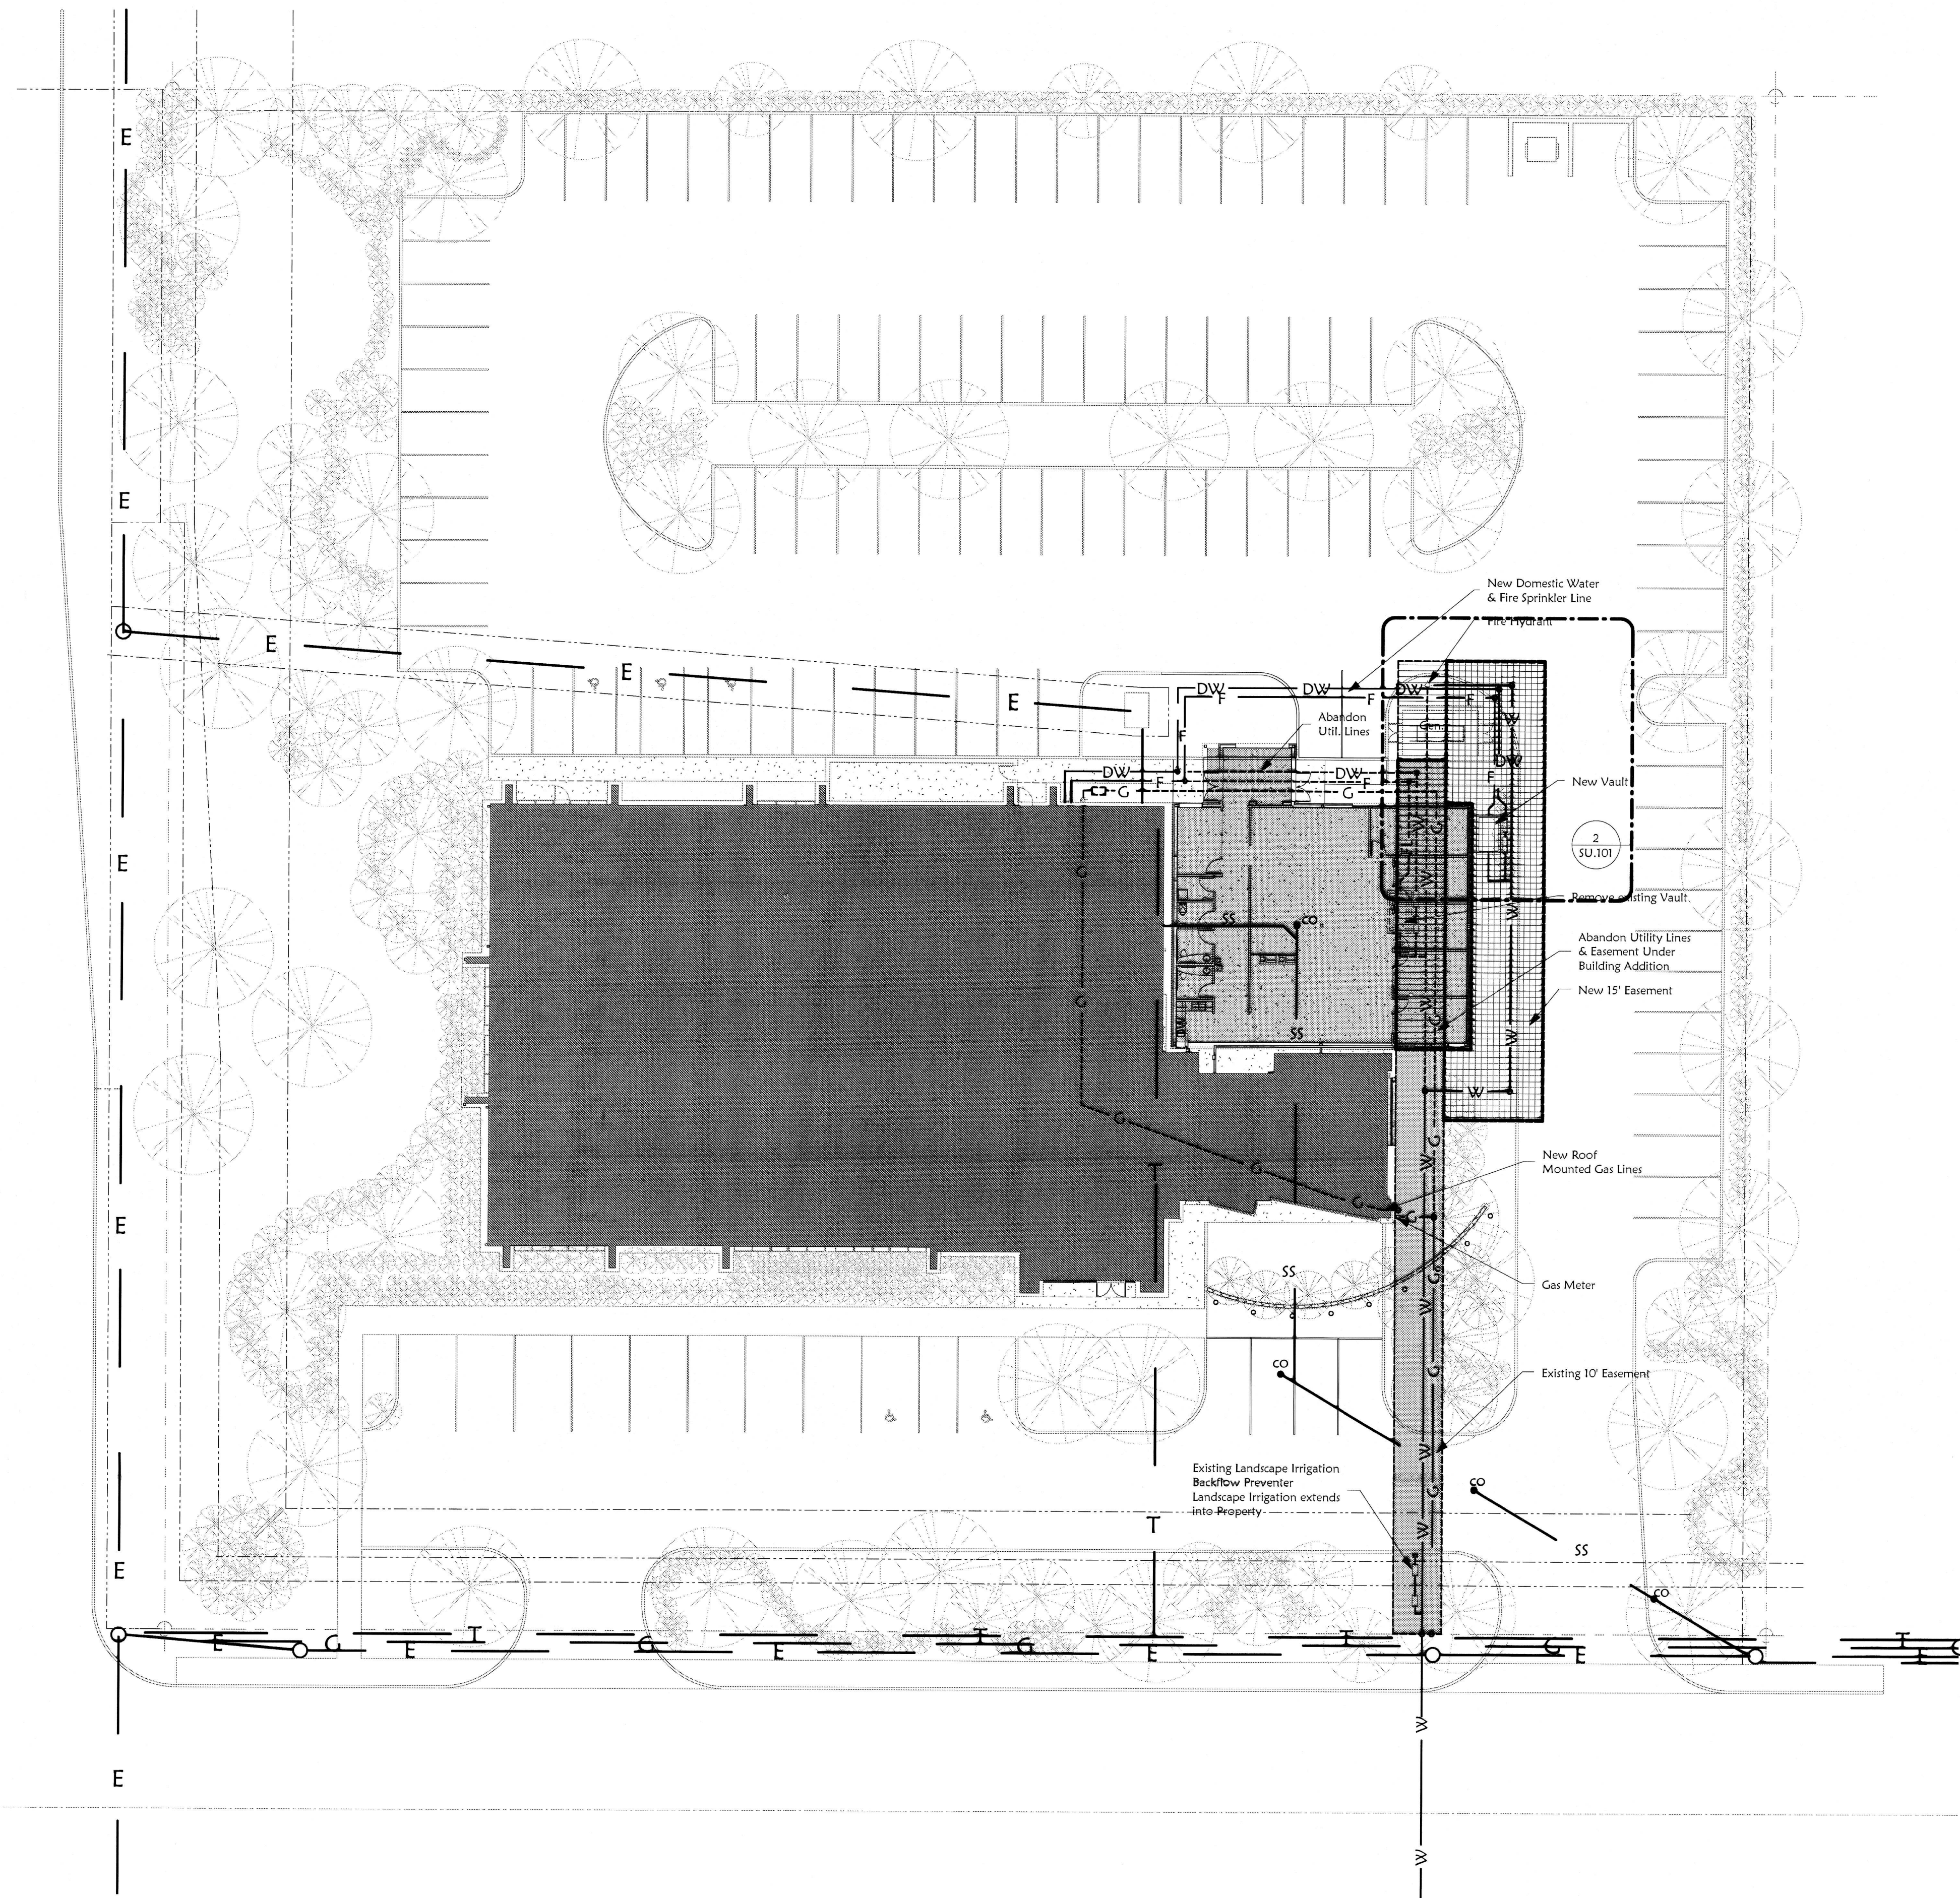


2 Enlarged Vault Detail
Scale: 1/8" = 1'-0"

1 Revised Site Utilities Plan
Scale: 1" = 20'-0"

APPROVED FOR CONSTRUCTION
Town of Addison
Infrastructure Operations And Services Department
APPROVED BY: *Richard Libre*
DATE: 7/3/17
16601 Westgrove Dr. Addison, TX 75001 (972)450-2871

All responsibility for the adequacy of these plans remains with the Engineer who prepared them. In approving these plans, the Town of Addison makes no representation of adequacy of the work of the Design Engineer.

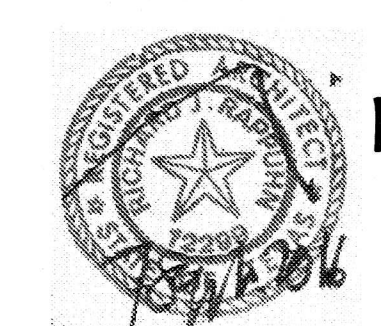

LIBRE.Ventures LLC
Architectural Services

2400 Louisiana Boulevard NE
Albuquerque, New Mexico 87110
tele no. 505.348.3513
richard@libre.ventures

SWRe/DAC Building Addition
15920 Addison Road
Addison, Texas 75001
Plan Review & Permit
7 Sept. 2016

Revised Site Utilities Plan

SU.101

COPYRIGHT NOTICE ALL RIGHTS RESERVED
These drawings and specifications shall remain the property of the ARCHITECT and shall not be used for any other projects without the written consent of the ARCHITECT. These documents are not to be reproduced, changed or copied in any form or manner whatsoever. Nor are they to be assigned to any third party without first obtaining the written permission and consent of the ARCHITECT.