




1 CONCRETE DETAIL @ DISPENSER ISLAND
SD4 NTS

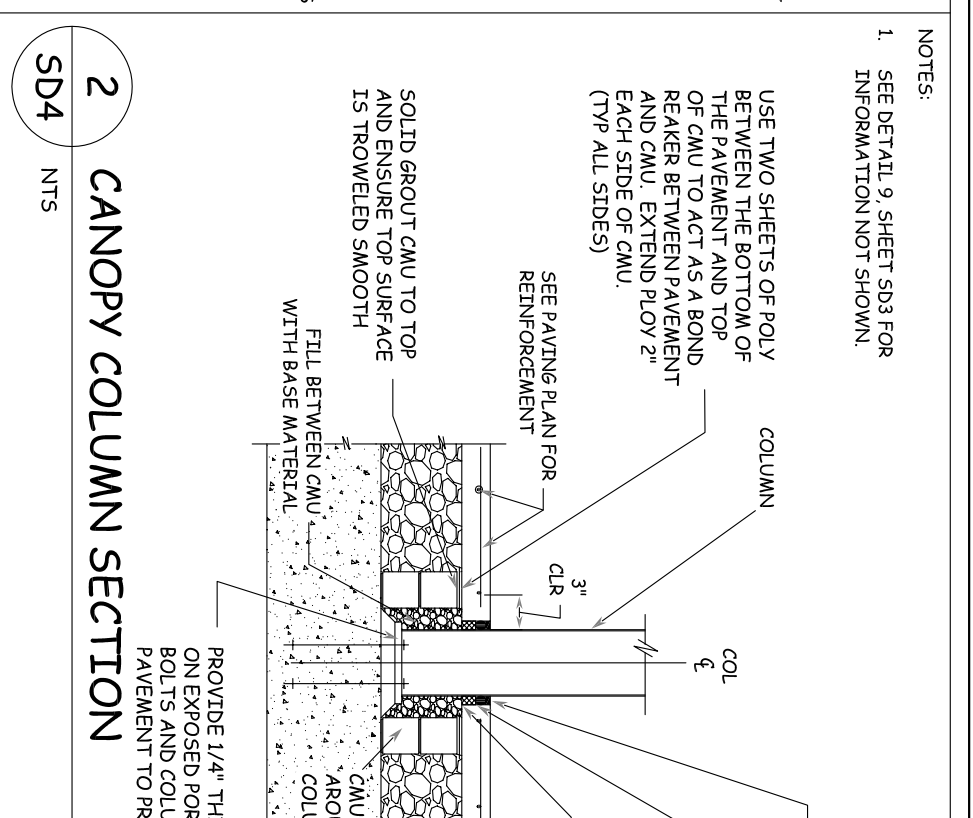


2 CANOPY COLUMN SECTION
SD4 NTS

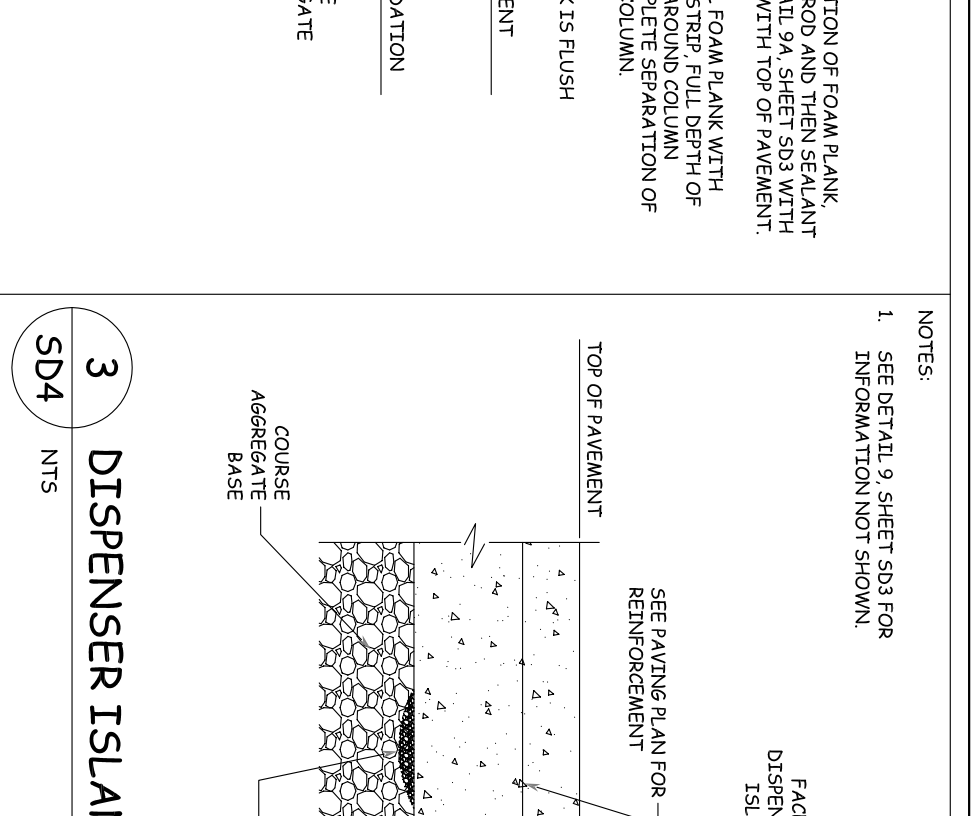


3 DISPENSER ISLAND SECTION
SD4 NTS

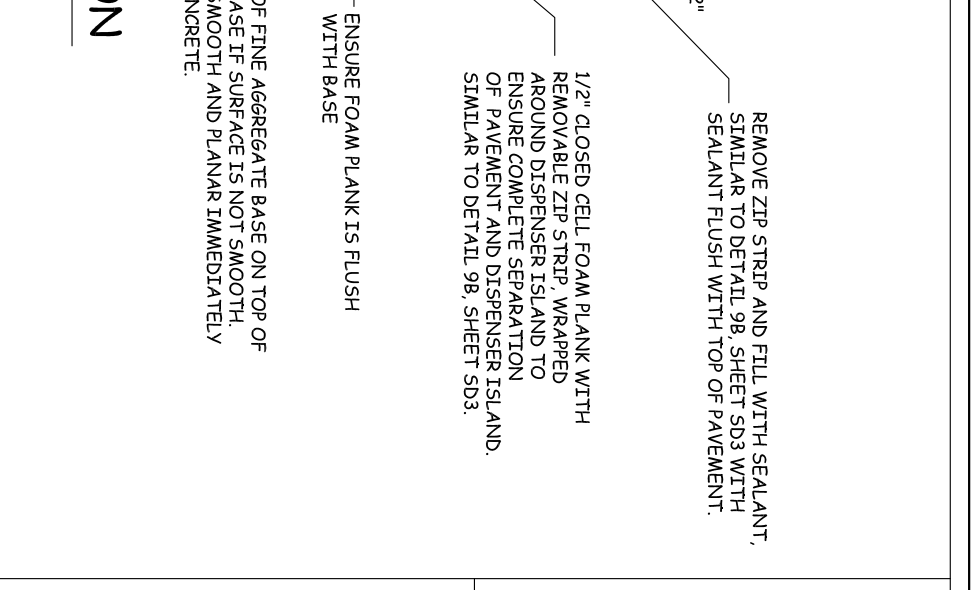


7 TANK MANHOLE PLAN
SD4 NTS

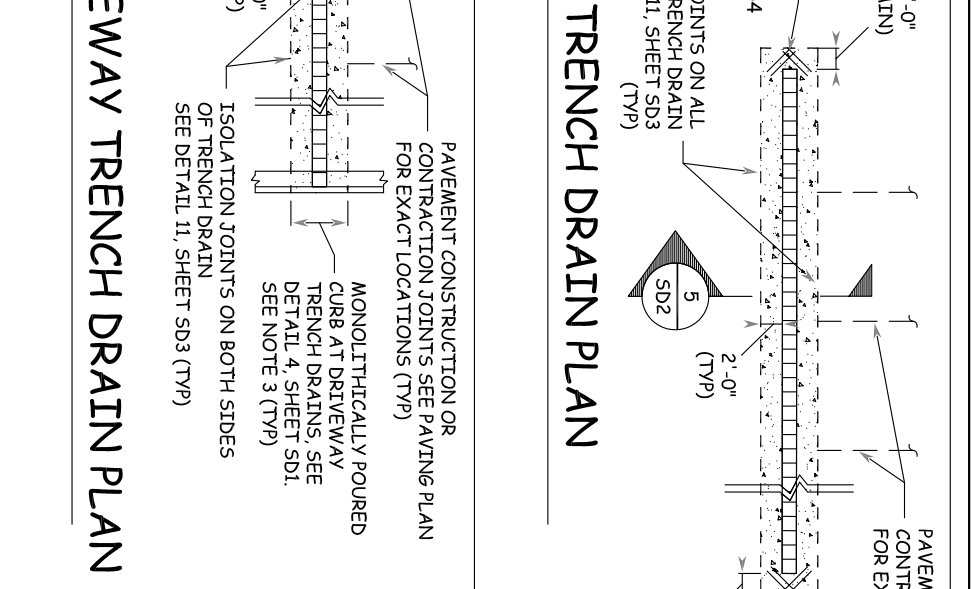


7A TANK MANHOLE SECTION
SD4 NTS

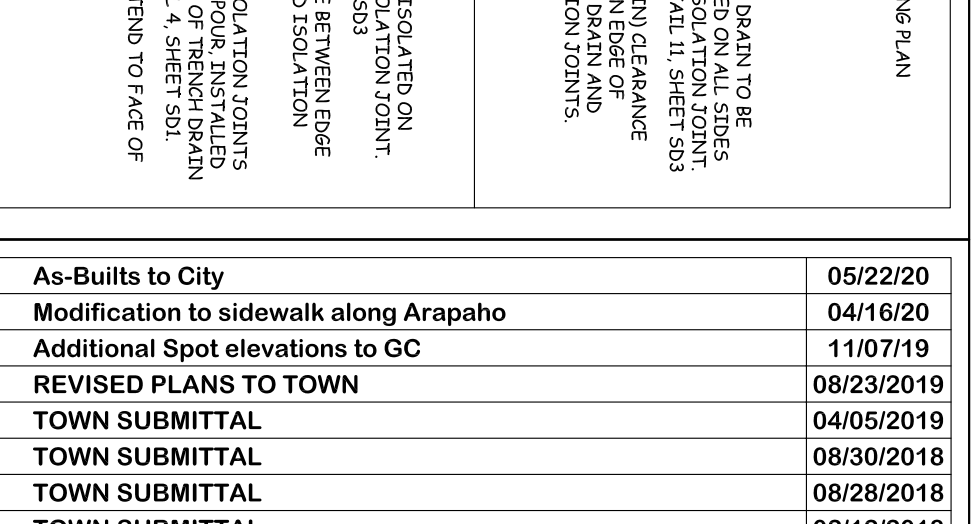


11 JOINT SPACING DETAIL PARTIAL PLAN (TYP)
SD4 NTS

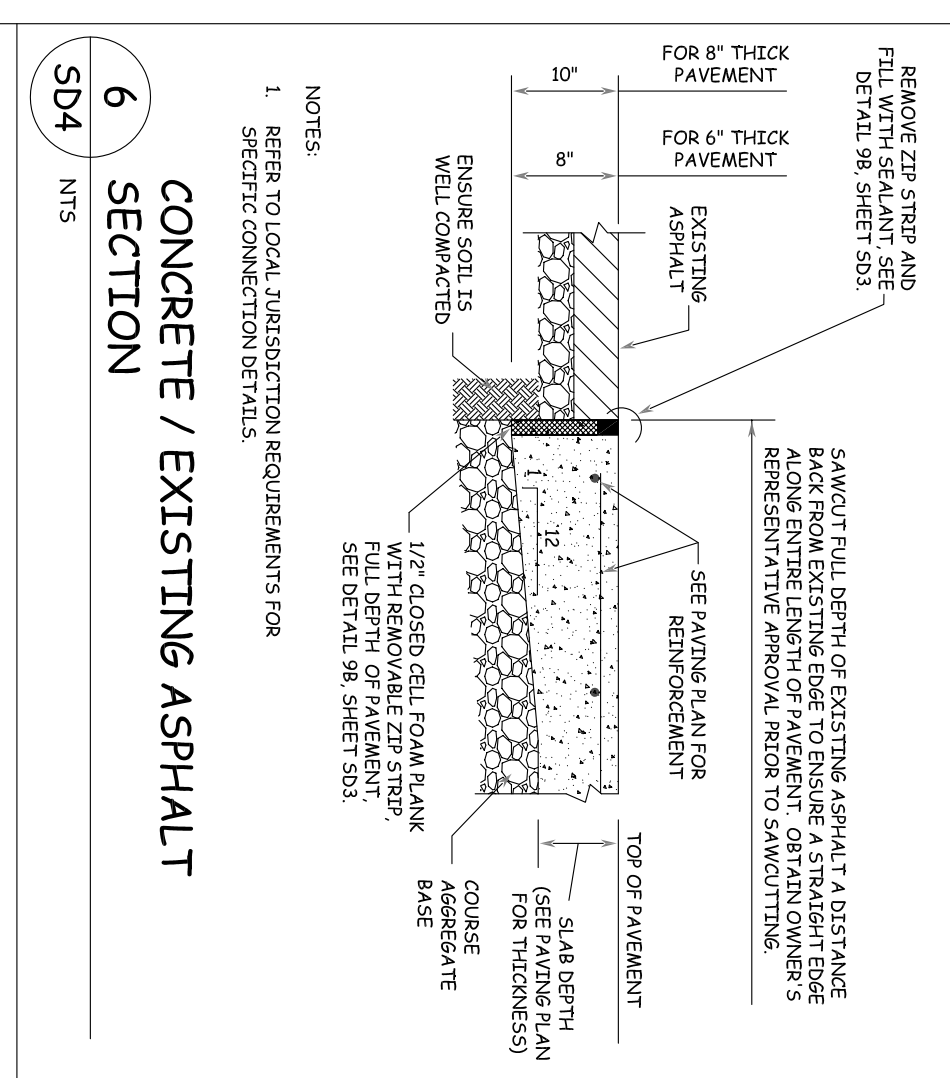


6 CONCRETE / EXISTING ASPHALT SECTION
SD4 NTS

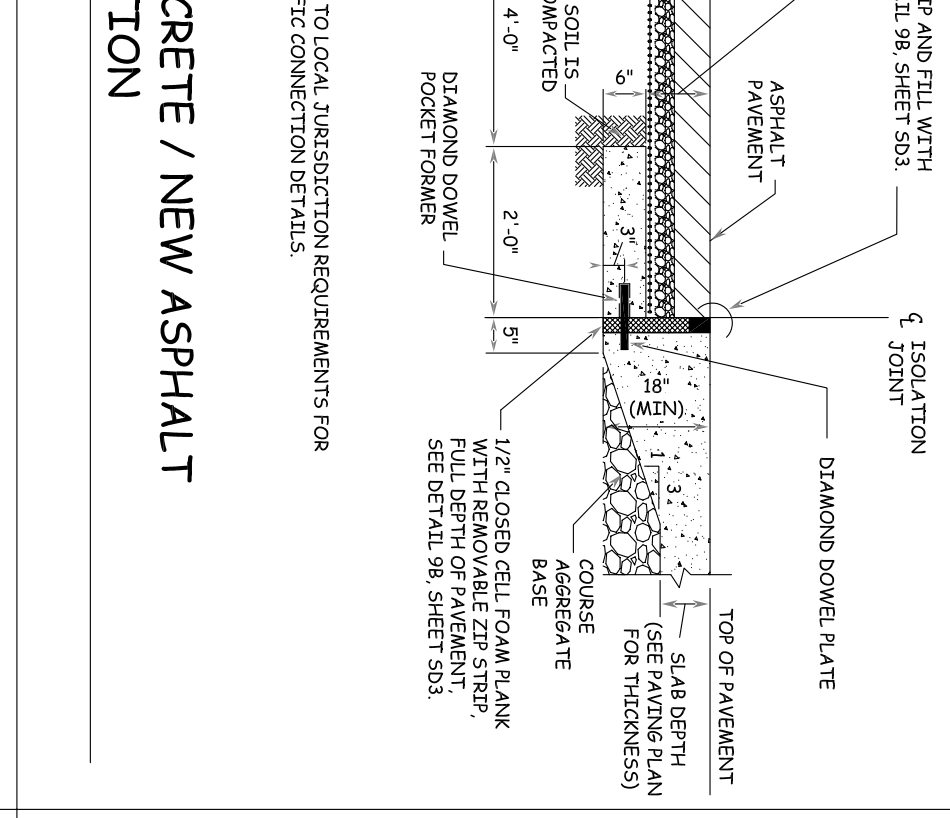


6A CONCRETE / NEW ASPHALT SECTION
SD4 NTS

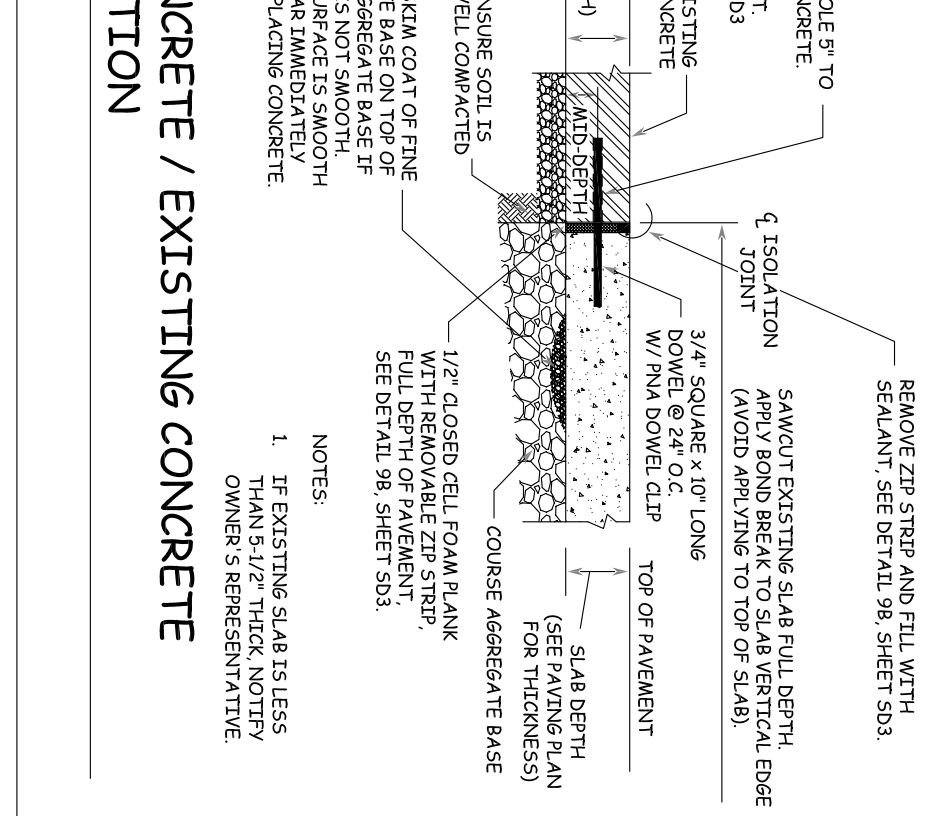


6B CONCRETE / EXISTING CONCRETE SECTION
SD4 NTS

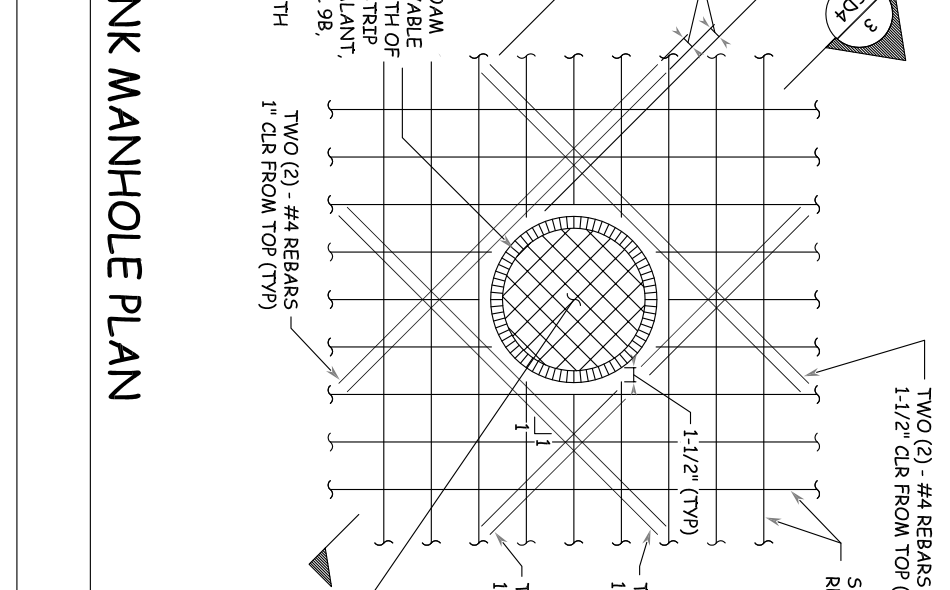


5B DRIVEWAY TRENCH DRAIN PLAN
SD4 NTS

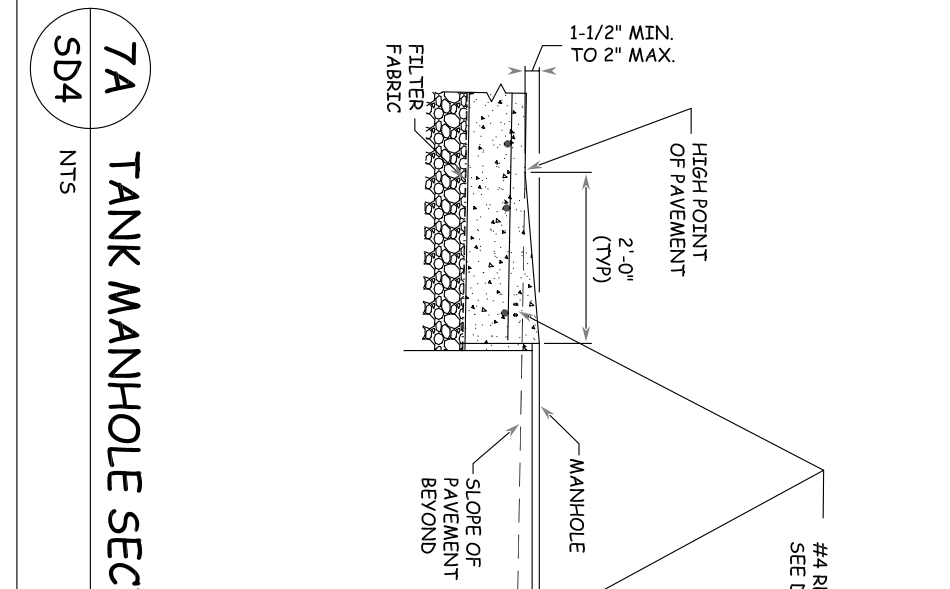


5A SITE TRENCH DRAIN PLAN
SD4 NTS

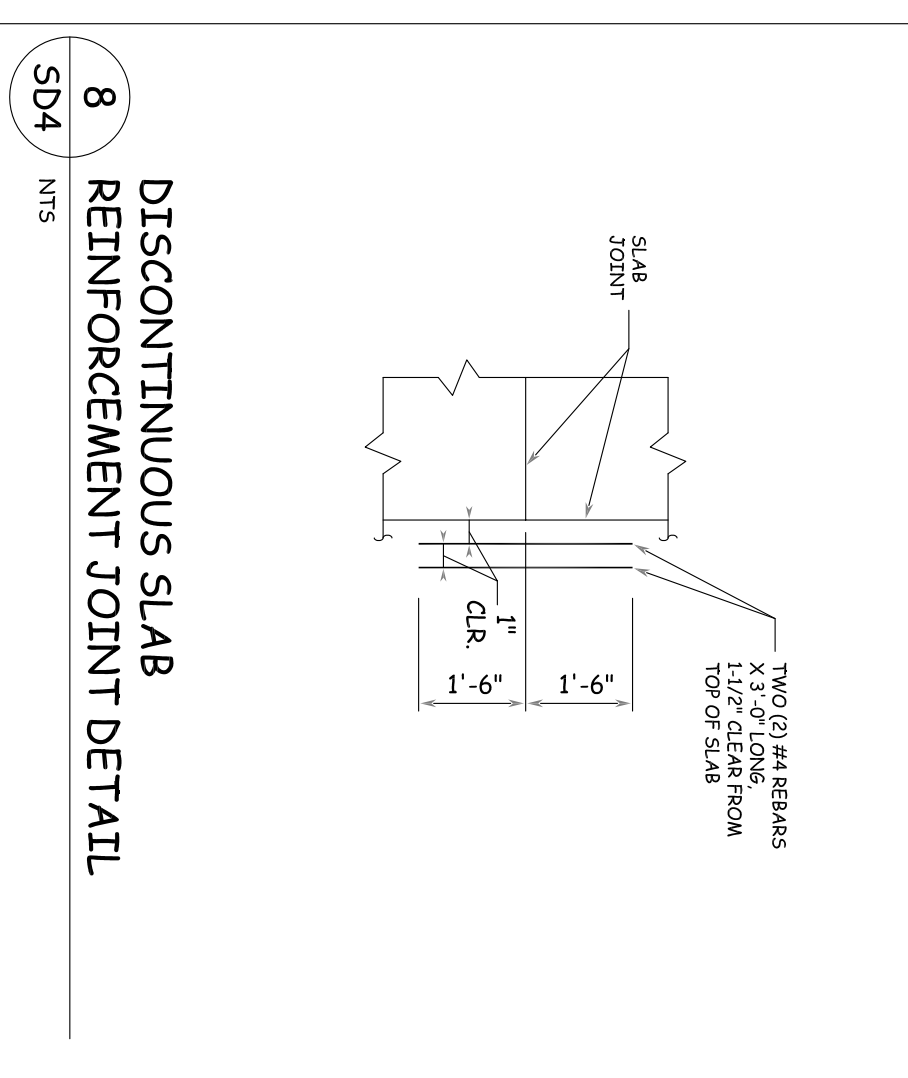


8 DISCONTINUOUS SLAB REINFORCEMENT JOINT DETAIL
SD4 NTS

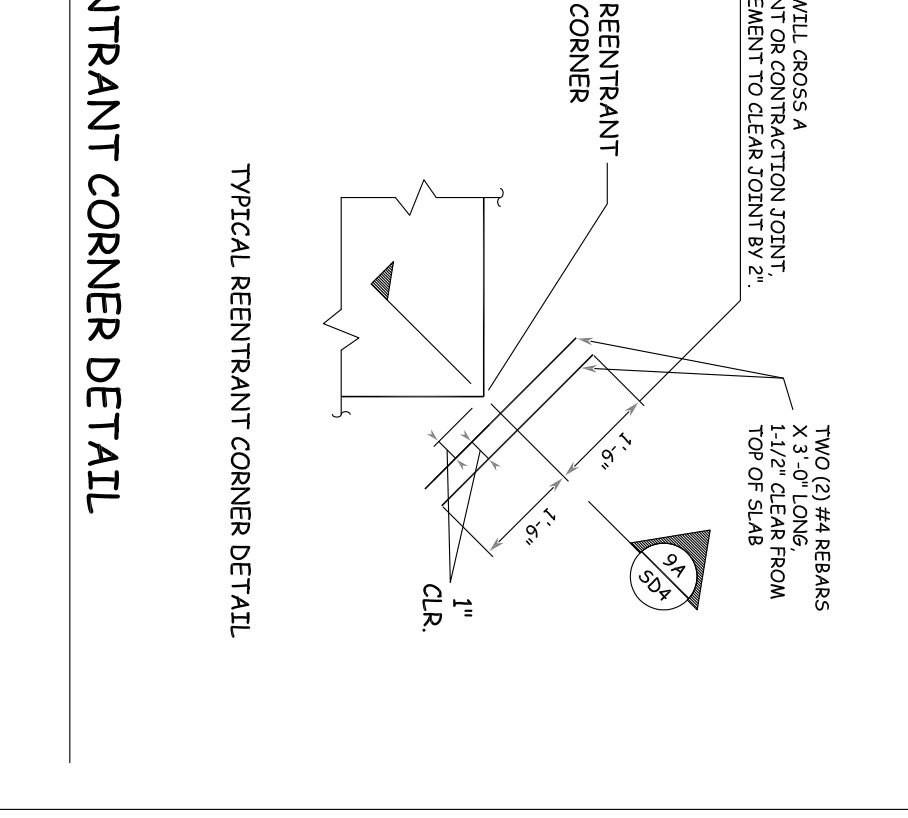


9 REENTRANT CORNER DETAIL
SD4 NTS

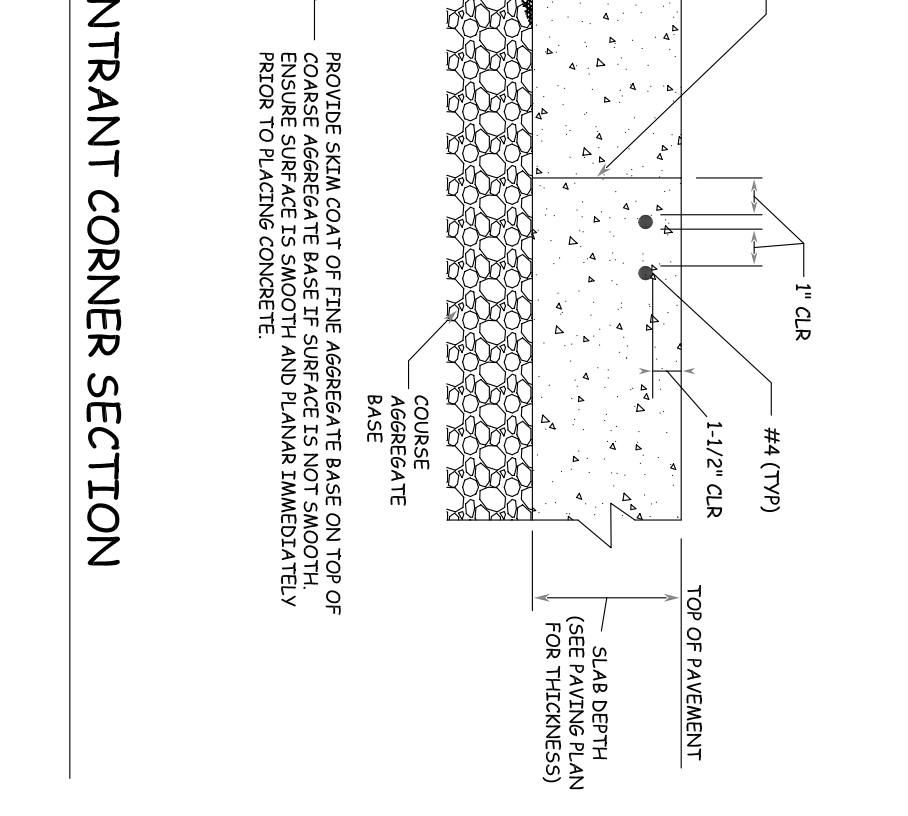


9A REENTRANT CORNER SECTION
SD4 NTS

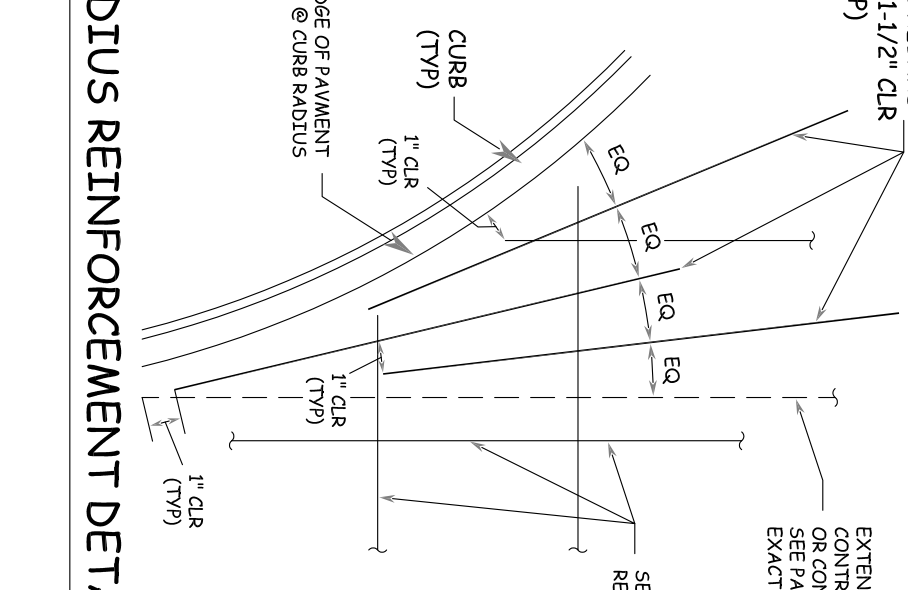


10 RADIUS REINFORCEMENT DETAIL
SD4 NTS

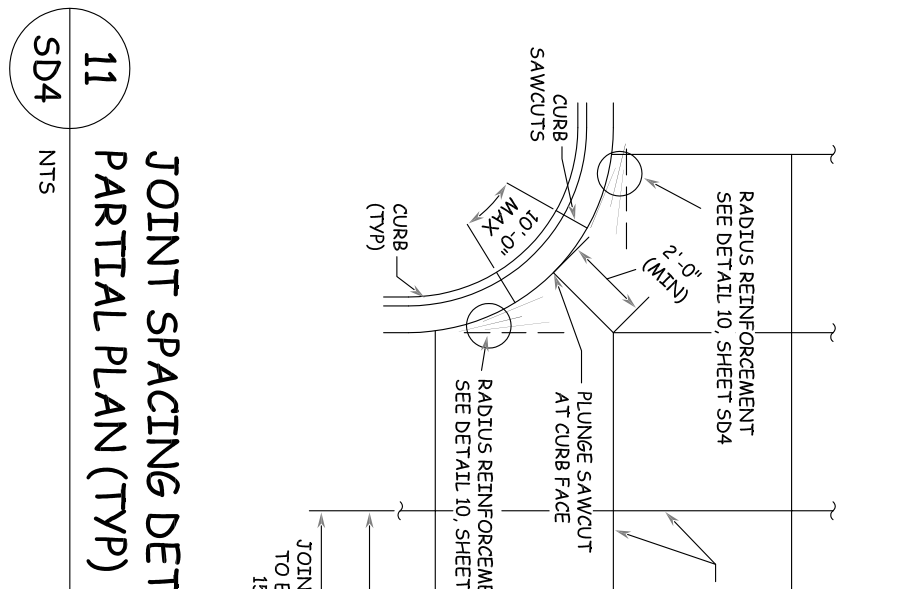


12B HANDICAP SIGNAGE DETAIL
SD4 NTS

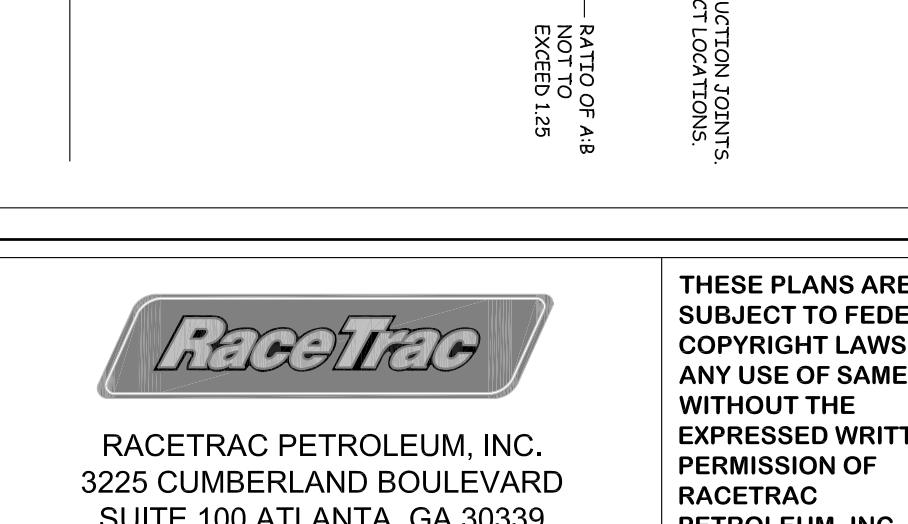


12 ISOLATION JOINT @ SIDEWALK PARTIAL PLAN
SD4 NTS

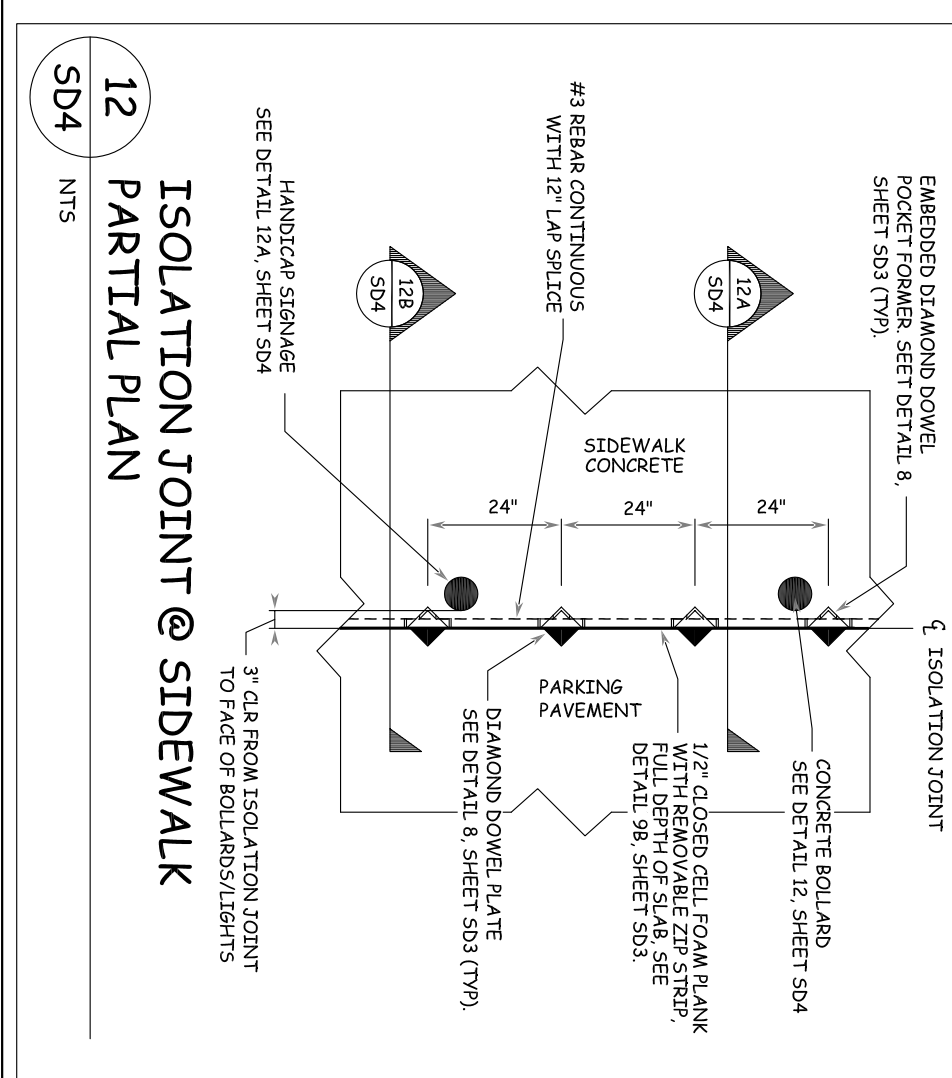


12A BOLLARD @ SIDEWALK SECTION
SD4 NTS

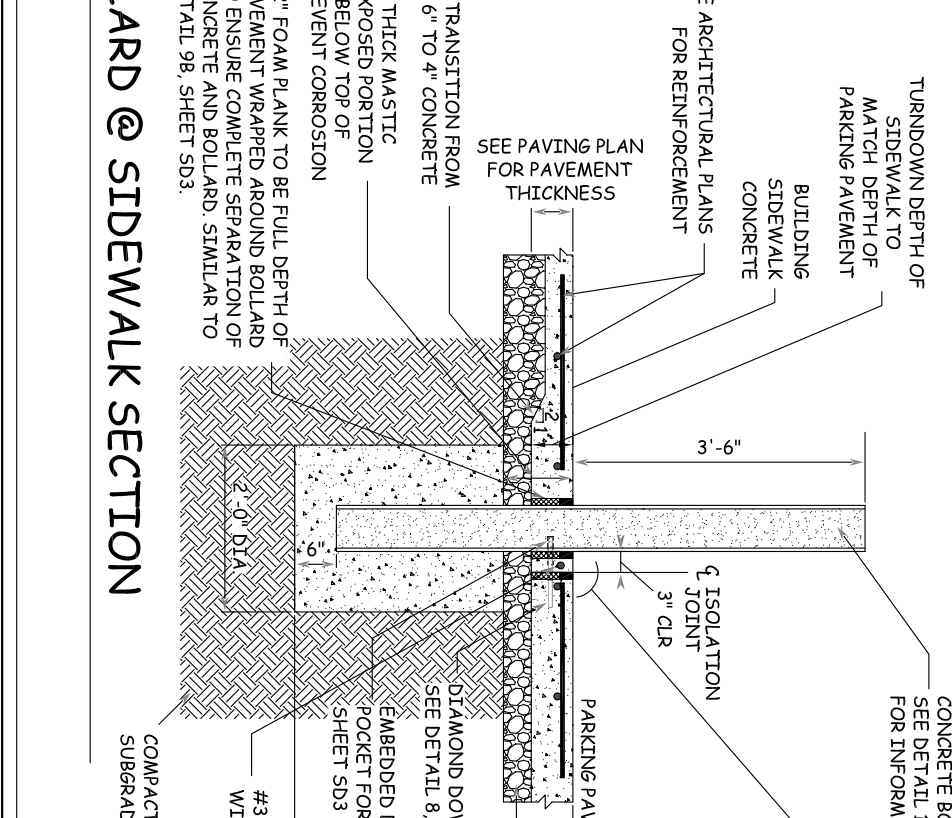

12B HANDICAP SIGNAGE DETAIL
SD4 NTS

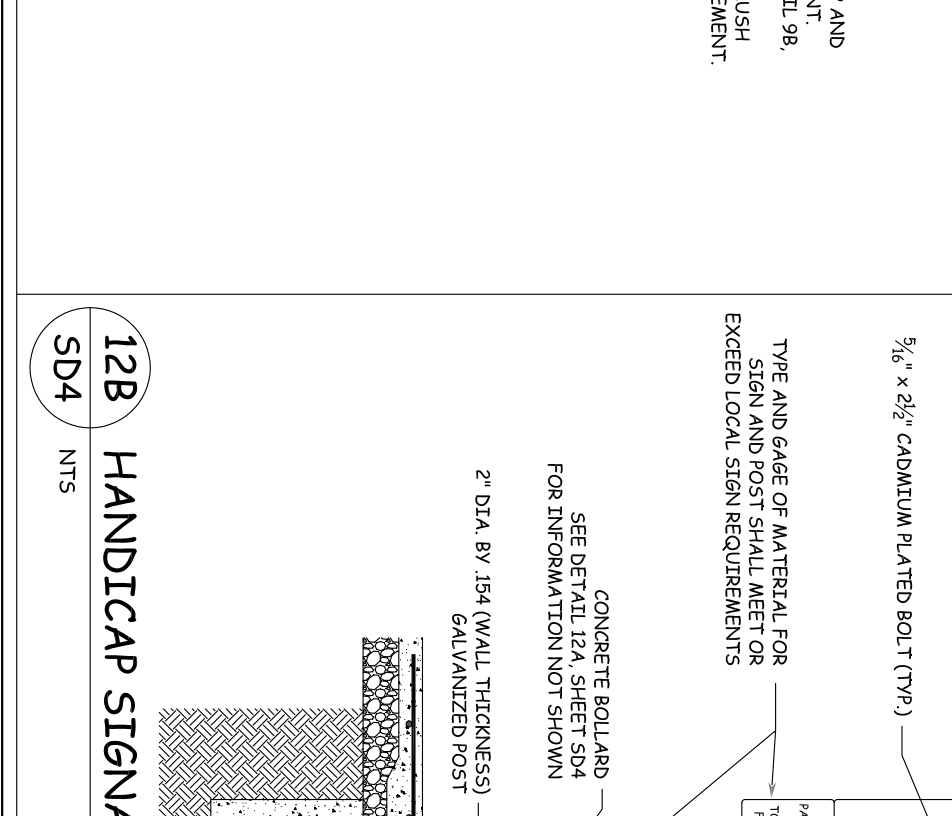

12B HANDICAP SIGNAGE DETAIL
SD4 NTS

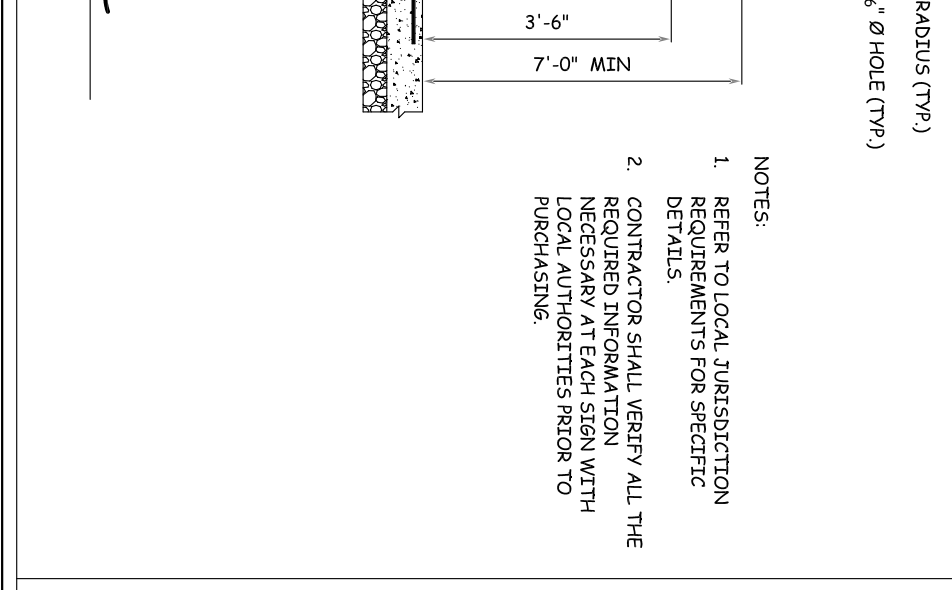

12 ISOLATION JOINT @ SIDEWALK PARTIAL PLAN
SD4 NTS



12B HANDICAP SIGNAGE DETAIL
SD4 NTS



12B HANDICAP SIGNAGE DETAIL
SD4 NTS

NO.	1	2	3	4	5	6	7	8	
REVISION	CONSTRUCTION, CONTRACTOR OR ISOLATION JOINT. SEE DETAILS 9, 10 OR 11. SHEET 503 FOR INFORMATION NOT SHOWN.	USE TWO SHEETS OF ROUV FOR THE PAVEMENT AND TOP OF CMU TO ACT AS A BOND. EACH SIDE OF CMU (TYP. ALL SIDES).	REMOVE TOP PORTION OF FOAM PLANK SIMILAR TO DETAIL 9A. SHEET 503 WITH SEALANT FLUSH WITH TOP OF PAVEMENT.	REMOVE ZEP STRIP AND FILL WITH SEALANT. SEE DETAIL 9B. SHEET 503.	REMOVE ZEP STRIP AND FILL WITH SEALANT. SEE DETAIL 9B. SHEET 503.	REMOVE ZEP STRIP AND FILL WITH SEALANT. SEE DETAIL 9B. SHEET 503.	REMOVE ZEP STRIP AND FILL WITH SEALANT. SEE DETAIL 9B. SHEET 503.	REMOVE ZEP STRIP AND FILL WITH SEALANT. SEE DETAIL 9B. SHEET 503.	REMOVE ZEP STRIP AND FILL WITH SEALANT. SEE DETAIL 9B. SHEET 503.

NO.	1	2	3	4	5	6	7	8	
REVISION	REMOVE ZEP STRIP AND FILL WITH SEALANT. SEE DETAIL 9B. SHEET 503.	REMOVE ZEP STRIP AND FILL WITH SEALANT. SEE DETAIL 9B. SHEET 503.	REMOVE ZEP STRIP AND FILL WITH SEALANT. SEE DETAIL 9B. SHEET 503.	REMOVE ZEP STRIP AND FILL WITH SEALANT. SEE DETAIL 9B. SHEET 503.	REMOVE ZEP STRIP AND FILL WITH SEALANT. SEE DETAIL 9B. SHEET 503.	REMOVE ZEP STRIP AND FILL WITH SEALANT. SEE DETAIL 9B. SHEET 503.	REMOVE ZEP STRIP AND FILL WITH SEALANT. SEE DETAIL 9B. SHEET 503.	REMOVE ZEP STRIP AND FILL WITH SEALANT. SEE DETAIL 9B. SHEET 503.	REMOVE ZEP STRIP AND FILL WITH SEALANT. SEE DETAIL 9B. SHEET 503.

NO.	1	2	3	4	5	6	7	8	
REVISION	REMOVE ZEP STRIP AND FILL WITH SEALANT. SEE DETAIL 9B. SHEET 503.	REMOVE ZEP STRIP AND FILL WITH SEALANT. SEE DETAIL 9B. SHEET 503.	REMOVE ZEP STRIP AND FILL WITH SEALANT. SEE DETAIL 9B. SHEET 503.	REMOVE ZEP STRIP AND FILL WITH SEALANT. SEE DETAIL 9B. SHEET 503.	REMOVE ZEP STRIP AND FILL WITH SEALANT. SEE DETAIL 9B. SHEET 503.	REMOVE ZEP STRIP AND FILL WITH SEALANT. SEE DETAIL 9B. SHEET 503.	REMOVE ZEP STRIP AND FILL WITH SEALANT. SEE DETAIL 9B. SHEET 503.	REMOVE ZEP STRIP AND FILL WITH SEALANT. SEE DETAIL 9B. SHEET 503.	REMOVE ZEP STRIP AND FILL WITH SEALANT. SEE DETAIL 9B. SHEET 503.

RACETRAC
Beltline/Marsh Business Park
Lot 2, Block 1
3.133 Ac. - Zoned: Light Retail
Addison, Texas

RaceTrac
RACETRAC PETROLEUM, INC.
3225 CUMBERLAND BOULEVARD
SUITE 100 ATLANTA, GA 30339
(770) 431-7600

THESE PLANS ARE SUBJECT TO FEDERAL COPYRIGHT LAWS: ANY USE OF SAME WITHOUT THE EXPRESSED WRITTEN PERMISSION OF RACETRAC PETROLEUM, INC. IS PROHIBITED.

JONES CARTER
Texas Board of Professional Engineers Registration No. F-439
4866 Mercedita Plaza Drive, Suite 210 • Fort Worth, TX 76137 • 817.388.2200

TRANS J. BOUSQUET
86084
05/22/20

DATE	May 22, '20
SCALE	1"=3'-0"
DRAWING BY	TJB
DRAWING NAME	
SHEET NO.	SD4
VERSION	-

NO.	1	2	3	4	5	6	7	8
REVISION	TOWN SUBMITTAL	TOWN SUBMITTAL	TOWN SUBMITTAL	TOWN SUBMITTAL	REVISED PLANS TO TOWN	Additional Spot elevations to GC	Modification to sidewalk along Arapaho	As-Builts to City
DATE	02/12/2018	08/28/2018	08/30/2018	04/05/2019	08/23/2019	11/07/19	04/18/20	05/22/20