




1 DECORATIVE PAVEMENT SECTION DETAIL  
SD5 NTS

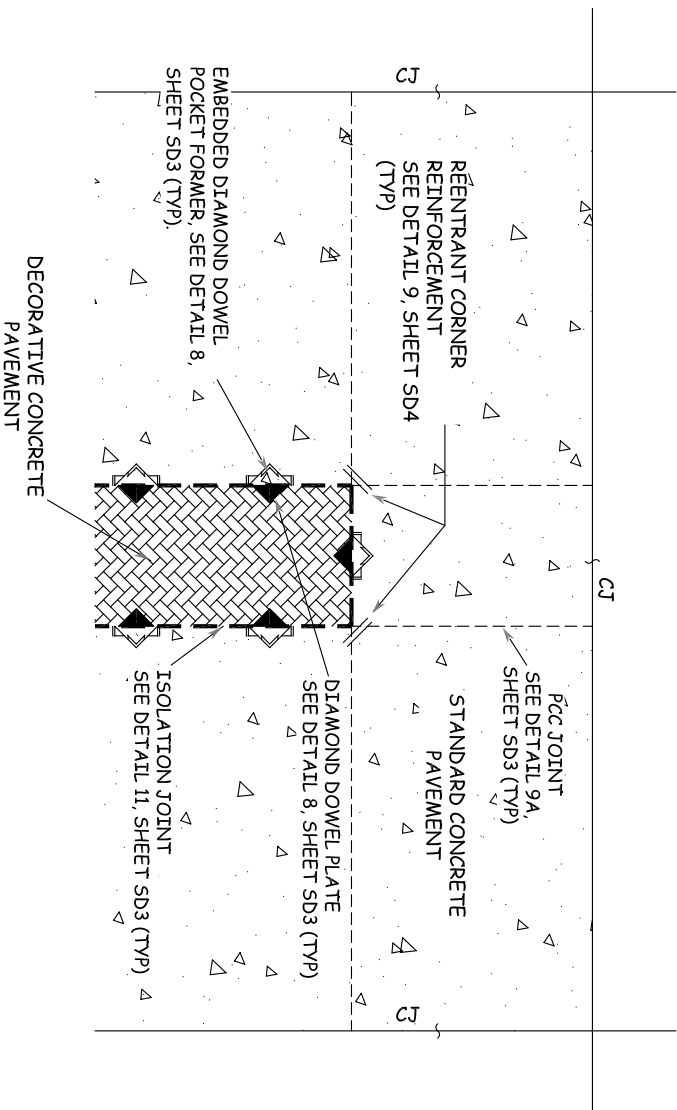


2 DECORATIVE PAVEMENT PARTIAL PLAN  
SD5 NTS

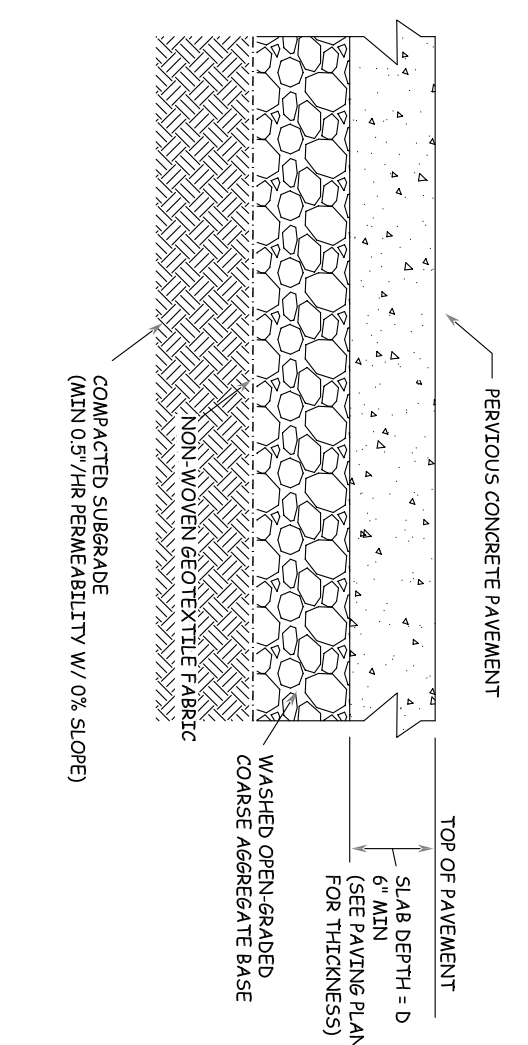


3 PERVIOUS CONCRETE DETAIL  
SD5 NTS

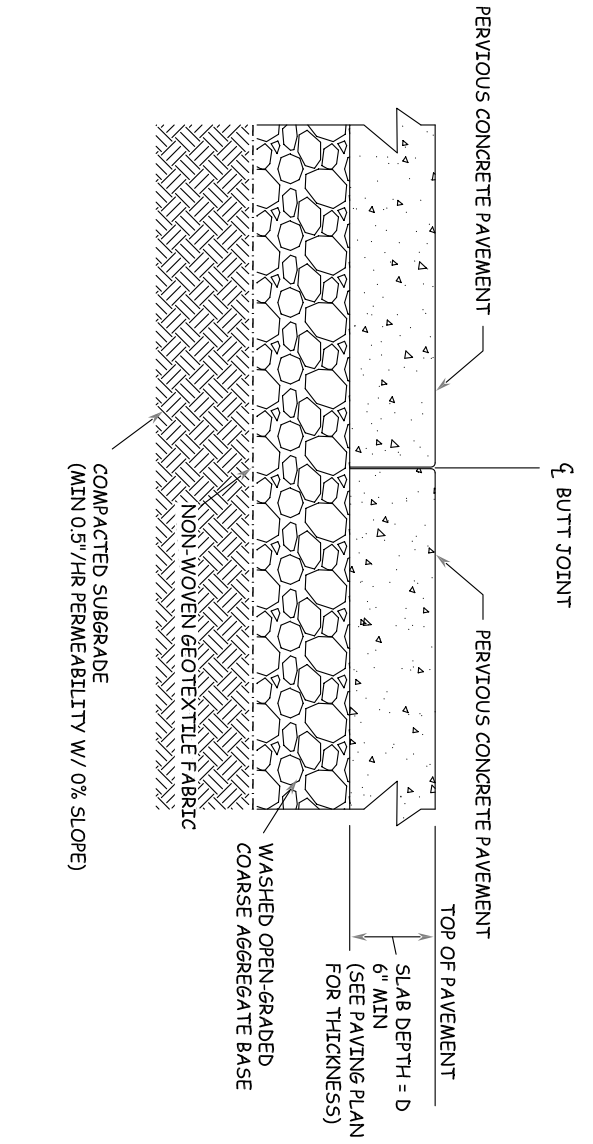

4 PERVIOUS CONCRETE - BUTT JOINT DETAIL  
SD5 NTS

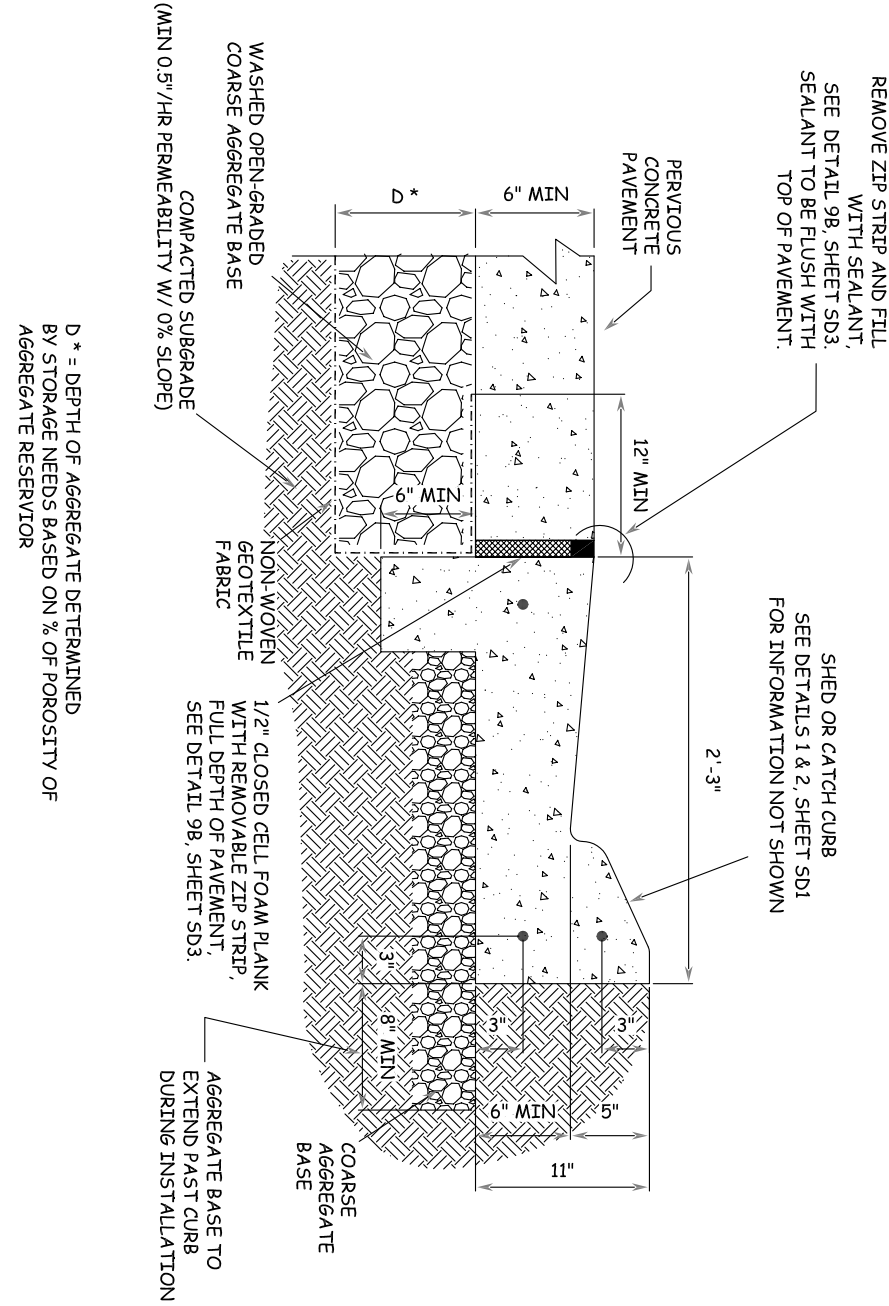

5 PERVIOUS CONCRETE @ CURB DETAIL  
SD5 NTS

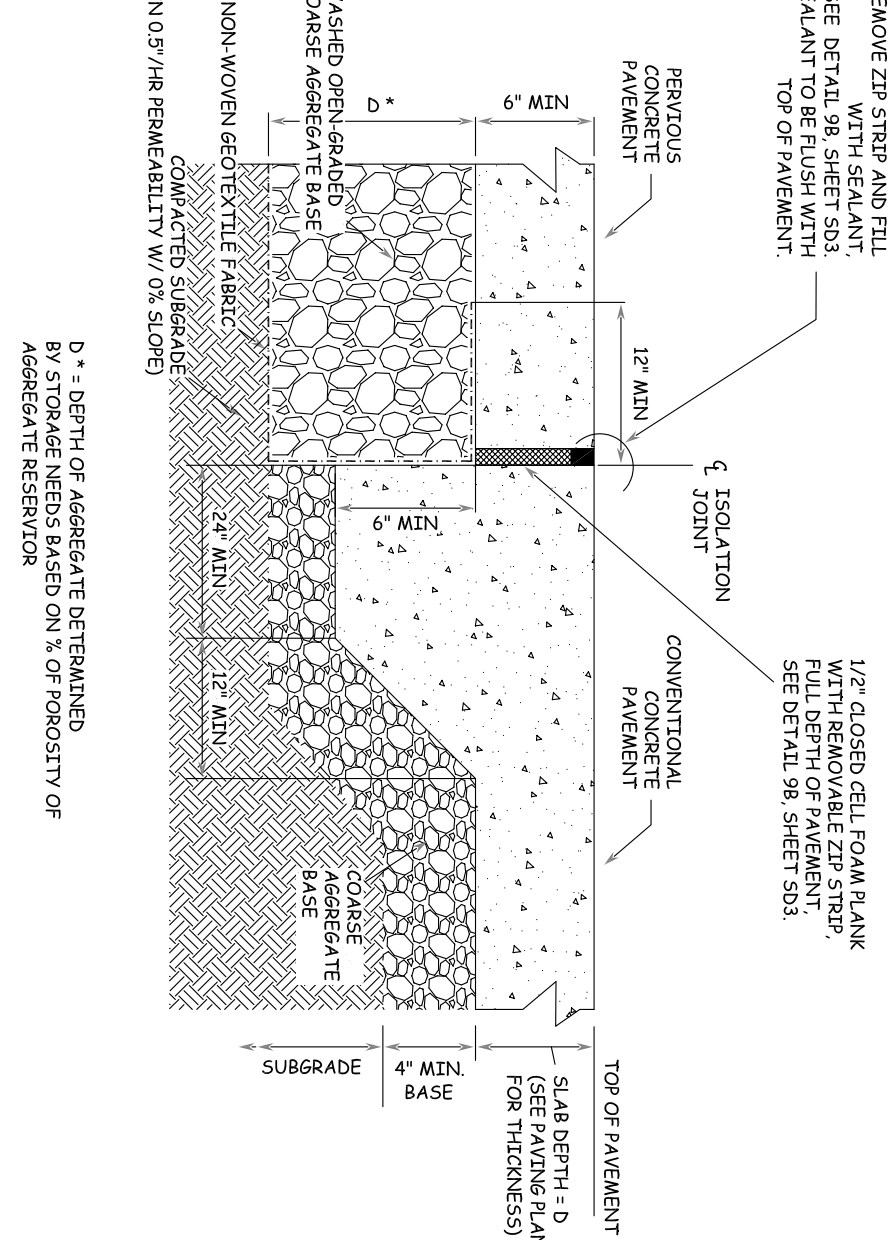

6 PERVIOUS CONCRETE / CONVENTIONAL CONCRETE DETAIL  
SD5 NTS

NOTE TO CIVIL ENGINEERING COMPANY  
FOR DETAILS 5 & 6, SHEET SD5, ENGINEER TO DETERMINE DEPTH OF AGGREGATE BASE PER NOTE "D".

AS-BUILTS

Travis J. Bousquet, PE  
Date

SD5  
SHEET NO. VERSION

DETAIL SHEET 5 (PRIVATE)  
**RACETRAC**  
Beltline/Marsh Business Park  
Lot 2, Block 1  
3.133 Ac. - Zoned: Light Retail  
Addison, Texas

**RaceTrac**  
RACETRAC PETROLEUM, INC.  
3225 CUMBERLAND BOULEVARD  
SUITE 100 ATLANTA, GA 30339  
(770) 431-7600

THESE PLANS ARE SUBJECT TO FEDERAL COPYRIGHT LAWS: ANY USE OF SAME WITHOUT THE EXPRESSED WRITTEN PERMISSION OF RACETRAC PETROLEUM, INC. IS PROHIBITED.

STATE OF TEXAS  
TRAVIS J. BOUSQUET  
86084  
Professional Engineer Seal

**JONES CARTER**  
Texas Board of Professional Engineers Registration No. F-439  
4808 Mercedita Plaza Drive, Suite 200 • Fort Worth, TX 76137 • 817.358.2200

NO.	DESCRIPTION	DATE
8	As-Builts to City	05/22/20
7	Modification to sidewalk along Arapaho	04/16/20
6	Additional Spot elevations to GC	11/07/19
5	REVISED PLANS TO TOWN	08/23/2019
4	TOWN SUBMITTAL	04/05/2019
3	TOWN SUBMITTAL	08/30/2018
2	TOWN SUBMITTAL	08/28/2018
1	TOWN SUBMITTAL	02/12/2018