

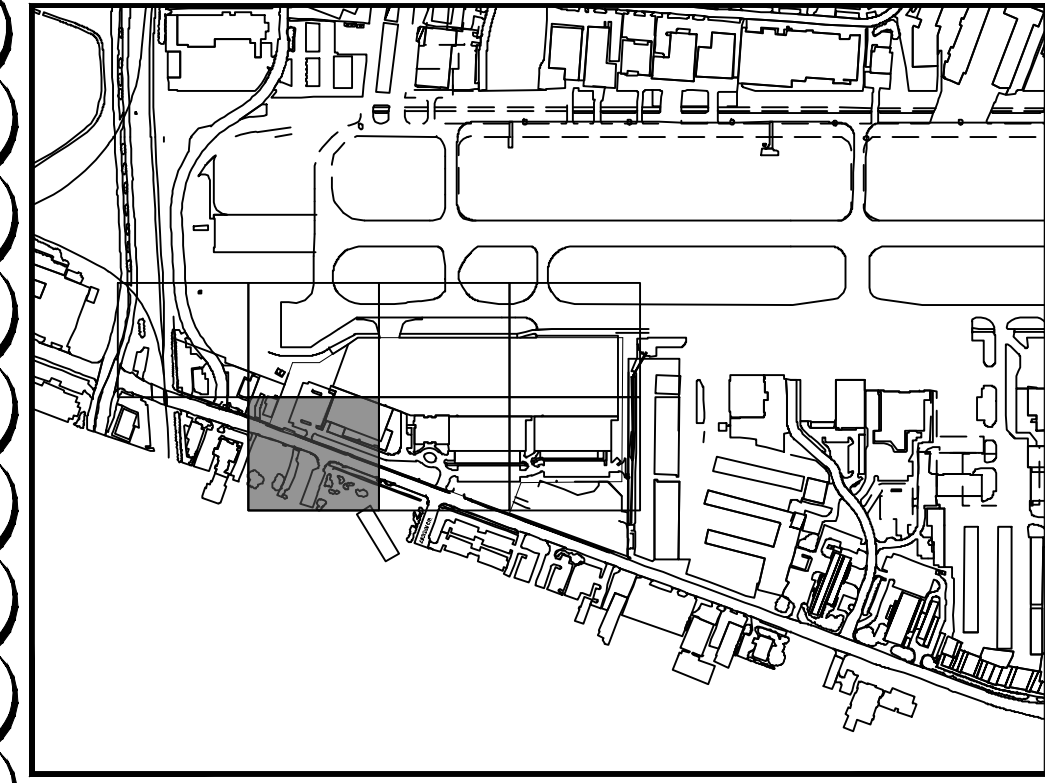


Plotted By: Acevedo, Eleth Sheet Set: Kha Layout: C10.05 April 15, 2020 08:52:59am C:\SubDrives\KDrive\067792503 - Addison Galaxy FBO\ACAD\Draw\Sheets\C10.05 GRADING PLAN.dwg  
 This document, together with the concepts and designs presented herein, is an instrument of service, as an instrument of service, and shall be without liability to Kimley-Horn and Associates, Inc.

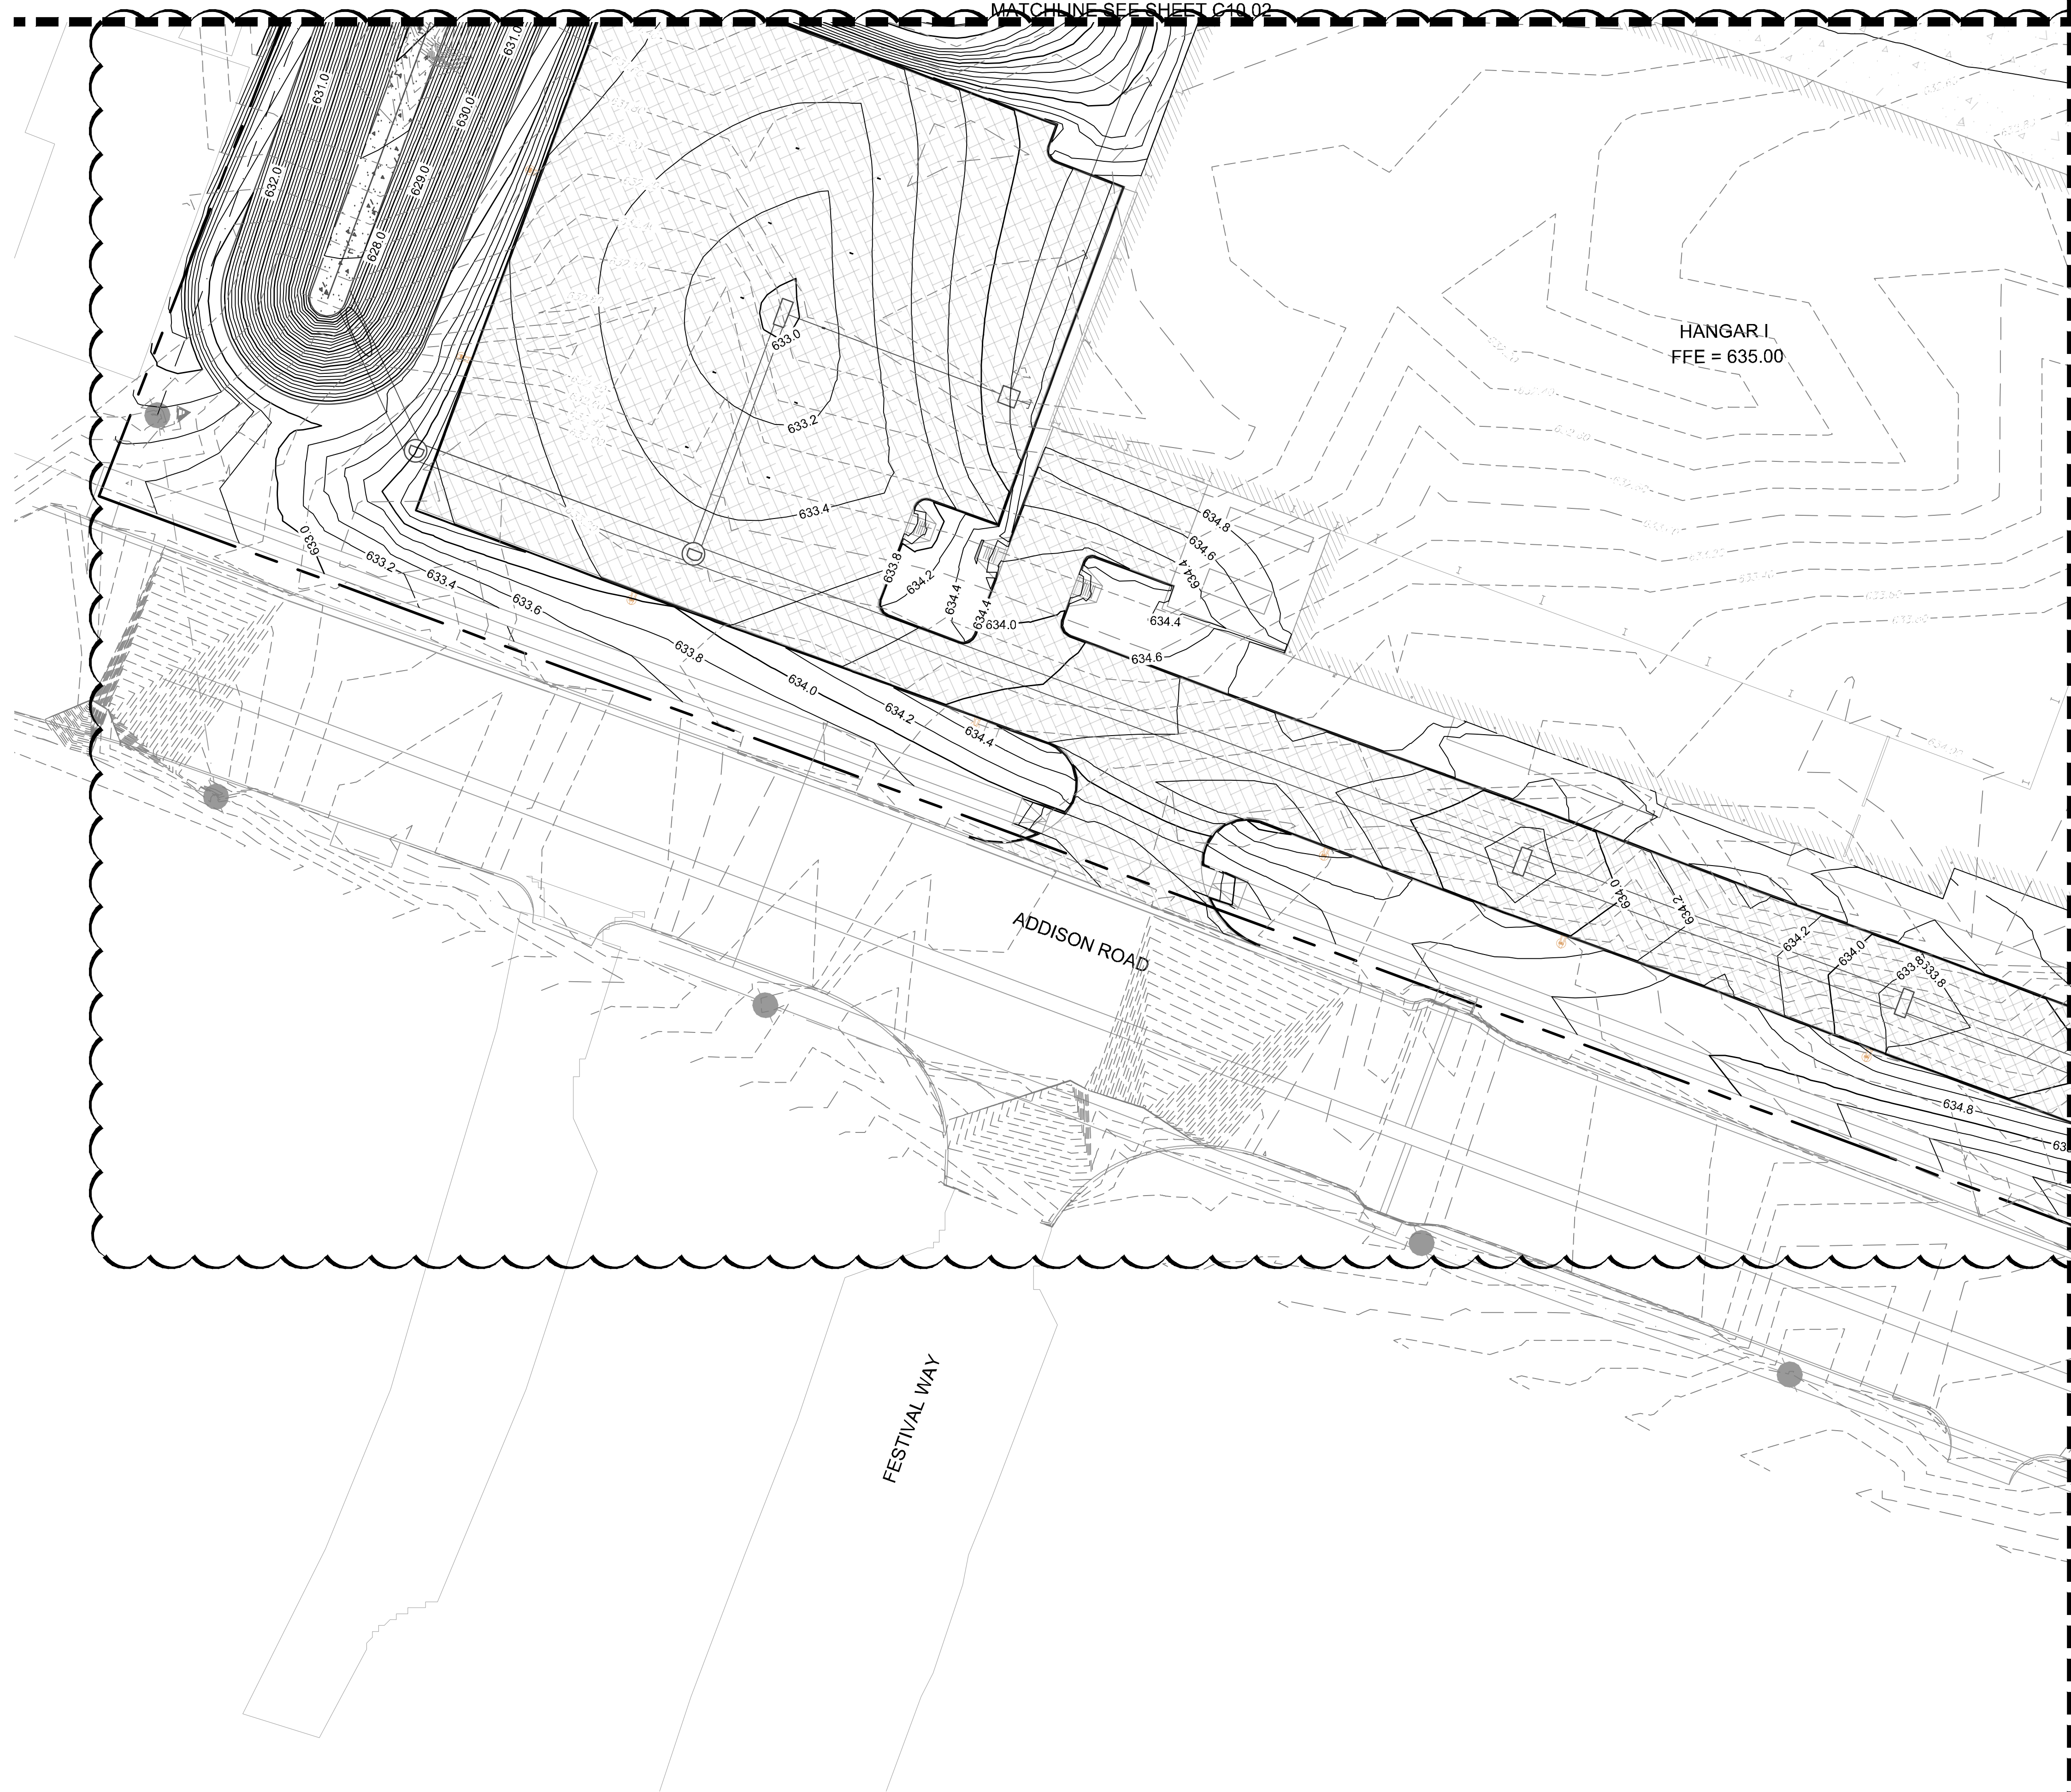


KEY PLAN

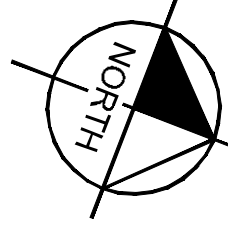

LEGEND

- EXISTING CONTOURS
- PROPOSED CONTOURS
- TRENCH DRAIN
- DRAINAGE INLET
- DRAINAGE MANHOLE

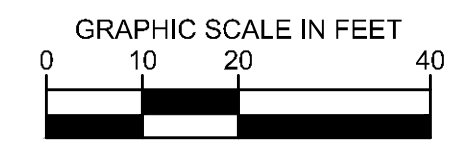

© 2019 KIMLEY-HORN AND ASSOCIATES, INC. 1400 WOODLICK FOREST DRIVE, SUITE 225 HOUSTON, TEXAS 77057 PHONE: 281-475-2816 TBPE FIRM REGISTRATION F-928 WWW.KIMLEY-HORN.COM	
04/15/20	
KHA PROJECT 067792503	DATE 2/21/2020
SCALE AS SHOWN	
DESIGNED BY HCV	
DRAWN BY EC EAC	
CHECKED BY HCV	
<b>GRADING PLAN</b>	
ADDISON GALAXY FBO 15601 ADDISON RD. PREPARED FOR BLACK FOREST VENTURE	
DALLAS, TEXAS	
SHEET NUMBER <b>C10.05</b>	
ADDISON	REVISIONS No. DATE BY