




Plotted By: Acevedo, Elsie - Sheet: Set: K10 - Layout: C10.07 - April 15, 2020 08:54:31am - C:\SubDrives\KDrive\067792503 - Addison_Galaxy_FBO\ACAD\Draws\067792503 - GRADING PLAN.dwg
 This document, together with the concepts and designs presented herein, is an instrument of service, as an instrument of service, and is intended only for the specific purpose and client for which it was prepared. Reuse of any information contained herein without the written authorization and approval of Kimley-Horn and Associates, Inc. shall be without liability to Kimley-Horn and Associates, Inc.

MATCHLINE SEE SHEET C10.06


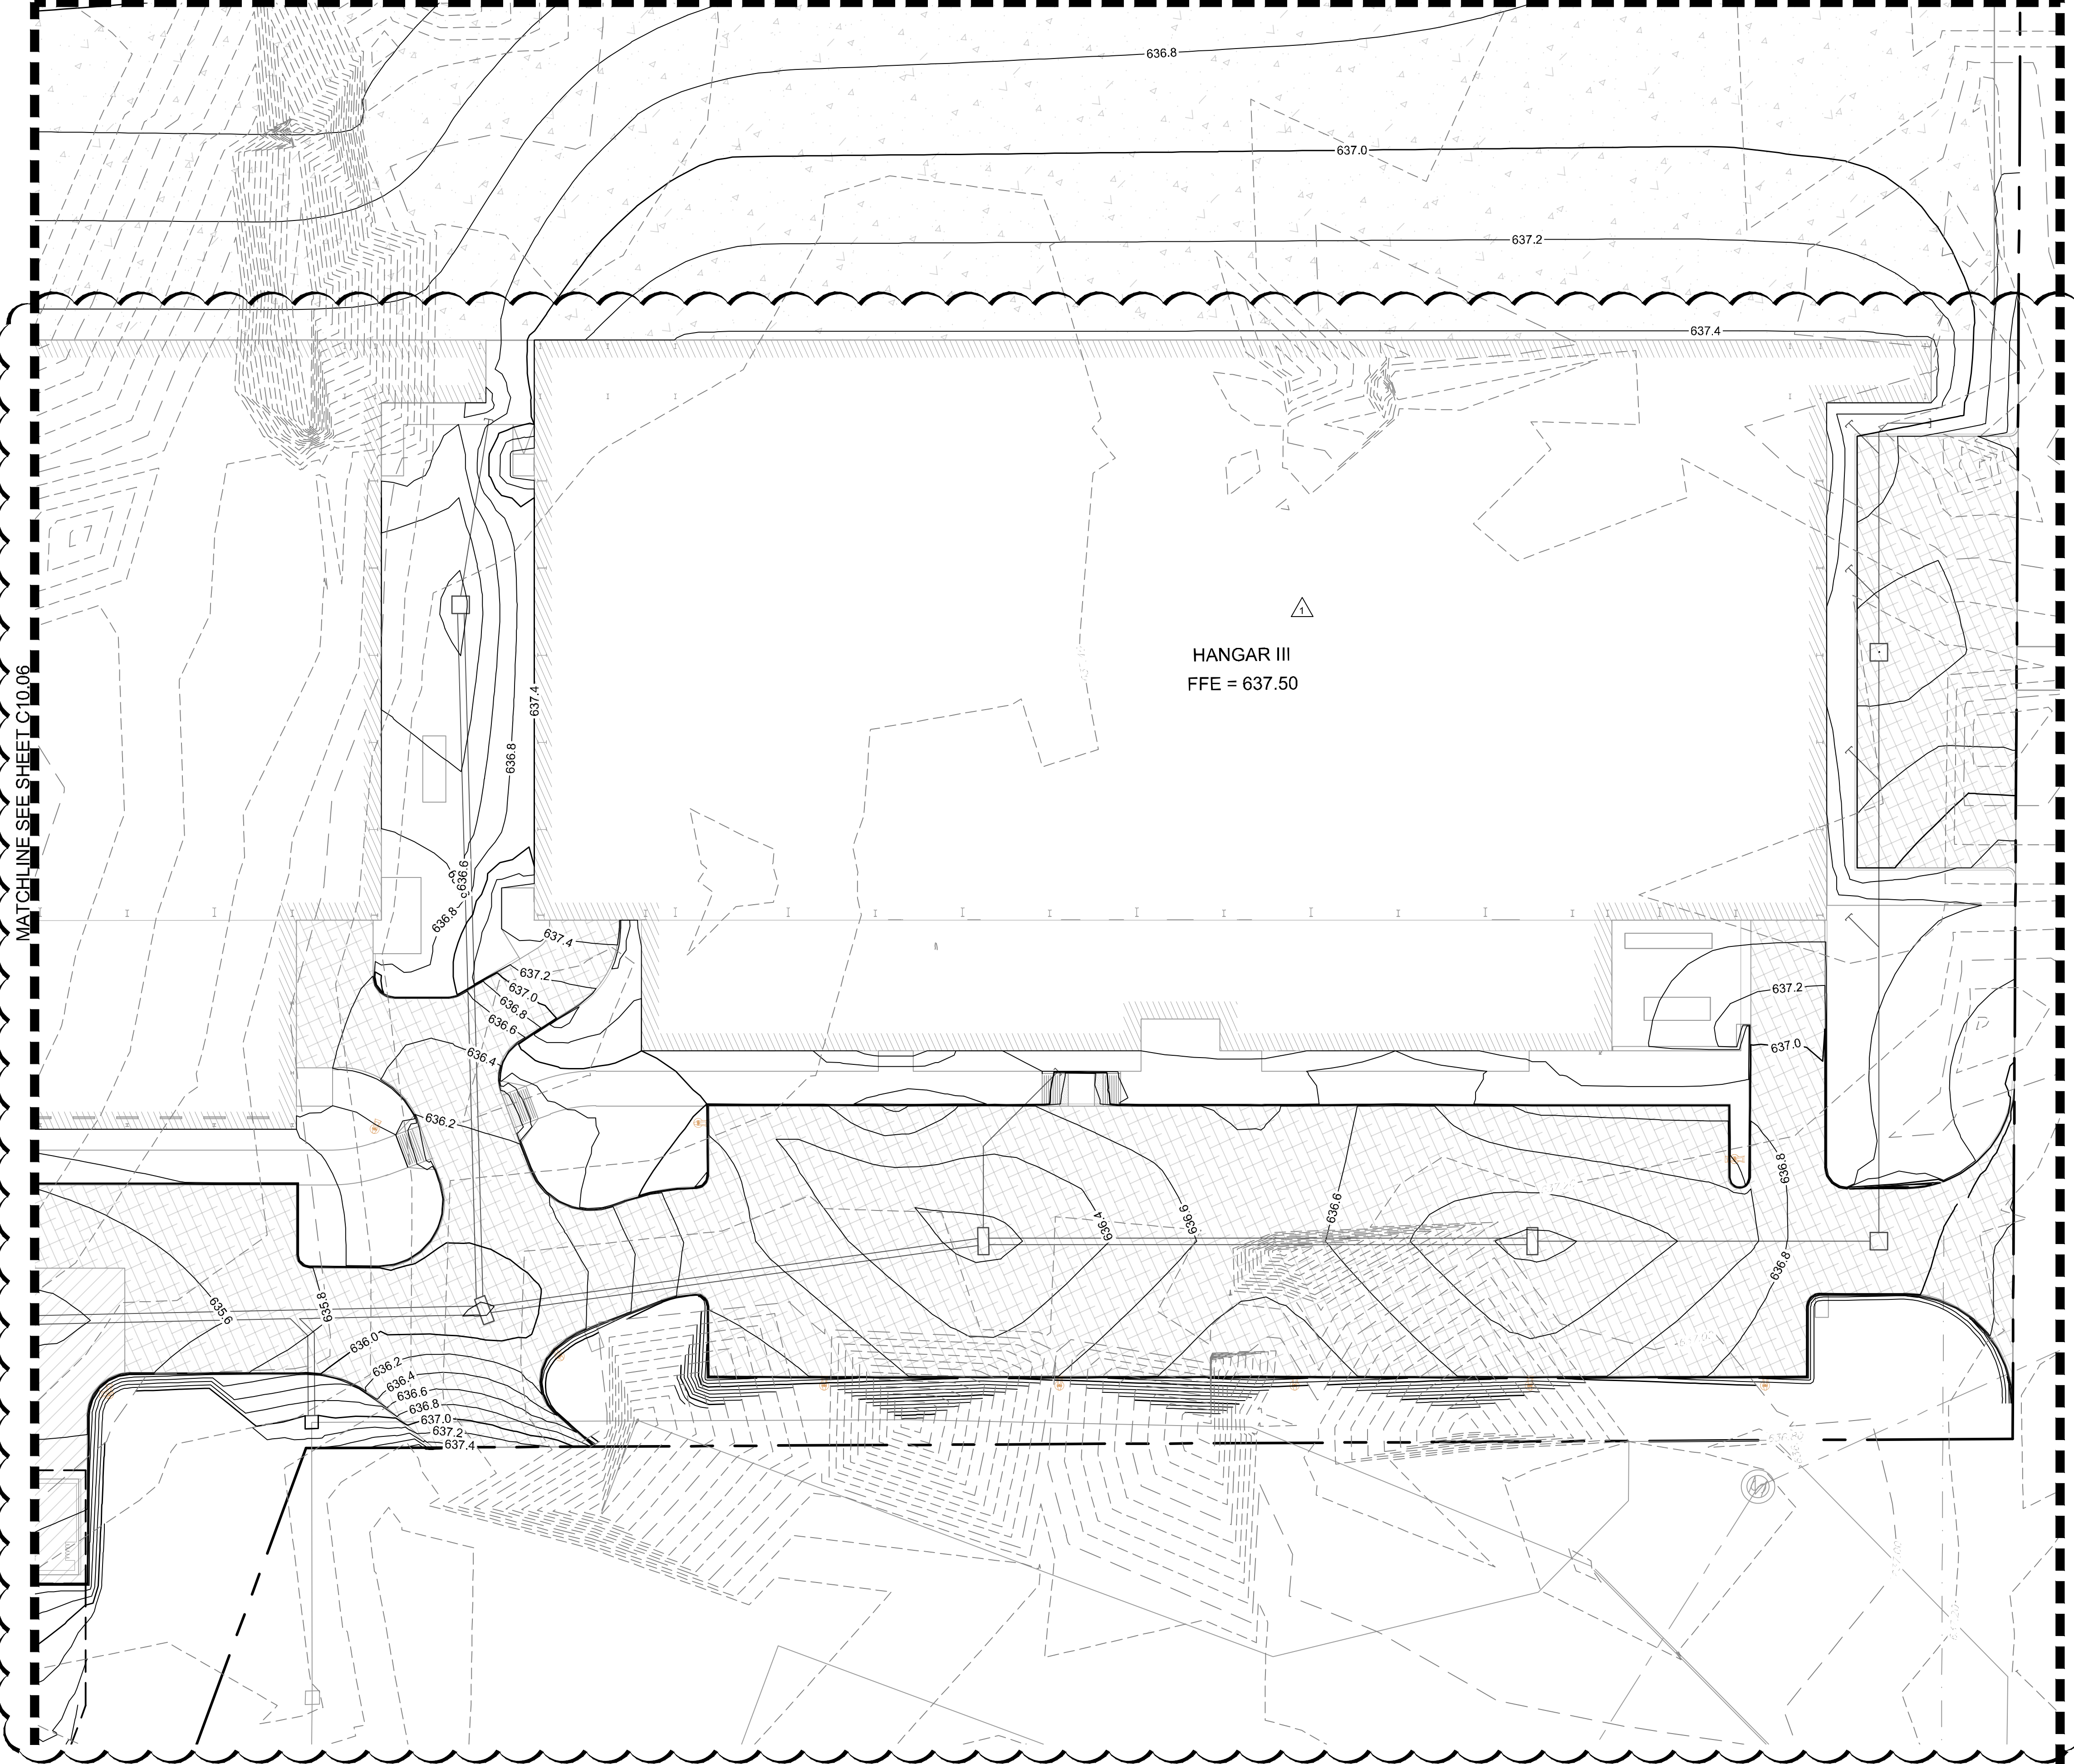



MATCHLINE SEE SHEET C10.04




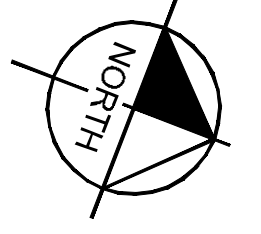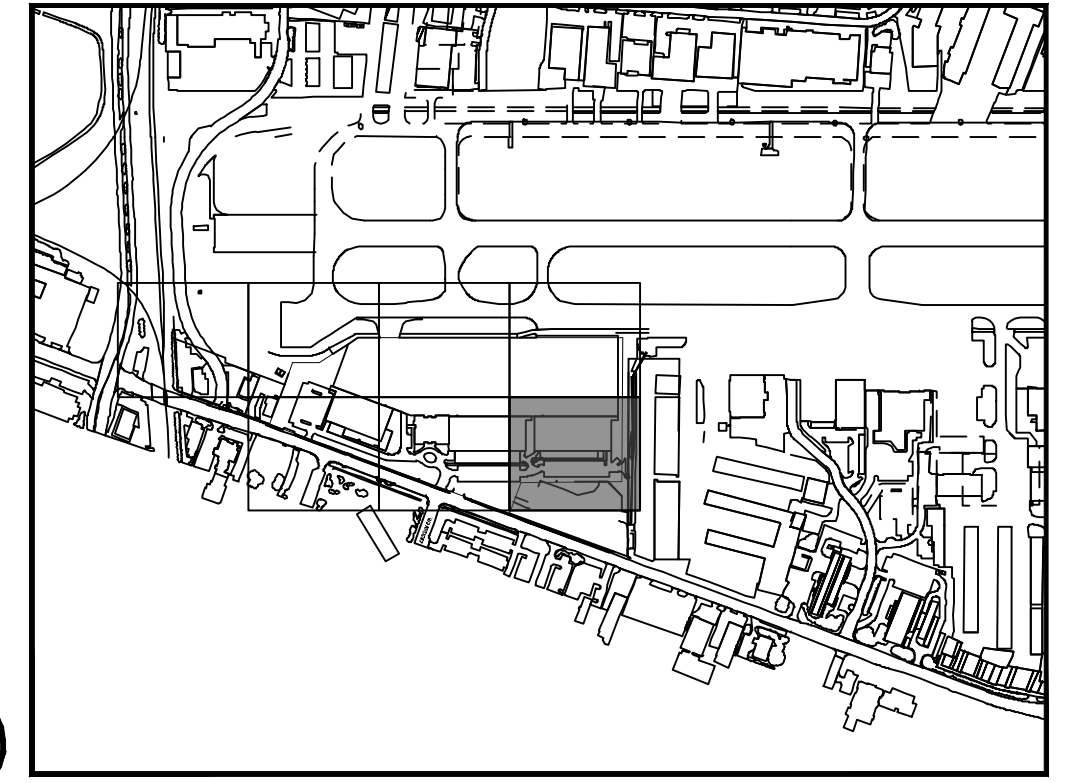
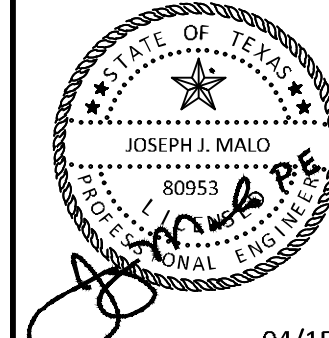
KEY PLAN

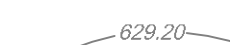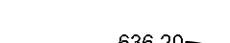

LEGEND

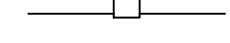-  EXISTING CONTOURS
-  PROPOSED CONTOURS
-  TRENCH DRAIN
-  DRAINAGE INLET
-  DRAINAGE MANHOLE

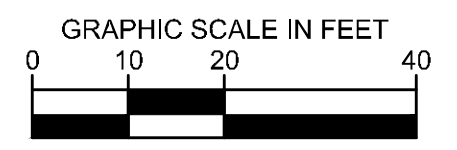

 © 2019 KIMLEY-HORN AND ASSOCIATES, INC. 1400 WOODLICK FOREST DRIVE, SUITE 225 ADDISON, TEXAS 75001 PHONE: 281-475-2816 TBP# FIRM REGISTRATION F-928 WWW.KIMLEY-HORN.COM	 04/15/20	KHA PROJECT 067792503 DATE 2/21/2020 SCALE AS SHOWN DESIGNED BY HCV DRAWN BY EC EAC CHECKED BY HCV	GRADING PLAN	ADDISON GALAXY FBO 15601 ADDISON RD. PREPARED FOR BLACK FOREST VENTURE DALLAS, TEXAS ADDISON								
SHEET NUMBER C10.07		<table border="1" style="width: 100%; border-collapse: collapse;"> <thead> <tr> <th>No.</th> <th>REVISIONS</th> <th>DATE</th> <th>BY</th> </tr> </thead> <tbody> <tr> <td> </td> <td> </td> <td> </td> <td> </td> </tr> </tbody> </table>			No.	REVISIONS	DATE	BY				
No.	REVISIONS	DATE	BY									