


WING AVIATION APRON CONNECTOR AND CLAIRE CHENNAULT STREET DRIVEWAY RECONSTRUCTION

ADDISON AIRPORT

ADDISON, TEXAS

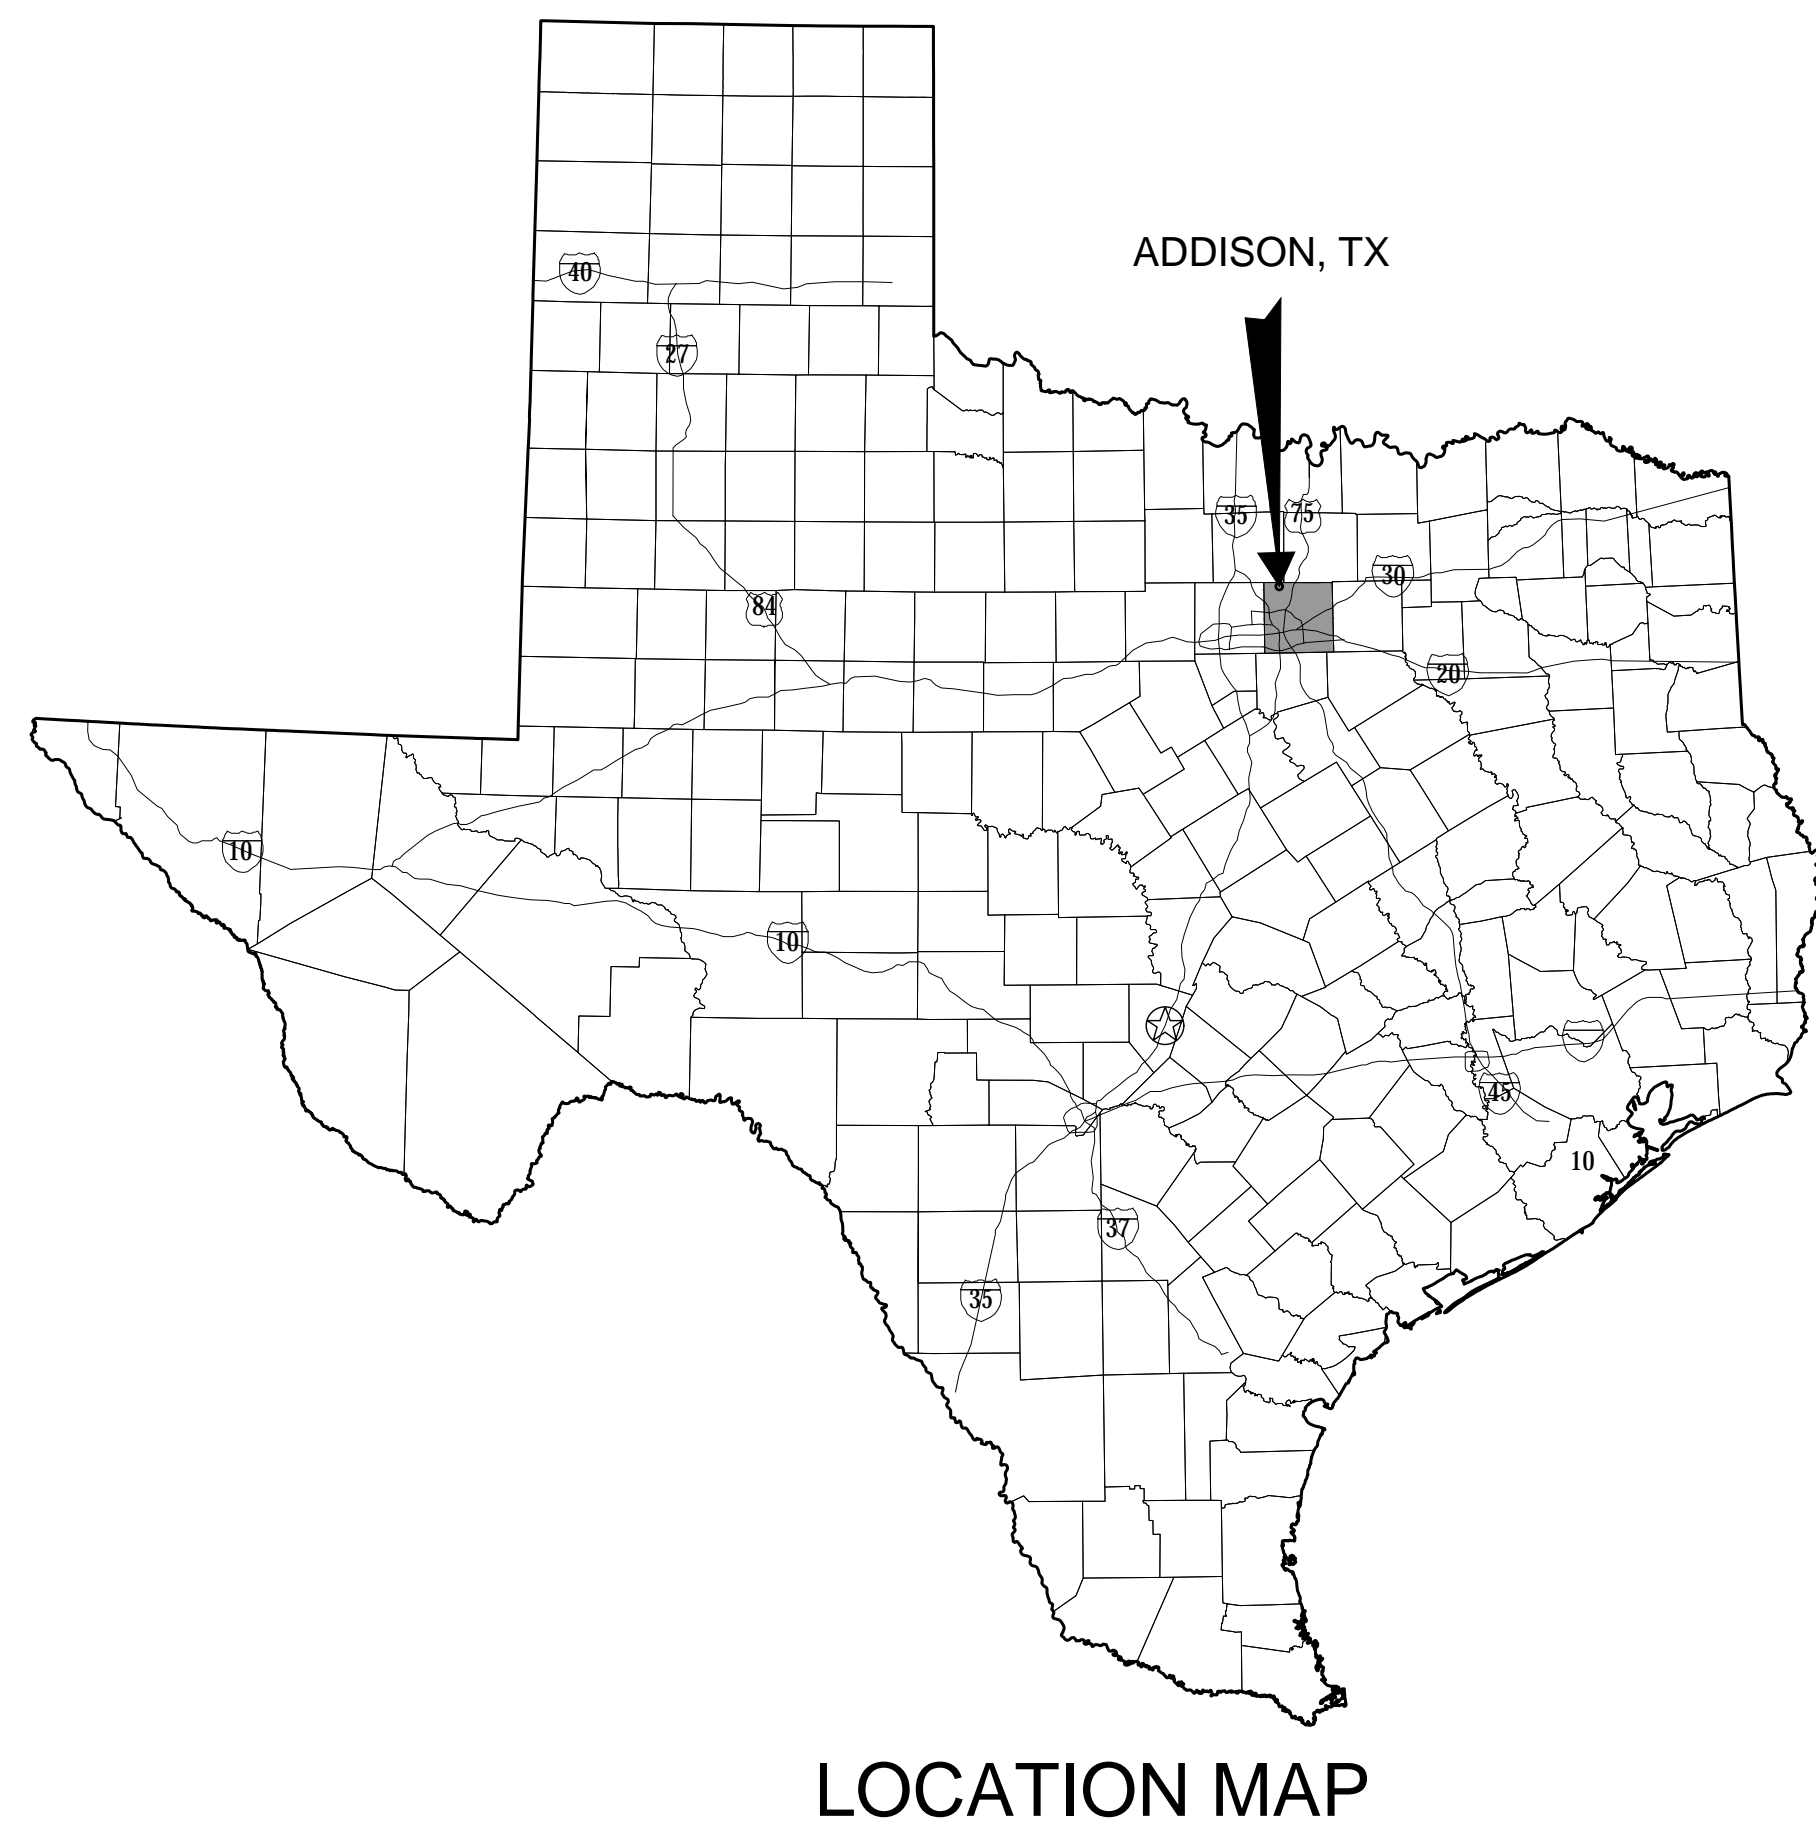


LOCATION MAP



TOWN OF ADDISON BID NO. 18-22
 GARVER PROJECT NO. 17081100
 JANUARY 2019



3010 Gaylord Parkway
 Suite 190
 Frisco, TX 75034
 (972) 377-7480

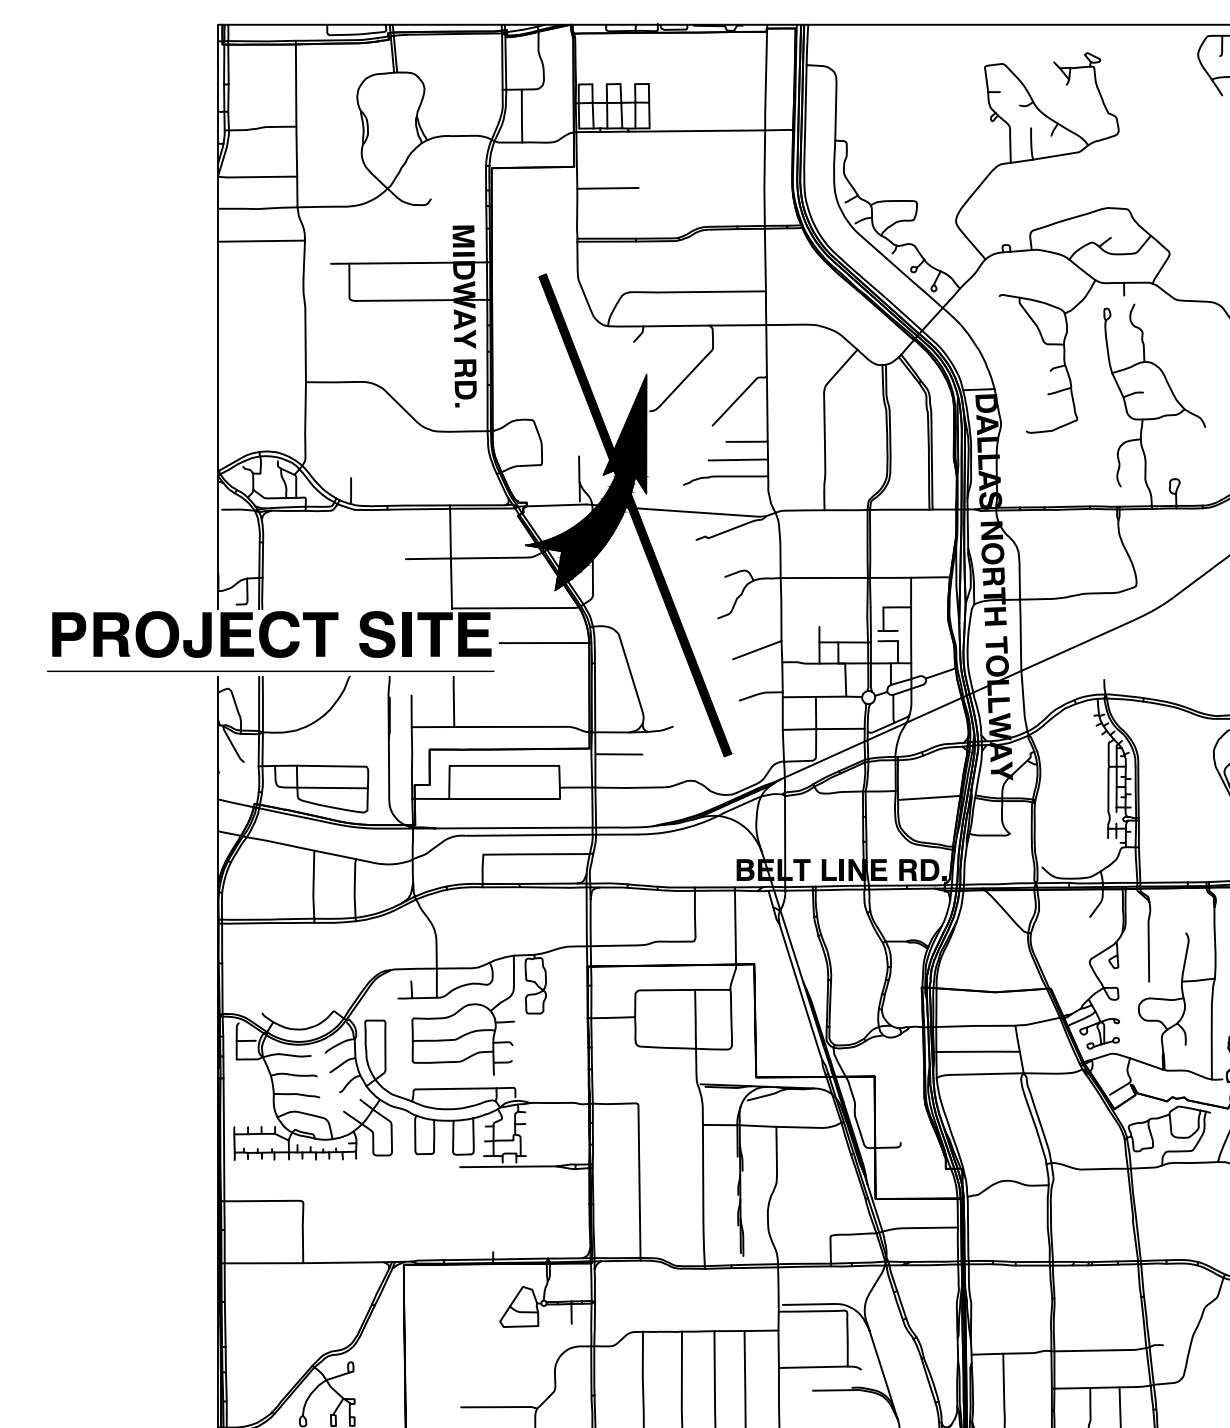

VICINITY MAP
 NO SCALE

RECORD DRAWINGS

(ADD DATE)

To the best knowledge of the Engineer, these drawings have been generally conformed to the construction of the improvements based on information supplied by the owner, contractor and/or resident project representative. The accuracy of the information contained within these record drawings is not guaranteed.

Brandon C. Beville
 BRANDON C. BEVILLE, P.E.

01/21/2018
 Date

| EARTHWORK QUANTITIES | | |
|--|------------|-------------|
| WORK | CUT (C.Y.) | FILL (C.Y.) |
| WING AVIATION APRON CONNECTOR CONSTRUCTION | 142 | 76 |
| DITCH GRADING | 176 | 200 |

© 2017 GARVER, LLC
 THIS DOCUMENT, ALONG WITH THE IDEAS AND DESIGNS CONVEYED HEREIN, SHALL BE CONSIDERED INSTRUMENTS OF PROFESSIONAL SERVICE AND ARE PROPERTY OF GARVER, LLC. ANY USE, REPRODUCTION, OR DISTRIBUTION OF THIS DOCUMENT, ALONG WITH THE IDEAS AND DESIGN CONTAINED HEREIN, IS PROHIBITED UNLESS AUTHORIZED IN WRITING BY GARVER, LLC OR EXPLICITLY ALLOWED IN THE GOVERNING PROFESSIONAL SERVICES AGREEMENT FOR THIS WORK.

REGISTRATION NO.
 F-5713

RECORD DRAWINGS
 1/22/2019

| REV. | DATE | DESCRIPTION | BY |
|------|------|-------------|----|
| | | | |

ADDISON AIRPORT
 ADDISON, TEXAS

WING AVIATION APRON CONNECTOR AND CLAIRE CHENNAULT STREET DRIVEWAY RECONSTRUCTION

COVER SHEET

JOB NO.: 17081100
 DATE: JAN 2019
 DESIGNED BY: JAH
 DRAWN BY: JAH

BAR IS ONE INCH ON ORIGINAL DRAWING
 IF NOT ONE INCH ON THIS SHEET, ADJUST SCALES ACCORDINGLY.

DRAWING NUMBER
G-101

SHEET NUMBER
1

File: L:\2018\17081100 - ADS On Call Services\Drawings\RECORDS\BAAADS-SBA-G101-CO.dwg, Last Saved: 1/21/2019 11:07 AM, Last saved by: JAHenderson
 Last plotted by: Henderson, James, A Plot Style: AECmon.ctb Plot Scale: 1:1 Plot Date: 1/22/2019 2:58 PM Plotter used: AutoCAD PDF (General Documentation).pc3

File: L:\2018\18081100 - ADS On Call Services\Drawings\RECORD\SBAAADS-SBA-G102-IN.dwg Last Save: 1/21/2019 7:02 AM Last saved by: KKRutabana
 Last plotted by: Henderson, James, A Plot Style: AECmono.ctb Plot Scale: 1:1 Plot Date: 1/22/2019 2:58 PM Plotter used: AutoCAD PDF (General Documentation).pc3

| Sheet Index | | |
|-------------------------|----------------|--|
| Sheet Number | Drawing Number | Sheet Title |
| GENERAL | | |
| 1 | G-101 | COVER SHEET |
| 2 | G-102 | SHEET INDEX & GENERAL NOTES |
| 3 | G-201 | GENERAL PROJECT LAYOUT |
| 4 | G-202 | SAFETY & PHASING PLAN - WING AVIATION ENTRANCE (BASE BID 1) |
| 5 | G-203 | SAFETY & PHASING PLAN - CLAIRE CHENNAULT STREET DRIVEWAY RECONSTRUCTION (BASE BID 2) |
| 6 | G-301 | SURVEY CONTROL PLAN |
| 7 | G-401 | EROSION CONTROL PLAN |
| 8 | G-402 | EROSION CONTROL DETAILS I |
| 9 | G-403 | EROSION CONTROL DETAILS II |
| 10 | G-404 | EROSION CONTROL NOTES |
| WING AVIATION APRON | | |
| 11 | C-100 | WING AVIATION APRON CONNECTOR - DETAILS (BASE BID 1) |
| 12 | C-101 | WING AVIATION DRAINAGE DETAILS |
| 13 | C-102 | WING AVIATION APRON CONNECTOR - DEMOLITION PLAN (BASE BID 1) |
| 14 | C-103 | WING AVIATION APRON CONNECTOR - LAYOUT PLAN (BASE BID 1) |
| 15 | C-104 | WING AVIATION APRON CONNECTOR - JOINT LAYOUT PLAN (BASE BID 1) |
| 16 | C-105 | WING AVIATION APRON CONNECTOR - DRAINAGE PLAN I (BASE BID 1) |
| 17 | C-106 | WING AVIATION APRON CONNECTOR - DRAINAGE PLAN II (BASE BID 1) |
| CLAIRE CHENNAULT STREET | | |
| 18 | C-200 | CLAIRE CHENNAULT STREET DRIVEWAY - DETAILS (BASE BID 2) |
| 19 | C-201 | CLAIRE CHENNAULT STREET DRIVEWAY DRAINAGE DETAILS |
| 20 | C-202 | CLAIRE CHENNAULT STREET DRIVEWAY - DEMOLITION PLAN (BASE BID 2) |
| 21 | C-203 | CLAIRE CHENNAULT STREET DRIVEWAY - LAYOUT PLAN (BASE BID 2) |
| 22 | C-204 | CLAIRE CHENNAULT STREET DRIVEWAY - DRAINAGE PLAN (BASE BID 2) |

GENERAL NOTES

- THE CONTRACTOR SHALL NOTIFY ALL UTILITY COMPANIES 48 HOURS BEFORE WORK IS STARTED TO VERIFY UTILITY LOCATIONS (DIGTESS 1-800-344-8377).
- THE CONTRACTOR SHALL NOTIFY ADDISON AIRPORT OPERATIONS 48 HOURS IN ADVANCE OF CONSTRUCTION ACTIVITY TO ALLOW SUFFICIENT TIME FOR COORDINATION OF NOTAMS AND TO LOCATE AND MARK EXISTING FIELD CABLES AND TO AVOID UNSCHEDULED FACILITY OUTAGES. THE CONTRACTOR SHALL PROVIDE 35 DAYS NOTICE TO FAA PRIOR TO BEGINNING CONSTRUCTION.
- THE CONTRACTOR SHALL COMPLETE ALL WORK IN ACCORDANCE WITH THE FAA ADVISORY CIRCULAR 150/5370-2F, OR CURRENT VERSION, "OPERATIONAL SAFETY ON AIRPORTS DURING CONSTRUCTION".
- THE CONTRACTOR'S STAGING AREA FOR OFFICE, STOCKPILE, EQUIPMENT, ENGINEER'S OFFICE, MATERIALS STORAGE AND EMPLOYEE PARKING SHALL BE NO CLOSER THAN 25 FEET FROM ANY FENCE LINE. ADDISON OPERATIONS SHALL APPROVE THE EXACT LOCATION OF THE STAGING AREA PRIOR TO ITS USE. THE SUGGESTED LOCATION IS SHOWN, OTHERS PROPOSED MAY BE ACCEPTABLE.
- THE CONTRACTOR SHALL MAINTAIN ALL EXISTING ACCESS AND HAUL ROADS OUTSIDE THE LIMITS OF CONSTRUCTION DURING CONSTRUCTION AND SHALL RESTORE THE ROADS TO A CONDITION EQUAL TO OR BETTER THAN ITS ORIGINAL CONDITION AT NO ADDITIONAL COST TO THE OWNER. THE LOCATION OF ANY ADDITIONAL HAUL ROADS DESIRED BY THE CONTRACTOR IS SUBJECT TO THE APPROVAL OF THE AIRPORT AND ENGINEER.
- THE CONTRACTOR IS RESPONSIBLE FOR CONSTRUCTING AND MAINTAINING TEMPORARY ACCESS AND/OR HAUL ROADS WHERE NECESSARY TO THE CONSTRUCTION LIMITS. THE CONTRACTOR SHALL COMPLETELY REMOVE THE TEMPORARY HAUL ROADS SHOWN ON THE PHASING PLANS UPON COMPLETION OF THE PROJECT AND SHALL RESTORE THE GROUND SURFACE AND TURF IN THE AREA TO ITS CONDITION PRIOR TO THIS CONSTRUCTION.
- DURING MATERIAL DELIVERY / PAVING OPERATIONS, THE CONTRACTOR SHALL BE RESPONSIBLE FOR PROVIDING AND MAINTAINING TRAFFIC CONTROL. TRAFFIC CONTROL SHALL BE INCIDENTAL TO THE TOTAL PROJECT.
- ALL EMPLOYEES OF THE CONTRACTOR SHALL ENTER AND EXIT THE WORK SITE AT THE DESIGNATED CONTRACTOR'S ACCESS GATE (AG). AN ADEQUATE SIGN SHALL BE PROVIDED DESIGNATING THIS GATE LOCATION AS THE "CONSTRUCTION EMPLOYEE ENTRANCE". MINIMUM REQUIREMENTS FOR AN ACCESS GATE ARE AS FOLLOWS:
 - ALL VEHICLES MUST STOP PRIOR TO ENTERING THE AIRPORT. IF A GATE GUARD IS USED, THEY MUST WAIT FOR THE GATE GUARD TO SIGNAL THEM TO PROCEED. ONLY AUTHORIZED CONTRACTORS, FAA PERSONNEL, AIRPORT PERSONNEL, PROJECT ENGINEERS, AND TENNANTS WILL BE ALLOWED ACCESS. THE CONTRACTOR WILL FURNISH TRAINING AND WRITTEN PROCEDURES TO THE GATE GUARD THAT MUST BE FOLLOWED DURING THE PROJECT.
 - DELIVERY VEHICLES FOR THE CONTRACTOR NEED TO CHECK IN AT THE GATE. THE CONTRACTOR MUST MAINTAIN POSITIVE ESCORT CONTROL OF ALL DELIVERY VEHICLES WHILE ON SITE.
 - THE GATE GUARD SHALL BE EQUIPPED WITH A TELEPHONE TO CONTACT AIRPORT OPERATIONS IF ANY UNAUTHORIZED VEHICLE ATTEMPTS TO ENTER THE AIRPORT AIR OPERATIONS AREA.
 - THE ACCESS GATE SHOWN ON THE PLANS SHALL REMAIN CLOSED AT ALL TIMES.
 - ANY AND ALL FINES THAT MAY BE LEVIED ON THE AIRPORT FOR A SECURITY AND/OR SAFETY VIOLATION IN CONNECTION WITH THE ACCESS GATE OR THE CONTRACTOR'S ACTIVITIES SHALL BE PAID BY THE CONTRACTOR. THE FAA MAY ASSESS A FINE DEPENDING ON THE SERIOUSNESS OF THE INFRACTION.
 - THE CONTRACTOR SHALL AT ALL TIMES ENSURE AGAINST UNAUTHORIZED ACCESS TO THE AIRFIELD.
 - PRIVATE AND COMPANY VEHICLES OPERATING WITHIN THE AIRCRAFT OPERATION AREA (AOA) MUST HAVE A COMPANY LOGO / IDENTIFICATION ON BOTH SIDES OF THE VEHICLE. THE CONTRACTOR'S EMPLOYEES' VEHICLES PARKED IN ANY OF THE CONTRACTOR'S STAGING AREA AND NOT USED FOR CONSTRUCTION PURPOSES DO NOT REQUIRE THIS IDENTIFICATION. SIGNS AS DESCRIBED ABOVE ARE REQUIRED ON PRIVATE VEHICLES OPERATED IN AREAS OTHER THAN THE STAGING AREA, DIRECT ACCESS ROUTES TO AND FROM THE STAGING AREA AND WITHIN THE CONSTRUCTION WORK LIMITS.
- CONSTRUCTION WORK LIMITS ARE AS SHOWN ON THE PLANS. ANY AND ALL WORK CONDUCTED OUTSIDE THE CONSTRUCTION LIMITS, EXCEPT FOR MAINTENANCE ON BARRICADES SHALL BE ACCOMPLISHED WITH THE USE OF AN AIRPORT ESCORT. THE CONTRACTOR WILL PROVIDE AN ESCORT WITH A MINIMUM NOTICE OF TWO WORKING DAYS. NO WORK OR TRAVEL WILL BE PERMITTED OUTSIDE THE CONSTRUCTION LIMITS SHOWN WITHOUT PRIOR APPROVAL BY AIRPORT OPERATIONS AND AN AUTHORIZED ESCORT. AIRPORT OPERATIONS WILL NEED TO KEEP OPEN

VARIOUS TAXIWAYS ADJACENT OR IN THE PROXIMITY OF OR CROSSING THE CONSTRUCTION AREA. THE WORK SHALL BE COORDINATED WITH AIRPORT OPERATIONS. NO WORK IS PERMITTED NOR ARE OPEN EXCAVATIONS, STORED MATERIALS, STOCKPILES OR EQUIPMENT ALLOWED OUTSIDE OF THE WORK AREA AS SHOWN IN THE PLANS WITHOUT PRIOR COORDINATION WITH AIRPORT OPERATIONS.

- THE CONTRACTOR'S ACCESS TO THE AIRFIELD IS LIMITED TO THE LOCATIONS AS SHOWN ON THE PLANS. ACCESS FROM THE GATE TO THE STAGING, STORAGE AND WORK AREAS SHALL BE CONFINED TO THE ROUTES SHOWN AND WITHIN THE WORK AREA LIMITS. ACCESS VIA ANY OTHER ROUTES OR GATES WILL REQUIRE PRIOR WRITTEN APPROVAL BY AIRPORT OPERATIONS.
- ANY TEMPORARY FACILITIES SHALL BE COMPLETELY REMOVED FROM THE SITE AT THE COMPLETION OF THE PROJECT AND THE SITE RESTORED TO ITS ORIGINAL CONDITION.
- CONSTRUCTION LIMITS - ALL CONTRACTOR VEHICLES AND TRAFFIC (UNLESS OTHERWISE AUTHORIZED) SHALL REMAIN WITHIN THE DESIGNATED CONSTRUCTION LIMITS OR HAUL ROUTES. CONSTRUCTION, STORAGE AND STOCKPILING LIMITS MUST BE APPROVED BY THE AIRPORT OR ENGINEER.
- FUEL, DIESEL FUEL, OR OTHER CONTAMINANTS SHALL NOT BE ALLOWED TO ENTER THE STORM SEWER SYSTEM. IF, IN THE EVENT SUCH CONTAMINANTS DO ENTER THE STORM SEWER SYSTEM OR GROUND WATER, THE CONTRACTOR SHALL IMMEDIATELY NOTIFY THE AIRPORT OF THE SPILL. THE CONTRACTOR WILL BE RESPONSIBLE FOR ALL COSTS INCURRED FOR CLEANUP OF CONTAMINATED AREAS ON AND OFF AIRPORT PROPERTY.
- CAUTION SHALL BE TAKEN BY THE CONTRACTOR IN PREVENTING ANY DUST OR MUD WHICH MAY BECOME A HAZARD TO AIR AND GROUND OPERATIONS. THE CONTRACTOR SHALL CONTROL DUST AND MUD AT ALL TIMES AND MAY REQUIRE FULL TIME OPERATION WATER TRUCKS OR SWEEPERS. IF, IN THE OPINION OF THE AIRPORT OR THE ENGINEER, DUST OR MUD IS NOT BEING ADEQUATELY CONTROLLED THEY MAY SUSPEND WORK AND MAKE NECESSARY ARRANGEMENTS FOR DUST OR MUD CONTROL. THE COSTS THEREFORE SHALL BE DEDUCTED FROM THE PROGRESS PAYMENTS DUE THE CONTRACTOR.
- CONTRACTOR SHALL TAKE THE NECESSARY STEPS TO OBTAIN DRIVER'S TRAINING FOR CONTRACTOR EMPLOYEES PRIOR TO ENTERING THE AIR OPERATIONS AREA.
- MATERIAL / TOPSOIL STOCKPILES SHALL BE AT LOCATIONS APPROVED BY THE AIRPORT. MAXIMUM STOCKPILE HEIGHT IS 20 FEET.
- THE CONTRACTOR WILL ISSUE AIRPORT APPROVED LAMINATED SAFETY CARDS SHOWING THE ACCESS GATE LOCATION, CONSTRUCTION AREA, ACCESS / HAUL ROUTE, CLOSED PAVEMENTS AND RUNWAY SAFETY AREAS AND/OR ANY OTHER PERTINENT INFORMATION. THESE CARDS WILL BE SUPPLIED BY THE CONTRACTOR. THESE SAFETY CARDS WILL BE SPECIFIC TO EACH INTERMEDIATE PHASE OF THE PROJECT. THE CONTRACTOR IS RESPONSIBLE FOR DISTRIBUTING AND COLLECTING THESE CARDS TO ALL OF THEIR EMPLOYEES, SUBCONTRACTORS AND SUPPLIER DELIVERY DRIVERS WHO WILL ENTER THE AOA. THE CONTRACTOR IS REQUIRED TO BRIEF ALL EMPLOYEES OR SUBCONTRACTORS ON AIRPORT SECURITY AND SAFETY PRIOR TO DISTRIBUTING THE SAFETY CARDS. BEFORE A NEW EMPLOYEE, SUBCONTRACTOR OR SUPPLIER BEGINS WORKING ON THE AIRPORT THE CONTRACTOR IS RESPONSIBLE TO MAKE SURE THEY ARE AWARE OF AIRPORT OPERATIONS, AS WELL AS GIVE THEM A TOUR OF THE PROJECT SITE, SHOWING THEM THE SPECIFIC WORK AREA, HAUL ROUTE AND THE MOVEMENT AREA THAT IS NOT TO ENTERED WITHOUT AIRPORT APPROVAL.
- ALL EMPLOYEES OF THE CONTRACTOR OR SUBCONTRACTORS SHALL RECEIVE VEHICLE OPERATOR/PEDESTRIAN TRAINING FROM THE PROJECT SUPERINTENDENT. ALL EMPLOYEES SHALL RECEIVE NEW TRAINING WHEN MOVED TO DIFFERENT WORK AREAS OR PHASES OF THE PROJECT. A CONTRACTOR VEHICLE OPERATOR/PEDESTRIAN TRAINING CHECKLIST IS PROVIDED IN THE CONTRACT SPECIFICATIONS. THE CONTRACTOR'S PROJECT SUPERINTENDENT SHALL MAINTAIN THE COMPLETED CHECKLIST AND PROVIDE TO AIRPORT PERSONNEL FOR INSPECTION UPON THEIR REQUEST.
- IF FOR ANY REASON, THE AIRPORT OR ENGINEER FEELS THAT SAFETY IS NOT BEING ADEQUATELY MAINTAINED, THEY MAY SUSPEND WORK UNTIL THE SAFETY ISSUE IS RESOLVED. THE COSTS THEREFORE SHALL BE DEDUCTED FROM THE PROGRESS PAYMENTS DUE THE CONTRACTOR.
- IN THE EVENT THAT UNANTICIPATED ARCHEOLOGICAL DEPOSITS ARE ENCOUNTERED DURING CONSTRUCTION, WORK IN THE IMMEDIATE AREA WILL CEASE AND THE TXDOT ENGINEER WILL BE NOTIFIED.
- IN THE EVENT THAT UNANTICIPATED HAZARDOUS MATERIALS ARE ENCOUNTERED DURING CONSTRUCTION, WORK IN THE IMMEDIATE AREA WILL CEASE AND THE TXDOT PROJECT MANAGER WILL BE NOTIFIED.
- STOCKPILES AND STAGING AREAS WILL NOT BE PLACED WITHIN ANY WATER OF THE UNITED STATES, INCLUDING WETLANDS.
- HAZARDOUS WASTE: ALL SPILLS MUST BE REPORTED IMMEDIATELY TO THE TXDOT ENGINEER.




© 2017 GARVER, LLC
 THIS DOCUMENT, ALONG WITH THE IDEAS AND DESIGNS CONVEYED HEREIN, SHALL BE CONSIDERED INSTRUMENTS OF PROFESSIONAL SERVICE AND ARE PROPERTY OF GARVER, LLC. ANY USE, REPRODUCTION, OR DISTRIBUTION OF THIS DOCUMENT, ALONG WITH THE IDEAS AND DESIGN CONTAINED HEREIN, IS PROHIBITED UNLESS AUTHORIZED IN WRITING BY GARVER, LLC OR EXPLICITLY ALLOWED IN THE GOVERNING PROFESSIONAL SERVICES AGREEMENT FOR THIS WORK.

REGISTRATION NO. F-5713

RECORD DRAWINGS 1/22/2019

| REV. | DATE | DESCRIPTION | BY |
|------|------|-------------|----|
| | | | |
| | | | |
| | | | |

ADDISON AIRPORT
 ADDISON, TEXAS

 WING AVIATION APRON CONNECTOR AND CLAIRE CHENNAULT STREET DRIVEWAY RECONSTRUCTION

SHEET INDEX & GENERAL NOTES

JOB NO.: 17081100
 DATE: JAN 2019
 DESIGNED BY: JAH
 DRAWN BY: JAH

BAR IS ONE INCH ON ORIGINAL DRAWING
 IF NOT ONE INCH ON THIS SHEET, ADJUST SCALES ACCORDINGLY.


DRAWING NUMBER
G-102

SHEET NUMBER
2

File: L:\2018\18081100 - ADS On Call Services\Drawings\RECORDS\BAAADS-SBA-G201-PL.dwg Last Save: 1/21/2019 7:25 AM Last saved by: JAHenderson
 Last plotted by: Henderson, James_A Plot Style: AECmono.ctb Plot Scale: 1:1 Plot Date: 1/22/2019 2:59 PM Plotter used: AutoCAD PDF (General Documentation).pc3



| LEGEND | |
|--------|---|
| | WING AVIATION APRON CONNECTOR CONSTRUCTION (BASE BID 1) |
| | CLAIRE CHENNAULT DRIVE RECONSTRUCTION (BASE BID 2) |
| | ACCESS GATE |
| | CONTRACTOR STAGING AREA |
| | EMPLOYEE PARKING |
| | HAUL ROUTES |

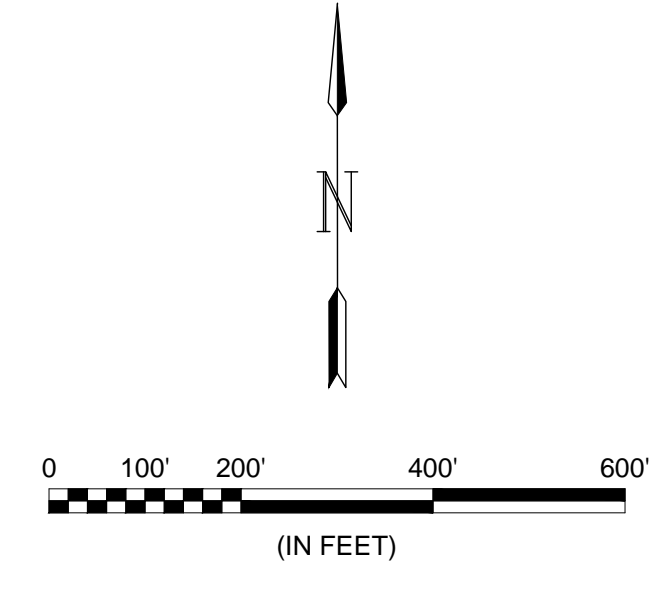

| ITEMS OF WORK | |
|--|--|
| BIDDING | DESCRIPTION |
| BASE BID 1 - WING AVIATION APRON CONNECTOR CONSTRUCTION | 1. INSTALL BARRICADES. 2. CONSTRUCTION OF WING AVIATION APRON ENTRANCE. 3. COMPLETE ALL GRADING ACCORDING TO LAYOUT PLANS. |
| BASE BID 2 - CLAIRE CHENNAULT STREET DRIVEWAY RECONSTRUCTION | 1. INSTALL BARRICADES. 2. FULL DEPTH RECONSTRUCTION OF CLAIRE CHENNAULT DRIVE AS SHOWN WITHIN LAYOUT PLAN. |

| TOTAL CONTRACT TIME | | |
|---|---------------|-------------------|
| | CALENDAR DAYS | WORK AVAILABILITY |
| WING AVIATION APRON ENTRANCE (BASE BID 1) | | ANYTIME |
| CLAIRE CHENNAULT DRIVE (BASE BID 2) | | ANYTIME |

© 2017 GARVER, LLC
 THIS DOCUMENT, ALONG WITH THE IDEAS AND DESIGNS CONVEYED HEREIN, SHALL BE CONSIDERED INSTRUMENTS OF PROFESSIONAL SERVICE AND ARE PROPERTY OF GARVER, LLC. ANY USE, REPRODUCTION, OR DISTRIBUTION OF THIS DOCUMENT, ALONG WITH THE IDEAS AND DESIGN CONTAINED HEREIN, IS PROHIBITED UNLESS AUTHORIZED IN WRITING BY GARVER, LLC OR EXPLICITLY ALLOWED IN THE GOVERNING PROFESSIONAL SERVICES AGREEMENT FOR THIS WORK.

REGISTRATION NO. F-5713

RECORD DRAWINGS
 1/22/2019

| REV. | DATE | DESCRIPTION | BY |
|------|------|-------------|----|
| | | | |

ADDISON AIRPORT
 ADDISON, TEXAS

WING AVIATION APRON CONNECTOR AND CLAIRE CHENNAULT STREET DRIVEWAY RECONSTRUCTION

GENERAL PROJECT LAYOUT

JOB NO.: 17081100
 DATE: JAN 2019
 DESIGNED BY: JAH
 DRAWN BY: JAH

BAR IS ONE INCH ON ORIGINAL DRAWING
 IF NOT ONE INCH ON THIS SHEET, ADJUST SCALES ACCORDINGLY.

DRAWING NUMBER
G-201
 SHEET NUMBER
3



© 2017 GARVER, LLC
 THIS DOCUMENT, ALONG WITH THE IDEAS AND DESIGNS CONVEYED HEREIN, SHALL BE CONSIDERED INSTRUMENTS OF PROFESSIONAL SERVICE AND ARE PROPERTY OF GARVER, LLC. ANY USE, REPRODUCTION, OR DISTRIBUTION OF THIS DOCUMENT, ALONG WITH THE IDEAS AND DESIGN CONTAINED HEREIN, IS PROHIBITED UNLESS AUTHORIZED IN WRITING BY GARVER, LLC OR EXPLICITLY ALLOWED IN THE GOVERNING PROFESSIONAL SERVICES AGREEMENT FOR THIS WORK.

REGISTRATION NO. F-5713

RECORD DRAWINGS
 1/22/2019

| REV. | DATE | DESCRIPTION | BY |
|------|------|-------------|----|
| | | | |
| | | | |
| | | | |

ADDISON AIRPORT
 ADDISON, TEXAS

WING AVIATION APRON CONNECTOR AND CLAIRE CHENNAULT STREET DRIVEWAY RECONSTRUCTION


SAFETY & PHASING PLAN - WING AVIATION ENTRANCE (BASE BID 1)

JOB NO.: 17081100
 DATE: JAN 2019
 DESIGNED BY: JAH
 DRAWN BY: JAH

BAR IS ONE INCH ON ORIGINAL DRAWING
 IF NOT ONE INCH ON THIS SHEET, ADJUST SCALES ACCORDINGLY.


DRAWING NUMBER
G-202

SHEET NUMBER
4

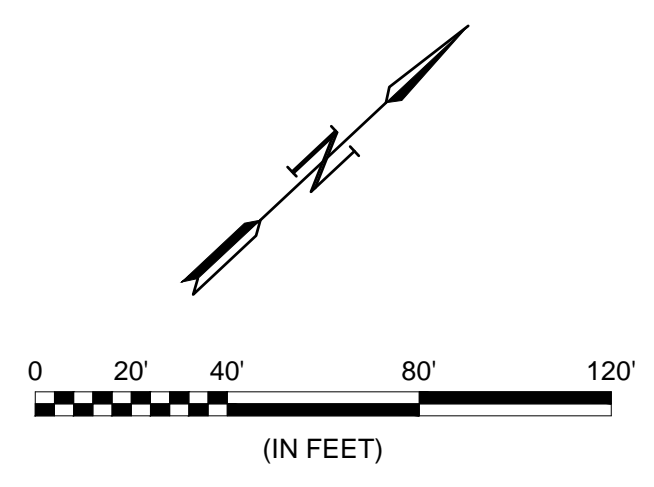


PLACE STEEL PLATES TO DIVERT TRAFFIC DURING WORK ON THE SERVICE ROAD. PAYMENT SHALL BE SUBSIDIARY TO SITE PREPARATION.

EXISTING SERVICE ROAD

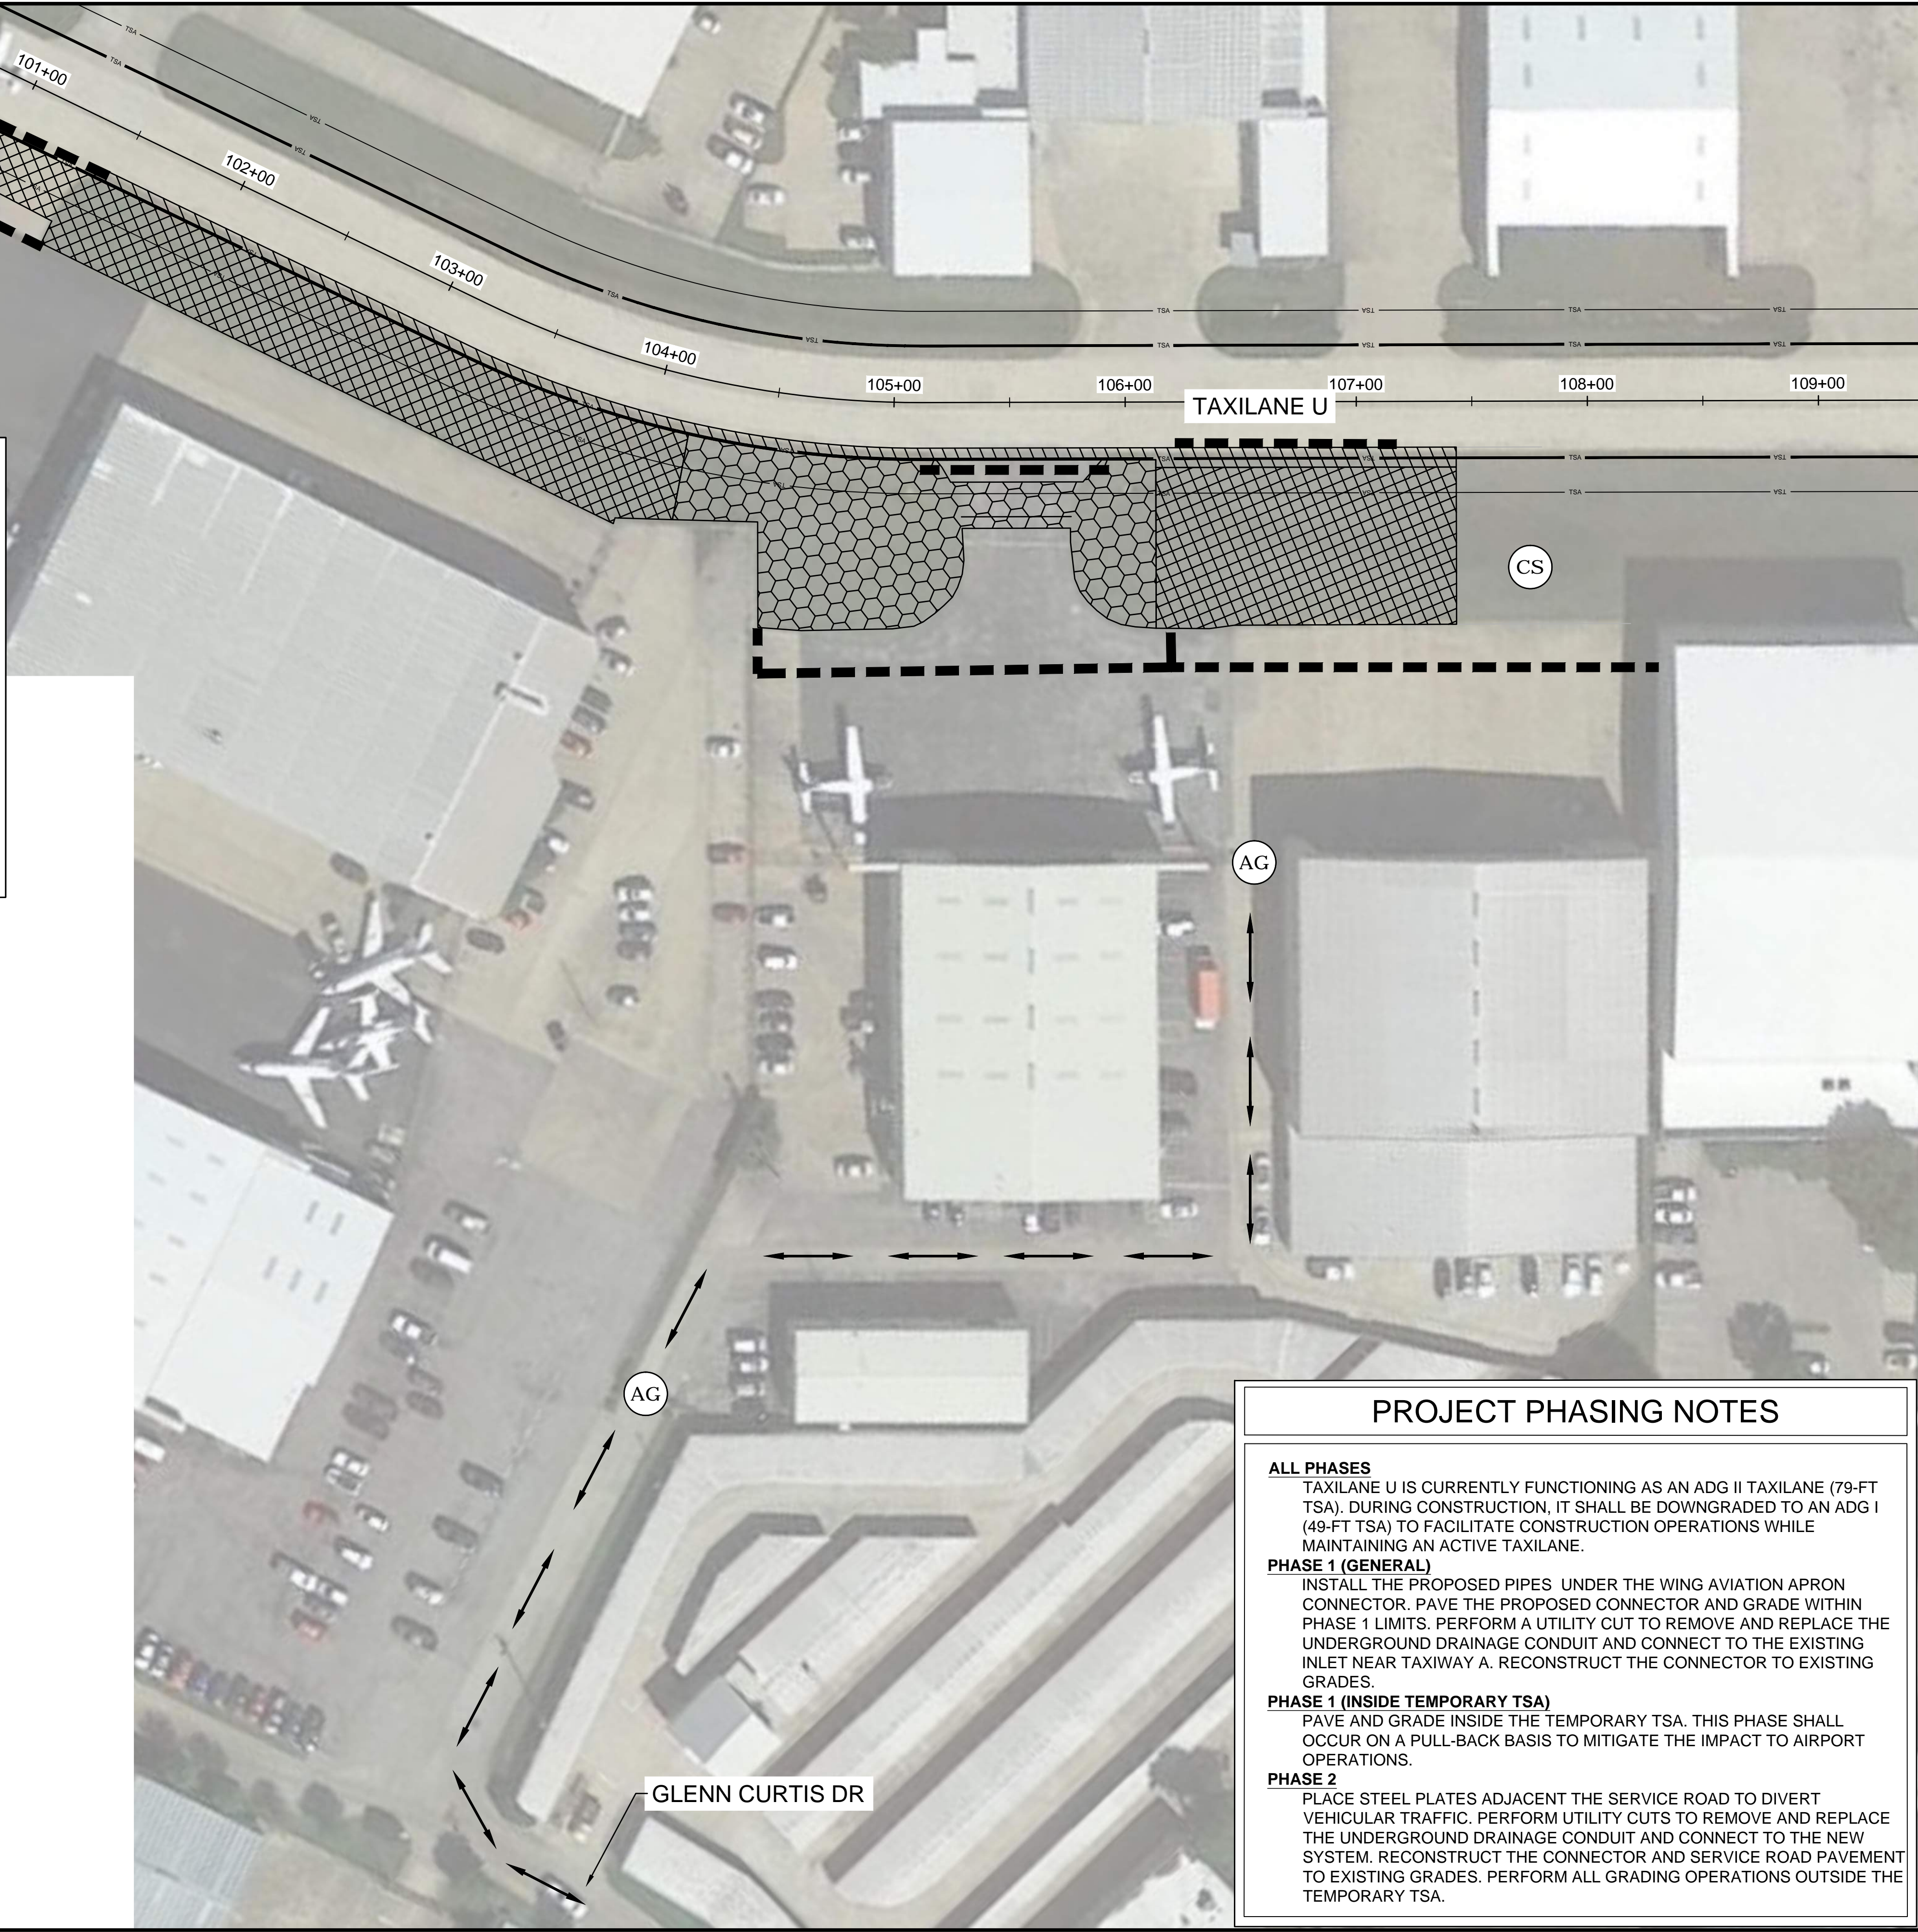

LEGEND

| | | | |
|--|--------------------------------|--|--|
| | PHASE 1 (53 DAYS) | | LOW PROFILE AIRCRAFT BARRICADES |
| | PHASE 1 (INSIDE TEMPORARY TSA) | | HAUL ROUTES |
| | PHASE 2 (5 DAYS) | | TAXILANE SAFETY AREA (ADG II) |
| | ACCESS GATE | | TEMPORARY TAXILANE SAFETY AREA (ADG I) |
| | CONTRACTOR STAGING AREA | | |

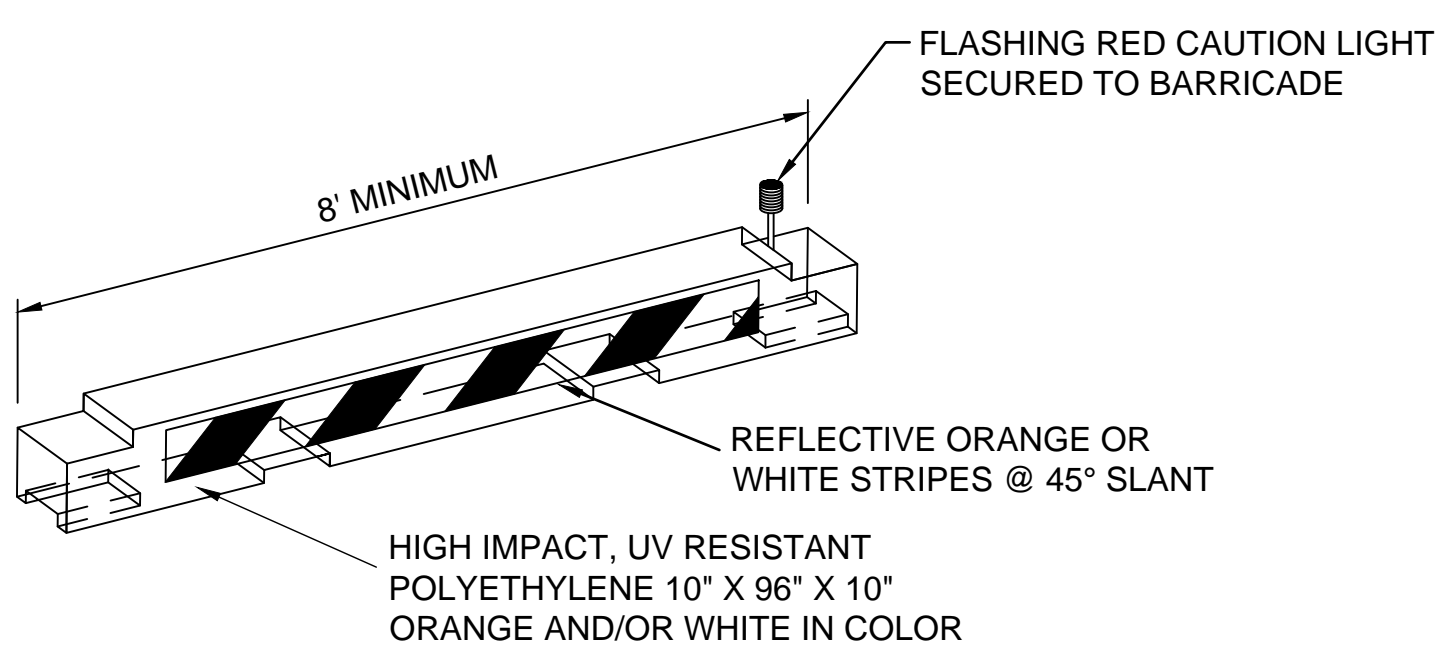

LOW PROFILE AIRCRAFT BARRICADE (MOVEMENT AREAS)

1
 G-202
 SCALE: NONE

NOTES:

- BARRICADES SHALL BE PLACED DURING WORK ACTIVITIES.
- UPON COMPLETION OF WORK, AREA SHALL BE CLEANED AND FREE OF FOD.
- BARRICADES SHALL MEET THE REQUIREMENTS OF THE CURRENT FAA ADVISORY CIRCULAR 150/5370-2 AND BE APPROVED BY THE ENGINEER.
- CONTRACTOR SHALL WEIGHT BARRICADE TO PREVENT DISPLACEMENT. THE METHOD SHALL BE APPROVED BY THE ENGINEER.
- BARRICADES SHALL BE LOCATED AS DEFINED IN THE CONSTRUCTION SAFETY AND PHASING PLAN (CSPP).

CONTRACT TIME

| | CALENDAR DAYS | WORK AVAILABILITY |
|-------------------|---------------|-------------------|
| PHASE 1 (55 DAYS) | | ANYTIME |
| PHASE 2 (5 DAYS) | | ANYTIME |

PROJECT PHASING NOTES

ALL PHASES
 TAXILANE U IS CURRENTLY FUNCTIONING AS AN ADG II TAXILANE (79-FT TSA). DURING CONSTRUCTION, IT SHALL BE DOWNGRADED TO AN ADG I (49-FT TSA) TO FACILITATE CONSTRUCTION OPERATIONS WHILE MAINTAINING AN ACTIVE TAXILANE.

PHASE 1 (GENERAL)
 INSTALL THE PROPOSED PIPES UNDER THE WING AVIATION APRON CONNECTOR. PAVE THE PROPOSED CONNECTOR AND GRADE WITHIN PHASE 1 LIMITS. PERFORM A UTILITY CUT TO REMOVE AND REPLACE THE UNDERGROUND DRAINAGE CONDUIT AND CONNECT TO THE EXISTING INLET NEAR TAXIWAY A. RECONSTRUCT THE CONNECTOR TO EXISTING GRADES.


PHASE 1 (INSIDE TEMPORARY TSA)
 PAVE AND GRADE INSIDE THE TEMPORARY TSA. THIS PHASE SHALL OCCUR ON A PULL-BACK BASIS TO MITIGATE THE IMPACT TO AIRPORT OPERATIONS.

PHASE 2
 PLACE STEEL PLATES ADJACENT THE SERVICE ROAD TO DIVERT VEHICULAR TRAFFIC. PERFORM UTILITY CUTS TO REMOVE AND REPLACE THE UNDERGROUND DRAINAGE CONDUIT AND CONNECT TO THE NEW SYSTEM. RECONSTRUCT THE CONNECTOR AND SERVICE ROAD PAVEMENT TO EXISTING GRADES. PERFORM ALL GRADING OPERATIONS OUTSIDE THE TEMPORARY TSA.

File: L:\2018\18081100 - ADS On Call Services\Drawings\RECORD\SBAA\ADS-SBA-G202-SP.dwg, Last Save: 1/21/2019 7:27 AM, Last saved by: JAHenderson
 Last plotted by: Henderson, James, A, Plot Style: AECmon.ctb, Plot Scale: 1:1, Plot Date: 1/22/2019 2:59 PM, Plotter User: AutoCAD PDF (General Documentation).pc3

CS

CLAIRE CHENNAULT ST

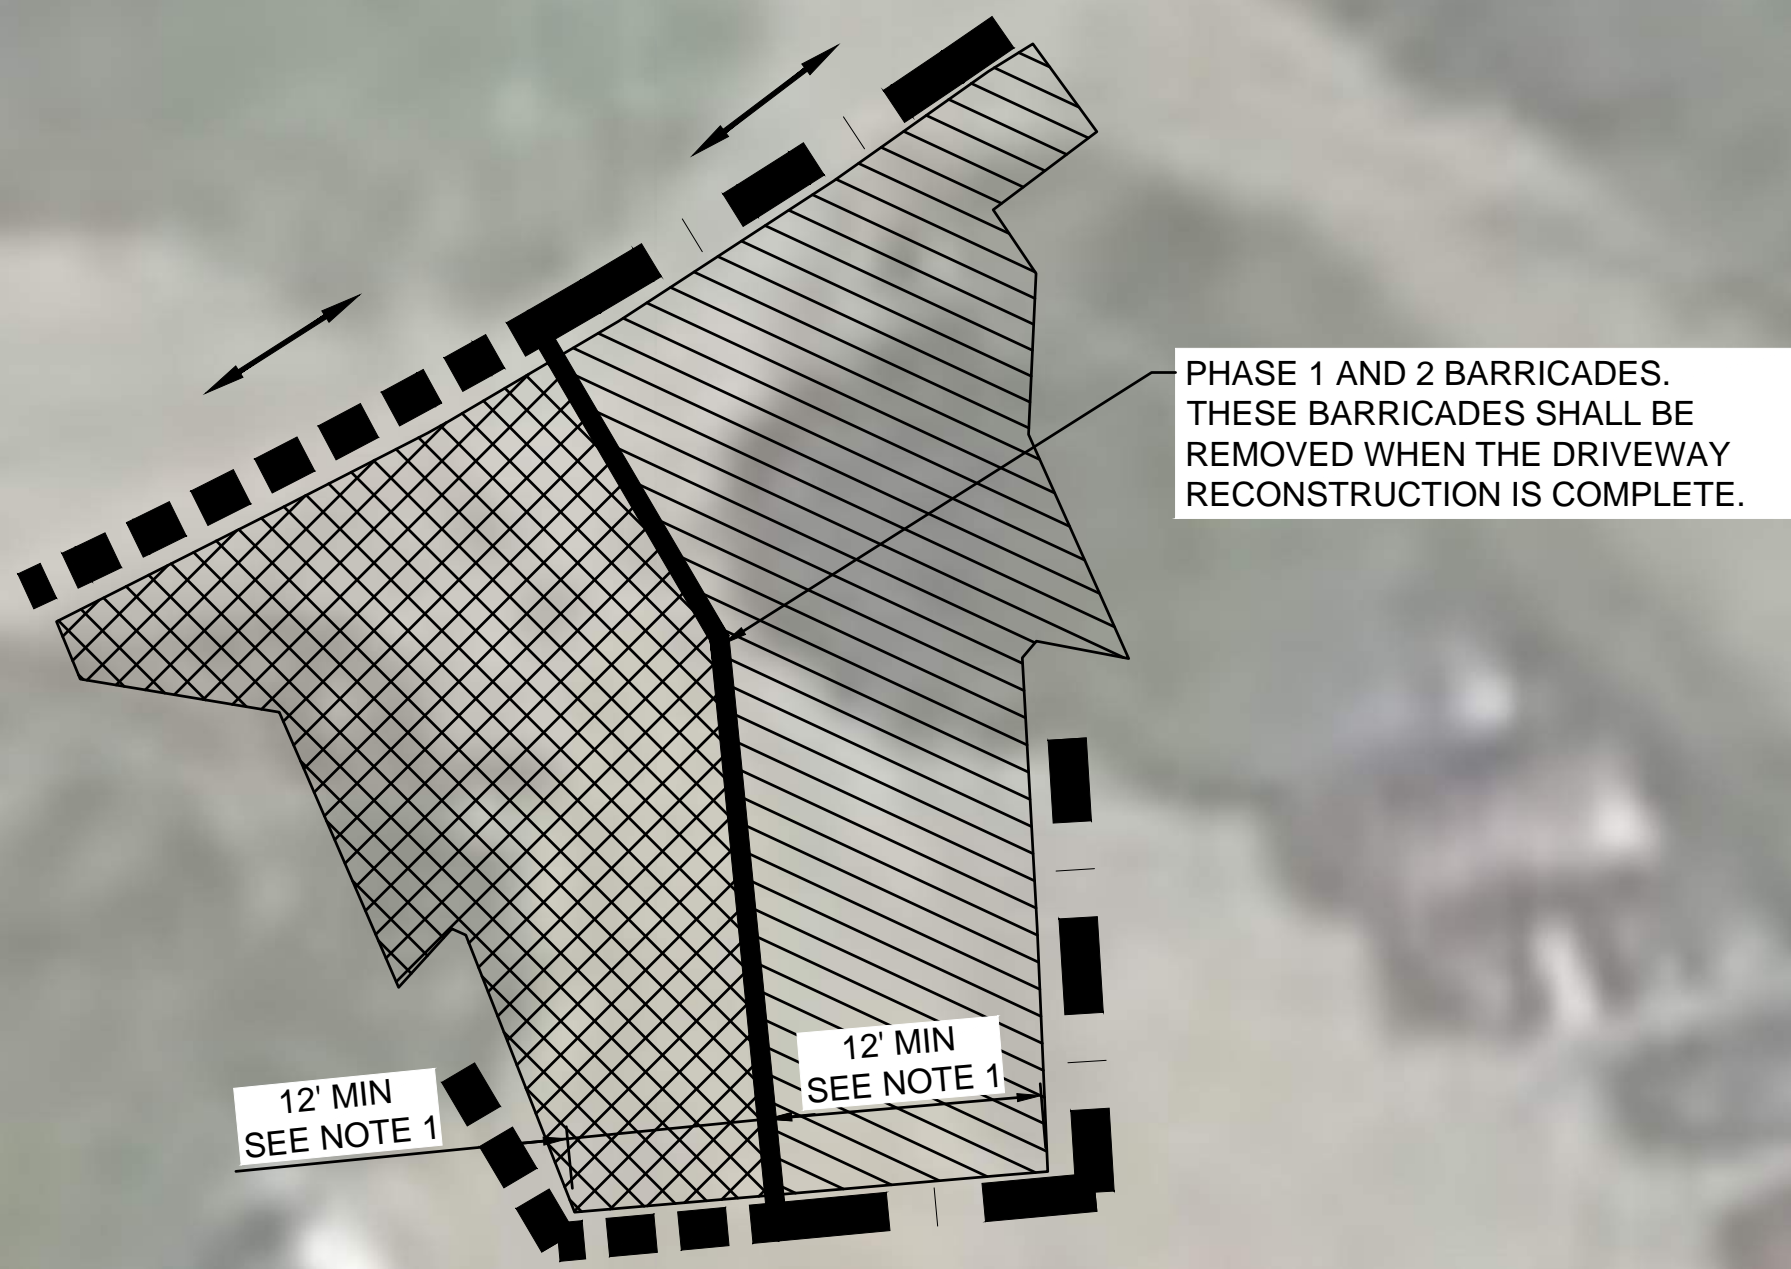



PHASE 1 AND 2 BARRICADES. THESE BARRICADES SHALL BE REMOVED WHEN THE DRIVEWAY RECONSTRUCTION IS COMPLETE.

12' MIN SEE NOTE 1

12' MIN SEE NOTE 1

LEGEND

- PHASE 1 (30 DAYS)
- PHASE 2 (30 DAYS)
- BARRICADES (PHASE 1)
- BARRICADES (PHASE 2)
- HAUL ROUTES
- CONTRACTOR STAGING AREA (CS)

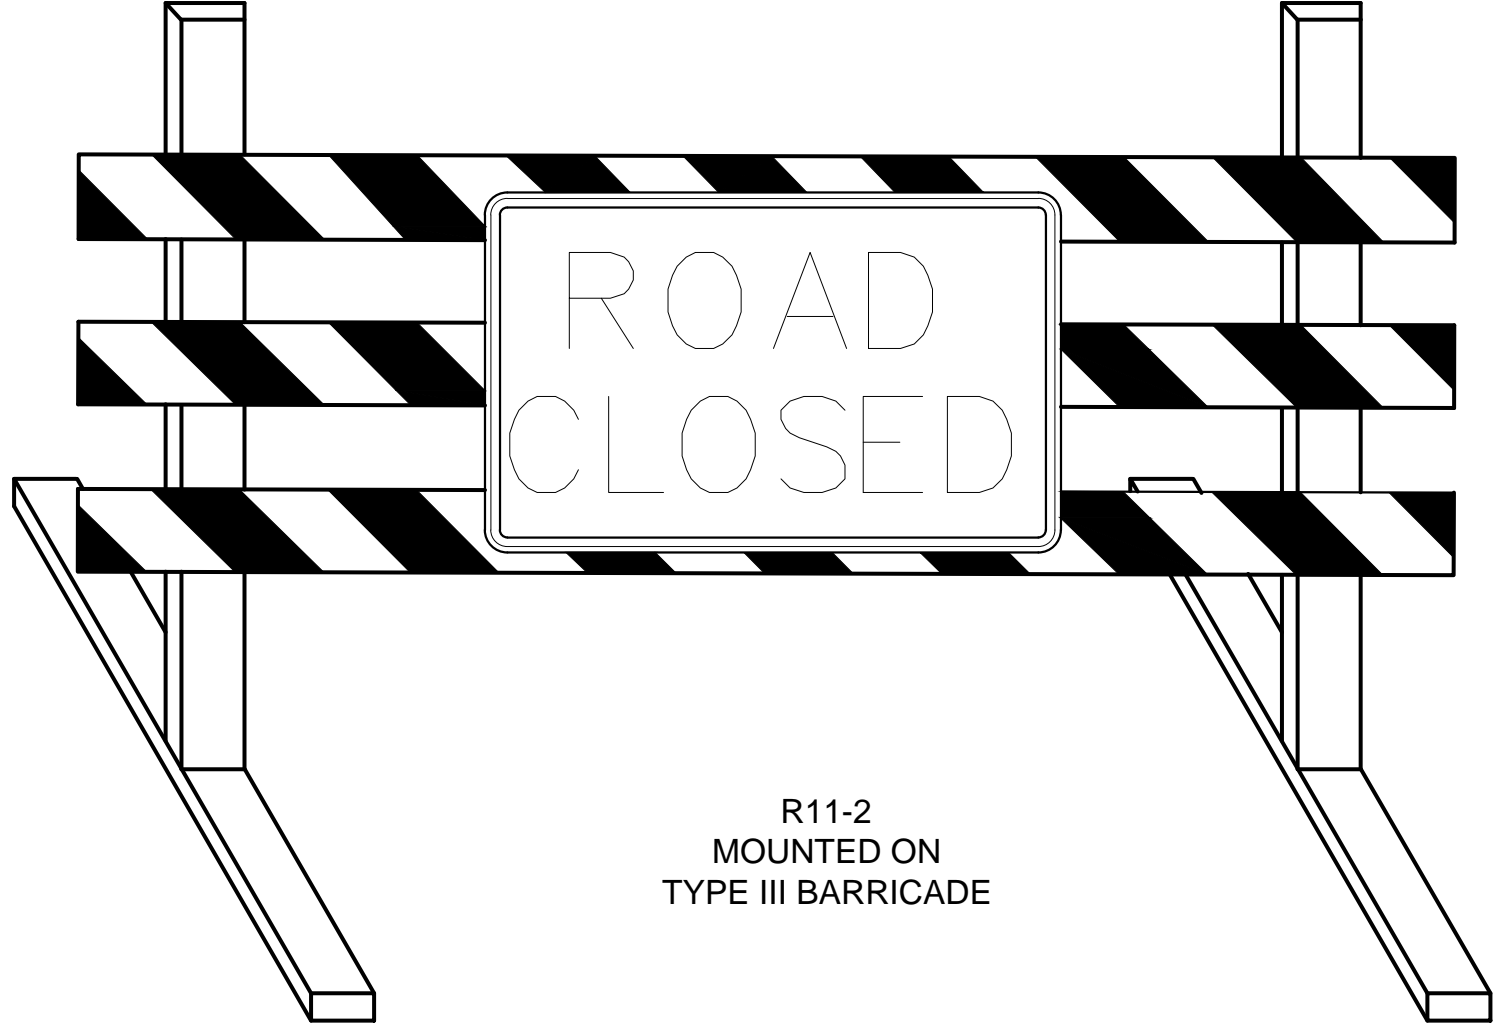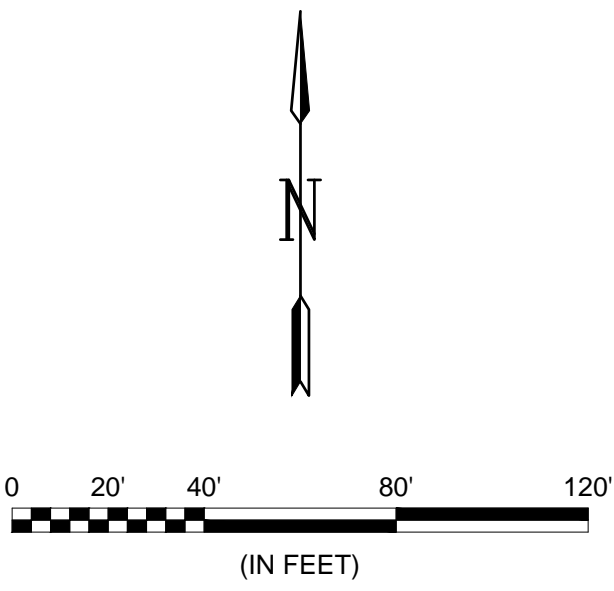

R11-2 MOUNTED ON TYPE III BARRICADE

TRAFFIC CONTROL NOTES

1. THE CONTRACTOR SHALL ENSURE THAT A MINIMUM OF 12' OF USABLE PAVEMENT IS OPEN TO TRAFFIC ON THE DRIVEWAY AT ALL TIME.
2. THE CONTRACTOR IS RESPONSIBLE FOR PLACEMENT AND MAINTENANCE OF ALL NECESSARY BARRICADES AS REQUIRED BY THE TOWN OF ADDISON. CONTRACTOR SHALL PROVIDE, INSTALL, AND MAINTAIN TRAFFIC CONTROL DEVICES IN CONFORMANCE WITH THE 2011 TEXAS MANUAL OF UNIFORM TRAFFIC CONTROL DEVICES (TMUTCD), TEXAS DEPARTMENT OF TRANSPORTATION. SIGNING AND BARRICADING SHALL BE SUBJECT TO INSPECTION BY THE TOWN.
3. NO STOP OR YIELD SIGN IS TO BE RELOCATED OR REMOVED WITHOUT PRIOR APPROVAL BY THE TOWN. THE CONTRACTOR MUST CALL TOWN OF ADDISON TRANSPORTATION DIVISION AND OBTAIN PERMISSION FOR ANY CHANGES IN THESE SIGNS.
4. ACCESS TO ABUTTING PROPERTY DURING THE CONSTRUCTION OF THIS PROJECT MUST BE MAINTAINED FOR EMERGENCY AND LOCAL TRAFFIC AT ALL TIMES, EXCEPT AS OTHERWISE ALLOWED BY THESE PLANS OR BY THE TOWN ENGINEER. CONTRACTOR SHALL SEQUENCE CONSTRUCTION OPERATIONS SUCH THAT ACCESS TO RESIDENTIAL STREETS OUTSIDE THE PROJECT LIMITS ARE OPEN AT ALL TIMES.
5. ALL PERMANENT LANE MARKINGS ARE TO BE INSTALLED PER THE TOWN OF ADDISON STANDARD DETAILS AND PER THE TEXAS MANUAL OF UNIFORM TRAFFIC CONTROL DEVICES.
6. ALL EXISTING CONFLICTING SIGNS SHALL BE COVERED.

CONTRACT TIME

| | CALENDAR DAYS | WORK AVAILABILITY |
|-------------------|---|-------------------|
| PHASE 1 (30 DAYS) | [Bar chart showing 30 days from day 0 to 30] | ANYTIME |
| PHASE 2 (30 DAYS) | [Bar chart showing 30 days from day 30 to 60] | ANYTIME |

PROJECT PHASING NOTES

1. INSTALL BARRICADES SHOWN IN THE PLANS.
2. SWEEP EXISTING PAVEMENT AND PERFORM SURFACE PREPARATION.
3. CONSTRUCT FULL DEPTH RECONSTRUCTION OF DRIVE PAVEMENT.
4. DRAINAGE AND UNDERGROUND UTILITIES WORK SHALL BE PERFORMED WITHIN THEIR INDIVIDUAL PHASES

File: L:\2018\18081100 - ADS On Call Services\Drawings\RECORD\SBAA\ADS-SBA-G203-SP.dwg, Last Save: 1/21/2019 7:02 AM, Last saved by: KKRuhana, Last plotted by: Henderson, James, A, Plot Style: AECmon.ctb, Plot Scale: 1:1, Plot Date: 1/22/2019 3:00 PM, Plotter: usset, AutoCAD PDF (General Documentation).pc3



© 2017 GARVER, LLC. THIS DOCUMENT, ALONG WITH THE IDEAS AND DESIGNS CONVEYED HEREIN, SHALL BE CONSIDERED INSTRUMENTS OF PROFESSIONAL SERVICE AND ARE PROPERTY OF GARVER, LLC. ANY USE, REPRODUCTION, OR DISTRIBUTION OF THIS DOCUMENT, ALONG WITH THE IDEAS AND DESIGN CONTAINED HEREIN, IS PROHIBITED UNLESS AUTHORIZED IN WRITING BY GARVER, LLC OR EXPLICITLY ALLOWED IN THE GOVERNING PROFESSIONAL SERVICES AGREEMENT FOR THIS WORK.

REGISTRATION NO. F-5713

RECORD DRAWINGS 1/22/2019

| REV. | DATE | DESCRIPTION | BY |
|------|------|-------------|----|
| | | | |

ADDISON AIRPORT ADDISON, TEXAS
WING AVIATION APRON CONNECTOR AND CLAIRE CHENNAULT STREET DRIVEWAY RECONSTRUCTION

SAFETY & PHASING PLAN - CLAIRE CHENNAULT STREET DRIVEWAY RECONSTRUCTION (BASE BID 2)


JOB NO.: 17081100
DATE: JAN 2019
DESIGNED BY: JAH
DRAWN BY: JAH

BAR IS ONE INCH ON ORIGINAL DRAWING
IF NOT ONE INCH ON THIS SHEET, ADJUST SCALES ACCORDINGLY.

DRAWING NUMBER G-203

SHEET NUMBER 5

File: L:\2018\18081100 - ADS On Call Services\Drawings\RECORD\SBAAADS-SBA-G301-SC.dwg Last Save: 1/21/2019 7:03 AM Last saved by: KKRuabana
 Last plotted by: Henderson, James_A Plot Style: AECmon.ctb Plot Scale: 1:1 Plot Date: 1/22/2019 3:00 PM Plotter Usert: AutoCAD PDF (General Documentation).pc3

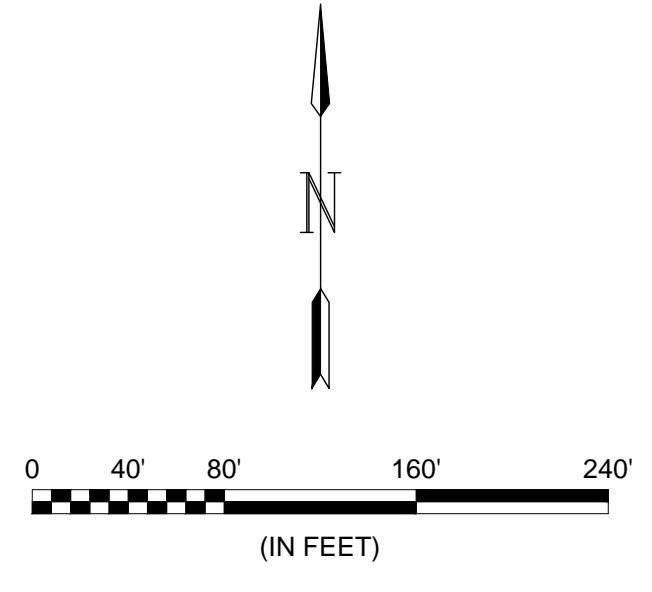

| LEGEND | |
|--------|-----------------------|
| △ X | SURVEY CONTROL POINTS |

| SURVEY CONTROL POINTS | | | | |
|-----------------------|------------|------------|-----------|---------------------------|
| POINT NO. | NORTHING | EASTING | ELEVATION | DESCRIPTION |
| A | 7040415.68 | 2479070.97 | 639.33 | BM/SET SQUARE CUT |
| B | 7041202.84 | 2479082.54 | 637.87 | IRSC/5/8IN PLASTIC YELLOW |
| C | 7041196.28 | 2479233.52 | 638.38 | IRSC/5/8IN PLASTIC YELLOW |
| D | 7041215.45 | 2479331.60 | 639.68 | IRSC/5/8IN PLASTIC YELLOW |
| E | 7041248.78 | 2479436.39 | 640.44 | IRSC/5/8IN PLASTIC YELLOW |
| F | 7041397.75 | 2479489.47 | 639.15 | IRSC/5/8IN PLASTIC YELLOW |
| G | 7041509.86 | 2479595.06 | 639.83 | IRSC/5/8IN PLASTIC YELLOW |
| H | 7041584.78 | 2479727.09 | 640.45 | IRSC/5/8IN PLASTIC YELLOW |
| I | 7041721.00 | 2479788.31 | 641.36 | IRSC/5/8IN PLASTIC YELLOW |
| J | 7041789.10 | 2479917.95 | 641.80 | IRSC/5/8IN PLASTIC YELLOW |
| K | 7041894.98 | 2480022.25 | 642.66 | IRSC/5/8IN PLASTIC YELLOW |

GARVER

© 2017 GARVER, LLC
 THIS DOCUMENT, ALONG WITH THE IDEAS AND DESIGNS CONVEYED HEREIN, SHALL BE CONSIDERED INSTRUMENTS OF PROFESSIONAL SERVICE AND ARE PROPERTY OF GARVER, LLC. ANY USE, REPRODUCTION, OR DISTRIBUTION OF THIS DOCUMENT, ALONG WITH THE IDEAS AND DESIGN CONTAINED HEREIN, IS PROHIBITED UNLESS AUTHORIZED IN WRITING BY GARVER, LLC OR EXPLICITLY ALLOWED IN THE GOVERNING PROFESSIONAL SERVICES AGREEMENT FOR THIS WORK.

REGISTRATION NO. F-5713

RECORD DRAWINGS
 1/22/2019

| REV. | DATE | DESCRIPTION | BY |
|------|------|-------------|----|
| | | | |

ADDISON AIRPORT
 ADDISON, TEXAS
 WING AVIATION APRON CONNECTOR AND CLAIRE CHENNAULT STREET DRIVEWAY RECONSTRUCTION

SURVEY CONTROL PLAN

JOB NO.: 17081100
 DATE: JAN 2019
 DESIGNED BY: JAH
 DRAWN BY: JAH

BAR IS ONE INCH ON ORIGINAL DRAWING
 IF NOT ONE INCH ON THIS SHEET, ADJUST SCALES ACCORDINGLY.

DRAWING NUMBER
G-301
 SHEET NUMBER
6



© 2017 GARVER, LLC
 THIS DOCUMENT, ALONG WITH THE IDEAS AND DESIGNS CONVEYED HEREIN, SHALL BE CONSIDERED INSTRUMENTS OF PROFESSIONAL SERVICE AND ARE PROPERTY OF GARVER, LLC. ANY USE, REPRODUCTION, OR DISTRIBUTION OF THIS DOCUMENT, ALONG WITH THE IDEAS AND DESIGN CONTAINED HEREIN, IS PROHIBITED UNLESS AUTHORIZED IN WRITING BY GARVER, LLC OR EXPLICITLY ALLOWED IN THE GOVERNING PROFESSIONAL SERVICES AGREEMENT FOR THIS WORK.

REGISTRATION NO. F-5713

RECORD DRAWINGS
 1/22/2019

| REV. | DATE | DESCRIPTION | BY |
|------|------|-------------|----|
| | | | |
| | | | |
| | | | |

ADDISON AIRPORT
 ADDISON, TEXAS

WING AVIATION APRON CONNECTOR AND CLAIRE CHENNAULT STREET DRIVEWAY RECONSTRUCTION

EROSION CONTROL PLAN

JOB NO.: 17081100
 DATE: JAN 2019
 DESIGNED BY: JAH
 DRAWN BY: JAH

BAR IS ONE INCH ON ORIGINAL DRAWING
 IF NOT ONE INCH ON THIS SHEET, ADJUST SCALES ACCORDINGLY.

DRAWING NUMBER
G-401

SHEET NUMBER
7



LEGEND

- CONCRETE WASHOUT
- CONSTRUCTION EXIT
- DRAINAGE STRUCTURE PROTECTION*

NOTES:

* DRAINAGE STRUCTURE PROTECTION CONSISTS OF INSTALLING EROSION CONTROL LOG AROUND EACH STRUCTURE, UNLESS OTHERWISE NOTED.

THE CONTRACTOR SHALL PROTECT THE PROPOSED DRAINAGE STRUCTURES AFTER INSTALLATION USING THESE PROTECTIONS OR OTHER APPROVED METHODS.

TAXIWAY ALPHA


INSTALL INLET PROTECTION

INSTALL INLET PROTECTION

INSTALL INLET PROTECTION

INSTALL INLET PROTECTION

File: L:\2018\18081100 - ADS On Call Services\Drawings\RECORD\SBAAADS-SBA-G401-SP.dwg, Last Save: 1/21/2019 7:03 AM, Last saved by: KKRutahana
 Last plotted by: Henderson, James, A, Plot Style: AECmono.ctb, Plot Scale: 1:1, Plot Date: 1/22/2019 3:01 PM, Plotter used: AutoCAD PDF (General Documentation).pc3

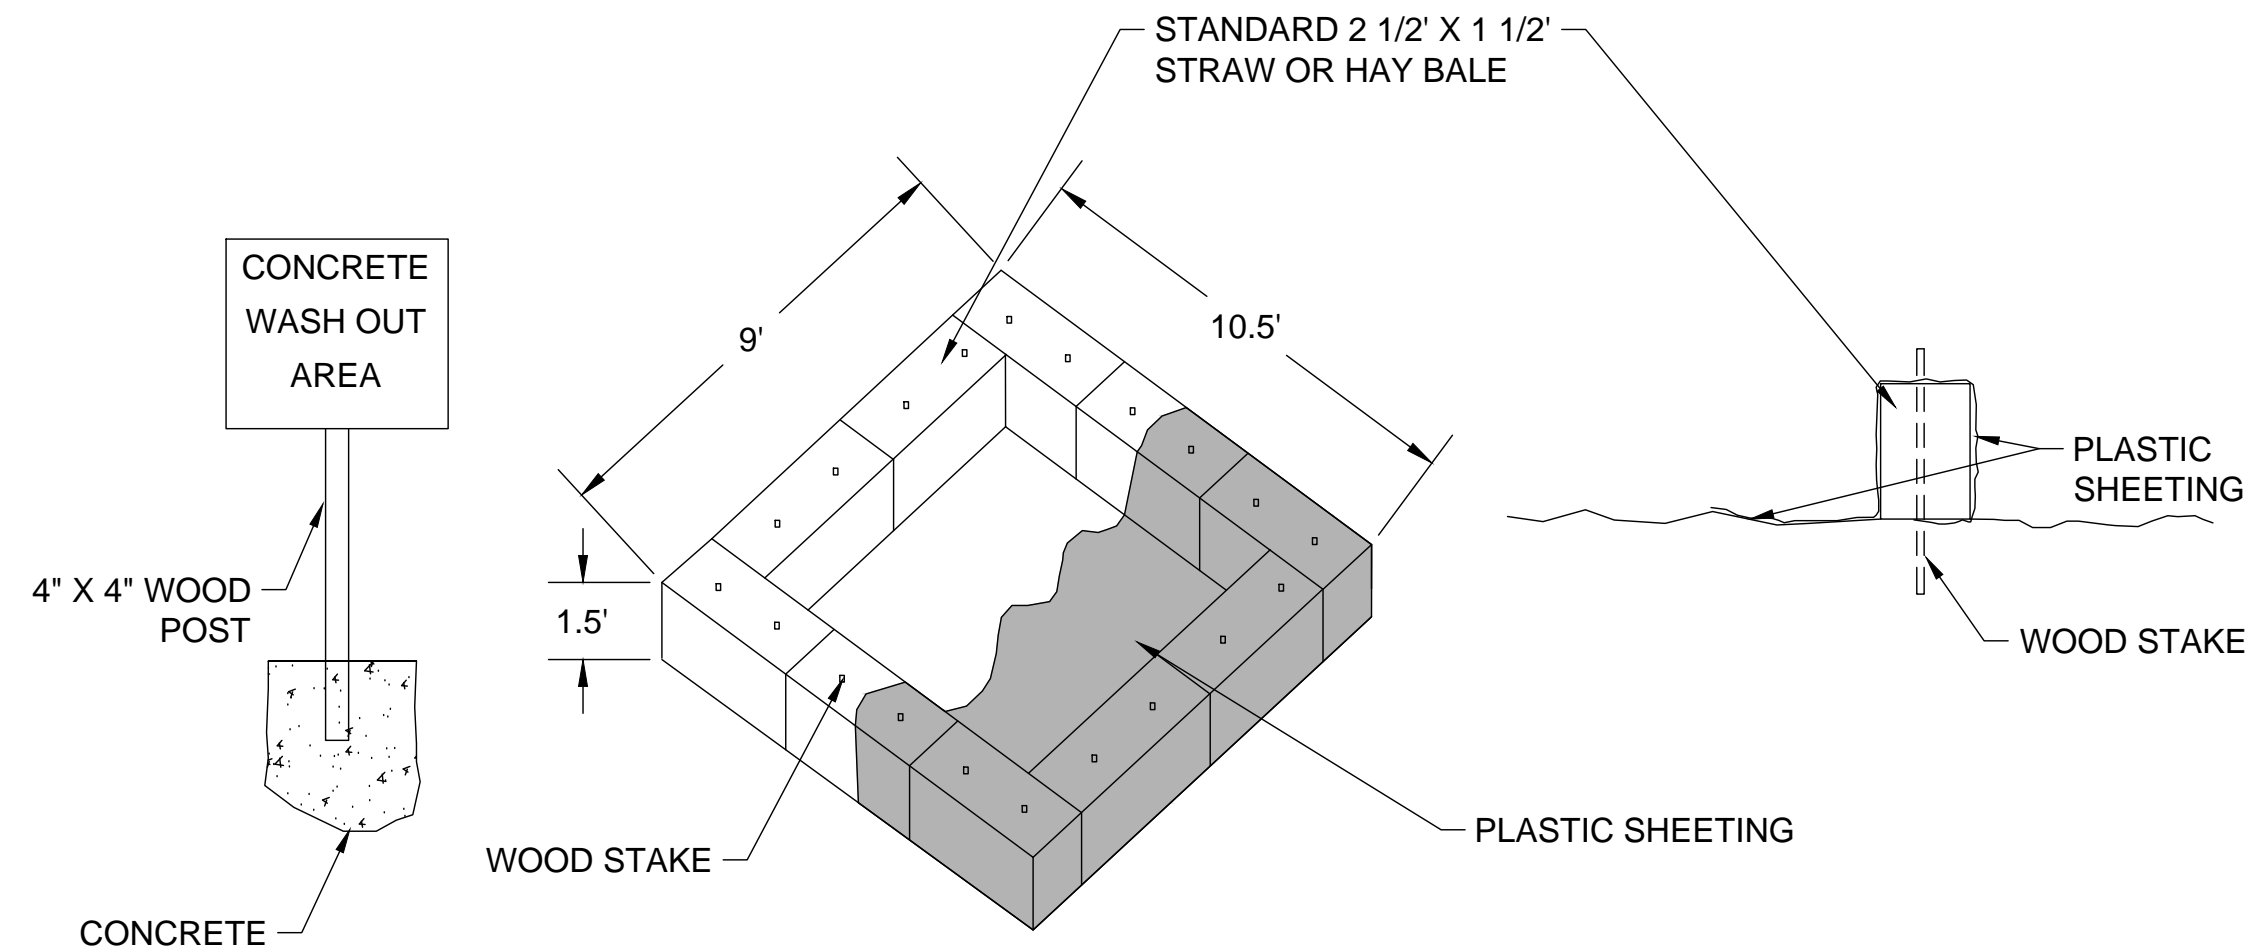


1 CONCRETE WASH OUT AREA
G-402 SCALE: NONE

NOTES:


1. PLASTIC MUST BE 10 MIL THICK OR TWO 6 MIL PIECES OVERLAPPED.
2. ONCE CONCRETE DRIES, IT CAN BE ROLLED UP IN THE PLASTIC.
3. HAY BALES MUST BE STAKED WITH STAKED HOLDING PLASTIC LINER IN PLACE AND COVER ALL BALES. WOODEN STAKES MUST BE 3 FEET IN LENGTH.
4. IT IS THE RESPONSIBILITY OF THE CONTRACTOR TO ESTABLISH A WASH OUT AREA.
5. THE CONCRETE TRUCK DRIVER AND CONTRACTOR CAN BE CITED FOR WASH OUTS CONDUCTED IN A NON-DESIGNATED AREA.
6. AFTER THE DESIGNATED AREA FOR THE WASH OUT IS DETERMINED, SIGNAGE INDICATING CONCRETE WASH OUT AREA SHALL BE INSTALLED THAT IS VISIBLE TO EXITING VEHICLES. THE SIGN SHALL BE PLACED ON A WOOD POST AND ANCHORED IN CONCRETE.

EROSION CONTROL NOTES:

1. THE CONTRACTOR IS RESPONSIBLE FOR THE PROPER INSTALLATION OF THESE DEVICES AS SHOWN ON THIS SHEET, AND DESCRIBED IN THE SPECIFICATIONS. ADDITIONAL EROSION CONTROL AND/OR ADJUSTMENT OF LOCATIONS FOR EROSION CONTROL MAY BE REQUIRED.
2. SILT FENCES, DITCH CHEXX, INLET FILTERS AND INLET FILTER BARRIERS SHALL BE INSTALLED PER MANUFACTURER RECOMMENDATIONS AND ACCORDING TO THESE PLANS.
3. EACH CONTRACTOR SHALL BE RESPONSIBLE FOR MAINTAINING ALL EROSION CONTROL DEVICES ALREADY IN PLACE. CONTRACTOR SHALL REMOVE AND REPLACE EROSION CONTROL AS NEEDED FOR CONSTRUCTION OR ACCESS. ALL EROSION CONTROL MUST BE IN PLACE AT ALL TIMES DURING CONSTRUCTION.
4. IT SHALL BE THE CONTRACTOR'S RESPONSIBILITY TO USE WHATEVER MEANS NECESSARY TO CONTROL AND LIMIT SILT AND SEDIMENT LEAVING THE SITE. SPECIFICALLY, THE CONTRACTOR SHALL PROTECT ALL TAXIWAYS, TAXILANES, PARKING AREAS, STREAMS, CREEKS, STORM DRAIN SYSTEMS AND INLETS FROM EROSION DEPOSITS.

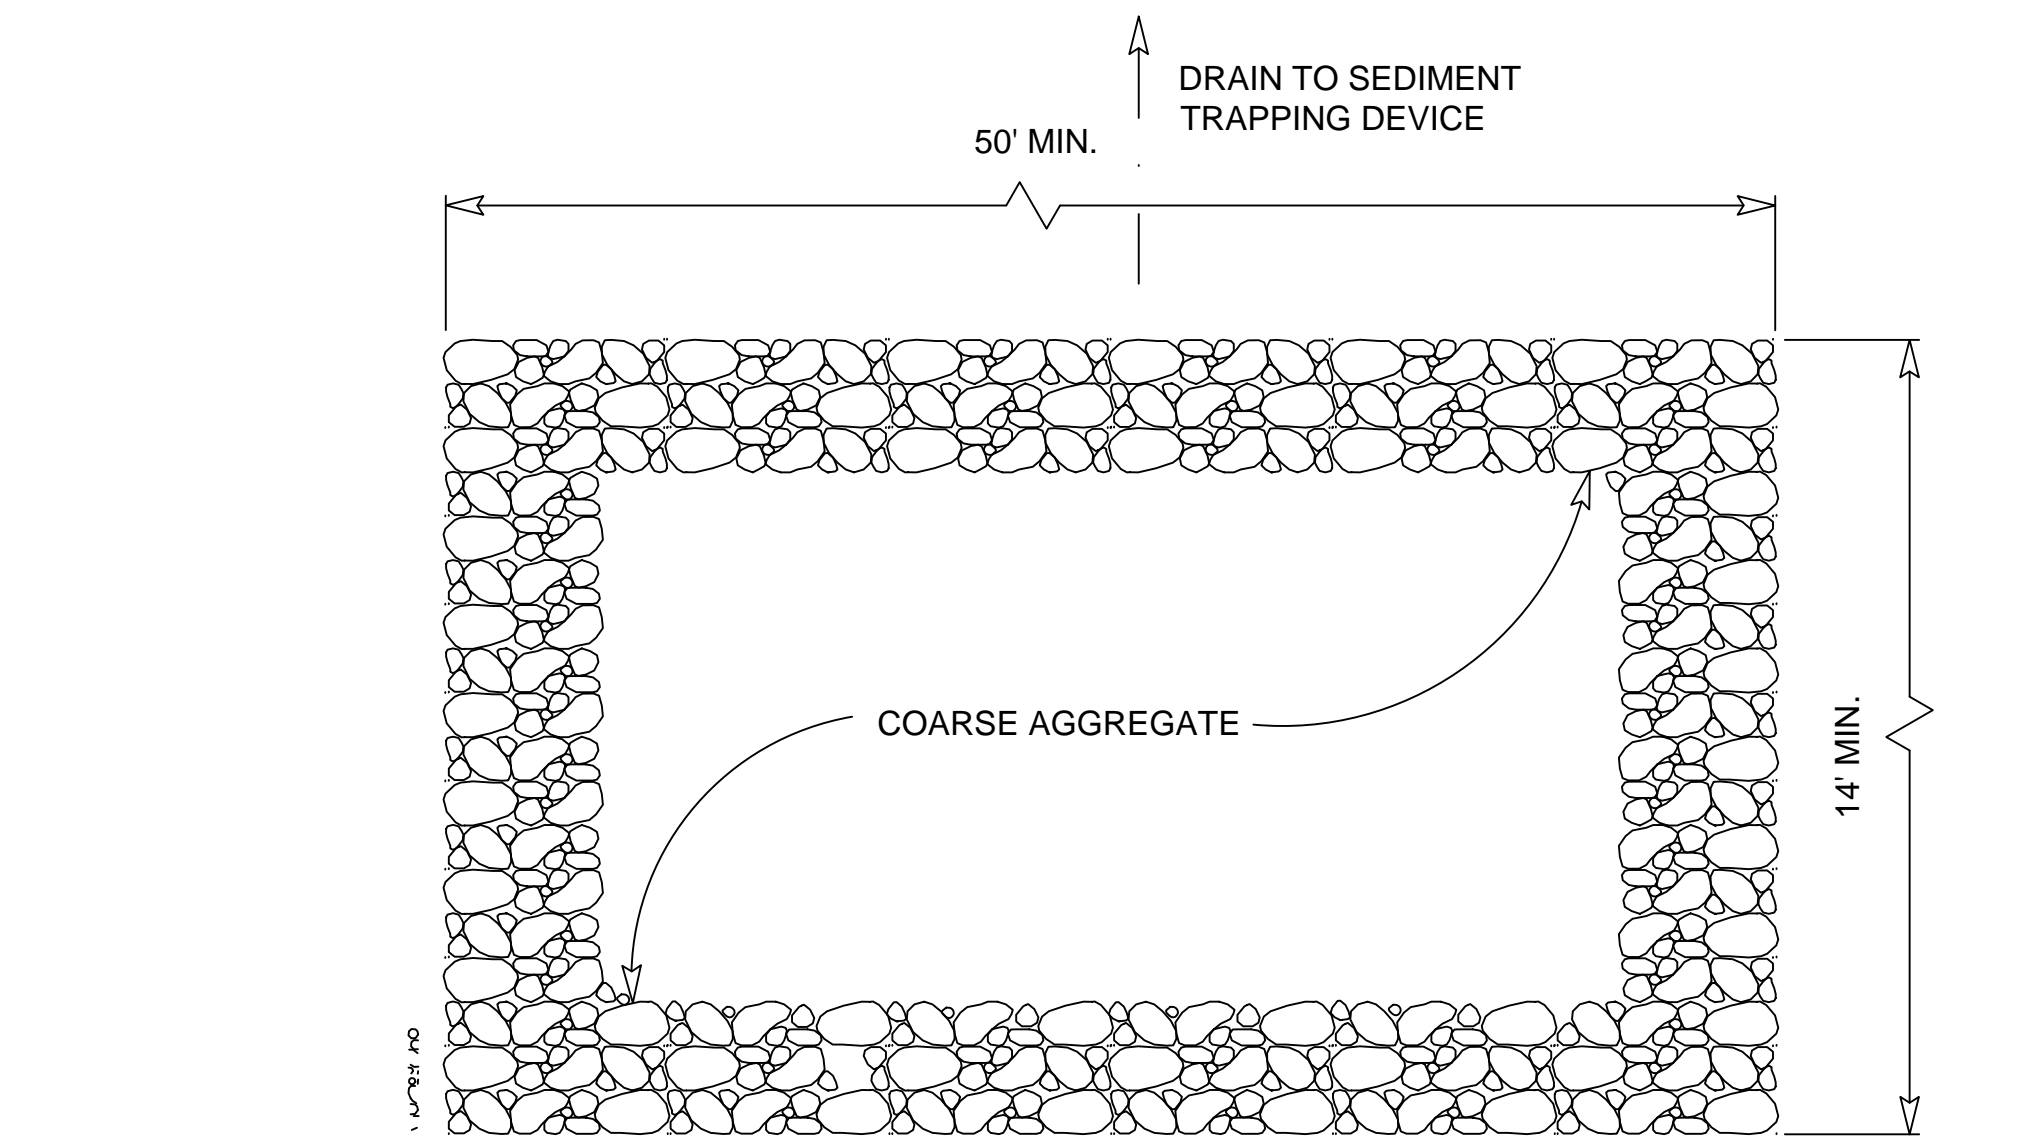

2A PLAN
G-402 SCALE: NONE

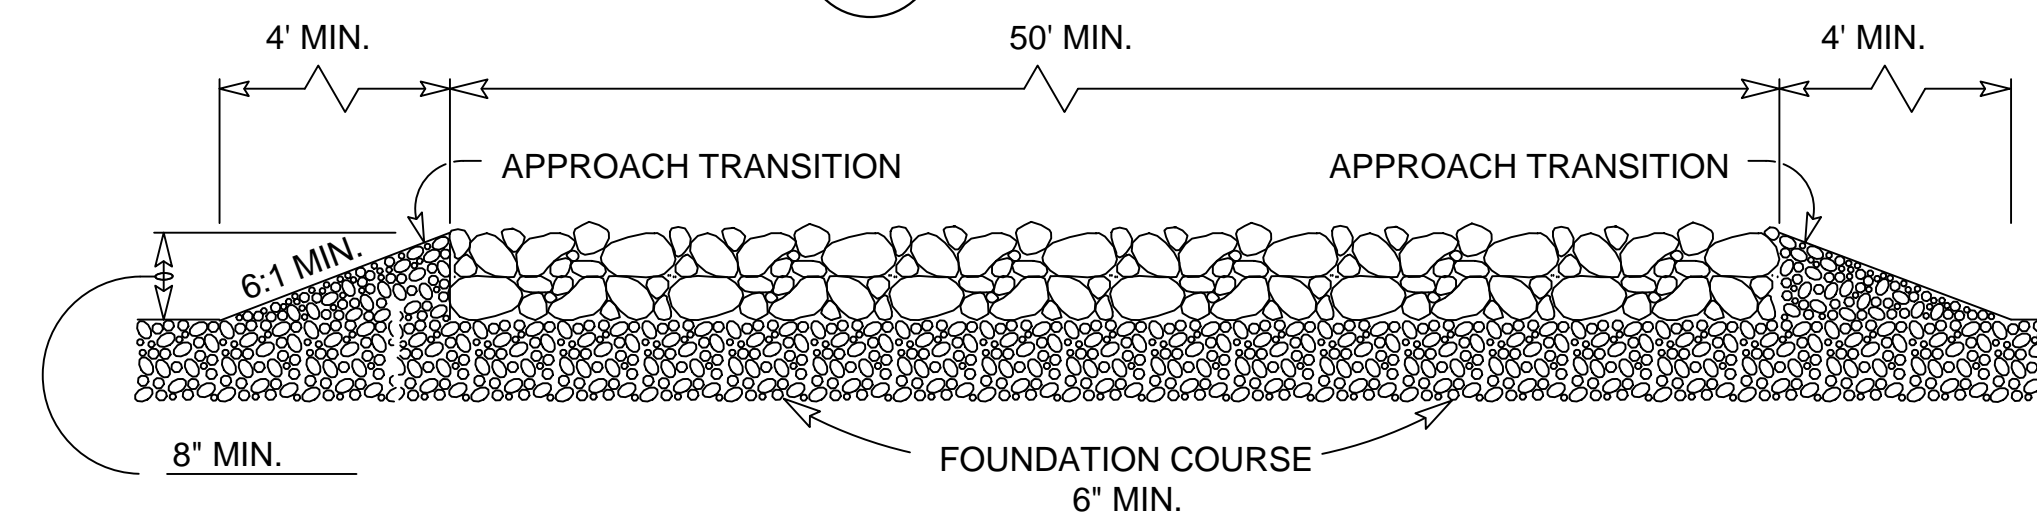

2B PROFILE
G-402 SCALE: NONE

2 CONSTRUCTION EXIT (TYPE 1)
G-402 SCALE: NONE

GENERAL NOTES:

1. THE LENGTH OF THE TYPE 1 CONSTRUCTION EXIT SHALL BE AS INDICATED ON THE PLANS, BUT NOT LESS THAN 50'.
2. THE COARSE AGGREGATE SHOULD BE OPEN GRADED WITH A SIZE OF 4" TO 8".
3. THE APPROACH TRANSITIONS SHOULD BE NO STEEPER THAN 6:1 AND CONSTRUCTED AS DIRECTED BY THE ENGINEER.
4. THE CONSTRUCTION EXIT FOUNDATION COURSE SHALL BE FLEXIBLE BASE, BITUMINOUS CONCRETE, PORTLAND CEMENT CONCRETE OR OTHER MATERIAL AS APPROVED BY THE ENGINEER.
5. THE CONSTRUCTION EXIT SHALL BE GRADED TO ALLOW DRAINAGE TO A SEDIMENT TRAPPING DEVICE.
6. THE GUIDELINES SHOWN HEREON ARE SUGGESTIONS AND MAY BE MODIFIED BY THE ENGINEER.



© 2017 GARVER, LLC
THIS DOCUMENT, ALONG WITH THE IDEAS AND DESIGNS CONVEYED HEREIN, SHALL BE CONSIDERED INSTRUMENTS OF PROFESSIONAL SERVICE AND ARE PROPERTY OF GARVER, LLC. ANY USE, REPRODUCTION, OR DISTRIBUTION OF THIS DOCUMENT, ALONG WITH THE IDEAS AND DESIGN CONTAINED HEREIN, IS PROHIBITED UNLESS AUTHORIZED IN WRITING BY GARVER, LLC OR EXPLICITLY ALLOWED IN THE GOVERNING PROFESSIONAL SERVICES AGREEMENT FOR THIS WORK.

REGISTRATION NO. F-5713

RECORD DRAWINGS
1/22/2019

| REV. | DATE | DESCRIPTION | BY |
|------|------|-------------|----|
| | | | |
| | | | |
| | | | |

ADDISON AIRPORT
ADDISON, TEXAS

ADDISON AIRPORT

WING AVIATION APRON CONNECTOR AND CLAIRE CHENNAULT STREET DRIVEWAY RECONSTRUCTION

EROSION CONTROL DETAILS I

JOB NO.: 17081100
DATE: JAN 2019
DESIGNED BY: JAH
DRAWN BY: JAH

BAR IS ONE INCH ON ORIGINAL DRAWING
IF NOT ONE INCH ON THIS SHEET, ADJUST SCALES ACCORDINGLY.

DRAWING NUMBER
G-402

SHEET NUMBER
8

File: L:\2018\18081100 - ADS On Call Services\Drawings\RECORDS\BA\ADS-SBA-G401-SP.dwg, Last Save: 1/21/2019 7:03 AM, Last saved by: KKRuhana
 Last plotted by: Henderson, James, A Plot Style: AECmon.ctb Plot Scale: 1:1 Plot Date: 1/22/2019 3:01 PM Plotter used: AutoCAD PDF (General Documentation).pc3



© 2017 GARVER, LLC
 THIS DOCUMENT, ALONG WITH THE IDEAS AND DESIGNS CONVEYED HEREIN, SHALL BE CONSIDERED INSTRUMENTS OF PROFESSIONAL SERVICE AND ARE PROPERTY OF GARVER, LLC. ANY USE, REPRODUCTION, OR DISTRIBUTION OF THIS DOCUMENT, ALONG WITH THE IDEAS AND DESIGN CONTAINED HEREIN, IS PROHIBITED UNLESS AUTHORIZED IN WRITING BY GARVER, LLC OR EXPLICITLY ALLOWED IN THE GOVERNING PROFESSIONAL SERVICES AGREEMENT FOR THIS WORK.

REGISTRATION NO. F-5713

RECORD DRAWINGS
 1/22/2019

| REV. | DATE | DESCRIPTION | BY |
|------|------|-------------|----|
| | | | |
| | | | |
| | | | |

ADDISON AIRPORT
 ADDISON, TEXAS
 WING AVIATION APRON CONNECTOR
 AND CLAIRE CHENNAULT STREET
 DRIVEWAY RECONSTRUCTION


EROSION CONTROL
 DETAILS II

JOB NO.: 17081100
 DATE: JAN 2019
 DESIGNED BY: JAH
 DRAWN BY: JAH


BAR IS ONE INCH ON ORIGINAL DRAWING
 IF NOT ONE INCH ON THIS SHEET, ADJUST SCALES ACCORDINGLY.

DRAWING NUMBER
G-403


SHEET NUMBER
9

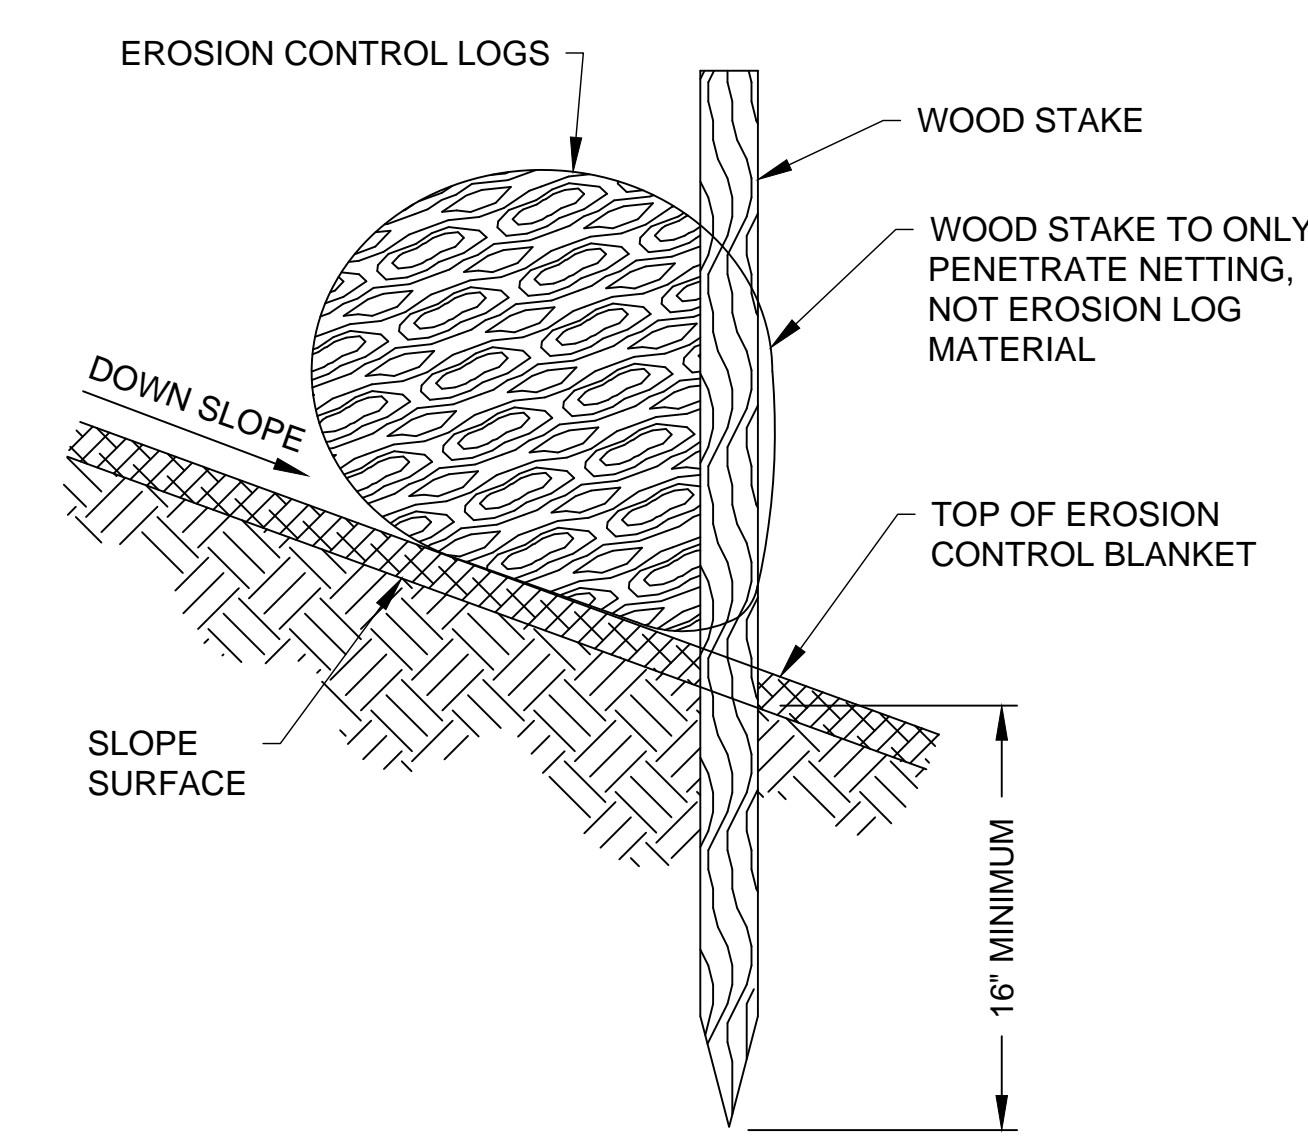


G-403 1A INSTALLATION WITH BLANKET
 SCALE: NONE

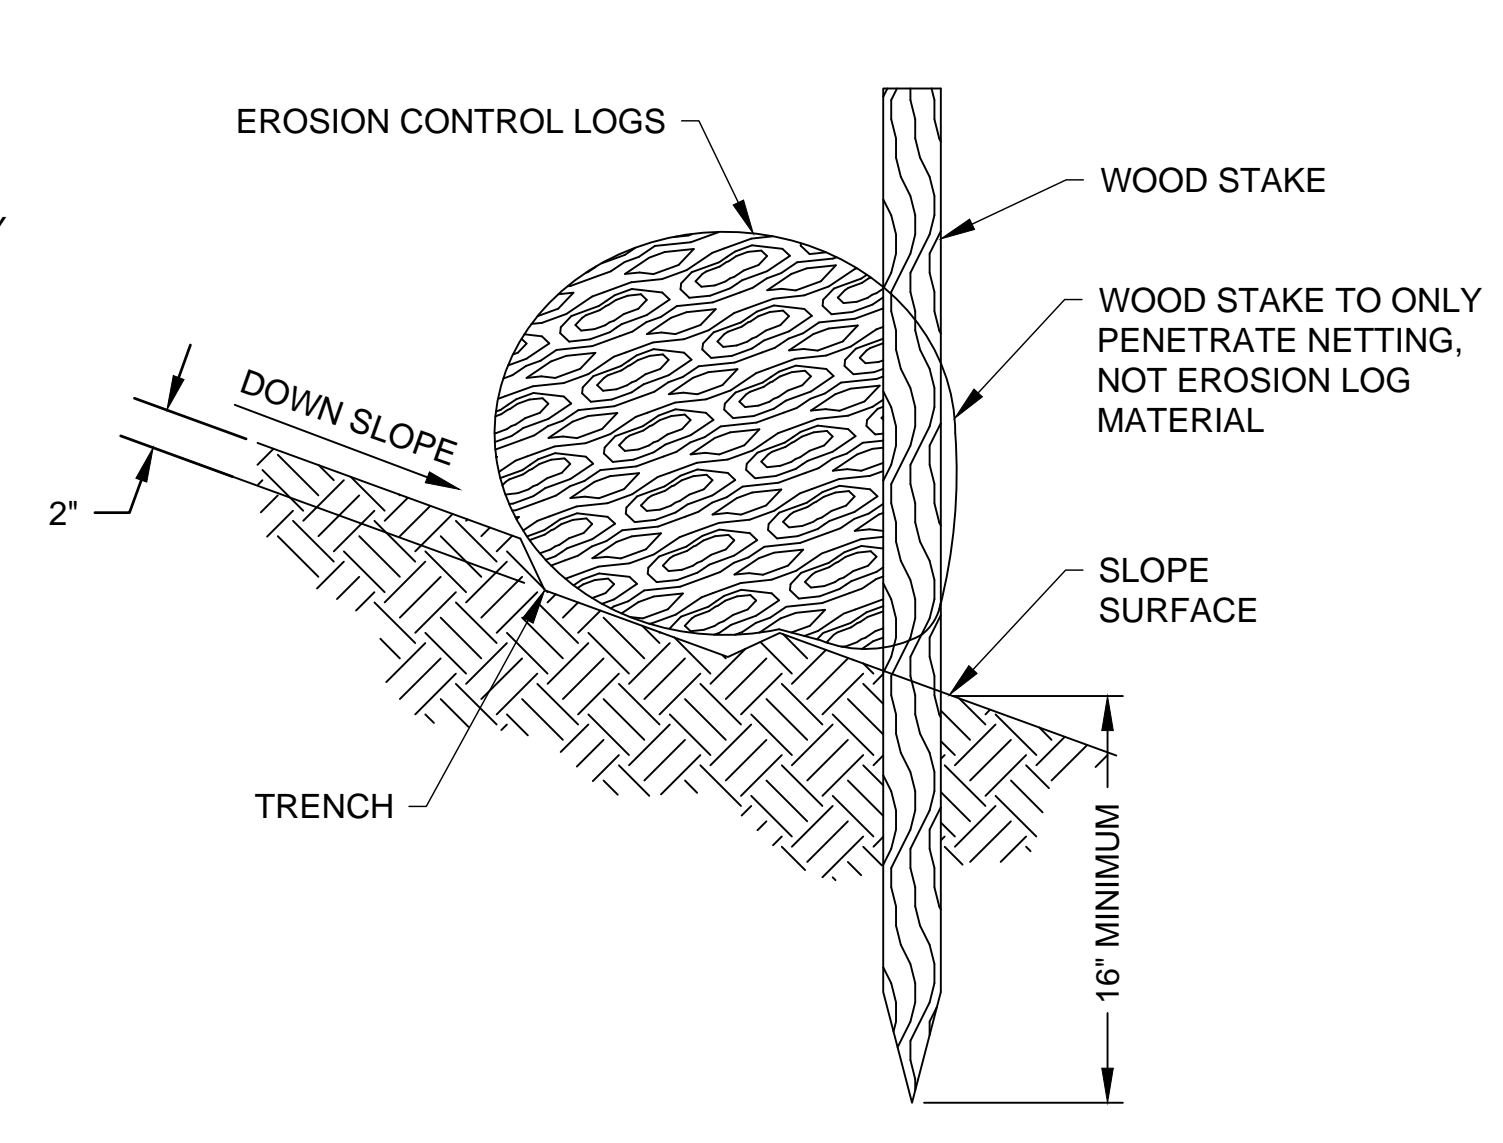

G-403 1B INSTALLATION WITH TRENCH
 SCALE: NONE

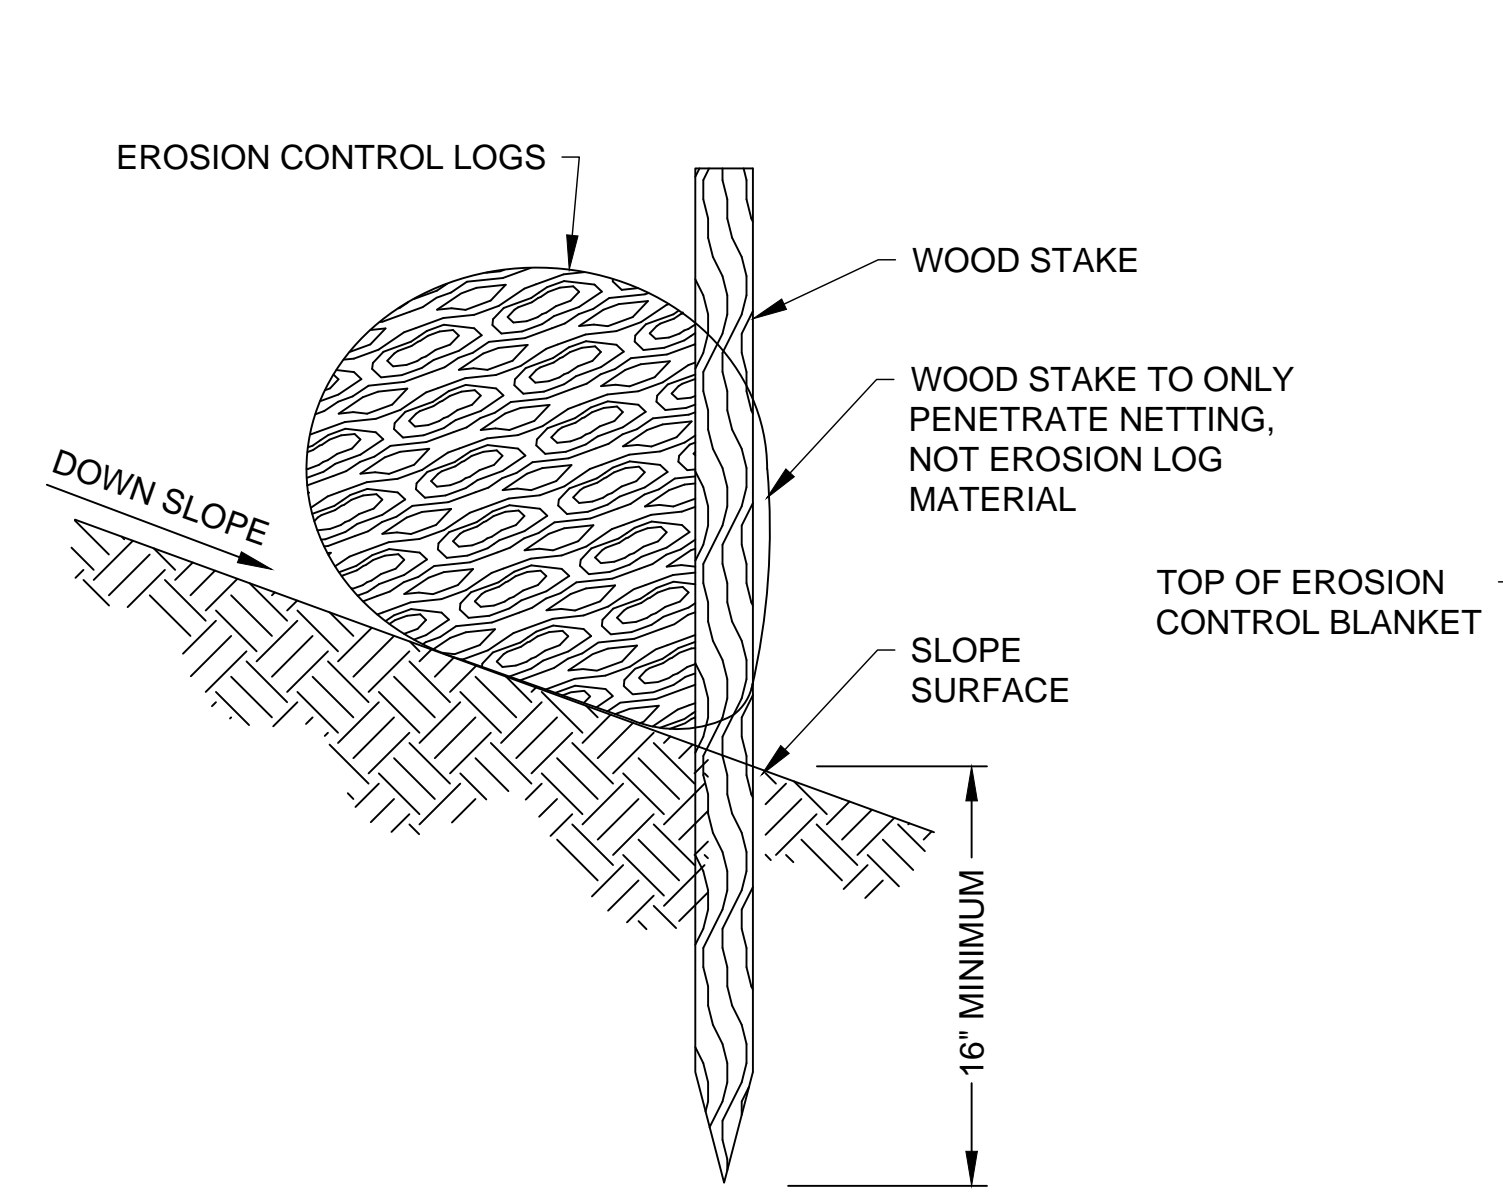

G-403 1C INSTALLATION ON BARE SOIL
 SCALE: NONE

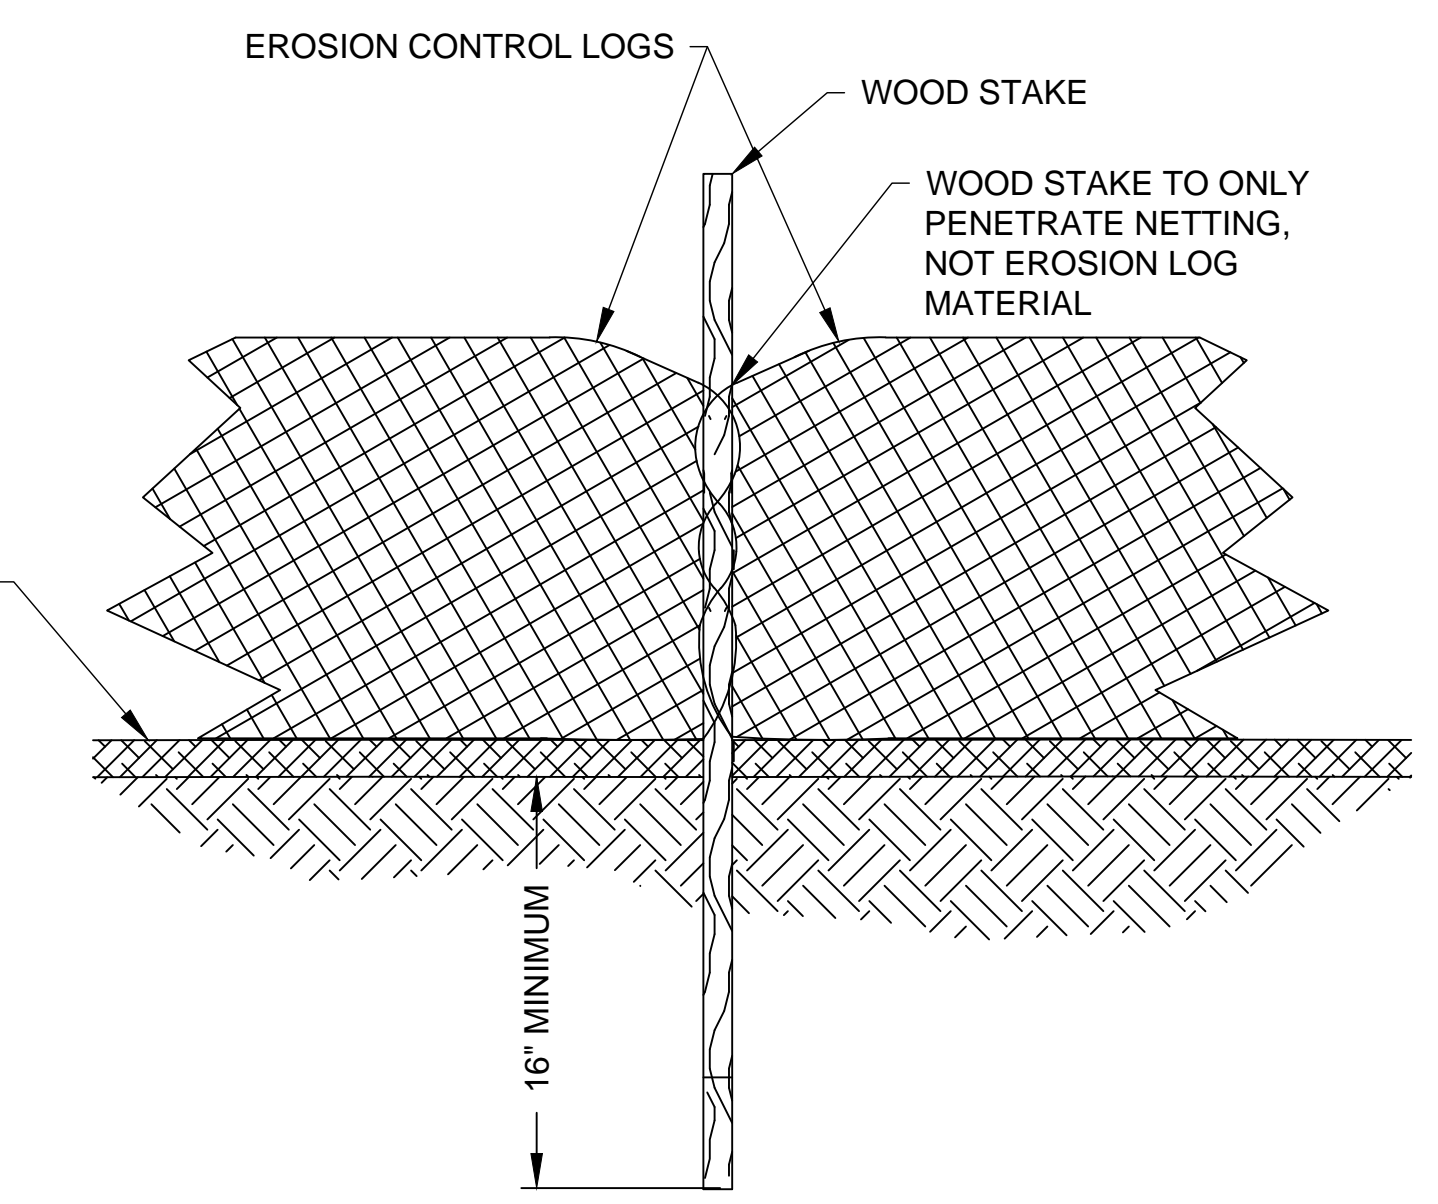

G-403 1D INSTALLATION DETAILS (FRONT VIEW)
 SCALE: NONE

G-403 1 TEMPORARY EROSION CONTROL LOG
 SCALE: NONE

NOTE:
 TRENCH OPTION IS MOST APPLICABLE IN LOOSE, UNCONSOLIDATED SOILS.
 1-1/8" X 1-1/8" X 30" WOODEN STAKES ARE RECOMMENDED FOR 6", 9", AND 12" SEDIMENT LOGS.
 1-1/8" X 1-1/8" X 48" WOODEN STAKES ARE RECOMMENDED FOR 20" SEDIMENT LOGS.

Site Description

PROJECT LIMITS: Addison Airport, Addison, TX

PROJECT DESCRIPTION: Improvements of the Northwest drainage ditch condition.

MAJOR SOIL DISTURBING ACTIVITIES: Installation of slope protection around existing drainage ditch as well as construction of a new drainage ditch section.

TOTAL PROJECT AREA: 1.91 ACRES

TOTAL AREA TO BE DISTURBED: 1.91 ACRES

WEIGHTED RUNOFF COEFFICIENT (AFTER CONSTRUCTION): 0.9

EXISTING CONDITON OF SOIL & VEGETATIVE COVER AND % OF EXISTING VEGETATIVE COVER: The existing cover is clayey with Bermuda grass and is in fair condition. Existing vegetative cover is at 85%

NAME OF RECEIVING WATERS: The Addison airport is in the Hutton Branch watershed and the receiving water is Elm Fork Trinity River.

SOIL STABILIZATION PRACTICES:

- TEMPORARY SEEDING
- PERMANENT PLANTING, SODDING, OR SEEDING
- MULCHING
- SOIL RETENTION BLANKET
- BUFFER ZONES
- PRESERVATION OF NATURAL RESOURCES

OTHER: _____

STRUCTURAL PRACTICES:

- SILT FENCES
- HAY BALES
- ROCK BERMS
- DIVERSION, INTERCEPTOR, OR PERIMETER DIKES
- DIVERSION, INTERCEPTOR, OR PERIMETER SWALES
- DIVERSION DIKE AND SWALE COMBINATIONS
- PIPE SLOPE DRAINS
- PAVED FLUMES
- ROCK BEDDING AT CONSTRUCTION EXIT
- TIMBER MATTING AT CONSTRUCTION EXIT
- CHANNEL LINERS
- SEDIMENT TRAPS
- SEDIMENT BASINS
- STORM INLET SEDIMENT TRAP
- STONE OUTLET STRUCTURES
- CURBS AND GUTTERS
- STORM SEWERS
- VELOCITY CONTROL DEVICES

OTHER: CONCRETE WASHOUT

NARRATIVE – SEQUENCE OF CONTRUSTION (STORM WATER MANAGEMENT) ACTIVITIES:

Erosion and sediment controls shall be installed at the beginning of the project. Once installed, these devices will be maintained during the duration of the project. Erosion and sediment controls will be removed at the project's completion.

STORM WATER MANAGEMENT: Existing storm sewers and drainage ditches will be used to remove water from the site. Storm water from the site will flow through rock filter dams to filter sediment from storm water runoff before it leaves the site.

OTHER EROSION AND SEDIMENT CONTROLS

MAINTENANCE:

ALL EROSION AND SEDIMENT CONTROLS WILL BE MAINTAINED IN GOOD WORKING ORDER. IF A REPAIR IS NECESSARY, IT WILL BE DONE AT THE EARLIEST DATE POSSIBLE, BUT NO LATER THAN 7 CALENDAR DAYS AFTER THE SURROUNDING EXPOSED GROUND HAS DRIED SUFFICIENTLY TO PREVENT DAMAGE FROM HEAVY EQUIPMENT. THE AREAS ADJACENT TO CREEKS AND DRAINAGE WAYS SHALL HAVE PRIORITY FOLLOWED BY DEVICES USED FOR SILT REDUCTION IN THE DISTURBED AREAS.

INSPECTION:

AN INSPECTION WILL BE PERFORMED BY A RESIDENT PROJECT REPRESENTATIVE EVERY 7 DAYS AN INSPECTION REPORT WILL BE MADE PER EACH INSPECTION. BASED ON THE INSPECTION RESULTS, THE CONTROLS SHALL BE REVISED PER THE INSPECTION REPORT.

WASTE MATERIALS:

ALL WASTE MATERIALS WILL BE COLLECTED AND STORED IN A SECURELY LIDDED METAL DUMPSTER. THE DUMPSTER WILL MEET ALL STATE AND LOCAL SOLID WASTE MANAGEMENT REGULATIONS. ALL TRASH AND CONSTRUCTION DEBRIS FROM THE SITE WILL BE DEPOSITED IN THE DUMPSTER. THE DUMPSTER WILL BE EMPTIED AS NECESSARY OR AS REQUIRED BY LOCAL REGULATION AT AN APPROVED LANDFILL. NO CONSTRUCTION WASTE MATERIAL WILL BE BURIED ON SITE.

HAZARDOUS WASTE (INCLUDING SPILL REPORTING):

AT A MINIMUM, ANY PRODUCTS IN THE FOLLOWING CATEGORIES ARE CONSIDERED TO BE HAZARDOUS: PAINTS ACIDS FOR CLEANING MASONRY SURFACES, CLEANING SOLVENTS, ASPHALT PRODUCTS, CHEMICAL ADDITIVES FOR SOIL STABILIZATION, AND CONCRETE CURING COMPOUNDS AND ADDITIVES. IN THE EVENT OF A SPILL WHICH MAY BE HAZARDOUS, THE SPILL COORDINATOR SHOULD BE CONTACTED IMMEDIATELY.

SANITARY WASTE:

ALL SANITARY WASTE WILL BE COLLECTED FROM THE PORTABLE UNITS BY A LICENSED SANITARY WASTE MANAGEMENT CONTRACTOR AS NECESSARY OR AS REQUIRED BY LOCAL REGULATION.

OFFSITE VEHICLE TRACKING:

- HAUL ROADS DAMPENED FOR DUST CONTROL
- LOADED HAUL TRUCKS TO BE COVERED WITH TARPULIN
- EXCESS DIRT ON ROAD REMOVED DAILY
- STABILIZED CONSTRUCTION ENTRANCE

OTHER:

REMARKS:

DISPOSAL AREAS, STOCKPILES, AND HAUL ROADS SHALL BE CONSTRUCTED IN A MANNER THAT WILL MINIMIZE AND CONTROL THE AMOUNT OF SEDIMENT THAT MAY ENTER RECEIVING WATERS. DISPOSAL AREAS SHALL NOT BE LOCATED IN ANY WETLANDS, WATERBODY OR STREAMBED. CONSTRUCTION STAGING AREAS AND VEHICLE MAINTENANCE AREAS SHALL BE CONSTRUCTED BY THE CONTRACTOR IN A MANNER TO MINIMIZE THE RUNOFF OF POLLUTANTS. ALL WATERWAYS SHALL BE CLEARED AS SOON AS PRACTICAL OF TEMPORARY EMBANKMENT, TEMPORARY BRIDGES, MATTING, FALSE WORK, PILING, DEBRIS OR OTHER OBSTRUCTIONS PAGED DURING CONSTRUCTION OPERATION THAT ARE NOT A PART OF THE FINISHED WORK.



© 2017 GARVER, LLC
THIS DOCUMENT, ALONG WITH THE IDEAS AND DESIGNS CONVEYED HEREIN, SHALL BE CONSIDERED INSTRUMENTS OF PROFESSIONAL SERVICE AND ARE PROPERTY OF GARVER, LLC. ANY USE, REPRODUCTION, OR DISTRIBUTION OF THIS DOCUMENT, ALONG WITH THE IDEAS AND DESIGN CONTAINED HEREIN, IS PROHIBITED UNLESS AUTHORIZED IN WRITING BY GARVER, LLC OR EXPLICITLY ALLOWED IN THE GOVERNING PROFESSIONAL SERVICES AGREEMENT FOR THIS WORK.

REGISTRATION NO. F-5713

RECORD DRAWINGS
1/22/2019

| REV. | DATE | DESCRIPTION | BY |
|------|------|-------------|----|
| | | | |
| | | | |
| | | | |

ADDISON AIRPORT
ADDISON, TEXAS

WING AVIATION APRON CONNECTOR AND CLAIRE CHENNAULT STREET DRIVEWAY RECONSTRUCTION

EROSION CONTROL NOTES

JOB NO.: 17081100
DATE: JAN 2019
DESIGNED BY: JAH
DRAWN BY: JAH

BAR IS ONE INCH ON ORIGINAL DRAWING
IF NOT ONE INCH ON THIS SHEET, ADJUST SCALES ACCORDINGLY.

DRAWING NUMBER
G-404


SHEET NUMBER
10




© 2017 GARVER, LLC
 THIS DOCUMENT, ALONG WITH THE IDEAS AND DESIGNS CONVEYED HEREIN, SHALL BE CONSIDERED INSTRUMENTS OF PROFESSIONAL SERVICE AND ARE PROPERTY OF GARVER, LLC. ANY USE, REPRODUCTION, OR DISTRIBUTION OF THIS DOCUMENT, ALONG WITH THE IDEAS AND DESIGN CONTAINED HEREIN, IS PROHIBITED UNLESS AUTHORIZED IN WRITING BY GARVER, LLC OR EXPLICITLY ALLOWED IN THE GOVERNING PROFESSIONAL SERVICES AGREEMENT FOR THIS WORK.

REGISTRATION NO. F-5713

RECORD DRAWINGS
 1/22/2019

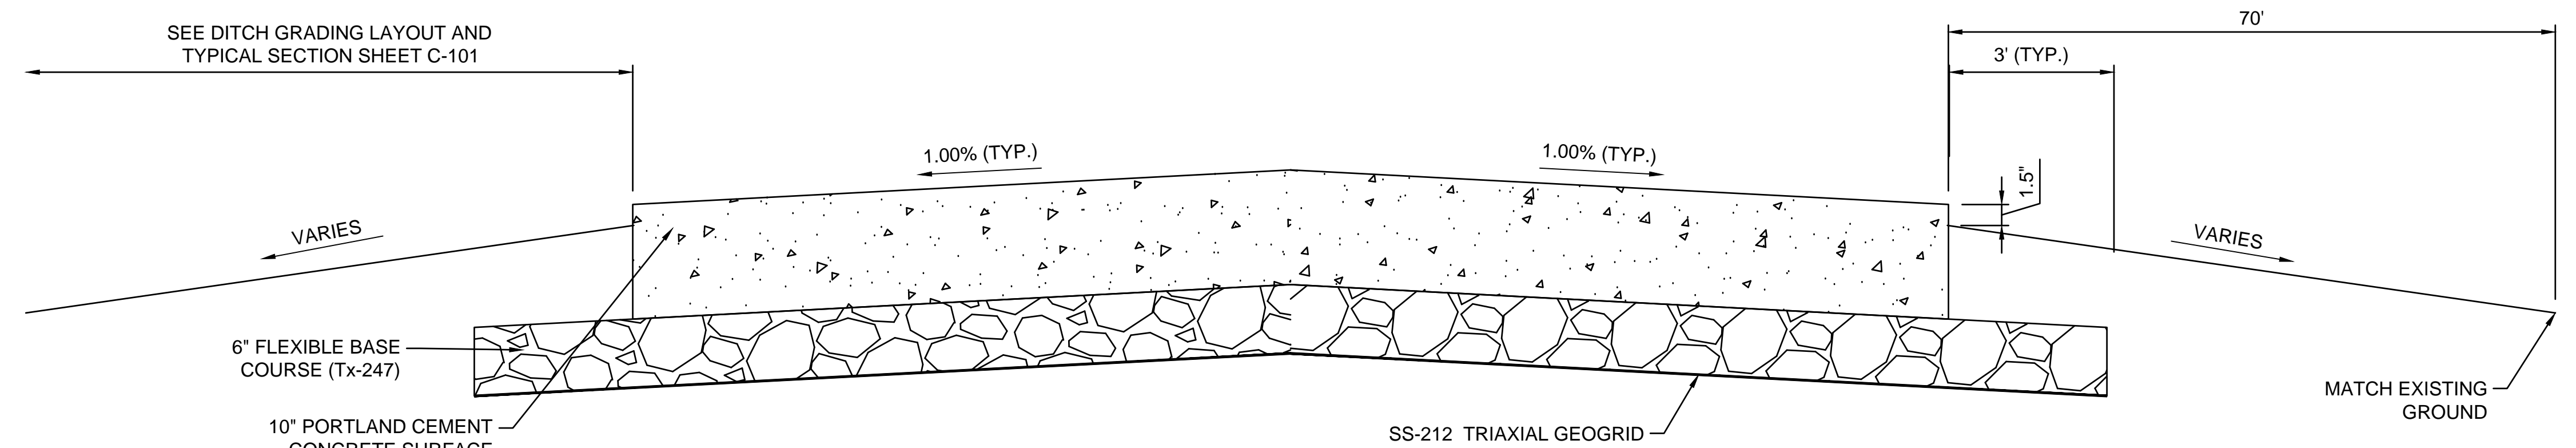


A WING AVIATION APRON CONNECTOR TYPICAL SECTION
 C-100 SCALE: NONE
 *SEE PAVING LAYOUT SHEET

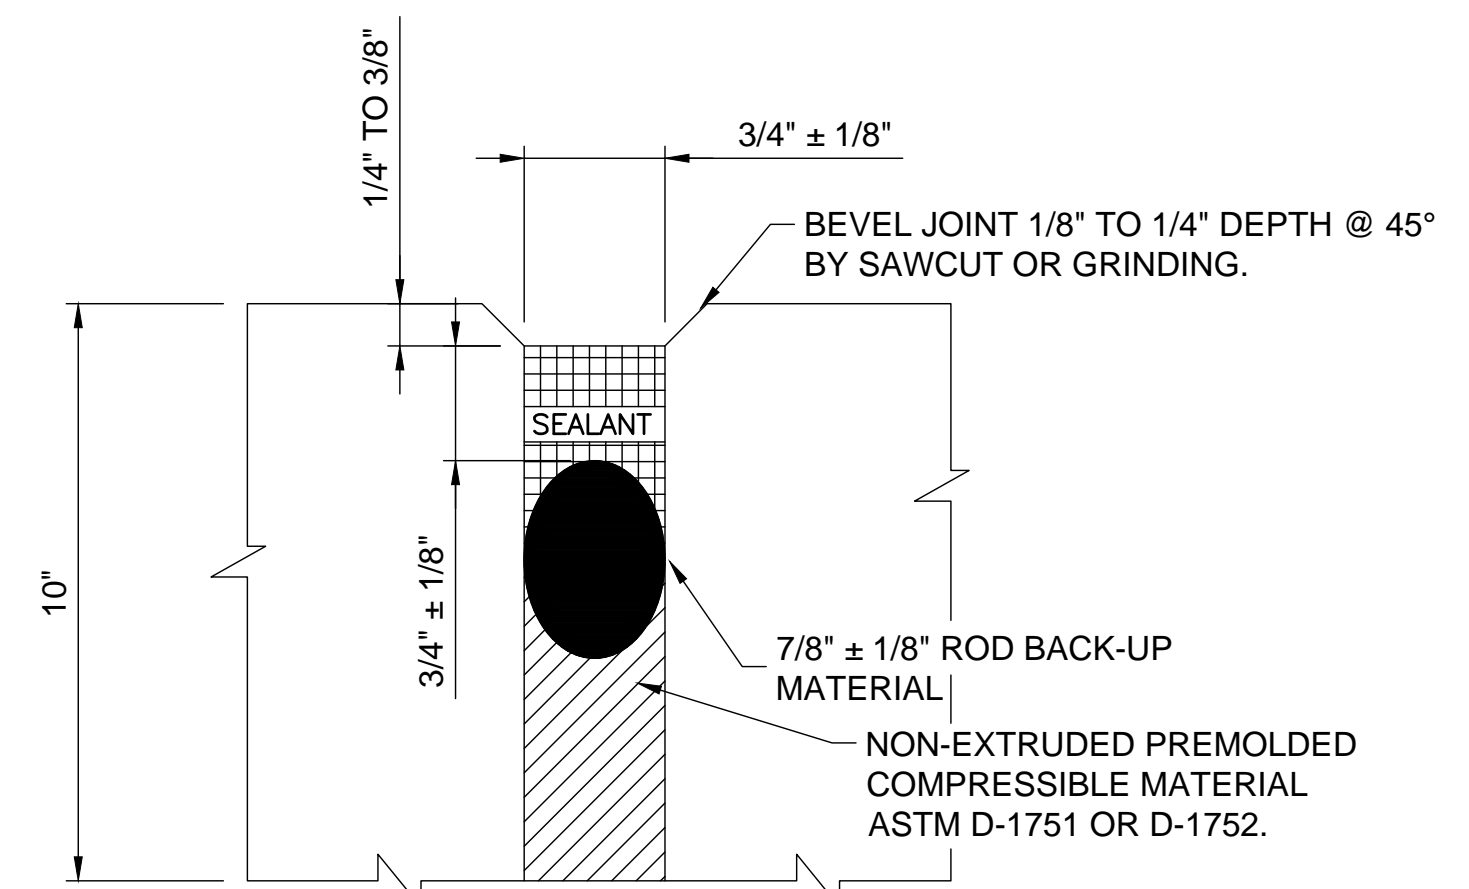

1 DETAIL 1-ISOLATION JOINTS
 C-100 SCALE: NONE

UTILITY CUTS SHALL BE REPAIRED USING THE SAME PAVEMENT SECTION AS THE WING AVIATION APRON CONNECTOR.

B UTILITY CUT REPAIR
 C-100 SCALE: NONE

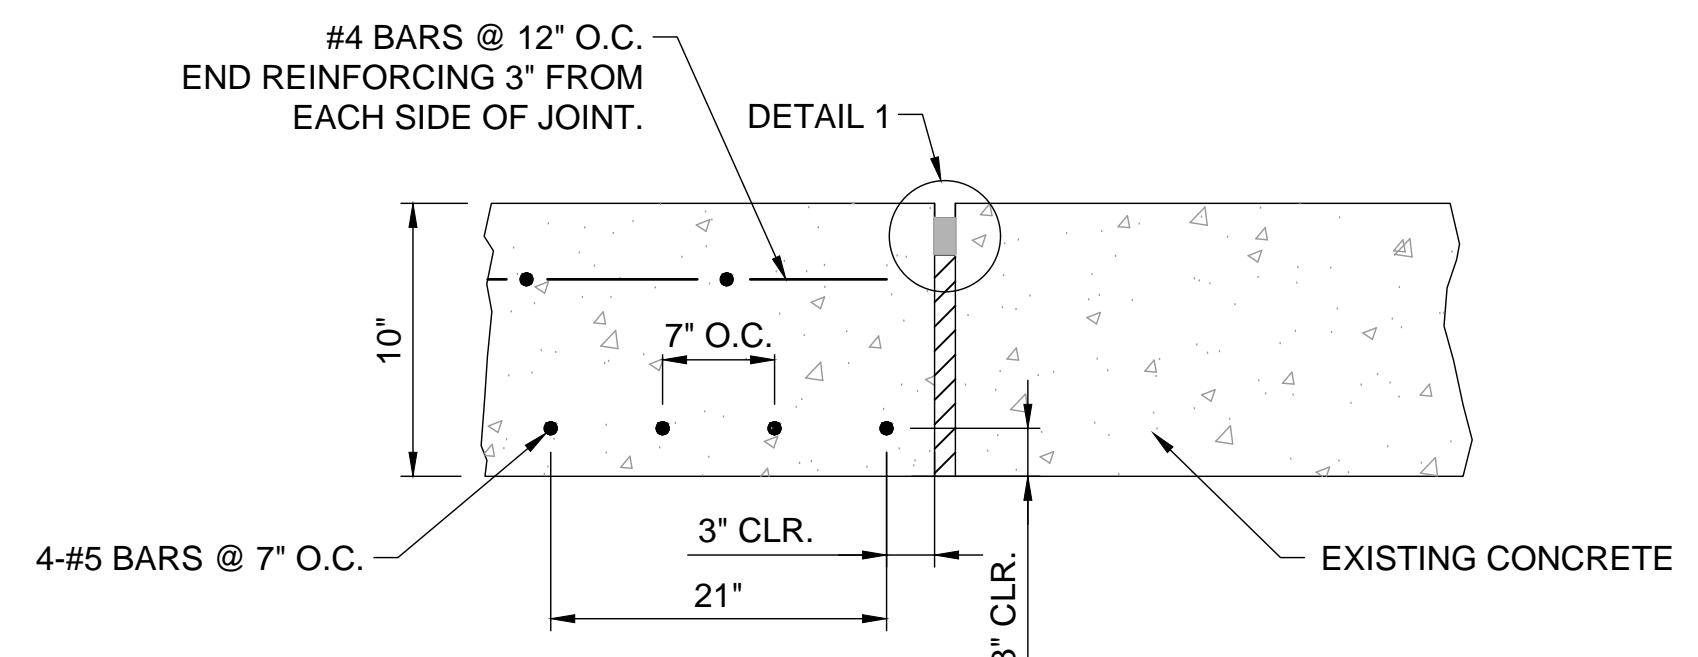


6 TYPE A-1-REINFORCED ISOLATION JOINT
 C-100 SCALE: NONE


SYMBOLS

| | |
|--|---|
| | SEALANT |
| | ROD BACK-UP MATERIAL CLOSED-CELL RESILIENT FOAM OR SPONGE RUBBER |
| | RESILIENT FILLER |


| DOWEL BAR LEGEND | |
|------------------|--------------------|
| | 10" SLAB THICKNESS |
| | DIAMETER = 3/4" |
| | LENGTH = 18" |
| | SPACING = 12" O.C. |

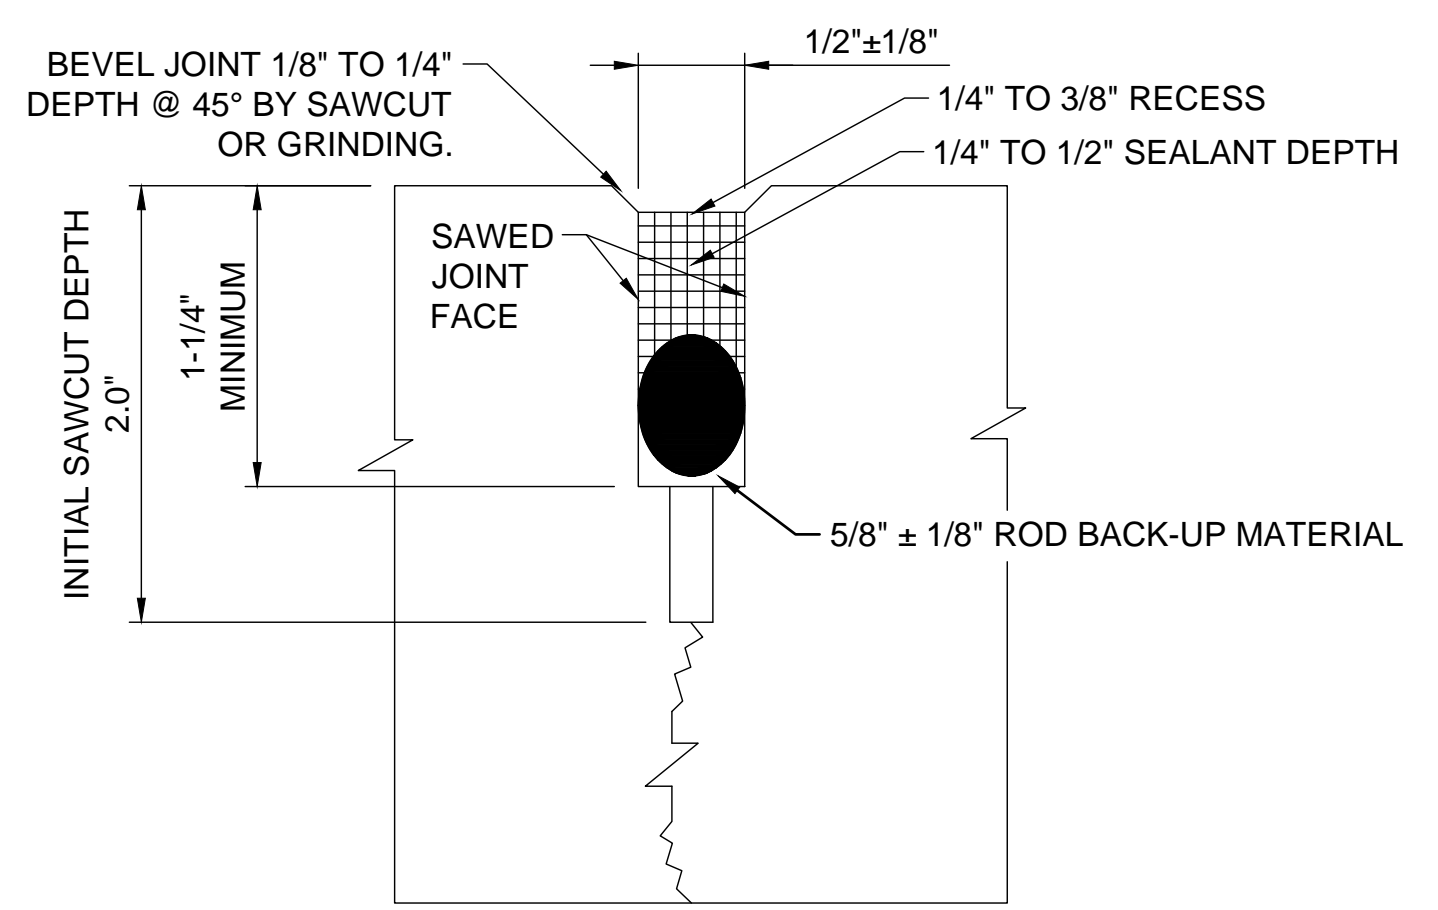


2 DETAIL 2-CONTRACTION JOINTS
 C-100 SCALE: NONE

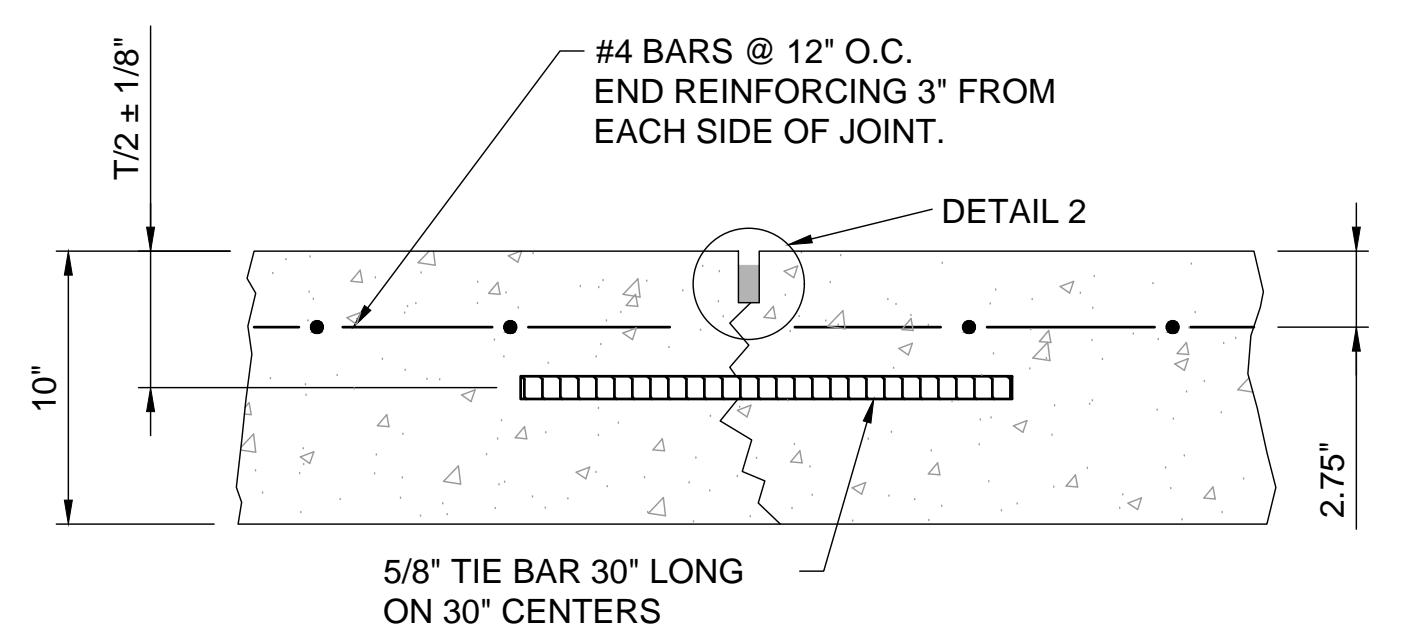


4 TYPE B-HINGED CONTRACTION JOINT
 C-100 SCALE: NONE

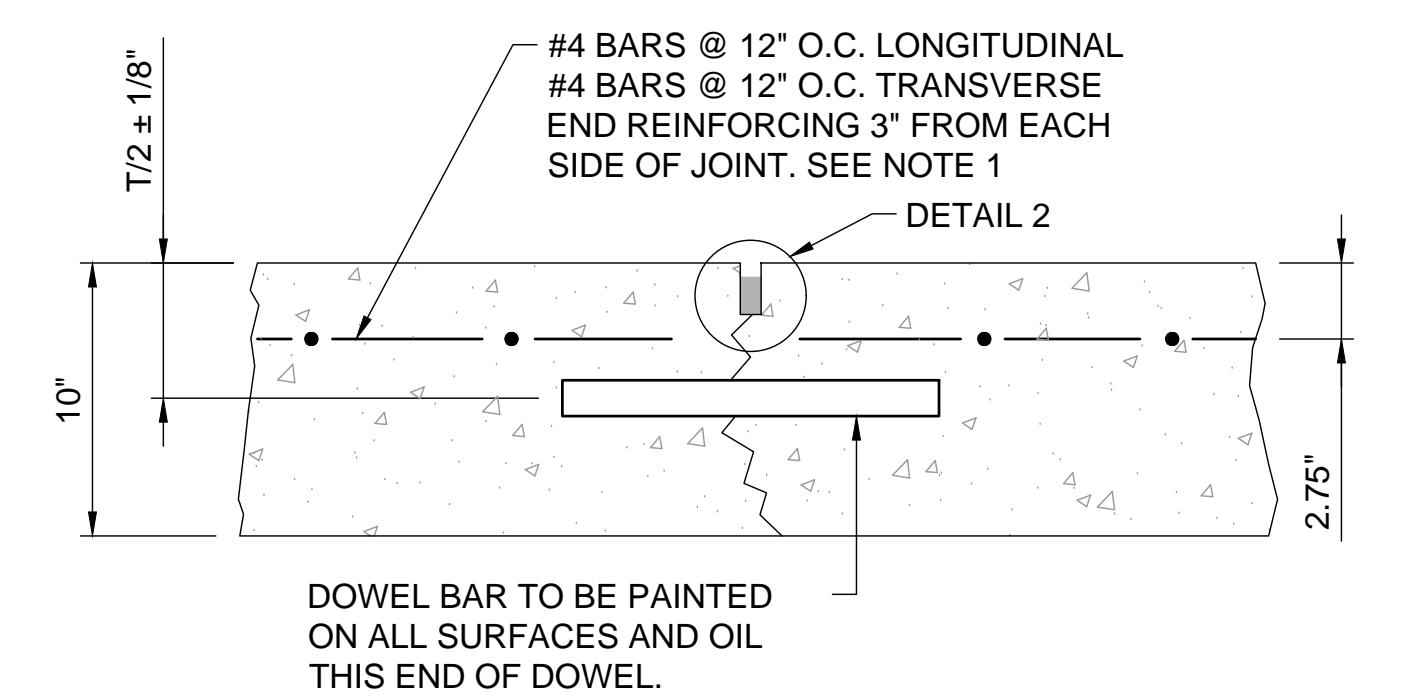


7 TYPE C-DOWELED CONTRACTION JOINT
 C-100 SCALE: NONE

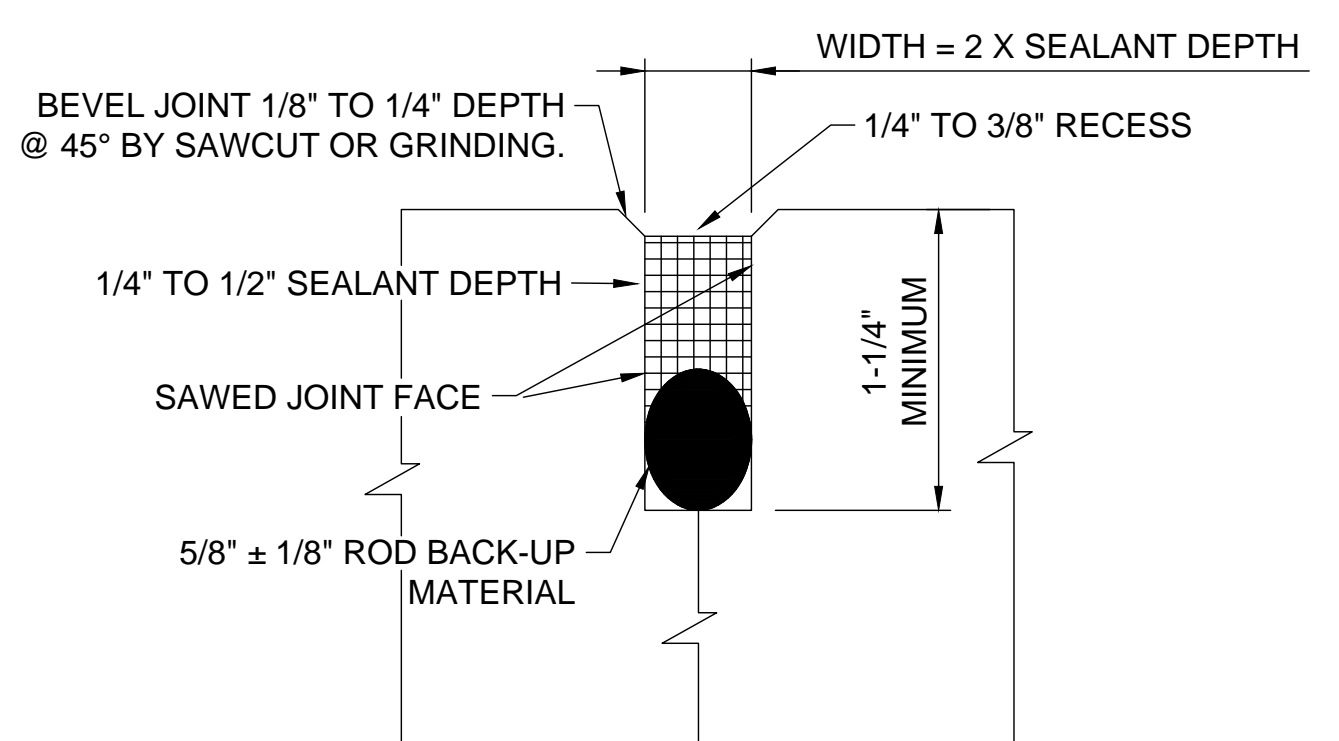

3 DETAIL 3-CONSTRUCTION JOINTS
 C-100 SCALE: NONE

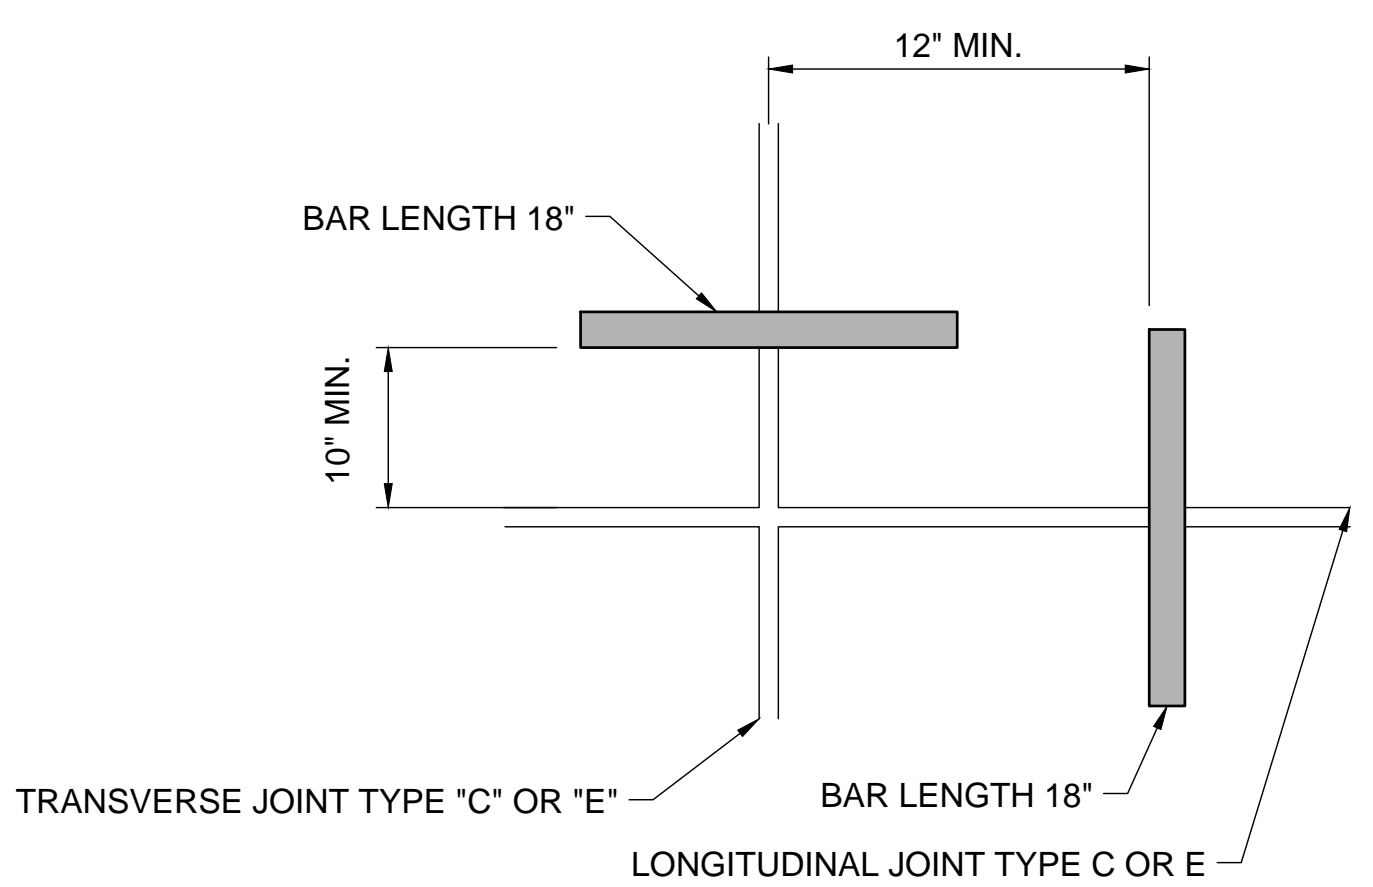

5 DOWEL BARS AT SLAB CORNERS (PLAN VIEW)
 C-100 SCALE: NONE

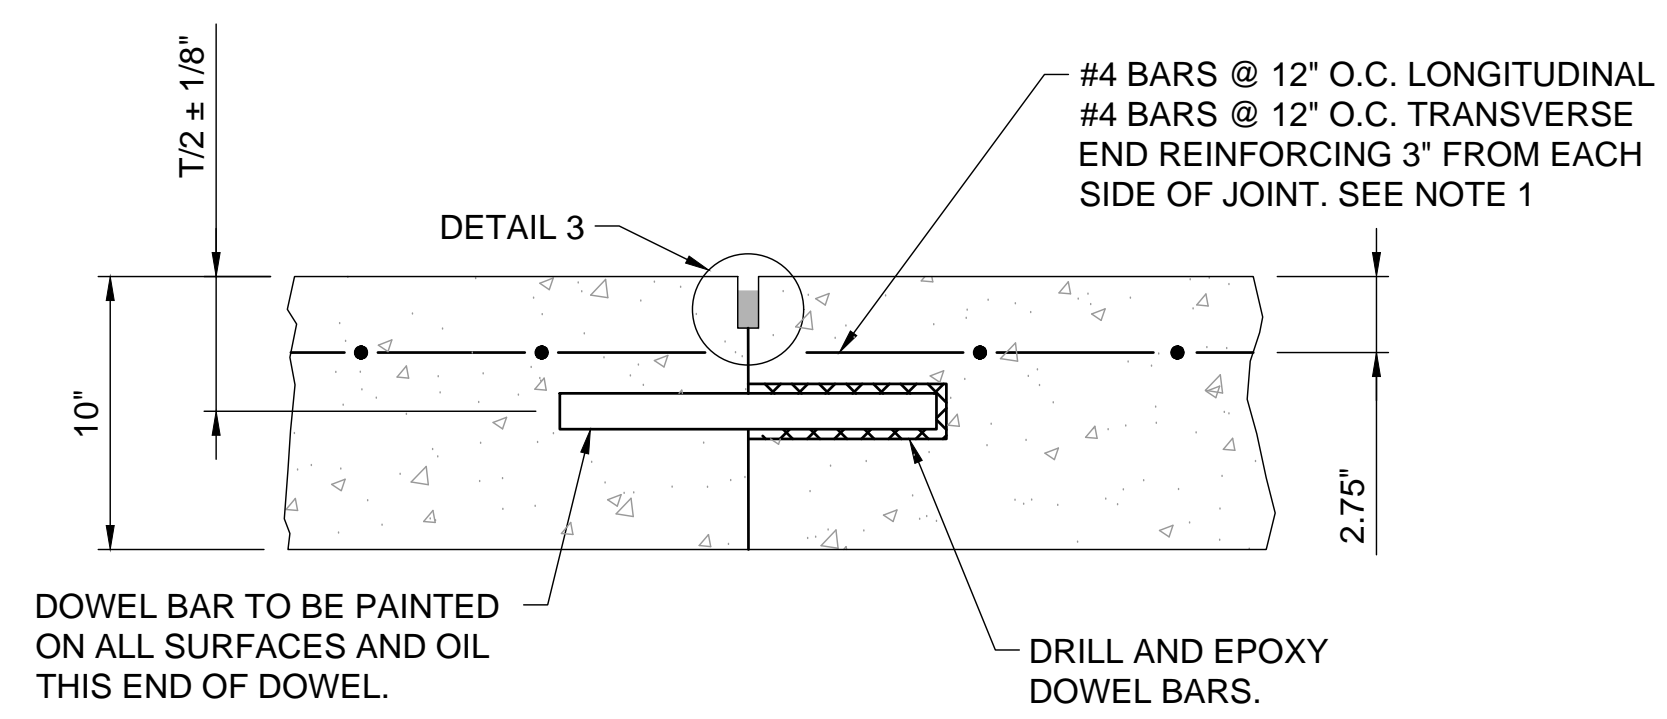

8 TYPE E-DOWELED CONSTRUCTION JOINT
 C-100 SCALE: NONE

File: L:\2018\18081100 - ADS On Call Services\Drawings\RECORDS\BAAADS-SBA-C100-TS.dwg, Last Save: 1/21/2019 7:50 AM, Last saved by: JAHenderson
 Last plotted by: Henderson, James, A Plot Style: AECmon.ctb, Plot Scale: 1:1 Plot Date: 1/22/2019 3:01 PM Plotter used: AutoCAD PDF (General Documentation).pc3

| BY | |
|-------------|--|
| DESCRIPTION | |
| DATE | |
| REV. | |

ADDISON AIRPORT
 ADDISON, TEXAS

WING AVIATION APRON CONNECTOR AND CLAIRE CHENNAULT STREET DRIVEWAY RECONSTRUCTION


WING AVIATION APRON CONNECTOR - DETAILS (BASE BID 1)

JOB NO.: 17081100
 DATE: JAN 2019
 DESIGNED BY: JAH
 DRAWN BY: JAH


BAR IS ONE INCH ON ORIGINAL DRAWING
 IF NOT ONE INCH ON THIS SHEET, ADJUST SCALES ACCORDINGLY.

DRAWING NUMBER
C-100


SHEET NUMBER
11

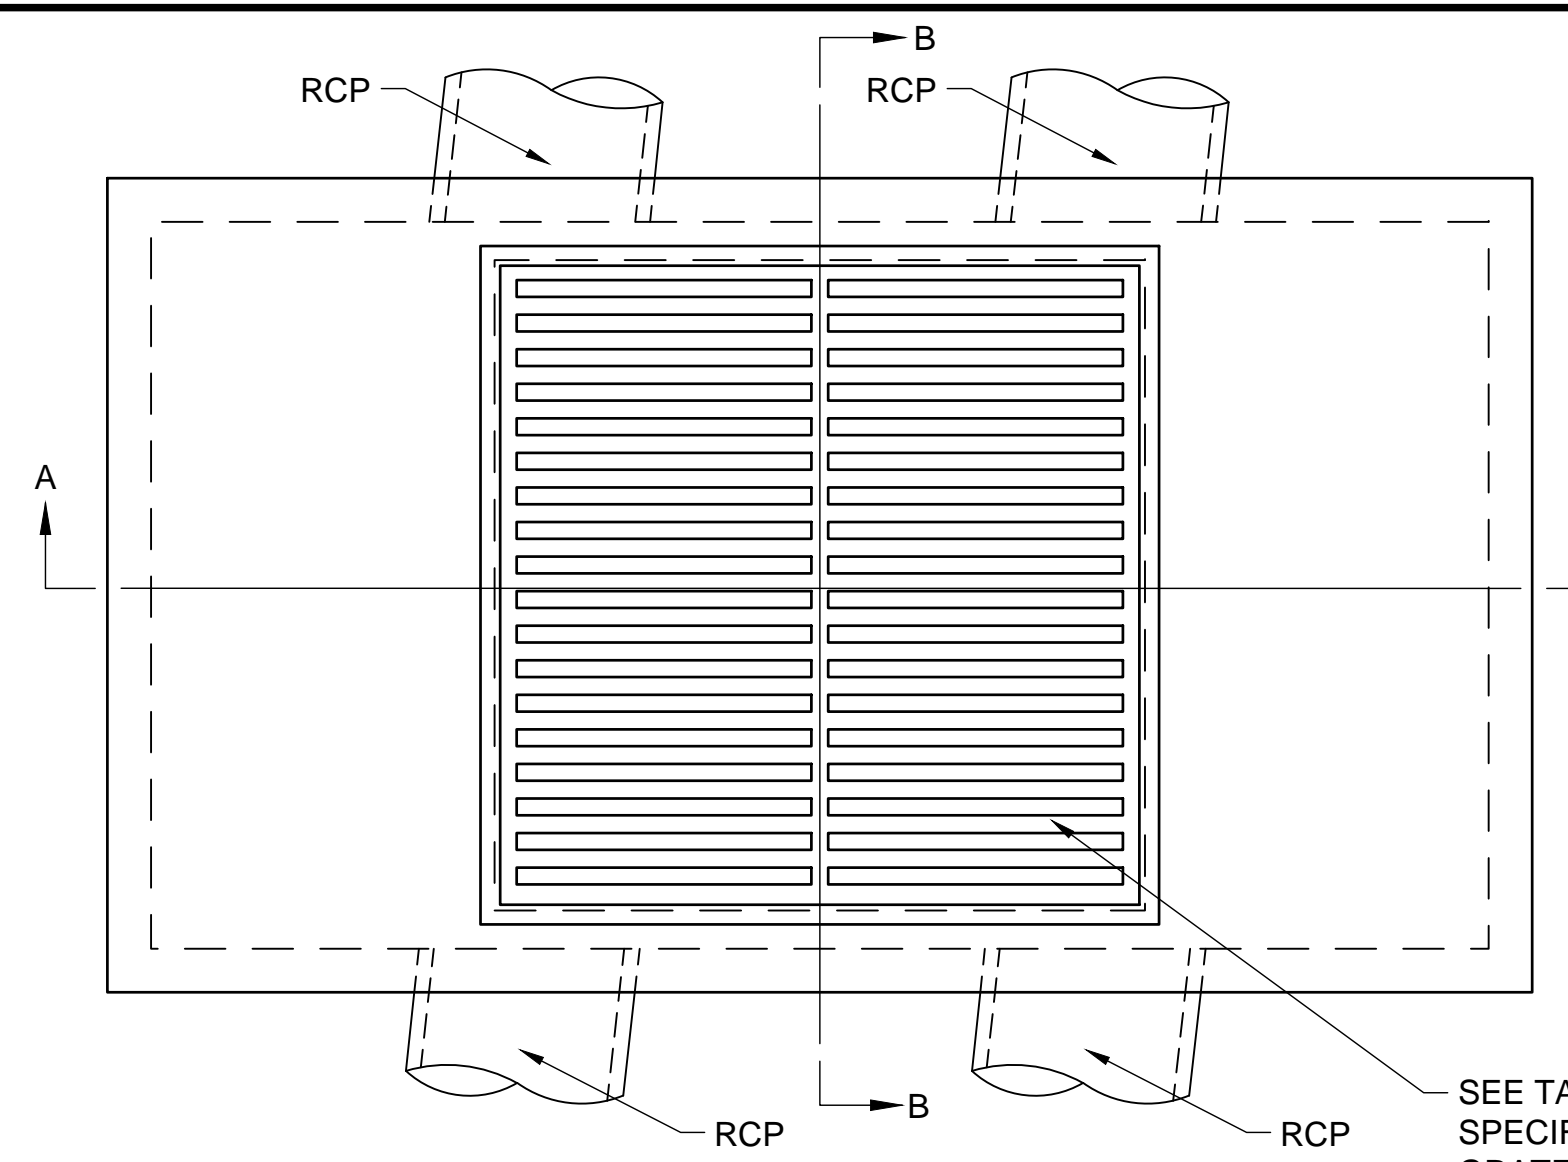

1A PLAN (SINGLE GRATE)
SCALE: NONE

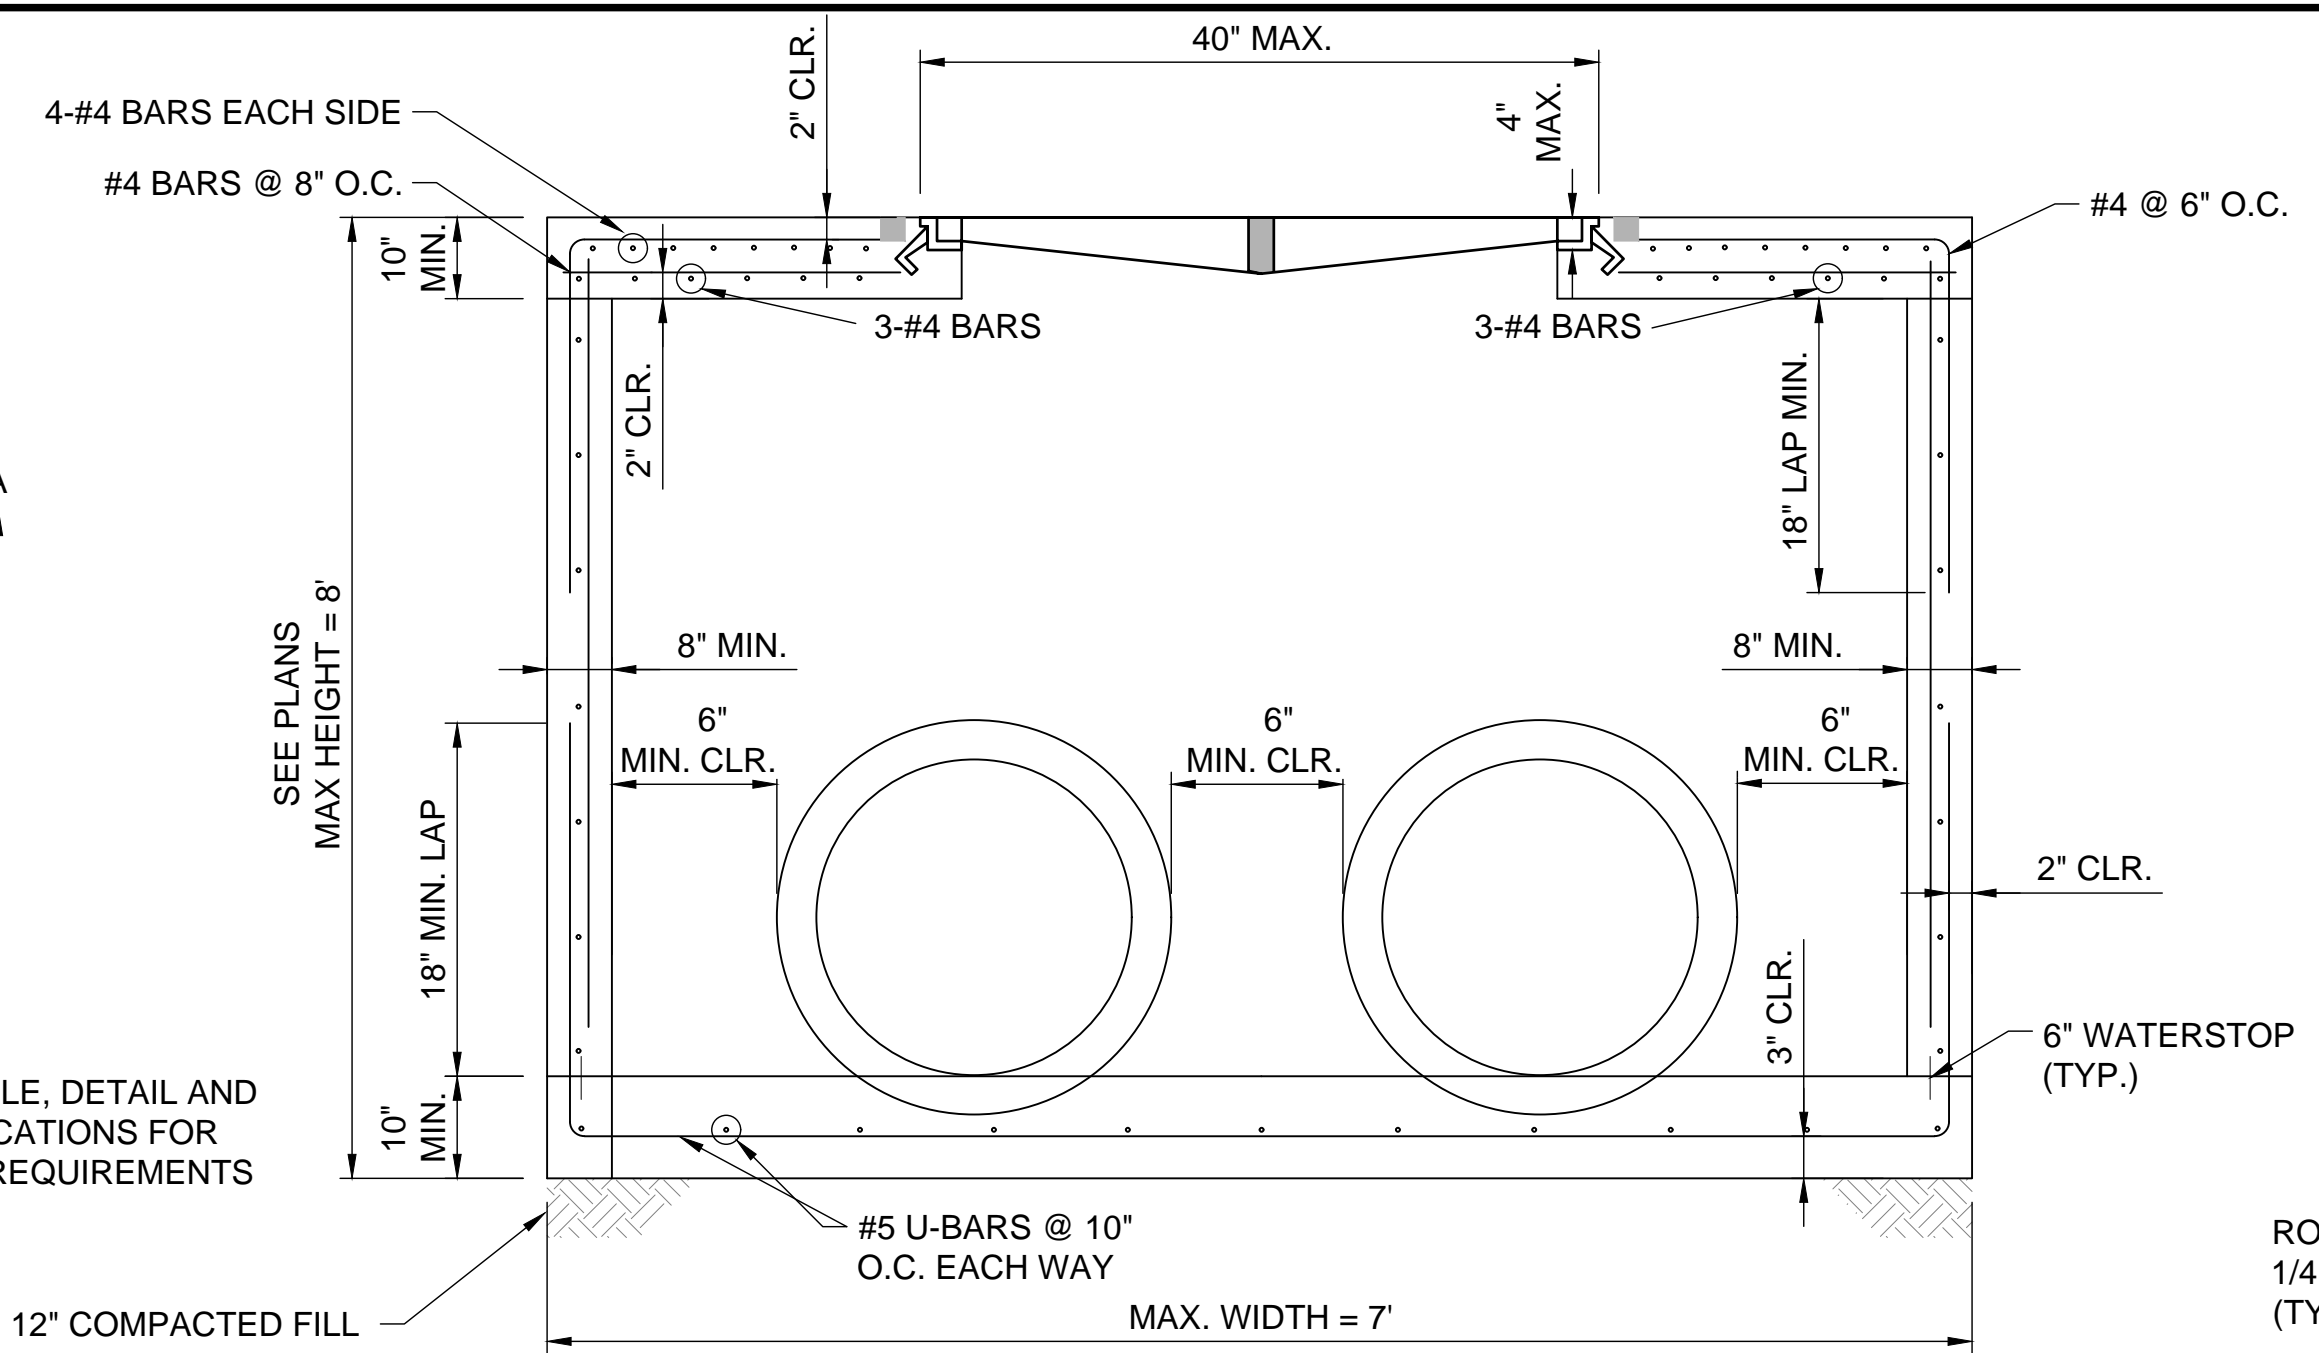

1B SECTION "A-A"
SCALE: NONE

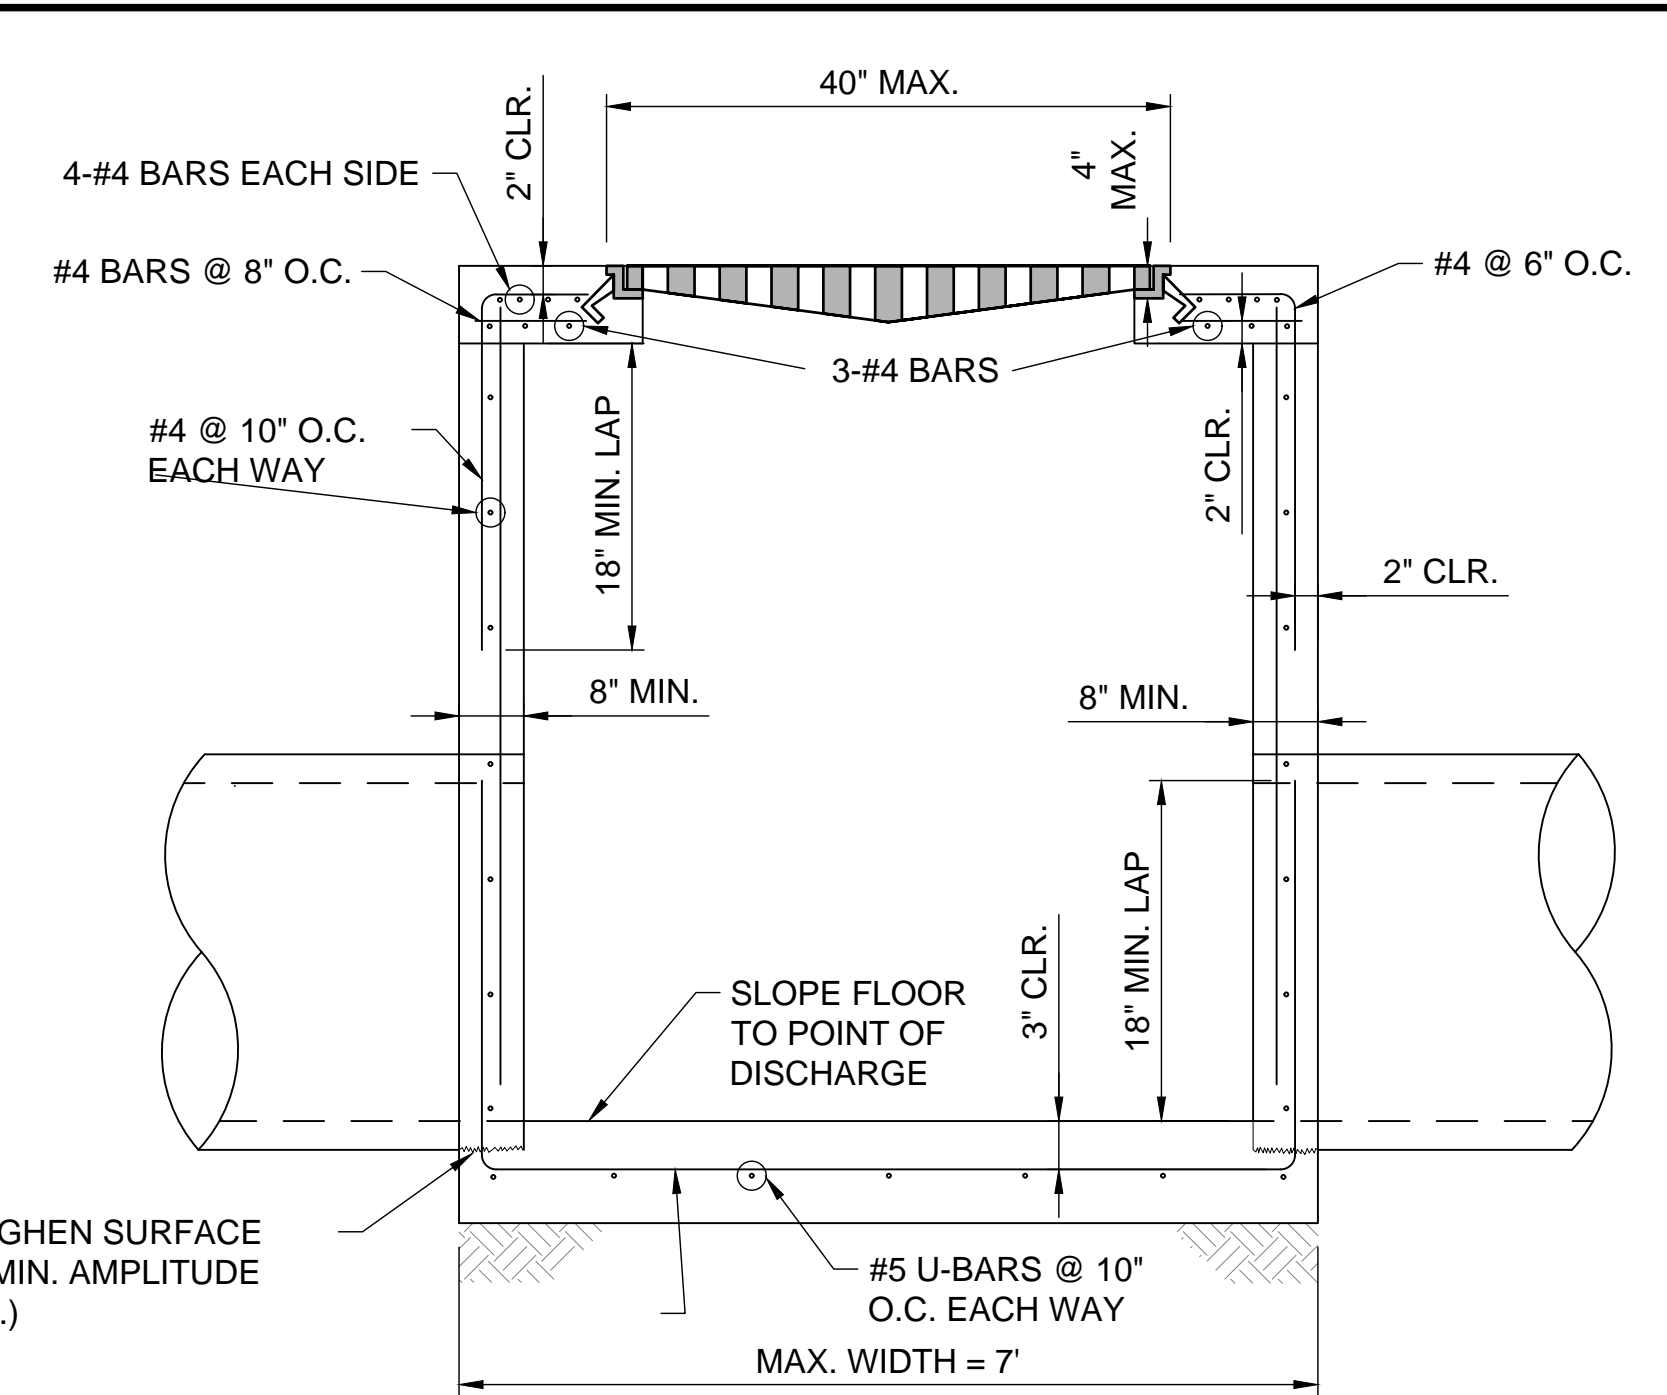


1C SECTION "B-B"
SCALE: NONE

1 AIRFIELD GRATE INLET (STANDARD)
SCALE: NONE


NOTE:
MINIMUM STEEL REINFORCEMENT LAP SHALL BE APPLIED WHERE APPLICABLE. IF THE CONTRACTOR CANNOT MEET THE MINIMUM LAP REQUIREMENT DUE TO THE INLET HEIGHT, THE CONTRACTOR SHALL LAP STEEL THE MAXIMUM AVAILABLE LENGTH.

| GRATE DESIGN PARAMETERS | |
|-------------------------|-----------------|
| MATERIAL | DUCTILE IRON |
| WEIR PERIMETER | 9.8 FT. MIN. |
| FREE OPEN AREA | 2.4 S.F. MIN. |
| WHEEL LOADING | 40,000 LBS MIN. |

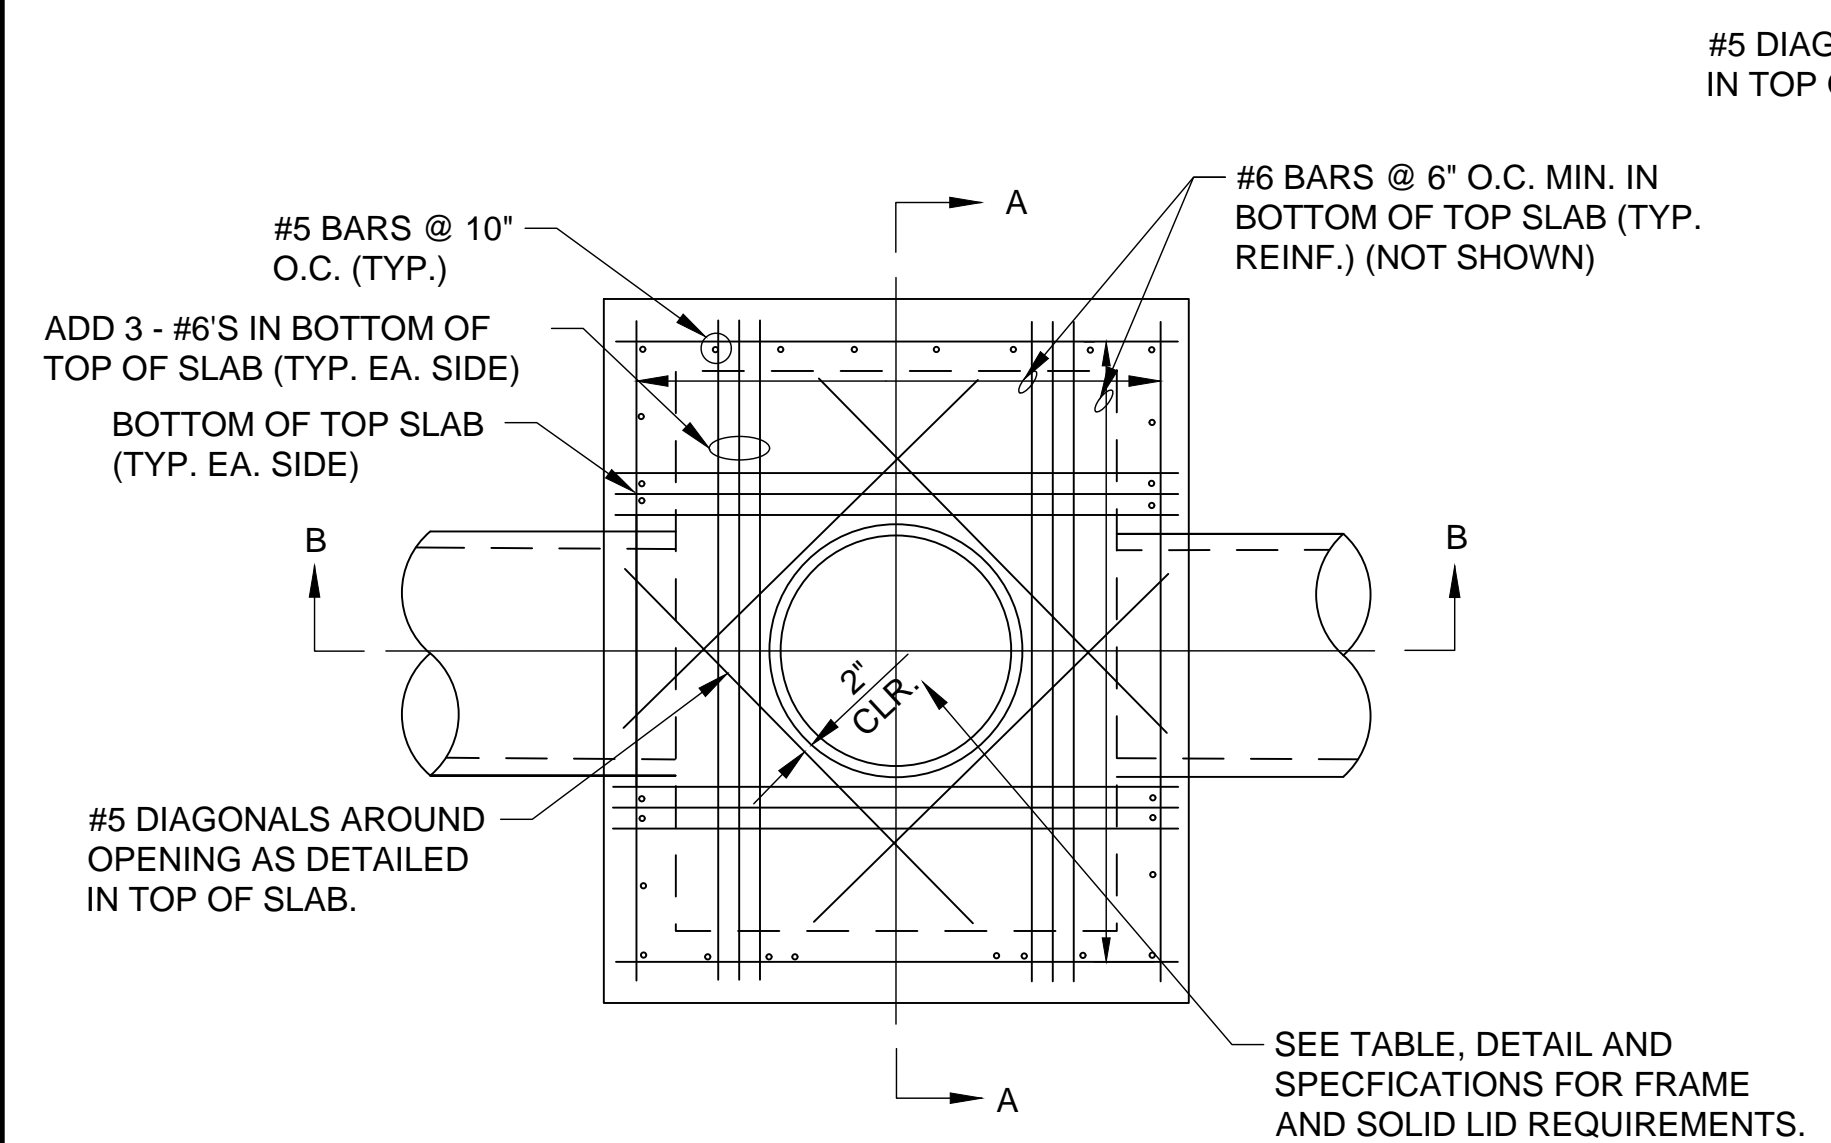

2A PLAN
SCALE: NONE


| MANHOLE COVER DESIGN PARAMETERS | |
|---------------------------------|-----------------|
| MATERIAL | CAST IRON |
| WHEEL LOADING | 40,000 LBS MIN. |
| OPENING | 32" MIN. |

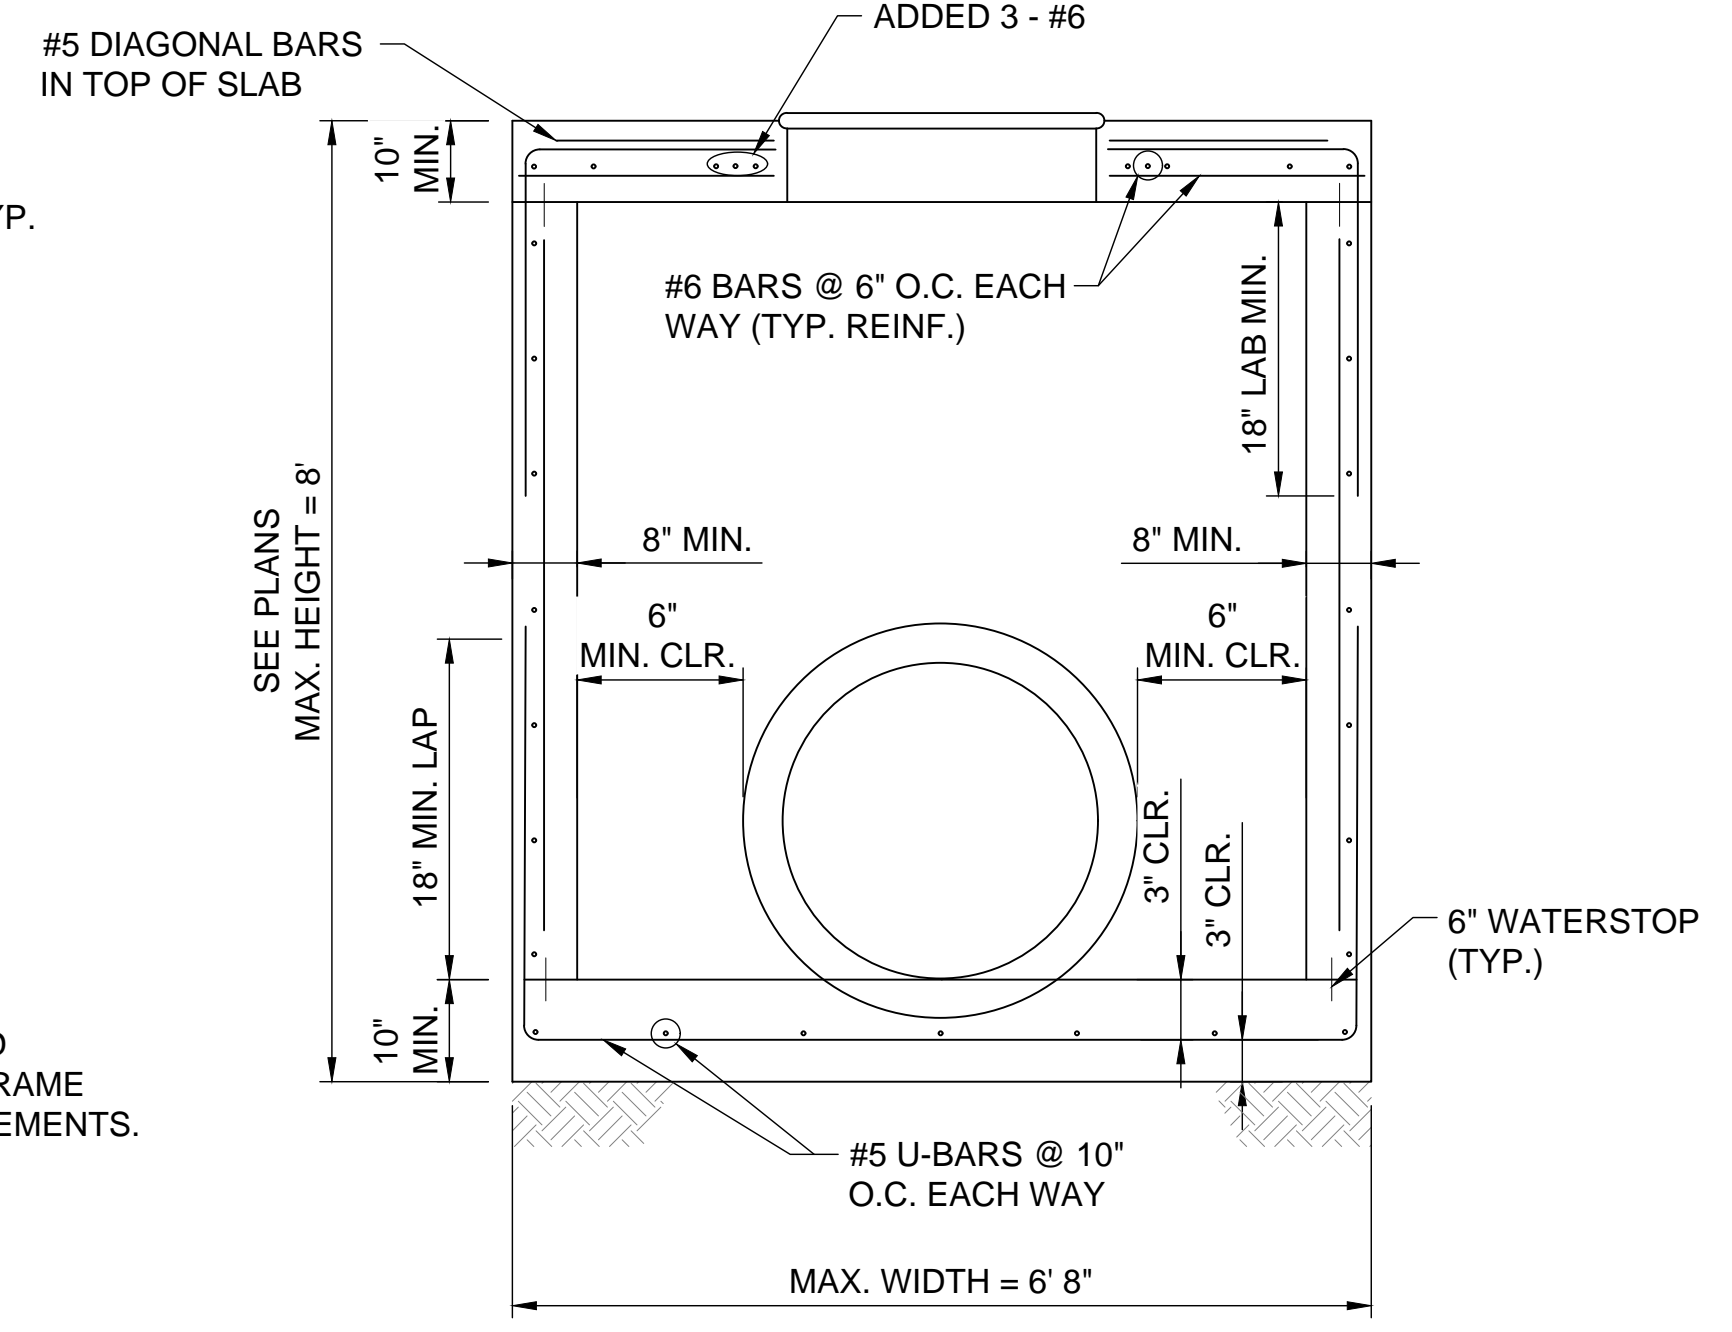


2B SECTION "A-A"
SCALE: NONE

NOTE:
MINIMUM STEEL REINFORCEMENT LAP SHALL BE APPLIED WHERE APPLICABLE. IF THE CONTRACTOR CANNOT MEET THE MINIMUM LAP REQUIREMENT DUE TO THE INLET HEIGHT, THE CONTRACTOR SHALL LAP STEEL THE MAXIMUM AVAILABLE LENGTH.

2 AIRFIELD JUNCTION BOX (STANDARD)
SCALE: NONE

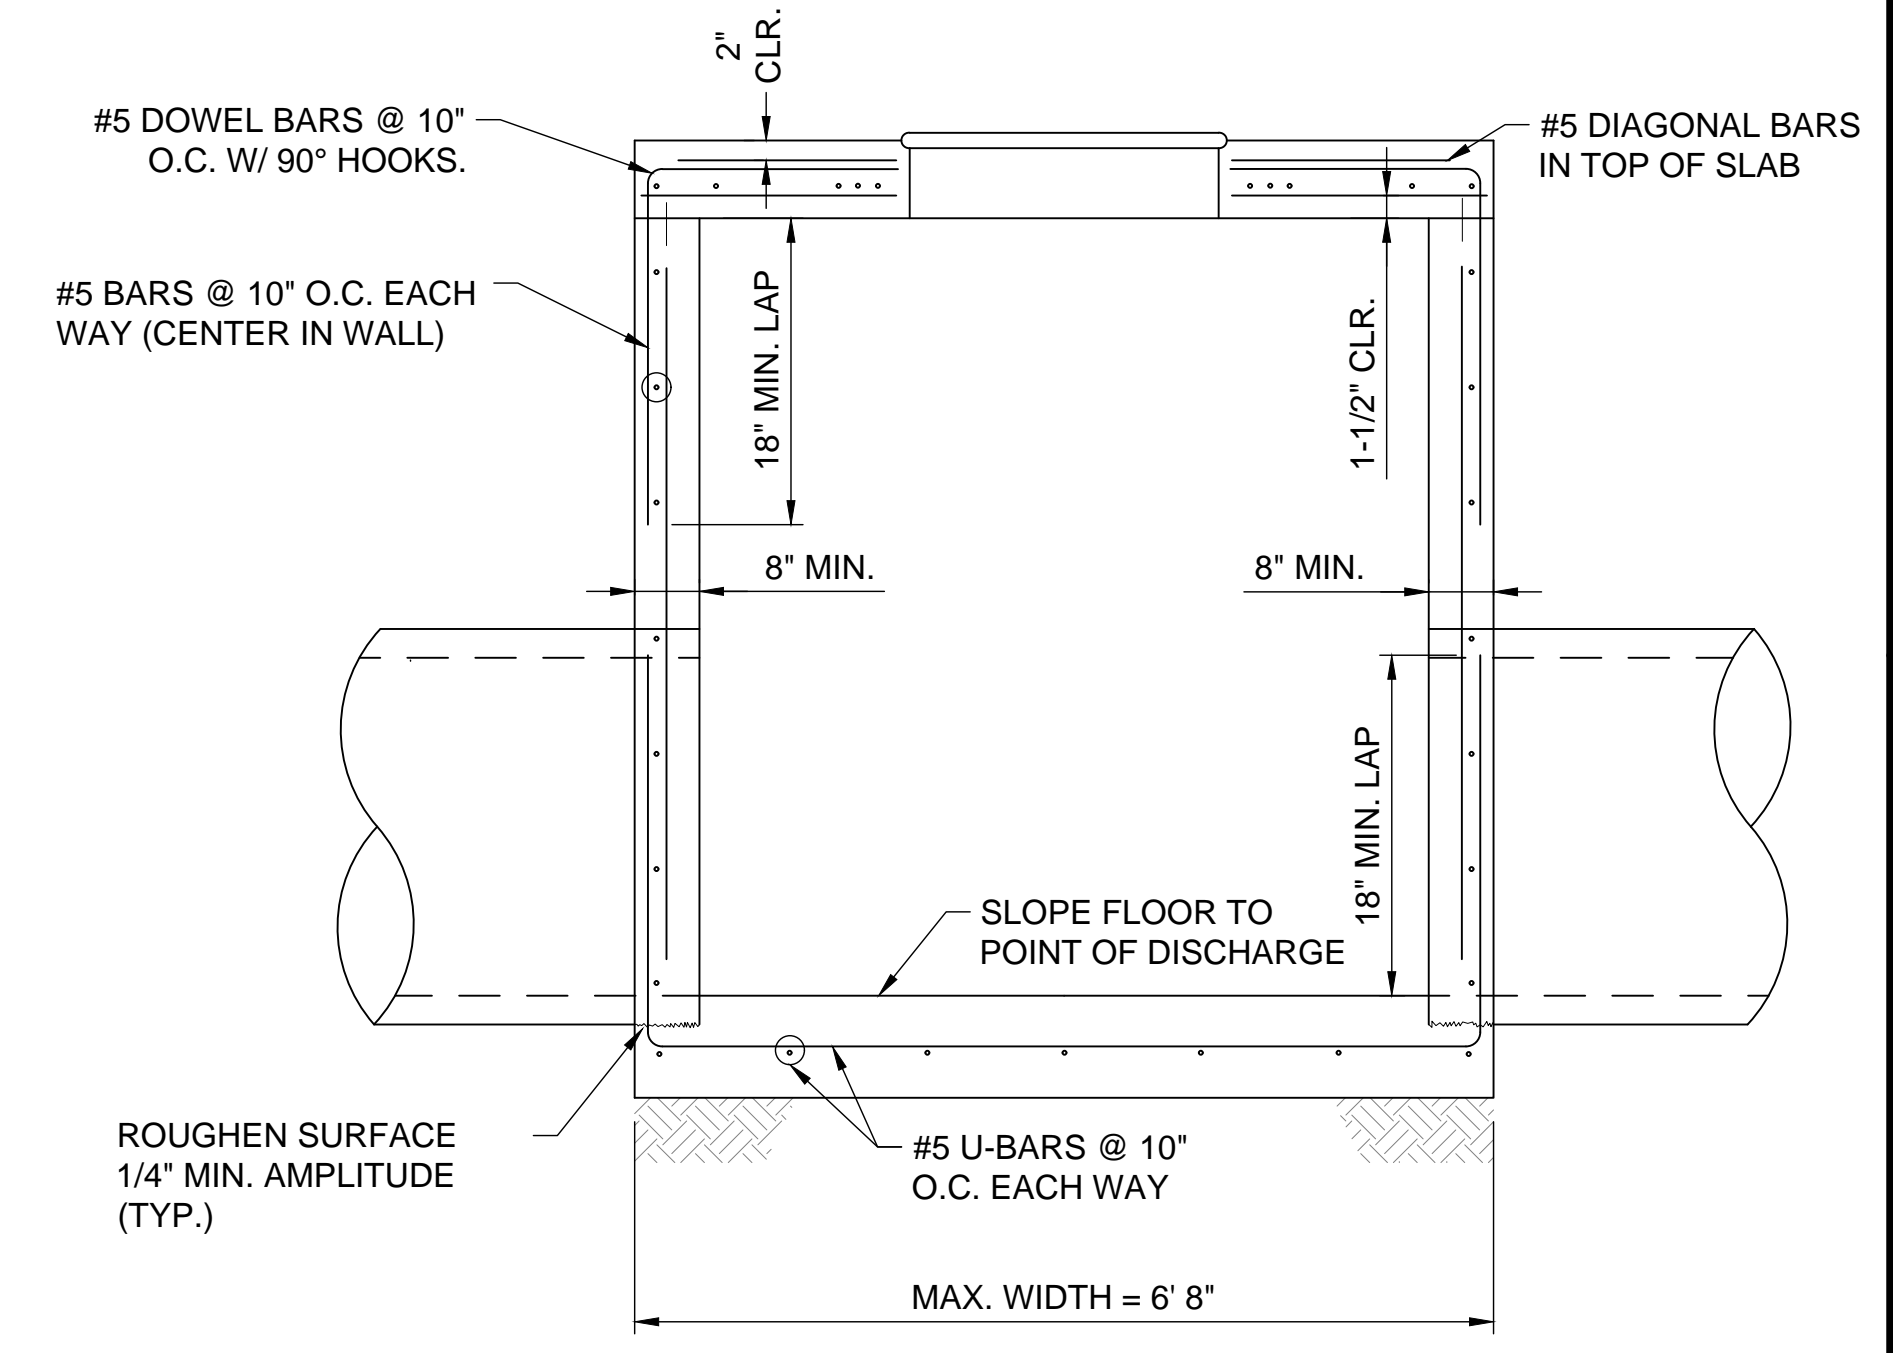

2C SECTION "B-B"
SCALE: NONE

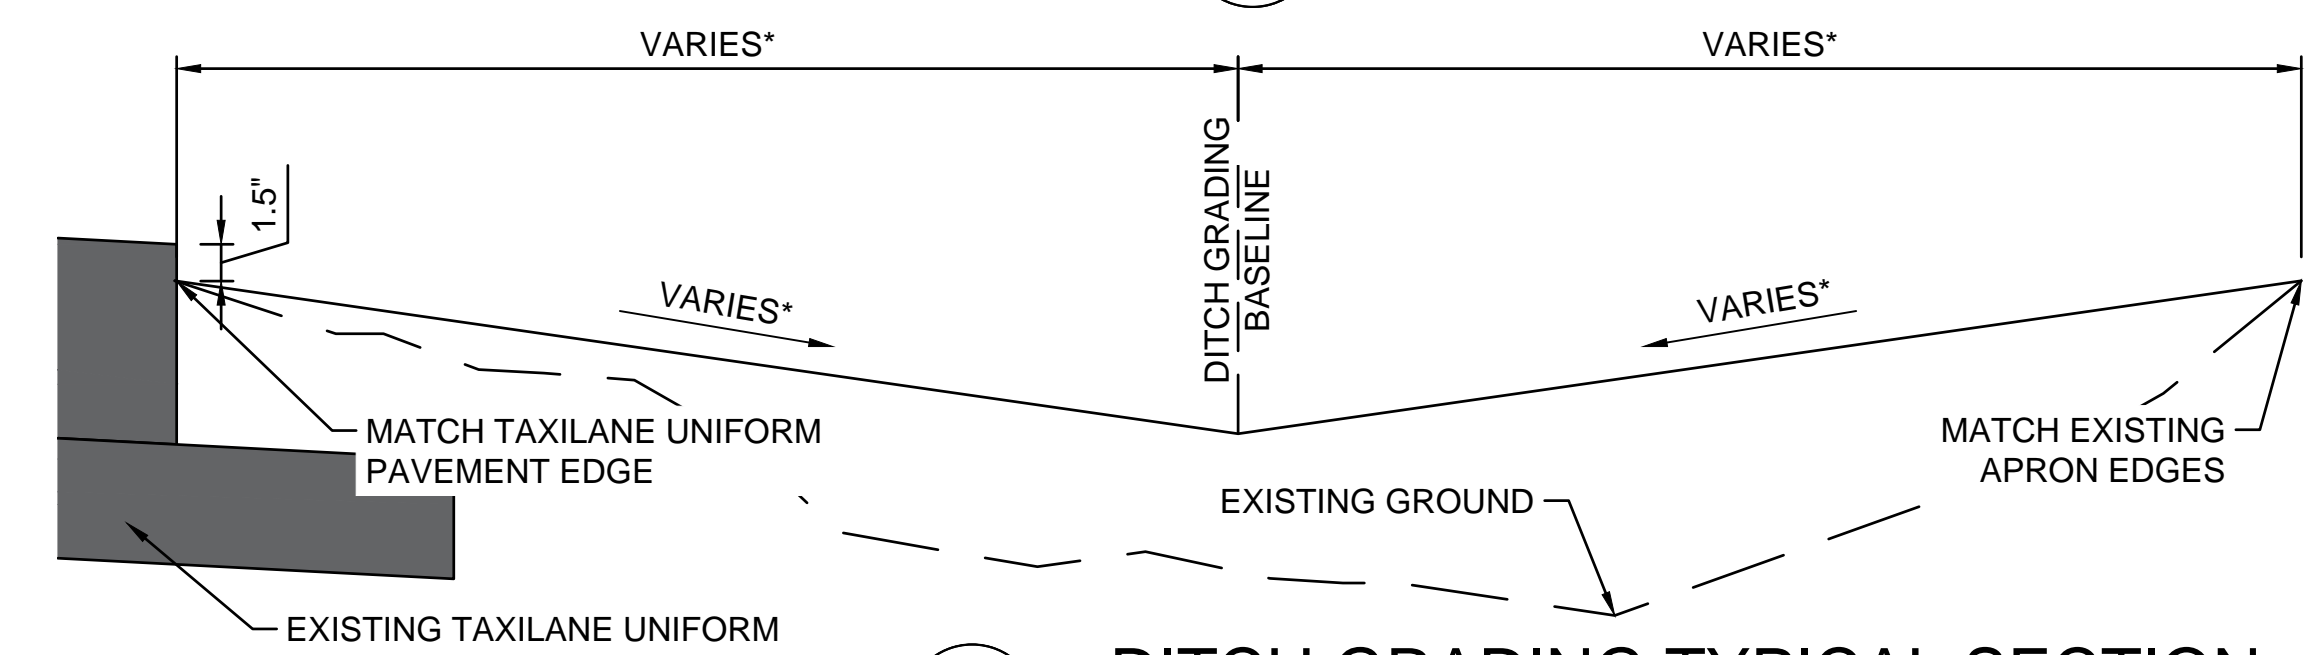

3 DITCH GRADING TYPICAL SECTION
SCALE: NONE
*SEE LAYOUT PLAN FOR DITCH ELEVATIONS AND EXTENTS OF GRADING.

File: L:\2018\18081100 - ADS On Call Services\Drawings\RECORD\SBAAADS-SBA-C201-DD.dwg, Last Save: 1/21/2019 7:03 AM, Last saved by: KKRutabana, Last plotted by: Henderson, James, A, Plot Style: AECmon.ctb, Plot Scale: 1:1, Plot Date: 1/22/2019 3:02 PM, Plotter User: AutoCAD PDF (General Documentation).pc3

| REV. | DATE | DESCRIPTION |
|------|------|-------------|
| | | |
| | | |
| | | |

ADDISON AIRPORT
ADDISON, TEXAS
WING AVIATION APRON CONNECTOR
AND CLAIRE CHENNAULT STREET
DRIVEWAY RECONSTRUCTION

WING AVIATION
DRAINAGE DETAILS

JOB NO.: 17081100
DATE: JAN 2019
DESIGNED BY: JAH
DRAWN BY: JAH


BAR IS ONE INCH ON ORIGINAL DRAWING
IF NOT ONE INCH ON THIS SHEET, ADJUST SCALES ACCORDINGLY.
DRAWING NUMBER
C-101
SHEET NUMBER
12



© 2017 GARVER, LLC
 THIS DOCUMENT, ALONG WITH THE IDEAS AND DESIGNS CONVEYED HEREIN, SHALL BE CONSIDERED INSTRUMENTS OF PROFESSIONAL SERVICE AND ARE PROPERTY OF GARVER, LLC. ANY USE, REPRODUCTION, OR DISTRIBUTION OF THIS DOCUMENT, ALONG WITH THE IDEAS AND DESIGN CONTAINED HEREIN, IS PROHIBITED UNLESS AUTHORIZED IN WRITING BY GARVER, LLC OR EXPLICITLY ALLOWED IN THE GOVERNING PROFESSIONAL SERVICES AGREEMENT FOR THIS WORK.

REGISTRATION NO. F-5713

RECORD DRAWINGS
 1/22/2019

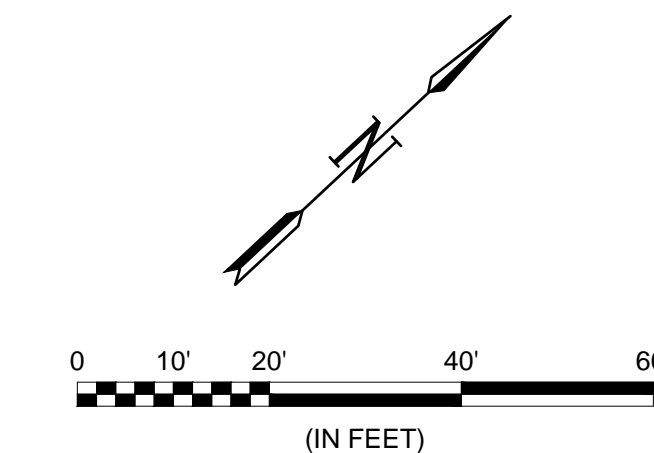

LEGEND


PAVEMENT REMOVAL

PIPE REMOVAL


FULL DEPTH PAVEMENT REMOVAL BOUNDARIES

| POINT NO. | NORTHING | EASTING |
|-----------|------------|------------|
| 1 | 7041122.80 | 2479070.15 |
| 2 | 7041127.08 | 2479081.36 |
| 3 | 7041116.26 | 2479072.64 |
| 4 | 7041120.54 | 2479083.85 |
| 5 | 7041145.39 | 2479132.68 |
| 6 | 7041161.96 | 2479180.24 |
| 7 | 7041153.70 | 2479183.38 |
| 8 | 7041137.22 | 2479136.08 |
| 9 | 7041358.75 | 2479532.28 |
| 10 | 7041400.69 | 2479571.28 |
| 11 | 7041383.08 | 2479582.22 |
| 12 | 7041348.73 | 2479550.28 |
| 13 | 7041430.68 | 2479680.08 |
| 14 | 7041539.68 | 2479781.57 |
| 15 | 7041538.06 | 2479783.33 |
| 16 | 7041428.57 | 2479682.11 |

NOTES:
 VARIANCE IN EXISTING PAVEMENT SHALL NOT WARRANT ADDITIONAL PAYMENT.
CAUTION: UNDERGROUND UTILITIES EXIST WITHIN AND ADJACENT TO THE LIMITS OF CONSTRUCTION. AN ATTEMPT HAS BEEN MADE TO LOCATE THESE UTILITIES ON THE PLANS. HOWEVER, ALL EXISTING UTILITIES MAY NOT BE SHOWN AND THE ACTUAL LOCATIONS OF THE UTILITIES MAY VARY FROM THE LOCATIONS SHOWN. PRIOR TO BEGINNING ANY TYPE OF EXCAVATION, THE CONTRACTOR SHALL CONTACT THE UTILITIES ON THE GROUND. THE CONTRACTOR SHALL MAINTAIN THE UTILITY LOCATION MARKINGS UNTIL THEY ARE NO LONGER NECESSARY.
 TEXAS STATE LAW, THE UNDERGROUND FACILITIES DAMAGE PREVENTION ACT, REQUIRES SUFFICIENT ADVANCE NOTIFICATION THROUGH THE TEXAS ONE-CALL SYSTEM CENTER BEFORE EXCAVATING USING MECHANIZED EQUIPMENT OF EXPLOSIVES (EXCEPT IN THE CASE OF AN EMERGENCY). THE ONE-CALL SYSTEM PHONE NUMBER IS 1-800-245-4545. THE CONTRACTOR IS ADVISED THAT THERE IS A SEVERE PENALTY FOR NOT MAKING THIS CALL. NOT ALL UTILITY COMPANIES ARE MEMBERS OF THE TEXAS ONE-CALL SYSTEM; THEREFORE, THE CONTRACTOR IS ADVISED TO CONTACT ALL NON-MEMBER UTILITIES AS WELL AS THE ONE-CALL SYSTEM.

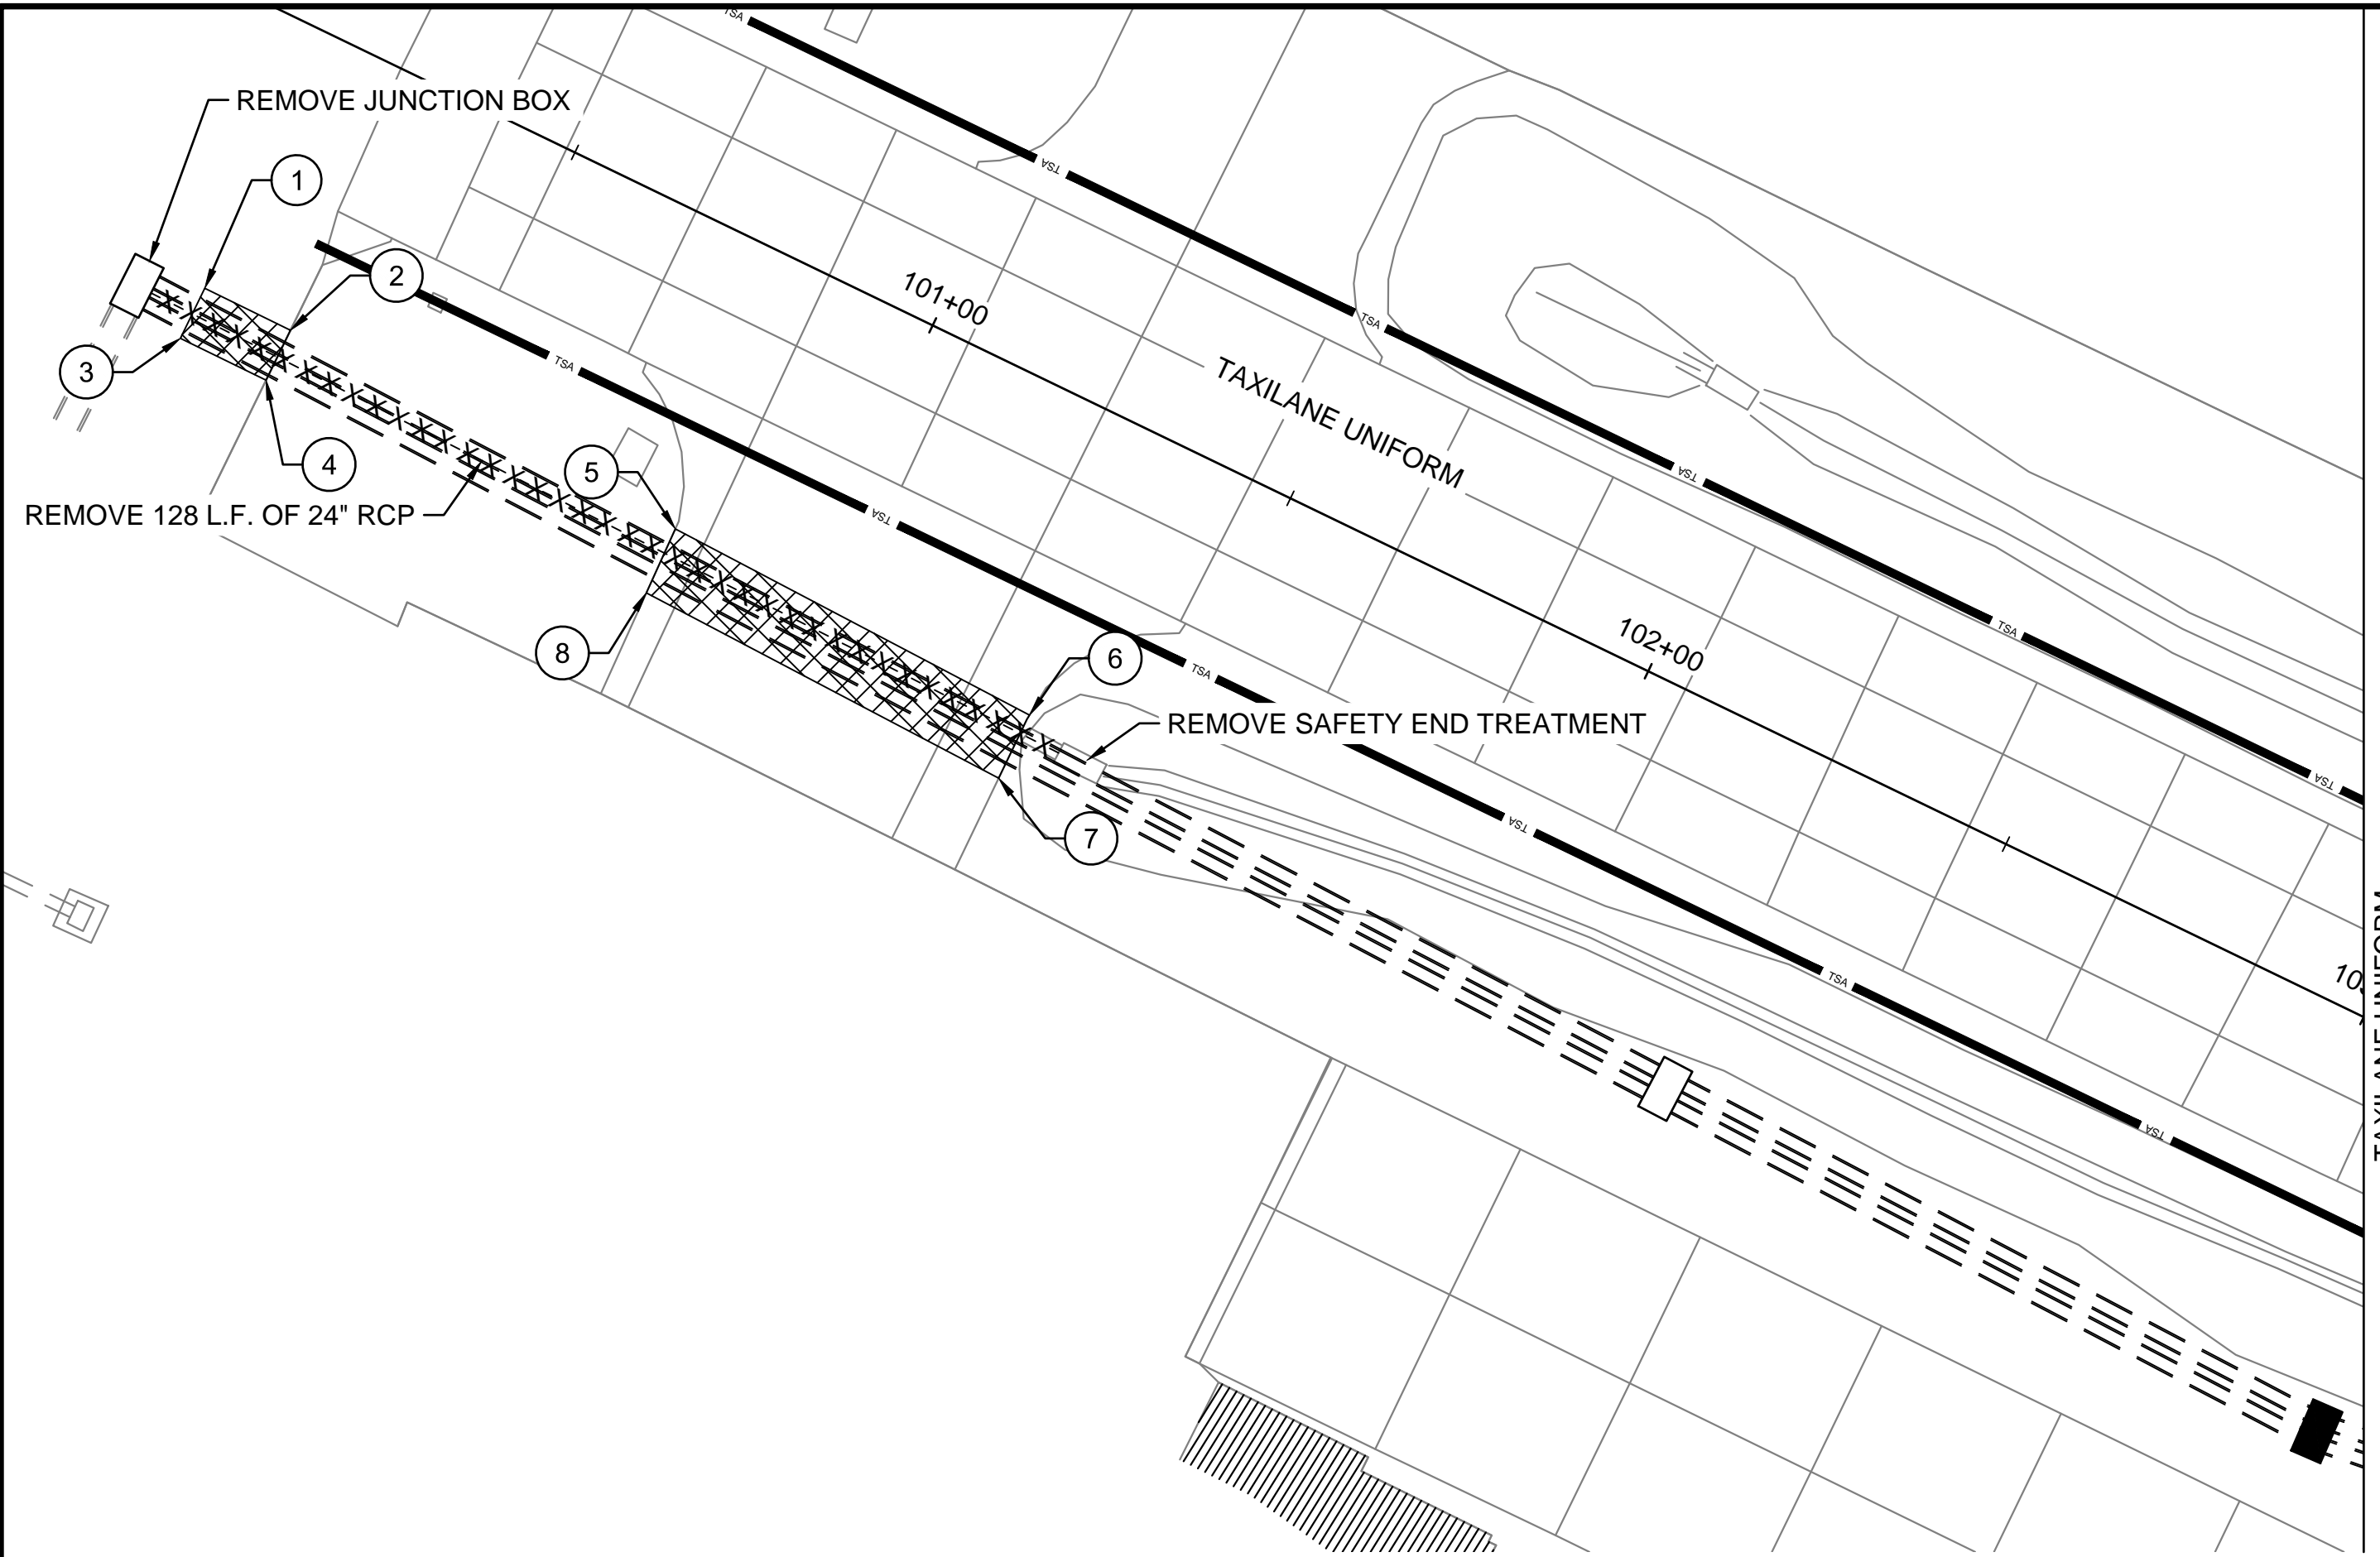

TAXILANE UNIFORM
 MATCHLINE STA 103+00

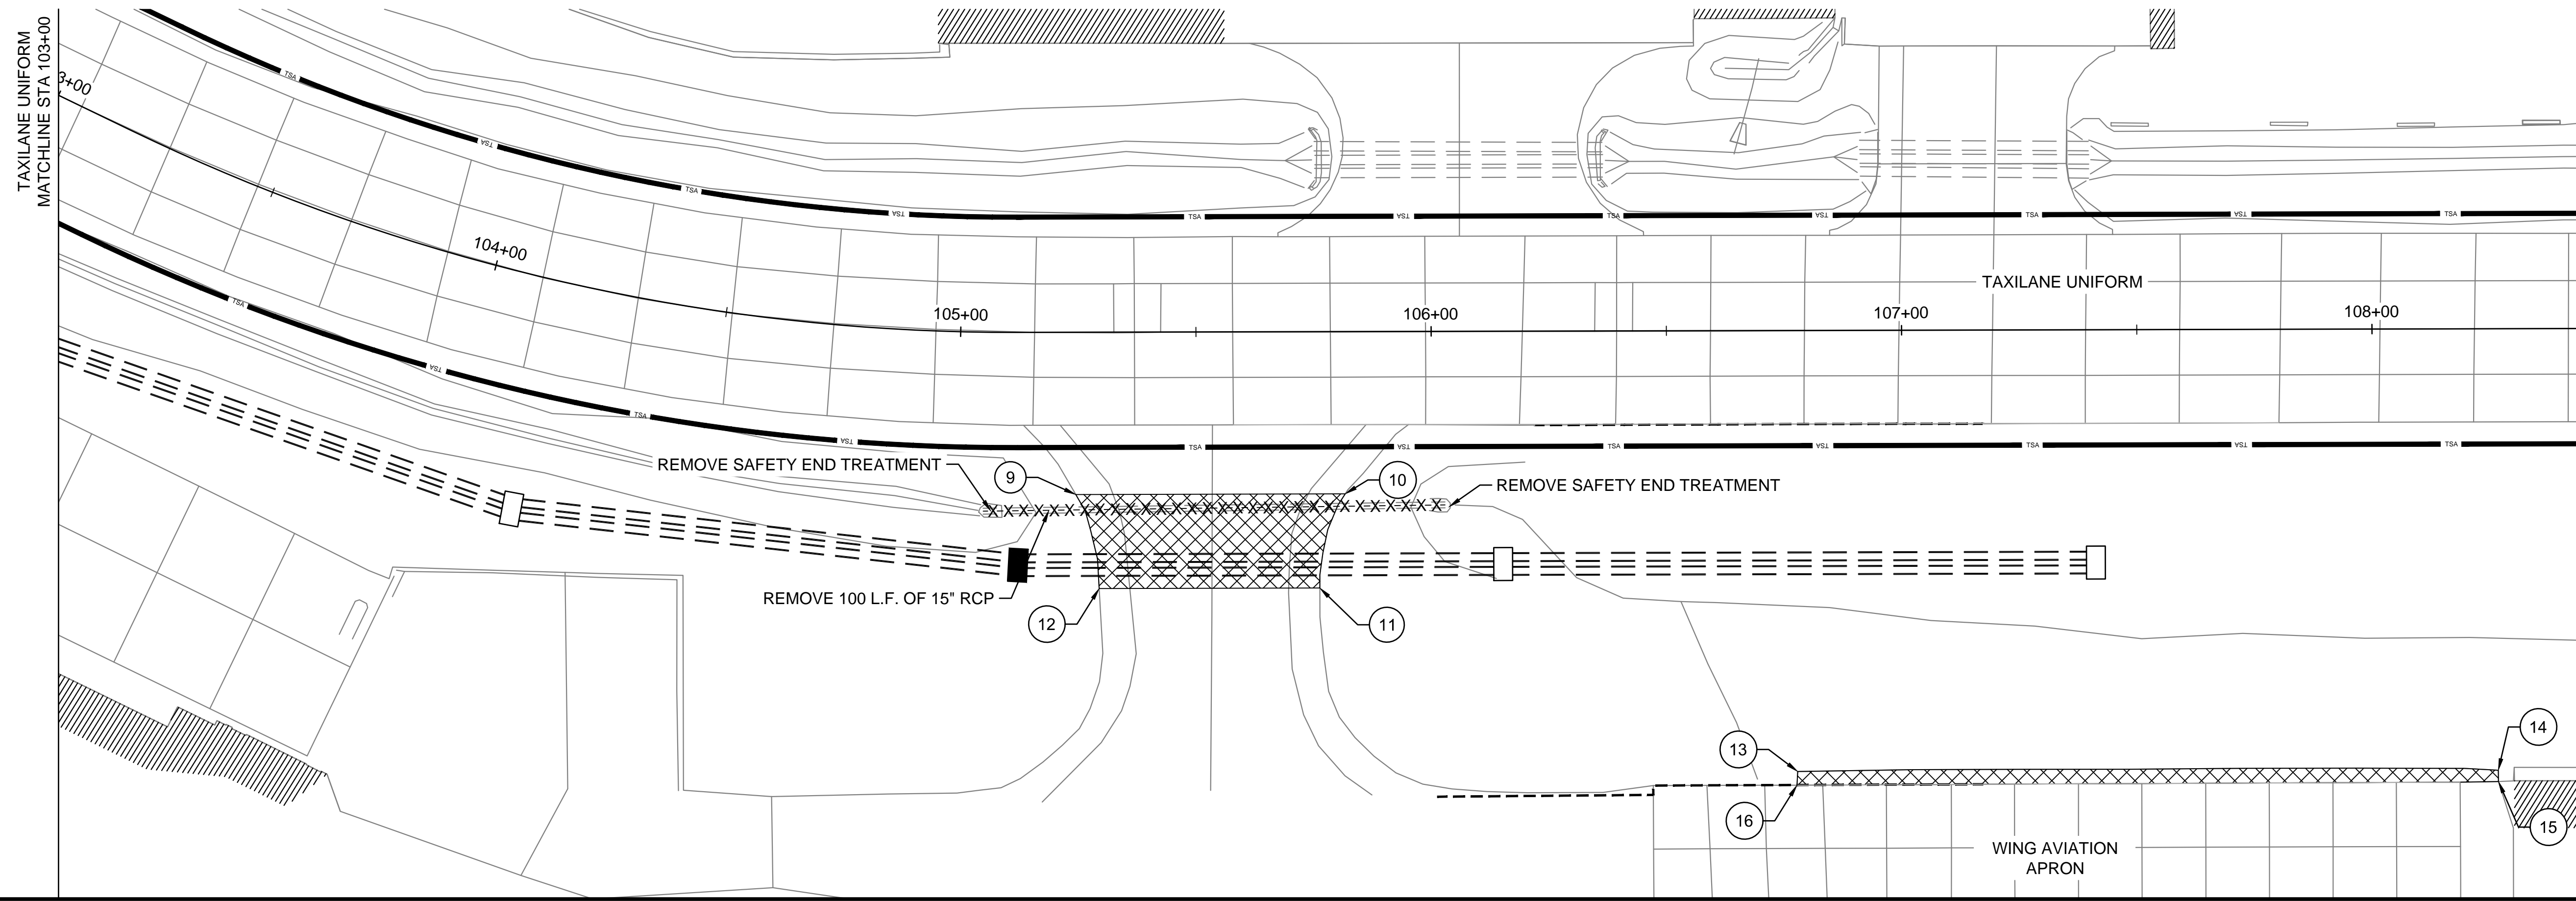

TAXILANE UNIFORM
 MATCHLINE STA 103+00

| REV. | DATE | DESCRIPTION | BY |
|------|------|-------------|----|
| | | | |
| | | | |
| | | | |

ADDISON AIRPORT
 ADDISON, TEXAS

WING AVIATION APRON CONNECTOR AND CLAIRE CHENNAULT STREET DRIVEWAY RECONSTRUCTION

WING AVIATION APRON CONNECTOR - DEMOLITION PLAN (BASE BID 1)

JOB NO.: 17081100
 DATE: JAN 2019
 DESIGNED BY: JAH
 DRAWN BY: JAH



BAR IS ONE INCH ON ORIGINAL DRAWING
 IF NOT ONE INCH ON THIS SHEET, ADJUST SCALES ACCORDINGLY.

DRAWING NUMBER
C-102

SHEET NUMBER
13

File: L:\2018\18081100 - ADS On Call Services\Drawings\RECORD\SBAA\ADS-SBA-C102-DP.dwg, Last Save: 1/21/2019 7:53 AM, Last saved by: JAHenderson
 Last plotted by: Henderson, James, A, Plot Style: AECmon.ctb, Plot Scale: 1:1, Plot Date: 1/22/2019 3:02 PM, Plotter used: AutoCAD PDF (General Documentation).pc3

File: L:\2018\18081100 - ADS On Call Services\Drawings\RECORD\SBAAADS-SBA-C104-IP.dwg Last Save: 1/22/2019 2:56 PM Last saved by: JAHenderson
 Last plotted by: Henderson, James A Plot Style: AECmon.ctb Plot Scale: 1:1 Plot Date: 1/22/2019 3:02 PM Plotter used: AutoCAD PDF (General Documentation).pc3

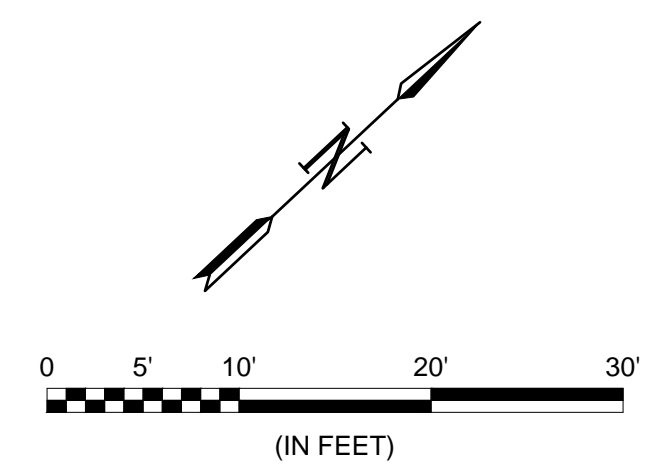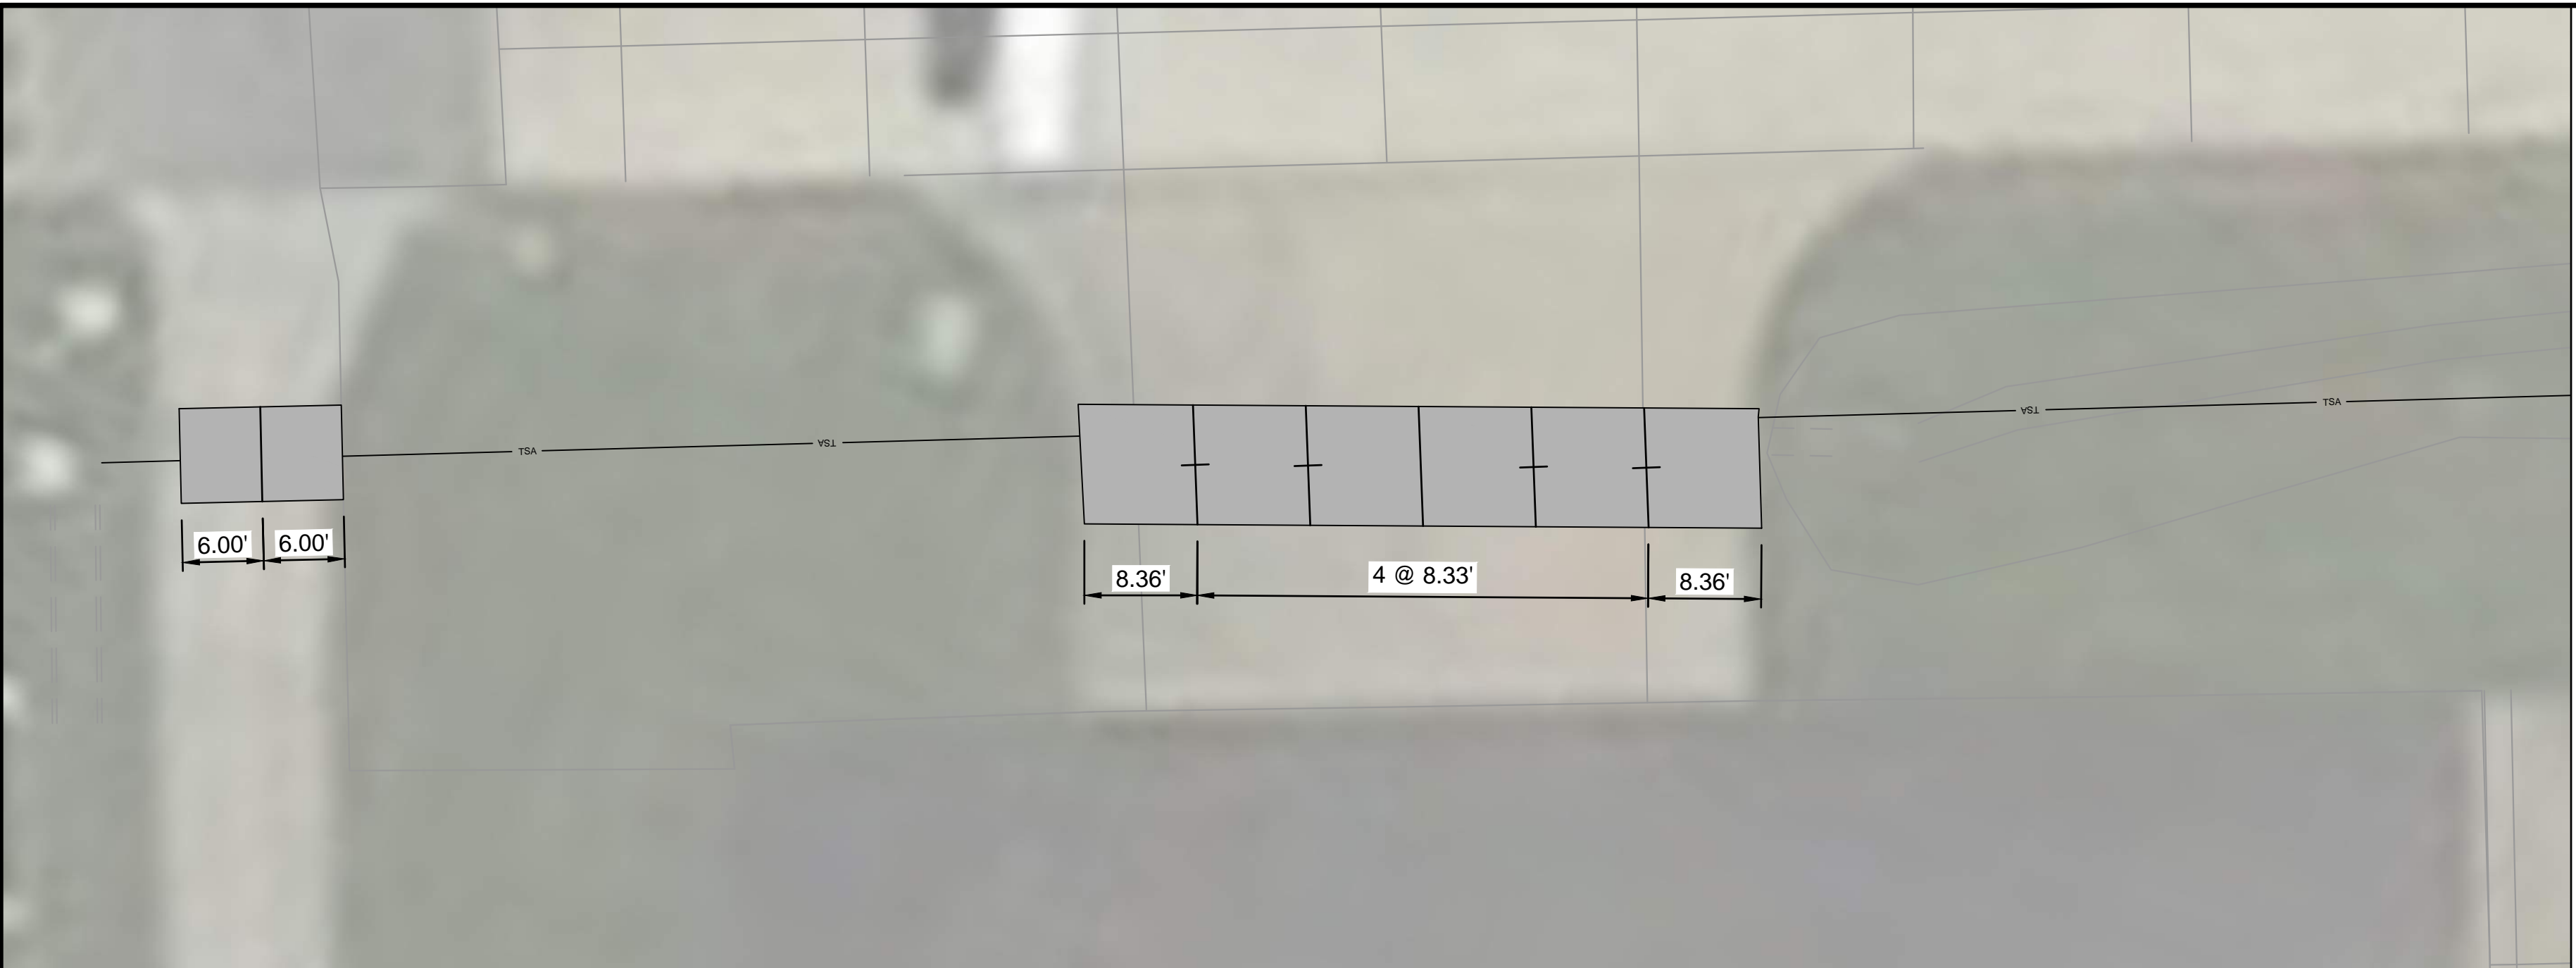


PAVEMENT JOINT LEGEND

- TYPE "A-1" - REINFORCED ISOLATION JOINT
- TYPE "E" - DOWELED CONSTRUCTION JOINT
- TYPE "C" - DOWELED CONTRACTION JOINT
- TYPE "B" - HINGED CONTRACTION JOINT

© 2017 GARVER, LLC
 THIS DOCUMENT, ALONG WITH THE IDEAS AND DESIGNS CONVEYED HEREIN, SHALL BE CONSIDERED INSTRUMENTS OF PROFESSIONAL SERVICE AND ARE PROPERTY OF GARVER, LLC. ANY USE, REPRODUCTION, OR DISTRIBUTION OF THIS DOCUMENT, ALONG WITH THE IDEAS AND DESIGN CONTAINED HEREIN, IS PROHIBITED UNLESS AUTHORIZED IN WRITING BY GARVER, LLC OR EXPLICITLY ALLOWED IN THE GOVERNING PROFESSIONAL SERVICES AGREEMENT FOR THIS WORK.

REGISTRATION NO.
F-5713

RECORD DRAWINGS
1/22/2019

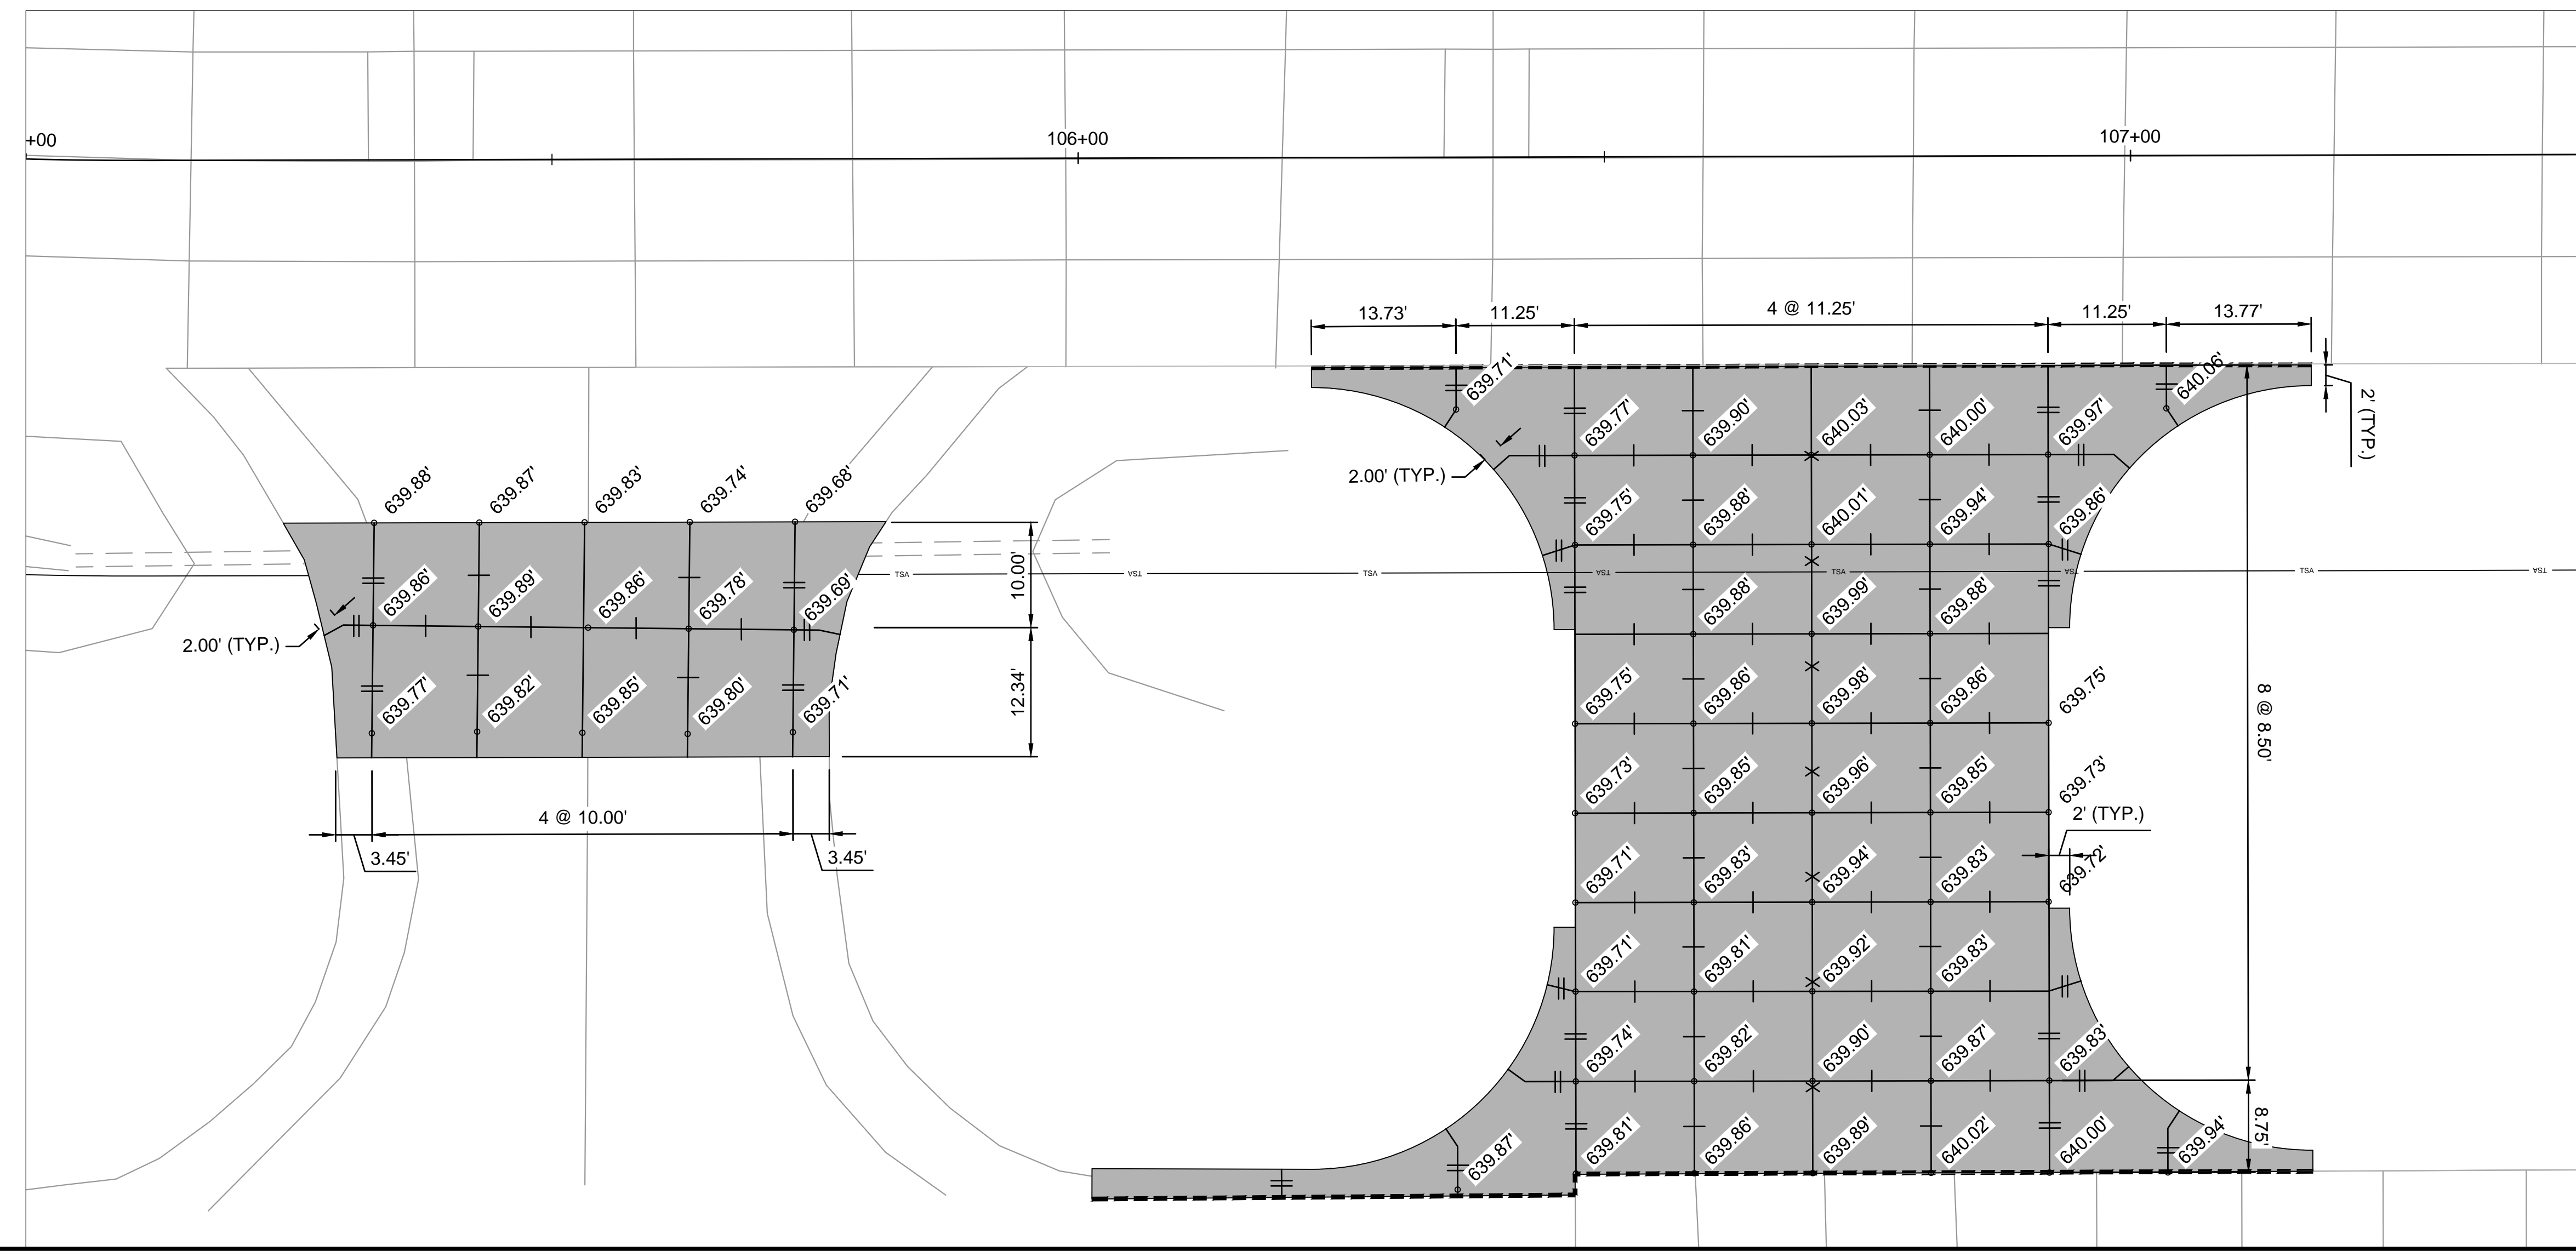

| REV. | DATE | DESCRIPTION | BY |
|------|------|-------------|----|
| | | | |
| | | | |
| | | | |

ADDISON AIRPORT
ADDISON, TEXAS

WING AVIATION APRON CONNECTOR
AND CLAIRE CHENNAULT STREET
DRIVEWAY RECONSTRUCTION

WING AVIATION
APRON CONNECTOR -
JOINT LAYOUT PLAN
(BASE BID 1)

JOB NO.: 17081100
 DATE: JAN 2019
 DESIGNED BY: JAH
 DRAWN BY: JAH

BAR IS ONE INCH ON ORIGINAL DRAWING
 IF NOT ONE INCH ON THIS SHEET, ADJUST SCALES ACCORDINGLY.

DRAWING NUMBER
C-104


SHEET NUMBER
15



© 2017 GARVER, LLC
 THIS DOCUMENT, ALONG WITH THE IDEAS AND DESIGNS CONVEYED HEREIN, SHALL BE CONSIDERED INSTRUMENTS OF PROFESSIONAL SERVICE AND ARE PROPERTY OF GARVER, LLC. ANY USE, REPRODUCTION, OR DISTRIBUTION OF THIS DOCUMENT, ALONG WITH THE IDEAS AND DESIGN CONTAINED HEREIN, IS PROHIBITED UNLESS AUTHORIZED IN WRITING BY GARVER, LLC OR EXPLICITLY ALLOWED IN THE GOVERNING PROFESSIONAL SERVICES AGREEMENT FOR THIS WORK.




REGISTRATION NO. F-5713

RECORD DRAWINGS
 1/22/2019

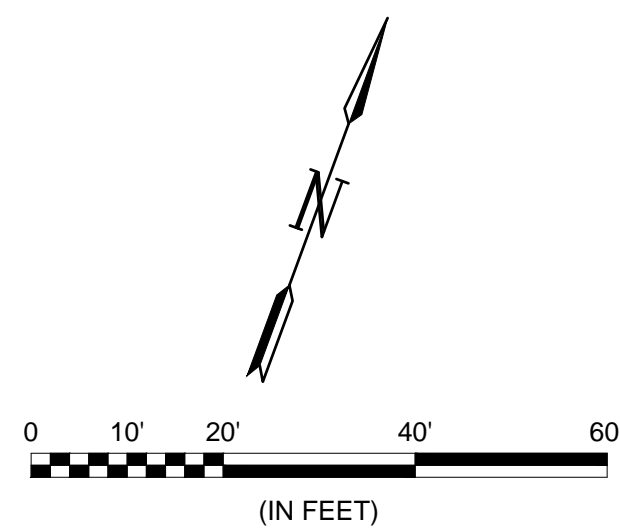

LEGEND

- PROPOSED PAVEMENT
- PROPOSED 2-18" RCP
- EXISTING RCP

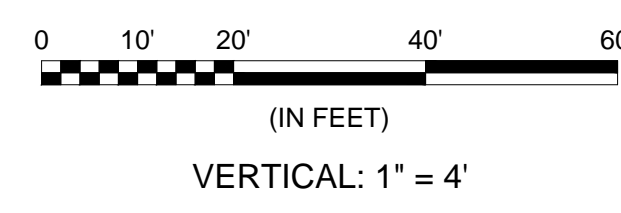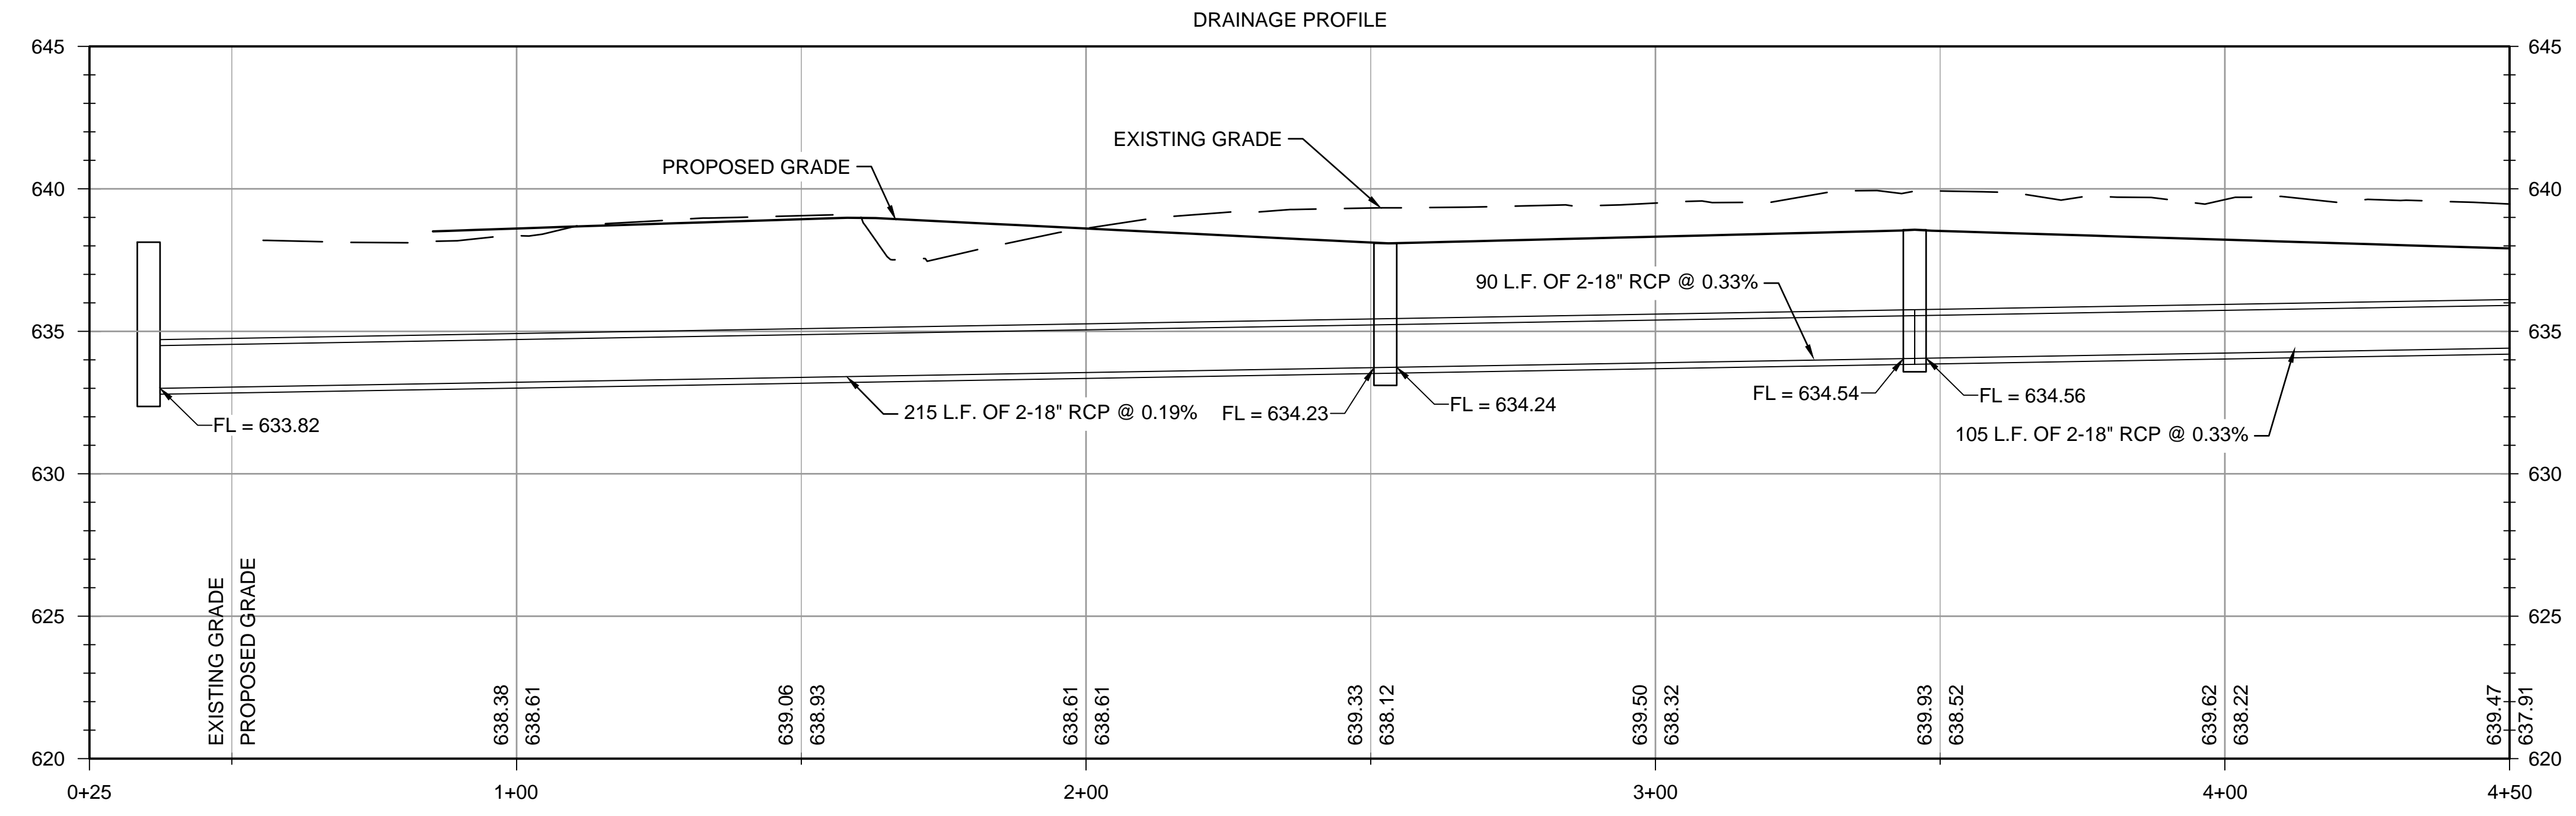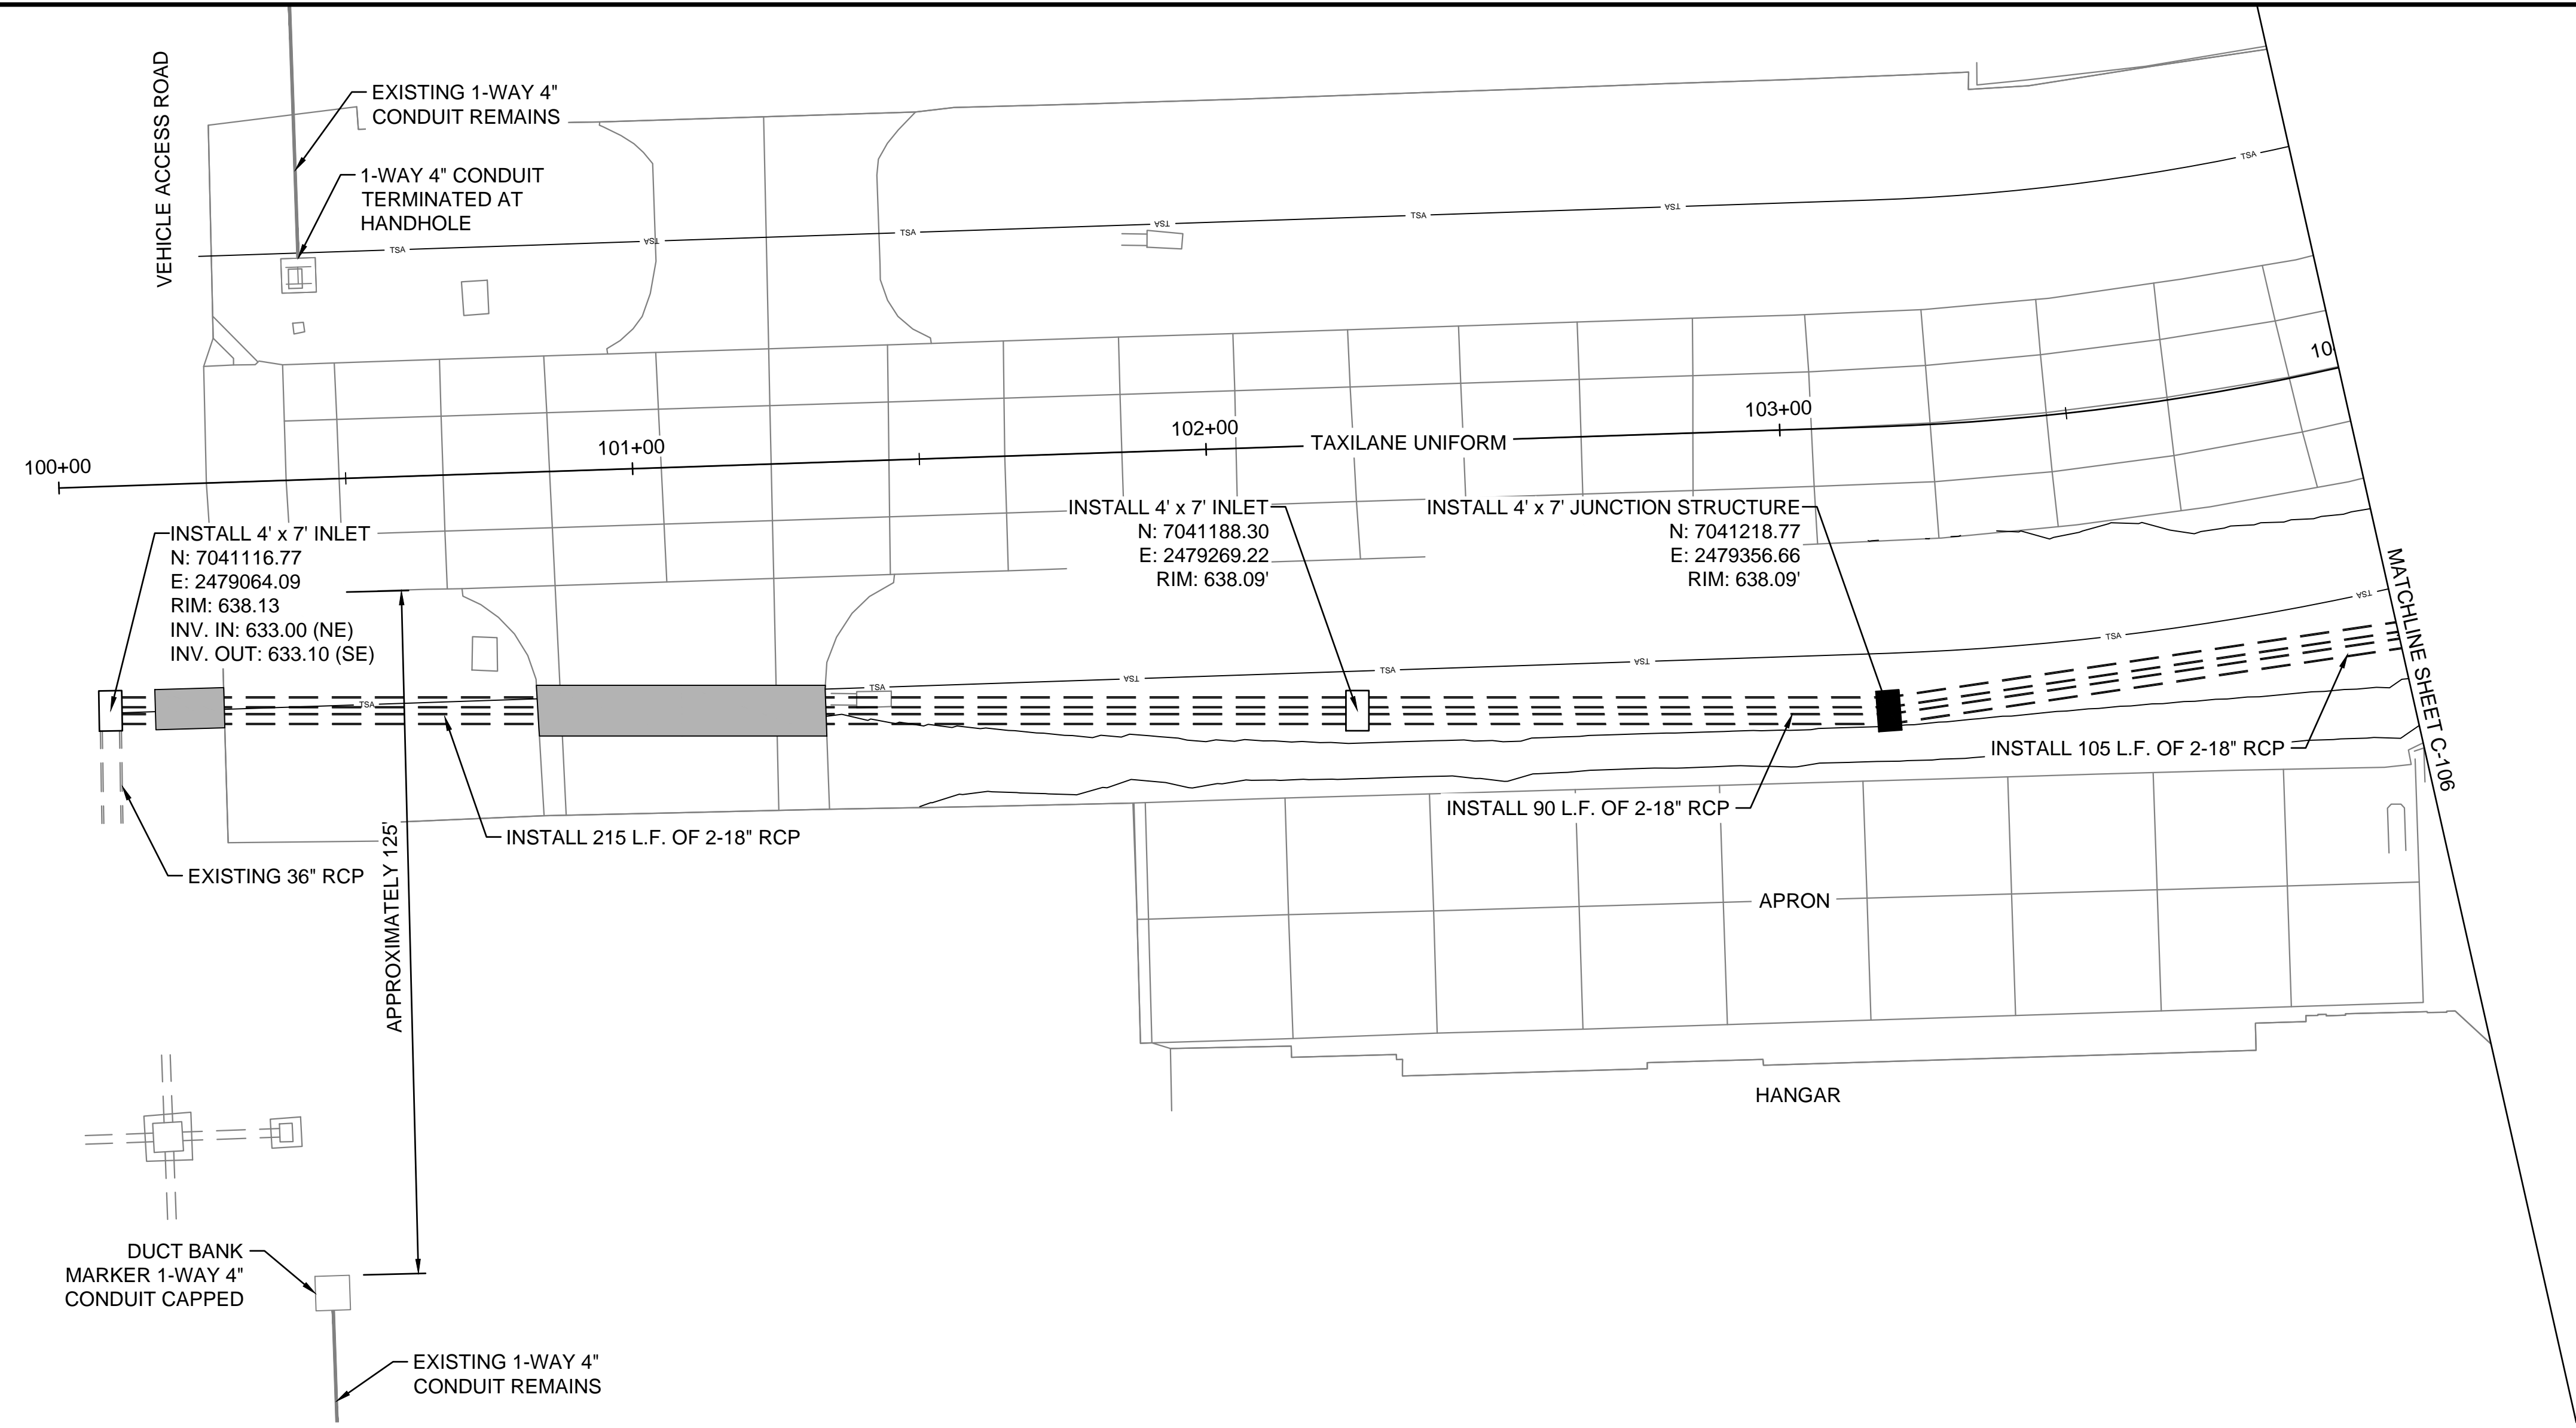

File: L:\2018\18081100 - ADS On Call Services\Drawings\RECORD\SBAA\ADS-SBA-C105-LP.dwg, Last Save: 1/22/2019 2:24 PM, Last saved by: JAHenderson
 Last plotted by: Henderson, James, A Plot Style: AECmon.ctb Plot Scale: 1:1 Plot Date: 1/22/2019 3:03 PM Plotter User: AutoCAD PDF (General Documentation).pc3

| REV. | DATE | DESCRIPTION | BY |
|------|------|-------------|----|
| | | | |
| | | | |
| | | | |

ADDISON AIRPORT
 ADDISON, TEXAS

WING AVIATION APRON CONNECTOR AND CLAIRE CHENNAULT STREET DRIVEWAY RECONSTRUCTION

WING AVIATION APRON CONNECTOR - DRAINAGE PLAN I (BASE BID 1)

JOB NO.: 17081100
 DATE: JAN 2019
 DESIGNED BY: JAH
 DRAWN BY: JAH

BAR IS ONE INCH ON ORIGINAL DRAWING
 IF NOT ONE INCH ON THIS SHEET, ADJUST SCALES ACCORDINGLY.

DRAWING NUMBER
C-105

SHEET NUMBER
16



© 2017 GARVER, LLC
 THIS DOCUMENT, ALONG WITH THE IDEAS AND DESIGNS CONVEYED HEREIN, SHALL BE CONSIDERED INSTRUMENTS OF PROFESSIONAL SERVICE AND ARE PROPERTY OF GARVER, LLC. ANY USE, REPRODUCTION, OR DISTRIBUTION OF THIS DOCUMENT, ALONG WITH THE IDEAS AND DESIGN CONTAINED HEREIN, IS PROHIBITED UNLESS AUTHORIZED IN WRITING BY GARVER, LLC OR EXPLICITLY ALLOWED IN THE GOVERNING PROFESSIONAL SERVICES AGREEMENT FOR THIS WORK.

REGISTRATION NO. F-5713

RECORD DRAWINGS
 1/22/2019

| REV. | DATE | DESCRIPTION | BY |
|------|------|-------------|----|
| | | | |
| | | | |
| | | | |

ADDISON AIRPORT
 ADDISON, TEXAS
 WING AVIATION APRON CONNECTOR AND CLAIRE CHENNAULT STREET DRIVEWAY RECONSTRUCTION






WING AVIATION APRON CONNECTOR - DRAINAGE PLAN II (BASE BID 1)

JOB NO.: 17081100
 DATE: JAN 2019
 DESIGNED BY: JAH
 DRAWN BY: JAH

BAR IS ONE INCH ON ORIGINAL DRAWING
 IF NOT ONE INCH ON THIS SHEET, ADJUST SCALES ACCORDINGLY.

DRAWING NUMBER
C-106

SHEET NUMBER
17

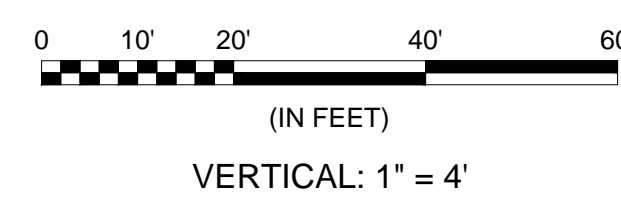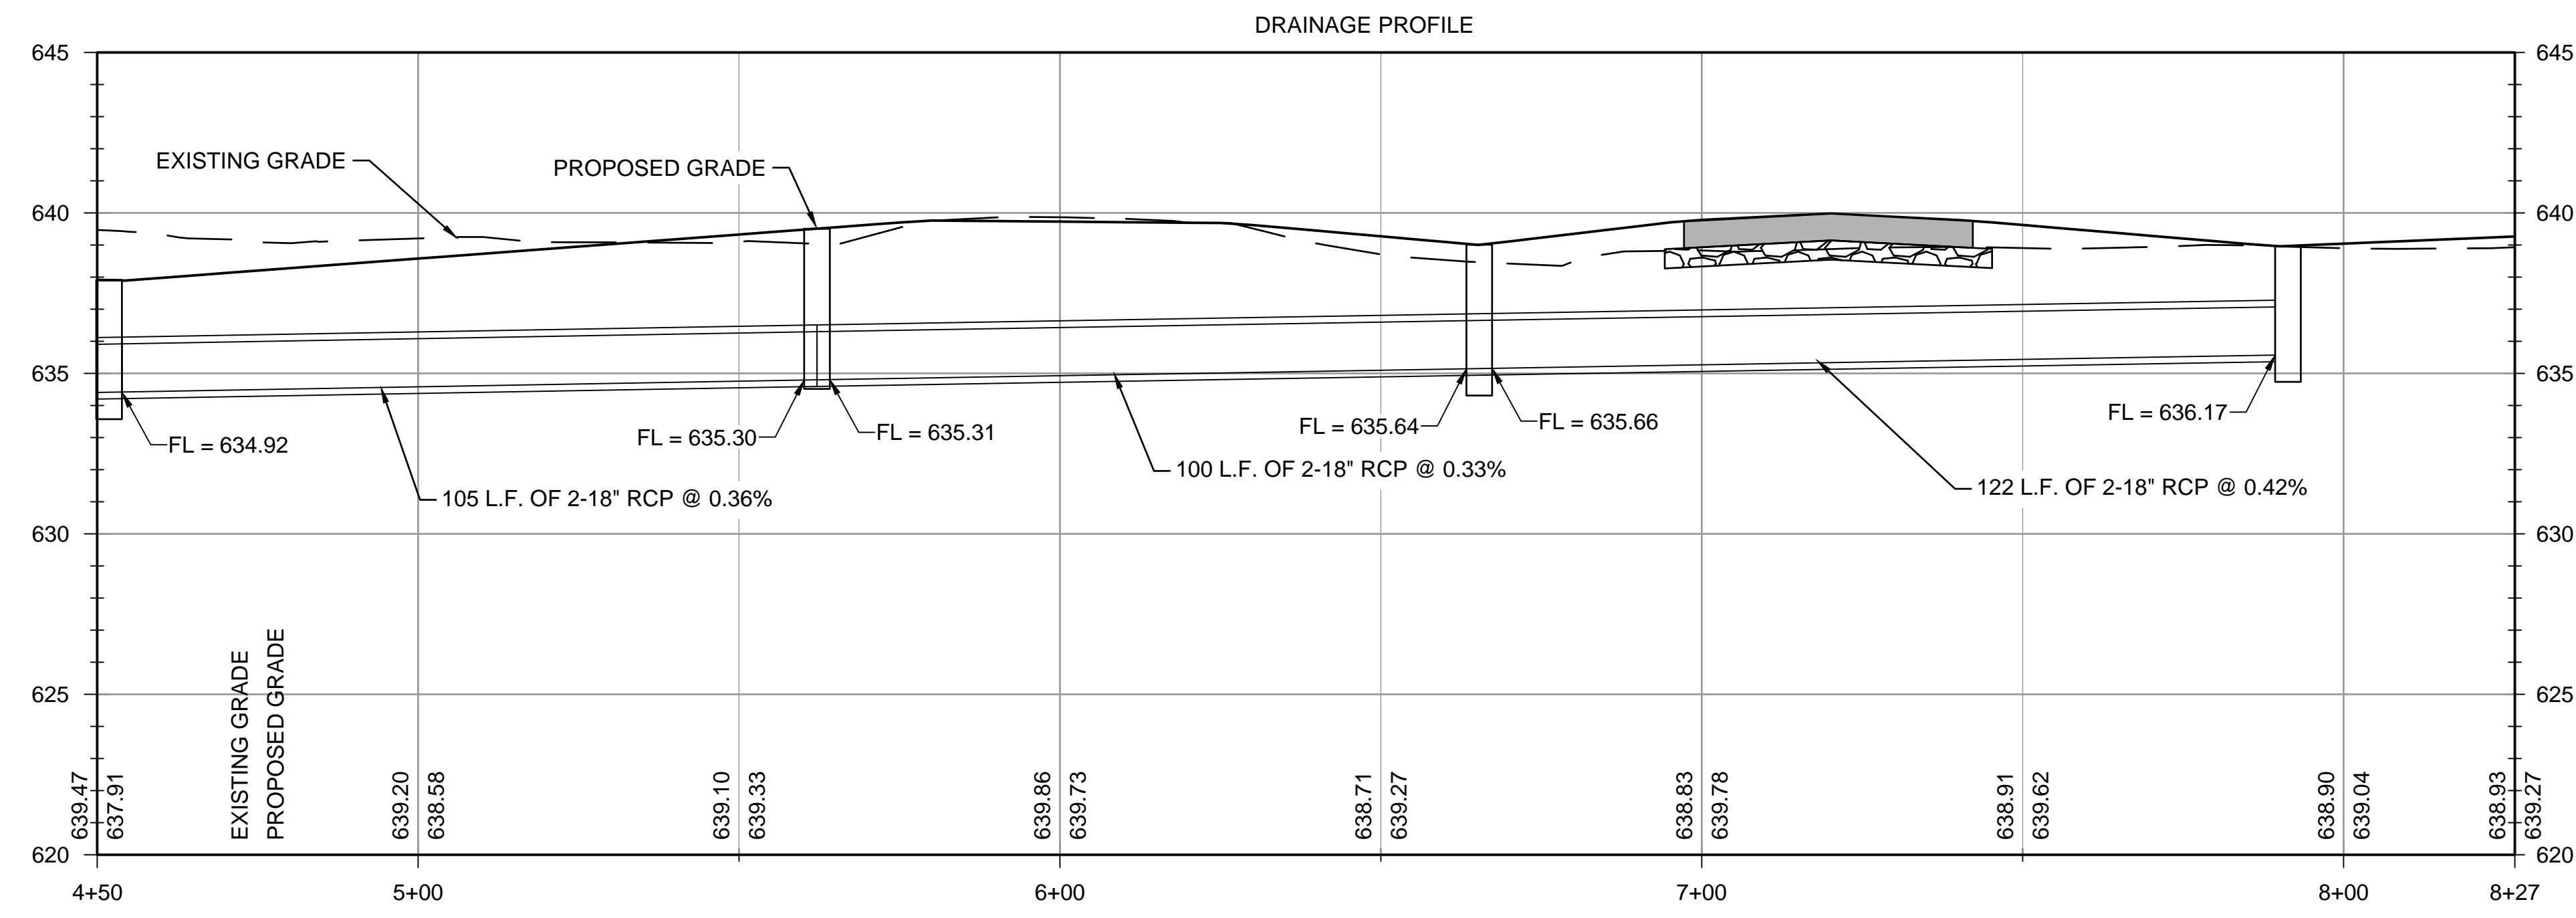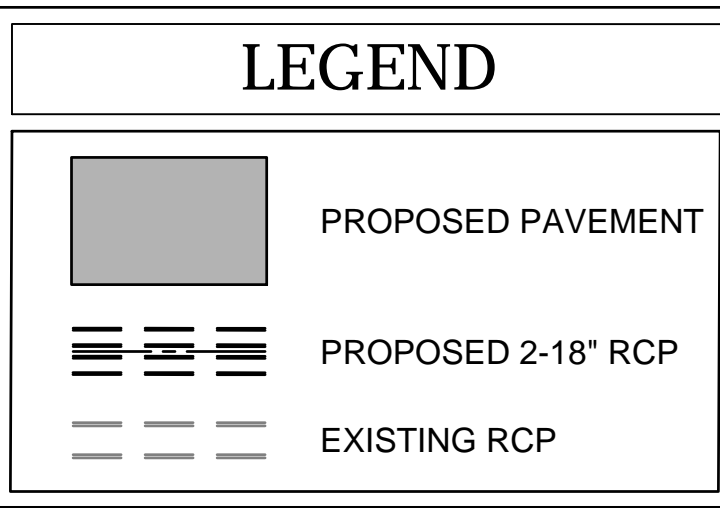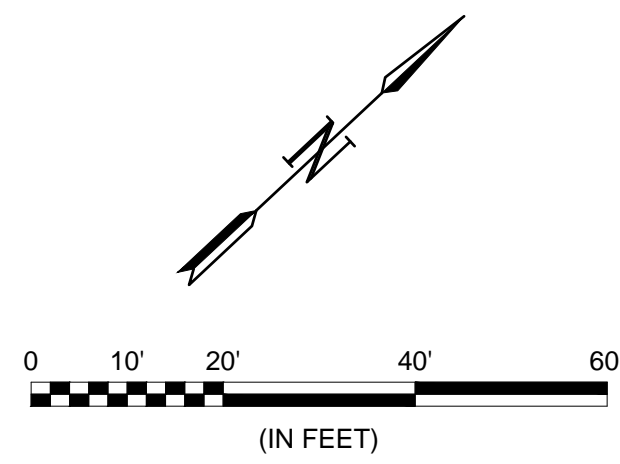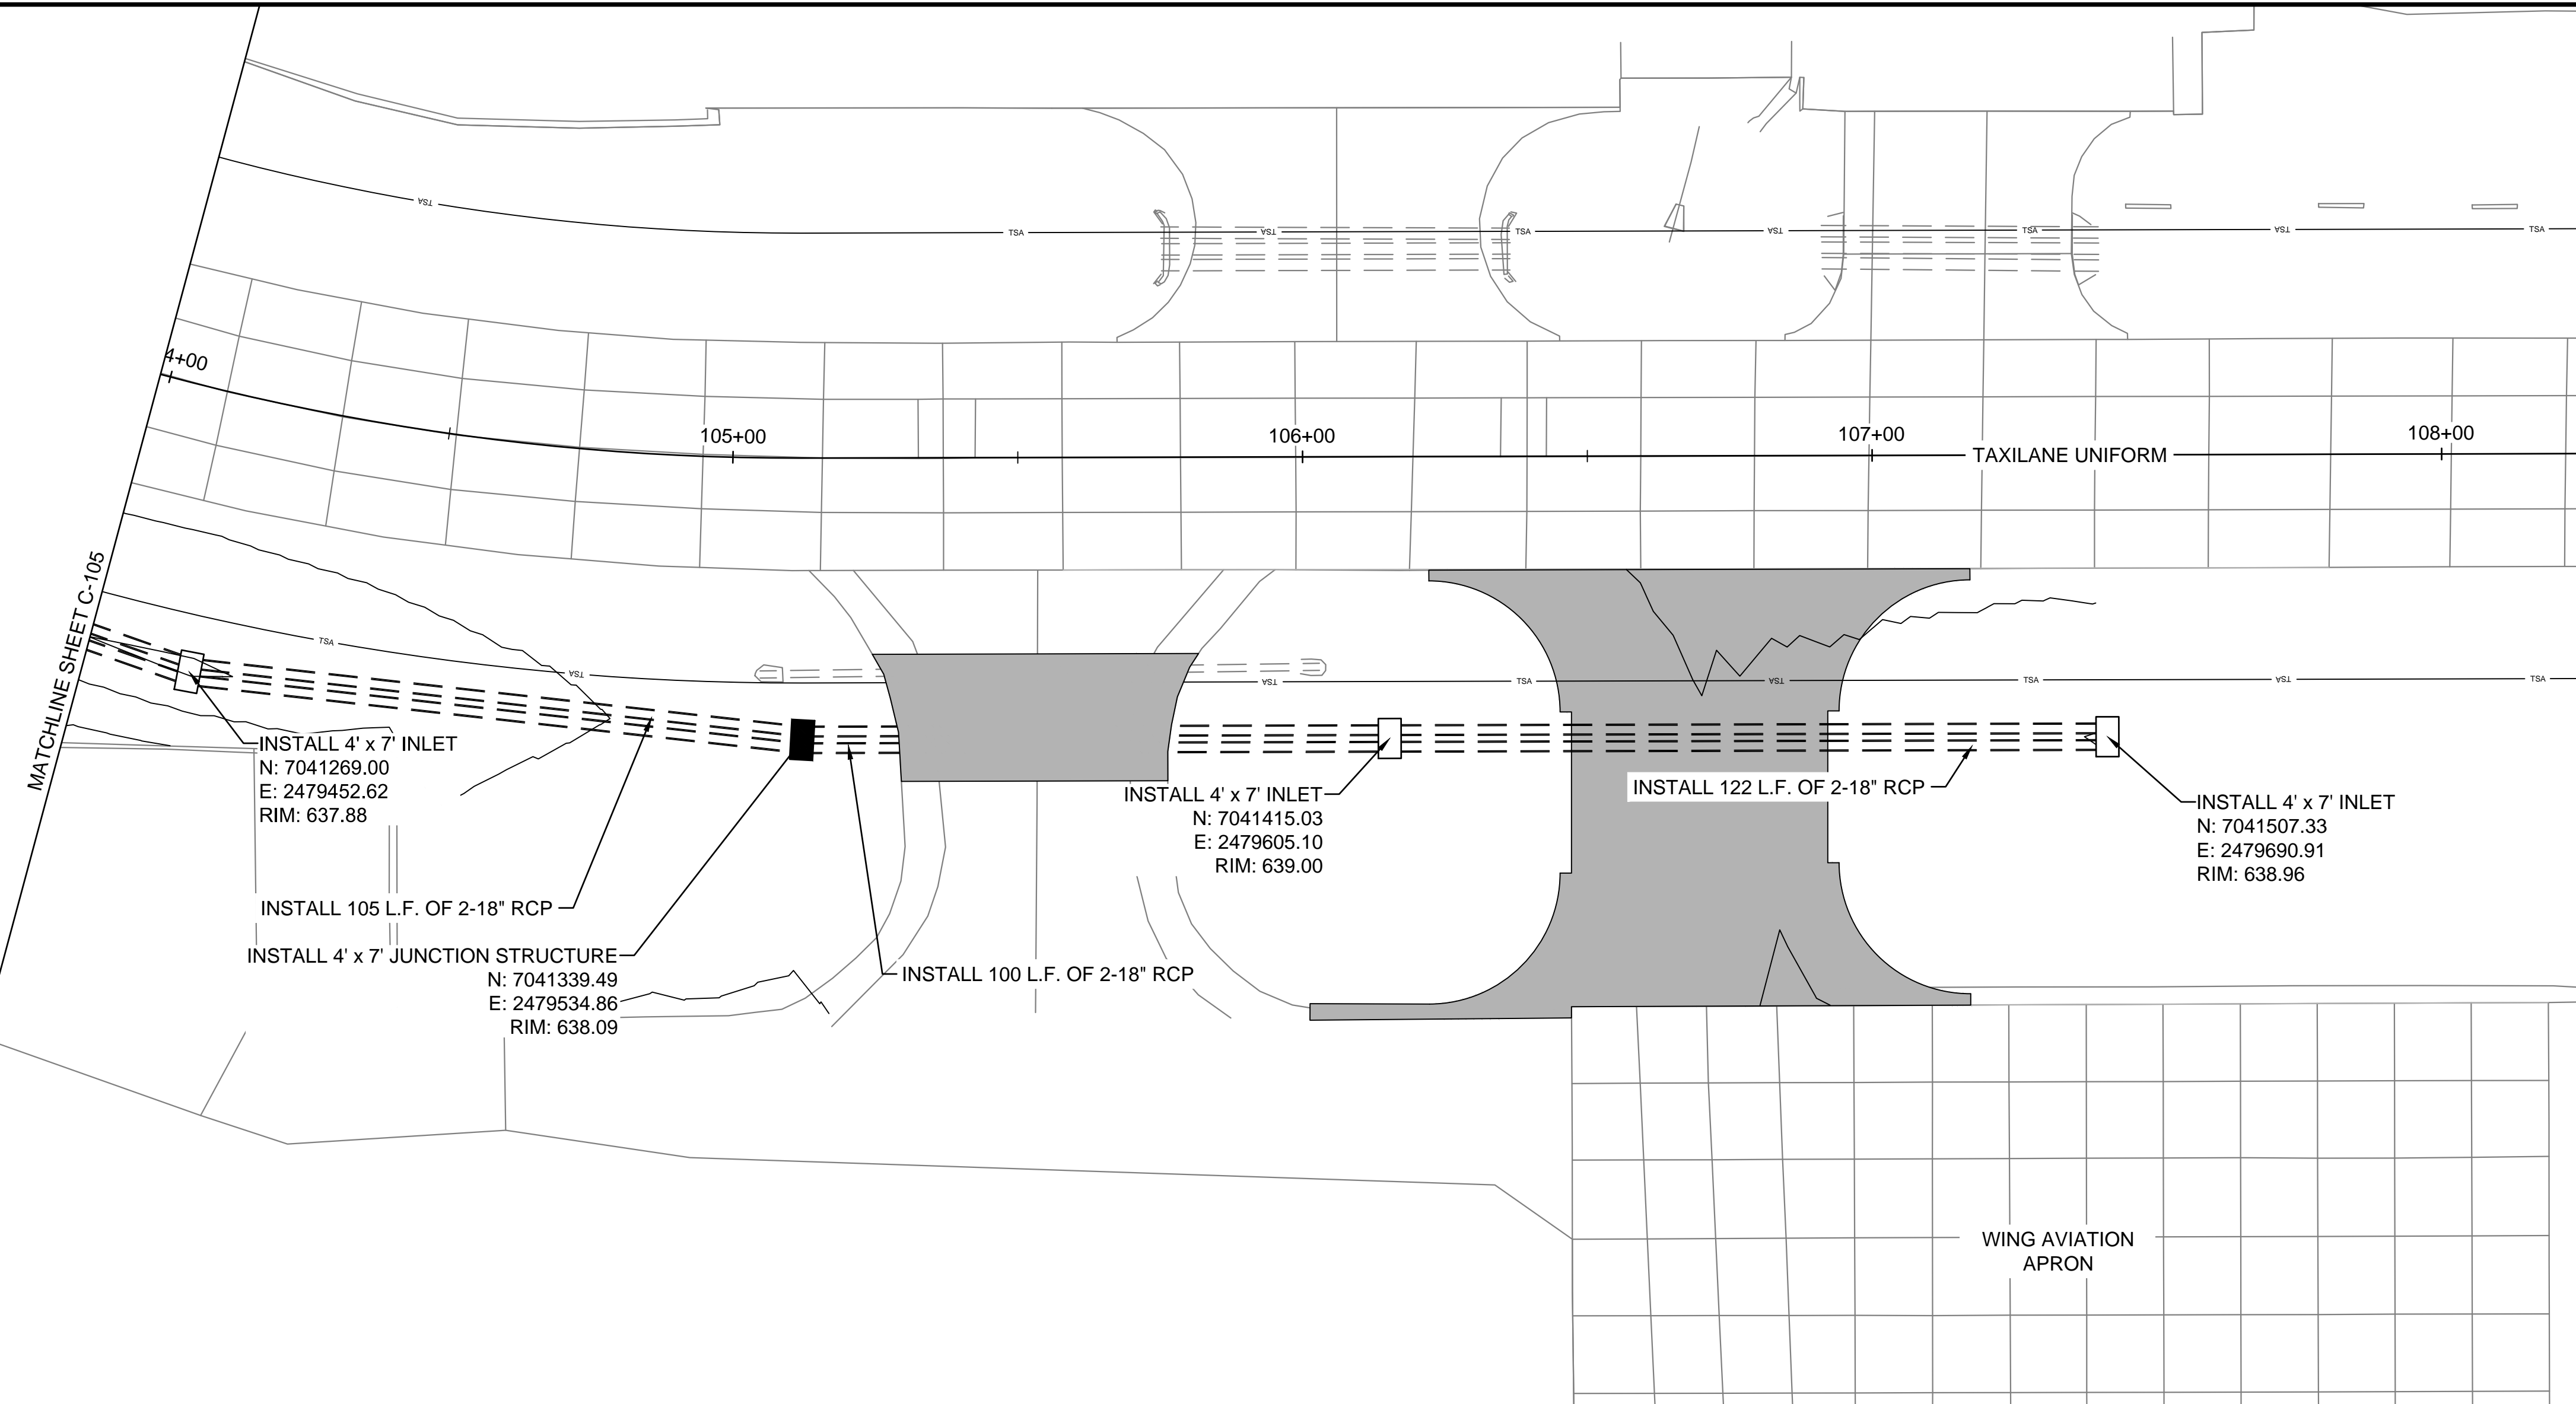


File: L:\2018\18081100 - ADS On Call Services\Drawings\RECORD\SBAA\ADS-SBA-C105-LP.dwg, Last Save: 1/22/2019 2:24 PM, Last saved by: JAHenderson
 Last plotted by: Henderson, James, A Plot Style: AECmono.ctb Plot Scale: 1:1 Plot Date: 1/22/2019 3:03 PM Plotter used: AutoCAD PDF (General Documentation).pc3




© 2017 GARVER, LLC
 THIS DOCUMENT, ALONG WITH THE IDEAS AND DESIGNS CONVEYED HEREIN, SHALL BE CONSIDERED INSTRUMENTS OF PROFESSIONAL SERVICE AND ARE PROPERTY OF GARVER, LLC. ANY USE, REPRODUCTION, OR DISTRIBUTION OF THIS DOCUMENT, ALONG WITH THE IDEAS AND DESIGN CONTAINED HEREIN, IS PROHIBITED UNLESS AUTHORIZED IN WRITING BY GARVER, LLC OR EXPLICITLY ALLOWED IN THE GOVERNING PROFESSIONAL SERVICES AGREEMENT FOR THIS WORK.

REGISTRATION NO. F-5713

RECORD DRAWINGS
 1/22/2019

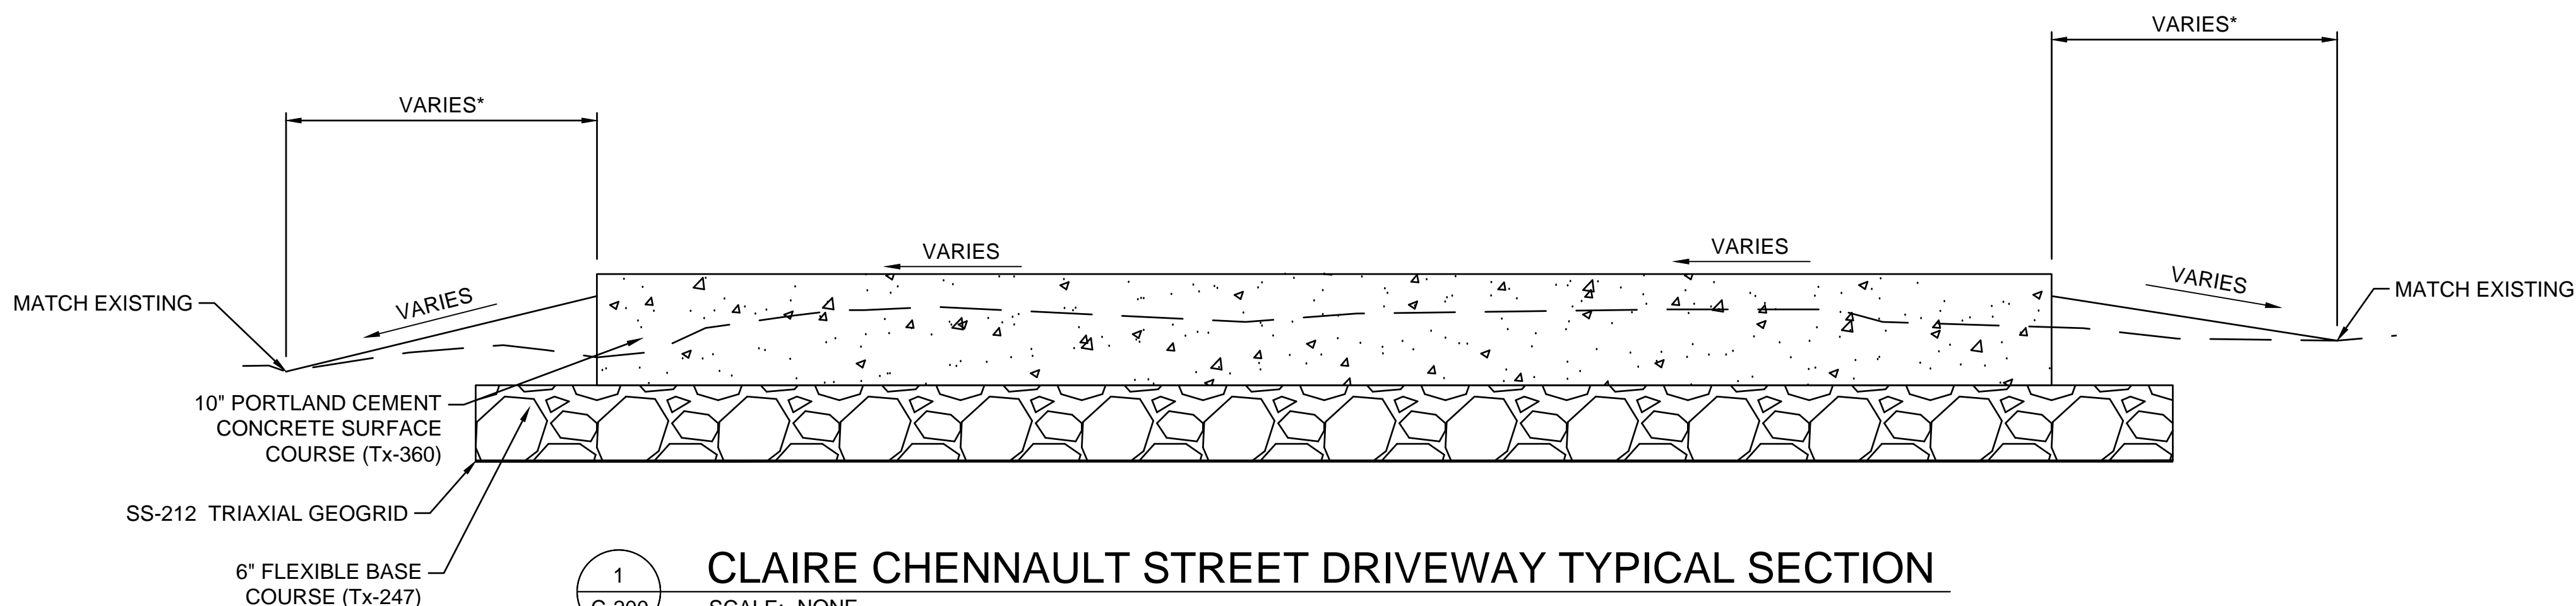

1 CLAIRE CHENNAULT STREET DRIVEWAY TYPICAL SECTION
 SCALE: NONE
 *SEE PLANS FOR LIMITS

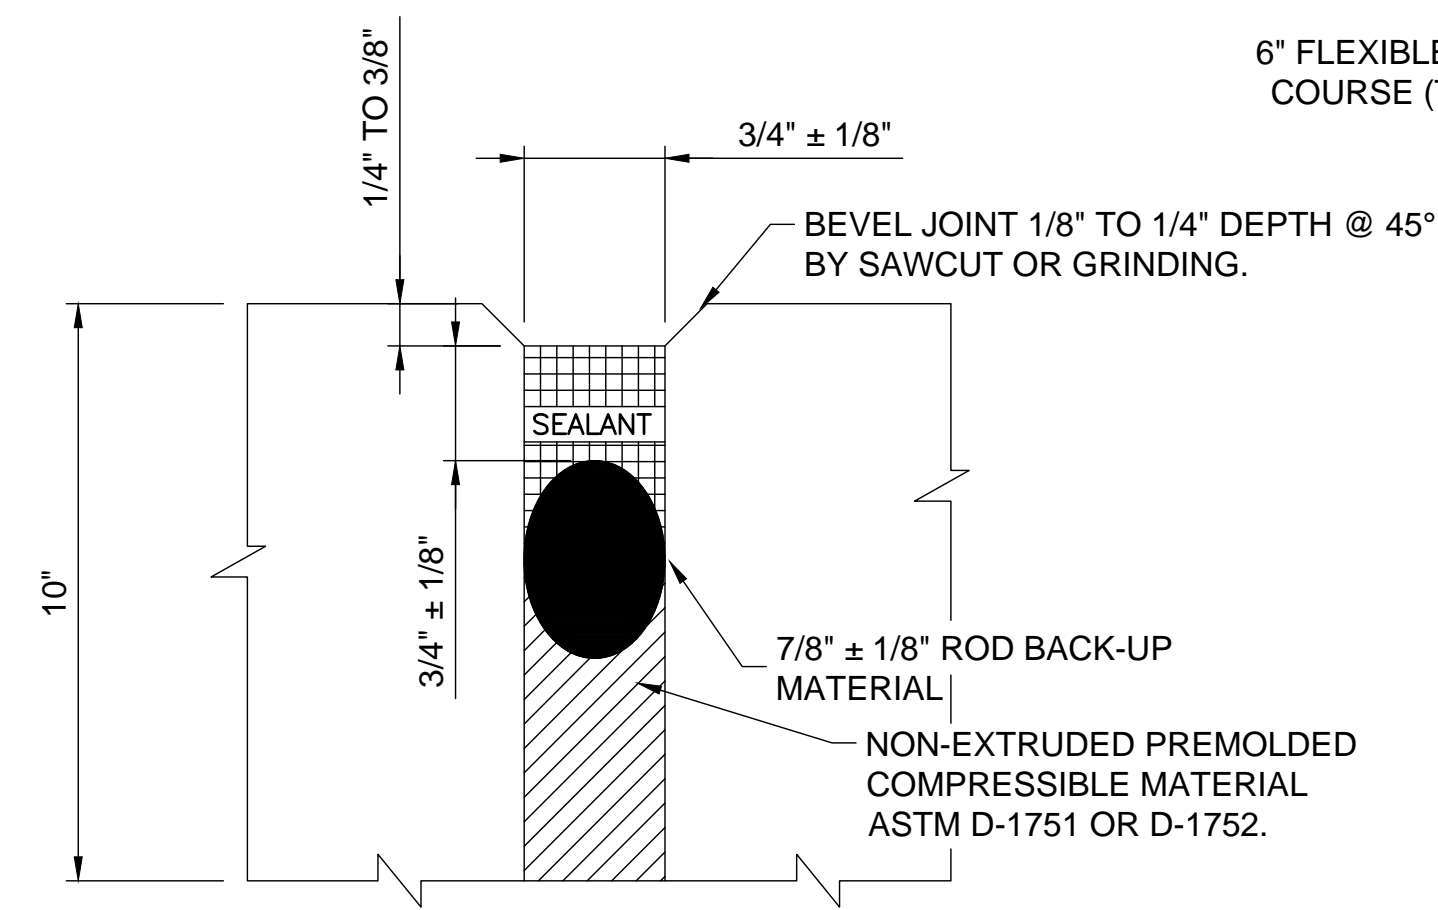


2 DETAIL 1-ISOLATION JOINTS
 SCALE: NONE


SYMBOLS

- SEALANT
- ROD BACK-UP MATERIAL CLOSED-CELL RESILIENT FOAM OR SPONGE RUBBER
- RESILIENT FILLER


| DOWEL BAR LEGEND | |
|------------------|--------------------|
| | 10" SLAB THICKNESS |
| | DIAMETER = 3/4" |
| | LENGTH = 18" |
| | SPACING = 12" O.C. |

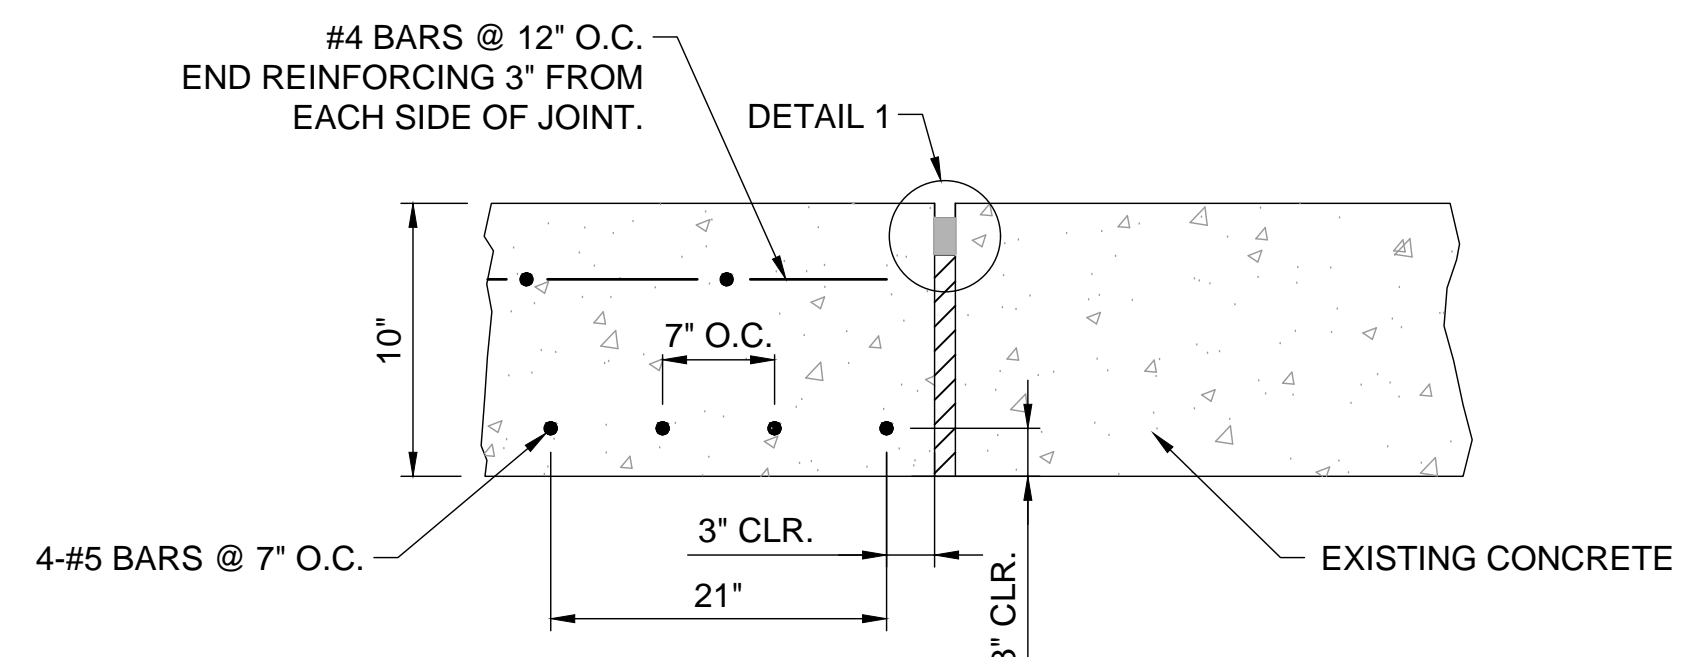


7 TYPE A-1-REINFORCED ISOLATION JOINT
 SCALE: NONE

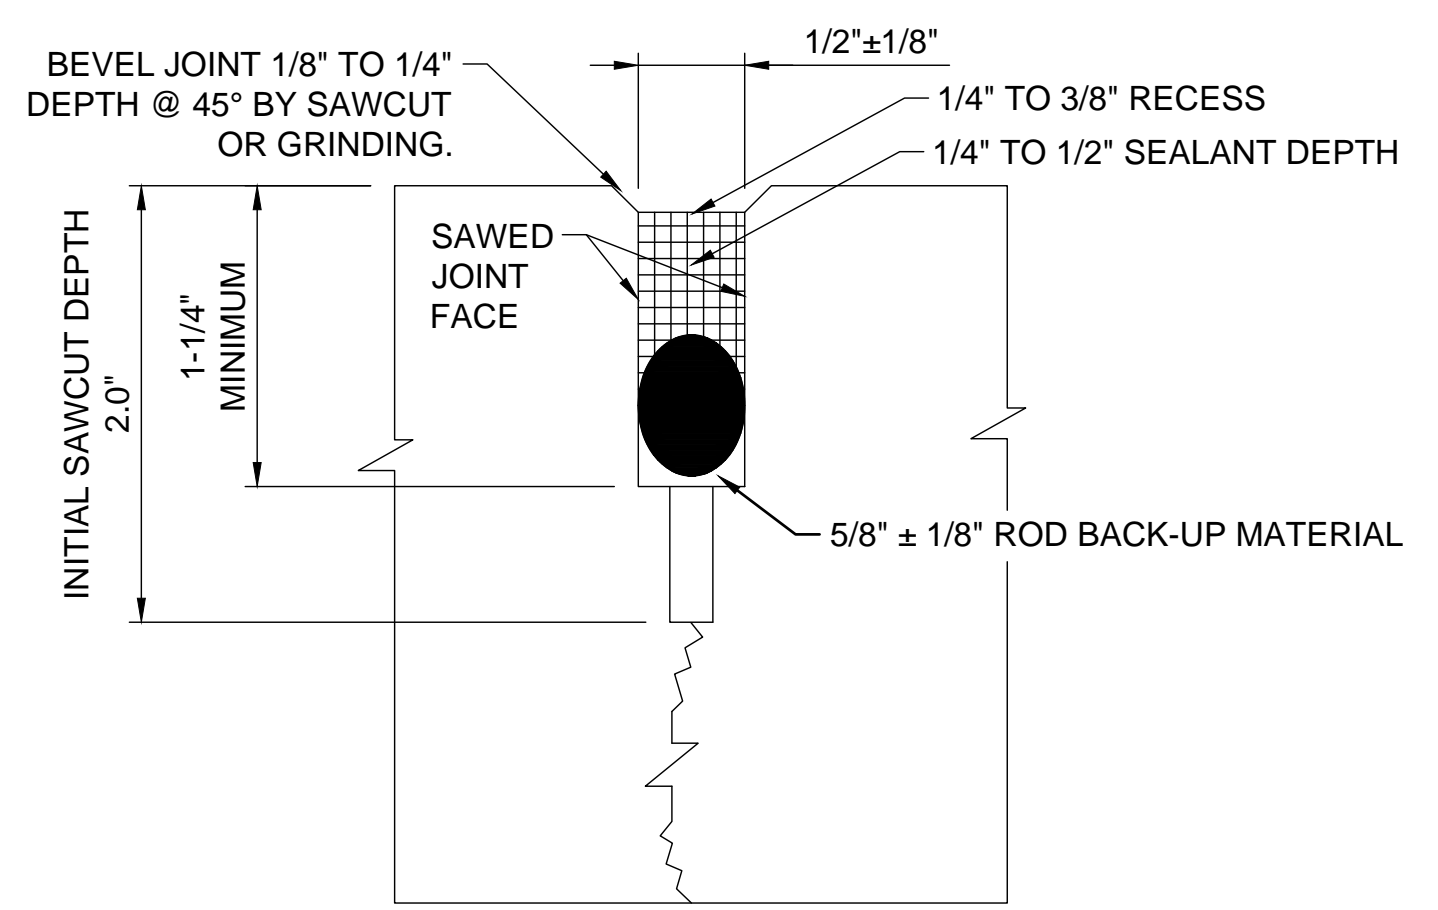


3 DETAIL 2-CONTRACTION JOINTS
 SCALE: NONE

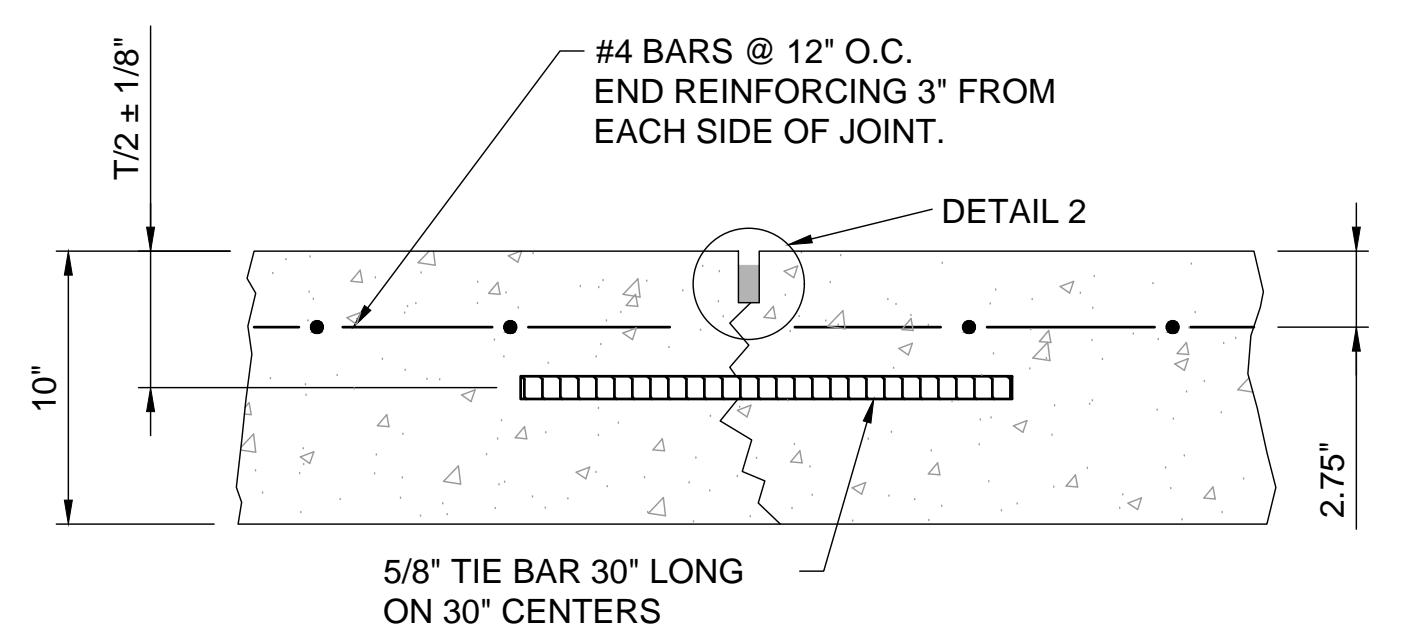


5 TYPE B-HINGED CONTRACTION JOINT
 SCALE: NONE

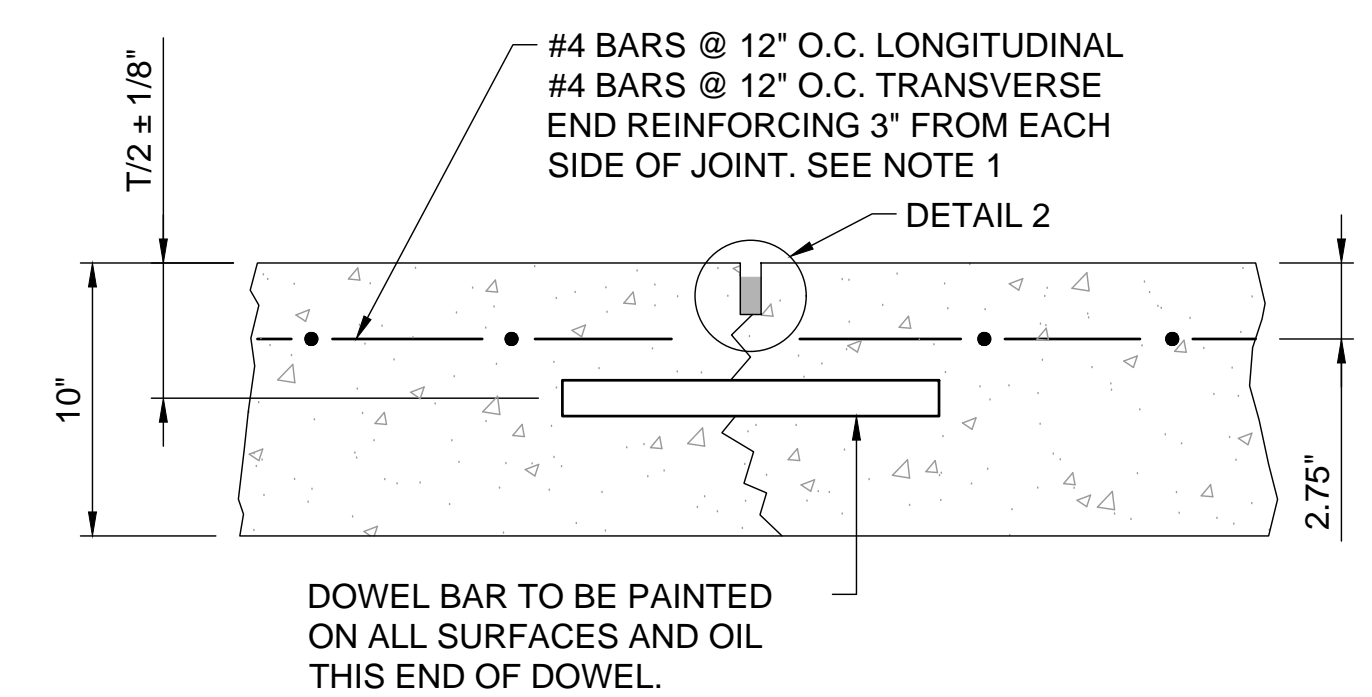


8 TYPE C-DOWELED CONTRACTION JOINT
 SCALE: NONE

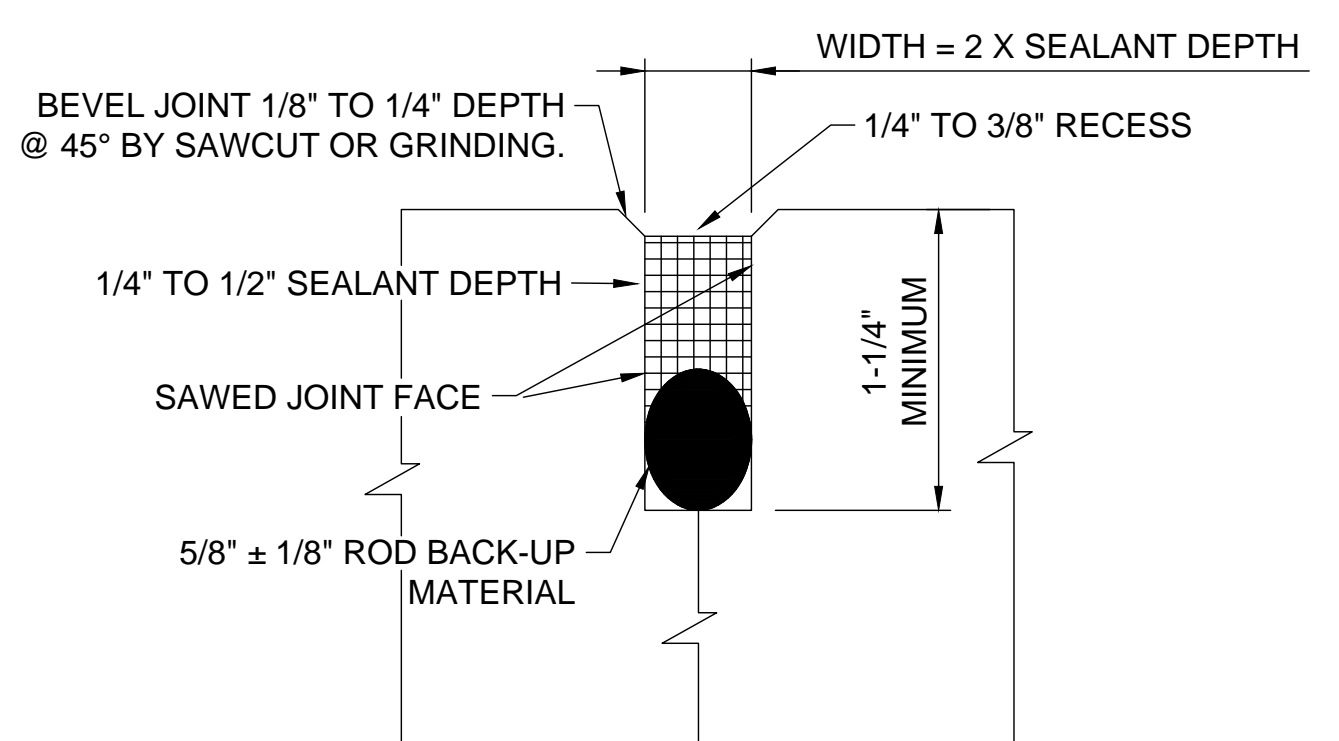

4 DETAIL 3-CONSTRUCTION JOINTS
 SCALE: NONE

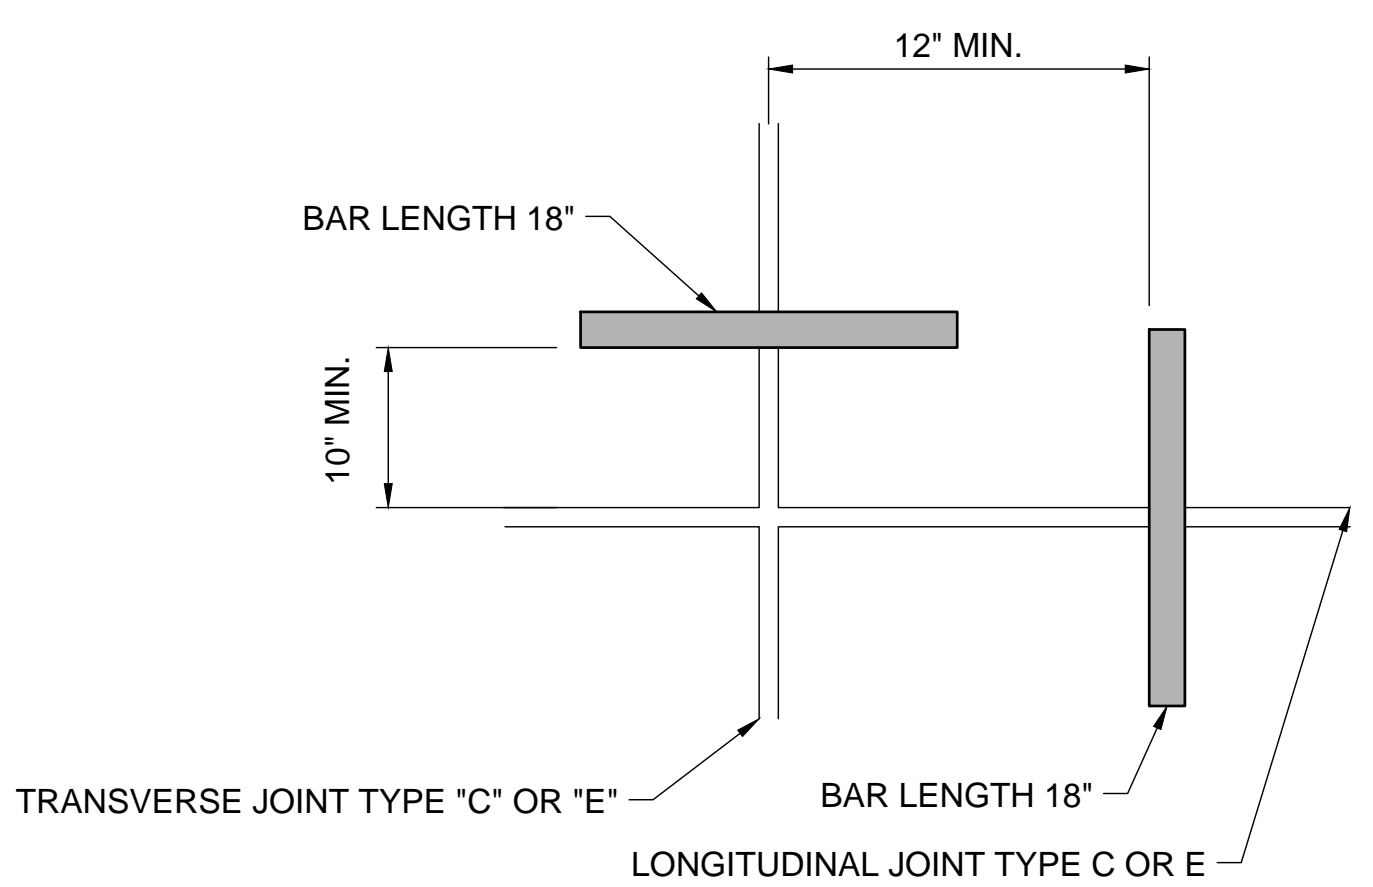

6 DOWEL BARS AT SLAB CORNERS (PLAN VIEW)
 SCALE: NONE

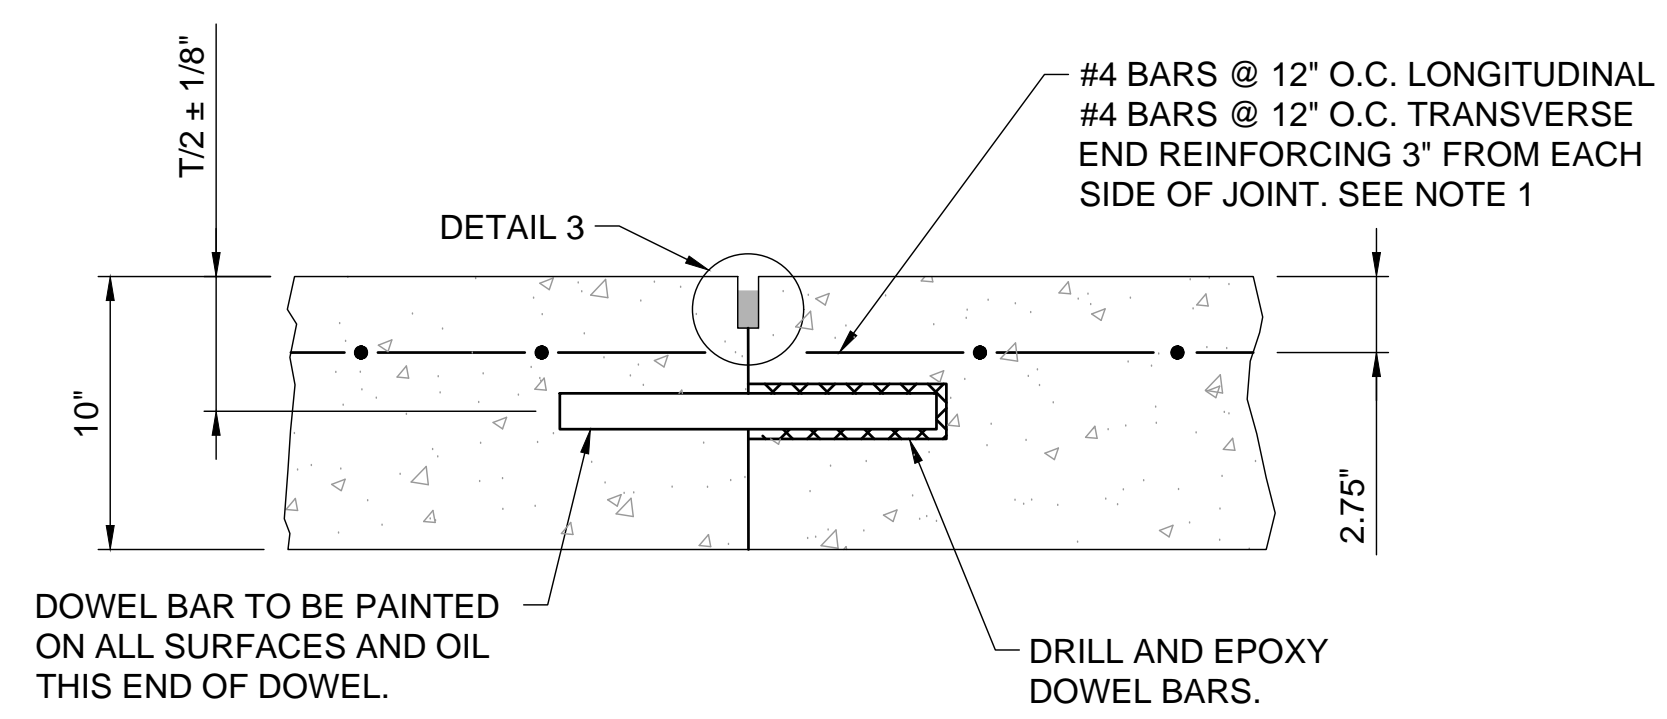

9 TYPE E-DOWELED CONSTRUCTION JOINT
 SCALE: NONE

File: L:\2018\18081100 - ADS On Call Services\Drawings\RECORDS\BAA\ADS-SBA-C200-TS.dwg, Last Save: 1/21/2019 9:48 AM, Last saved by: JAHenderson
 Last plotted by: Henderson, James, A Plot Style: AECmon.ctb, Plot Scale: 1:1 Plot Date: 1/22/2019 3:03 PM Plotter used: AutoCAD PDF (General Documentation).pc3

| REV. | DATE | DESCRIPTION |
|------|------|-------------|
| | | |
| | | |
| | | |

ADDISON AIRPORT
 ADDISON, TEXAS
 WING AVIATION APRON CONNECTOR
 AND CLAIRE CHENNAULT STREET
 DRIVEWAY RECONSTRUCTION


CLAIRE CHENNAULT
 STREET DRIVEWAY -
 DETAILS (BASE BID 2)

JOB NO.: 17081100
 DATE: JAN 2019
 DESIGNED BY: JAH
 DRAWN BY: JAH

BAR IS ONE INCH ON ORIGINAL DRAWING
 IF NOT ONE INCH ON THIS SHEET, ADJUST SCALES ACCORDINGLY.

DRAWING NUMBER
C-200

SHEET NUMBER
18

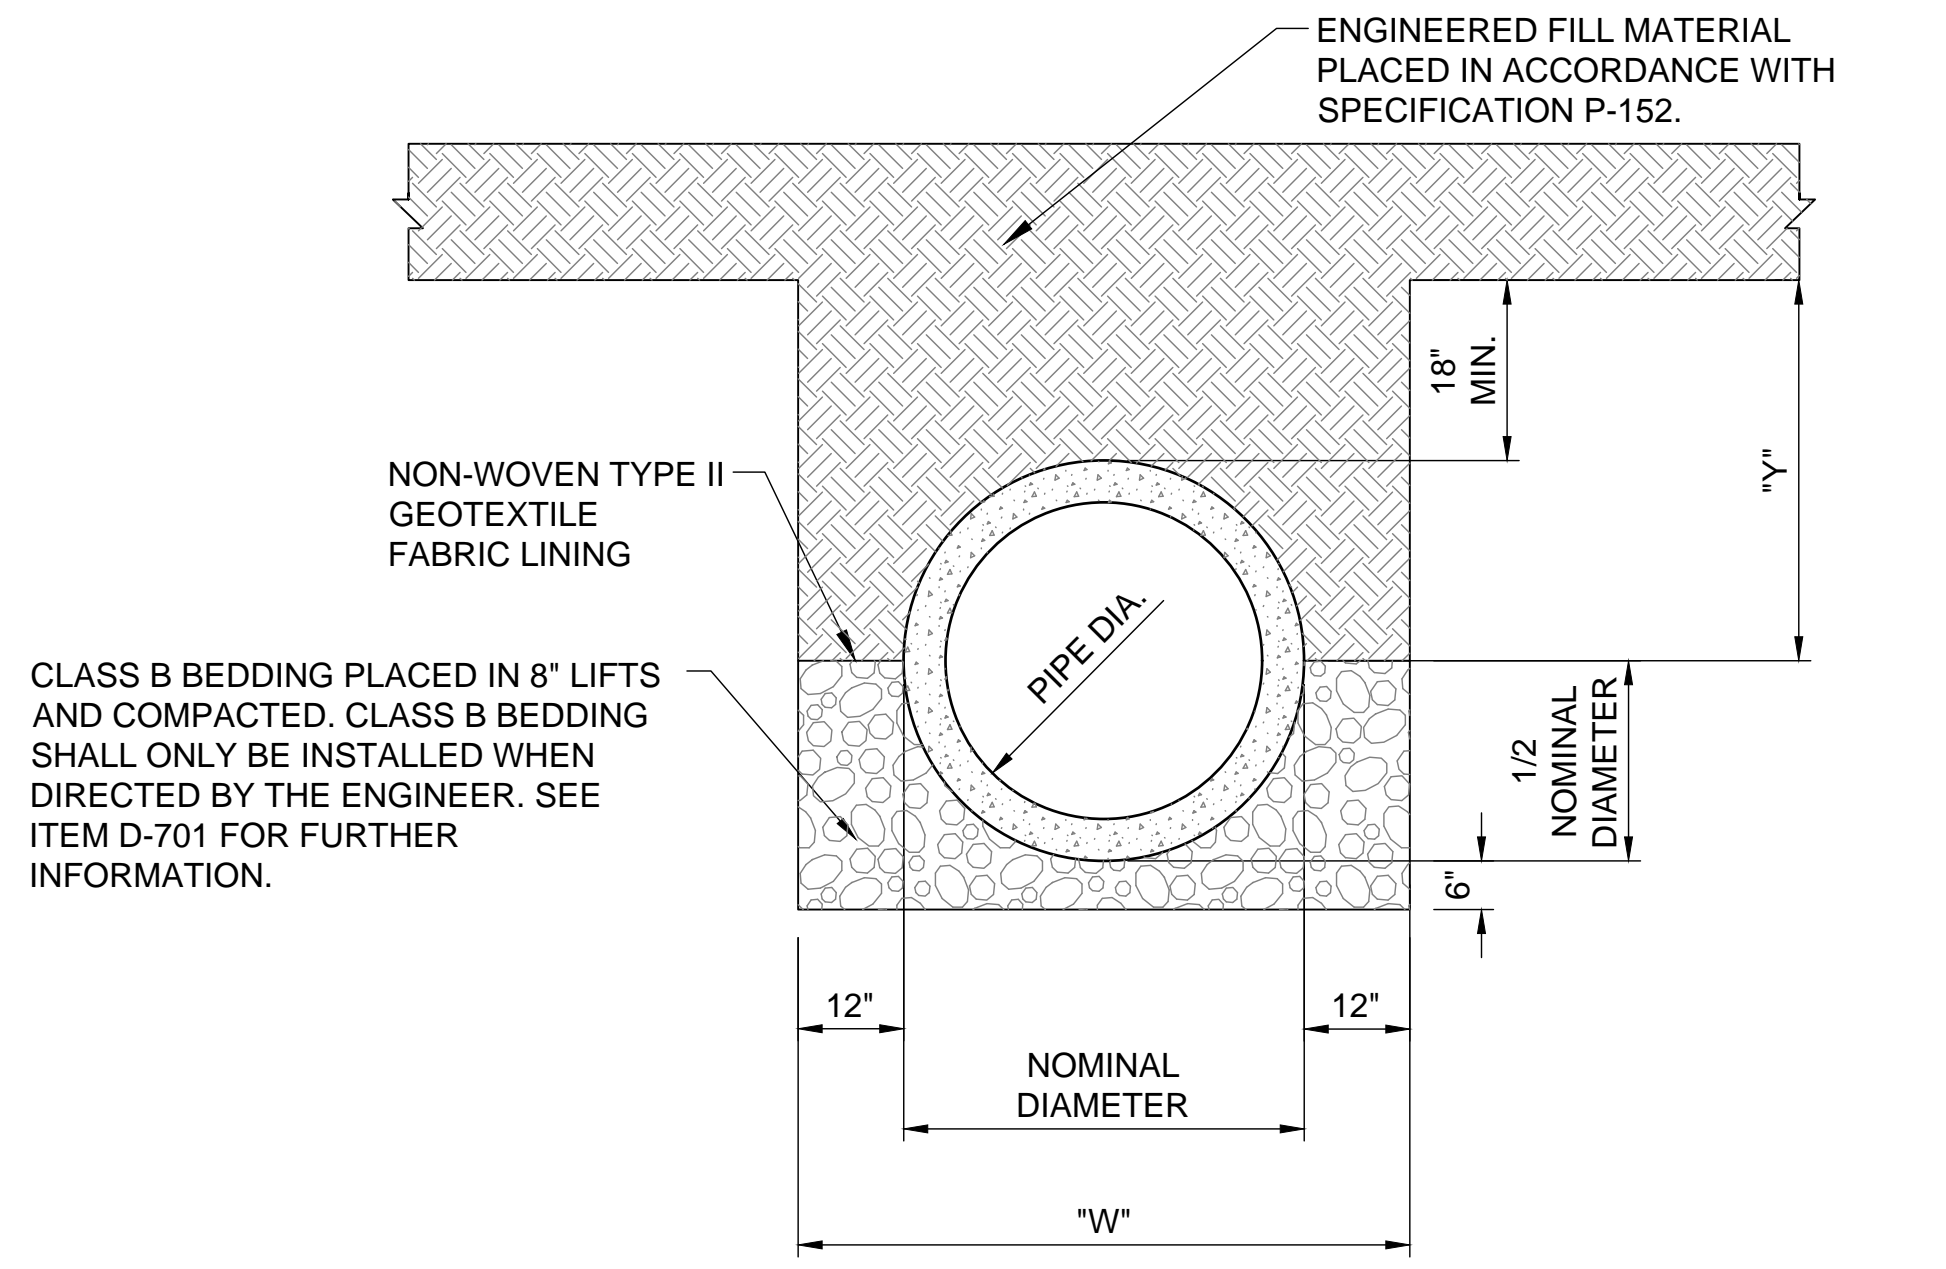


"W" = PIPE NOMINAL DIAMETER + 2' MINIMUM. TRENCH WIDTH SHALL MEET OSHA STANDARDS.

1 PIPE BACK FILLING
SCALE: NONE

CONSTRUCTION SEQUENCE:

- EXCAVATE A TRENCH AT A WIDTH OF "W". THE DITCH SHALL COMPLY WITH OSHA REGULATIONS AT ALL TIMES AND MAY REQUIRE A TRENCH SAFETY SYSTEM.
- LINE TRENCH WITH NON-WOVEN TYPE II GEOTEXTILE FABRIC AND FOLD EXCESS MATERIAL OVER EDGES OF TRENCH AND SECURE IN PLACE WITH SMALL PILES OF CLASS B BEDDING.
- PLACE 6" OF CLASS B BEDDING IN BOTTOM OF TRENCH FOR BEDDING MATERIAL. ENSURE SLOPE ON SURFACE OF CLASS B BEDDING COMPLIES WITH PLANS AND SPECIFICATION D-701.
- PLACE STORM PIPE IN TRENCH USING STANDARD CONSTRUCTION PRACTICE WITH CARE TAKEN NOT TO DAMAGE PIPE.
- BACKFILL TO 1/2 NOMINAL DIAMETER OF PIPE WITH CLASS B BEDDING PLACED IN 8" LIFTS AND COMPACTED.
- FOLD THE TYPE II GEOTEXTILE FABRIC OVER THE BACKFILLED MATERIAL SO THAT THE FABRIC MEETS THE EDGE OF THE STORM PIPE WITH NO GAPS PRESENT.
- PLACE ENGINEERED FILL ON TOP OF TYPE II GEOTEXTILE FABRIC PER SPECIFICATION P-152.

NOTE:
SEE TOWN OF ADDISON STD. FRAME AND COVER DETAIL.

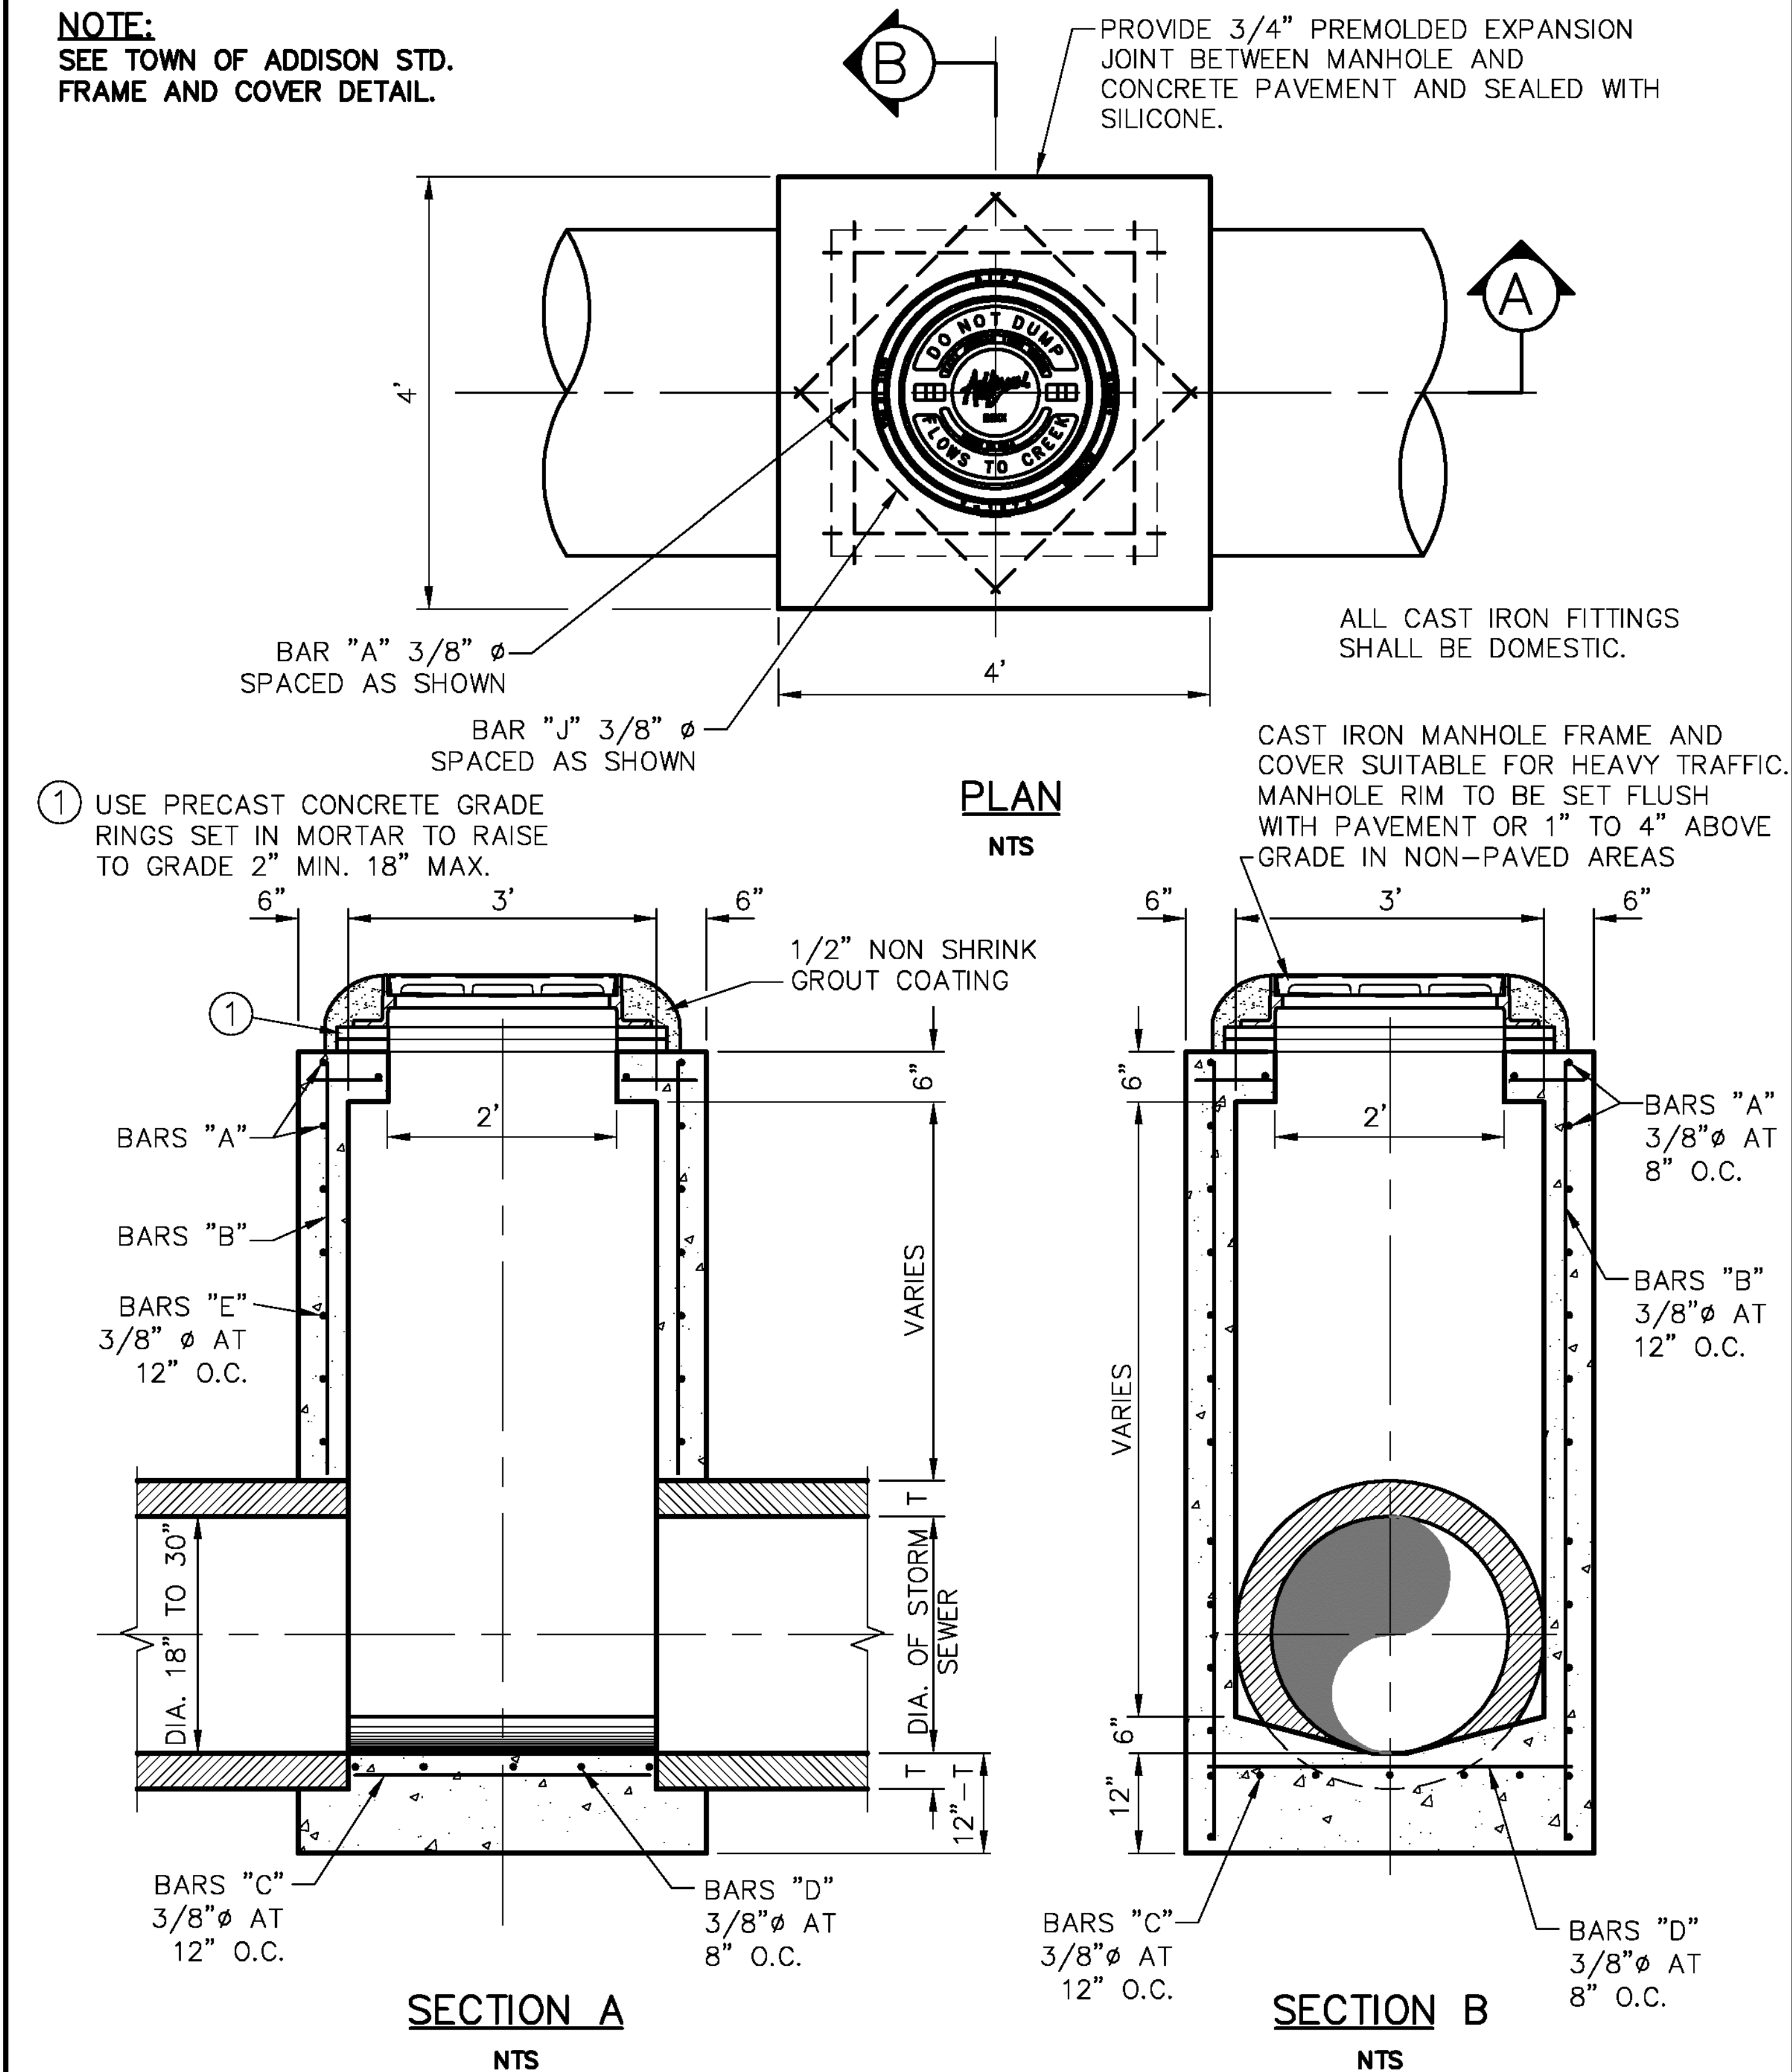

File: L:\2018\18081100 - ADS On Call Services\Drawings\RECORD\SBAA\ADS-SBA-C201-DD.dwg, Last Saved: 1/21/2019 7:03 AM, Last saved by: KKRutabana, Last plotted by: Henderson, James, A, Plot Style: AECmono.ctb, Plot Scale: 1:1, Plot Date: 1/22/2019 3:03 PM, Plotter used: AutoCAD PDF (General Documentation).pc3

© 2017 GARVER, LLC
THIS DOCUMENT, ALONG WITH THE IDEAS AND DESIGNS CONVEYED HEREIN, SHALL BE CONSIDERED INSTRUMENTS OF PROFESSIONAL SERVICE AND ARE PROPERTY OF GARVER, LLC. ANY USE, REPRODUCTION, OR DISTRIBUTION OF THIS DOCUMENT, ALONG WITH THE IDEAS AND DESIGN CONTAINED HEREIN, IS PROHIBITED UNLESS AUTHORIZED IN WRITING BY GARVER, LLC OR EXPLICITLY ALLOWED IN THE GOVERNING PROFESSIONAL SERVICES AGREEMENT FOR THIS WORK.

REGISTRATION NO. F-5713

RECORD DRAWINGS
1/22/2019

| REV. | DATE | DESCRIPTION |
|------|------|-------------|
| | | |
| | | |
| | | |

ADDISON AIRPORT
ADDISON, TEXAS

WING AVIATION APRON CONNECTOR AND CLAIRE CHENNAULT STREET DRIVEWAY RECONSTRUCTION

CLAIRE CHENNAULT STREET DRIVEWAY DRAINAGE DETAILS

JOB NO.: 17081100
DATE: JAN 2019
DESIGNED BY: JAH
DRAWN BY: JAH

BAR IS ONE INCH ON ORIGINAL DRAWING
IF NOT ONE INCH ON THIS SHEET, ADJUST SCALES ACCORDINGLY.

DRAWING NUMBER
C-201

SHEET NUMBER
19

Addison!
PUBLIC WORKS DEPARTMENT

TYPE "A" STORM SEWER MANHOLE (FOR 18" TO 30" RCP)

STANDARD CONSTRUCTION DETAILS STORM DRAINAGE

DATE: AUGUST, 2010 REV DATE: - SHEET : SD-D06



© 2017 GARVER, LLC
 THIS DOCUMENT, ALONG WITH THE IDEAS AND DESIGNS CONVEYED HEREIN, SHALL BE CONSIDERED INSTRUMENTS OF PROFESSIONAL SERVICE AND ARE PROPERTY OF GARVER, LLC. ANY USE, REPRODUCTION, OR DISTRIBUTION OF THIS DOCUMENT, ALONG WITH THE IDEAS AND DESIGN CONTAINED HEREIN, IS PROHIBITED UNLESS AUTHORIZED IN WRITING BY GARVER, LLC OR EXPLICITLY ALLOWED IN THE GOVERNING PROFESSIONAL SERVICES AGREEMENT FOR THIS WORK.

REGISTRATION NO. F-5713

RECORD DRAWINGS
 1/22/2019

| REV. | DATE | DESCRIPTION | BY |
|------|------|-------------|----|
| | | | |

ADDISON AIRPORT
 ADDISON, TEXAS
 WING AVIATION APRON CONNECTOR AND CLAIRE CHENNAULT STREET DRIVEWAY RECONSTRUCTION

CLAIRE CHENNAULT STREET DRIVEWAY - DEMOLITION PLAN (BASE BID 2)

JOB NO.: 17081100
 DATE: JAN 2019
 DESIGNED BY: JAH
 DRAWN BY: JAH



BAR IS ONE INCH ON ORIGINAL DRAWING
 IF NOT ONE INCH ON THIS SHEET, ADJUST SCALES ACCORDINGLY.

DRAWING NUMBER
C-202

SHEET NUMBER
20

FULL DEPTH PAVEMENT REMOVAL BOUNDARIES

| POINT NO. | NORTHING | EASTING |
|-----------|------------|------------|
| 1 | 7041767.68 | 2479249.58 |
| 2 | 7041795.32 | 2479295.97 |
| 3 | 7041765.65 | 2479298.48 |
| 4 | 7041764.78 | 2479297.74 |
| 5 | 7041738.02 | 2479299.07 |
| 6 | 7041735.91 | 2479274.43 |
| 7 | 7041750.34 | 2479268.76 |
| 8 | 7041750.66 | 2479268.04 |

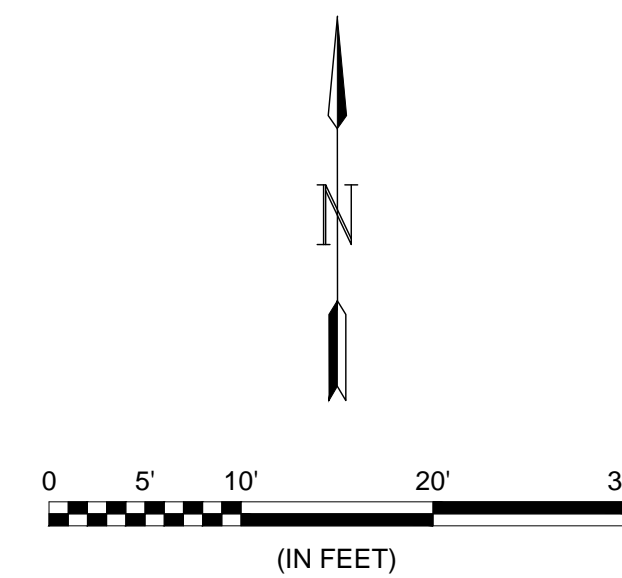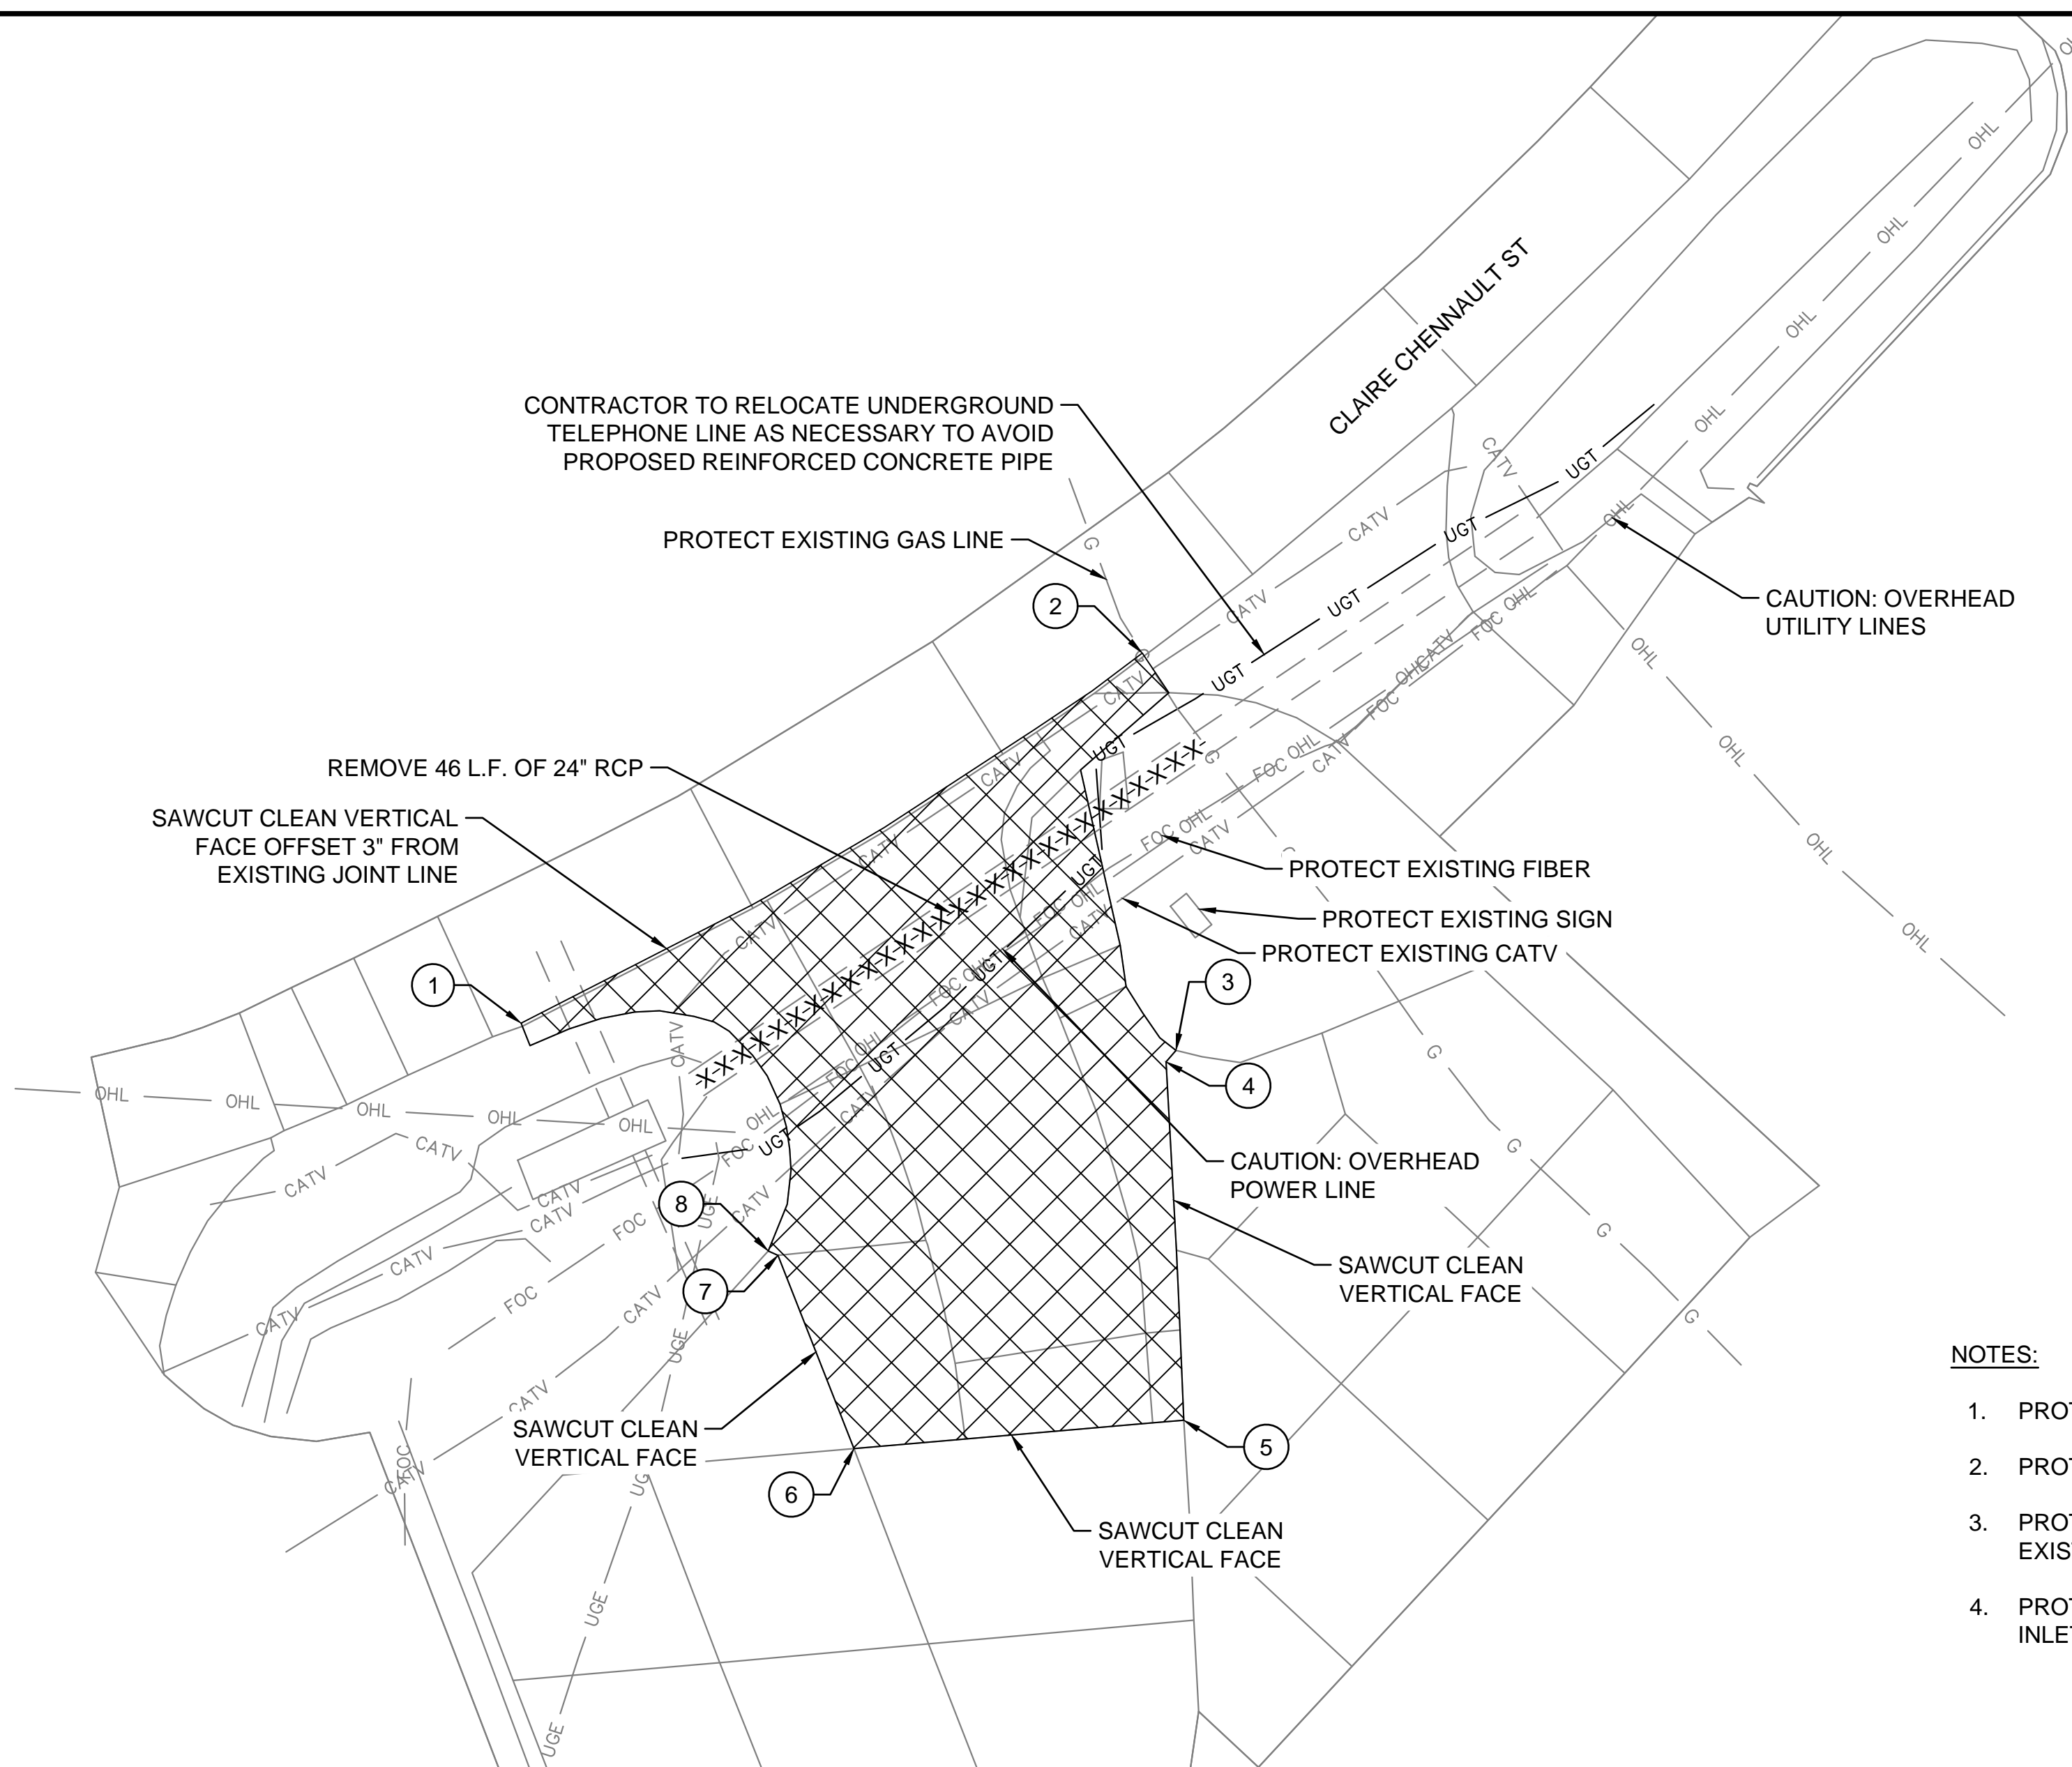


NOTES:

1. PROTECT SHRUBS ON BOTH SIDES OF DRIVE.
2. PROTECT EXISTING IRRIGATION LINES AS NECESSARY.
3. PROTECT MAILBOX AND DECORATIVE ROCK BETWEEN EXISTING DRIVES.
4. PROTECT POWER POLE NEAR EXISTING DRAINAGE INLET.

CAUTION: UNDERGROUND UTILITIES EXIST WITHIN AND ADJACENT TO THE LIMITS OF CONSTRUCTION. AN ATTEMPT HAS BEEN MADE TO LOCATE THESE UTILITIES ON THE PLANS. HOWEVER, ALL EXISTING UTILITIES MAY NOT BE SHOWN AND THE ACTUAL LOCATIONS OF THE UTILITIES MAY VARY FROM THE LOCATIONS SHOWN. PRIOR TO BEGINNING ANY TYPE OF EXCAVATION, THE CONTRACTOR SHALL CONTACT THE UTILITIES ON THE GROUND. THE CONTRACTOR SHALL MAINTAIN THE UTILITY LOCATION MARKINGS UNTIL THEY ARE NO LONGER NECESSARY.

TEXAS STATE LAW, THE UNDERGROUND FACILITIES DAMAGE PREVENTION ACT, REQUIRES SUFFICIENT ADVANCE NOTIFICATION THROUGH THE TEXAS ONE-CALL SYSTEM BEFORE EXCAVATING USING MECHANIZED EQUIPMENT OF EXPLOSIVES (EXCEPT IN THE CASE OF AN EMERGENCY). THE ONE-CALL SYSTEM PHONE NUMBER IS 1-800-245-4545. THE CONTRACTOR IS ADVISED THAT THERE IS A SEVERE PENALTY FOR NOT MAKING THIS CALL. NOT ALL UTILITY COMPANIES ARE MEMBERS OF THE TEXAS ONE-CALL SYSTEM; THEREFORE, THE CONTRACTOR IS ADVISED TO CONTACT ALL NON-MEMBER UTILITIES AS WELL AS THE ONE-CALL SYSTEM.

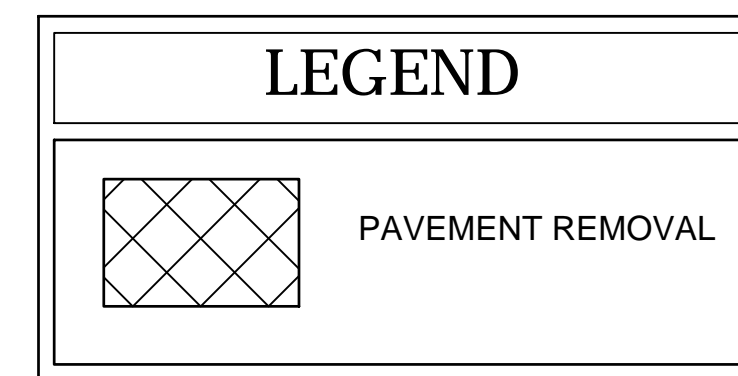



© 2017 GARVER, LLC
 THIS DOCUMENT, ALONG WITH THE IDEAS AND DESIGNS CONVEYED HEREIN, SHALL BE CONSIDERED INSTRUMENTS OF PROFESSIONAL SERVICE AND ARE PROPERTY OF GARVER, LLC. ANY USE, REPRODUCTION, OR DISTRIBUTION OF THIS DOCUMENT, ALONG WITH THE IDEAS AND DESIGN CONTAINED HEREIN, IS PROHIBITED UNLESS AUTHORIZED IN WRITING BY GARVER, LLC OR EXPLICITLY ALLOWED IN THE GOVERNING PROFESSIONAL SERVICES AGREEMENT FOR THIS WORK.

REGISTRATION NO. F-5713

RECORD DRAWINGS
 1/22/2019

| REV. | DATE | DESCRIPTION | BY |
|------|------|-------------|----|
| | | | |
| | | | |
| | | | |
| | | | |

ADDISON AIRPORT
 ADDISON, TEXAS
 WING AVIATION APRON CONNECTOR AND CLAIRE CHENNAULT STREET DRIVEWAY RECONSTRUCTION

CLAIRE CHENNAULT STREET DRIVEWAY - LAYOUT PLAN (BASE BID 2)

JOB NO.: 17081100
 DATE: JAN 2019
 DESIGNED BY: JAH
 DRAWN BY: JAH

BAR IS ONE INCH ON ORIGINAL DRAWING
 IF NOT ONE INCH ON THIS SHEET, ADJUST SCALES ACCORDINGLY.

DRAWING NUMBER
C-203


SHEET NUMBER
21

| POINT TABLE | | | |
|-------------|------------|------------|-----------|
| POINT NO. | NORTHING | EASTING | ELEVATION |
| 1 | 7041767.68 | 2479249.58 | 639.85 |
| 2 | 7041776.49 | 2479266.78 | 639.99 |
| 3 | 7041787.99 | 2479285.43 | 640.28 |
| 4 | 7041795.32 | 2479295.97 | 640.31 |
| 5 | 7041792.37 | 2479297.95 | 640.17 |
| 6 | 7041786.60 | 2479291.36 | 640.09 |
| 7 | 7041770.42 | 2479294.76 | 640.17 |
| 8 | 7041766.59 | 2479297.27 | 640.20 |
| 9 | 7041765.65 | 2479298.48 | 640.18 |
| 10 | 7041764.78 | 2479297.74 | 640.15 |
| 11 | 7041750.72 | 2479298.52 | 639.78 |
| 12 | 7041738.02 | 2479299.07 | 639.43 |
| 13 | 7041735.91 | 2479274.43 | 639.01 |
| 14 | 7041750.34 | 2479268.76 | 639.34 |
| 15 | 7041750.66 | 2479268.04 | 639.33 |
| 16 | 7041753.13 | 2479269.03 | 639.53 |
| 17 | 7041765.38 | 2479266.48 | 639.88 |
| 18 | 7041767.69 | 2479254.17 | 639.89 |
| 19 | 7041766.00 | 2479250.25 | 639.79 |

NOTE:
 MATCH EXISTING ELEVATIONS WHERE PROPOSED PAVEMENT MEETS EXISTING PAVEMENT.

| POINT TABLE | | | |
|-------------|------------|------------|-----------|
| POINT NO. | NORTHING | EASTING | ELEVATION |
| 201 | 7041766.66 | 2479247.45 | 639.81 |
| 202 | 7041764.98 | 2479248.22 | 639.53 |
| 203 | 7041762.06 | 2479252.68 | 638.54 |
| 204 | 7041761.95 | 2479259.05 | 638.95 |
| 205 | 7041747.66 | 2479265.31 | 639.00 |
| 206 | 7041790.35 | 2479299.55 | 640.08 |
| 208 | 7041784.80 | 2479298.47 | 640.18 |
| 209 | 7041778.88 | 2479297.18 | 640.19 |
| 210 | 7041774.72 | 2479298.14 | 640.41 |
| 211 | 7041772.94 | 2479299.38 | 640.28 |
| 212 | 7041764.74 | 2479303.29 | 640.24 |


| LEGEND | |
|--------|---|
| | PROPOSED PAVEMENT |
| | PROPOSED SODDING |
| | PROPOSED 2" RIP RAP |
| | TYPE "A-1" - REINFORCED ISOLATION JOINT |
| | TYPE "E" - DOWELED CONSTRUCTION JOINT |
| | TYPE "C" - DOWELED CONTRACTION JOINT |
| | TYPE "B" - HINGED CONTRACTION JOINT |

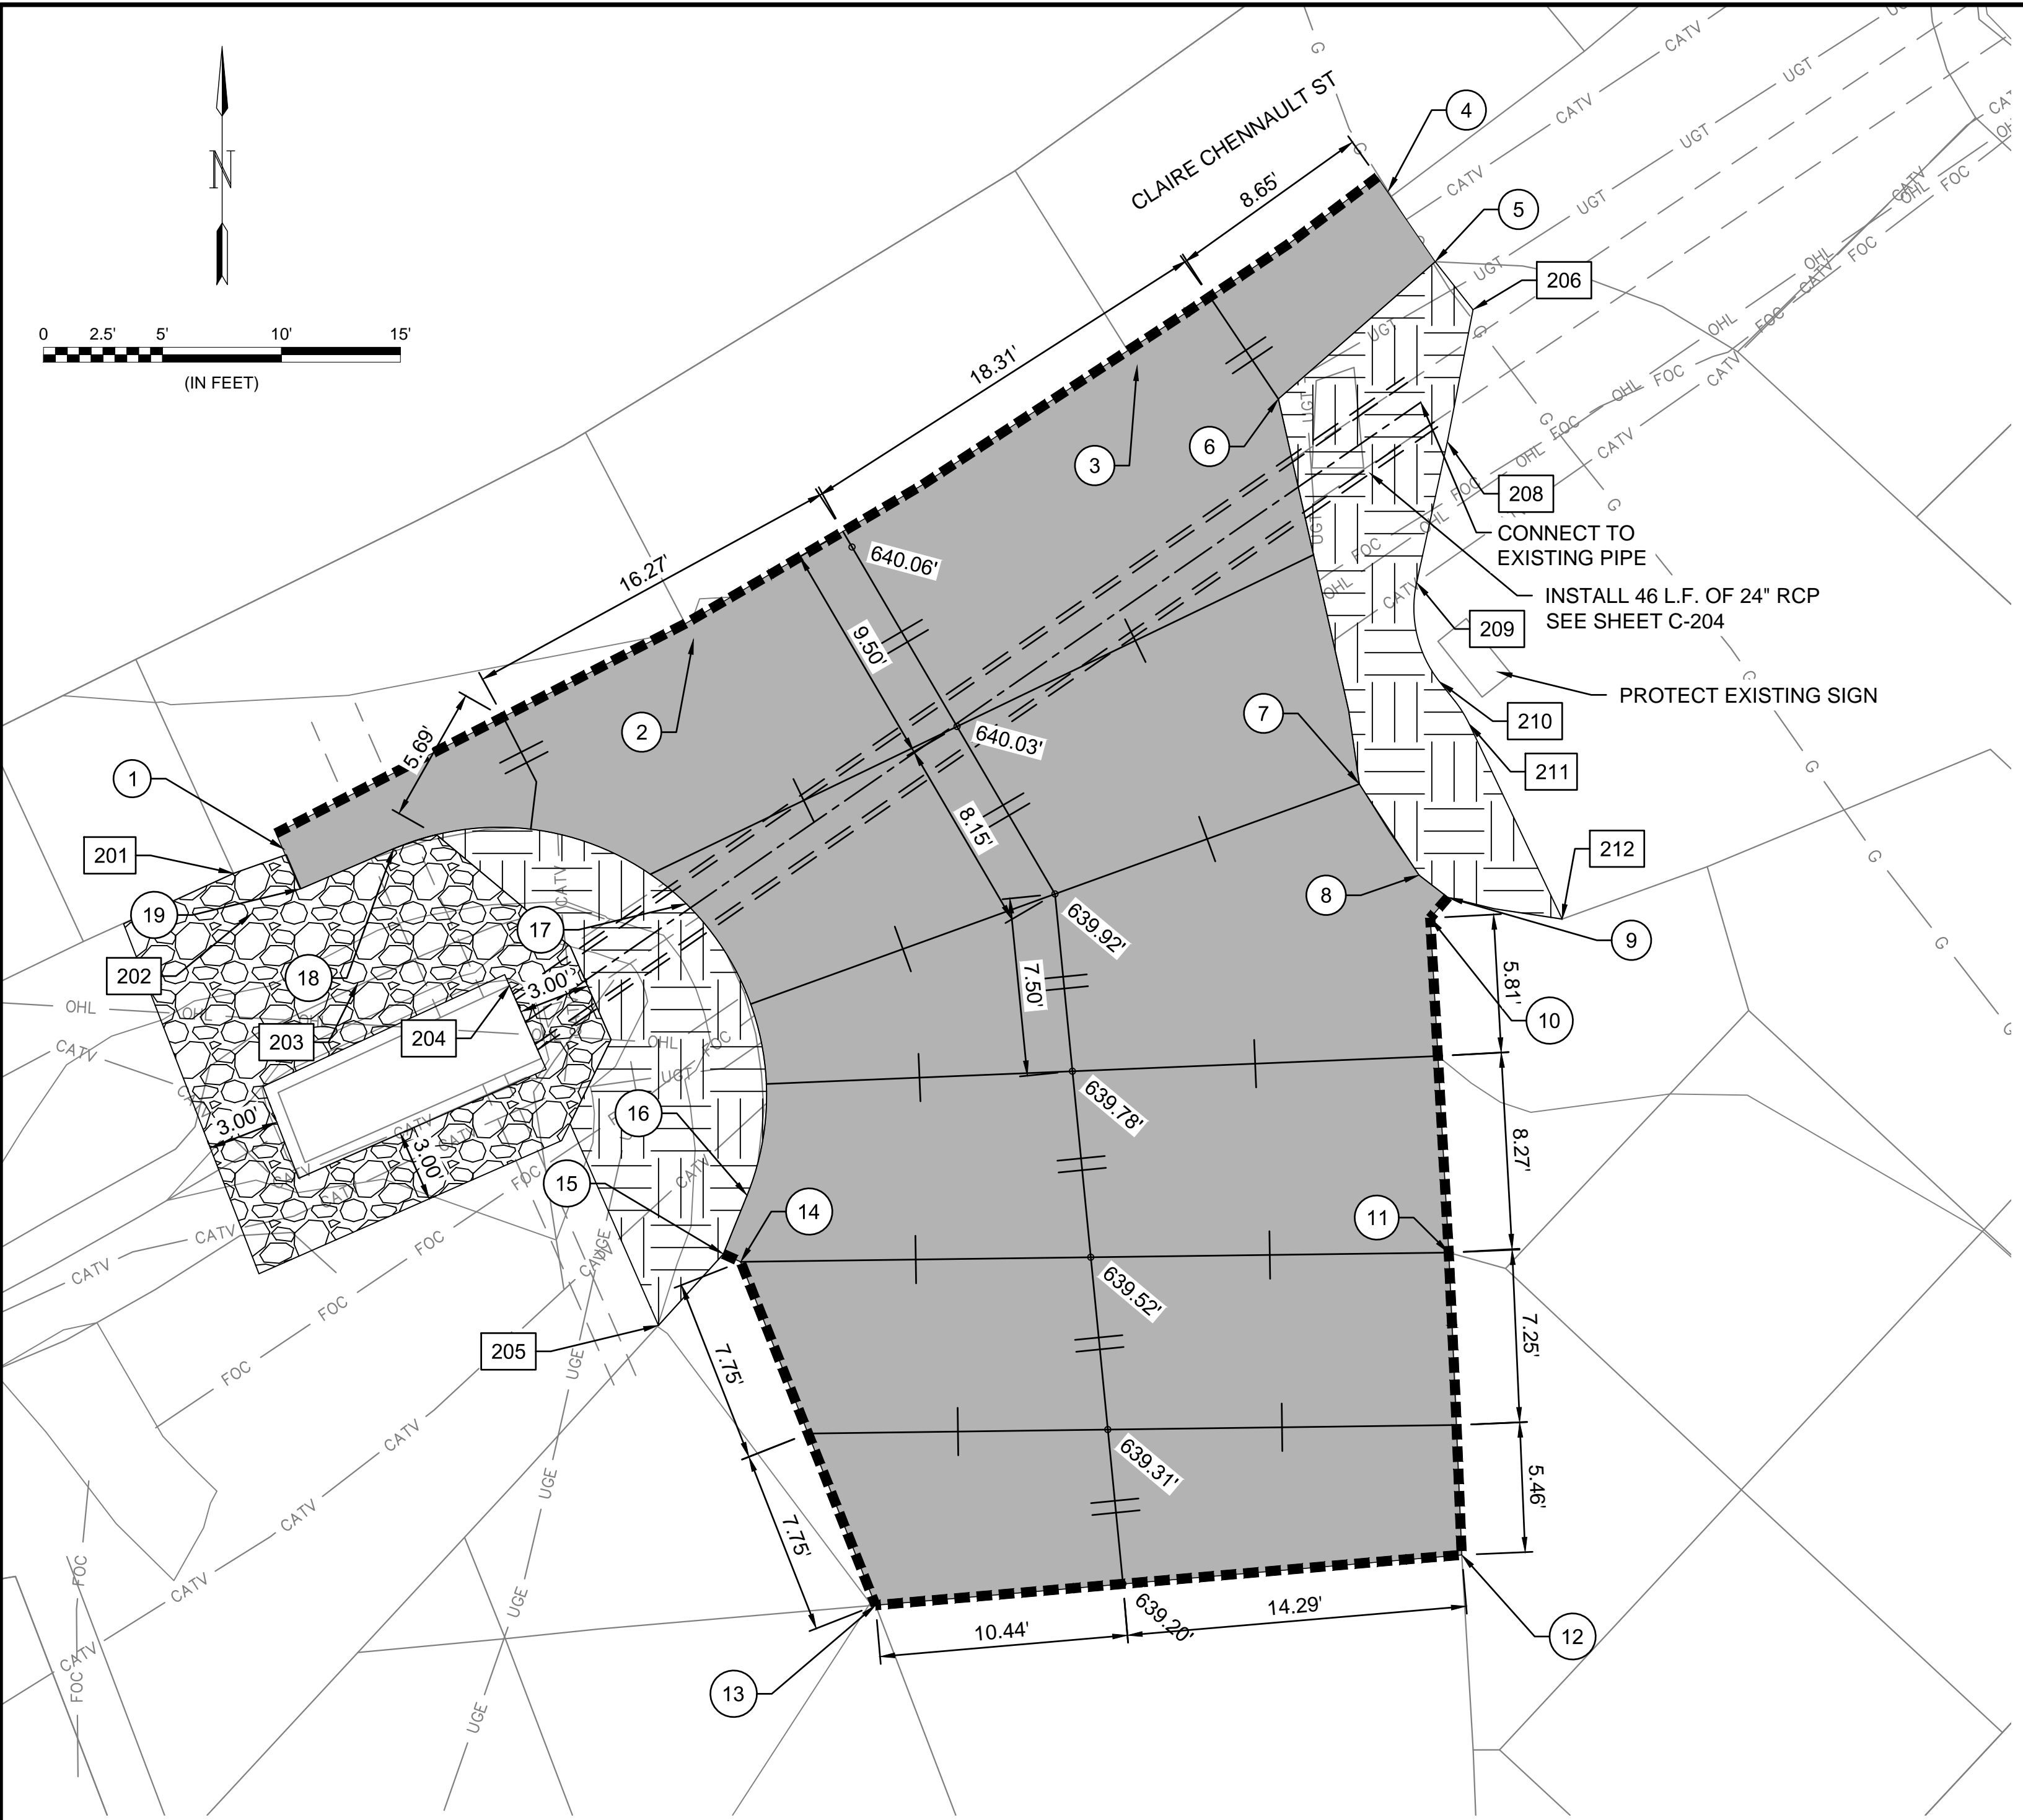






CAUTION: UNDERGROUND UTILITIES EXIST WITHIN AND ADJACENT TO THE LIMITS OF CONSTRUCTION. AN ATTEMPT HAS BEEN MADE TO LOCATE THESE UTILITIES ON THE PLANS. HOWEVER, ALL EXISTING UTILITIES MAY NOT BE SHOWN AND THE ACTUAL LOCATIONS OF THE UTILITIES MAY VARY FROM THE LOCATIONS SHOWN. PRIOR TO BEGINNING ANY TYPE OF EXCAVATION, THE CONTRACTOR SHALL CONTACT THE UTILITIES ON THE GROUND. THE CONTRACTOR SHALL MAINTAIN THE UTILITY LOCATION MARKINGS UNTIL THEY ARE NO LONGER NECESSARY.

TEXAS STATE LAW, THE UNDERGROUND FACILITIES DAMAGE PREVENTION ACT, REQUIRES SUFFICIENT ADVANCE NOTIFICATION THROUGH THE TEXAS ONE-CALL SYSTEM CENTER BEFORE EXCAVATING USING MECHANIZED EQUIPMENT OF EXPLOSIVES (EXCEPT IN THE CASE OF AN EMERGENCY). THE ONE-CALL SYSTEM PHONE NUMBER IS 1-800-245-4545. THE CONTRACTOR IS ADVISED THAT THERE IS A SEVERE PENALTY FOR NOT MAKING THIS CALL. NOT ALL UTILITY COMPANIES ARE MEMBERS OF THE TEXAS ONE-CALL SYSTEM; THEREFORE, THE CONTRACTOR IS ADVISED TO CONTACT ALL NON-MEMBER UTILITIES AS WELL AS THE ONE-CALL SYSTEM.

File: L:\2018\18081100 - ADS On Call Services\Drawings\RECORD\SBAAADS-SBA-C202-LP.dwg, Last Save: 1/22/2019 2:55 PM, Last saved by: JAHenderson
 Last plotted by: Henderson, James, A, Plot Style: AECmono.ctb, Plot Scale: 1:1, Plot Date: 1/22/2019 3:04 PM, Plotter used: AutoCAD PDF (General Documentation).pc3

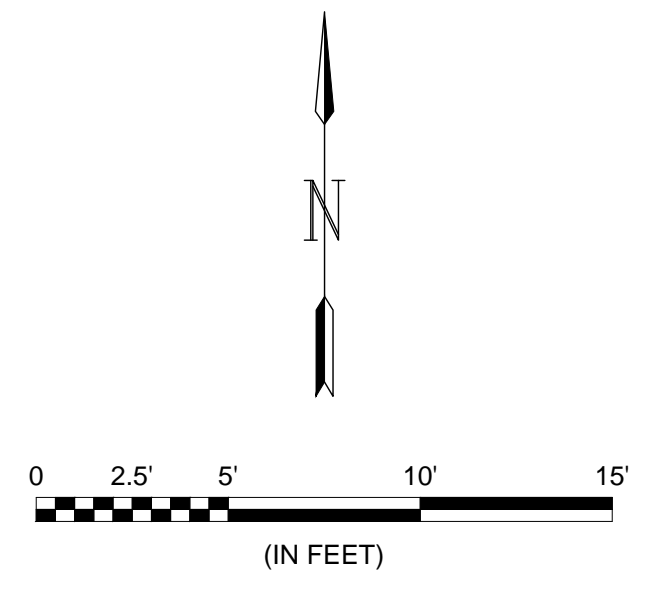

File: L:\2018\18081100 - ADS On Call Services\Drawings\RECORD\SBAAADS-SBA-D200-DR.dwg, Last Save: 1/22/2019 2:52 PM, Last saved by: JAHenderson
 Last plotted by: Henderson, James, A Plot Style: AECmono.ctb Plot Scale: 1:1 Plot Date: 1/22/2019 3:04 PM Plotter uset: AutoCAD PDF (General Documentation).pc3

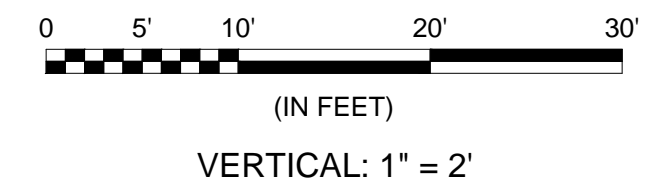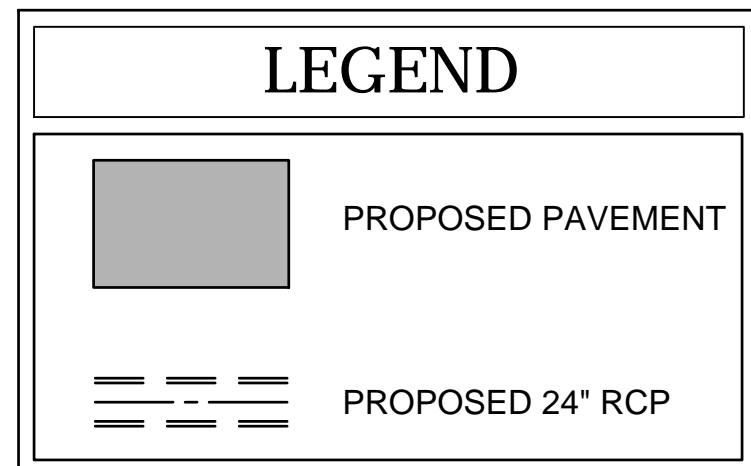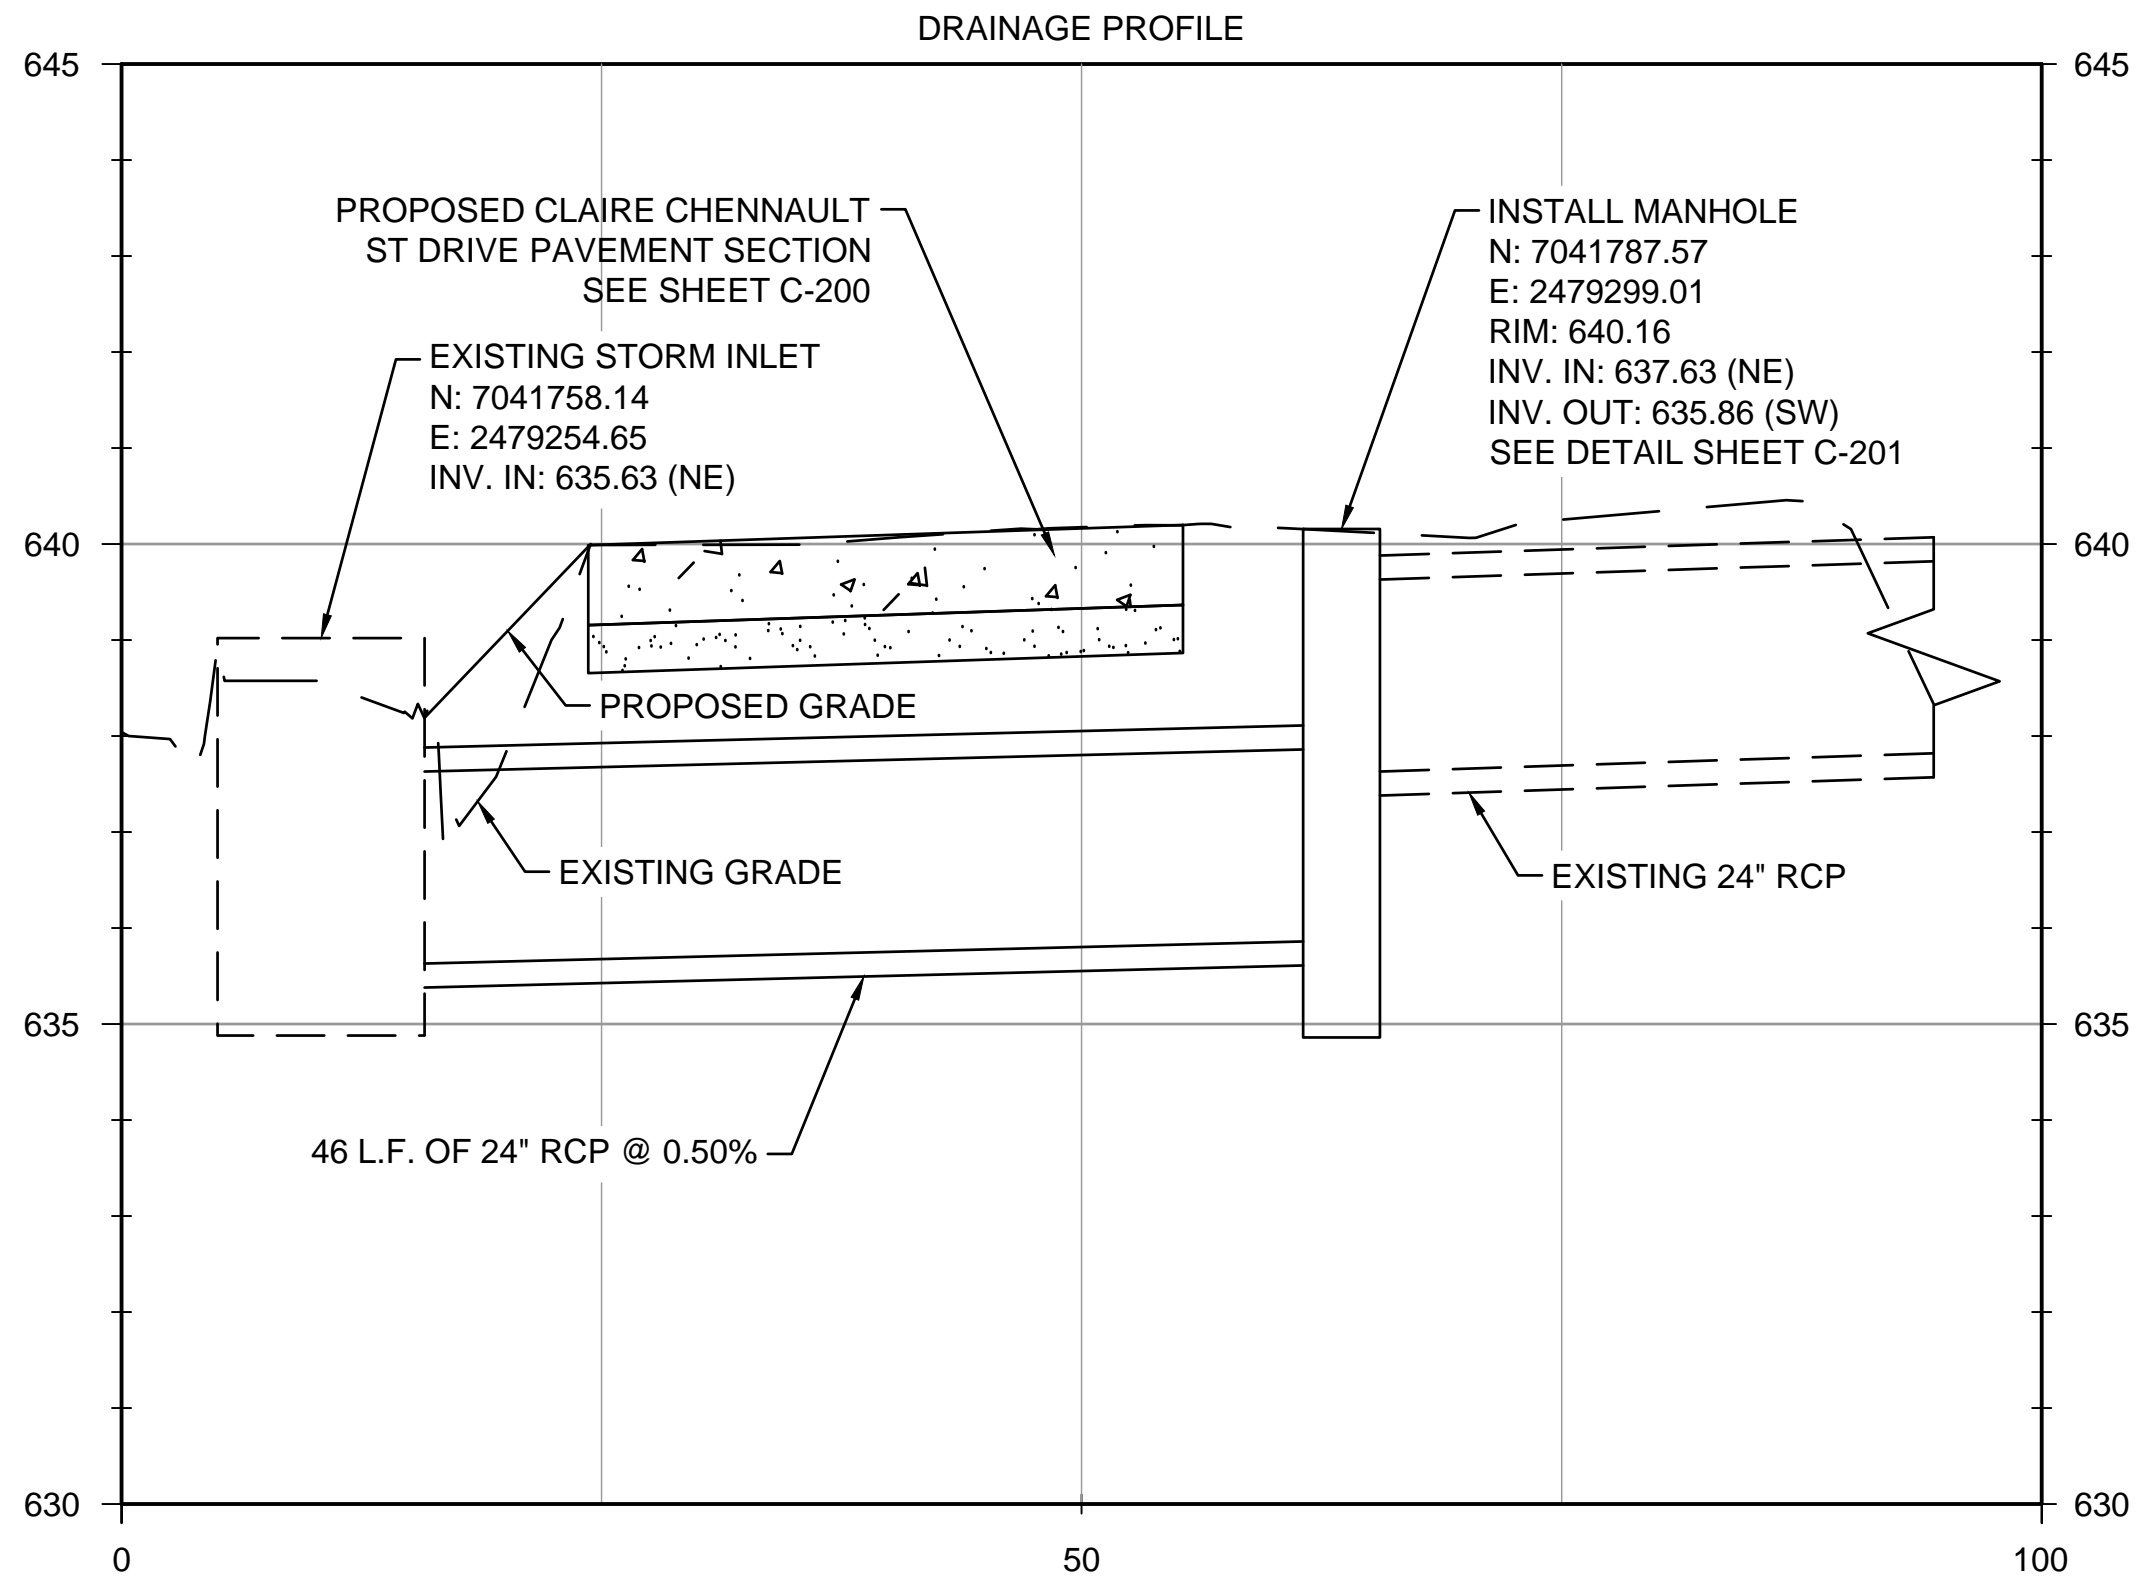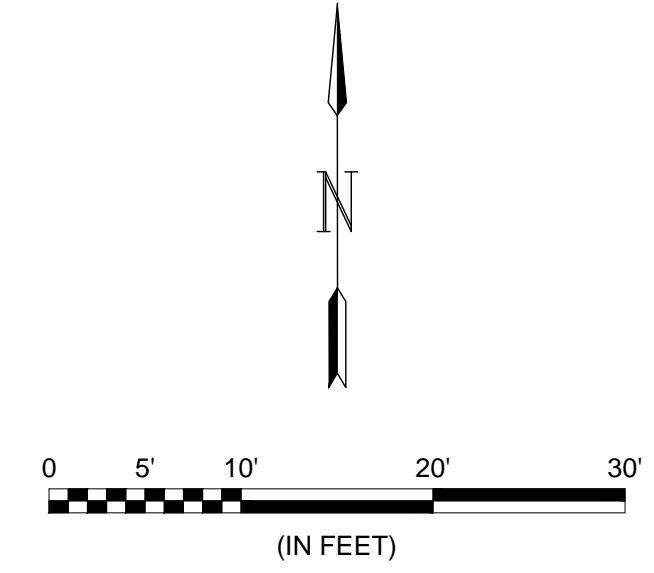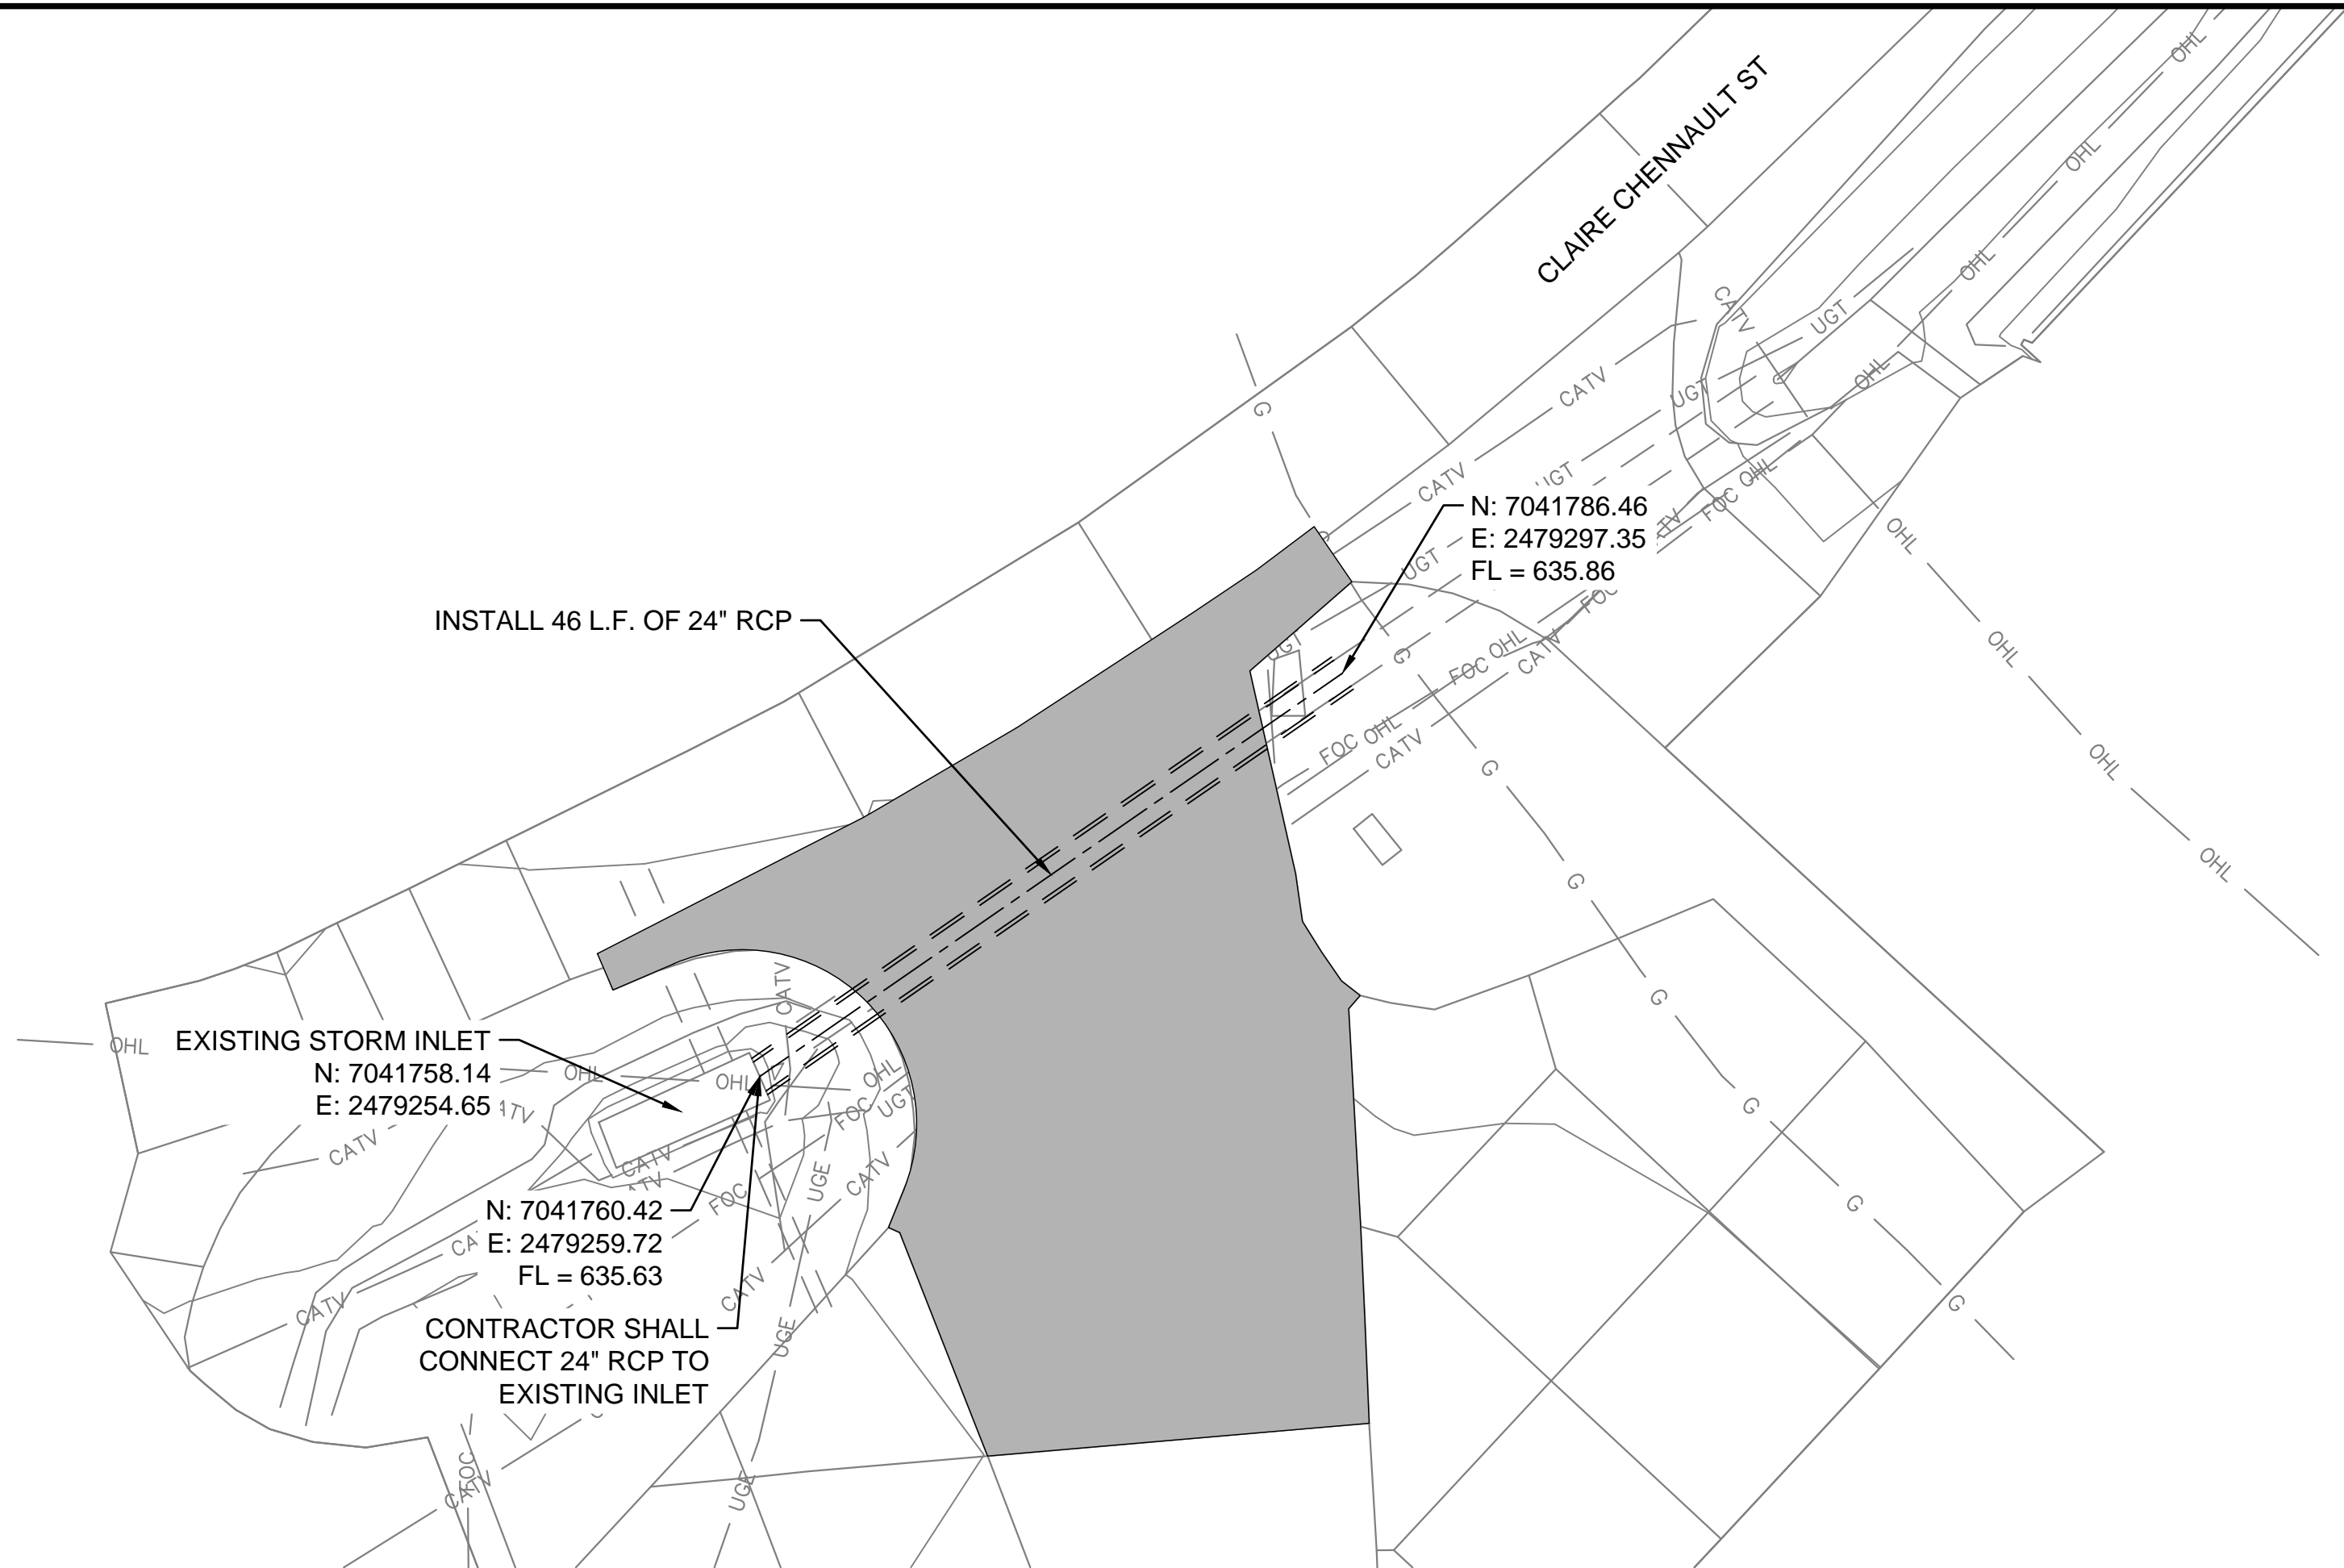

GARVER

© 2017 GARVER, LLC
 THIS DOCUMENT, ALONG WITH THE IDEAS AND DESIGNS CONVEYED HEREIN, SHALL BE CONSIDERED INSTRUMENTS OF PROFESSIONAL SERVICE AND ARE PROPERTY OF GARVER, LLC. ANY USE, REPRODUCTION, OR DISTRIBUTION OF THIS DOCUMENT, ALONG WITH THE IDEAS AND DESIGN CONTAINED HEREIN, IS PROHIBITED UNLESS AUTHORIZED IN WRITING BY GARVER, LLC OR EXPLICITLY ALLOWED IN THE GOVERNING PROFESSIONAL SERVICES AGREEMENT FOR THIS WORK.

REGISTRATION NO.
 F-5713

RECORD DRAWINGS
 1/22/2019

| REV. | DATE | DESCRIPTION | BY |
|------|------|-------------|----|
| | | | |
| | | | |
| | | | |

ADDISON AIRPORT
 ADDISON, TEXAS

WING AVIATION APRON CONNECTOR
 AND CLAIRE CHENNAULT STREET
 DRIVEWAY RECONSTRUCTION

CLAIRE CHENNAULT STREET DRIVEWAY - DRAINAGE PLAN (BASE BID 2)

JOB NO.: 17081100
 DATE: JAN 2019
 DESIGNED BY: JAH
 DRAWN BY: JAH

BAR IS ONE INCH ON ORIGINAL DRAWING
 IF NOT ONE INCH ON THIS SHEET, ADJUST SCALES ACCORDINGLY.

DRAWING NUMBER
C-204

SHEET NUMBER
22