



RECORD DRAWINGS
 (October 2013)
 Information Provided By:
BOB MOORE
 CONSTRUCTION

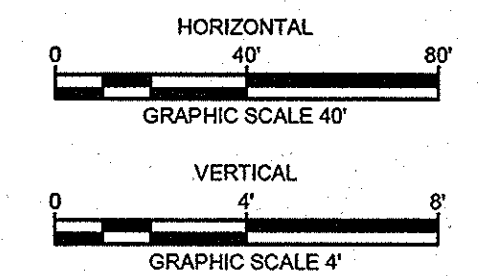

SANITARY SEWER
PROFILE

VILLAGE
ON THE
PARKWAY
 ADDISON, TEXAS

KHA PROJECT
 063319038
 DATE
 9/27/2012
 SCALE
 AS SHOWN
 DESIGNED BY
 TBB
 DRAWN BY
 AAE
 CHECKED BY
 TBB

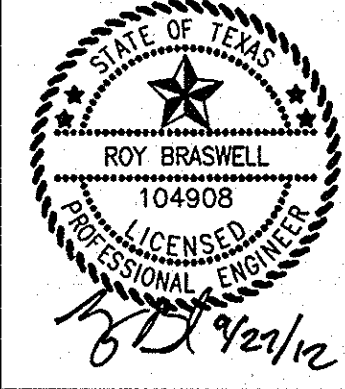

Kimley-Horn and Associates, Inc.
 State of Texas Registration No. F-928
 5750 GENESIS COURT, SUITE 200, PRISCO, TX 75034
 PHONE: 972-335-3580 FAX: 972-335-3779
 WWW.KIMLEY-HORN.COM

No.	REVISIONS	DATE	BY