

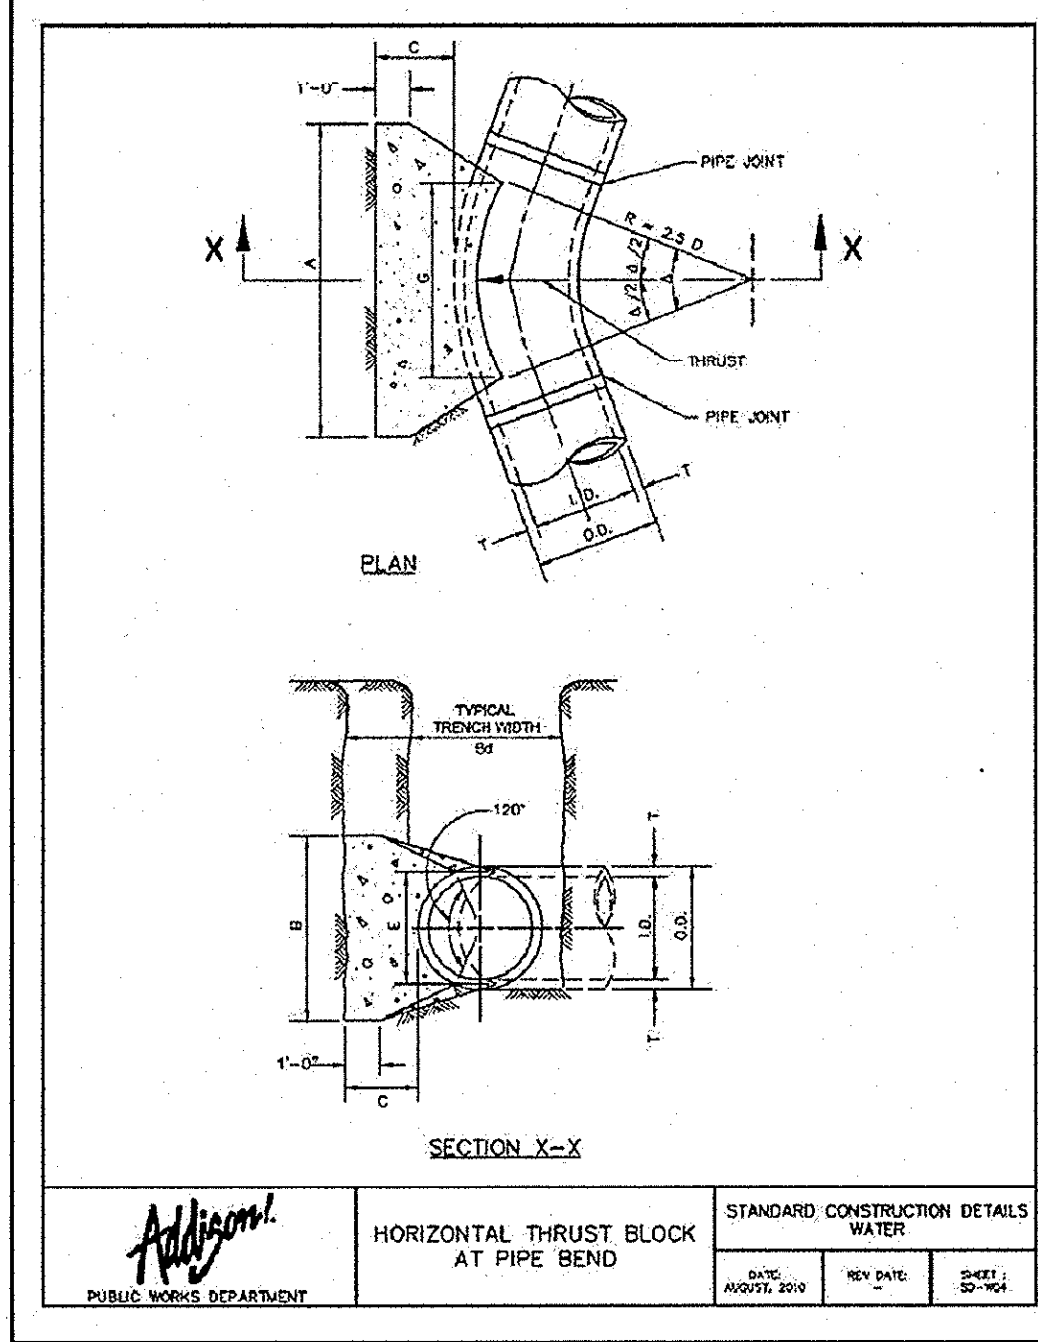
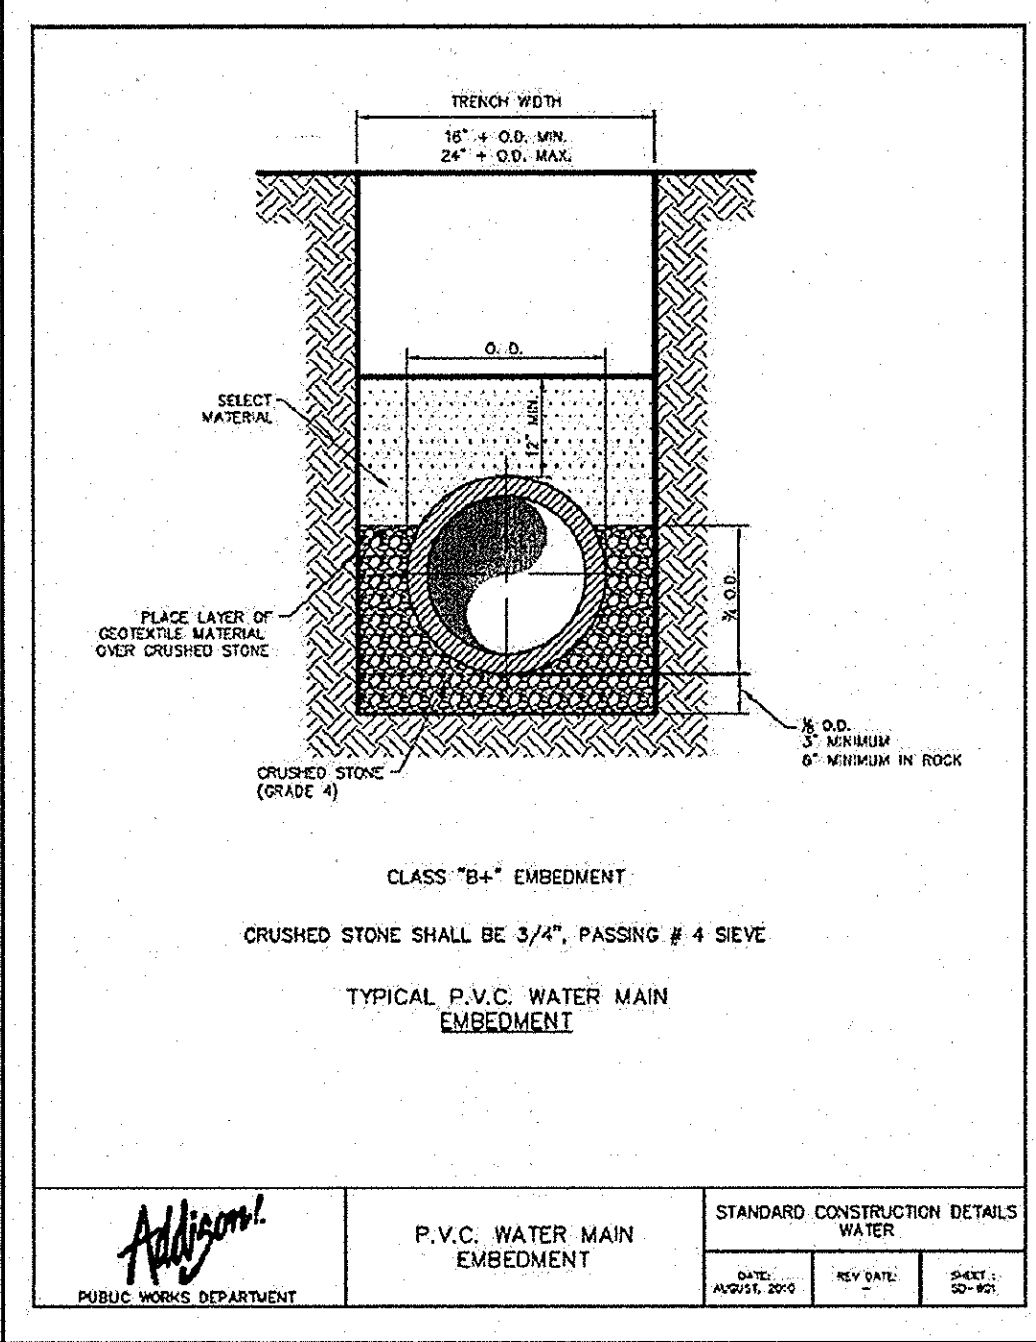
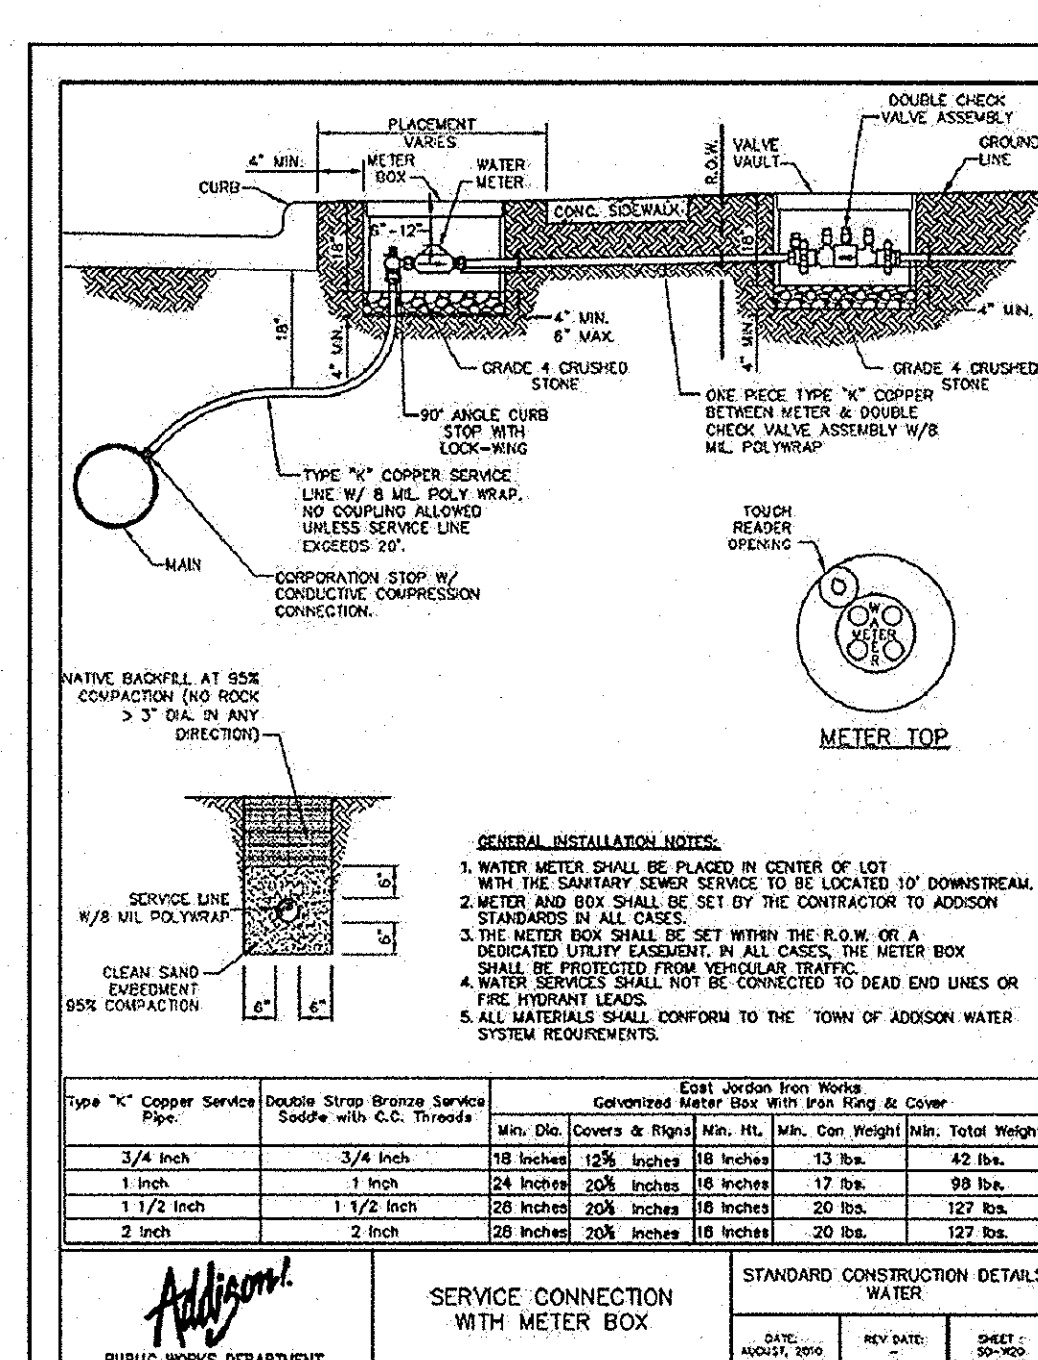
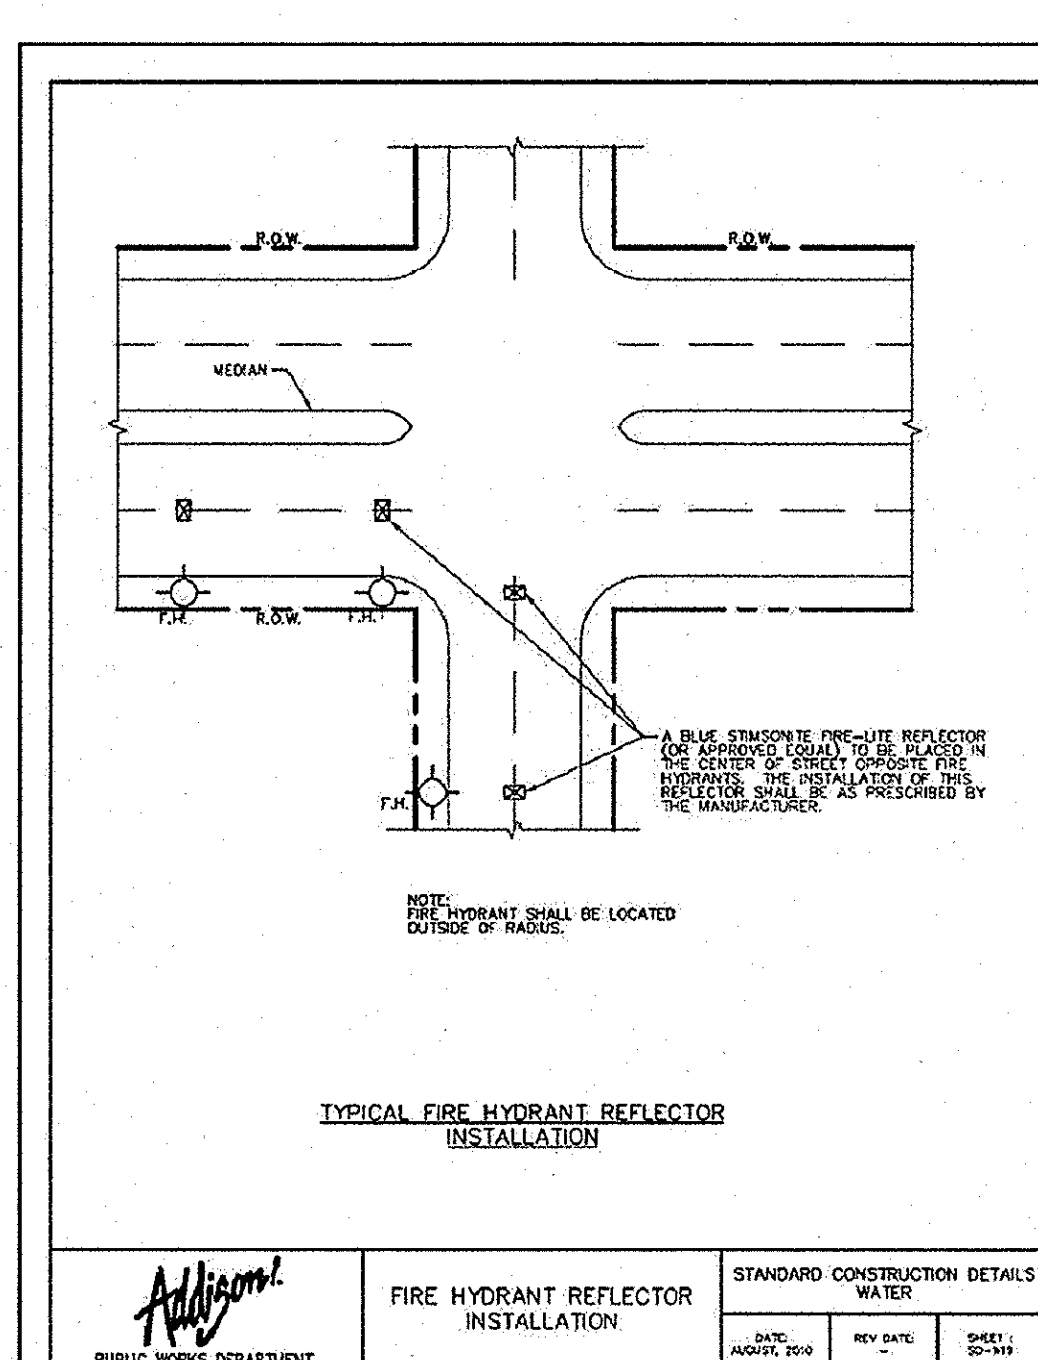
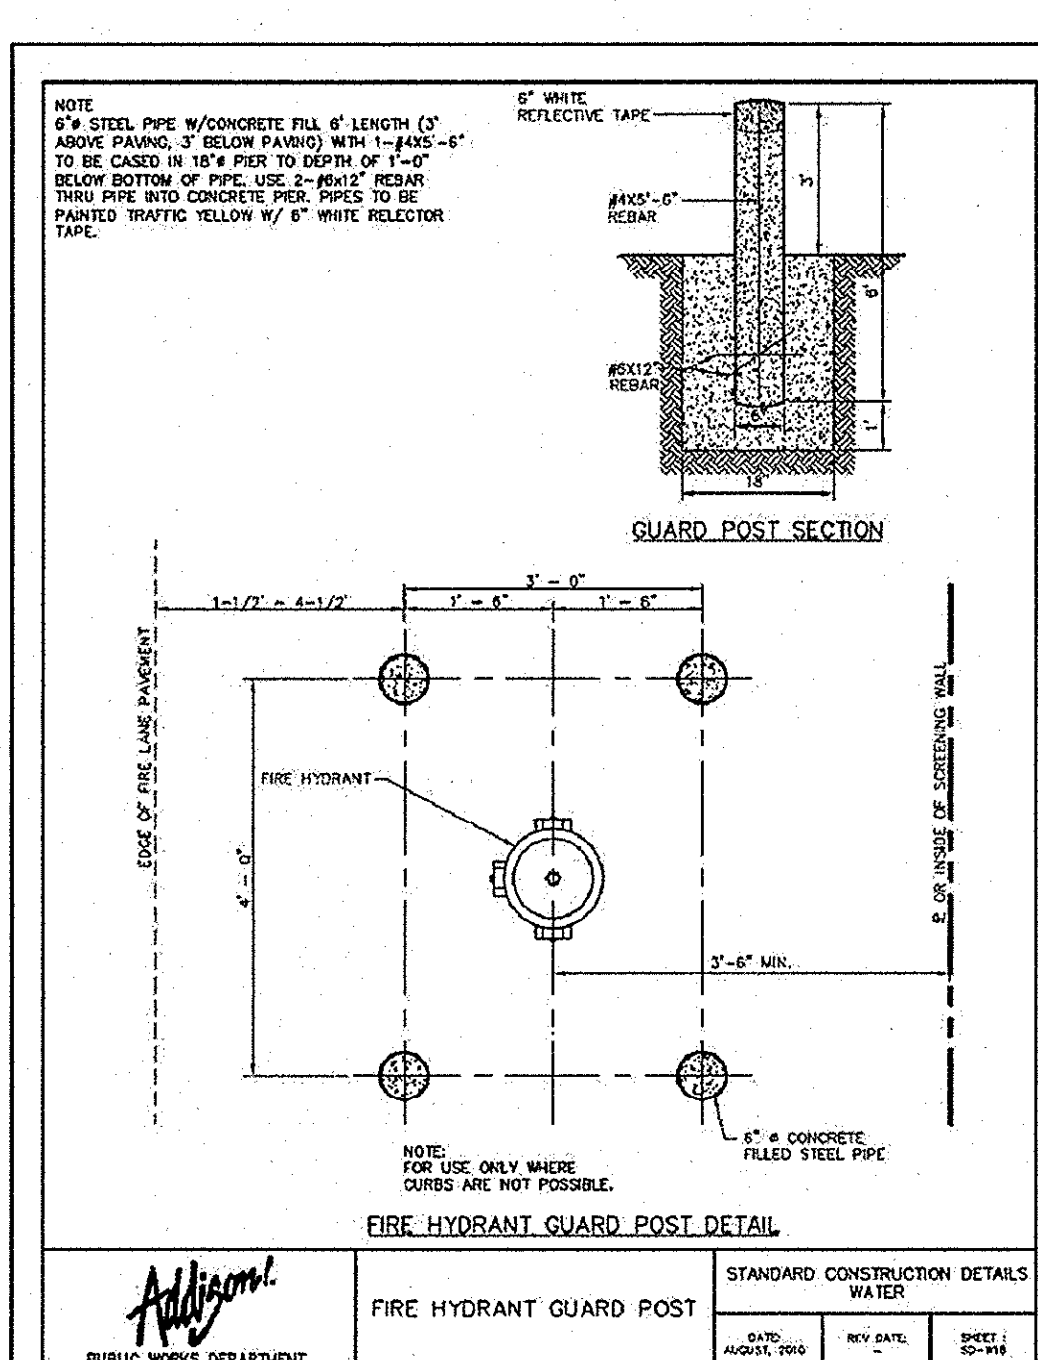
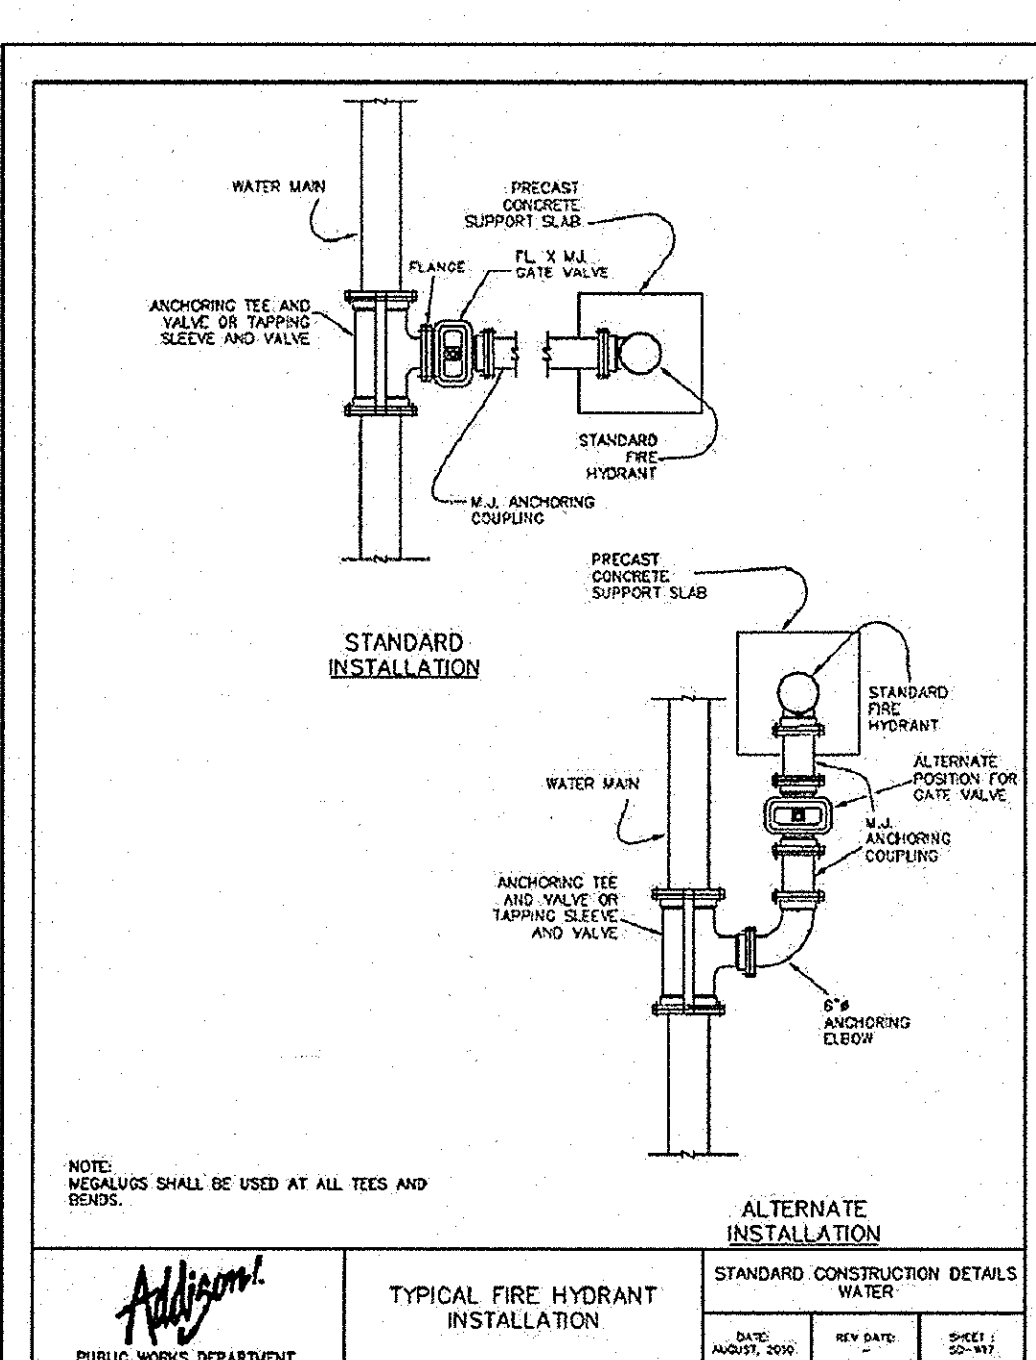
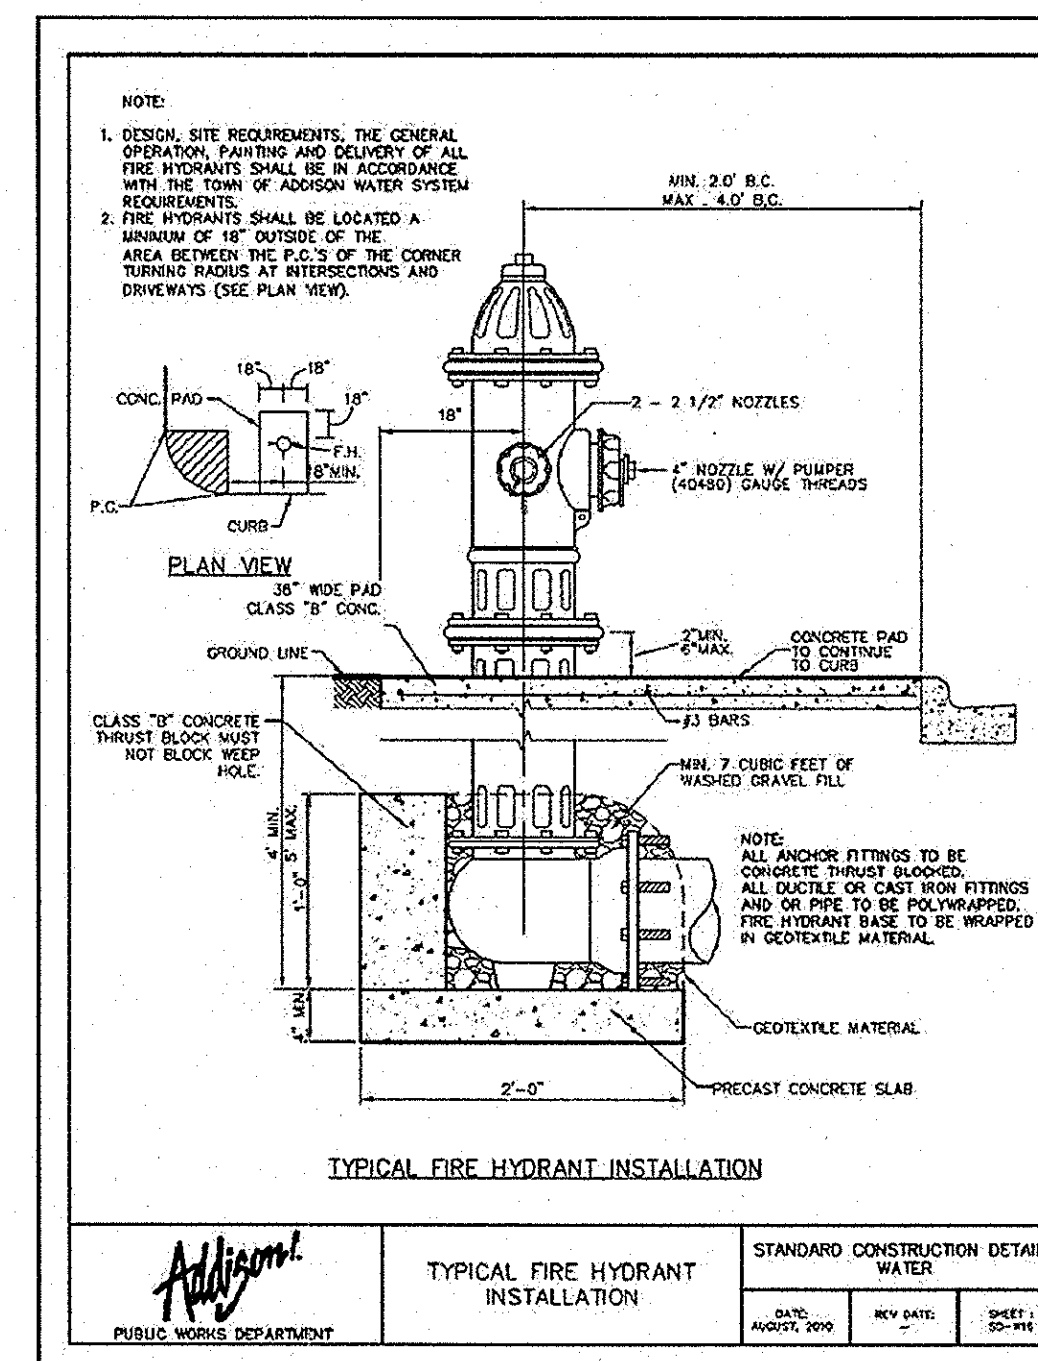
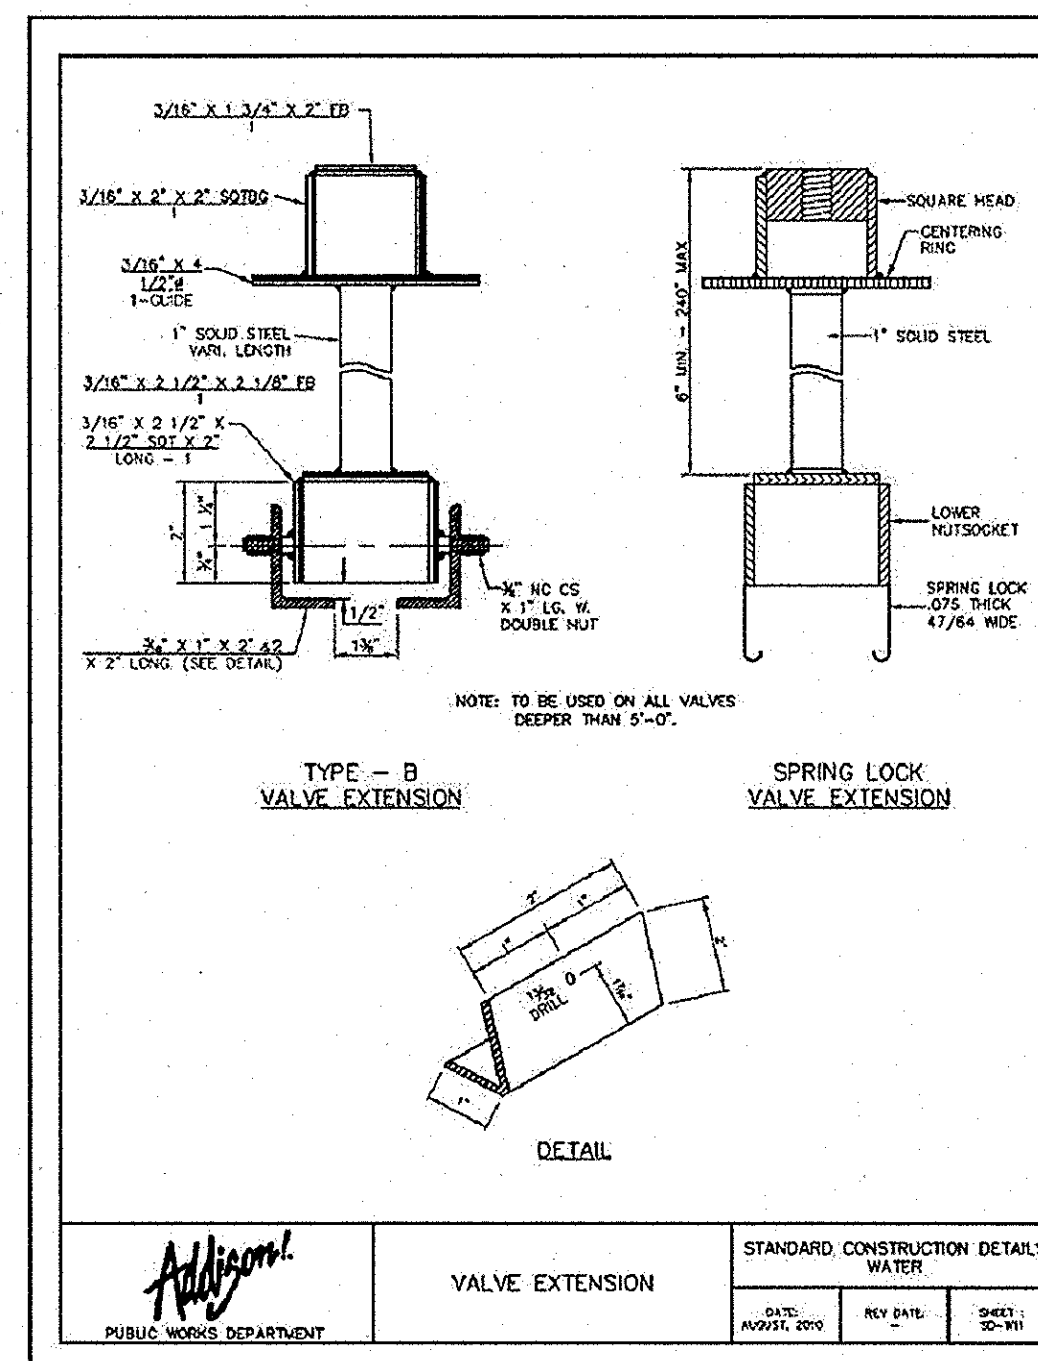
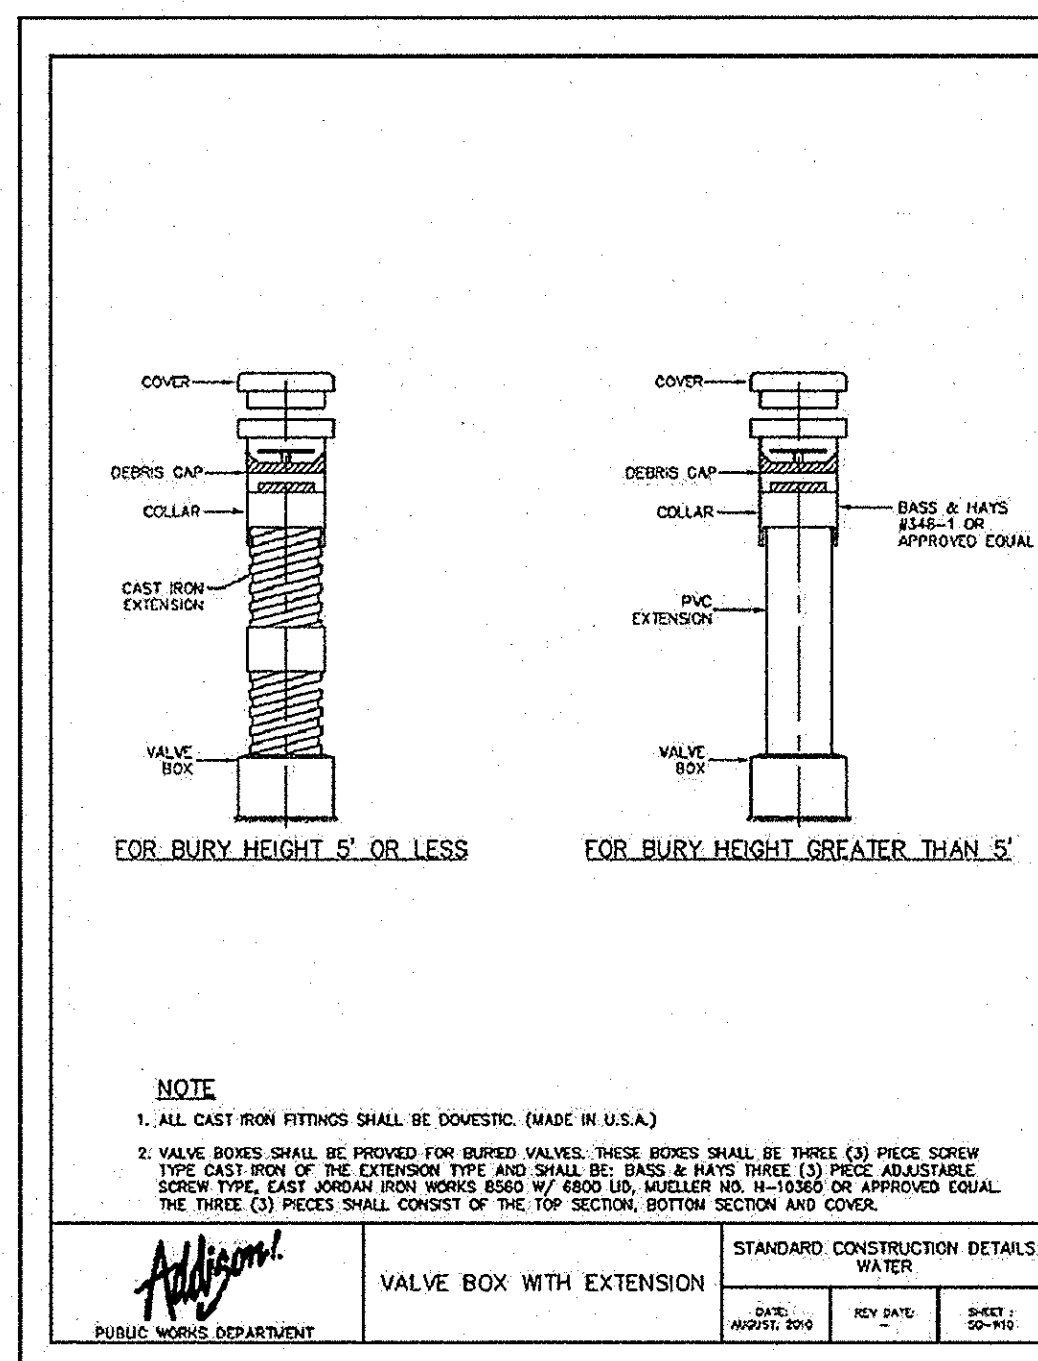
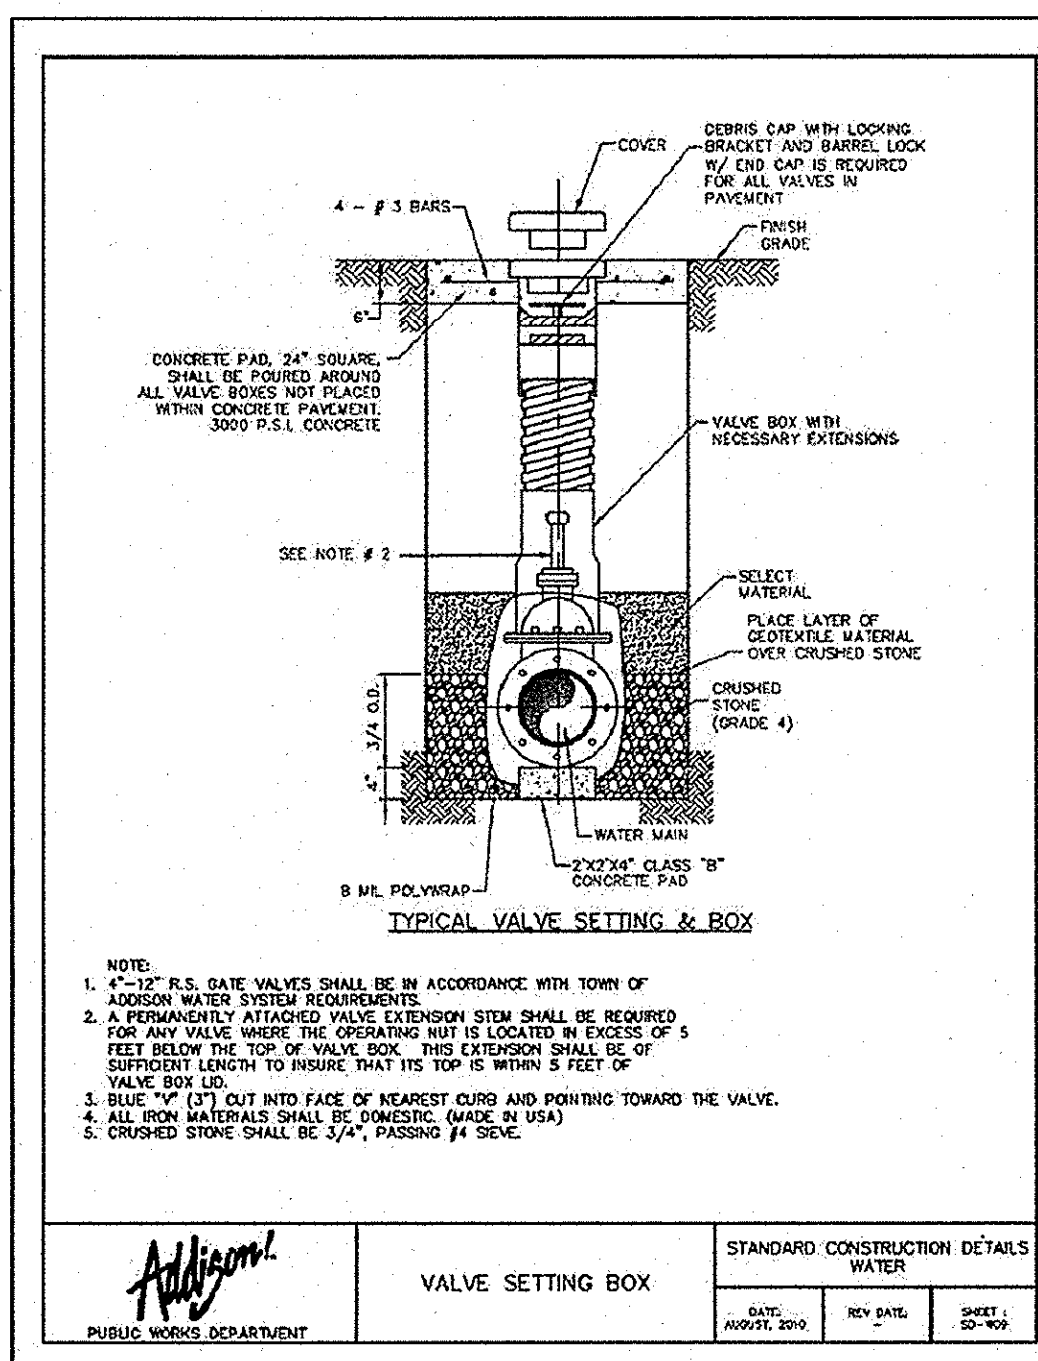


PLOTTED BY: MALIBICHO, MARLA, 09/28/2010 10:45 AM
DRAWING NO: K:\PROJECTS\10300\10300\DRAWINGS\10300\WATER\DETAILS.DWG (C:\TOWN OF ADDISON\WATER\DETAILS.DWG)
LAST SAVE: 09/28/2010 10:45 AM
This document, together with the concepts and designs presented herein, is intended only for the specific purpose and client for which it was prepared. Reuse of and improper reliance on this document without written authorization and adaptation by Kimley-Horn and Associates, Inc. shall be without liability to Kimley-Horn and Associates, Inc.

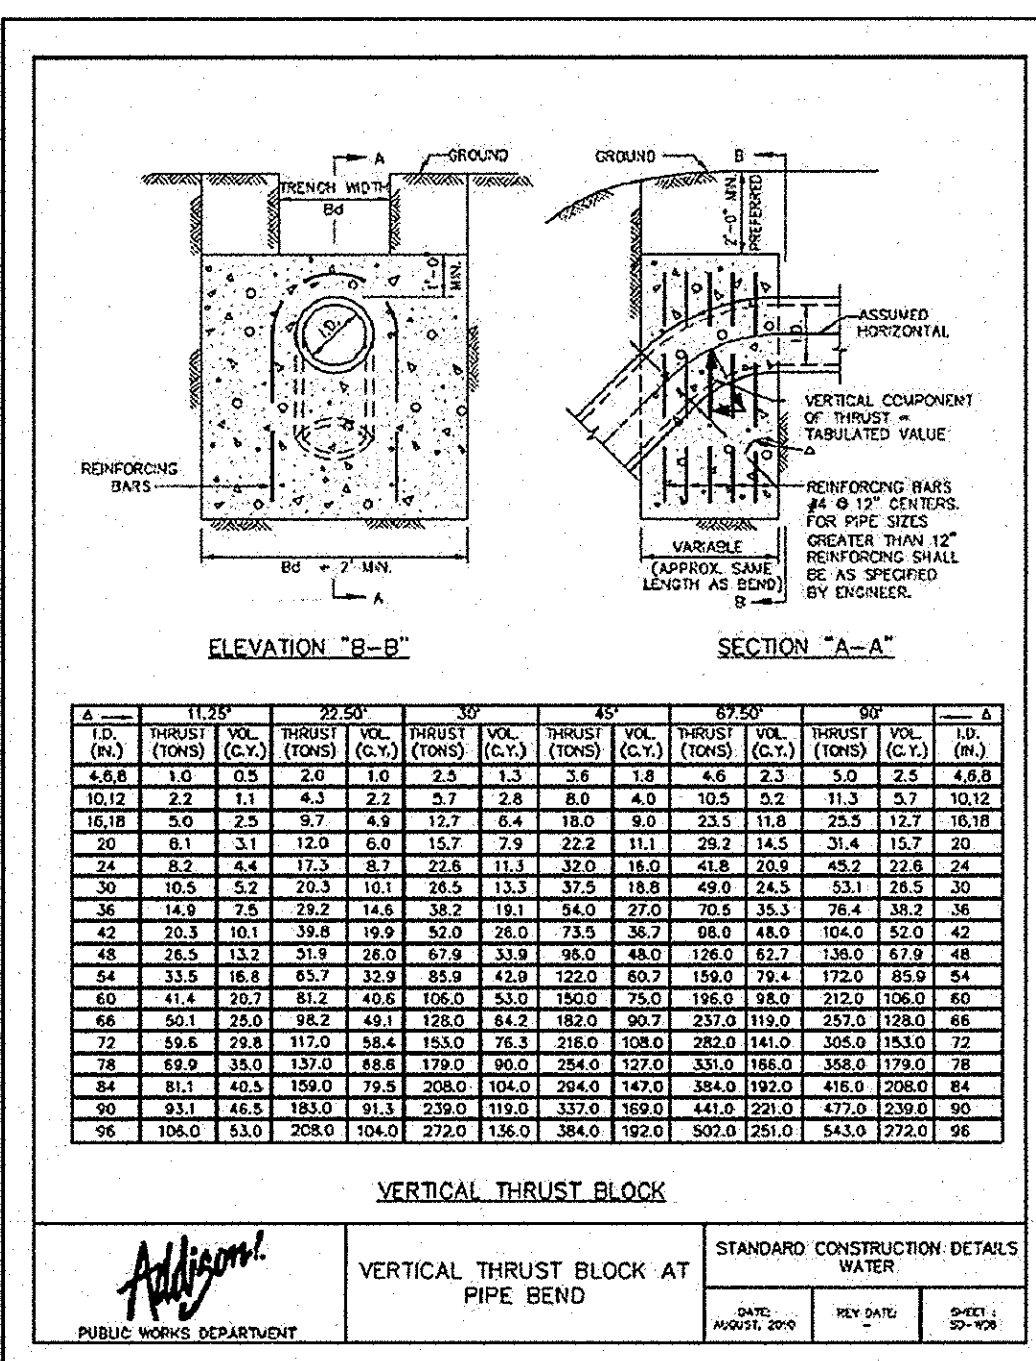

TABLES OF DIMENSIONS AND QUANTITIES											
Δ = 11.25°						Δ = 22.50°					
10' (L)	THURST (T)	THURST (T)	THURST (T)	THURST (T)	THURST (T)	10' (L)	THURST (T)	THURST (T)	THURST (T)	THURST (T)	THURST (T)
4.8	0.4	1.0	1.5	2.0	2.5	4.8	0.4	1.0	1.5	2.0	2.5
10.1	0.6	2.2	3.5	5.0	6.5	10.1	0.6	2.2	3.5	5.0	6.5
16.1	0.8	3.0	4.5	6.0	7.5	16.1	0.8	3.0	4.5	6.0	7.5
22.1	1.0	3.8	5.5	7.2	8.9	22.1	1.0	3.8	5.5	7.2	8.9
28.1	1.2	4.6	6.3	8.0	9.7	28.1	1.2	4.6	6.3	8.0	9.7
34.1	1.4	5.4	7.1	8.8	10.5	34.1	1.4	5.4	7.1	8.8	10.5
40.1	1.6	6.2	7.9	9.6	11.3	40.1	1.6	6.2	7.9	9.6	11.3
46.1	1.8	7.0	8.7	10.4	12.1	46.1	1.8	7.0	8.7	10.4	12.1
52.1	2.0	7.8	9.5	11.2	12.9	52.1	2.0	7.8	9.5	11.2	12.9
58.1	2.2	8.6	10.3	12.0	13.7	58.1	2.2	8.6	10.3	12.0	13.7
64.1	2.4	9.4	11.1	12.8	14.5	64.1	2.4	9.4	11.1	12.8	14.5
70.1	2.6	10.2	11.9	13.6	15.3	70.1	2.6	10.2	11.9	13.6	15.3
76.1	2.8	11.0	12.7	14.4	16.1	76.1	2.8	11.0	12.7	14.4	16.1
82.1	3.0	11.8	13.5	15.2	16.9	82.1	3.0	11.8	13.5	15.2	16.9
88.1	3.2	12.6	14.3	16.0	17.7	88.1	3.2	12.6	14.3	16.0	17.7
94.1	3.4	13.4	15.1	16.8	18.5	94.1	3.4	13.4	15.1	16.8	18.5
100.1	3.6	14.2	15.9	17.6	19.3	100.1	3.6	14.2	15.9	17.6	19.3

TABLES OF DIMENSIONS AND QUANTITIES											
Δ = 33.75°						Δ = 45.00°					
10' (L)	THURST (T)	THURST (T)	THURST (T)	THURST (T)	THURST (T)	10' (L)	THURST (T)	THURST (T)	THURST (T)	THURST (T)	THURST (T)
4.8	0.4	1.0	1.5	2.0	2.5	4.8	0.4	1.0	1.5	2.0	2.5
10.1	0.6	2.2	3.5	5.0	6.5	10.1	0.6	2.2	3.5	5.0	6.5
16.1	0.8	3.0	4.5	6.0	7.5	16.1	0.8	3.0	4.5	6.0	7.5
22.1	1.0	3.8	5.5	7.2	8.9	22.1	1.0	3.8	5.5	7.2	8.9
28.1	1.2	4.6	6.3	8.0	9.7	28.1	1.2	4.6	6.3	8.0	9.7
34.1	1.4	5.4	7.1	8.8	10.5	34.1	1.4	5.4	7.1	8.8	10.5
40.1	1.6	6.2	7.9	9.6	11.3	40.1	1.6	6.2	7.9	9.6	11.3
46.1	1.8	7.0	8.7	10.4	12.1	46.1	1.8	7.0	8.7	10.4	12.1
52.1	2.0	7.8	9.5	11.2	12.9	52.1	2.0	7.8	9.5	11.2	12.9
58.1	2.2	8.6	10.3	12.0	13.7	58.1	2.2	8.6	10.3	12.0	13.7
64.1	2.4	9.4	11.1	12.8	14.5	64.1	2.4	9.4	11.1	12.8	14.5
70.1	2.6	10.2	11.9	13.6	15.3	70.1	2.6	10.2	11.9	13.6	15.3
76.1	2.8	11.0	12.7	14.4	16.1	76.1	2.8	11.0	12.7	14.4	16.1
82.1	3.0	11.8	13.5	15.2	16.9	82.1	3.0	11.8	13.5	15.2	16.9
88.1	3.2	12.6	14.3	16.0	17.7	88.1	3.2	12.6	14.3	16.0	17.7
94.1	3.4	13.4	15.1	16.8	18.5	94.1	3.4	13.4	15.1	16.8	18.5
100.1	3.6	14.2	15.9	17.6	19.3	100.1	3.6	14.2	15.9	17.6	19.3

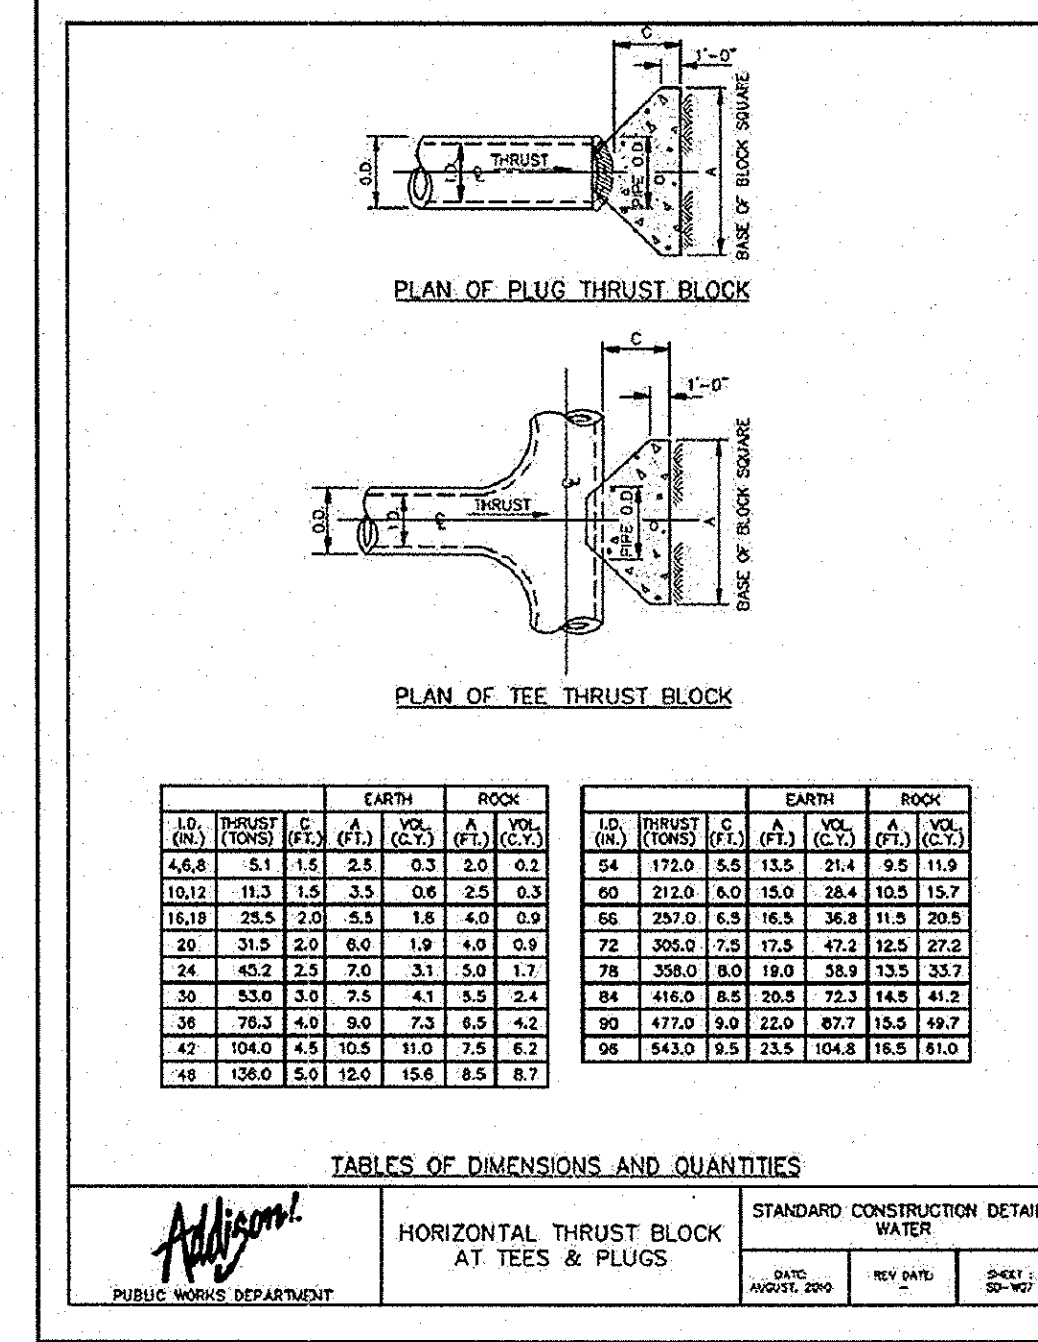

RECORD DRAWINGS (October 2013)
Information Provided By:
BOB MOORE CONSTRUCTION

Kimley-Horn and Associates, Inc.
State of Texas Registration No. F-928
5750 GENESS COURT, SUITE 200, FRISCO, TX 75034
PHONE: 972-335-3580 FAX: 972-335-3779
WWW.KIMLEY-HORN.COM

VILLAGE ON THE PARKWAY
ADDISON, TEXAS

TOWN OF ADDISON WATER DETAILS

SHEET NUMBER C-20

NO.	REVISIONS	DATE	BY