




**1 CONCRETE PAVEMENT SECTION**  
NOT TO SCALE

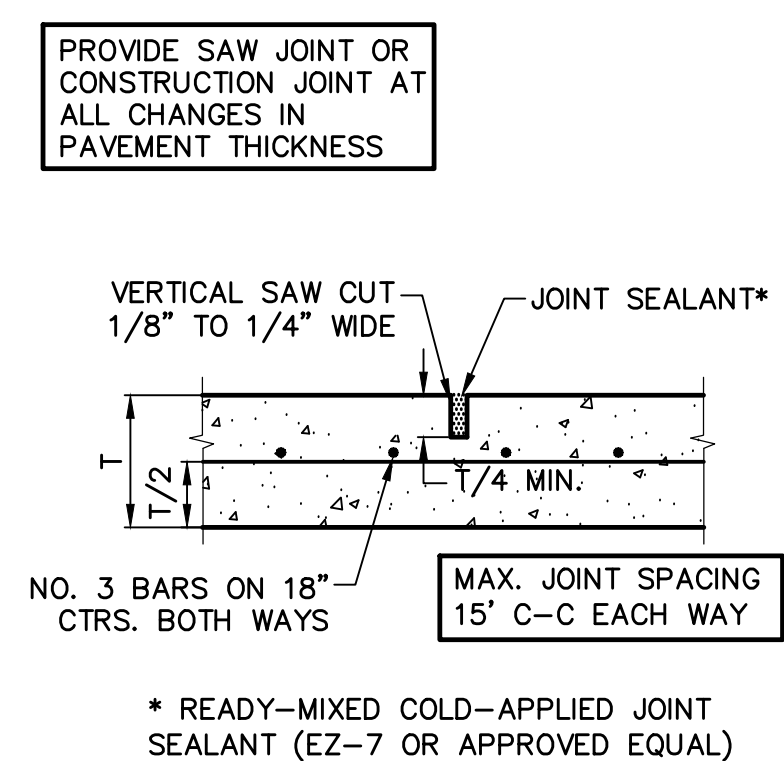


**2 SAWED DUMMY JOINT**  
NOT TO SCALE

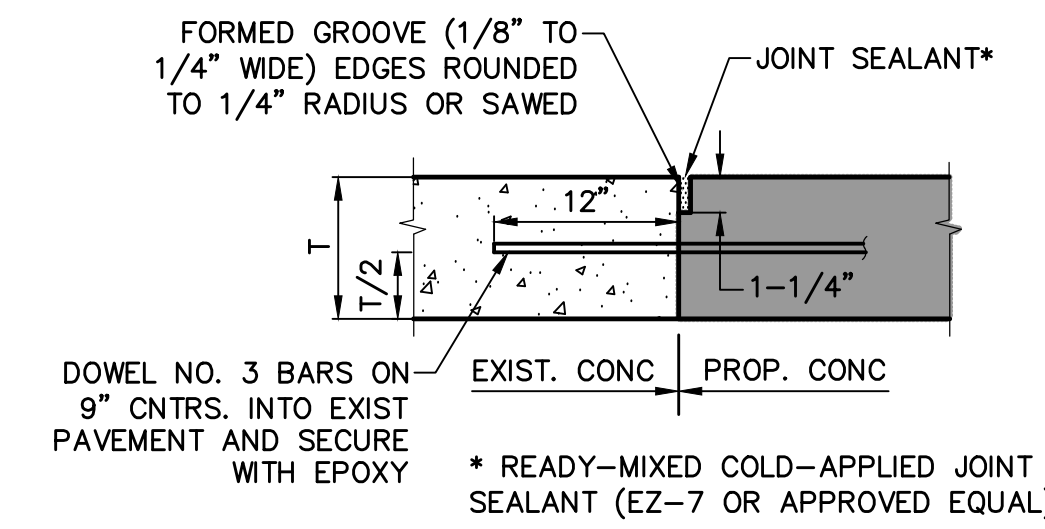


**3 PAVEMENT CONNECTION**  
NOT TO SCALE

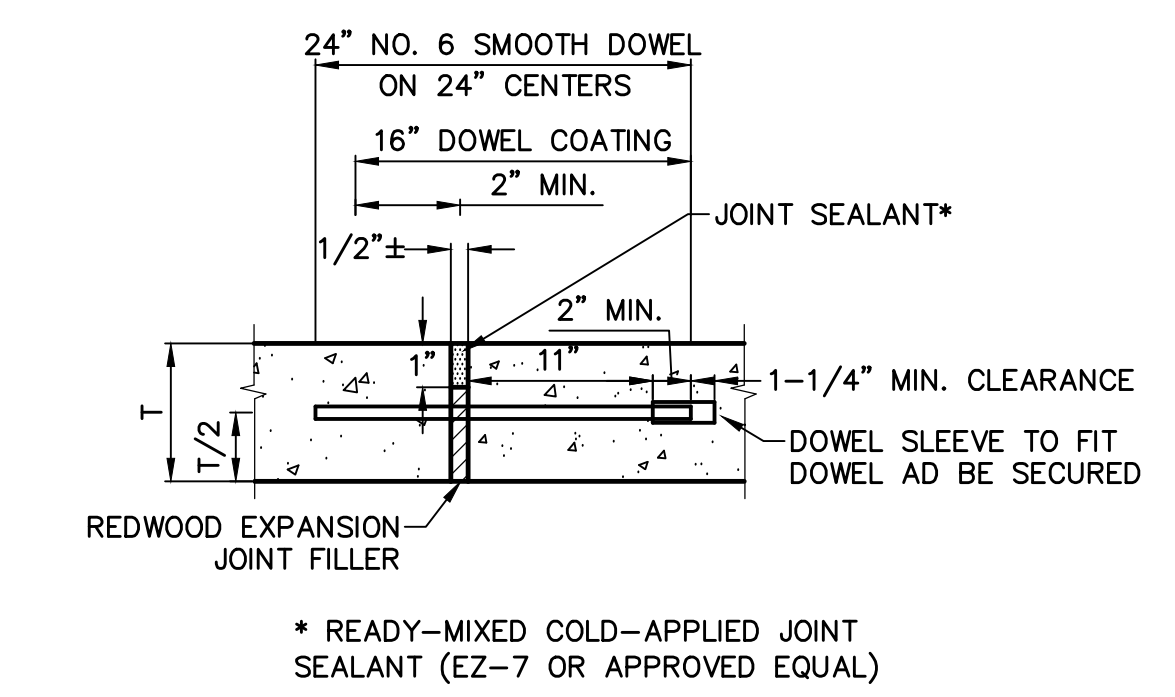


**4 EXPANSION JOINT**  
NOT TO SCALE

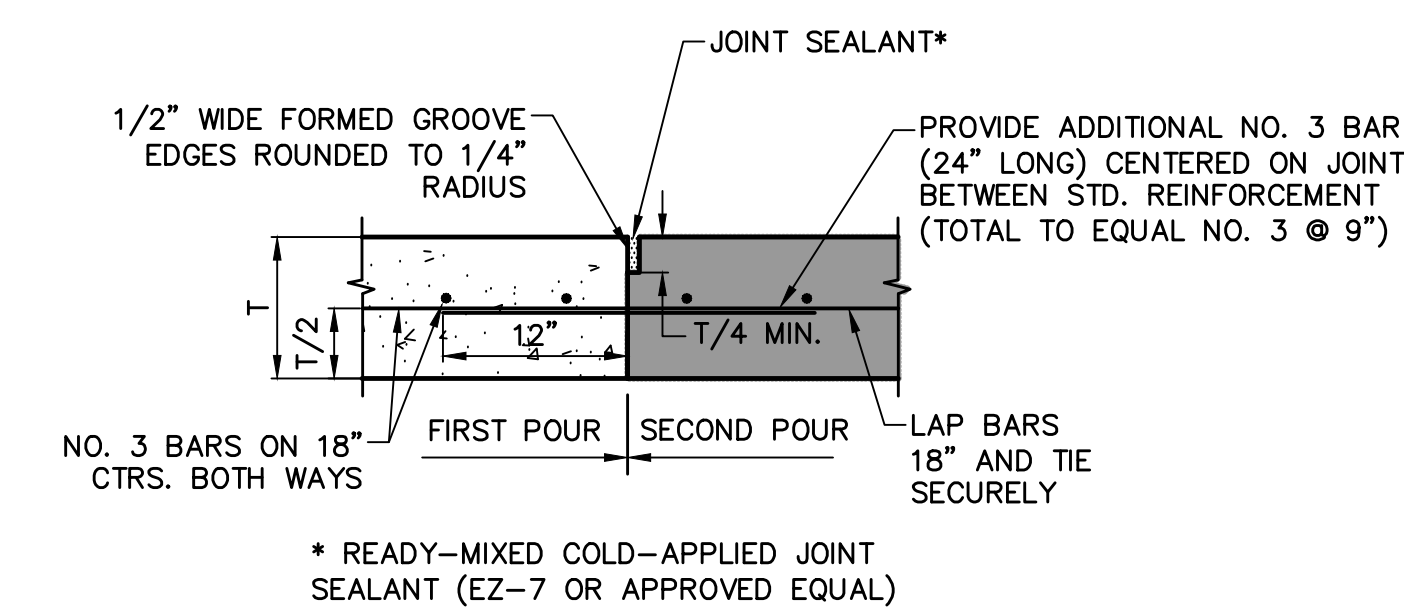


**5 CONSTRUCTION JOINT**  
NOT TO SCALE

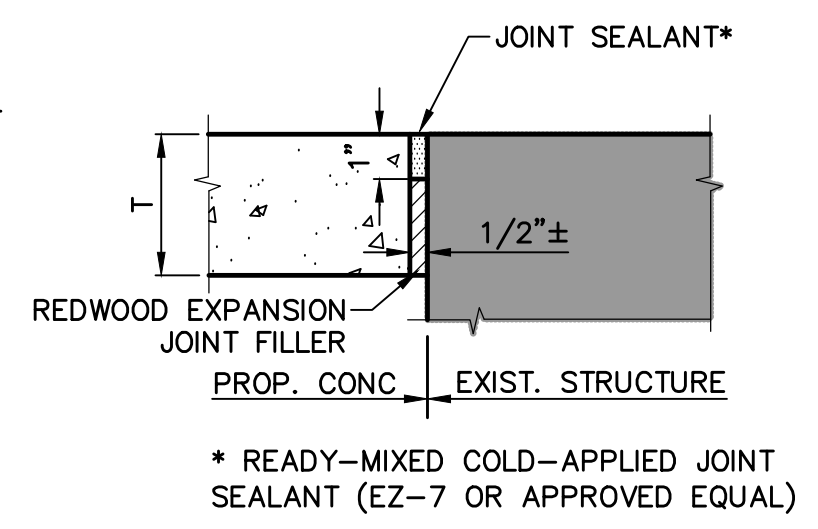

**6 ISOLATION JOINT**  
NOT TO SCALE

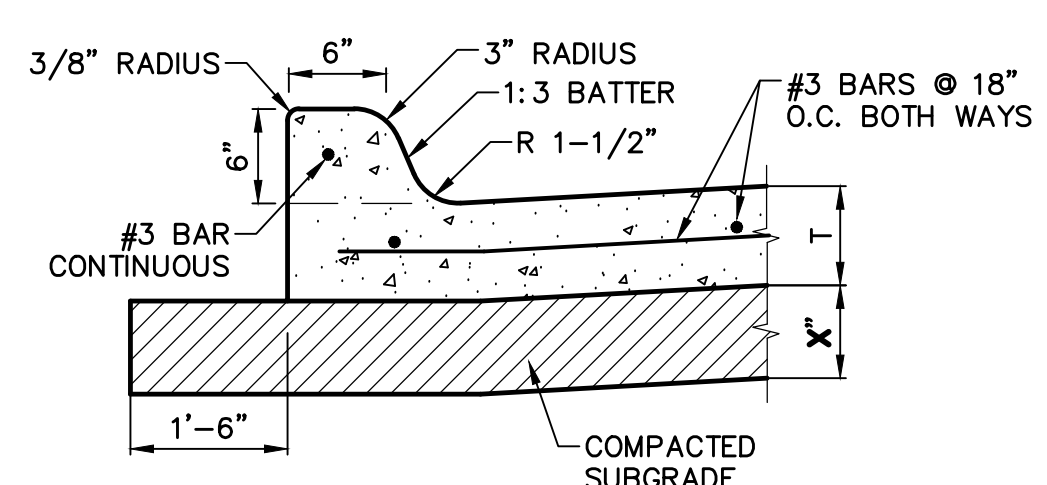


**7 INTEGRAL CURB**  
NOT TO SCALE

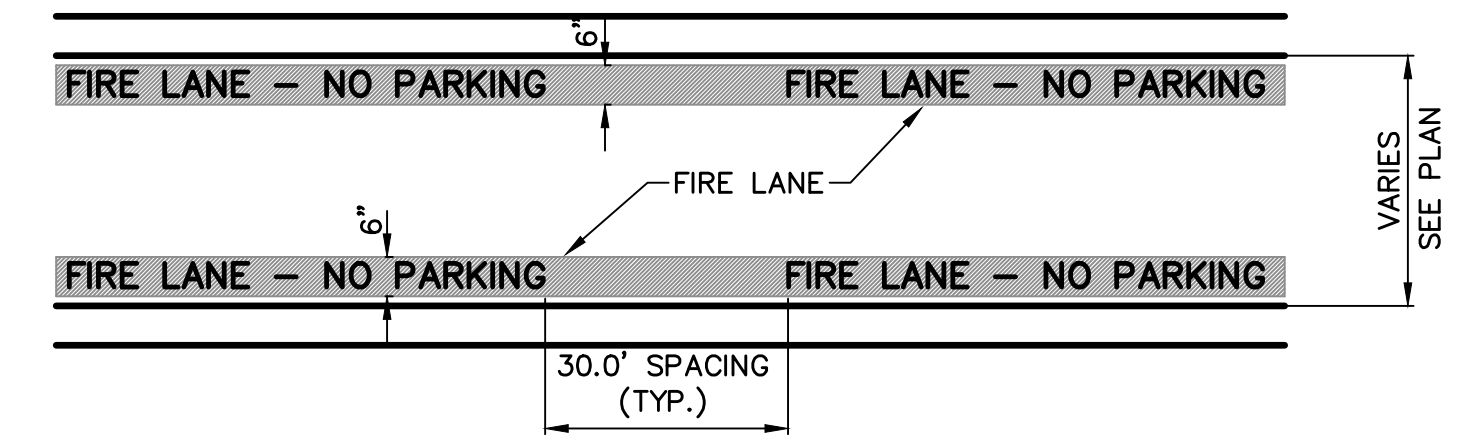


**GENERAL NOTE:**  
A. STRIPING TO BE DONE IN ACCORDANCE WITH CITY STANDARDS.

**STRIPING DETAIL NOTE:**  
A. PAINT:  
1. STRIPE SHALL BE SIX (6) INCHES WIDE PAINTED WITH AN EXTERIOR ACRYLIC LATEX PAINT.  
A. COLOR SHALL BE "TRAFFIC RED" GLIDDEN NO. 63251 OR EQUAL.  
2. LETTERS SHALL BE FOUR (4) INCHES HIGH PAINTED WITH AN EXTERIOR ACRYLIC LATEX PAINT.  
B. COLOR SHALL BE "TRAFFIC WHITE" GLIDDEN NO. 563245 OR EQUAL.  
B. APPLICATION:  
1. STRIPE MAY BE BRUSHED OR SPRAYED, ONE COAT TO FINISH.  
2. LETTERS SHALL BE STENCIL FORMED, BRUSH APPLIES AND SPACED AS DETAILED ON THIS SHEET.


**8 FIRE LANE STRIPING**  
NOT TO SCALE

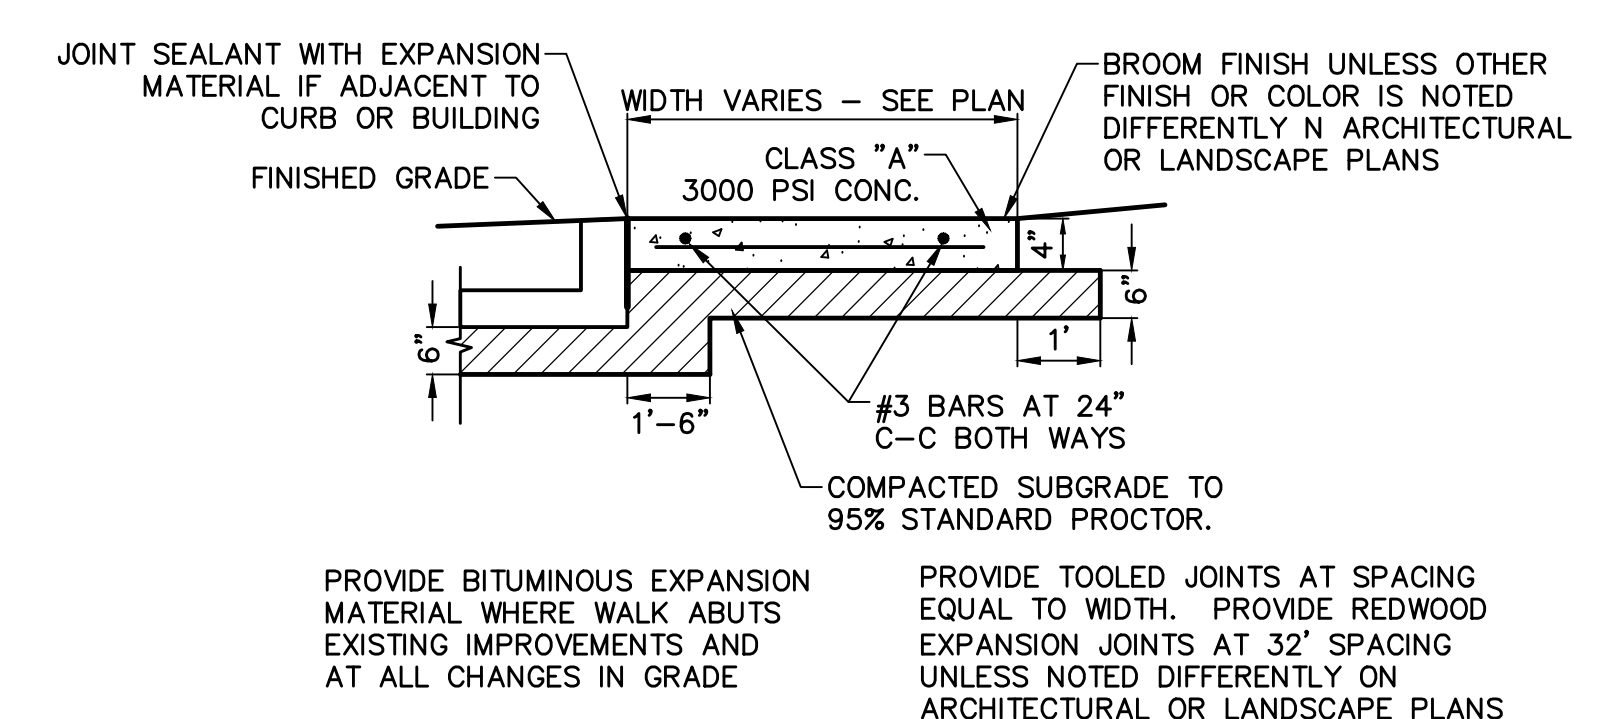

**9 CONCRETE WALK PRIVATE**  
NOT TO SCALE

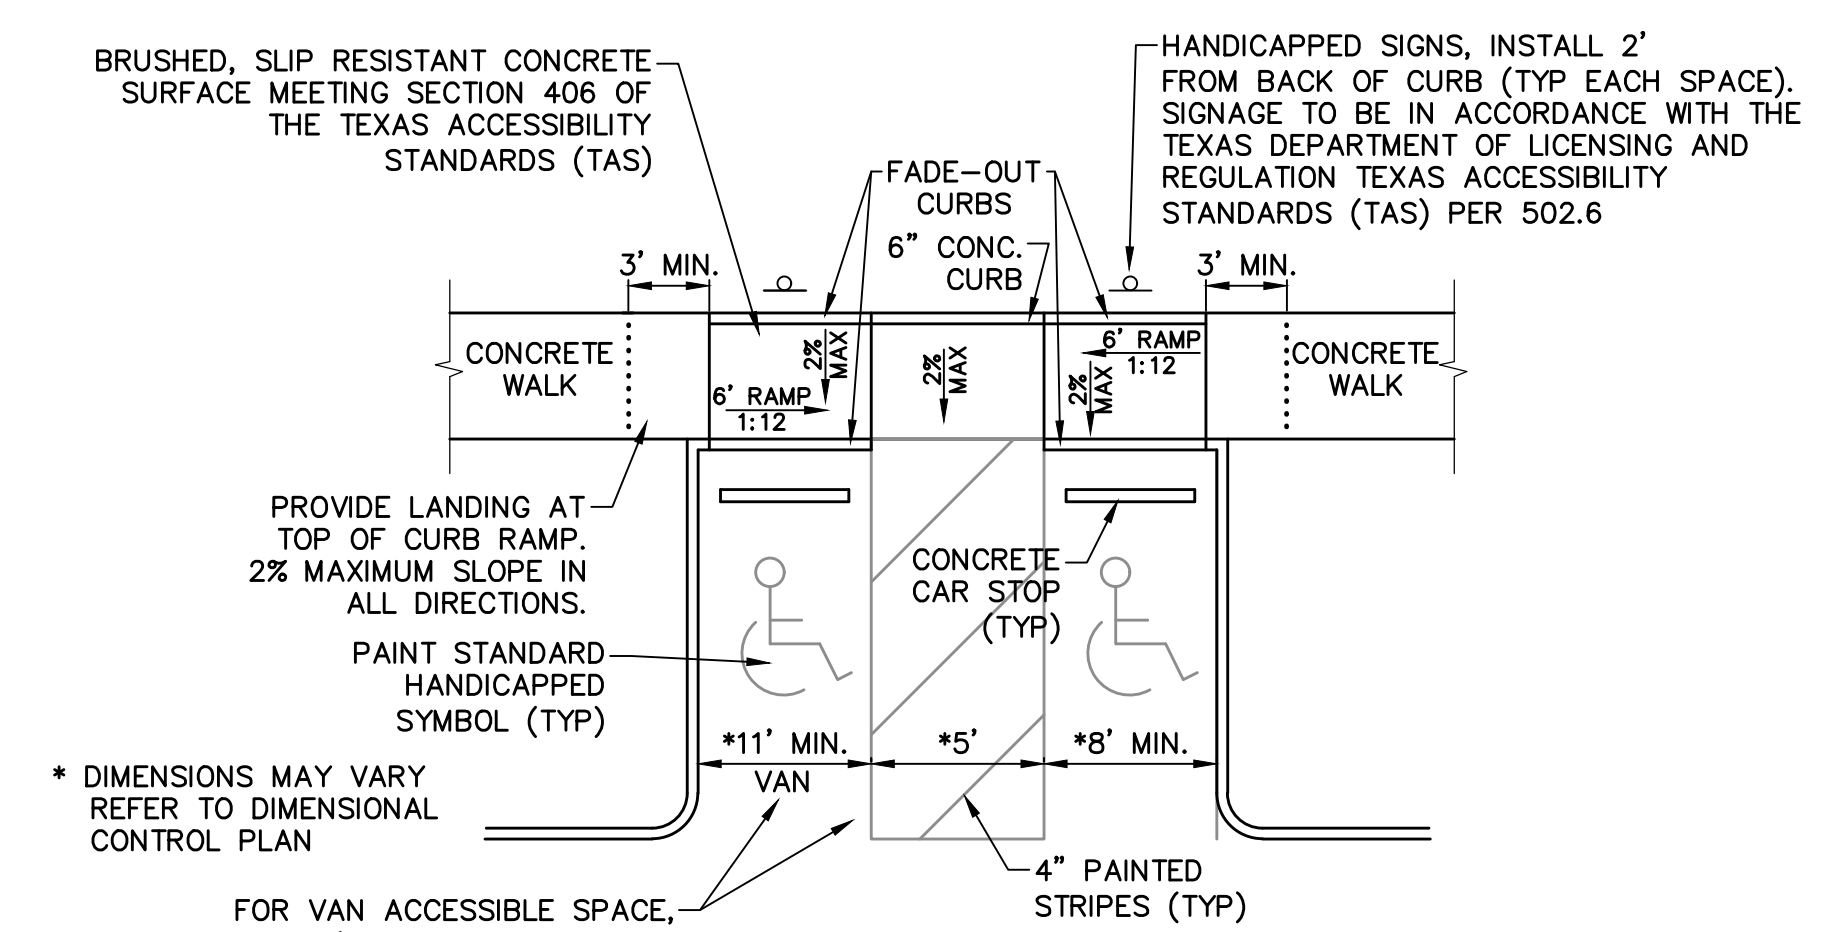

**10 90° HANDICAP PARKING & TWO-WAY CURB RAMP**  
NOT TO SCALE (PRIVATE ONLY)

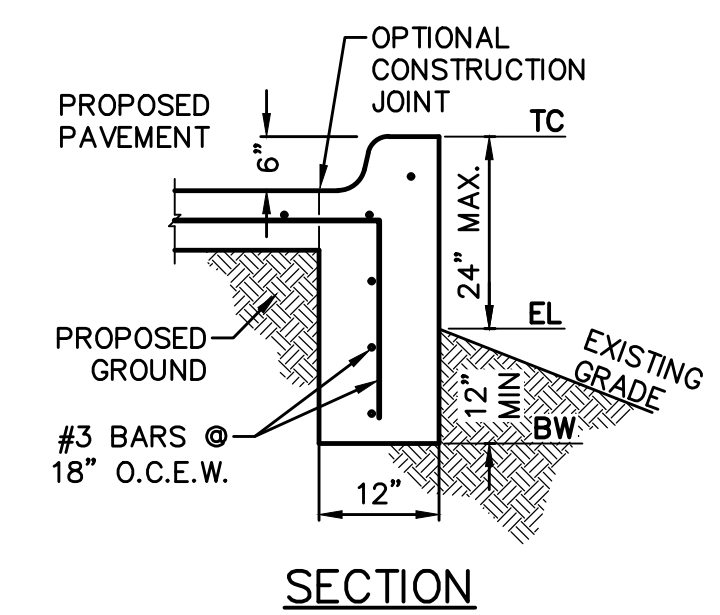

**11 CURB W/WALL**  
NOT TO SCALE

**RECORD DRAWING**

THE SIGNED AND SEALED CONSTRUCTION DOCUMENT HAS BEEN REVISED TO REFLECT CONSTRUCTION RECORDS MAINTAINED AND PROVIDED BY THE CONTRACTOR FOR THIS PROJECT. THE INFORMATION SHOWN ON THIS RECORD DRAWING, WHICH WAS PROVIDED BY THE CONTRACTOR, OR OTHERS NOT ASSOCIATED WITH THE DESIGN ENGINEER, CANNOT BE VERIFIED FOR ACCURACY OR COMPLETENESS. PACHECO KOCH SHALL ASSUME NO LIABILITY FOR ANY CHANGES MADE DURING CONSTRUCTION THAT WERE NOT SPECIFICALLY APPROVED BY THE ENGINEER PRIOR TO CONSTRUCTION. THE SEALED CONSTRUCTION DRAWINGS ARE ON FILE AT THE OFFICES OF PACHECO KOCH.

ATTESTED BY:  
*Cody Risner*  
ENGINEER OF RECORD: CODY R. RISNER, PE # 123160  
CONTRACTOR: STRATEGIC CONSTRUCTION  
DATE REVISED: 11/10/2020

NO.	DATE	REVISION
1	11/10/2020	RECORD DRAWINGS
<b>Pacheco Koch</b>		
7557 RAMBLER ROAD SUITE 1400 DALLAS, TX 75231 972.235.3031 TX REG. ENGINEERING FIRM F-469 TX REG. SURVEYING FIRM LS-10008000		
<b>PRIVATE PAVING DETAILS</b>		
<b>OFFICE BUILDING</b>		
<b>4595 EXCEL PARKWAY</b>		
<b>0.978 ACRE TRACT</b>		
<b>TOWN OF ADDISON, DALLAS COUNTY, TEXAS</b>		
DESIGN	DRAWN	DATE
CRR	CBA	FEB 2020
SCALE	NOTES	FILE
NO.	<b>C6.2</b>	

CARRANAGA 12:04 PM  
M:\DWG-21\2112-19.055\DWG\CIVIL\_CSD\_2018\2112-19.055\_PVMT.DWG