

CP XC
N 8477.62
E 9816.12

CP XC
N 8053.82
E 9815.77

BM #1

CP XC
N 8565.80
E 11113.21


CP XC
N 8065.33
E 10660.78

CP XC
N 8055.14
E 10753.98

LEGEND

LIMITS OF DISTURBANCE -----

BM #1 REF. ELEVATION = 547.84
SQUARE CUT IN TOP OF CURB, NORTH MEDIAN END NOSE,
AT INTERSECTION OF VITRUVIAN WAY AND MARSH LANE.
BM #2 REF. ELEVATION = 559.47
SQUARE CUT IN TOP OF CURB, SOUTH MEDIAN END
NOSE, MARSH LANE 1127' NORTH OF VITRUVIAN WAY.

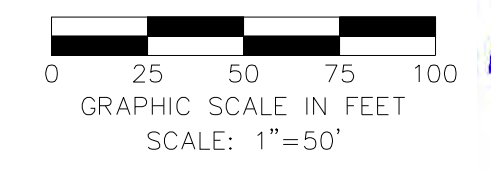

NO.	REVISION	BY	DATE

icon Consulting Engineers, Inc. 2840 W. Southlake Blvd., Suite 110
Civil Engineers - Designers - Planners Southlake, TX 76092 (817) 552-6210
Engineering Firm Registration Number F-9007

VITRUVIAN WEST 2
VITRUVIAN PARK - TOWN OF ADDISON, TEXAS
3725 VITRUVIAN WAY
**OVERALL LAYOUT &
PROJECT CONTROL**

DESIGN	DRAWN	DATE	SCALE	NOTES	Sheet No.
ICE	ICE	NOV 17, 2020	AS NOTED		C2.00

VITRUVIAN WEST 2 - PROJECT NO. 5019-18