



_	_
\geq	4
	11111

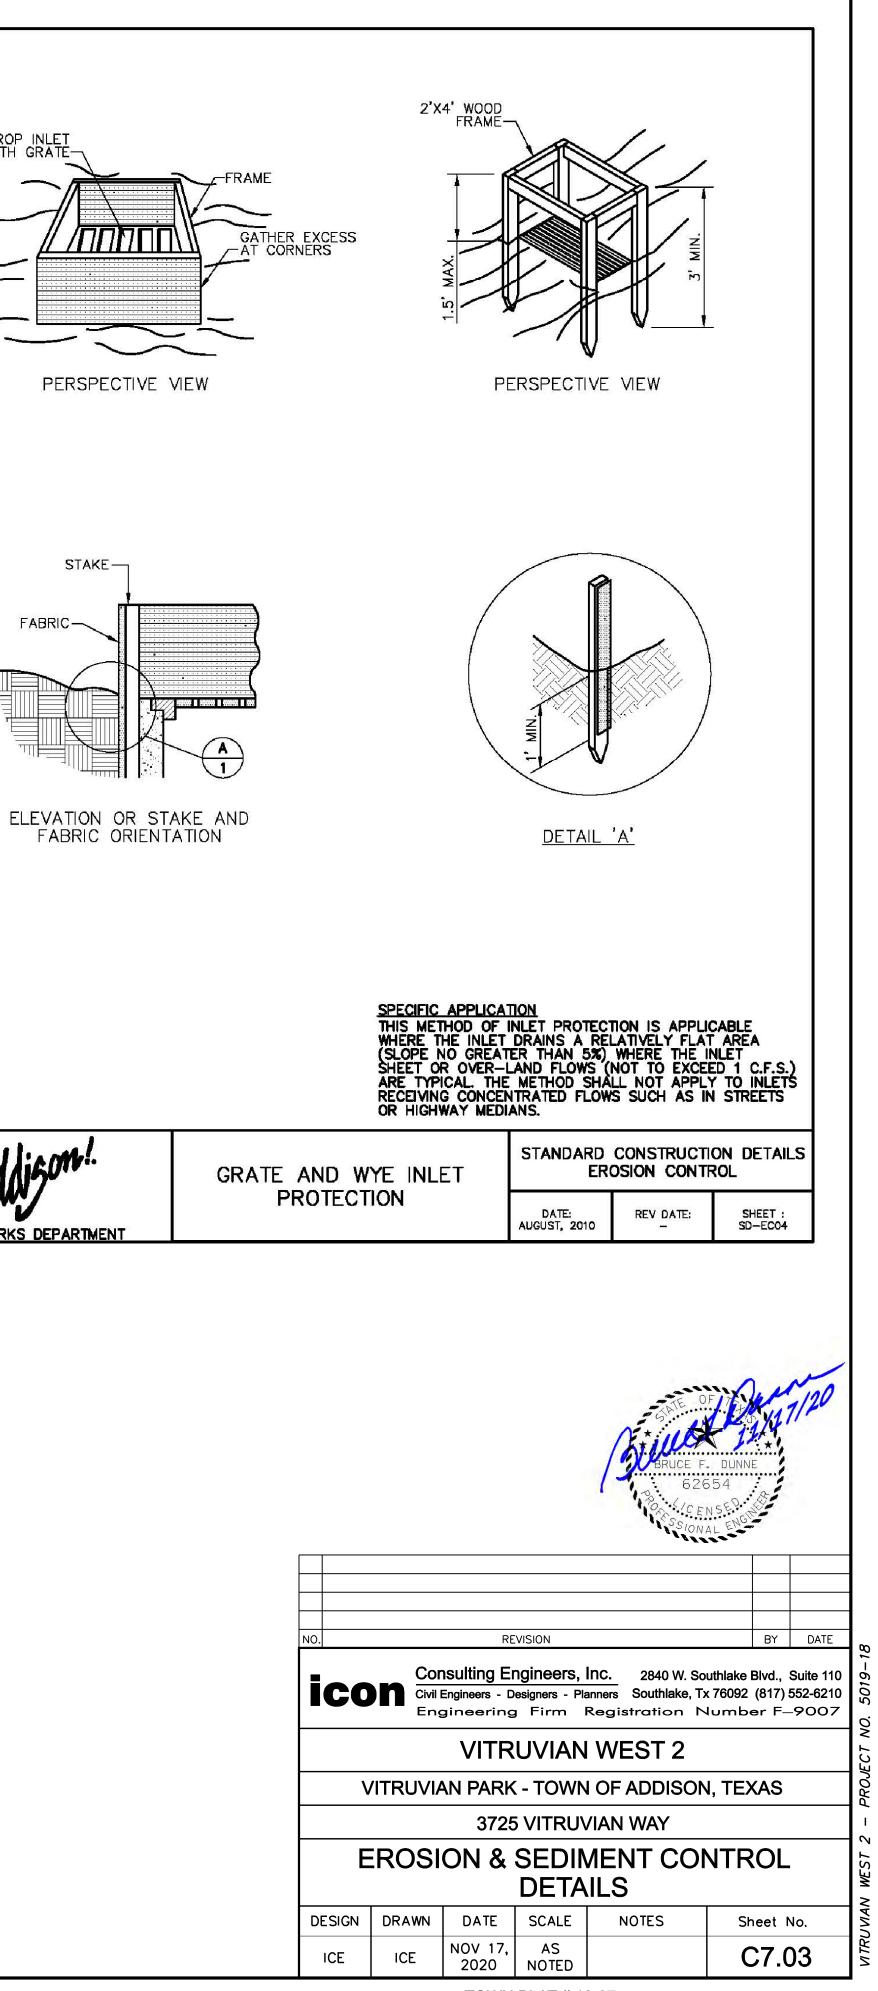

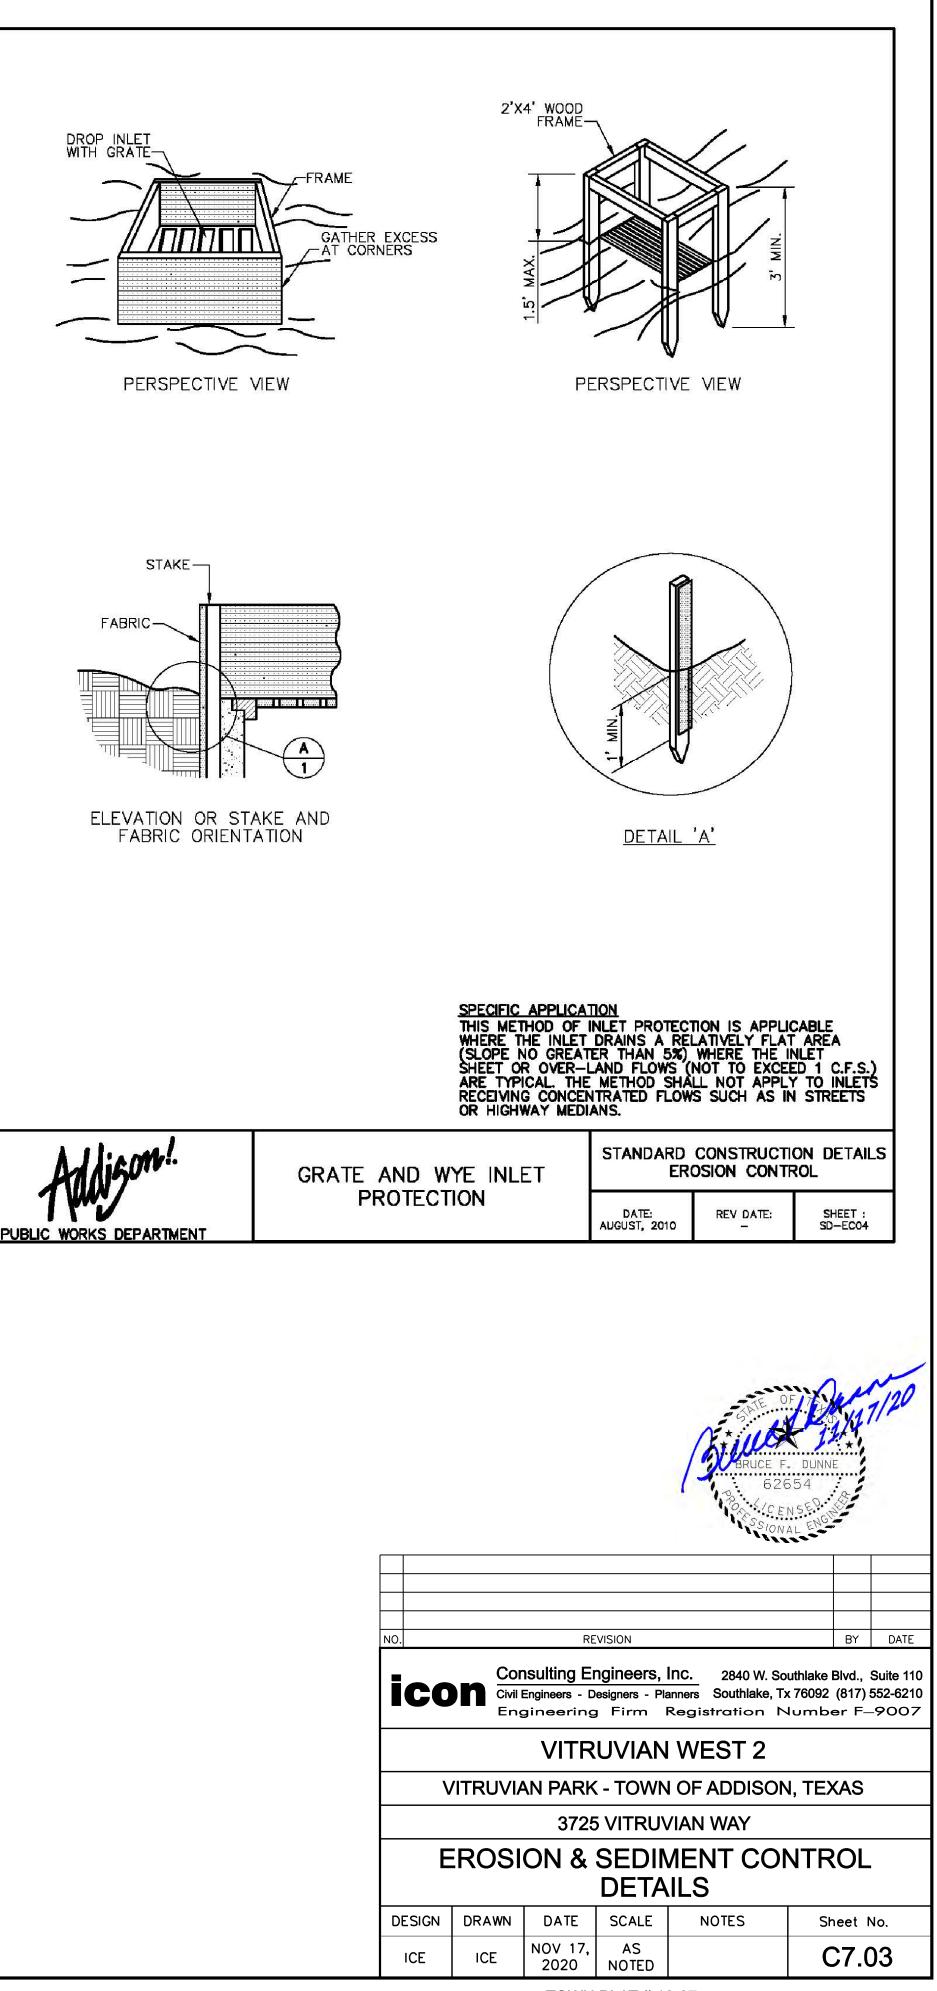

AS-BUILT/RECORD DRAWINGS TOWN PLAT # 16-07 TOWN PROJECT # 2018-09D