

PLANS FOR THE CONSTRUCTION OF  
**CIVIL SITE WORK IMPROVEMENTS**

FOR

**VITRUVIAN WEST 2**

*Lot 2, Block D, Vitruvian Park Addition*

*3725 Vitruvian Way*

*Addison, Texas*

**OWNER/DEVELOPER:**

UDR  
 3875 PONTE AVE., SUITE 400  
 ADDISON, TEXAS 75001  
 PH: (972) 774-0552

CONTACT: BRIAN RICHARDSON  
 EMAIL: BRRICHARDSON@UDR.COM


**CIVIL ENGINEER:**

ICON CONSULTING ENGINEERS, INC.  
 2840 W. SOUTHLAKE BLVD., SUITE 110  
 SOUTHLAKE, TEXAS 76092  
 PH: (817) 552-6210

CONTACT: BRUCE F. DUNNE, P.E.  
 EMAIL: BDUNNE@CON-ENGINEERS.COM

**SURVEYOR:**

KADLECK & ASSOCIATES,  
 A DIVISION OF WESTWOOD  
 2740 NORTH DALLAS PKWY., SUITE 280  
 PLANO, TEXAS, 75093  
 PH: (214) 473-4640  
 CONTACT: LYNN KADLECK, R.P.L.S.  
 EMAIL: LYNN.KADLECK@WESTWOODPS.COM

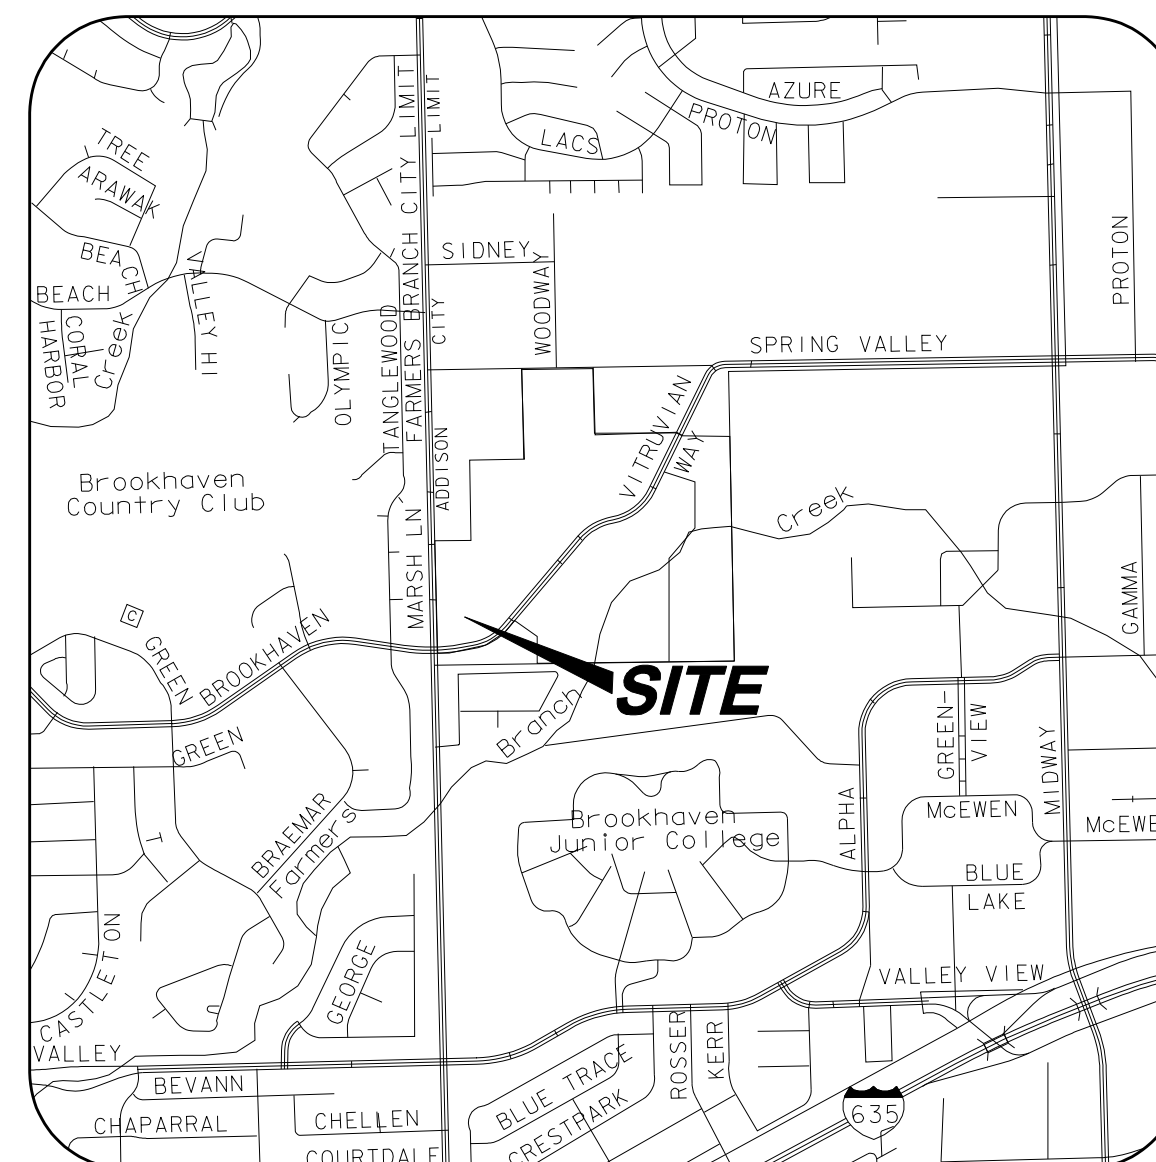

**VICINITY MAP**

NOT TO SCALE  
 (MAPSCO GRID 13 & 14)



**INDEX OF DRAWINGS**

1	CS	COVER SHEET
2	FP1	FINAL PLAT SHEET 1 of 2
3	FP2	FINAL PLAT SHEET 2 of 2
4	C1.00	GENERAL CONSTRUCTION NOTES, LEGEND & ABBREVIATIONS
5	C1.01	DEMOLITION PLAN - CENTER
6	C1.02	DEMOLITION PLAN - SOUTH
7	C1.03	DEMOLITION PLAN - NORTH
8	C2.00	OVERALL LAYOUT & PROJECT CONTROL
9	C2.01	LAYOUT & DIMENSIONAL CONTROL PLAN - CENTER
10	C2.02	LAYOUT & DIMENSIONAL CONTROL PLAN - SOUTH
11	C2.03	LAYOUT & DIMENSIONAL CONTROL PLAN - NORTH
12	C3.01	GRADING PLAN - CENTER
13	C3.02	GRADING PLAN - SOUTH
14	C3.03	GRADING PLAN - NORTH
15	C4.00E	STORM DRAIN CALCULATIONS - PREDEVELOPMENT
16	C4.00P	STORM DRAIN CALCULATIONS - POSTDEVELOPMENT
17	C4.01	STORM DRAIN PLAN - CENTER
18	C4.02	STORM DRAIN PLAN - SOUTH
19	C4.04	STORM DRAIN PROFILES
20	C4.05	STORM DRAIN PROFILES
21	C4.06	PRIVATE STORM DRAIN DETAILS
22	C5.01	UTILITY PLAN - CENTER
23	C5.02	UTILITY PLAN - SOUTH
24	C6.01	PAVING PLAN - CENTER
25	C6.02	PAVING PLAN - SOUTH
26	C6.03	PAVING PLAN - NORTH
27	C6.04	PRIVATE PAVING DETAILS
28	C7.01	EROSION & SEDIMENT CONTROL PLAN
29	C7.02	EROSION & SEDIMENT CONTROL DETAILS
30	C7.03	EROSION & SEDIMENT CONTROL DETAILS

**icon** Consulting Engineers, Inc.  
 Civil Engineers- Designers- Planners  
 ENGINEERING FIRM REGISTRATION NUMBER F-9007

**NOVEMBER 17, 2020 - AS-BUILT / RECORD DRAWINGS**

THE PROPERTY OWNER IS LIABLE TO RESTORE/REPLACE ANY  
 DAMAGED CITY APPROVED/CONTROLLED INFRASTRUCTURE  
 IN THE PUBLIC RIGHT OF WAY.

