


Landscape Plan - Vitruvian Way **A**
 Scale: 1"=20'

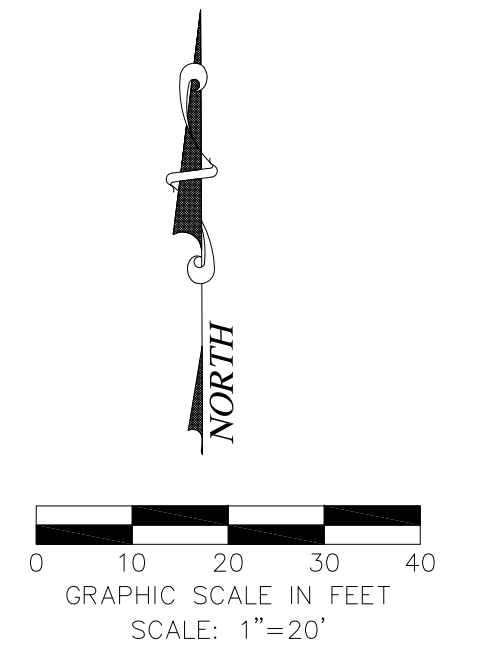

NO.	REVISION	BY	DATE

studioOutside
 824 Exposition Avenue, Ste. 5
 Dallas, Texas 75226
 o214.954.7160
 f214.954.7162

VW2 STREETSCAPE IMPROVEMENTS
 VP PUBLIC INFRASTRUCTURE - PHASE 5, BLOCK 200B
 TOWN OF ADDISON, TEXAS

LANDSCAPE PLAN
 VITRUVIAN WAY

DESIGN	DRAWN	DATE	SCALE	NOTES	Sheet No.
BG	LZ	SEPT 10, 2019	AS NOTED		17

VW2 STREETSCAPE - VP PUBLIC INFRASTRUCTURE - PHASE 5, BLOCK 200B - PROJECT NO. 5029-06