


Irrigation Plan - Vitruvian Way **A**

Scale: 1"=20'

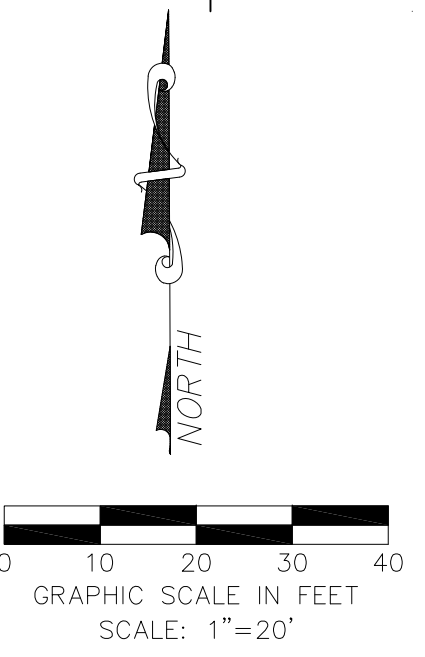

**SETH HEIDMAN**  
IRRIGATION DESIGN & CONSULTING, LLC  
1000 W. Parker Rd. #1402-221, Plano, Texas 75075 Tel: 972-854-5144



NO.	REVISION	BY	DATE

**studioOutside**  
824 Exposition Avenue, Ste. 5  
Dallas, Texas 75226  
o214.954.7160  
f214.954.7162

**VW2 STREETSCAPE IMPROVEMENTS**  
VP PUBLIC INFRASTRUCTURE - PHASE 5, BLOCK 200B  
TOWN OF ADDISON, TEXAS

IRRIGATION PLAN					
VITRUVIAN WAY					
DESIGN	DRAWN	DATE	SCALE	NOTES	Sheet No.
SAH	SAH	SEPT 10, 2019	AS NOTED		<b>19</b>

Irrigation in Texas is regulated by the Texas Commission of Environmental Quality (TCEQ), 1701 North East Street, Austin, Texas, 78711-3887. TCEQ website is: www.tceq.texas.gov

VP - PUBLIC INFRASTRUCTURE - PHASE 5, BLOCK 200B - PROJECT NO. 5029-06