



IRRIGATION SYSTEM FOR THIS AREA UNDER SEPARATE CONTRACT, TO BE COMPLETED BY THE BUILDING CONTRACTOR

FF(2)=565.0
FF(1)=552.8

FF(2)=
FF(1)=

FF(2)=
FF(1)=

MARSH LANE

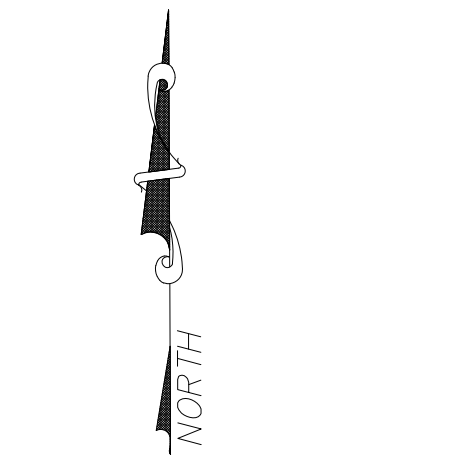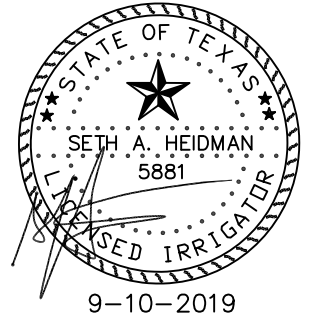

SETH HEIDMAN
IRRIGATION DESIGN & CONSULTING, LLC
1000 W. Parker Rd. #100-201, Plano, Texas 75075 Tel: 972.854.5144

NO.	REVISION	BY	DATE

studioOutside
824 Exposition Avenue, Ste. 5
Dallas, Texas 75226
o214.954.7160
f214.954.7162

VW2 STREETSCAPE IMPROVEMENTS
VP PUBLIC INFRASTRUCTURE - PHASE 5, BLOCK 200B
TOWN OF ADDISON, TEXAS

IRRIGATION PLAN
MARSH LANE

DESIGN	DRAWN	DATE	SCALE	NOTES	Sheet No.
SAH	SAH	SEPT 10, 2019	AS NOTED		20

Irrigation Plan - Marsh Lane **A**

Scale: 1"=20'

Irrigation in Texas is regulated by the Texas Commission of Environmental Quality (TCEQ), MC-578, P.O. Box 13887, Austin, Texas, 78711-3887. TCEQ website is: www.tceq.texas.gov

VP - PUBLIC INFRASTRUCTURE - PHASE 5, BLOCK 200B - PROJECT NO. 5029-06