



TYPICAL STREETSCAPE PLAN - VITRUVIAN WAY
SCALE: 1"=6"

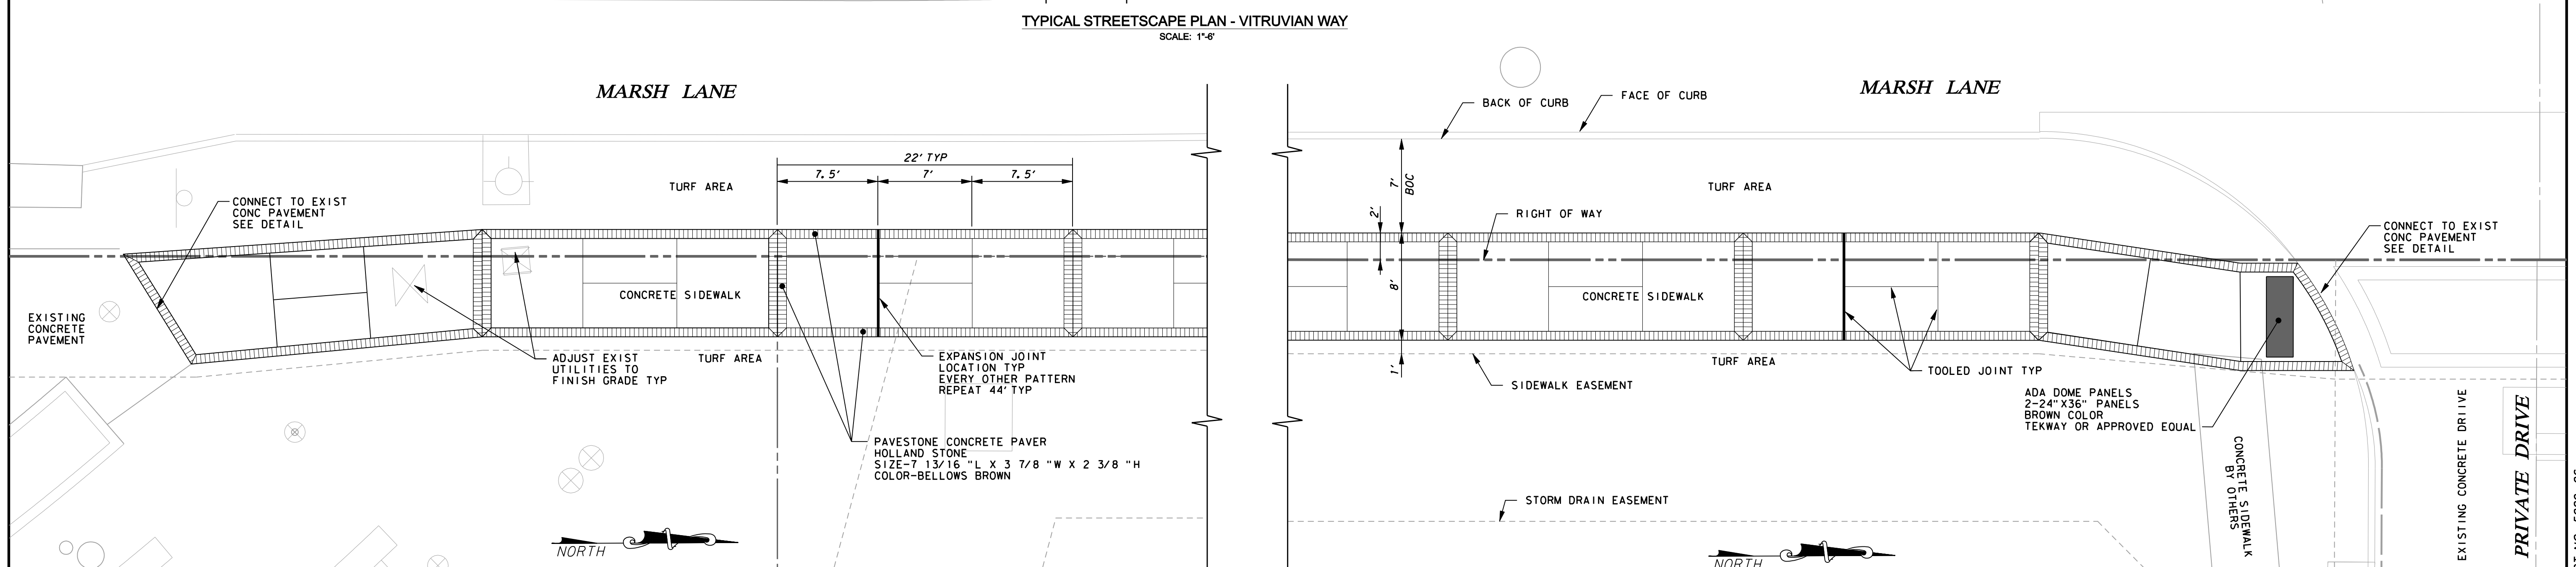

TYPICAL STREETSCAPE PLAN - MARSH LANE
SCALE: 1"=6"

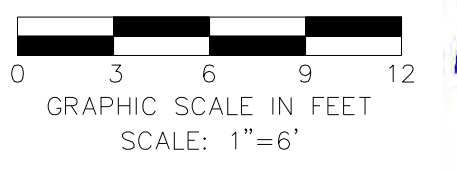

NO.	REVISION	BY	DATE

icon Consulting Engineers, Inc. 2840 W. Southlake Blvd., Suite 110
Civil Engineers - Designers - Planners Southlake, Tx 76092 (817) 552-6210
Engineering Firm Registration Number F-9007

VW2 STREETSCAPE IMPROVEMENTS
VP PUBLIC INFRASTRUCTURE - PHASE 5, BLOCK 200B
TOWN OF ADDISON, TEXAS

DESIGN	DRAWN	DATE	SCALE	NOTES	Sheet No.
ICE	ICE	NOV 17, 2020	AS NOTED		9

VW2 STREETSCAPE - VP PUBLIC INFRASTRUCTURE - PHASE 5, BLOCK 200B - PROJECT NO. 5029-06