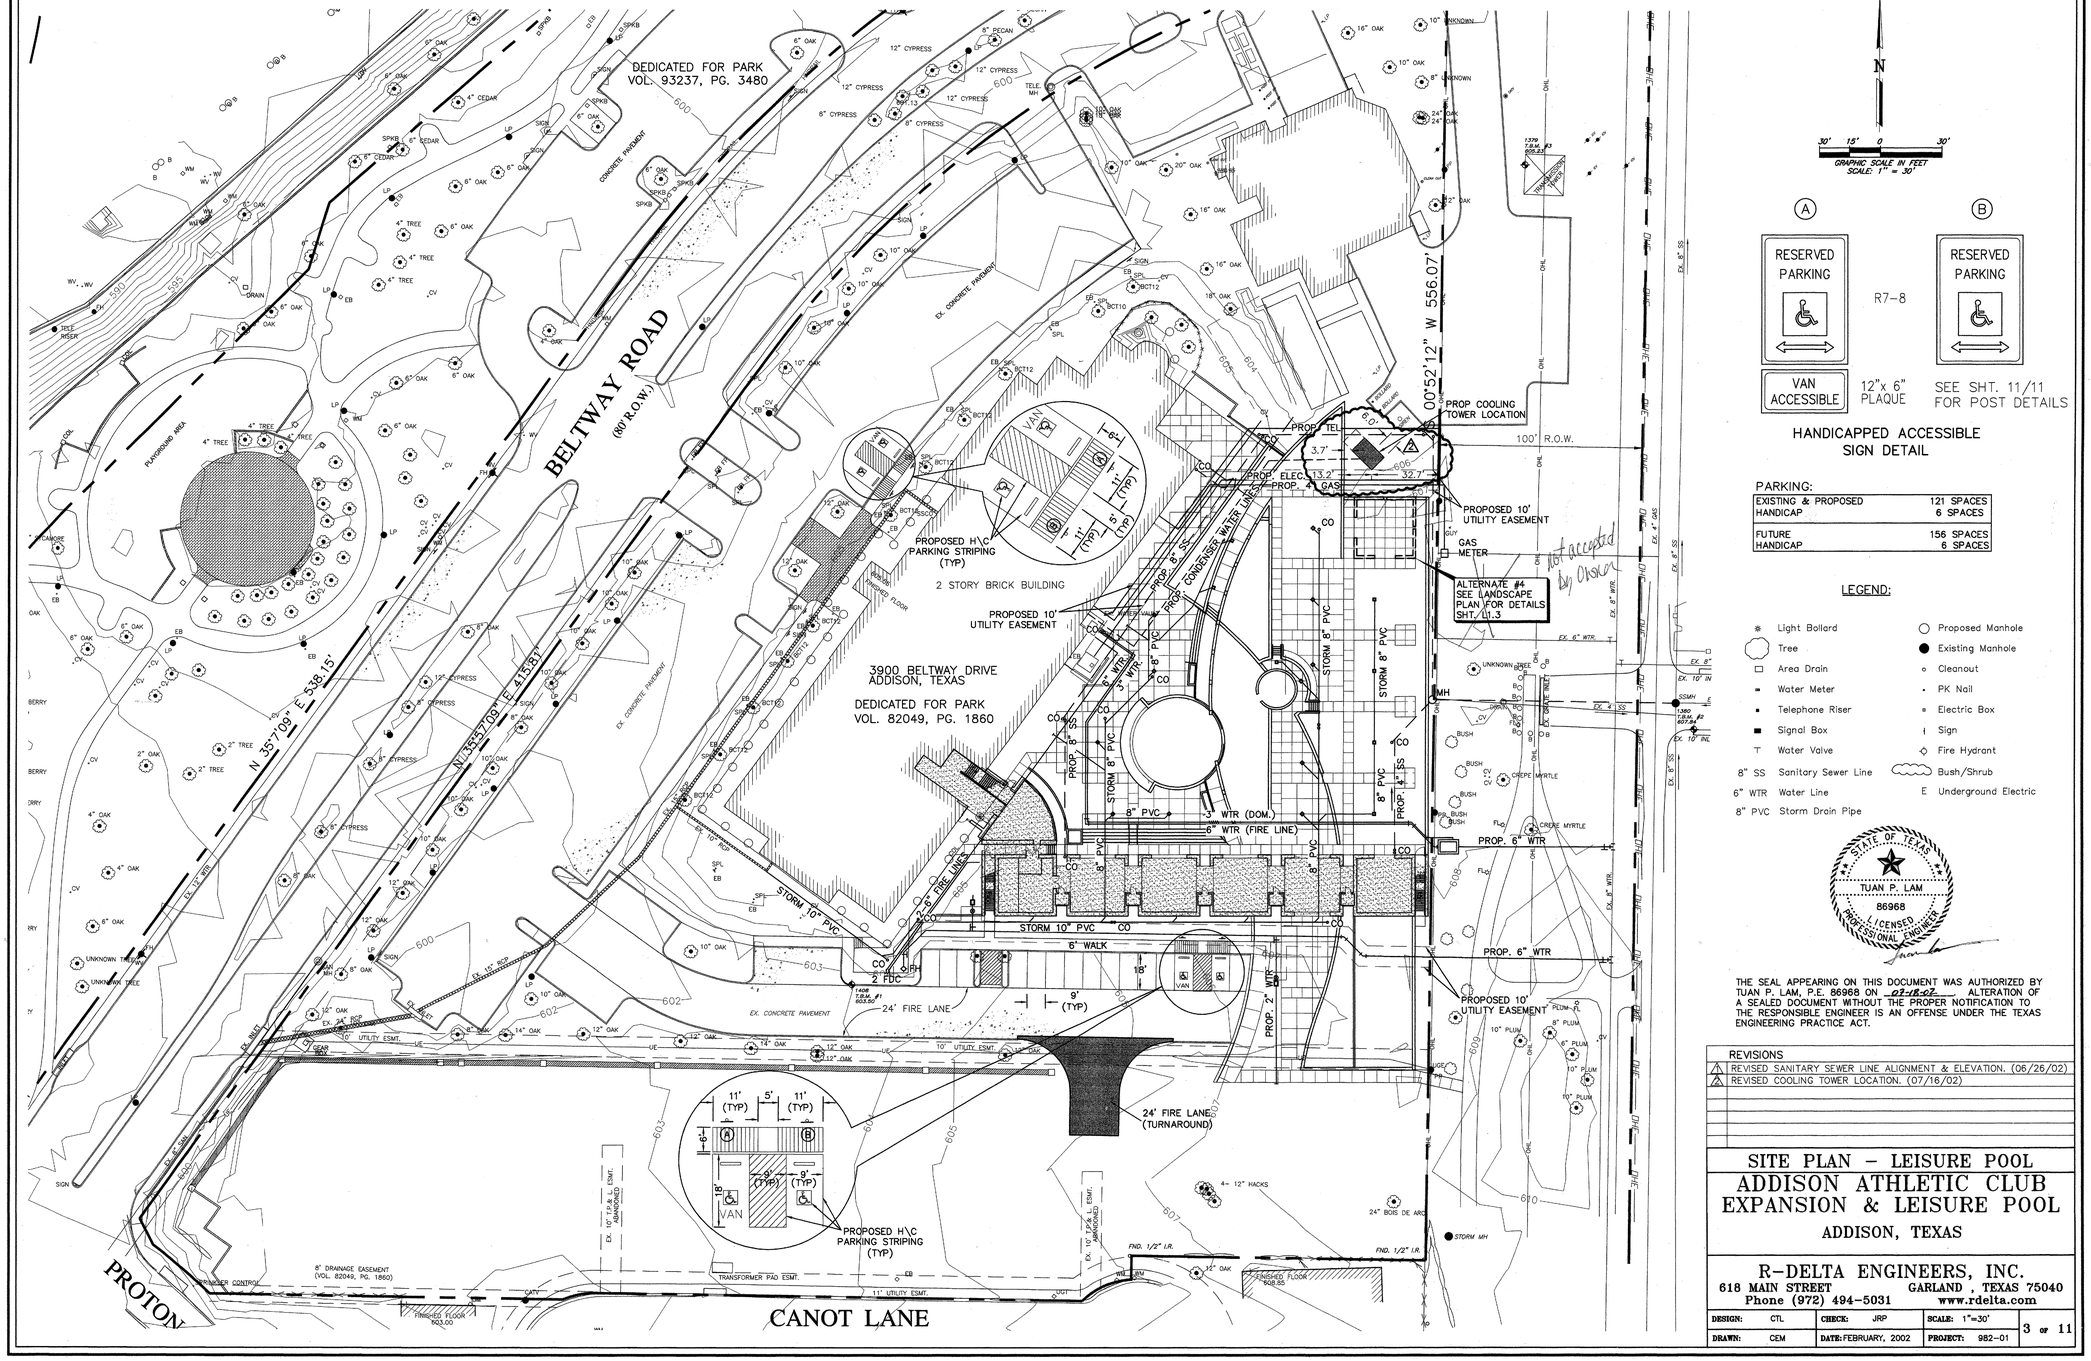

PARKING:

EXISTING & PROPOSED	121 SPACES
HANDICAP	6 SPACES
FUTURE	156 SPACES
HANDICAP	6 SPACES

LEGEND:

✱	Light Bollard	○	Proposed Manhole
⬡	Tree	●	Existing Manhole
□	Area Drain	○	Cleanout
▬	Water Meter	•	PK Nail
▪	Telephone Riser	▫	Electric Box
■	Signal Box	▮	Sign
T	Water Valve	◇	Fire Hydrant
8" SS	Sanitary Sewer Line	⬭	Bush/Shrub
6" WTR	Water Line	E	Underground Electric
8" PVC	Storm Drain Pipe		

THE SEAL APPEARING ON THIS DOCUMENT WAS AUTHORIZED BY TUAN P. LAM, P.E. 86968 ON 02-18-02 ALTERATION OF A SEALED DOCUMENT WITHOUT THE PROPER NOTIFICATION TO THE RESPONSIBLE ENGINEER IS AN OFFENSE UNDER THE TEXAS ENGINEERING PRACTICE ACT.

REVISIONS
- ⚠1 REVISED SANITARY SEWER LINE ALIGNMENT & ELEVATION. (06/26/02)
- ⚠2 REVISED COOLING TOWER LOCATION. (07/16/02)

SITE PLAN – LEISURE POOL
ADDISON ATHLETIC CLUB EXPANSION & LEISURE POOL
ADDISON, TEXAS

R-DELTA ENGINEERS, INC.
618 MAIN STREET GARLAND, TEXAS 75040
Phone (972) 494-5031 www.rdelta.com

DESIGN: CTL	CHECK: JRP	SCALE: 1"=30'	3 OF 11
DRAWN: CEM	DATE: FEBRUARY, 2002	PROJECT: 982-01	

ISSUE DATE
FEB. 20, 2002

REVISIONS

ADDISON ATHLETIC CLUB EXPANSION AND LEISURE POOL
ADDISON, TEXAS

RON HOBBS ARCHITECTS
614 W. MAIN ST. SUITE #200 GARLAND, TEXAS 75040
(972) 494-0174 FAX (972) 494-0722

JOB NUMBER
0012

SHEET NAME
SITE PLAN
LEISURE POOL

SHEET NUMBER
C103