


A ALTERNATE No. 1 HARDSCAPE PLAN
SCALE: 1"=20'-0"

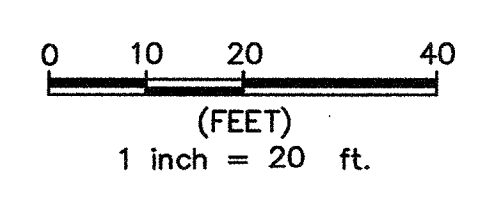

ALTERNATE No. 5 SITE FURNISHINGS LEGEND


KEY	KEY	DESCRIPTION & MODEL NO.	MANUFACTURER
TYPE A	2	BENCH Model #: P3260 WABASH VALLEY Prestige Series 6" bench w/arms, weave pattern, in ground mount.	WABASH VALLEY MANUFACTURING, INC REP. THE PLAYWELL GROUP, CONTACT LISA WOOLSEY (972-498-9355)
TYPE B	1	TRASH RECEPTACLE Model #: LRW22 WABASH VALLEY, weave pattern, RFL22 black liner, flat black 22 gal lid, 10056 black in ground post.	WABASH VALLEY MANUFACTURING, INC REP. THE PLAYWELL GROUP, CONTACT LISA WOOLSEY (972-498-9355)

NOTE: TO BE APPROVED BY OWNER BEFORE ORDERING



ADDISON ATHLETIC CLUB - ORNAMENTAL FENCE LAYOUT ELEVATIONS

WEST-EAST	FINISH GROUND ELEVATION	TOP ELEVATION @ COLUMN
1st column	901.00	907.00
2nd column	901.00	907.00
3rd column	901.00	907.00
4th column	901.00	907.00
5th column	902.32	908.32
6th column	902.32	908.32
7th column	903.58	909.58
8th column	903.58	909.58
9th column	904.15	910.15
10th column	904.45	910.45
11th column	905.05	911.05
12th column	905.85	911.85
13th column	906.79	912.79
14th column	907.25	913.25



EXISTING GRADE TO BE RE-GRADED INTO A CONSTANT SLOPE TO ACCOMMODATE FENCE POST AND FOOTINGS (SEE SAMPLE LAYOUT)

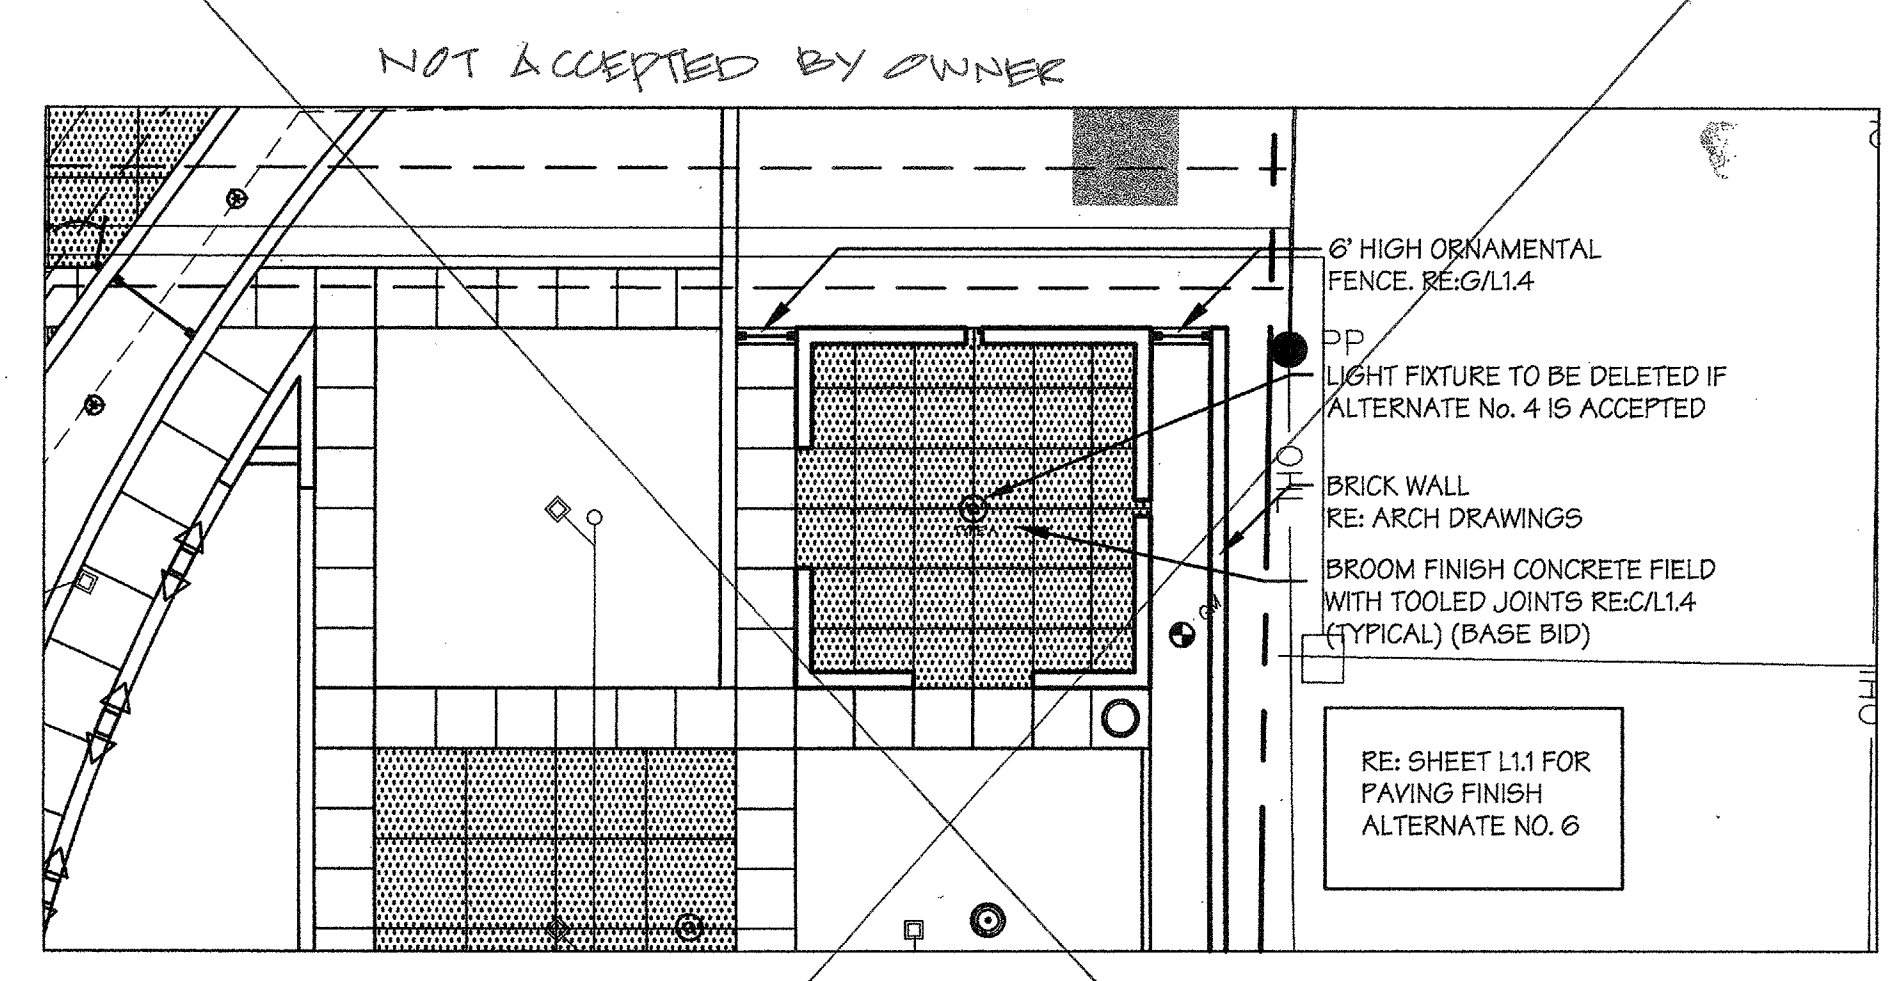

C ALTERNATE No. 4 HARDSCAPE PLAN
SCALE: 1"=16'-0"

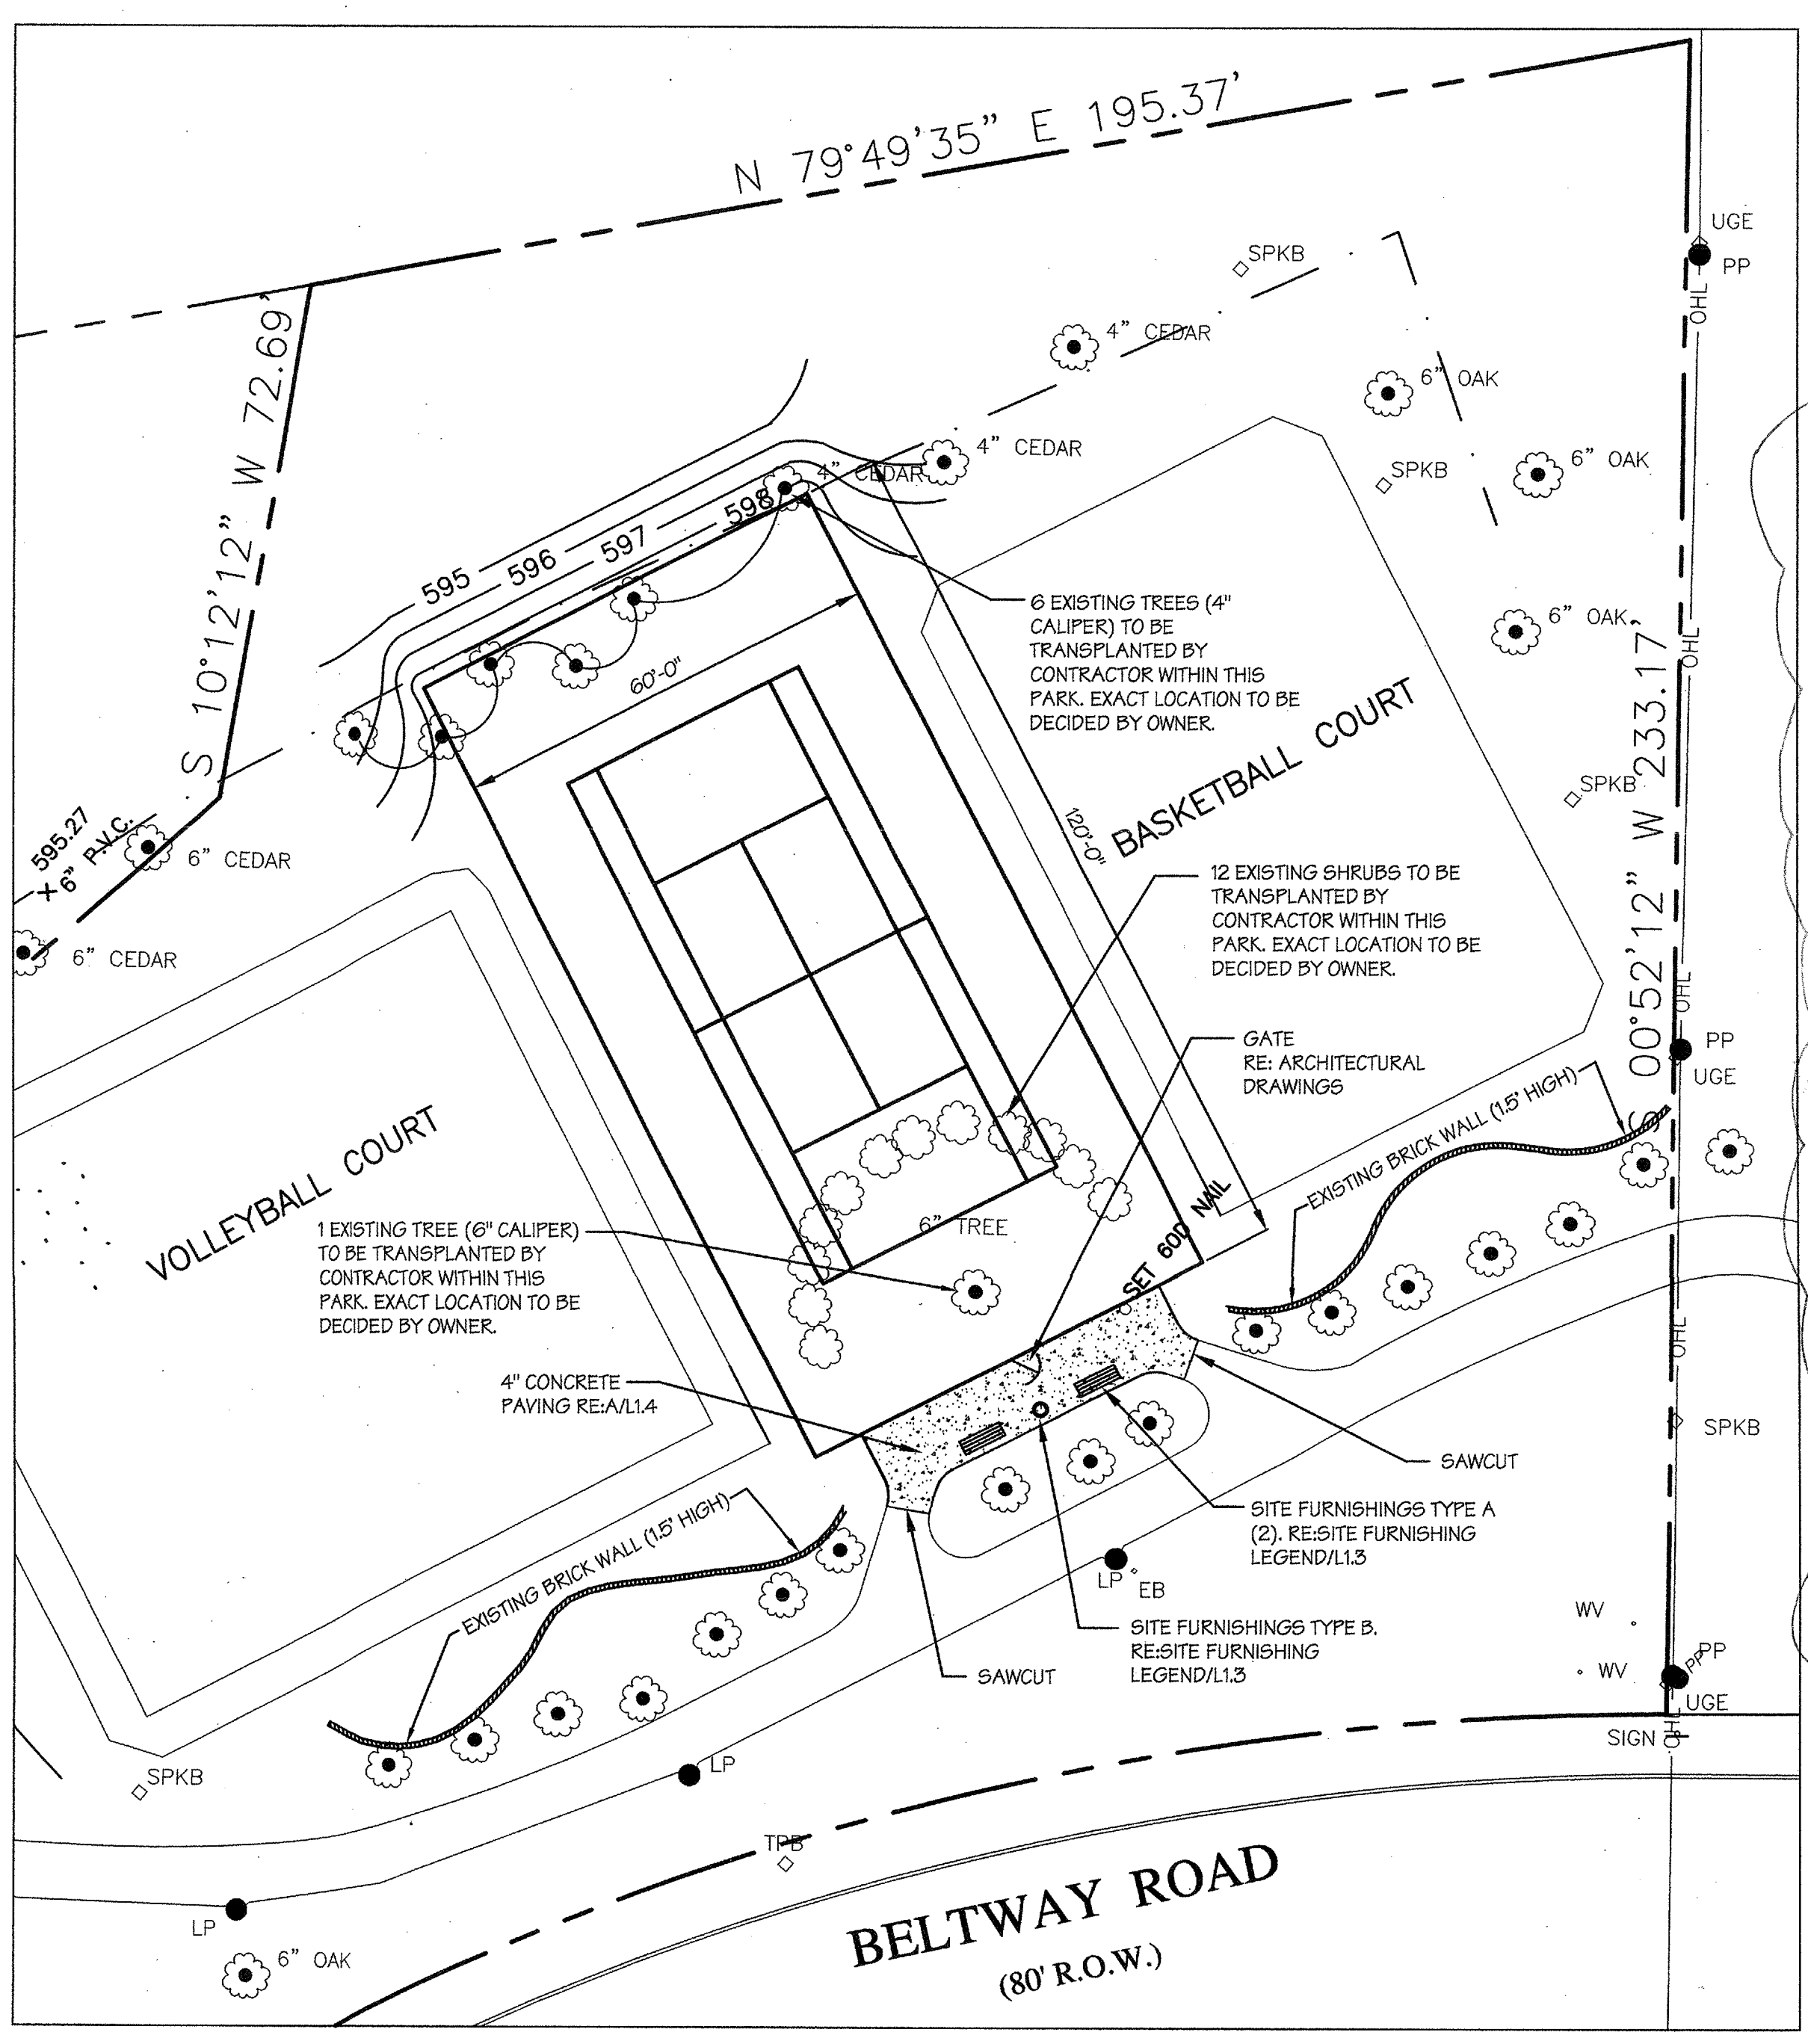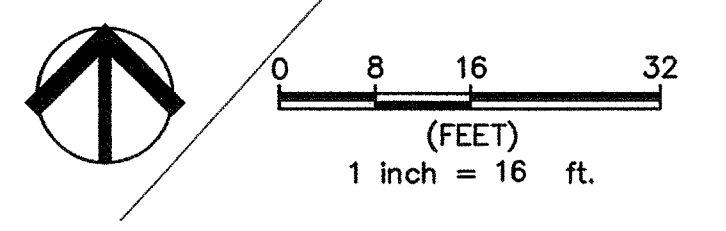


B ALTERNATE No. 5 HARDSCAPE PLAN
SCALE: 1"=20'-0"

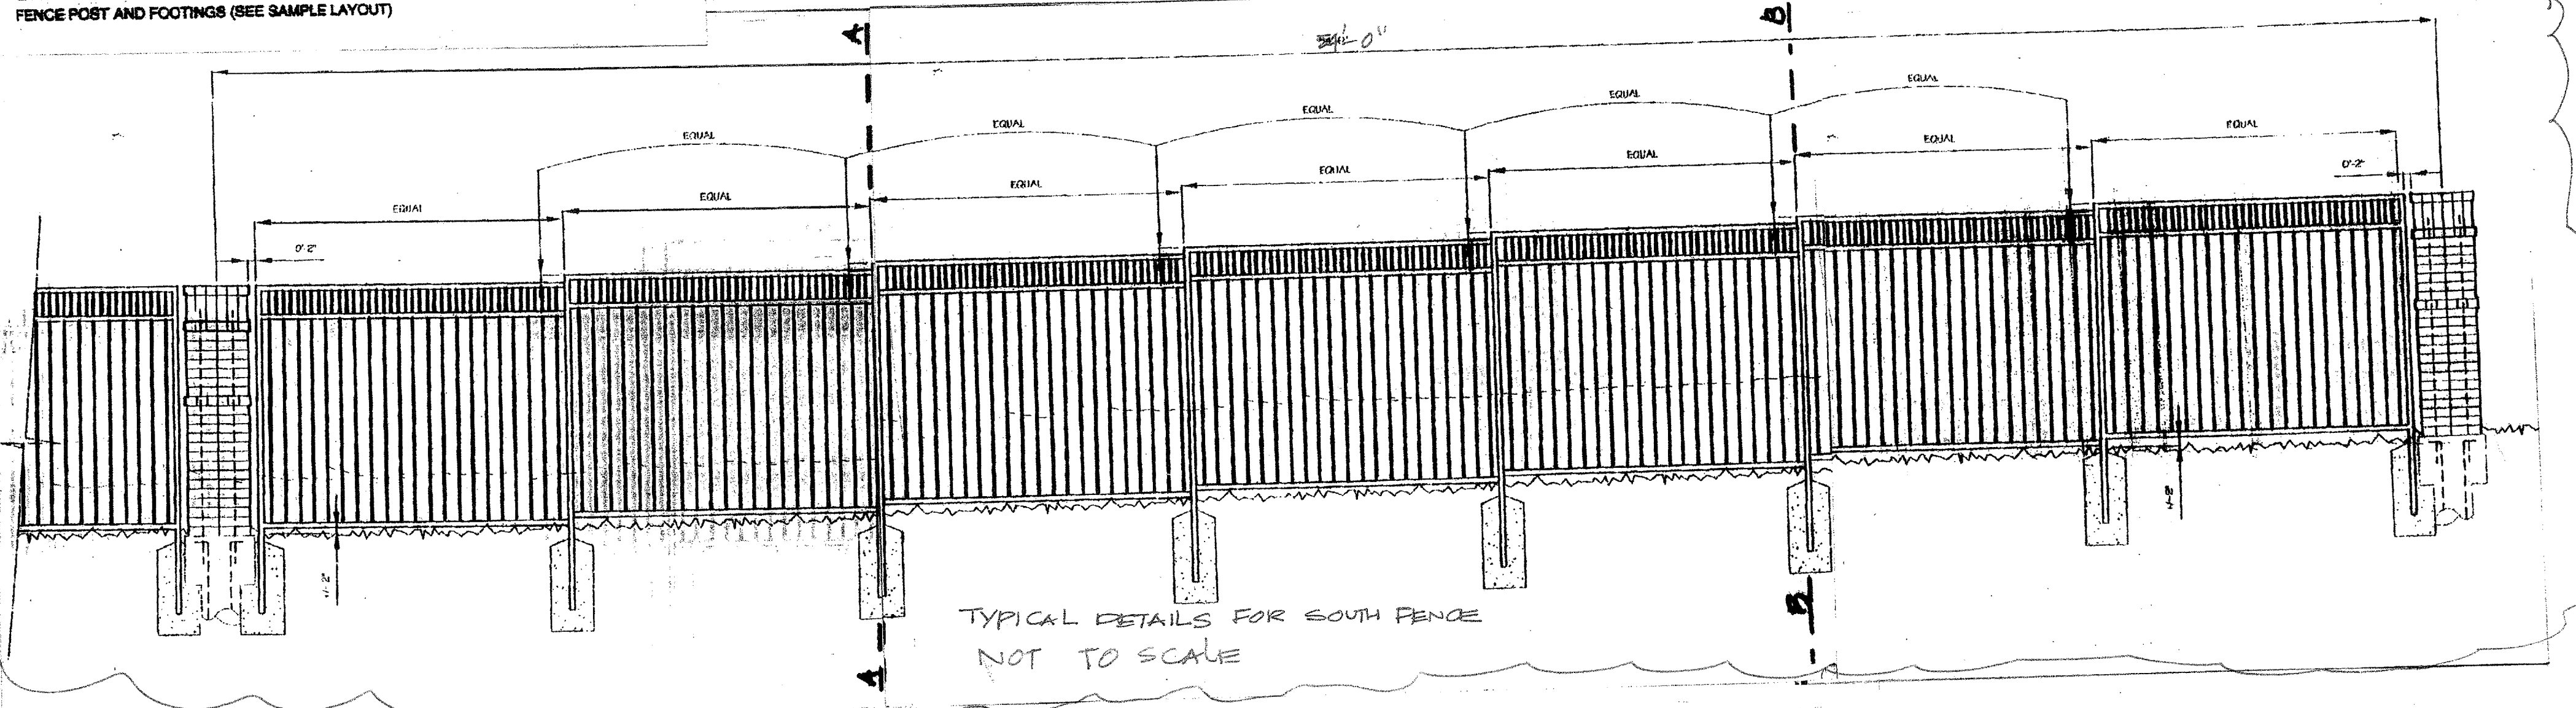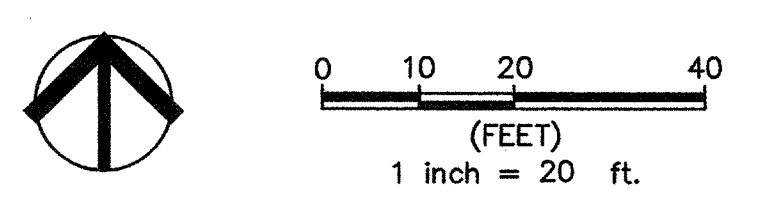

ADDISON ATHLETIC CLUB EXPANSION
AND
LEISURE POOL
ADDISON, TEXAS

RON HOBBS ARCHITECTS
614 W. MAIN ST. SUITE #200 GARLAND, TEXAS 75040
(972) 494-0722
FAX (972) 494-0174

DAVID C. BALDWIN
INCORPORATED
LANDSCAPE ARCHITECTS & PLANNING
5544 BURNING WOOD DRIVE
DALLAS, TEXAS 75236
TEL: 214-652-6100
FAX: 214-652-6562

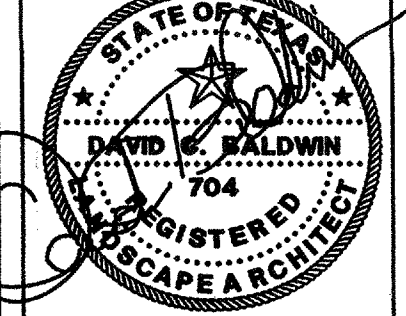

JOB NUMBER
ALTERNATES HARDSCAPE PLAN 0012

SHEET NUMBER
L1.3