


REVISIONS

NO.	DESCRIPTION


**ADDISON ATHLETIC CLUB EXPANSION
AND
LEISURE POOL**
ADDISON, TEXAS

RON HOBBS ARCHITECTS
64 W. MAIN ST. SUITE #300 GARLAND, TEXAS 75040
972-4940174 FAX 972-4940172

 

JOB NUMBER
0012

SHEET NAME
DIMENSION
SITE PLAN
SHEET NUMBER
ASP1

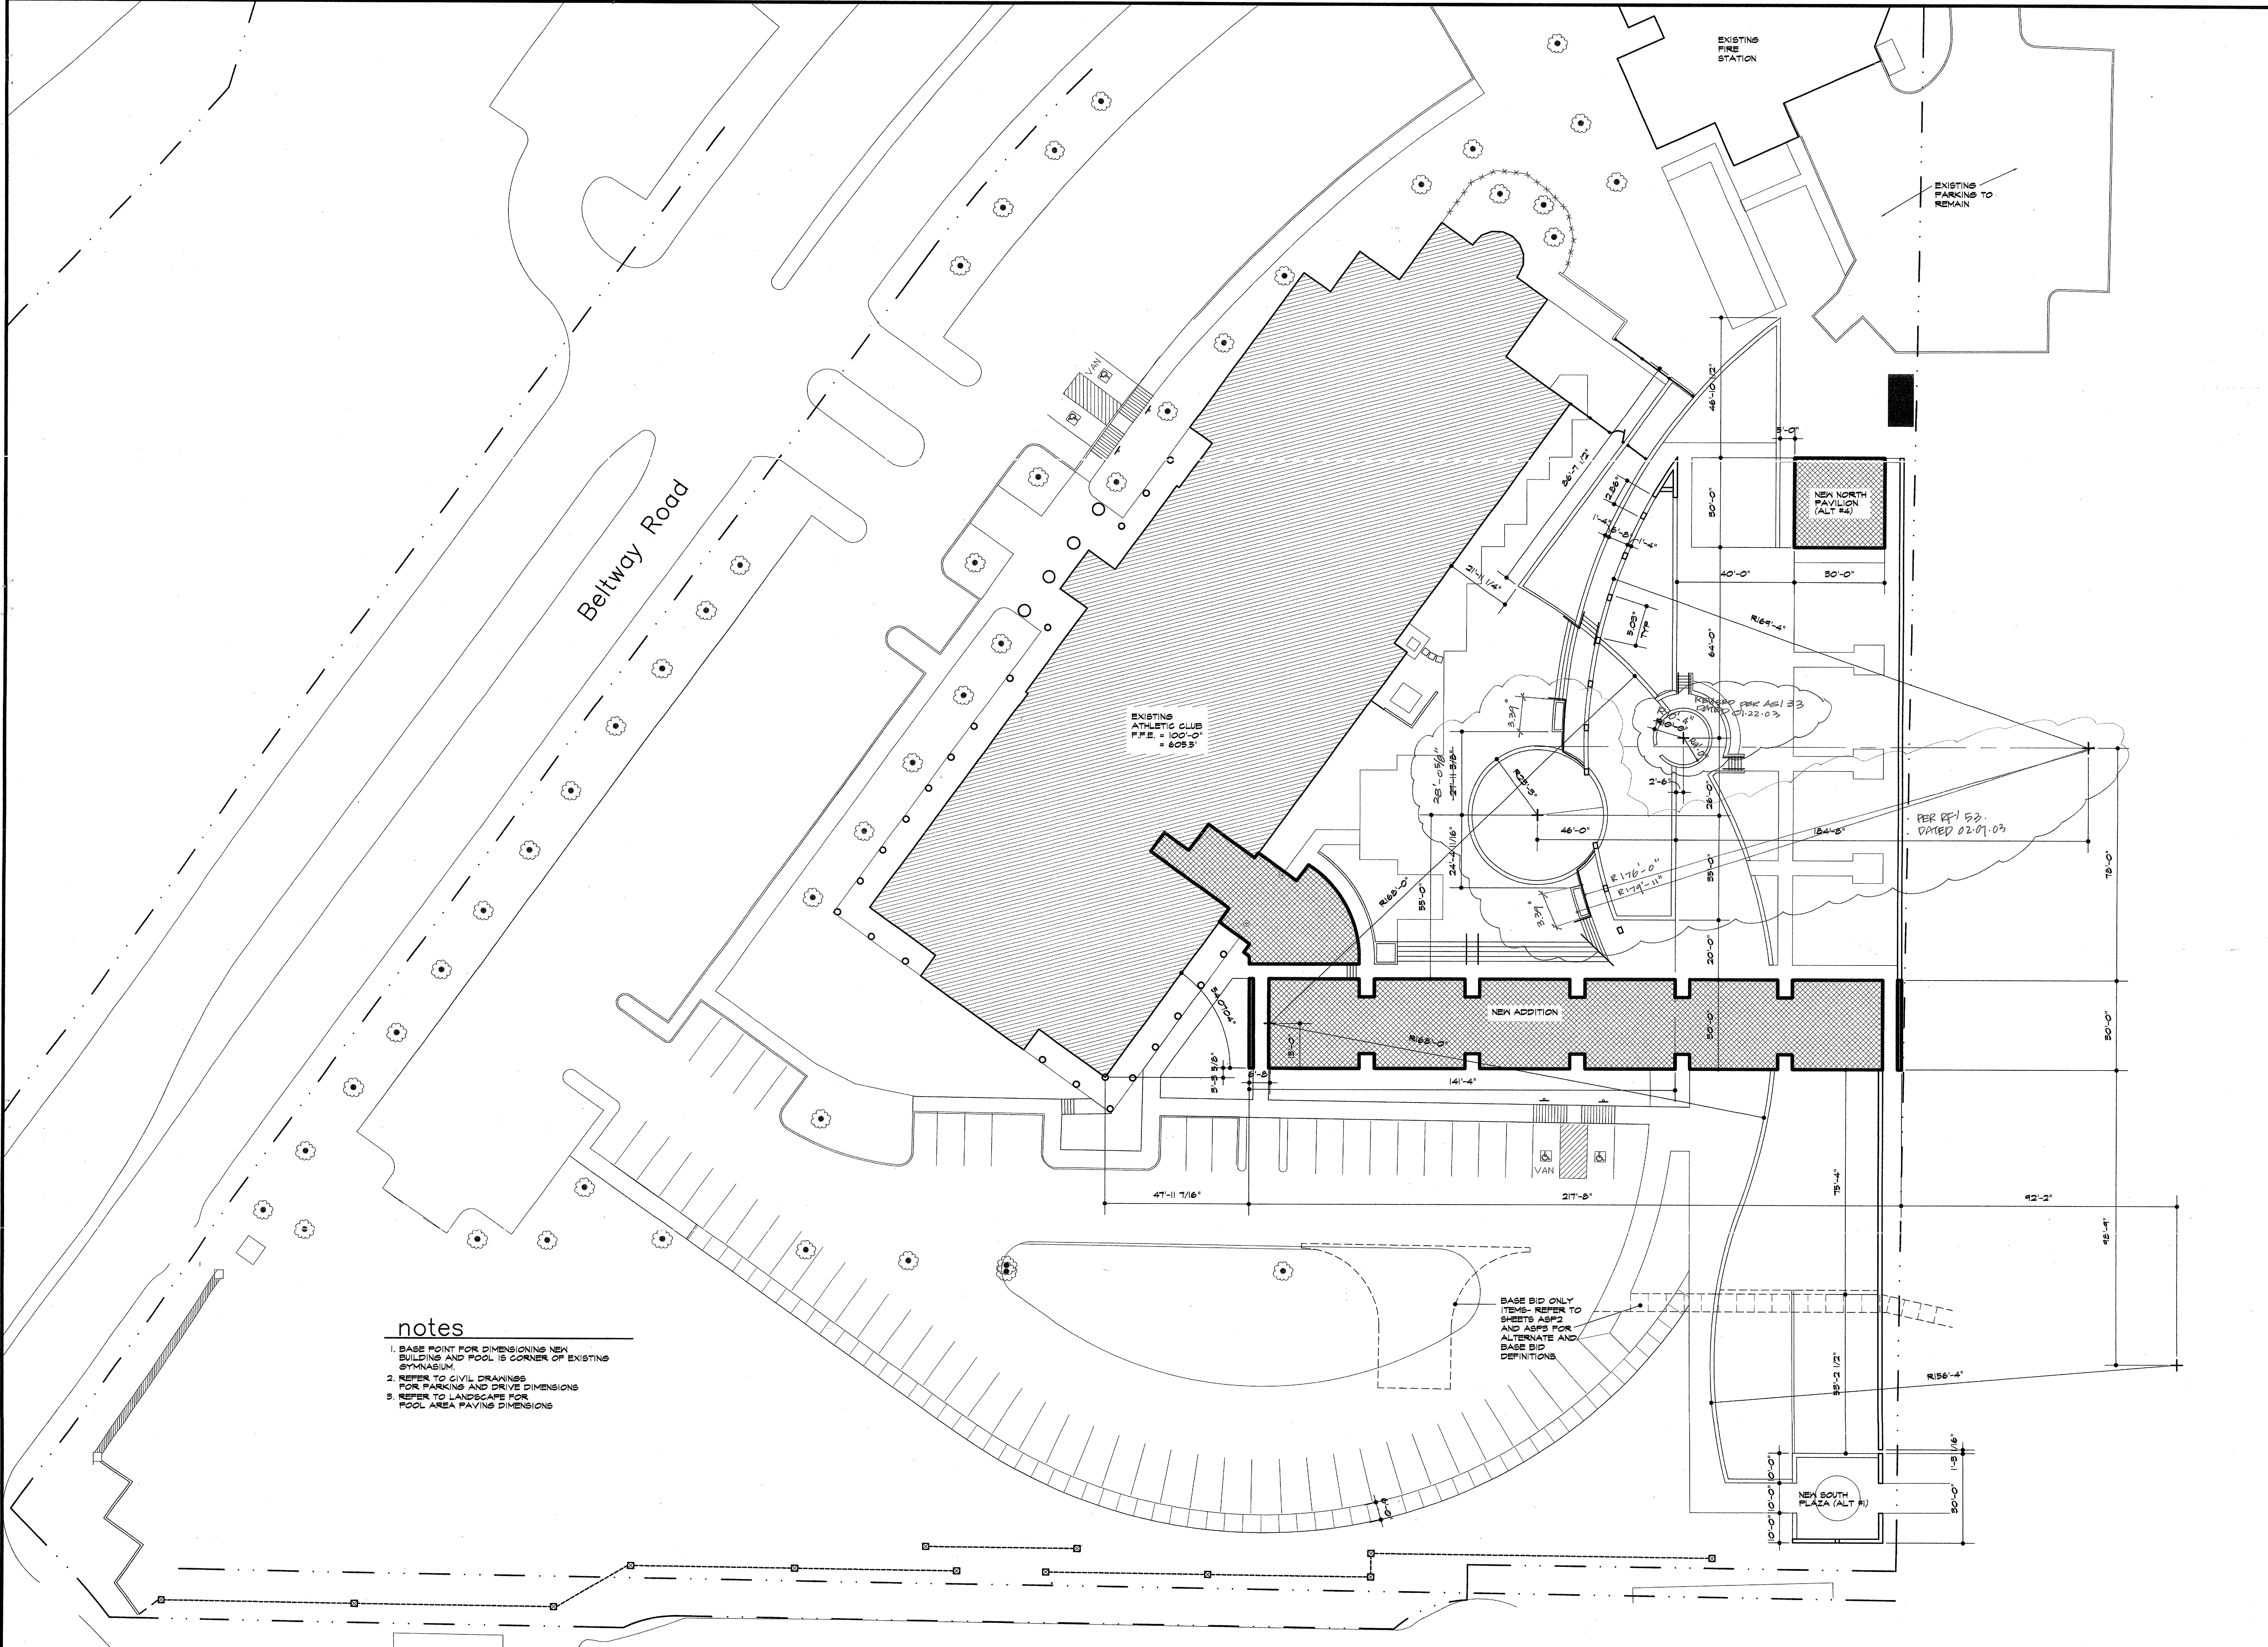

notes

1. BASE POINT FOR DIMENSIONING NEW BUILDING AND POOL IS CORNER OF EXISTING GYMNASIUM.
2. REFER TO CIVIL DRAWINGS FOR PARKING AND DRIVE DIMENSIONS
3. REFER TO LANDSCAPE FOR POOL AREA PAVING DIMENSIONS

BASE BID ONLY
ITEMS- REFER TO
SHEETS ASP2
AND ASP3 FOR
ALTERNATE AND
BASE BID
DEFINITIONS

1 dimension site plan
1"=20'-0"