2 section

1/29/03
RON HOBBS
ARCHITECTS

PER RFI 53, DATED 01-29-03

3 section

1/29/03
RON HOBBS
ARCHITECTS

4 section

1/29/03
RON HOBBS
ARCHITECTS

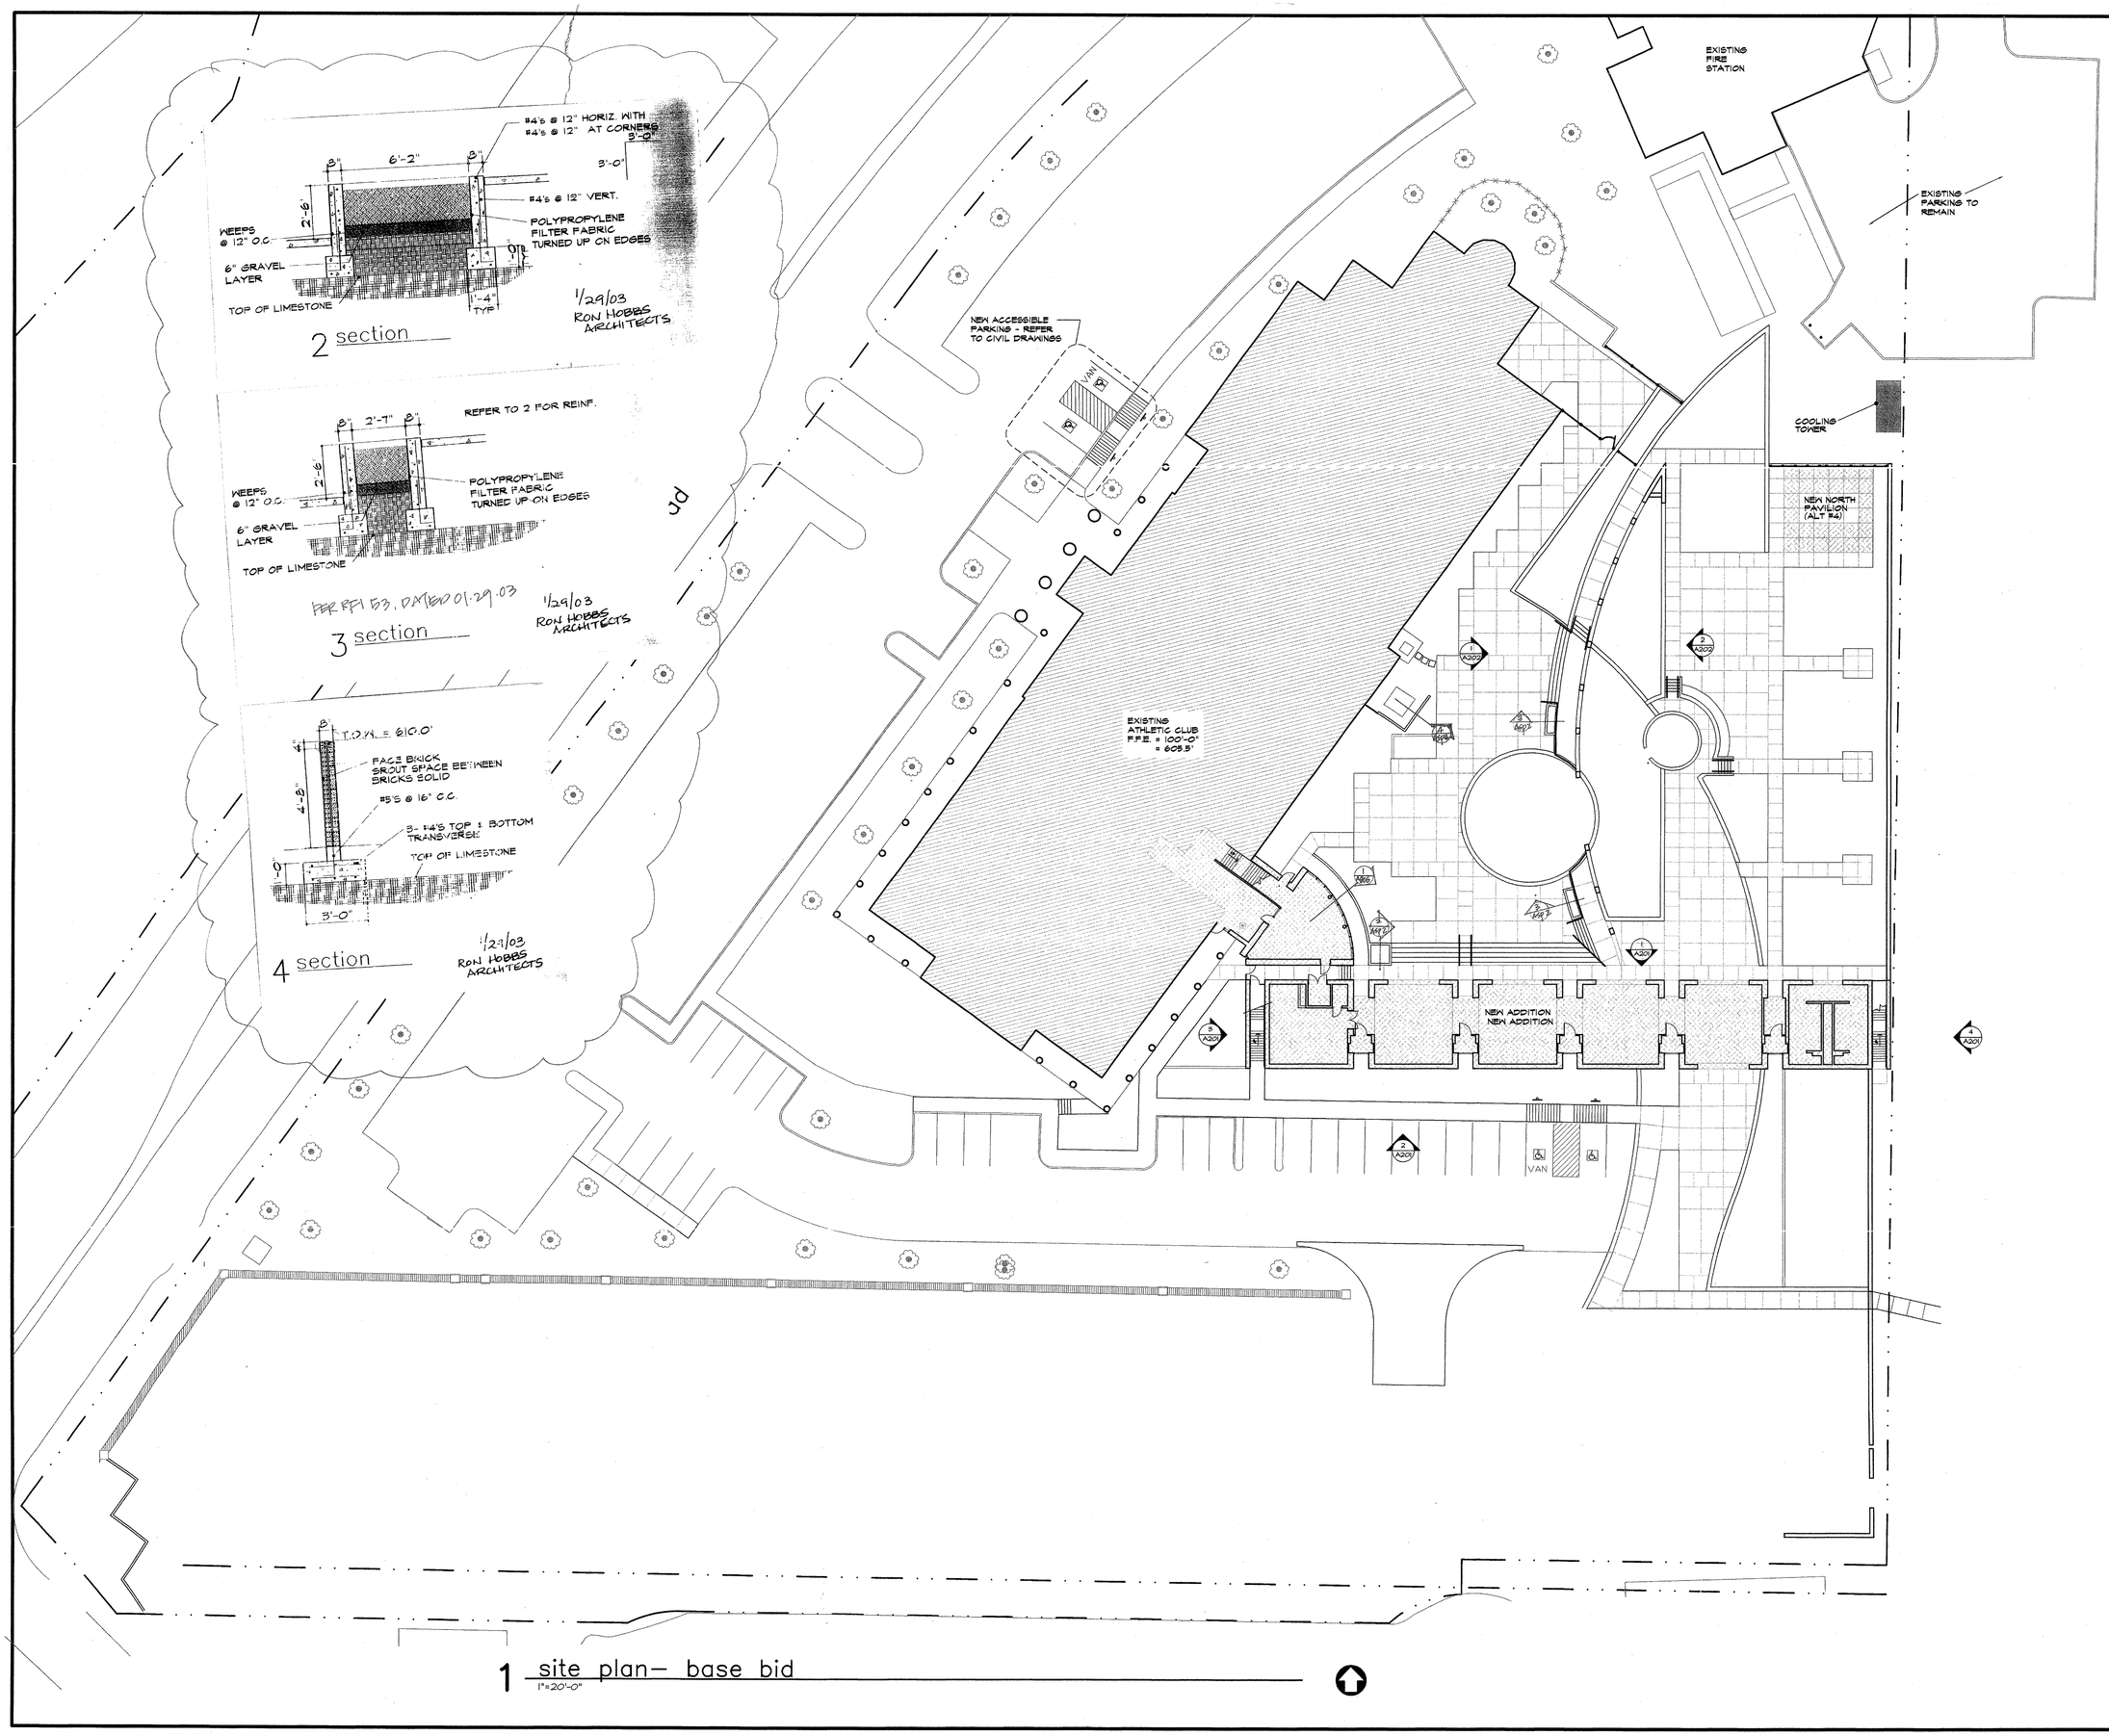

1 site plan— base bid
1"=20'-0"

ISSUE DATE
FEB. 20, 2002

REVISIONS

ADDISON ATHLETIC CLUB EXPANSION AND LEISURE POOL
ADDISON, TEXAS

RON HOBBS ARCHITECTS
614 W. MAIN ST. SUITE #200 GARLAND, TEXAS 75040
(972) 494-0174 FAX (972) 494-0722

JOB NUMBER
0012

SHEET NAME
BASE BID
SITE PLAN

SHEET NUMBER
ASP2