


bath & access. legend

- (A) TOILET PAPER DISPENSER
- (B) GRAB BAR
- (C) FRAMED MIRROR (STAINLESS STEEL)
- (D) FEMINE NAPKIN DISPOSAL
- (E) FRAMED MIRROR (GLASS)
- (F) TOWEL DISPENSER & WASTE RECEPTACLE
- (G) SOAP DISPENSER - WALL MOUNTED
- (H) UNFRAMED MIRROR
- (I) MOP & BROOM HOLDER
- (J) CHANGING TABLE
- (K) SHOWER ACCESSORIES
- (L) ELECTRIC HAND DRYER
- (X) FIRE EXTINGUISHER
- (Y) DEDICATION PLAQUE

wall legend

- [Pattern] CONCRETE
- [Pattern] CMU
- [Pattern] FACE BRICK
- [Pattern] GYP. BD. ON METAL STUDS
- [Pattern] EXISTING WALL

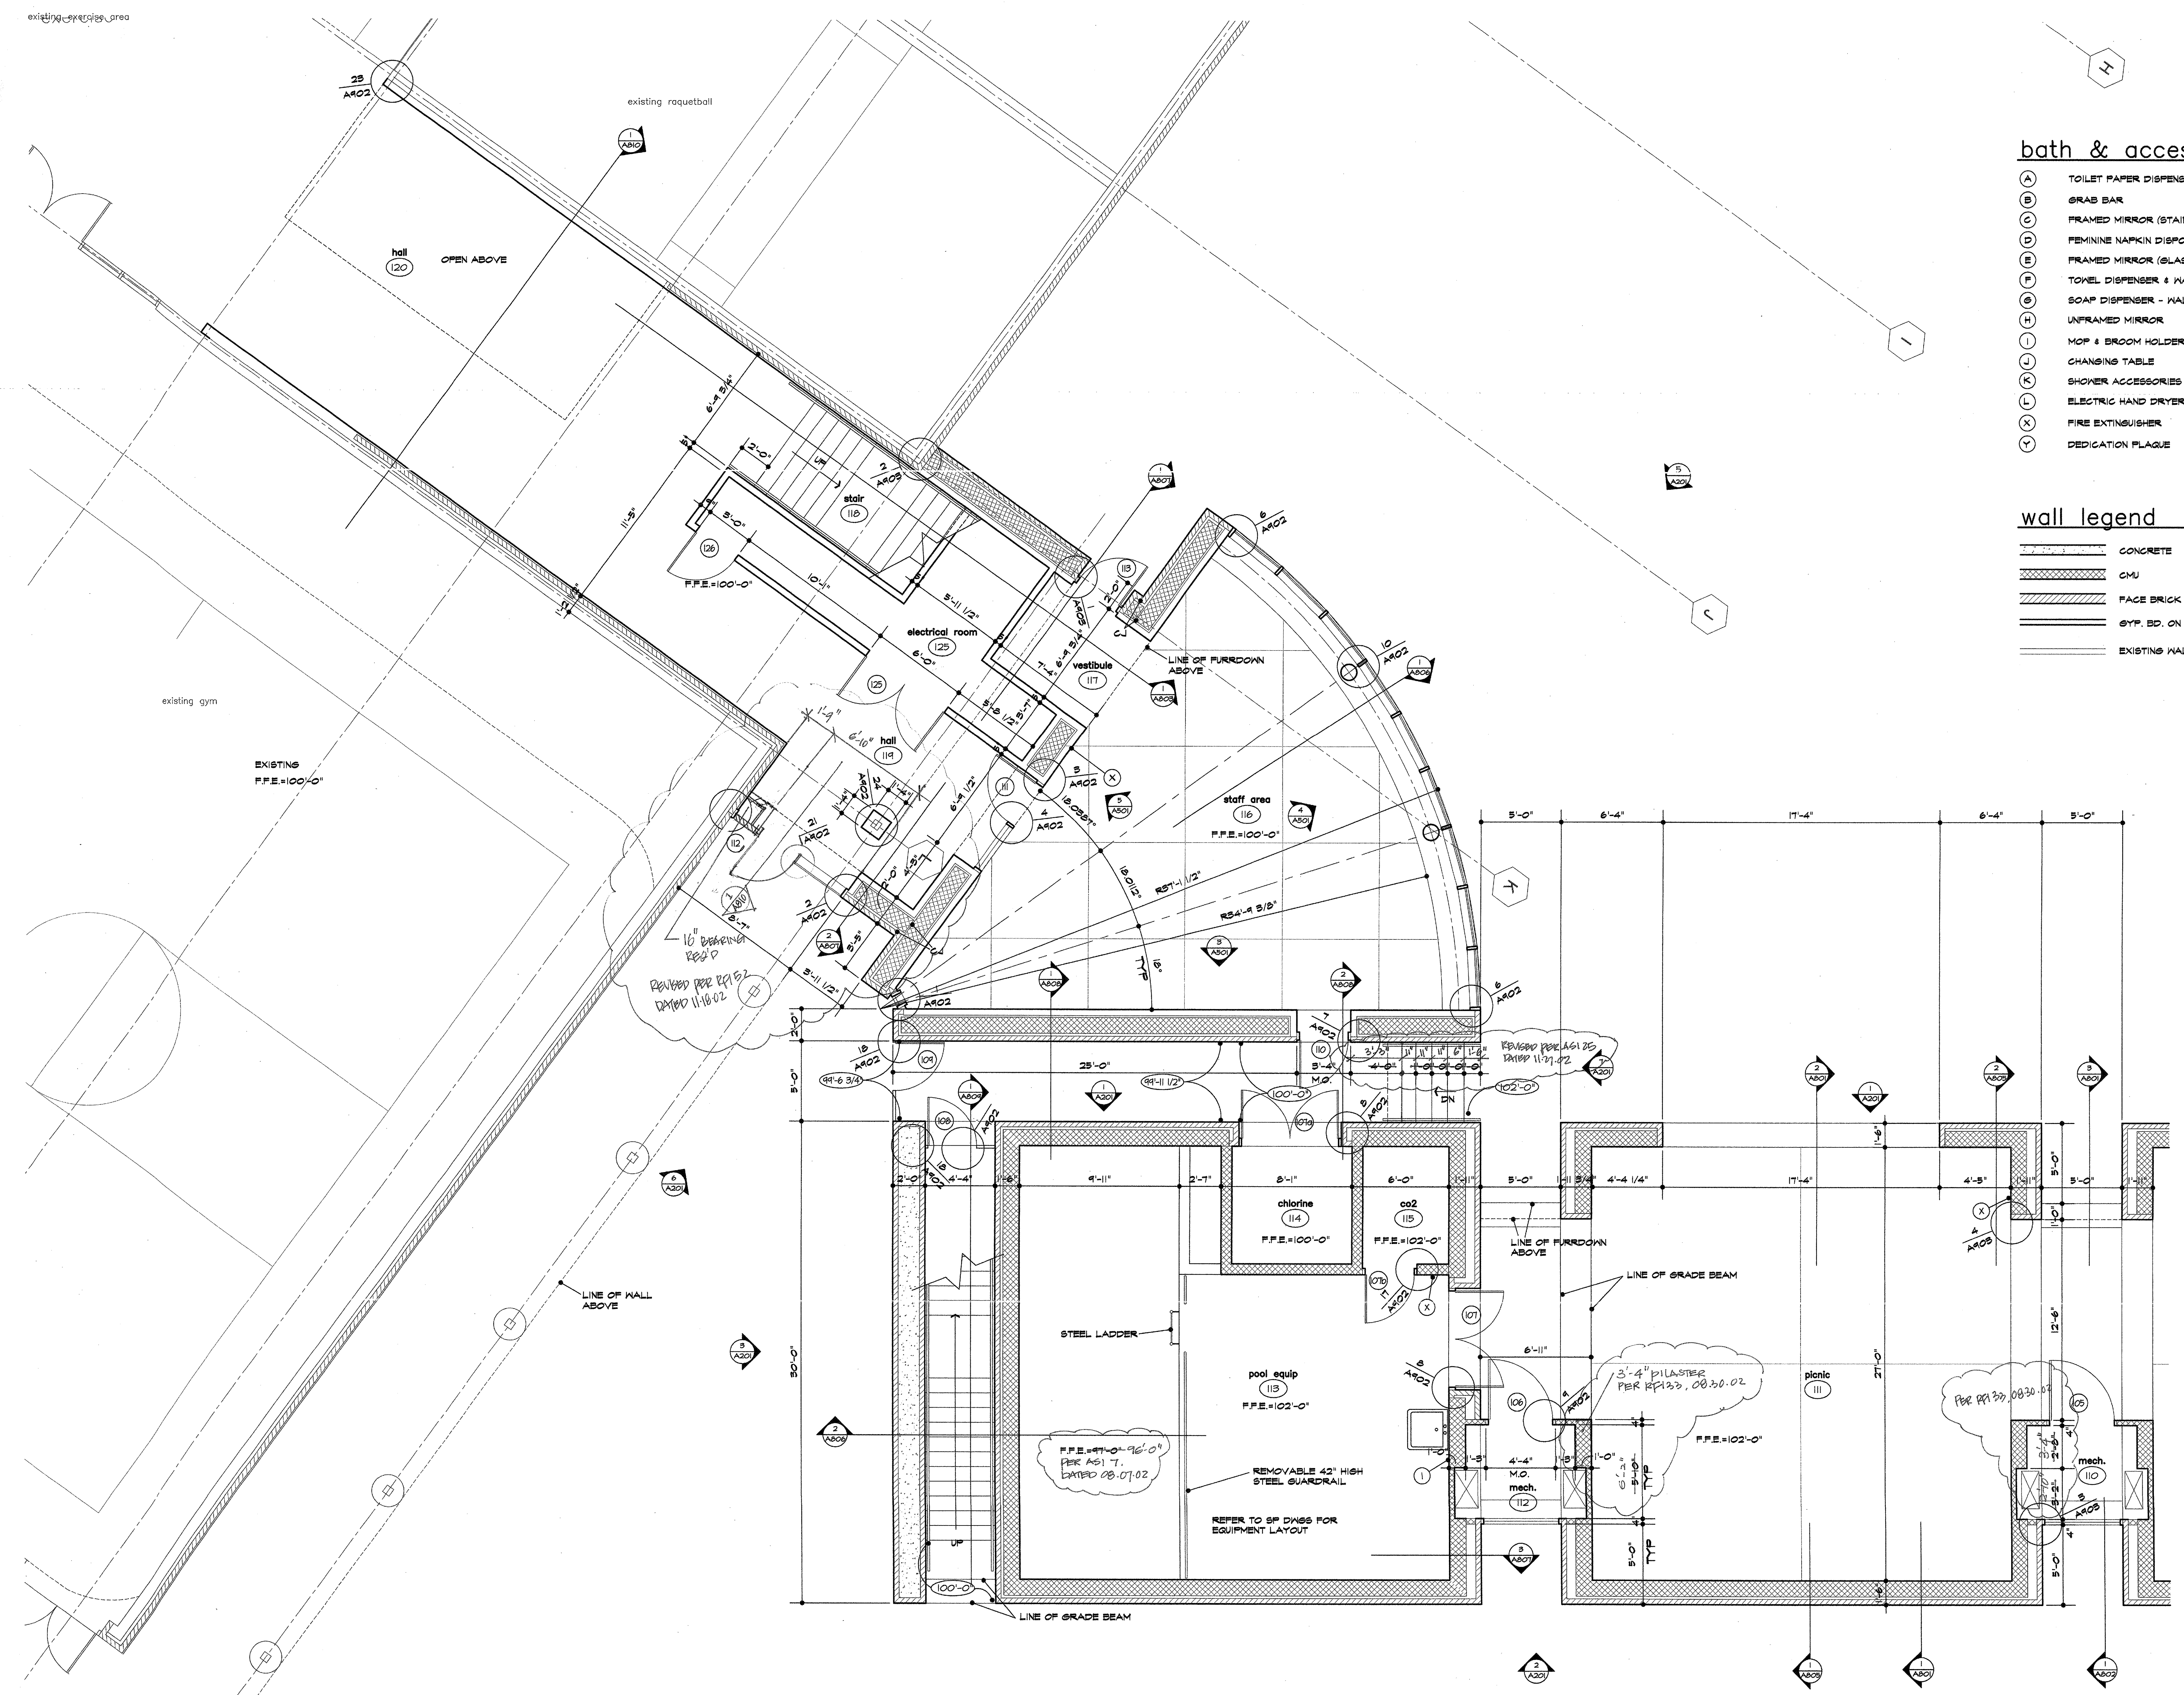

1 detail floor plan
 1/4"=1'-0"