


**8 south elev @ south plaza**  
1/8"=1'-0"

**9 elev @ south plaza**  
1/8"=1'-0"

**10 west elev @ south plaza**  
1/8"=1'-0"

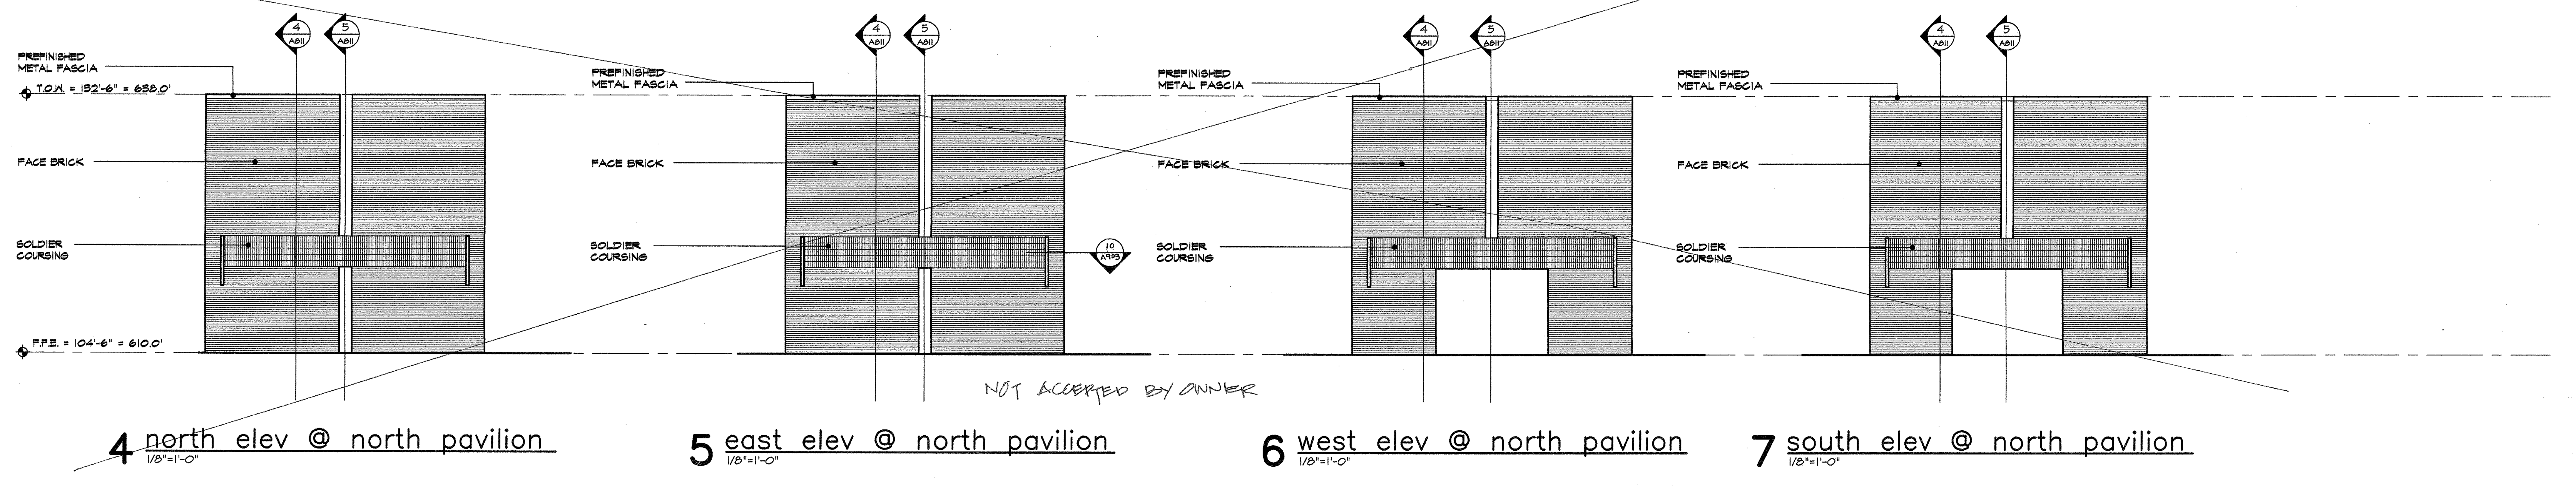


NOT ACCEPTED BY OWNER

**4 north elev @ north pavilion**  
1/8"=1'-0"

**5 east elev @ north pavilion**  
1/8"=1'-0"


**6 west elev @ north pavilion**  
1/8"=1'-0"

**7 south elev @ north pavilion**  
1/8"=1'-0"

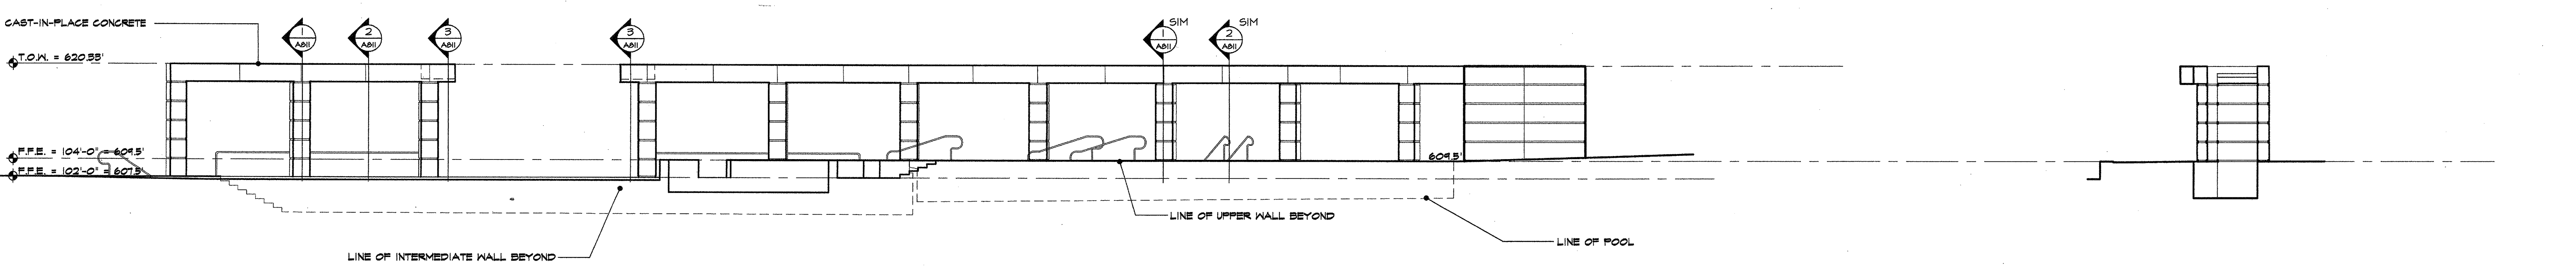


**2 aqueduct elevation**  
1/8"=1'-0"

**3 waterfall elevation**  
1/8"=1'-0"

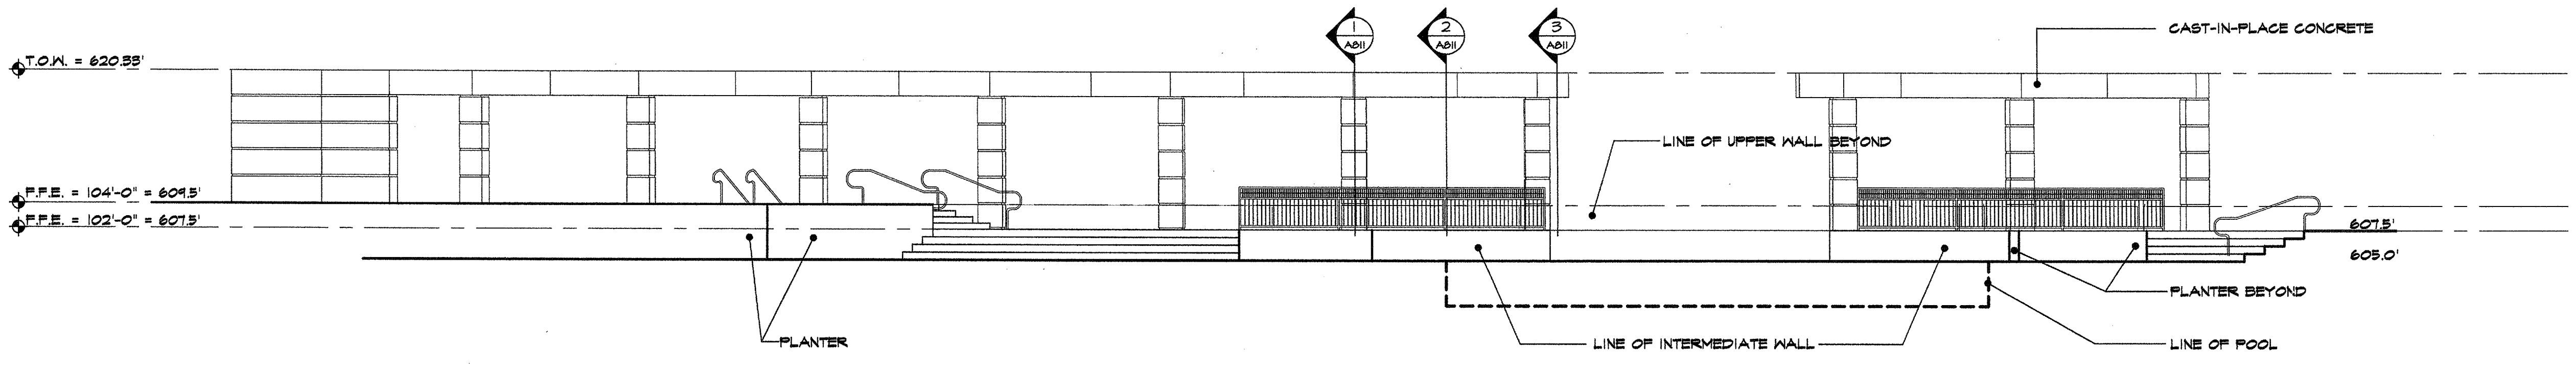

**1 aqueduct elevation**  
1/8"=1'-0"

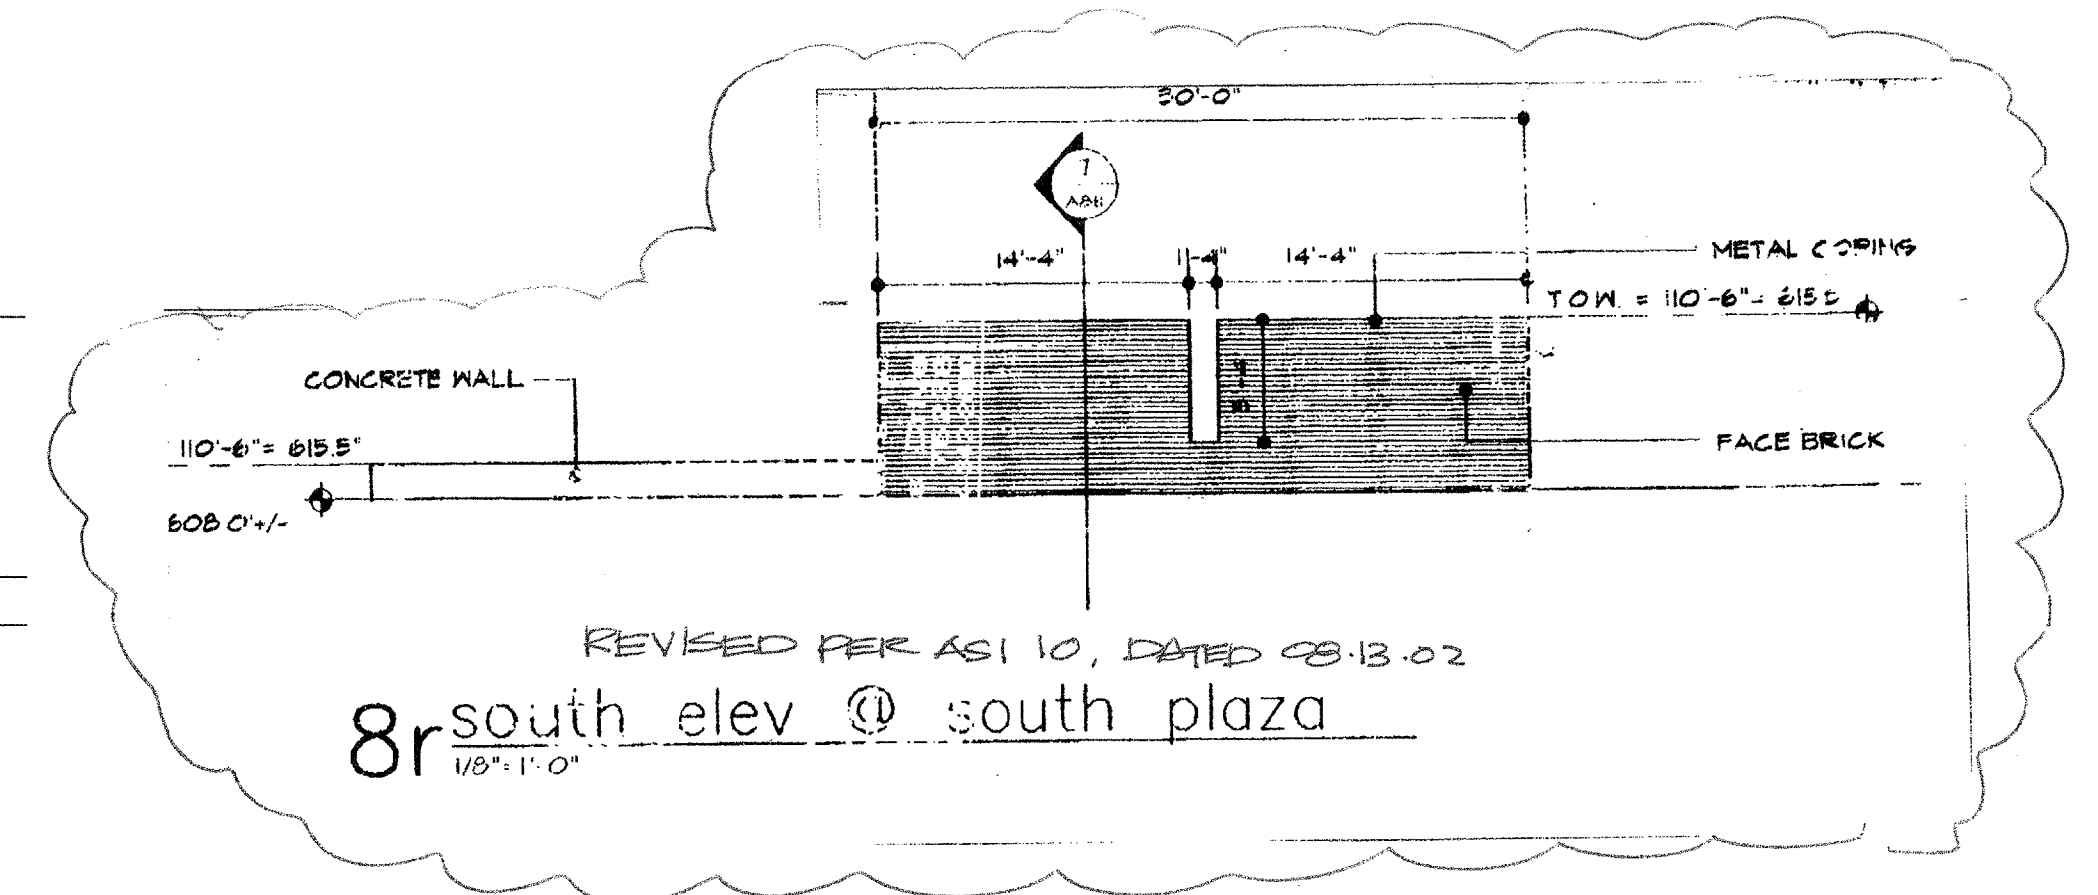

**8r south elev @ south plaza**  
1/8"=1'-0"