


ISSUE DATE	FEB. 20, 2002
REVISIONS	

ADDISON ATHLETIC CLUB EXPANSION  
AND  
LEISURE POOL  
ADDISON, TEXAS

RON HOBBS ARCHITECTS  
614 W. MAIN ST. SUITE #300 GARLAND, TEXAS 75040  
(972) 494-0174 FAX (972) 494-0722


 


JOB NUMBER


0012

SHEET NAME


SHEET NUMBER  
A301

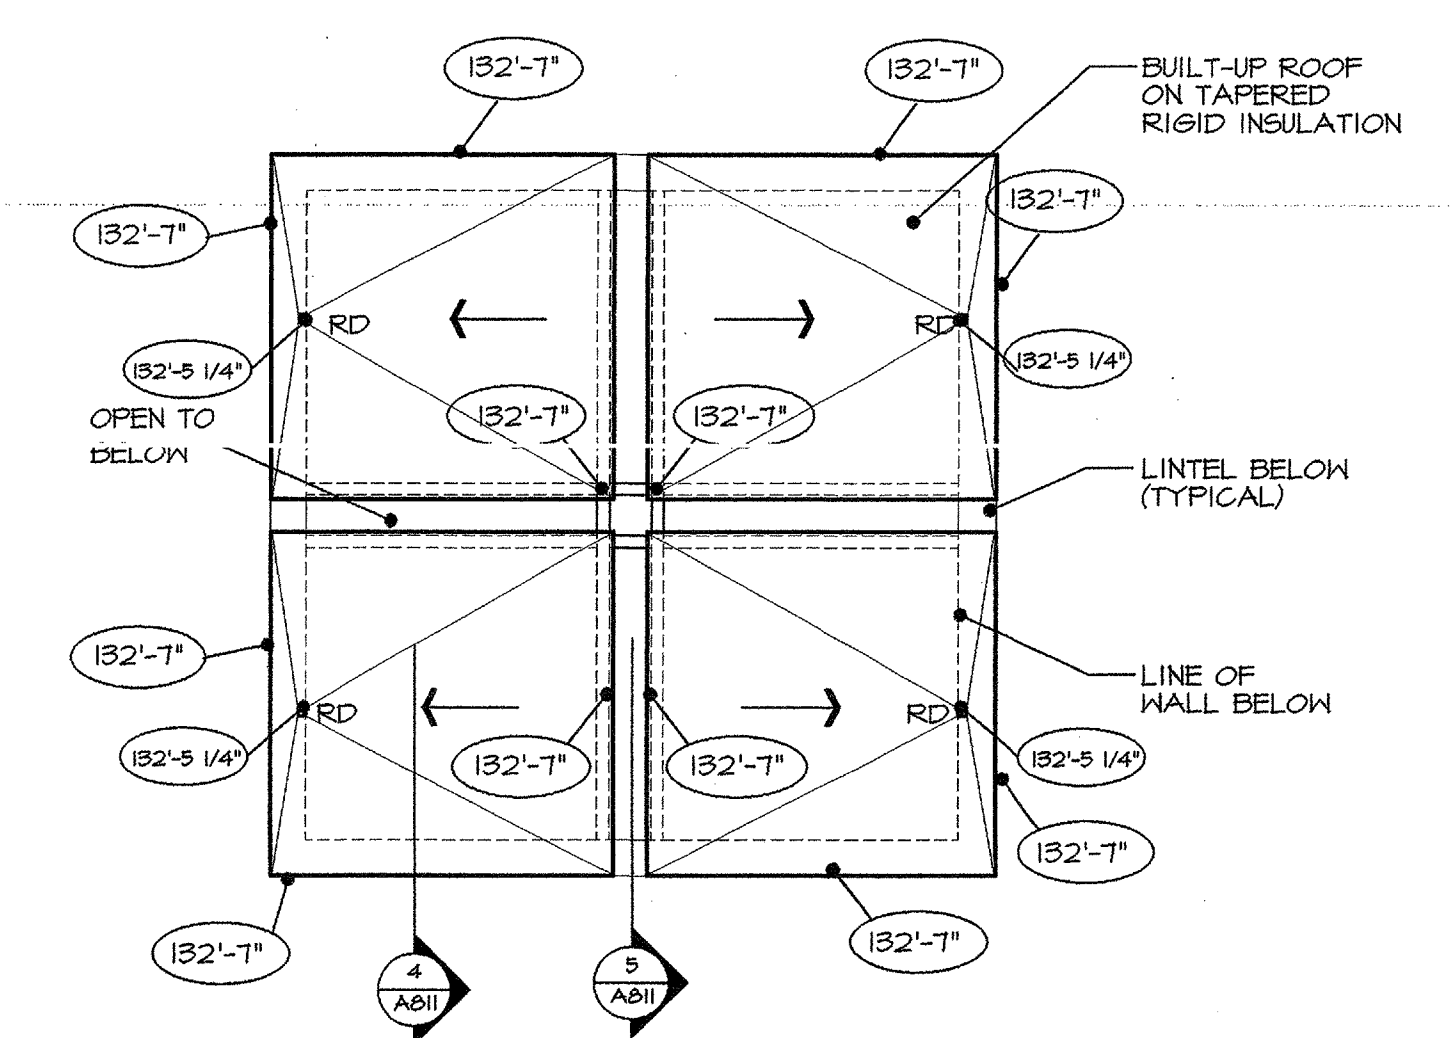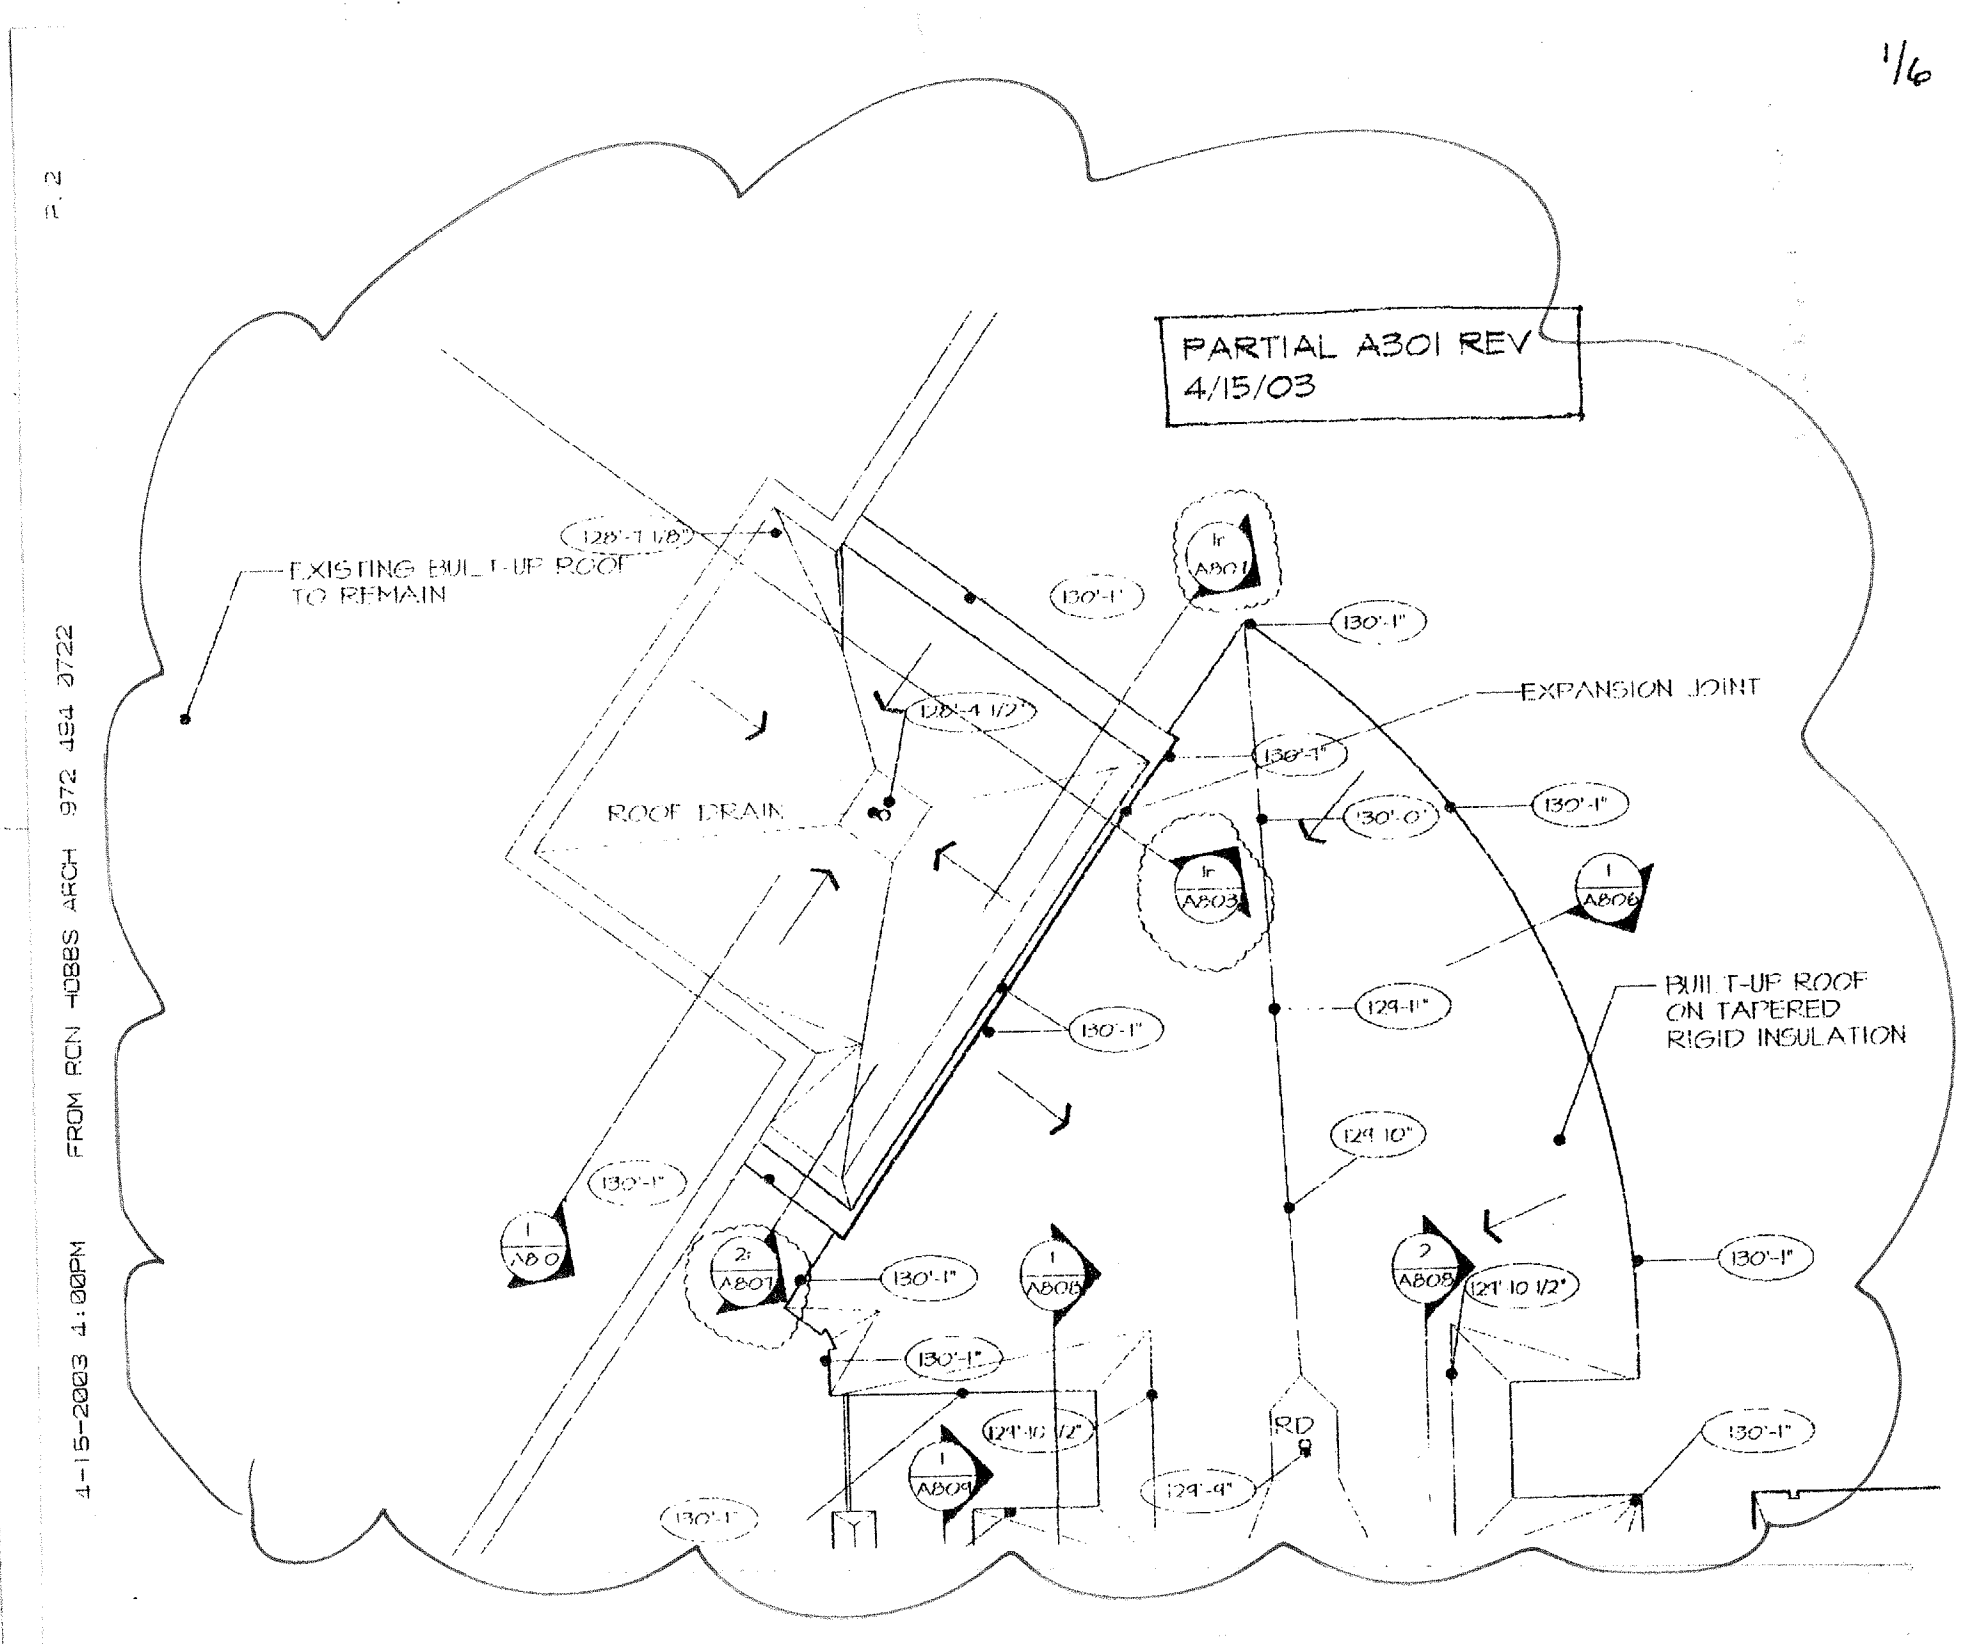

2 roof plan - north pavilion - alternate #4  
1/8"=1'-0"

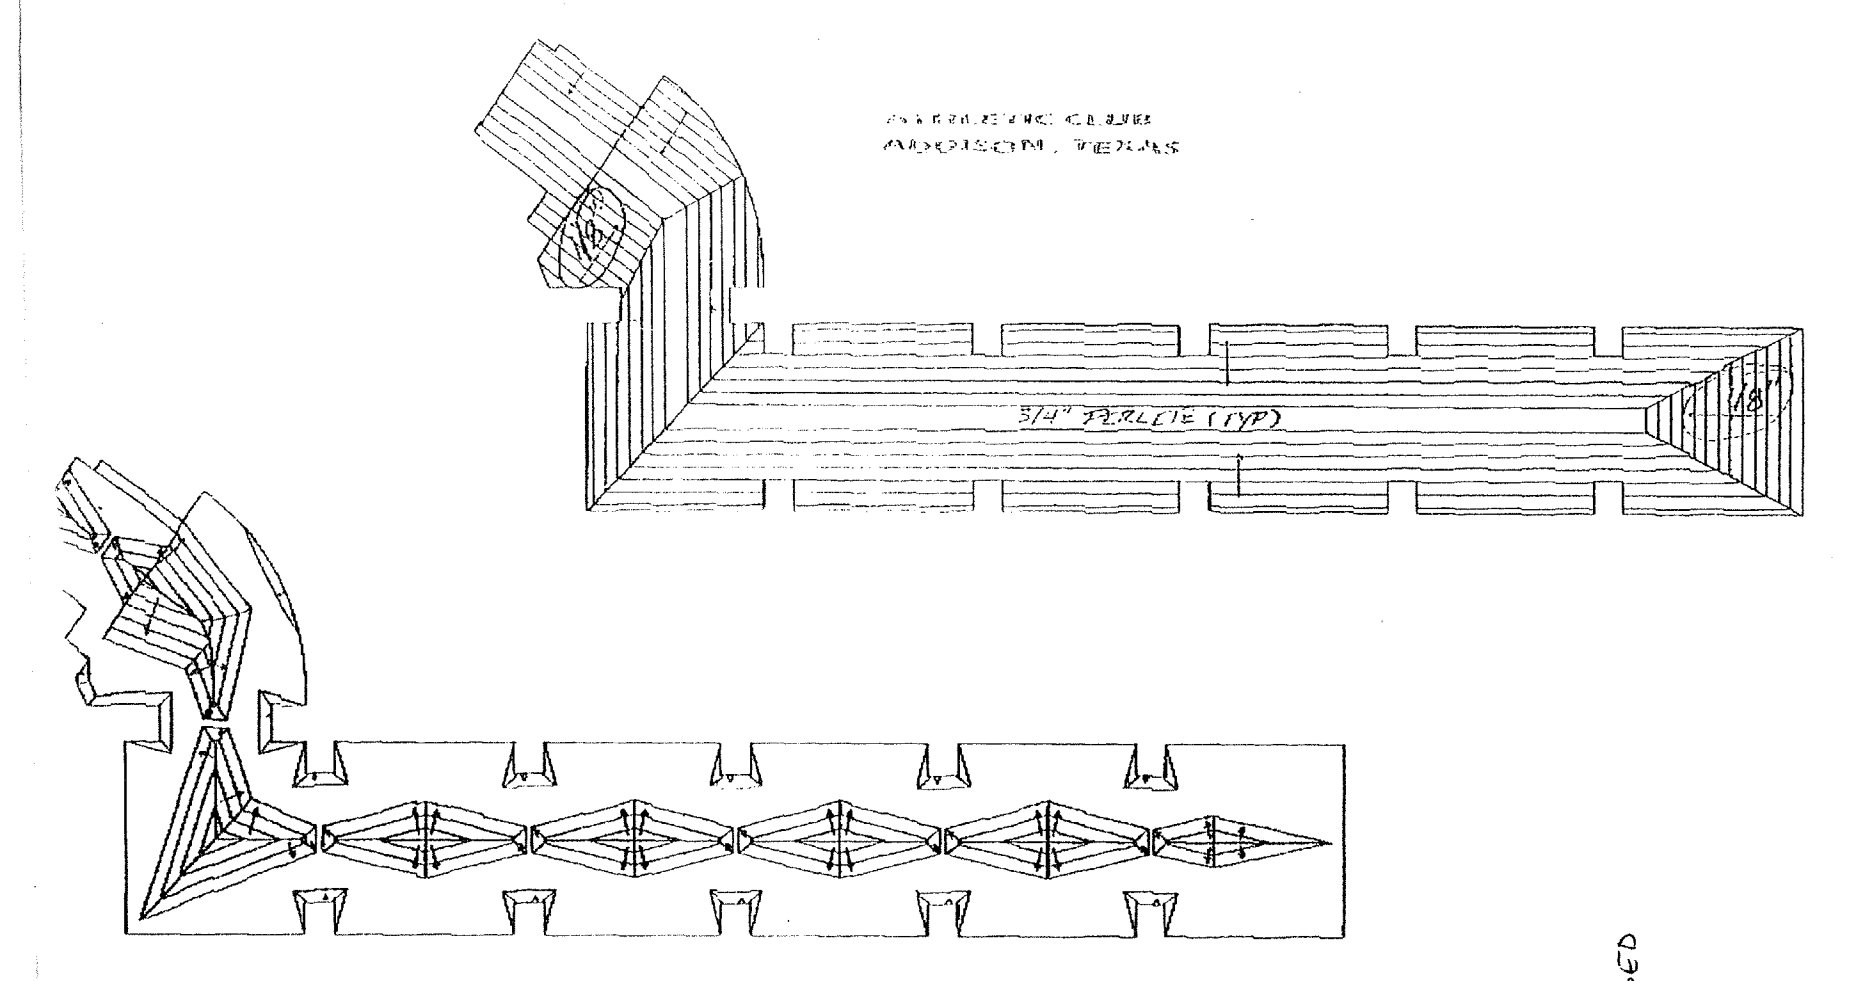

Revised

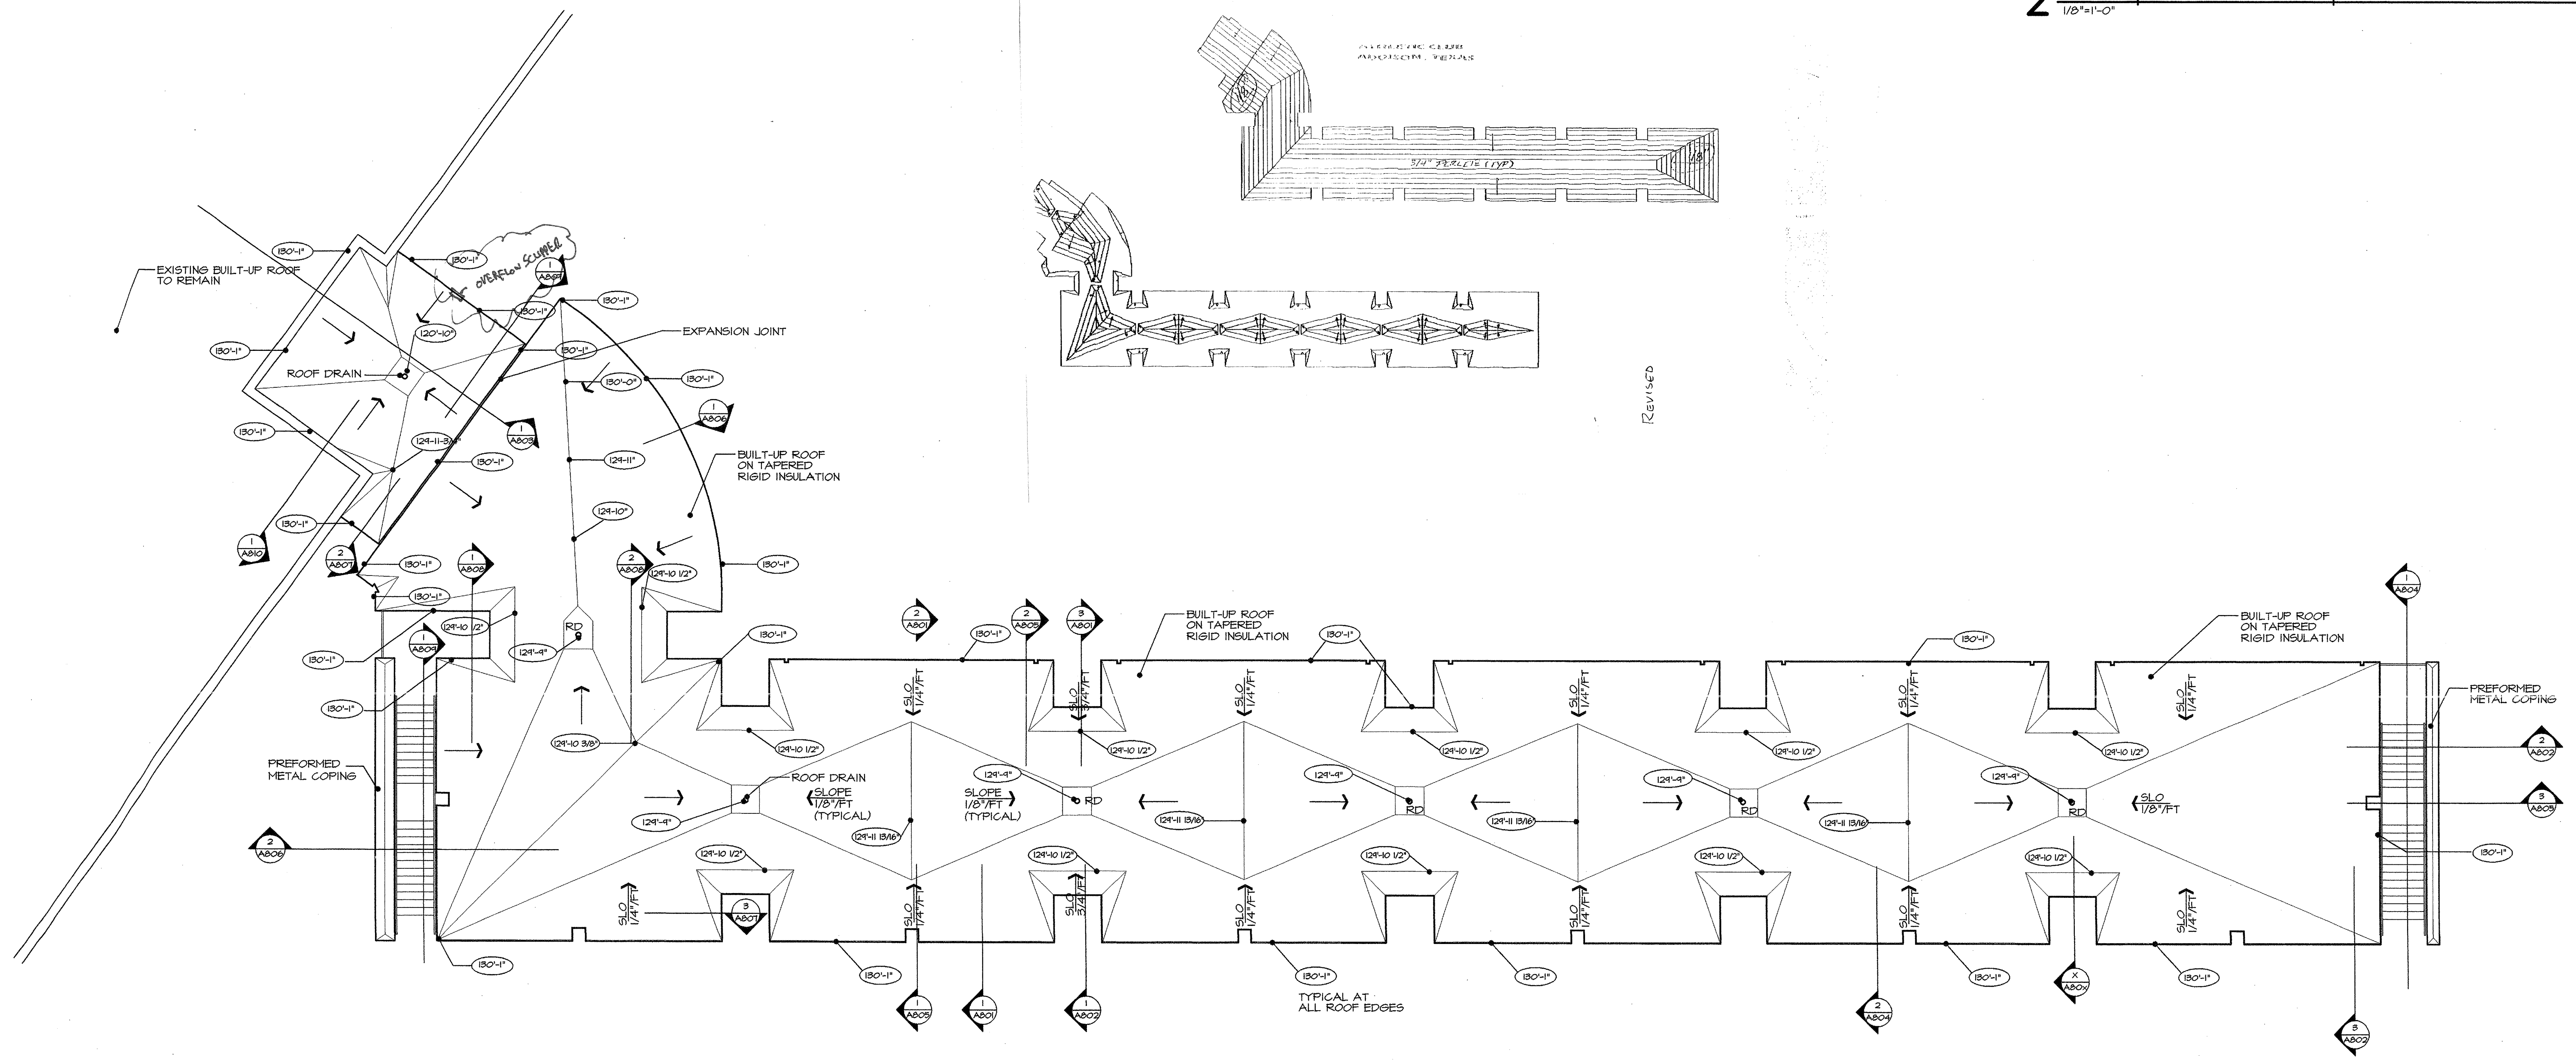

1 roof plan  
1/8"=1'-0"