symbol legend

- 2'x4' FLUORESCENT LIGHT
- 2'X2' FLUORESCENT LIGHT
- RECESSED DOWN LIGHT
- ACOUSTIC CEILING TILE
- GYPSUM BOARD CEILING
- SMOOTH TROWEL CONCRETE
- SUPPLY AIR GRILLE
- RETURN AIR GRILLE
- FLUORESCENT STRIP
- EXIT SIGN
- WALL MOUNTED LIGHT
- PENDANT FLUORESCENT

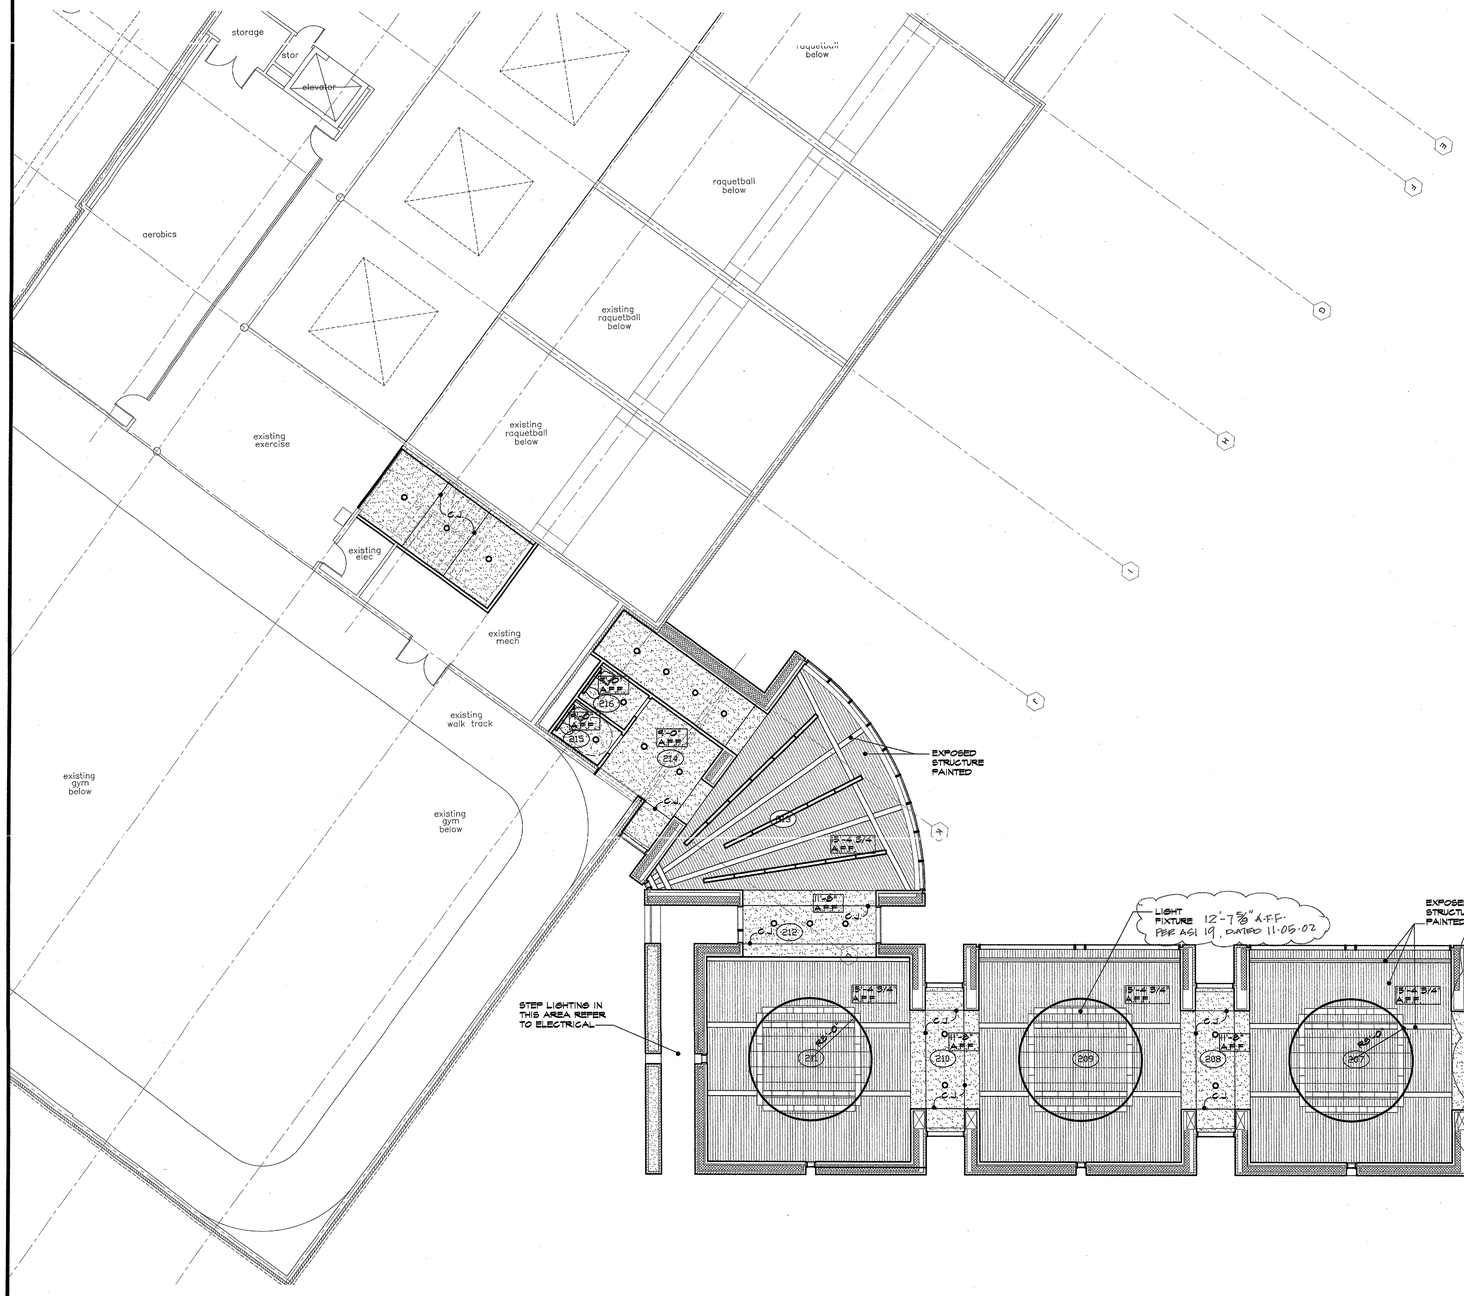

1 upper level refelcted ceiling plan
1/8"=1'-0"

ISSUE DATE
FEB. 20, 2002

REVISIONS

ADDISON ATHLETIC CLUB EXPANSION AND LEISURE POOL
ADDISON, TEXAS

RON HOBBS ARCHITECTS
614 W. MAIN ST. SUITE #200 GARLAND, TEXAS 75040
(972) 494-0174 FAX (972) 494-0722

REGISTERED ARCHITECT RONALD L. HOBBS STATE OF TEXAS

JOB NUMBER
0012

SHEET NAME
SECOND FLOOR REFLECTED CEILING PLAN

SHEET NUMBER
A402