



legend


CJ = CONTROL JOINT

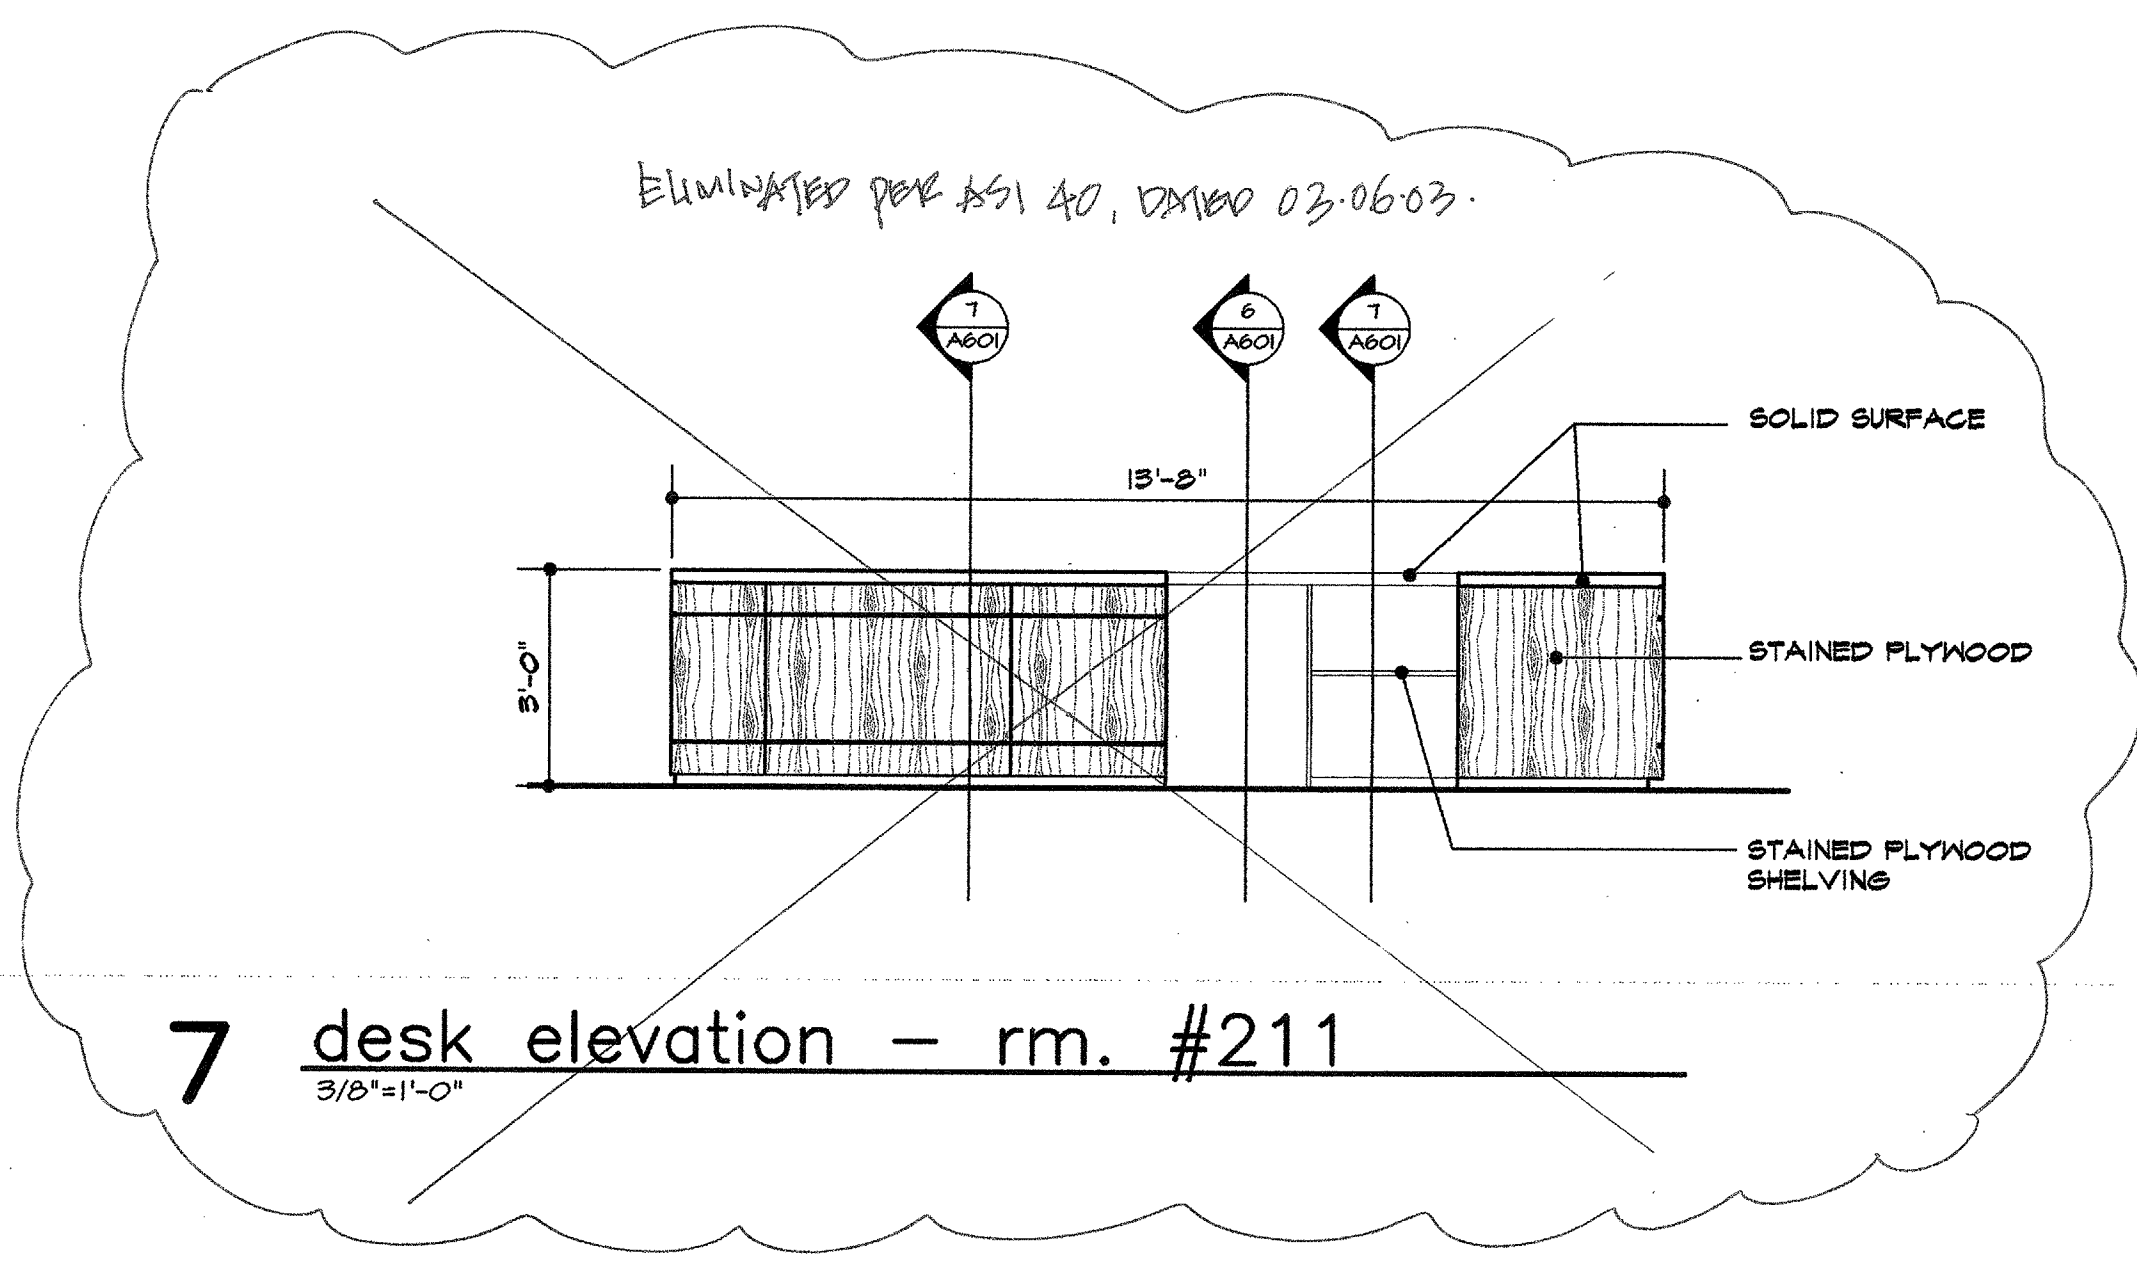


7 desk elevation - rm. #211
 3/8"=1'-0"

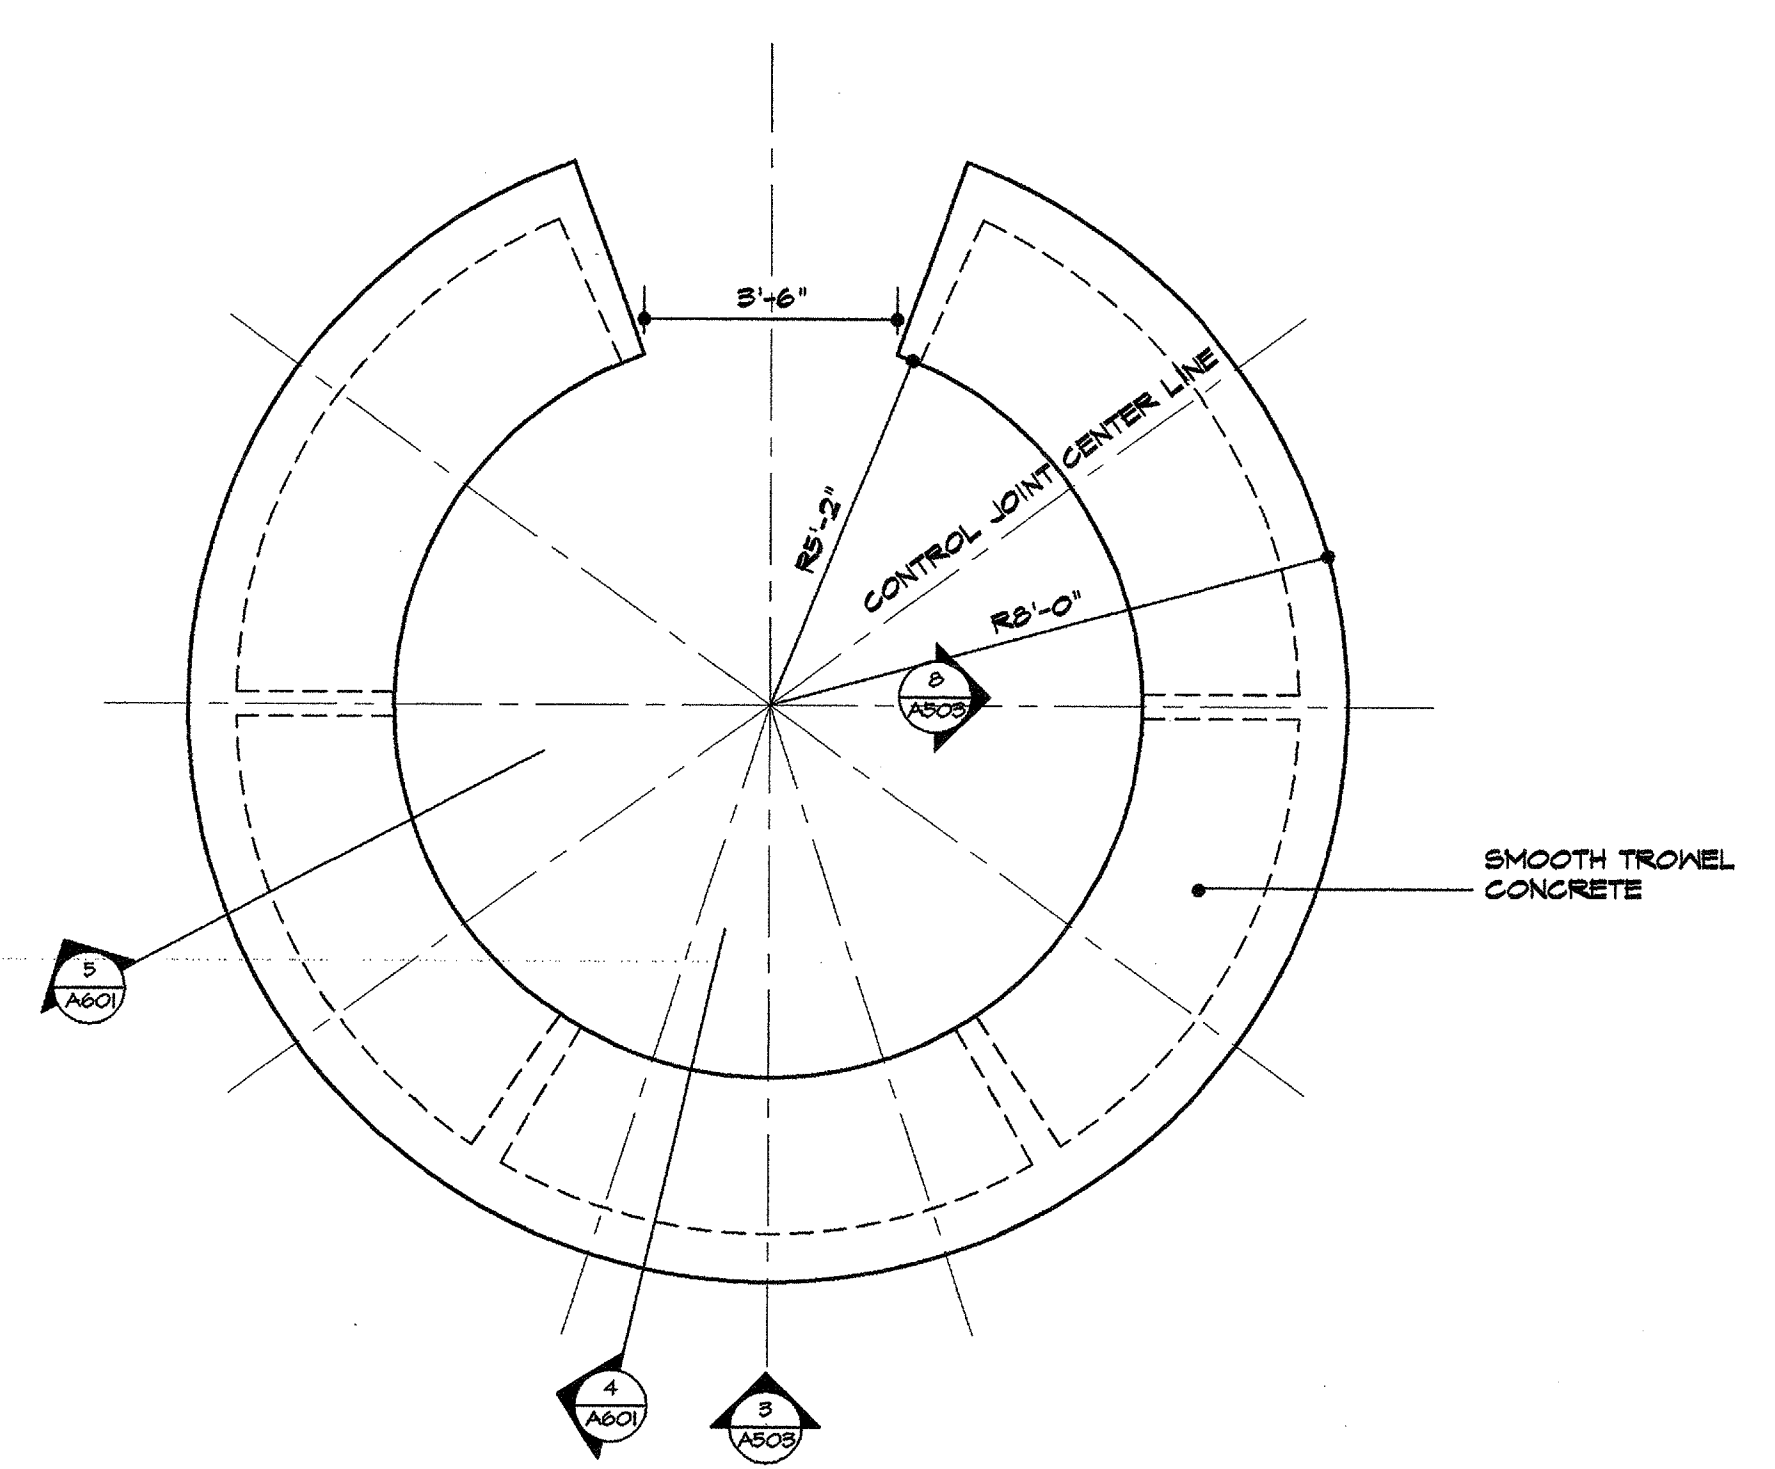


5 desk floor plan - rm. #105
 3/8"=1'-0"

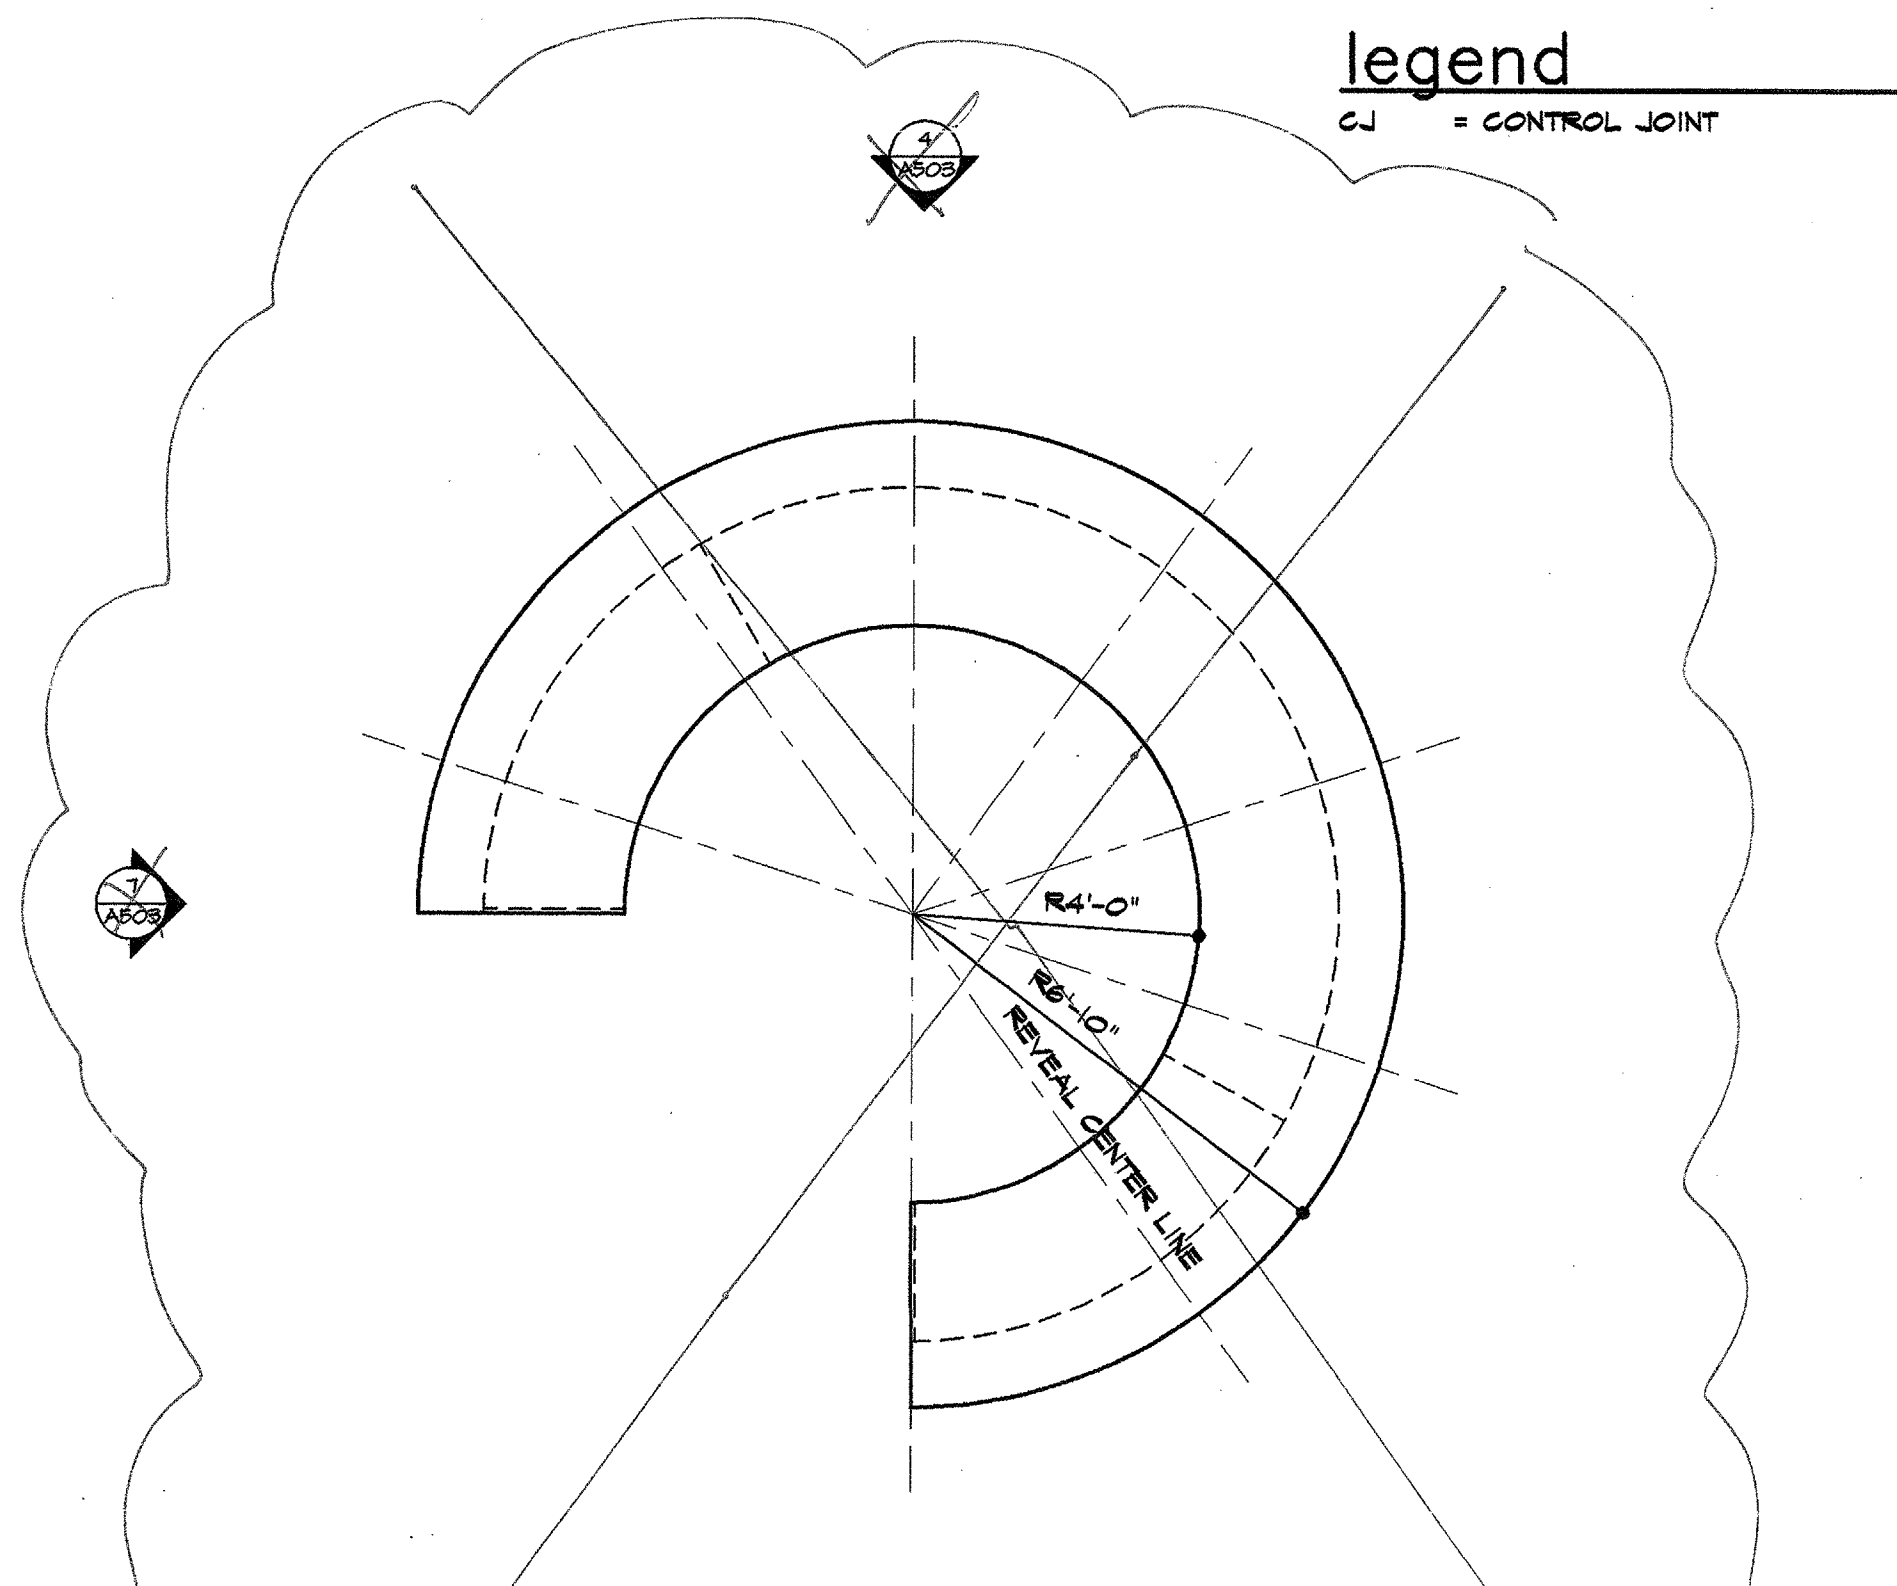


6 desk floor plan - rm. #211
 3/8"=1'-0"

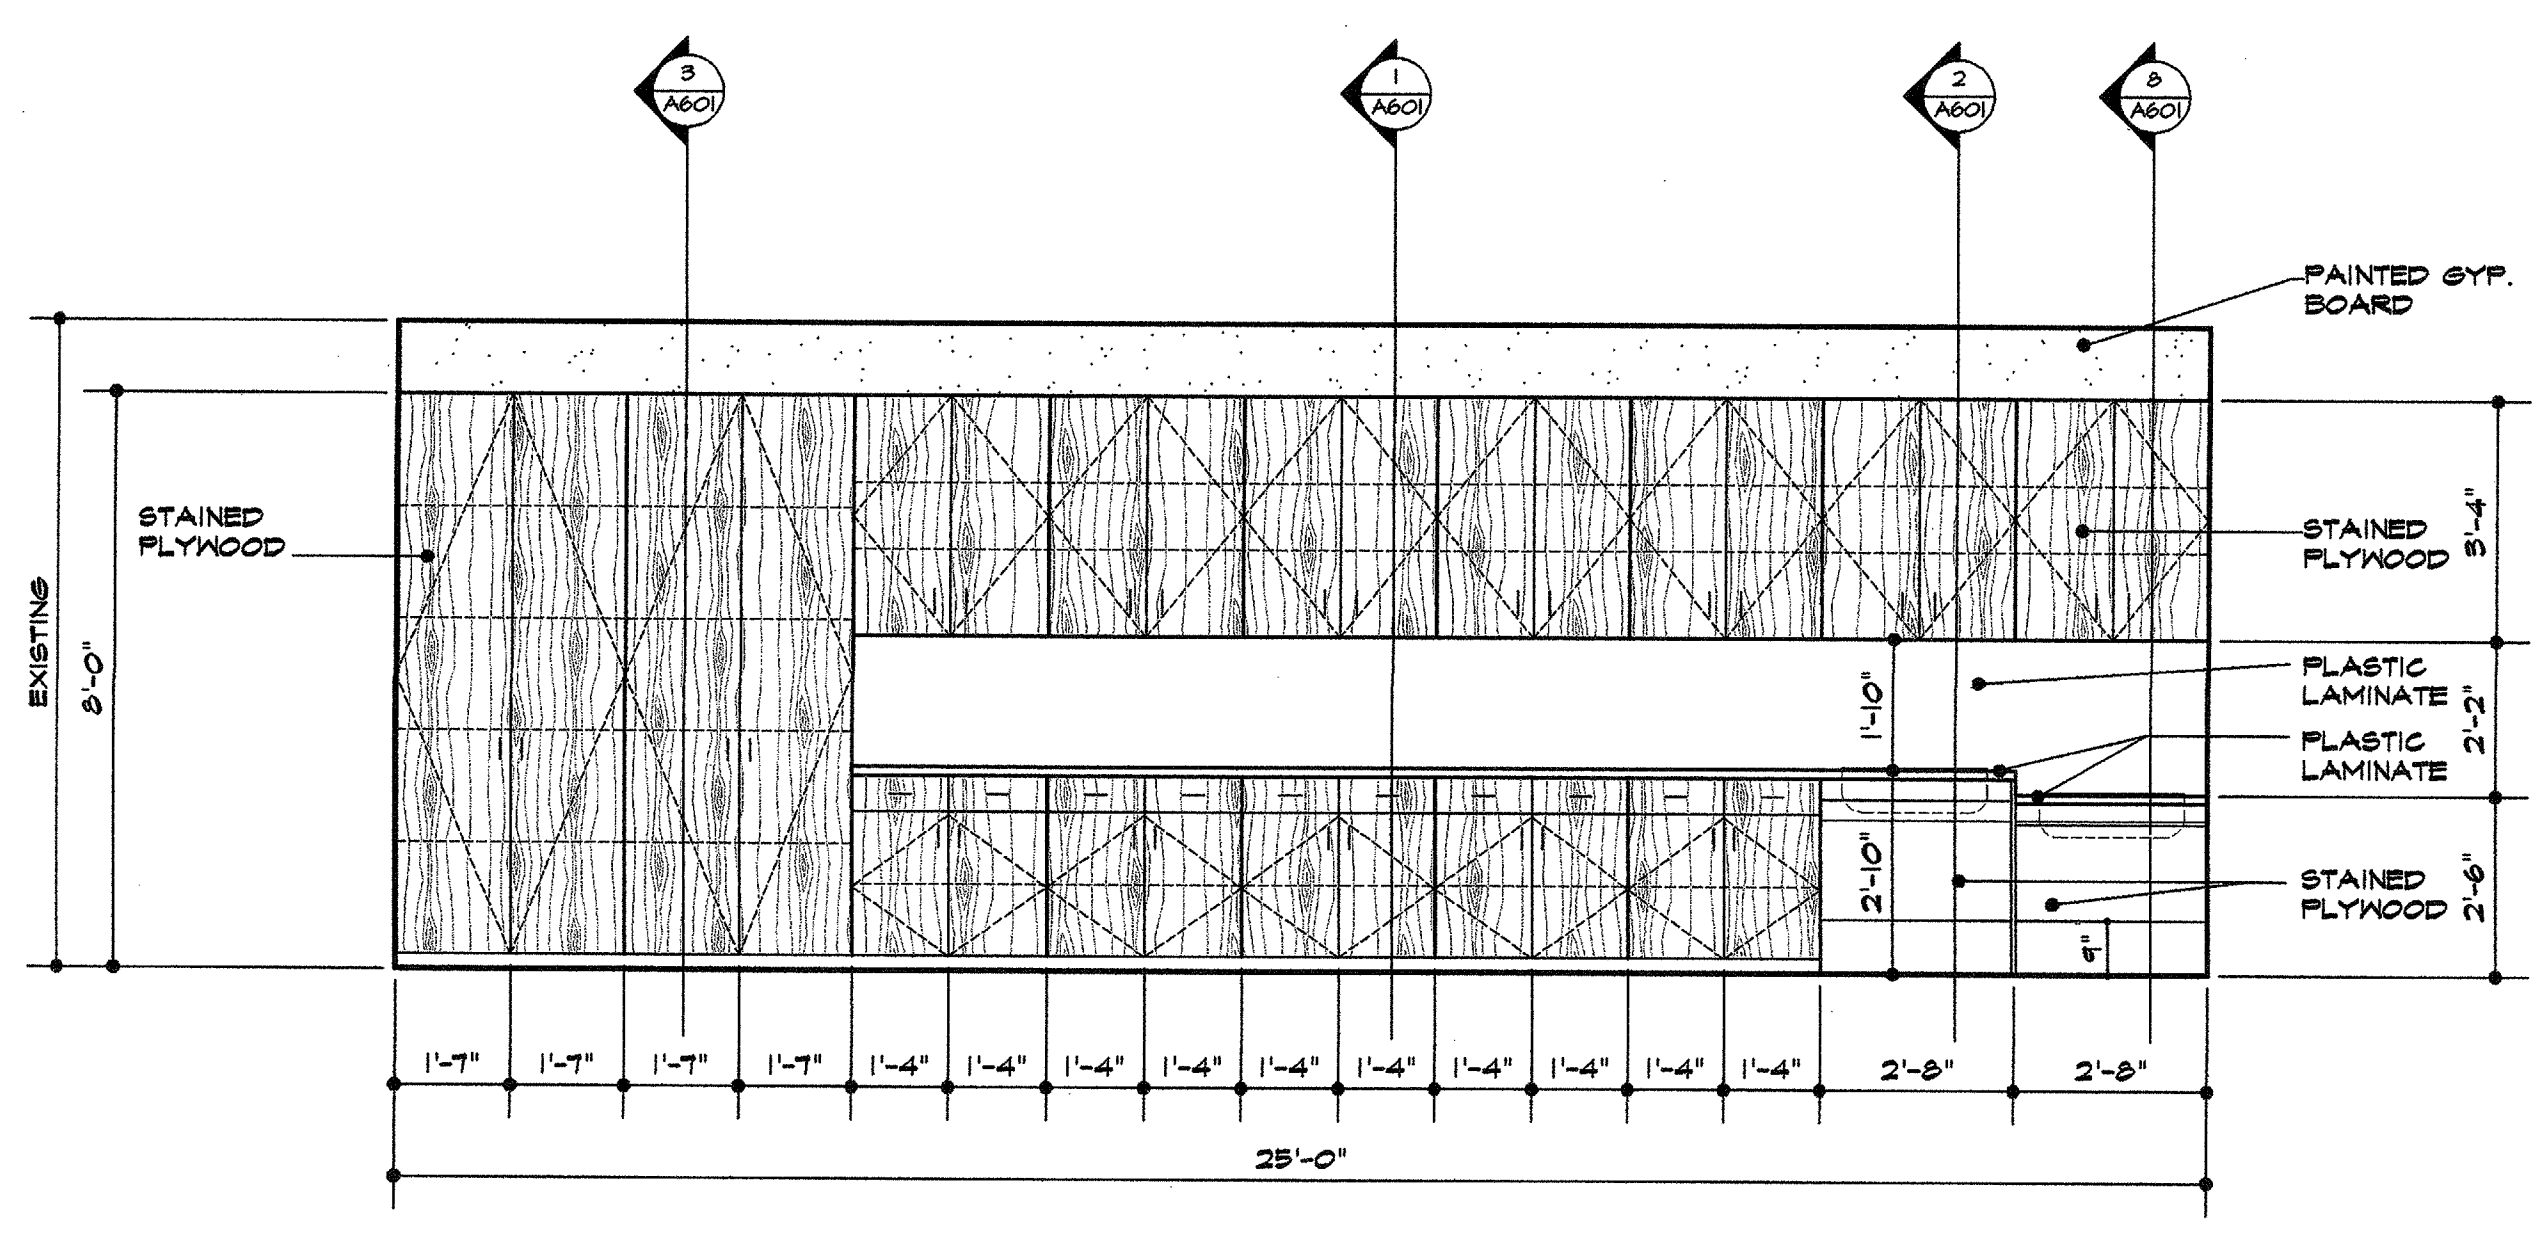


2 interior elevation - rm. #121
 3/8"=1'-0"

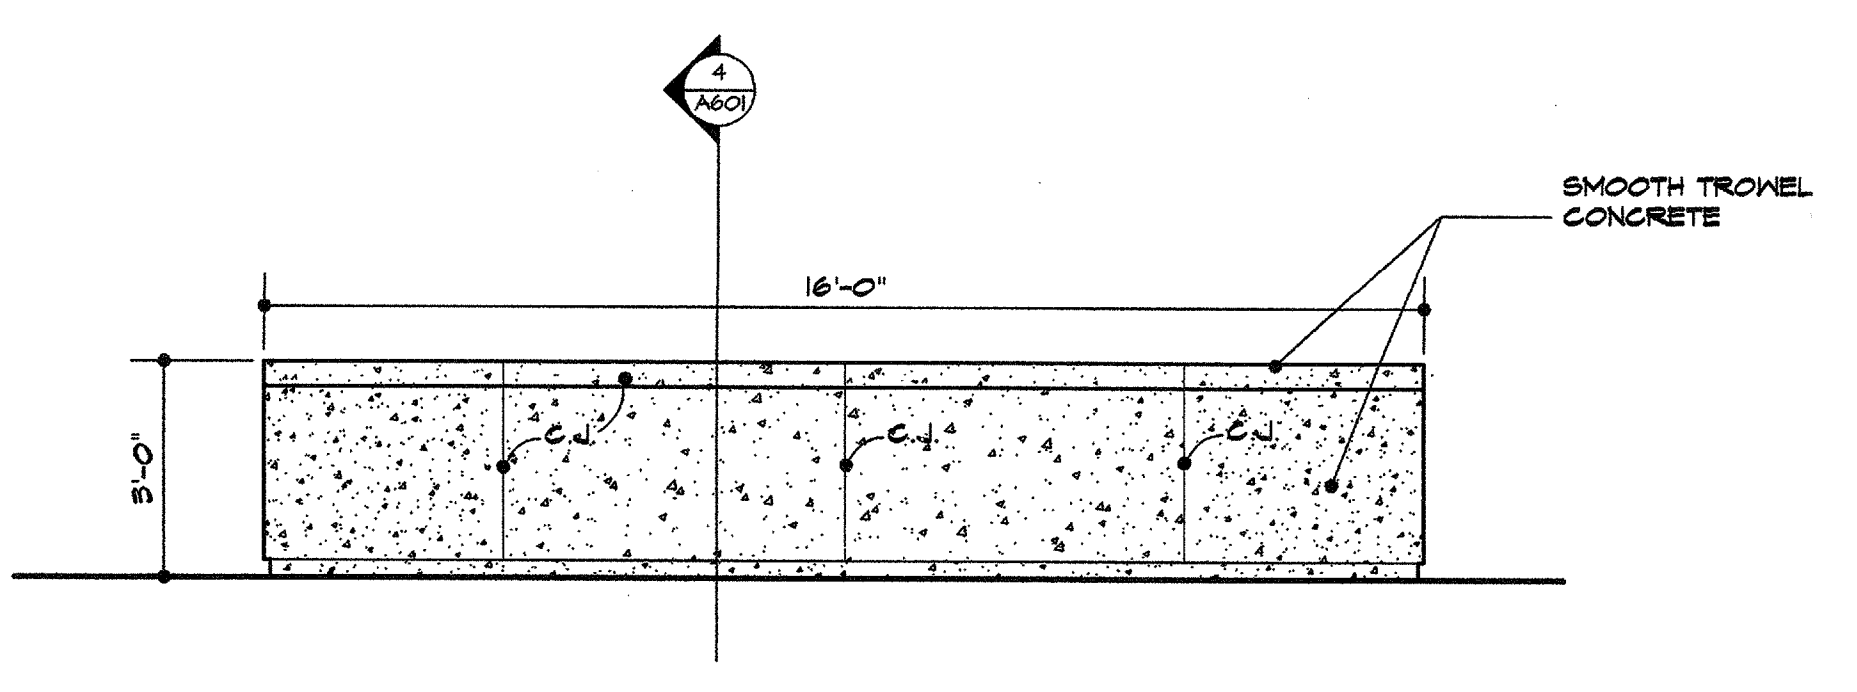


3 desk elevation - rm. #105
 3/8"=1'-0"

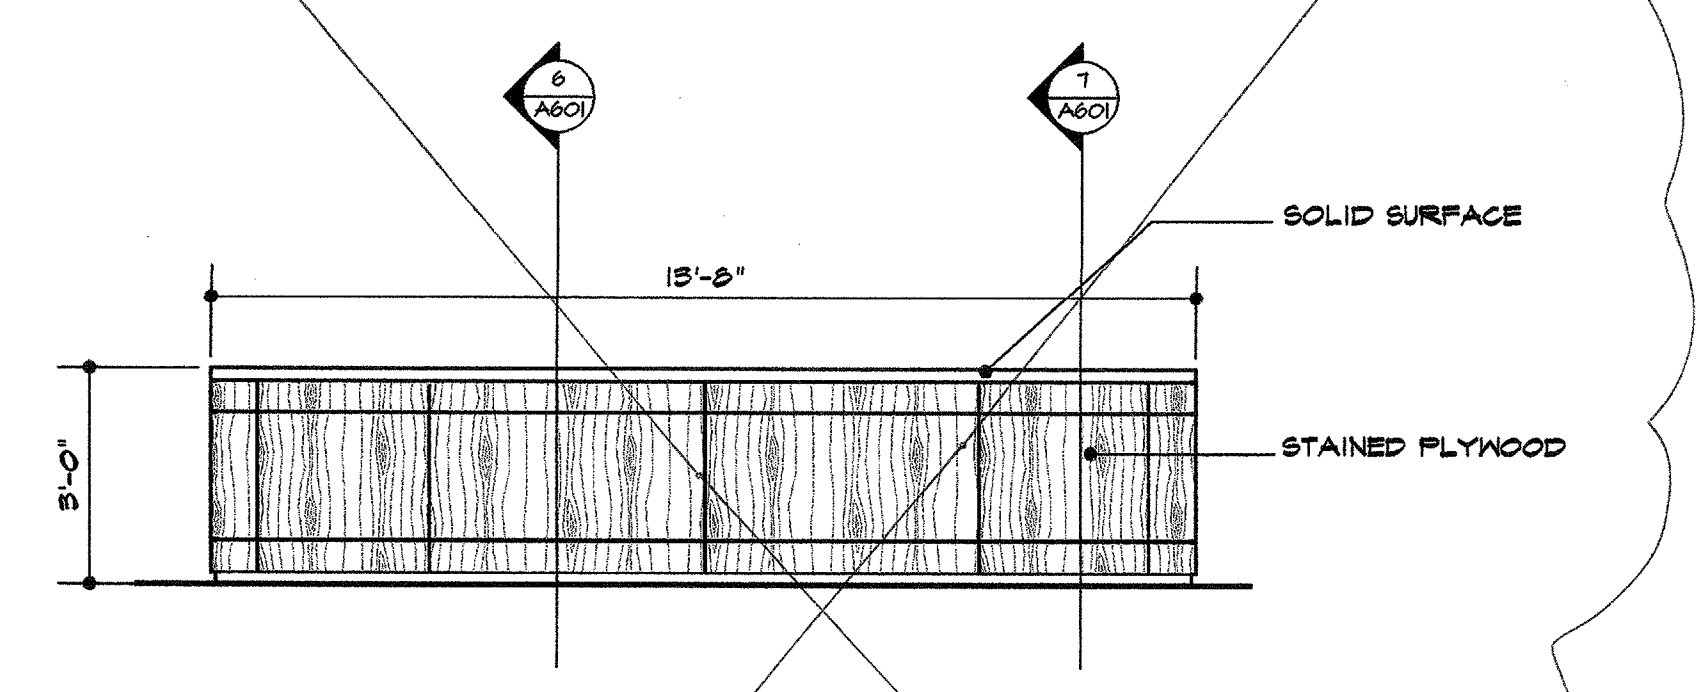


4 desk elevation - rm. #211
 3/8"=1'-0"

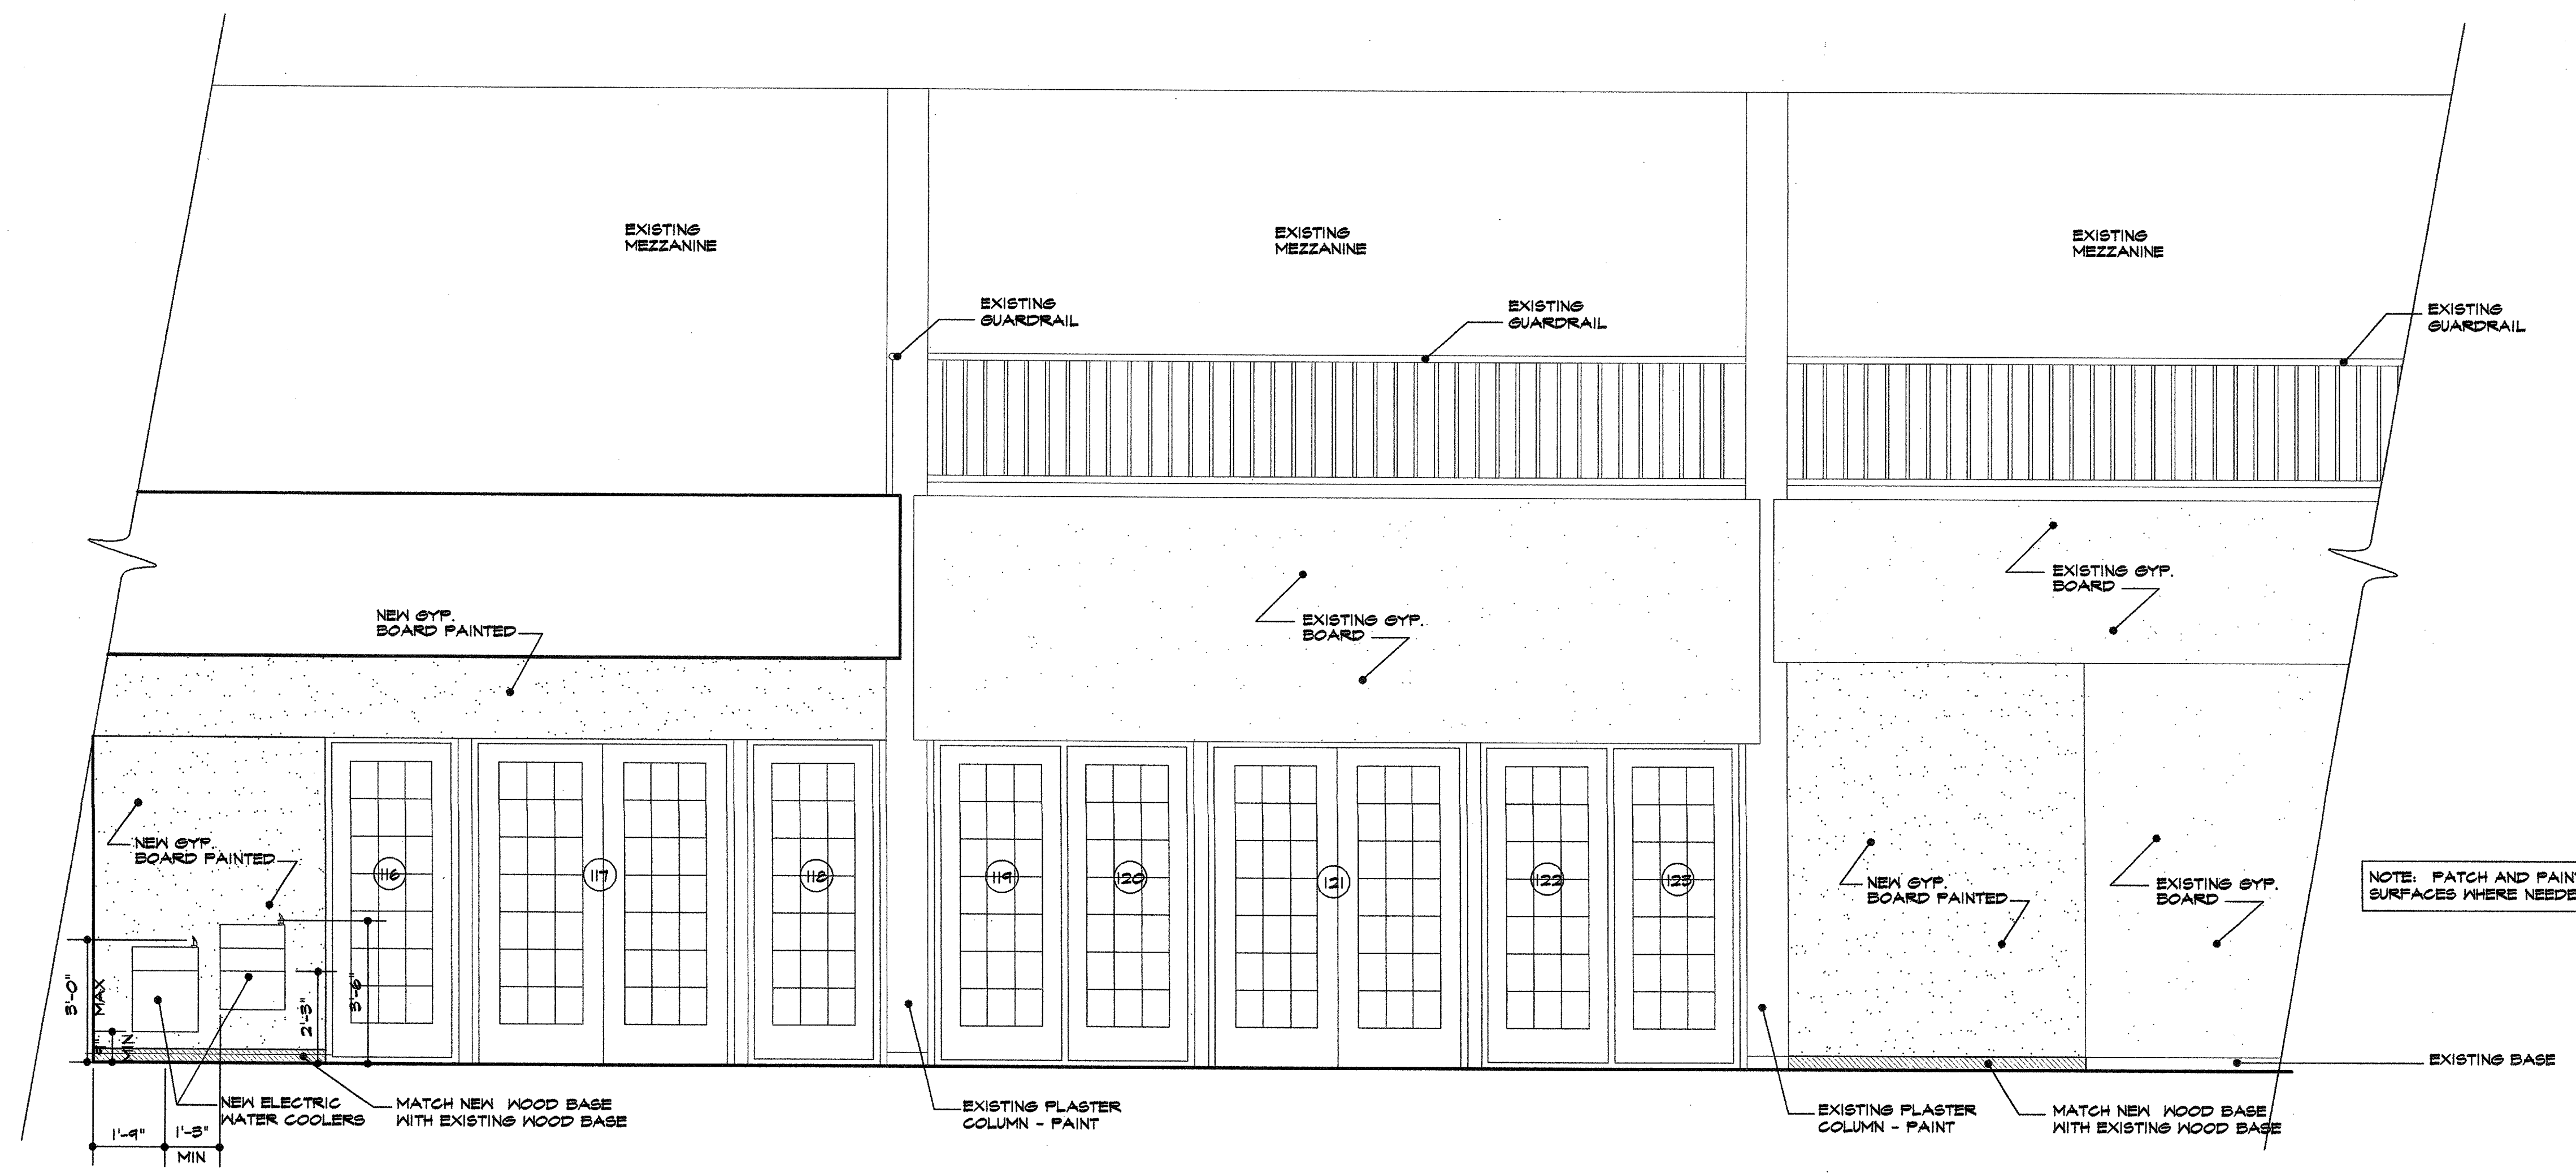

1 interior elevation - existing exercise
 3/8"=1'-0"

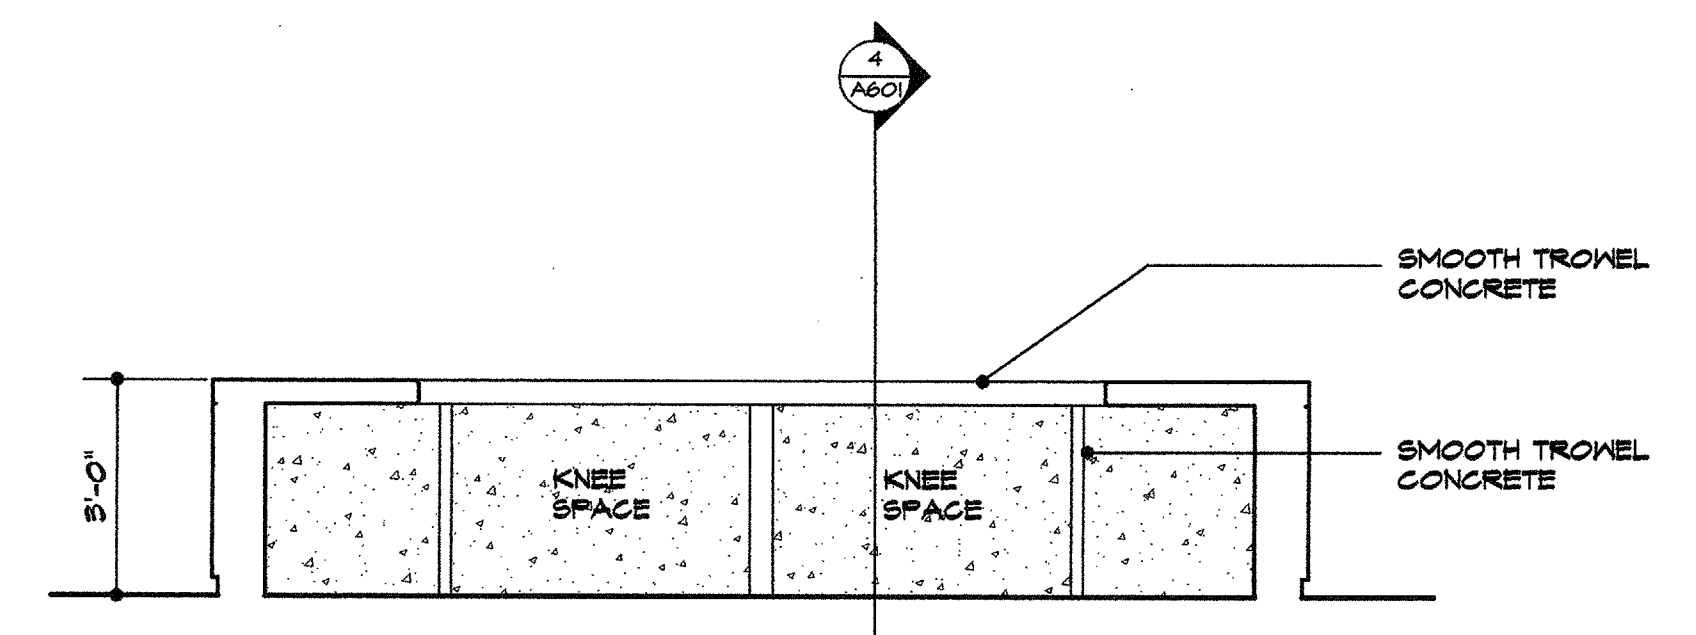

8 desk elevation - rm. #105
 3/8"=1'-0"

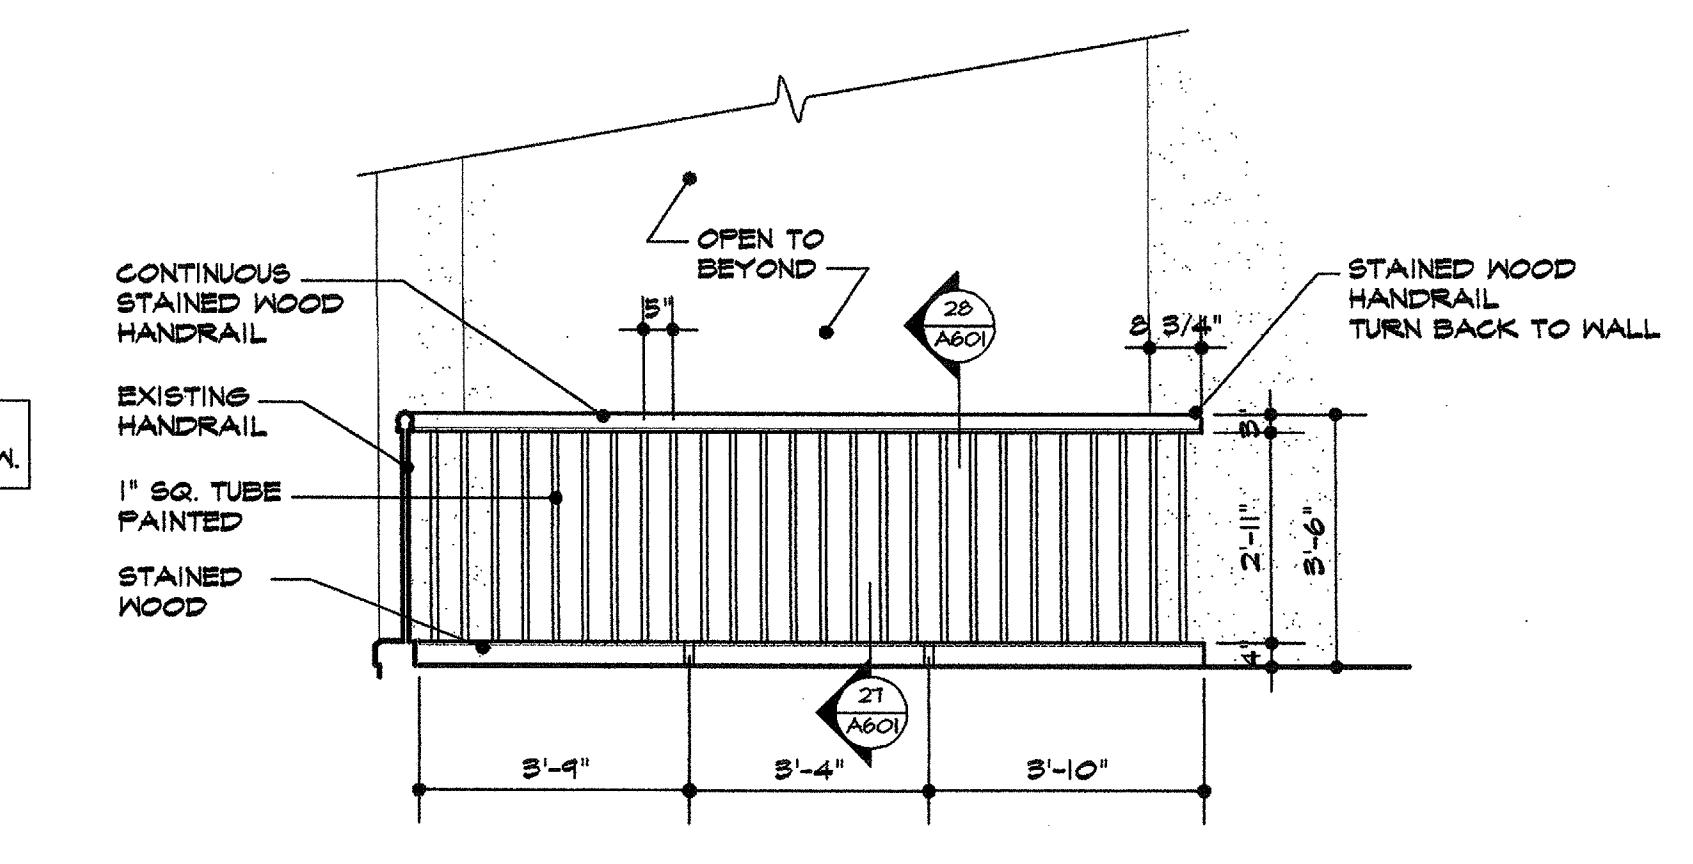

9 interior elevation
 3/8"=1'-0"

NOTE: PATCH AND PAINT EXISTING SURFACES WHERE NEEDED TO MATCH NEW.