


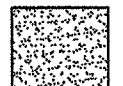


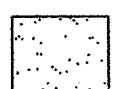


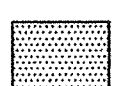


floor finish legend

-  CARPET TYPE 'C-1'
-  CARPET TYPE 'C-2'
-  CARPET TYPE 'C-3'
-  CARPET TYPE 'C-4'
-  CERAMIC TILE 2'x2'
-  SEALED CONCRETE
-  WEIGHT ROOM FLOORING TYPE '1'
-  WEIGHT ROOM FLOORING TYPE '2'

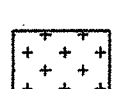

2 lower level floor finish plan  
 1/8"=1'-0"

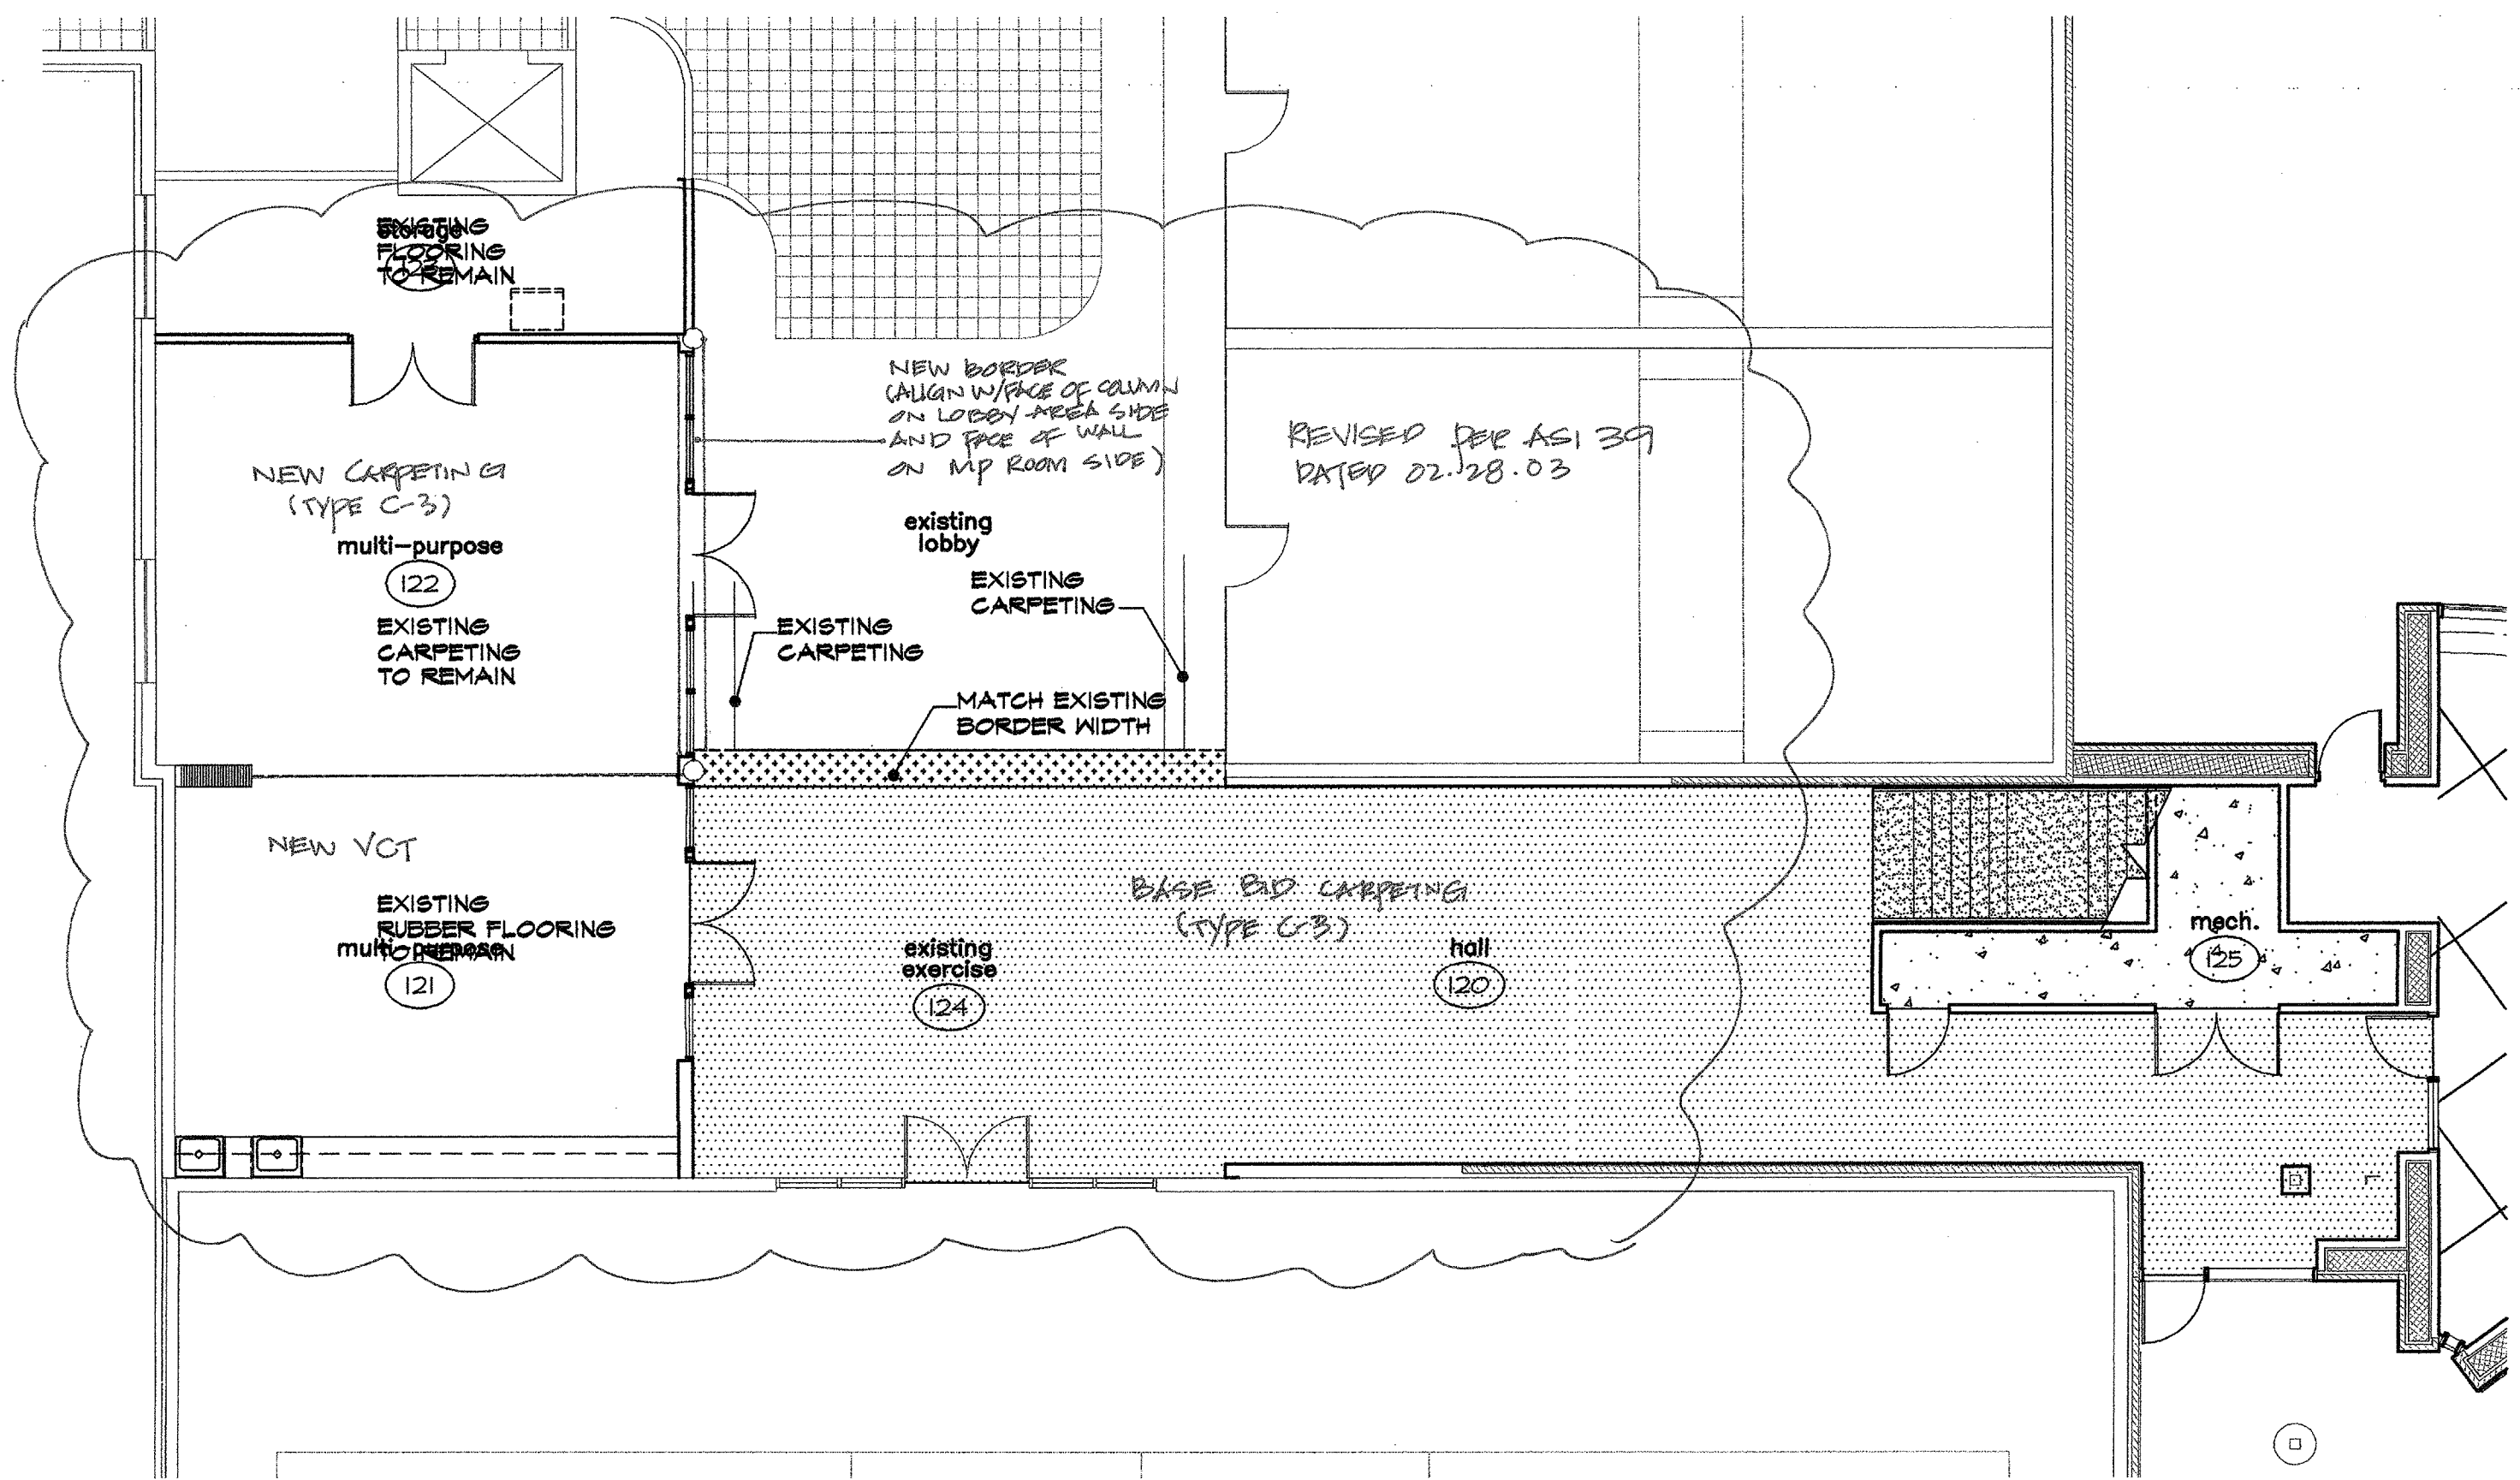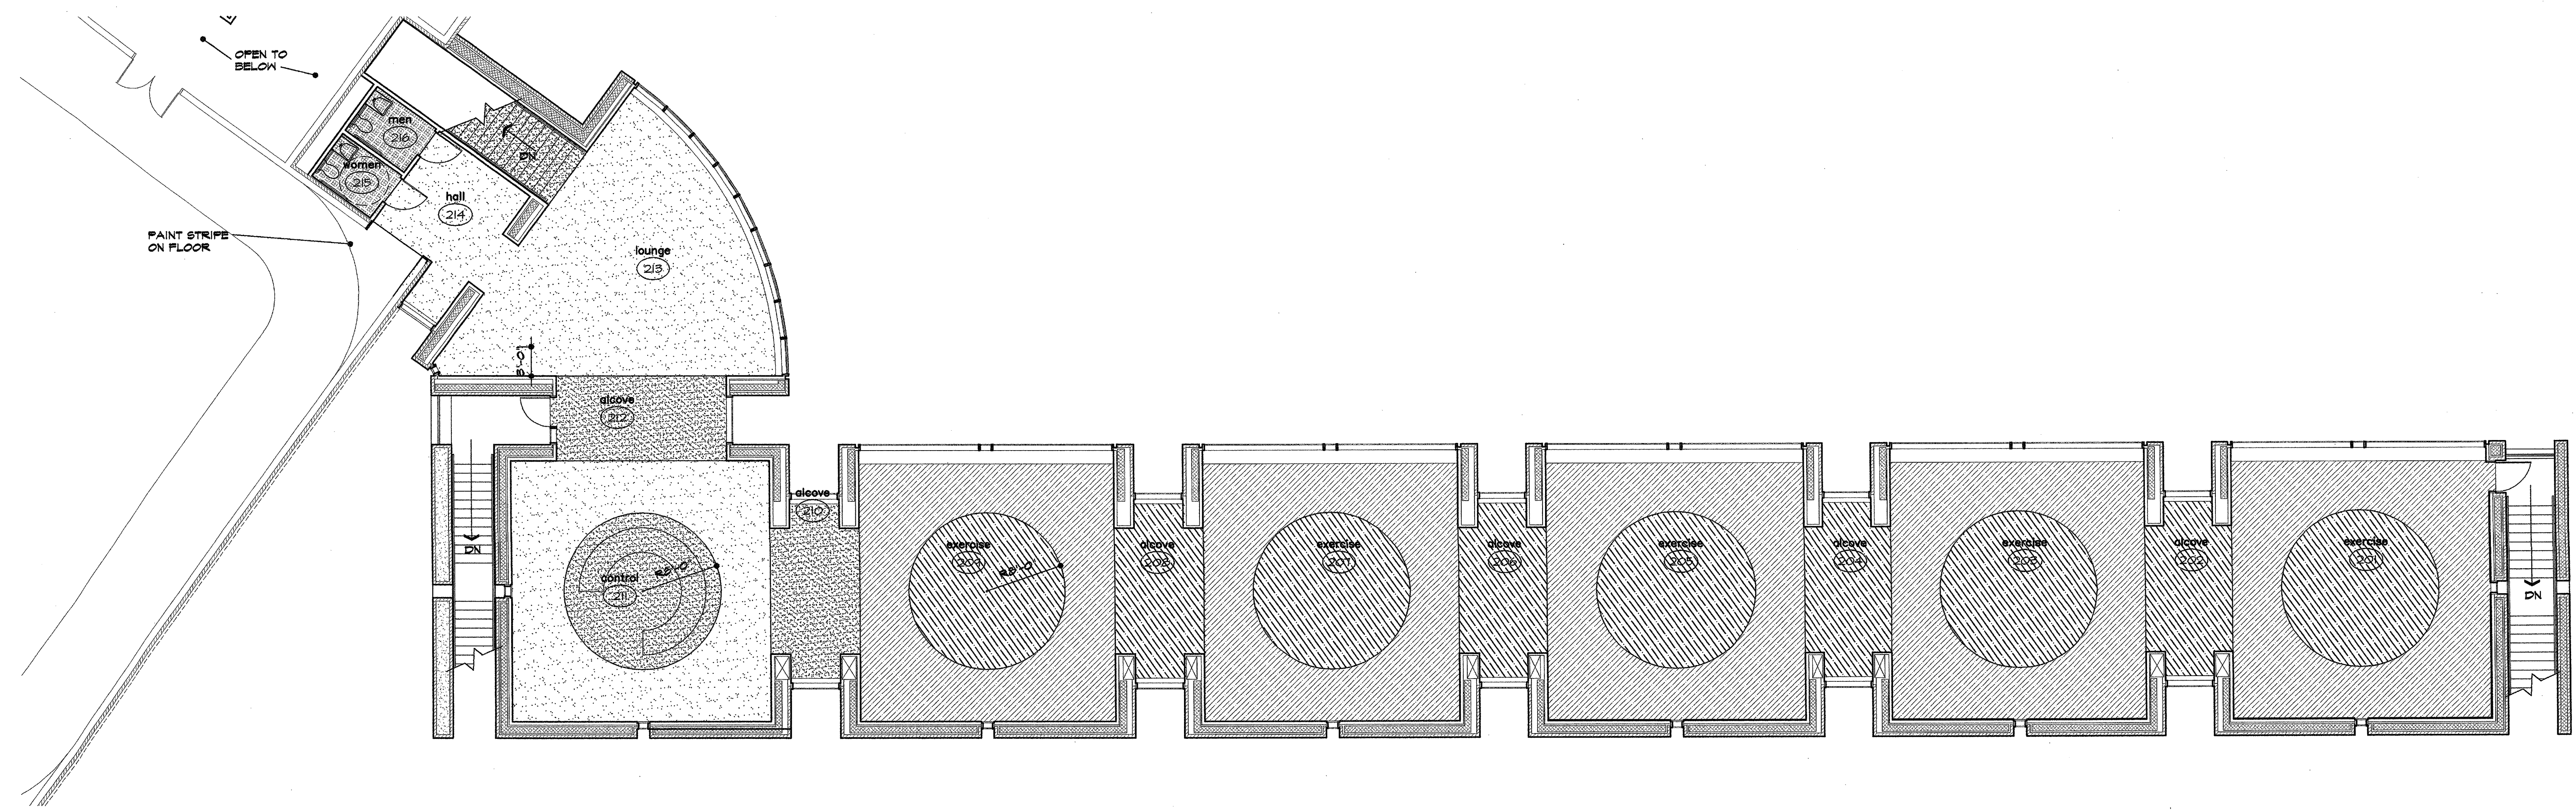

1 upper level floor finish plan  
 1/8"=1'-0"