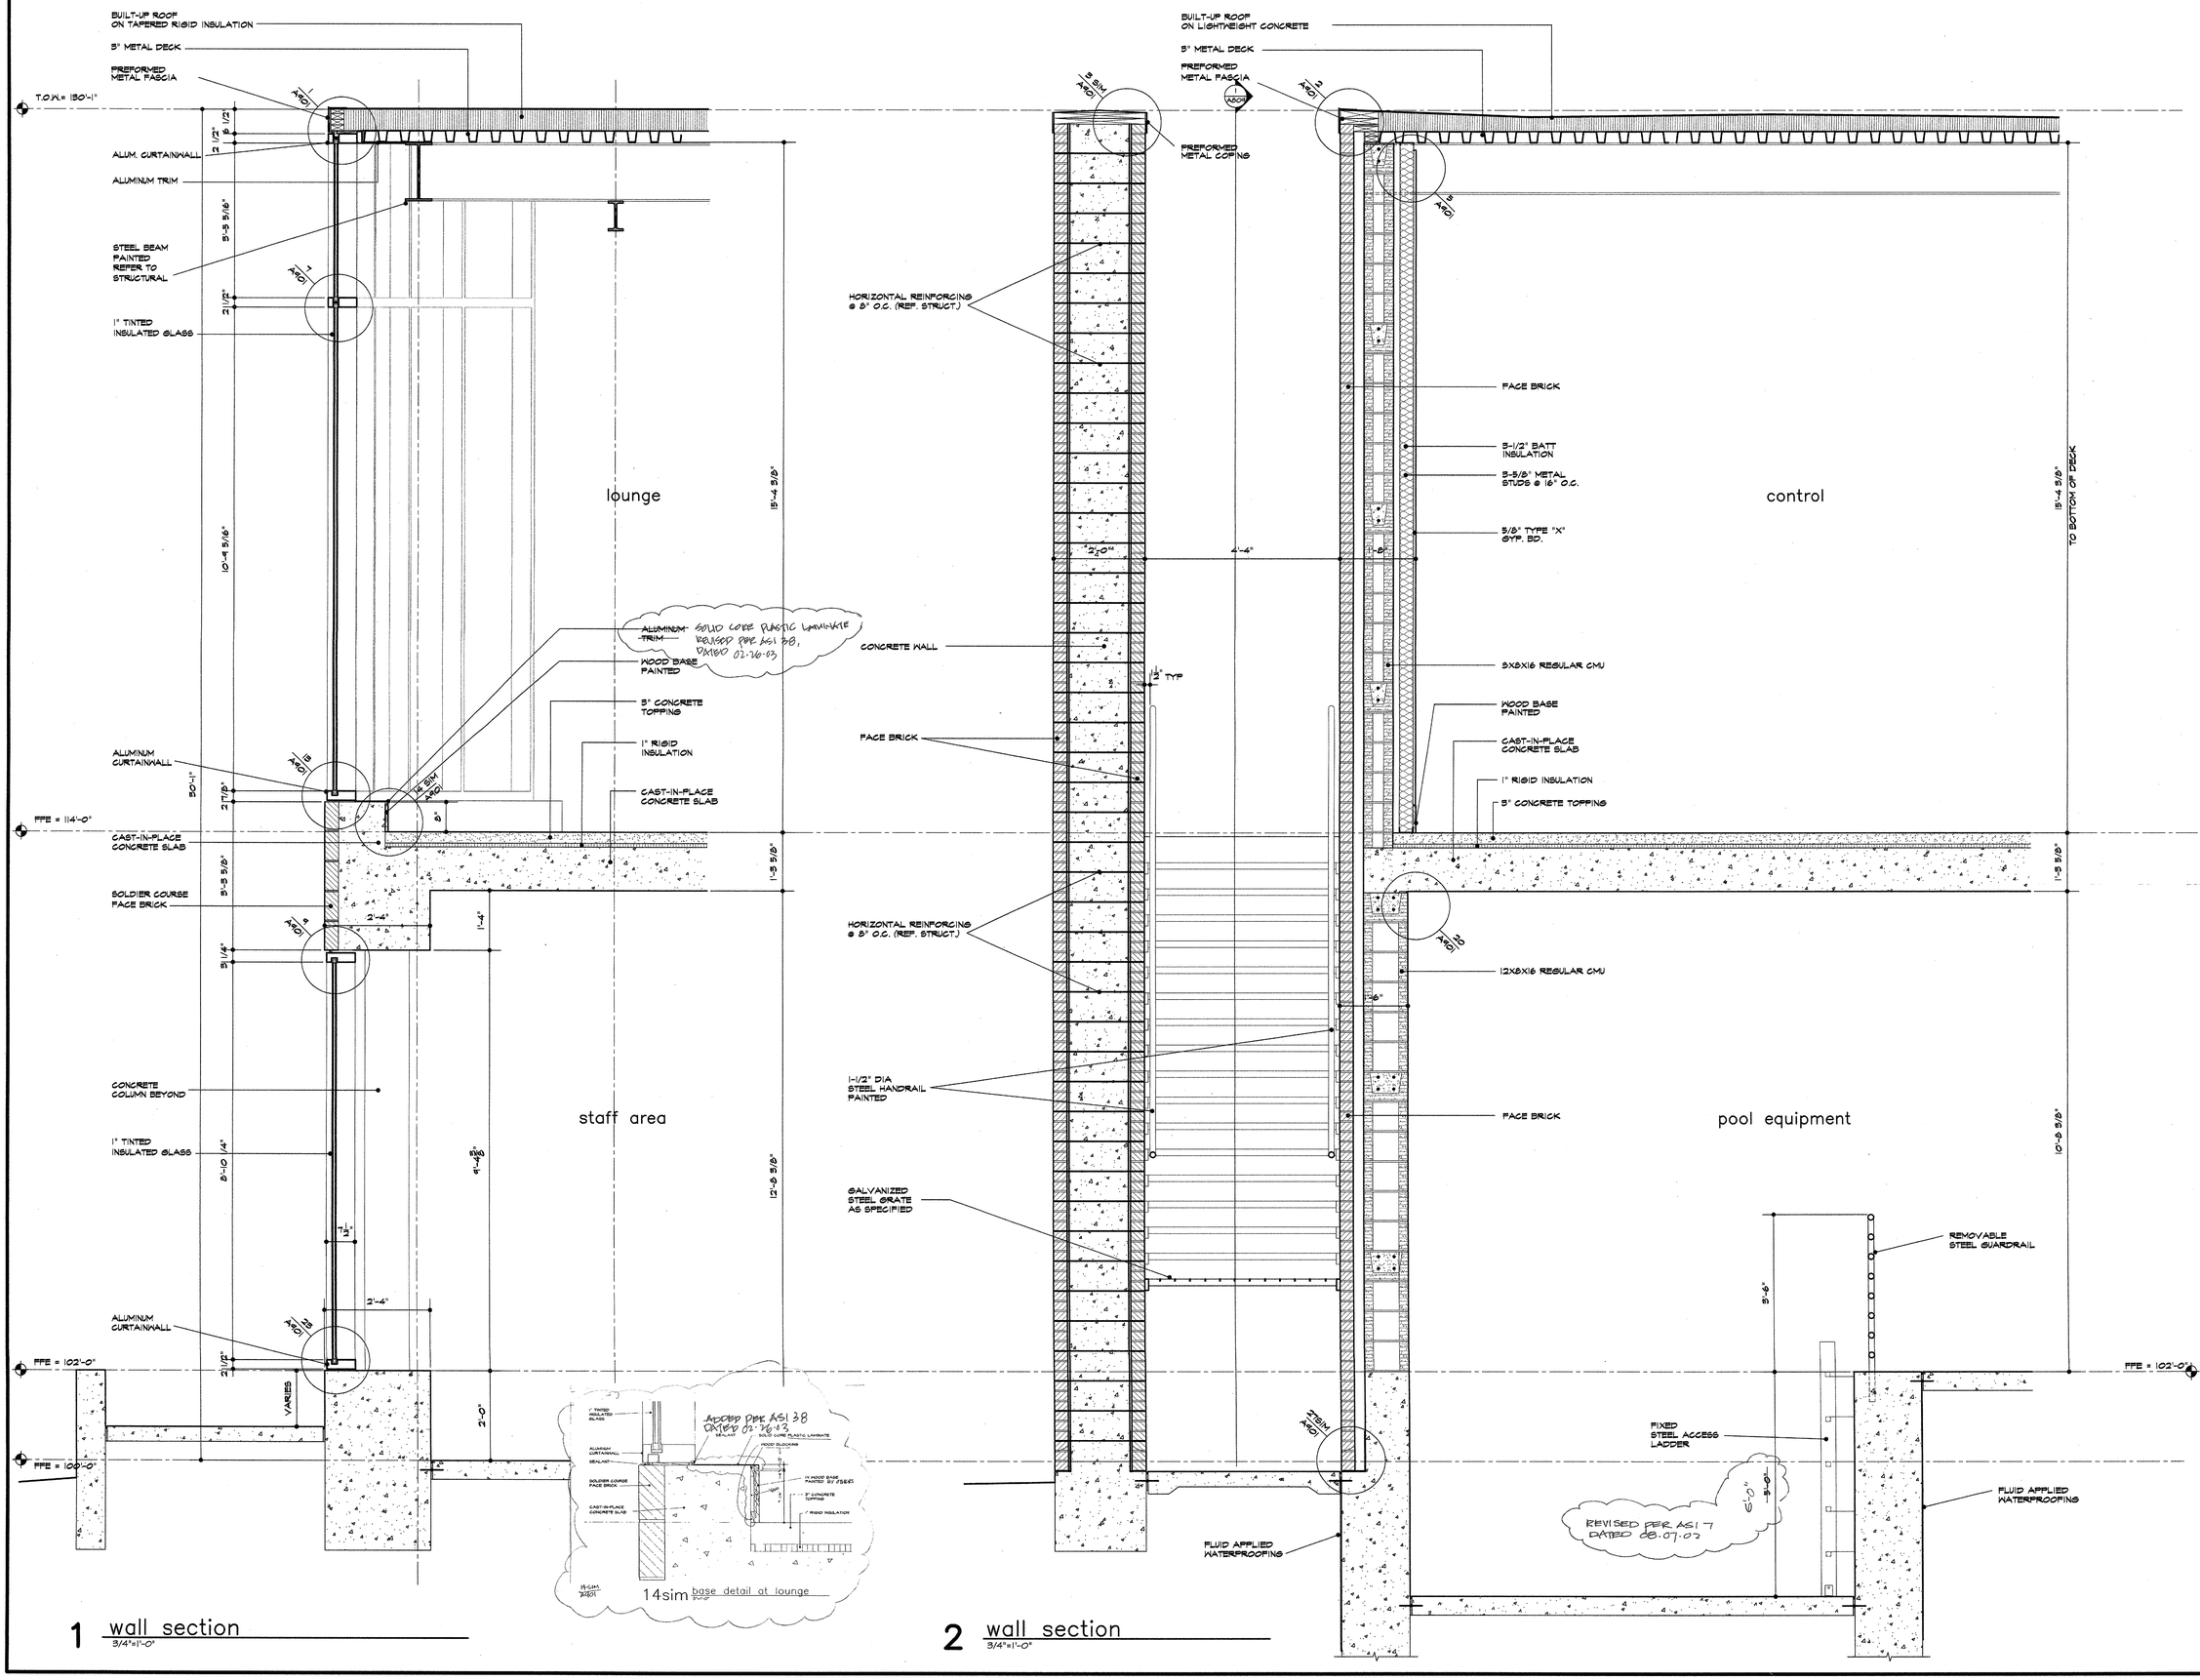

ISSUE DATE
FEB. 20, 2002

REVISIONS

ADDISON ATHLETIC CLUB EXPANSION AND LEISURE POOL
ADDISON, TEXAS

RON HOBBS ARCHITECTS
614 W. MAIN ST. SUITE #200 GARLAND, TEXAS 75040
(972) 494-0174 FAX (972) 494-0722

REGISTERED ARCHITECT RONALD W. HOBBS STATE OF TEXAS

JOB NUMBER
0012

SHEET NAME
3/4" SCALE WALL SECTIONS

SHEET NUMBER
A806