


NOTE:
 ORIENTATION OF VERTICAL REINFORCEMENT IN
 PIERS AND DOWNELS TO WALLS ARE CRITICAL
 AND MUST BE PLACED AS SHOWN IN DETAILS.
 SEE ARCHITECTURAL DRAWINGS FOR LAYOUT
 DIMENSIONS OF WALLS.

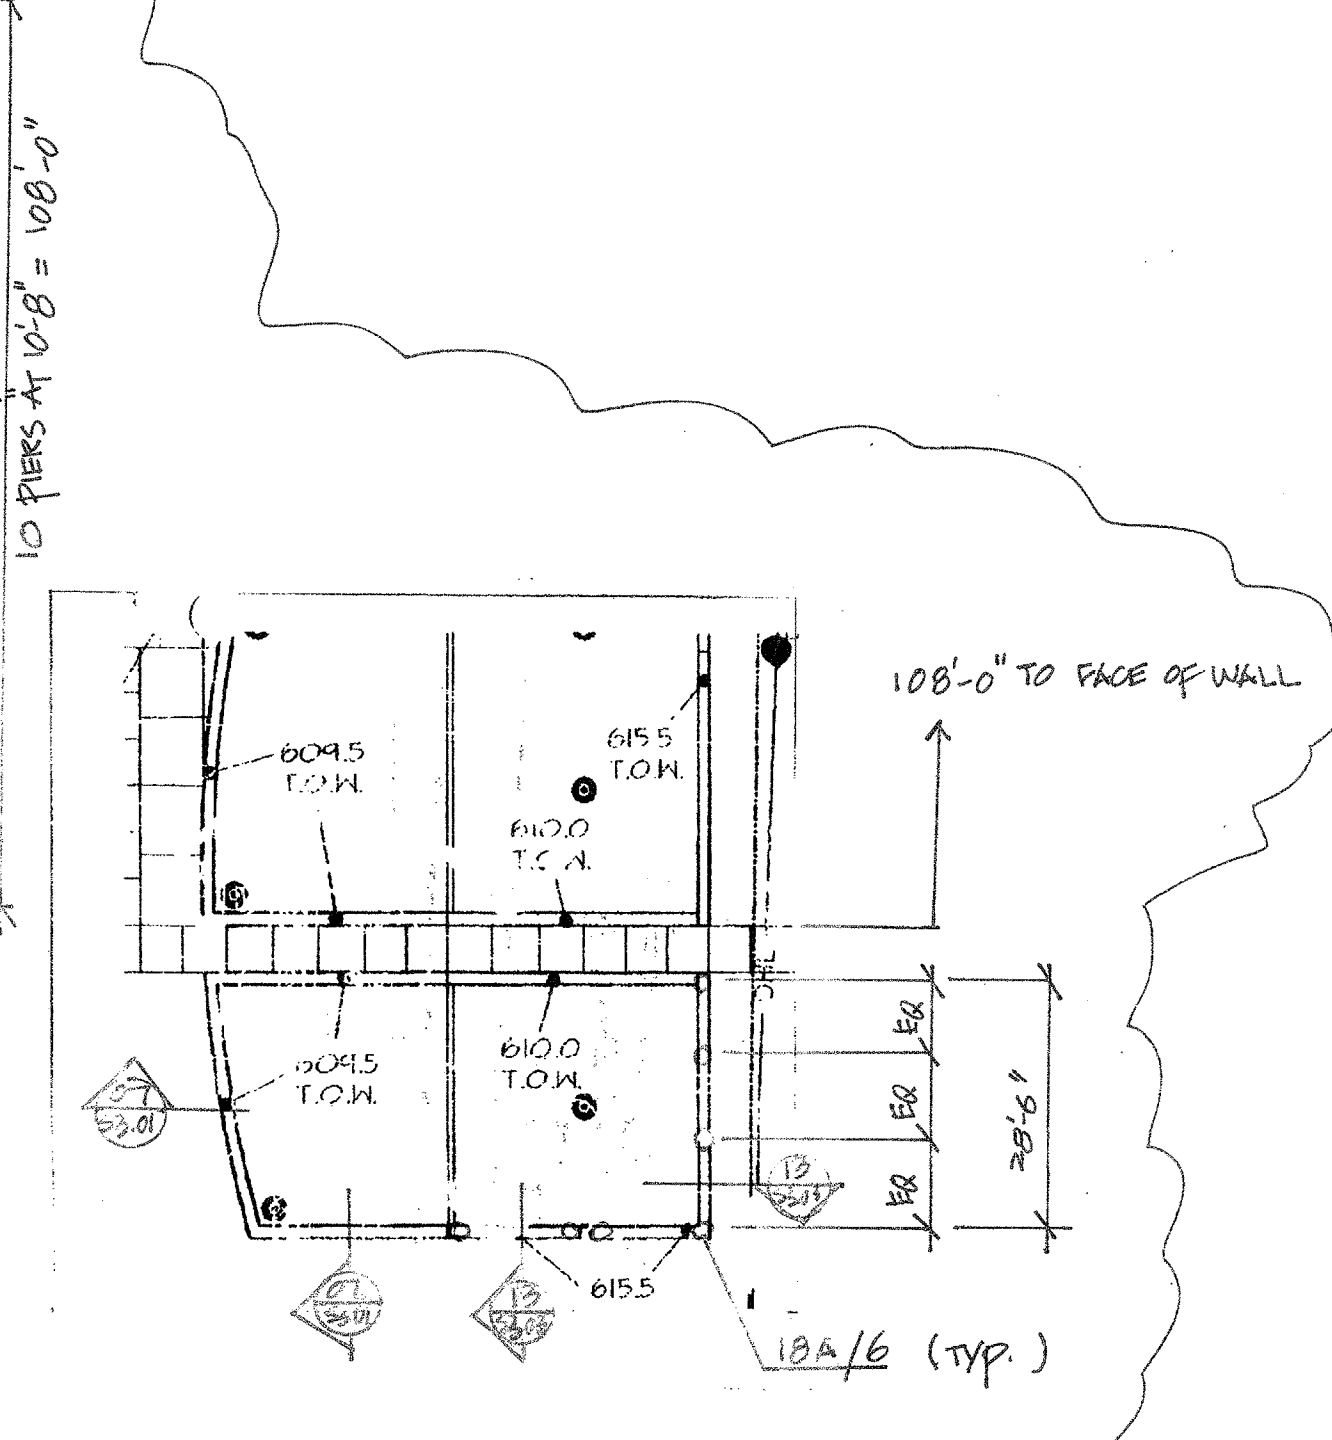

REVISED PER ASI 10, DATED 08-13-02

| DRAWING INDEX | |
|----------------------------|-------|
| GENERAL NOTES | S1.01 |
| DEMO PLAN | S2.00 |
| TYPICAL FOUNDATION DETAILS | S3.01 |
| PIER SCHEDULE | S3.01 |
| TYPICAL POOL DETAILS | S3.02 |
| TYPICAL CMU DETAILS | S4.01 |
| TYPICAL FLOOR DETAILS | S5.01 |
| TYPICAL ROOF DETAILS | S6.01 |

01 RETAINING WALL PLAN
 S2.05 1/8"=1'-0"