


ADDISON ATHLETIC CLUB EXPANSION  
AND  
LEISURE POOL  
ADDISON, TEXAS

RON HOBBS ARCHITECTS

614 W. MAIN ST., SUITE #200 GARLAND, TEXAS 75040  
(972) 494-0174

Lee & Baldauf  
Consulting Engineers Inc.  
15080 Parkview Drive  
Dallas, Texas 75244  
214-342-2800  
214-342-0389 Fax 214-342-2800




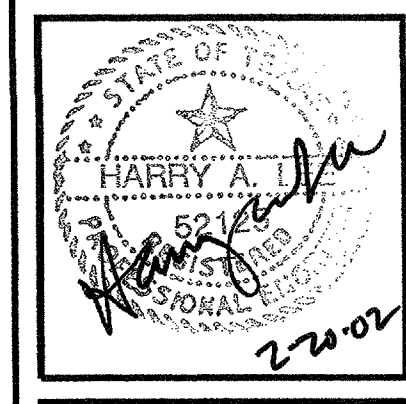


JOB NUMBER  
**0012**

JOB NAME  
ADDISON ATHLETIC CLUB  
EXPANSION & LEISURE POOL

SHEET DESCRIPTION  
**STEEL  
SECTIONS & DETAILS**

SHEET NUMBER  
**S6.01**

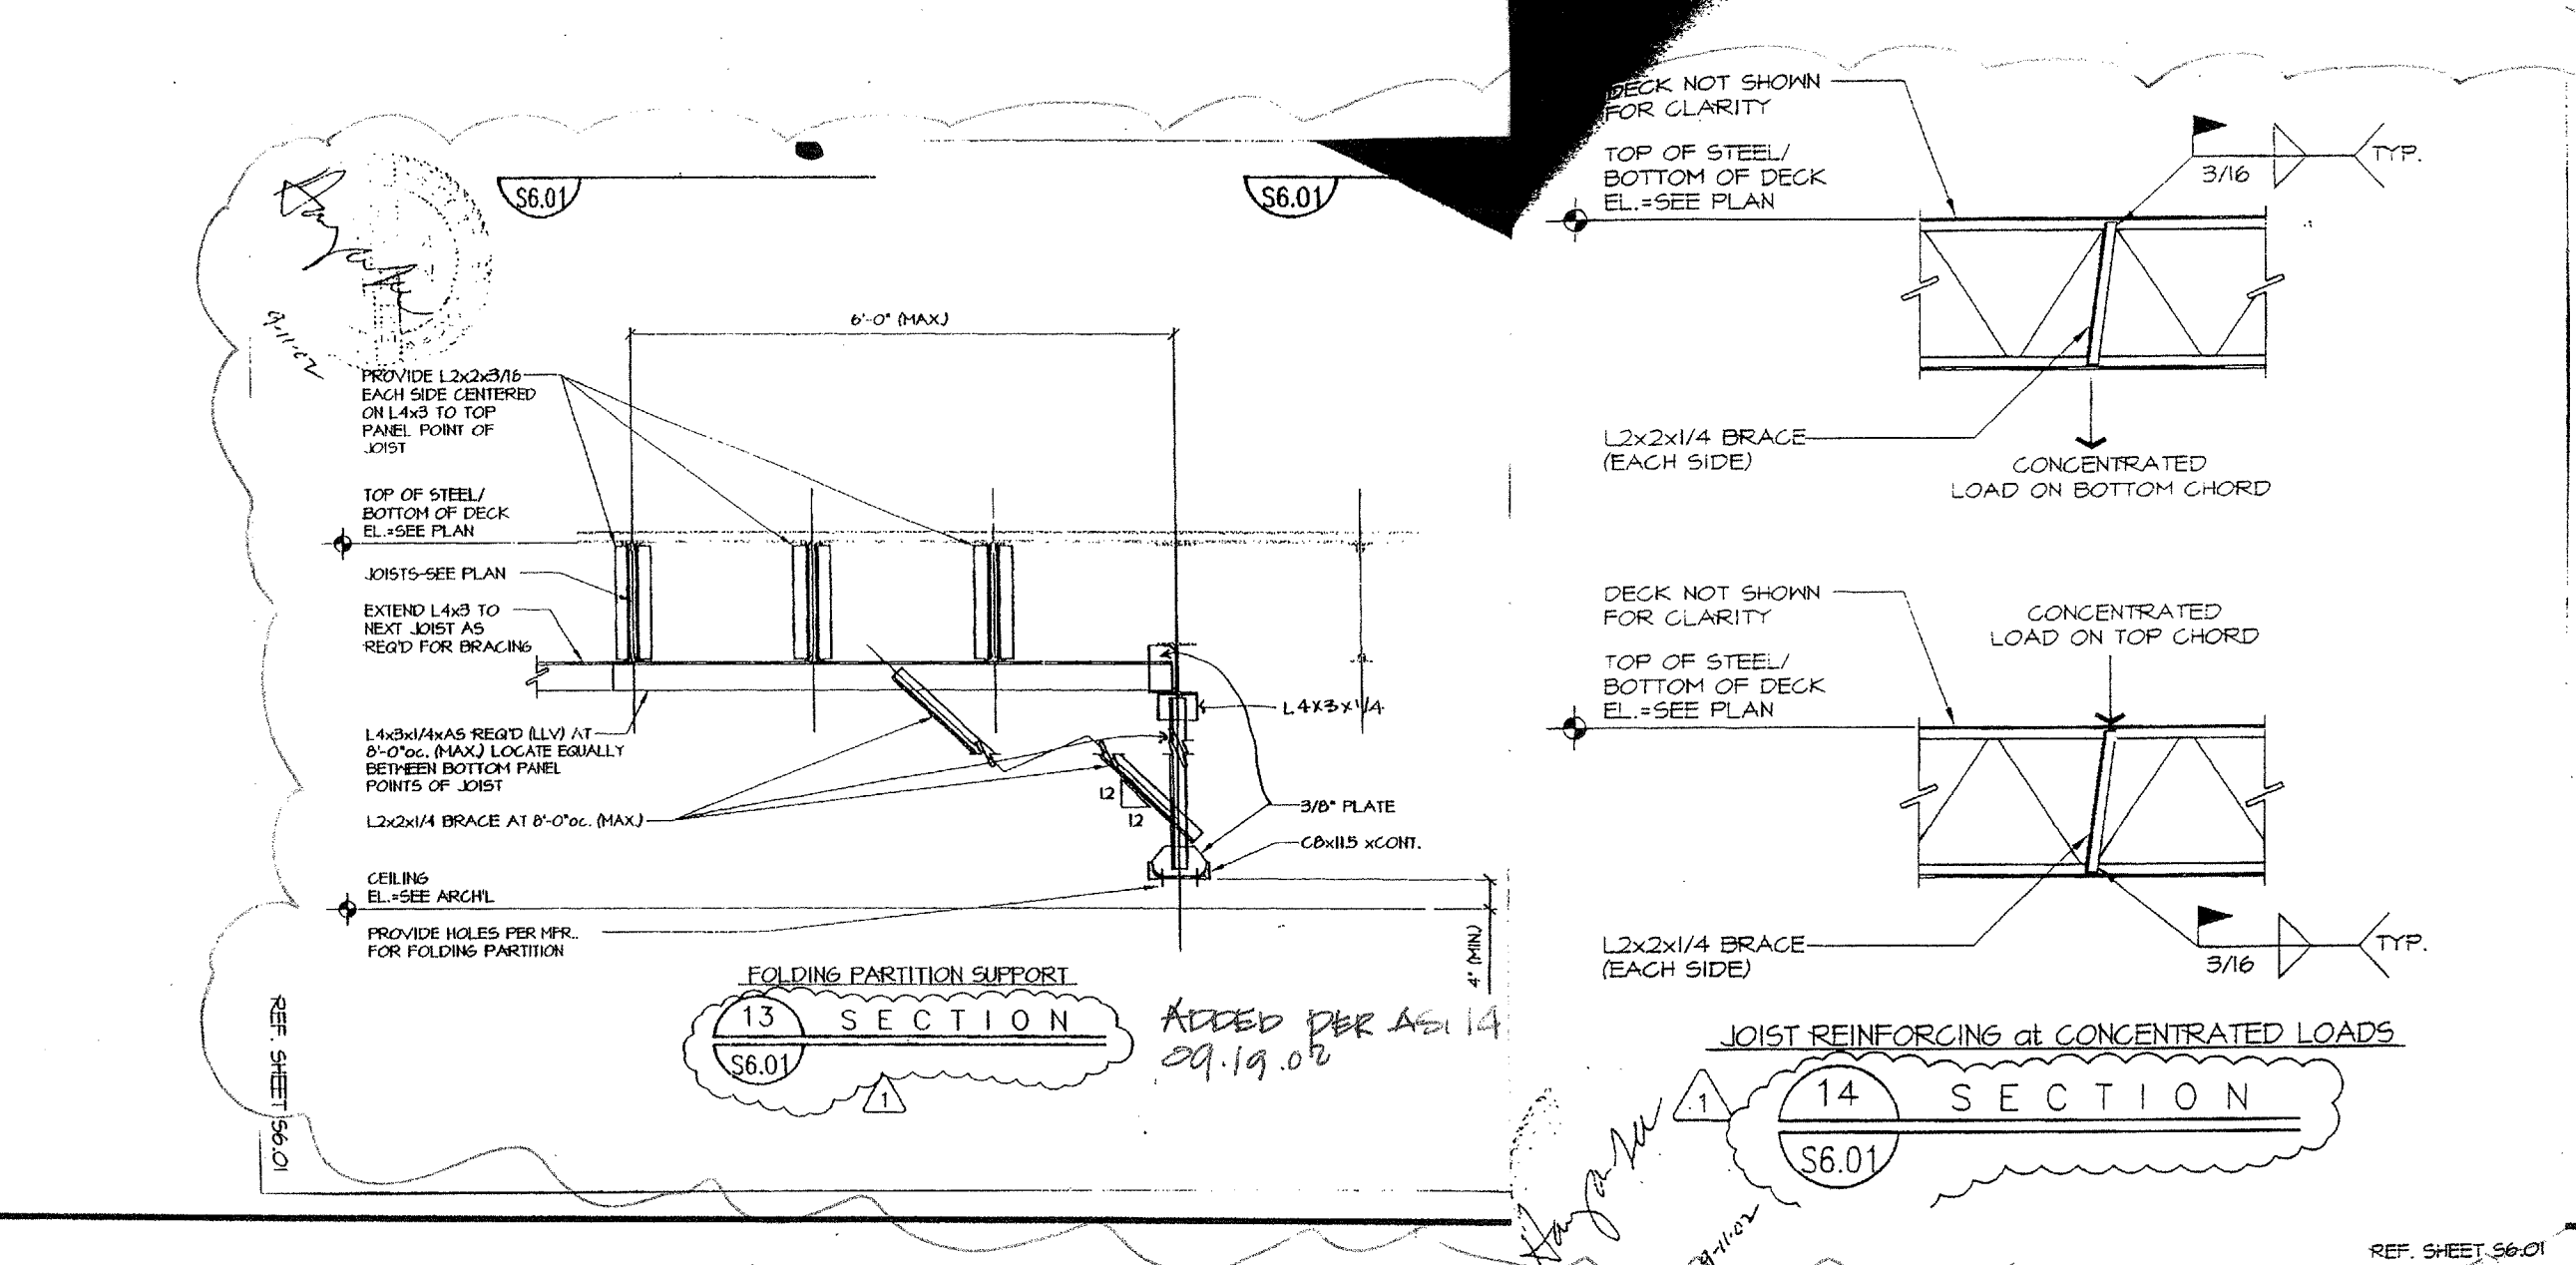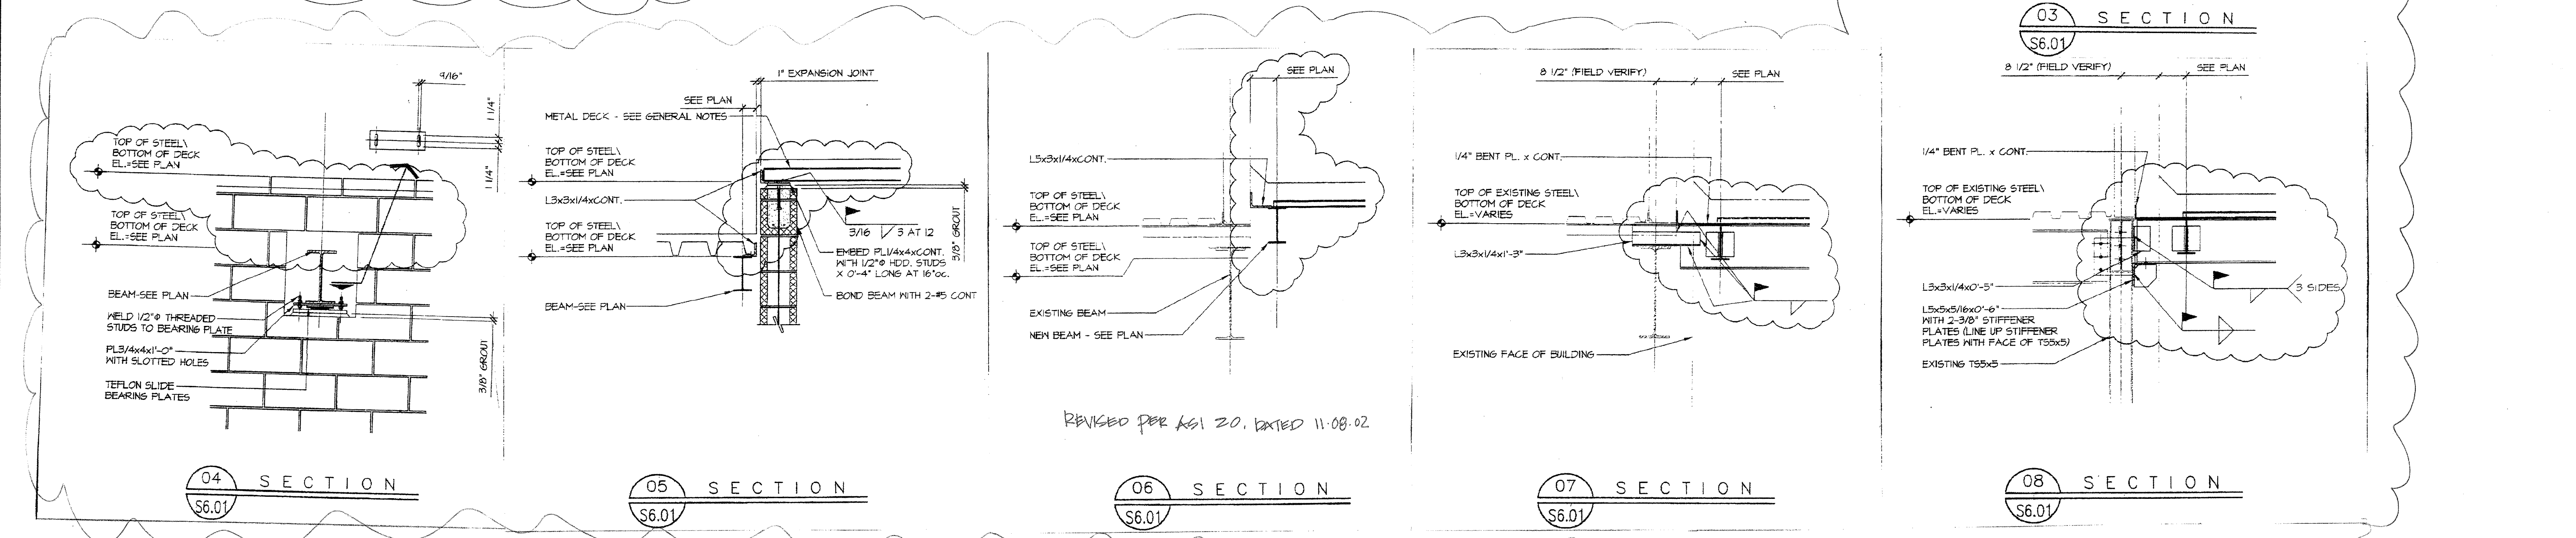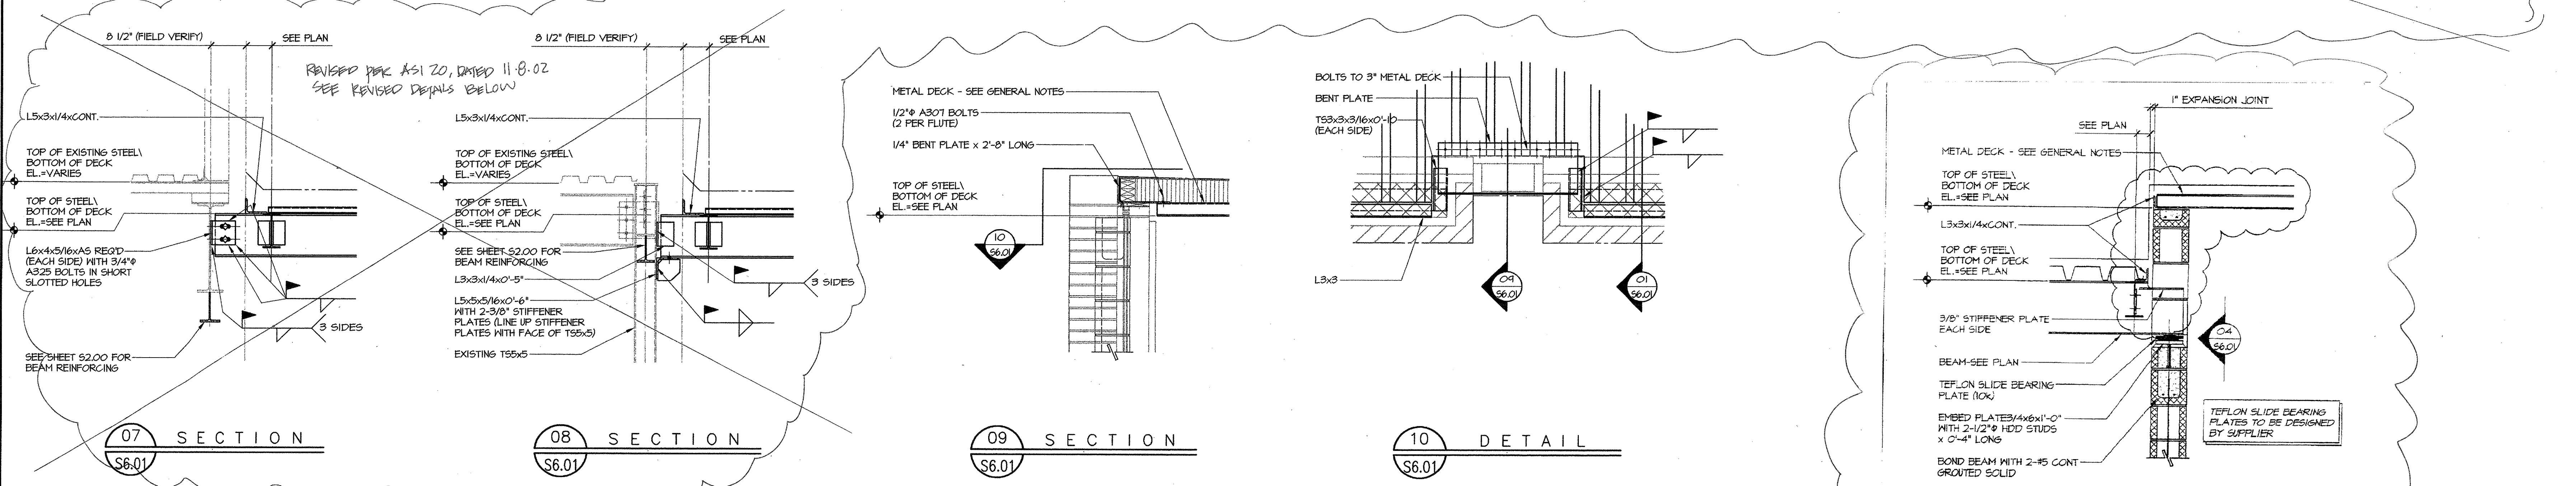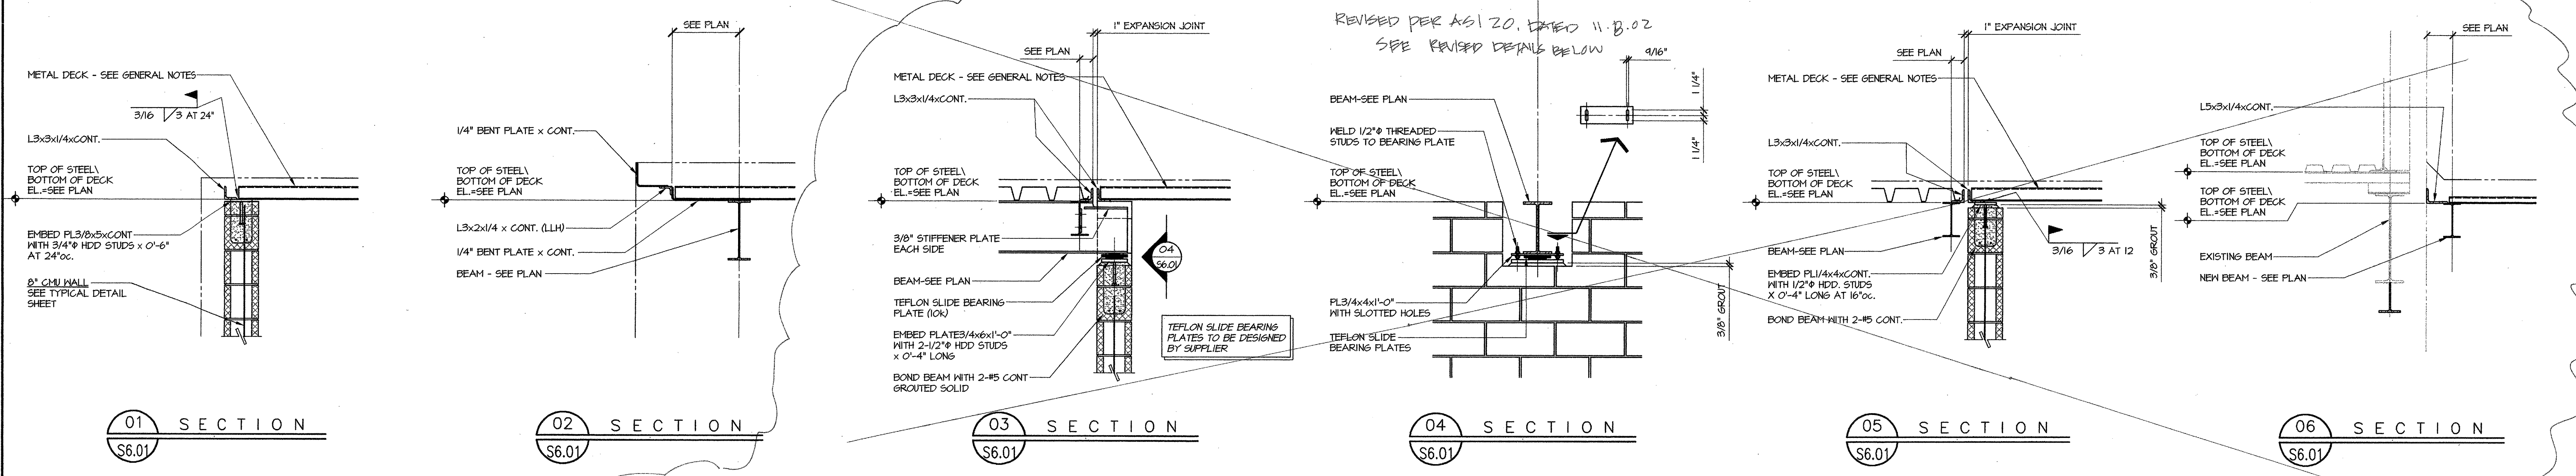

200010-00 02-20-02