


SHEET NO.	
BASE	
COMPOSITE	
CLAS	
DATE	
BY	
CHK'D	
DATE	
BY	
CHK'D	
DATE	
BY	

ADDISON RECREATION CENTER
 3900 BELTWAY DRIVE
 ADDISON, TEXAS

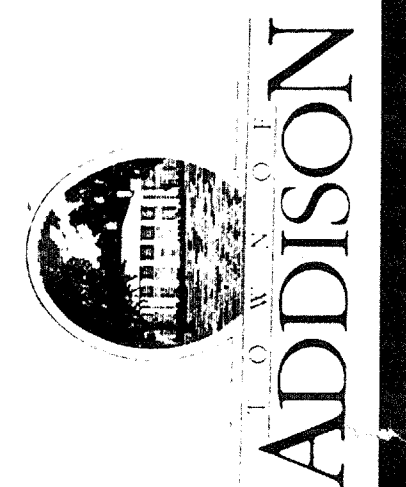

The Benham Group Dallas
 architects
 engineers
 planners

1341 w. mockingbird ln.
 suite 517 e
 dallas, texas




Sheet title
GROUND FLOOR PLAN

drawn H. ADAMS
 chkd H. ADAMS
 date 3-19-88
 revisions

no. date
 4-21-86

sheet of **A-1**

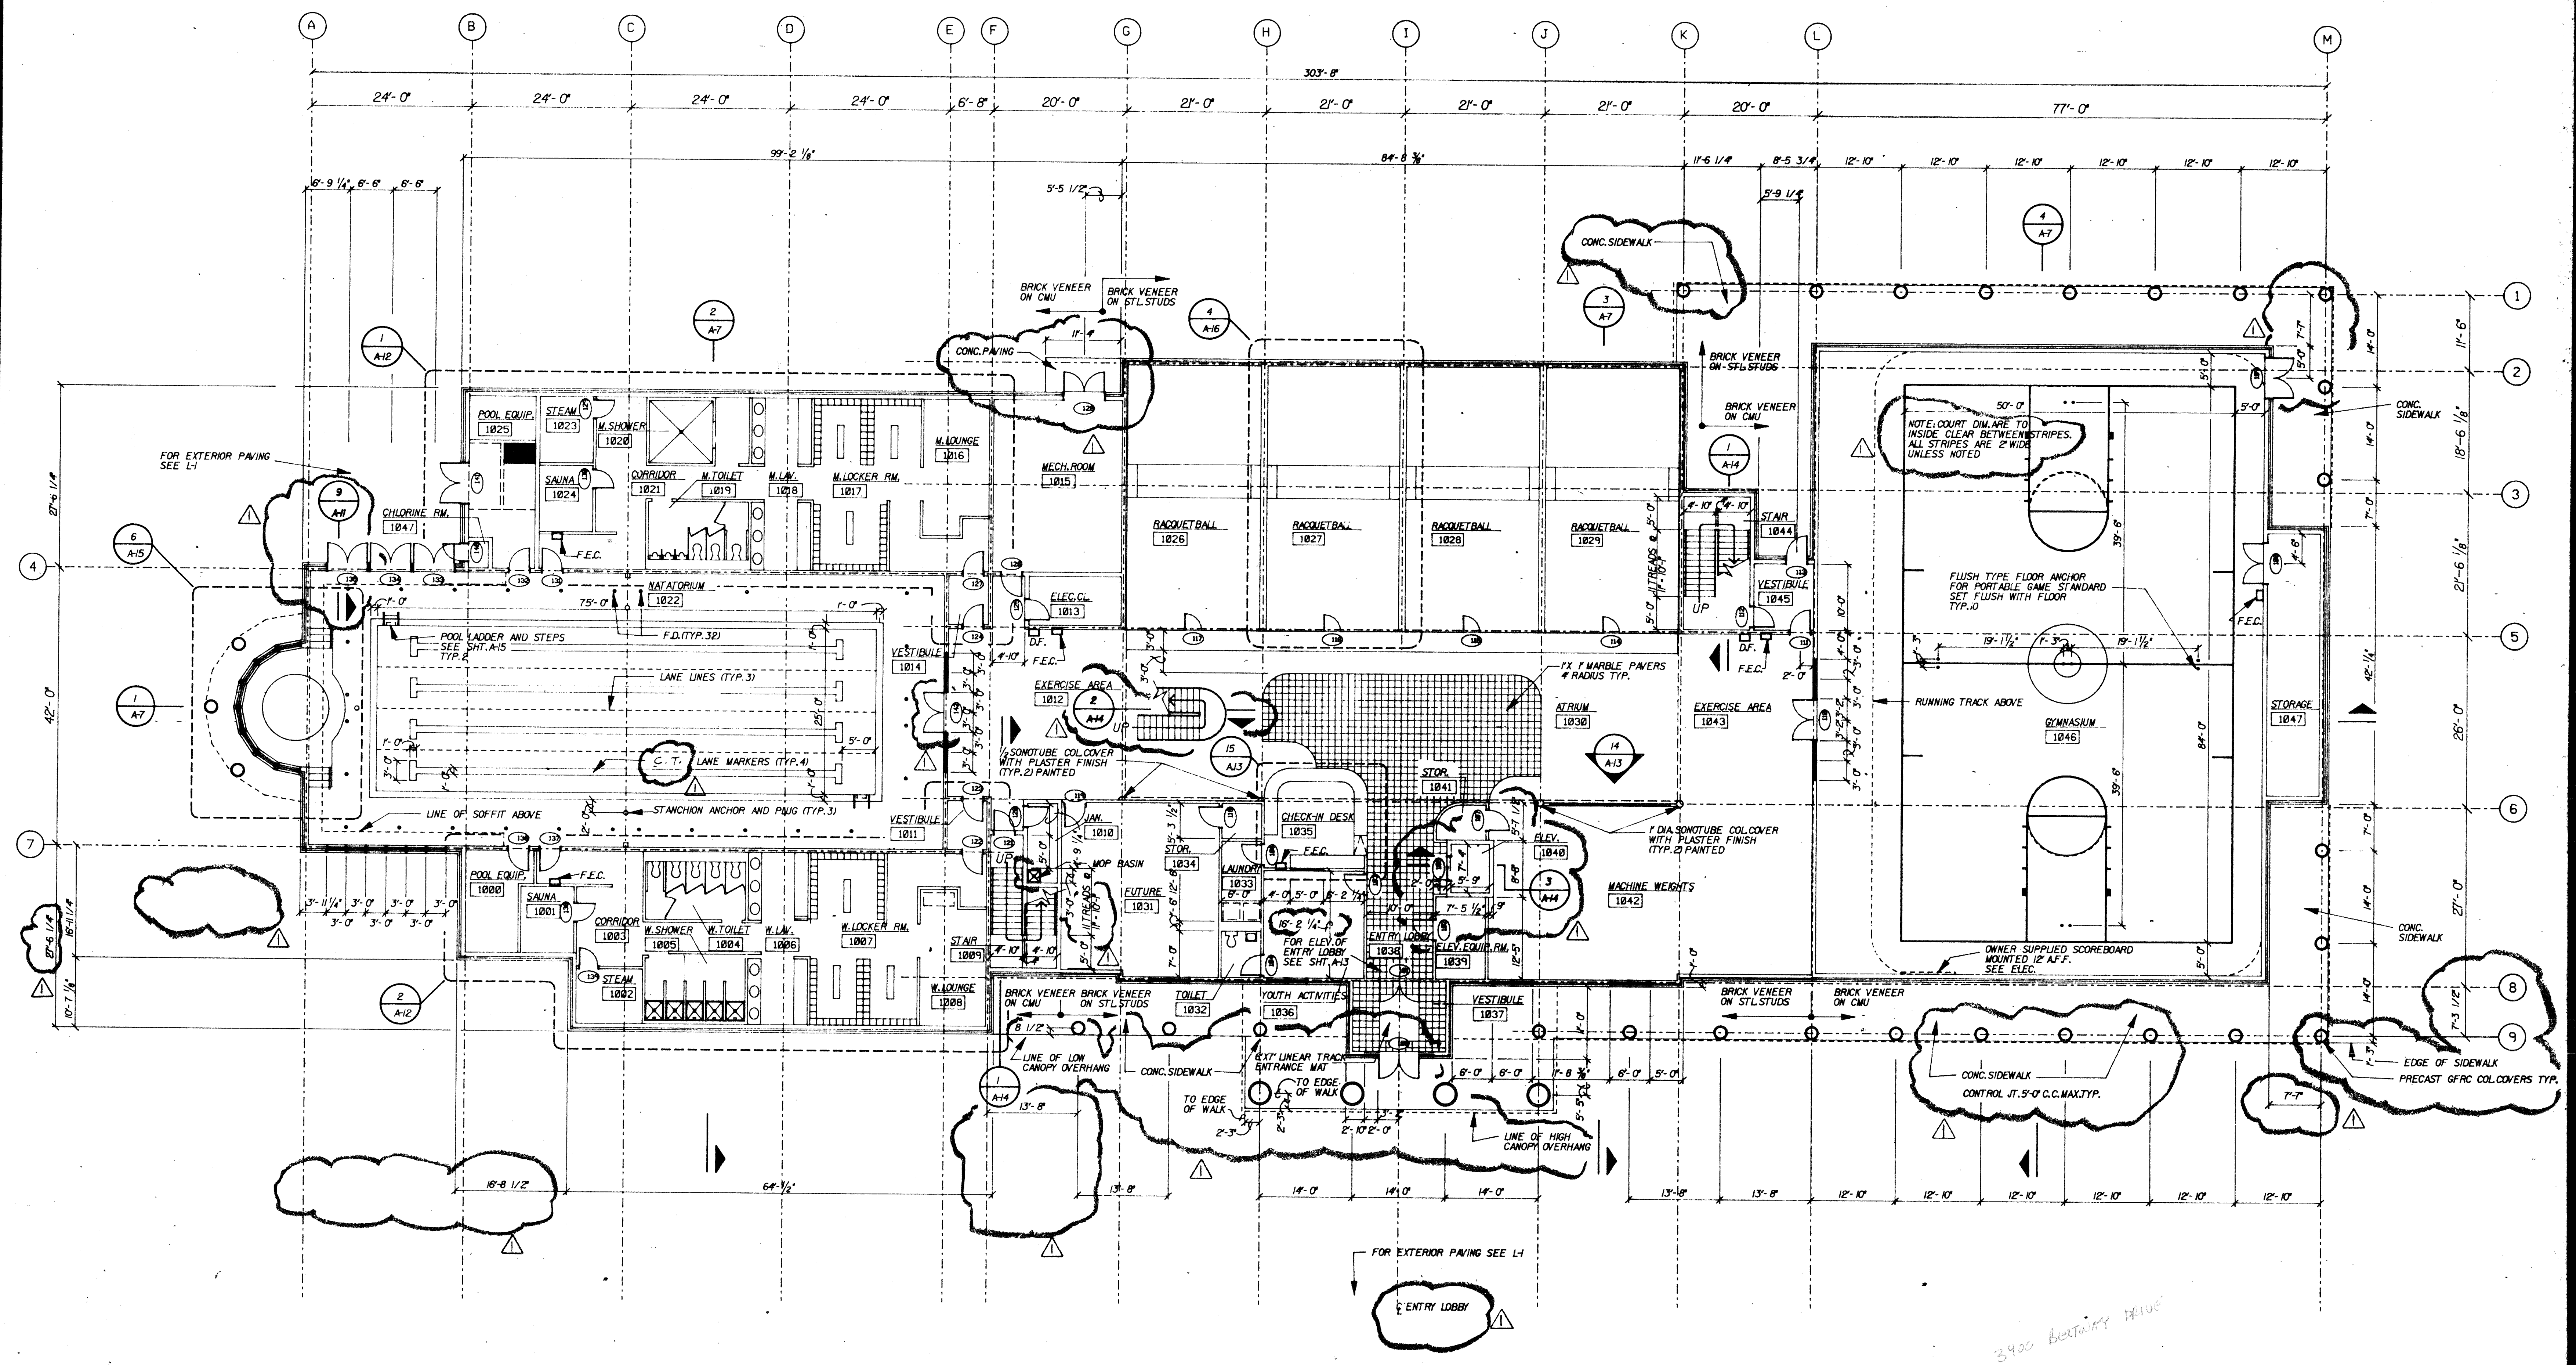

GROUND FLOOR PLAN
 SCALE: 3/32"=1'-0"

3900 BELTWAY DRIVE