



SHEET NO	
BASE	
C	
L	
A	
S	
I	
M	
E	

**ADDISON RECREATION CENTER**  
 3900 BELTWAY DRIVE  
 ADDISON, TEXAS

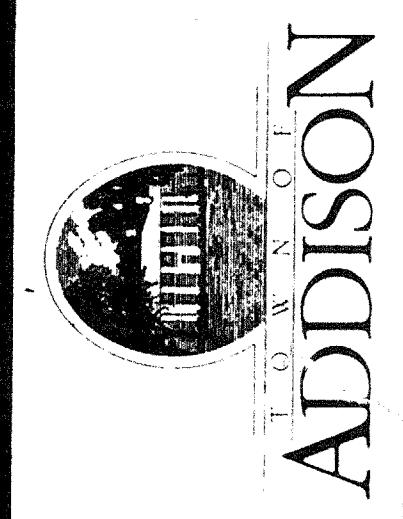

**The Benham Group**  
 Dallas

architects  
 engineers  
 planners  
 1341 w. mockingbird ln.  
 suite 517 e  
 dallas, texas

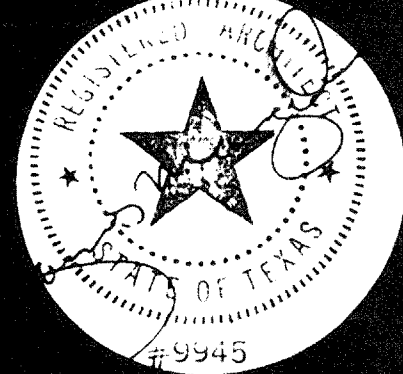

sheet title


**SITE PAVING PLAN**

drawn **J. MORROW**  
 chkd **J. MORROW**  
 date **4-3-86**


revisions

no.	date
1	4-3-86
2	4-21-86


sheet of **L-1**

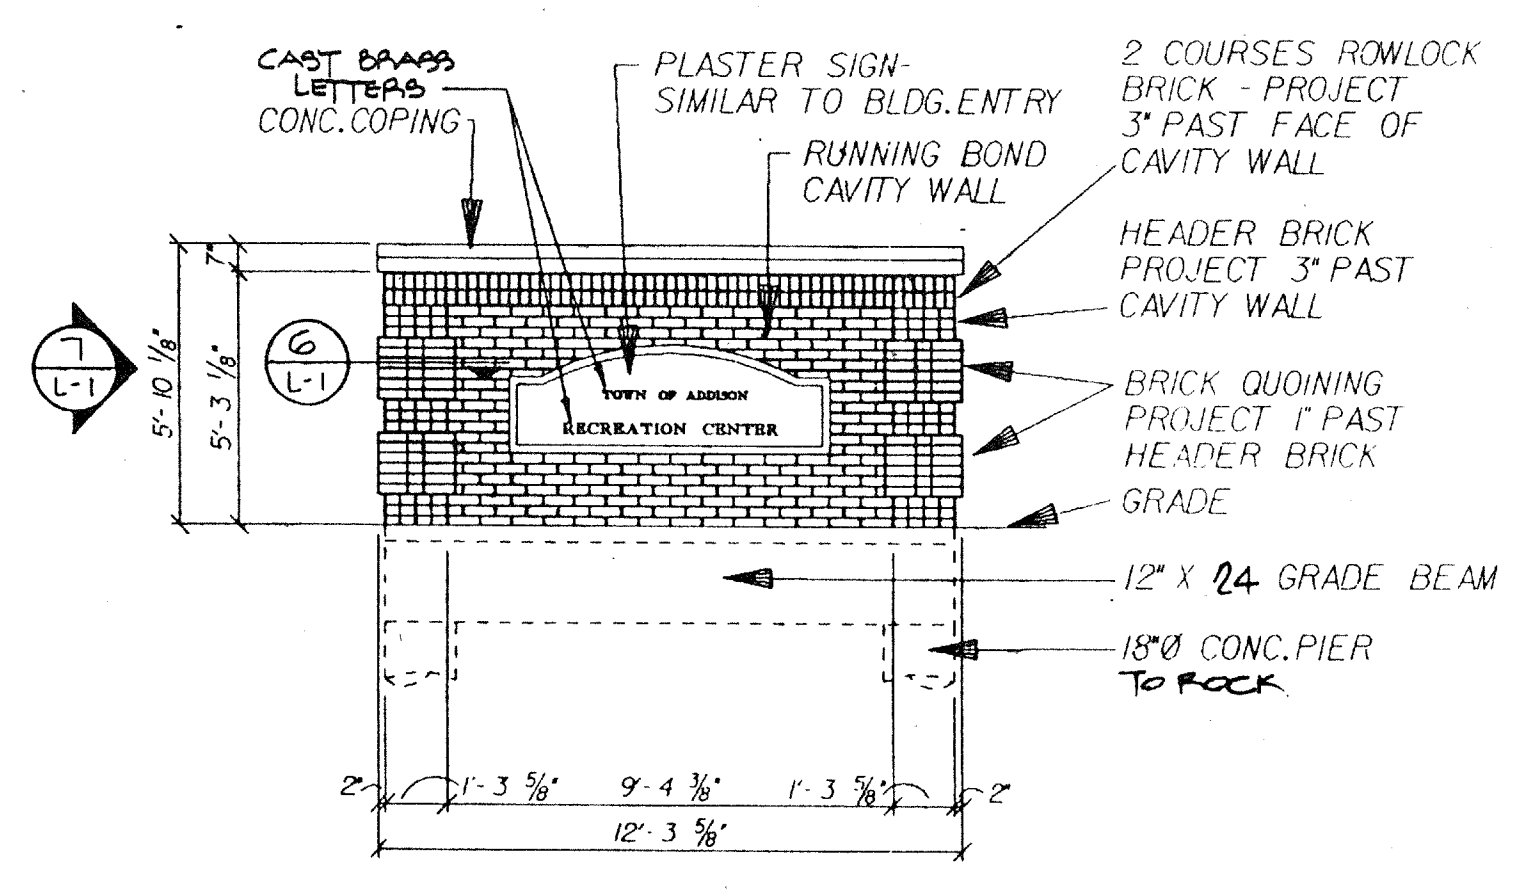


**5 ELEVATION** ENTRANCE SIGN  
 1/4" = 1'

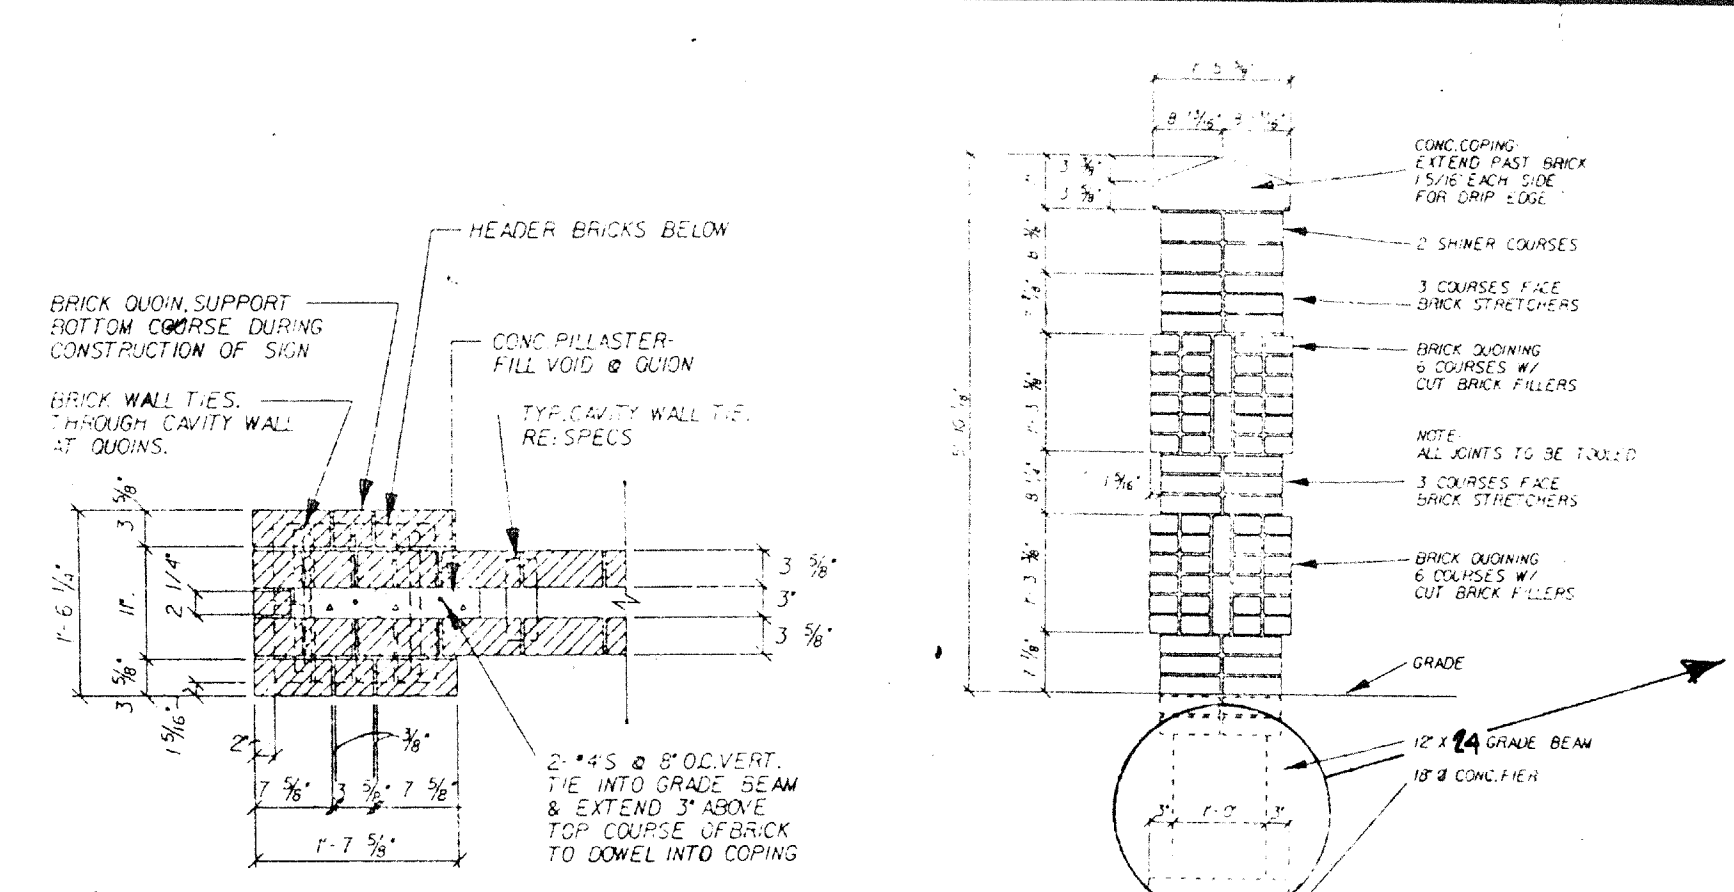


**6 PLAN @ SIGN QUOIN**

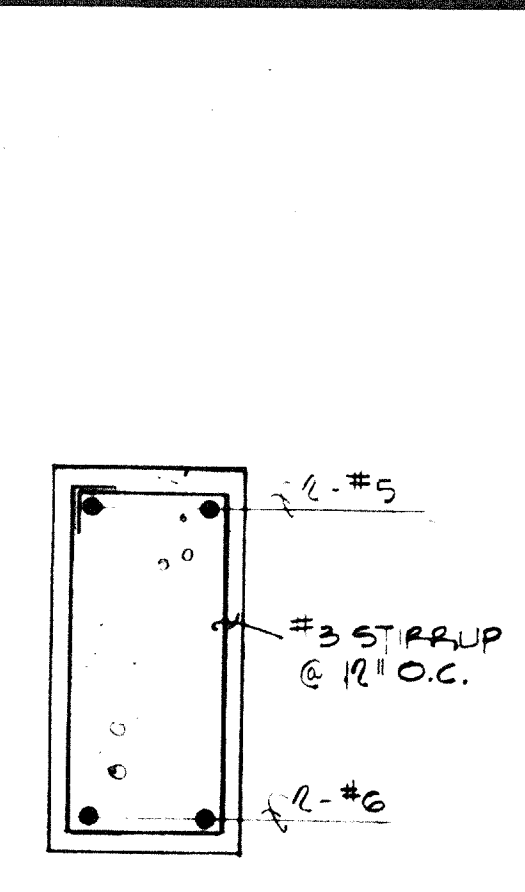


**7 ELEVATION** ENTRANCE SIGN

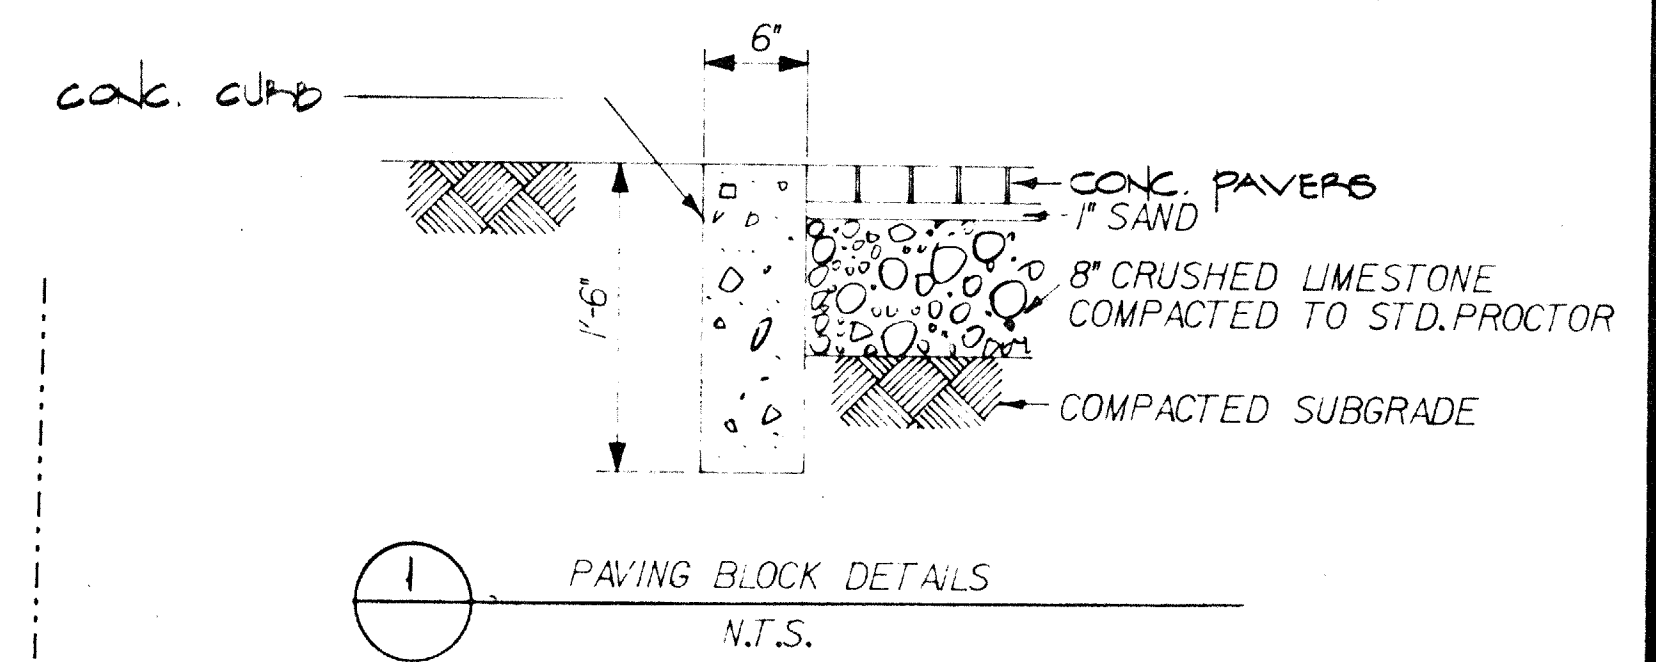


**1 PAVING BLOCK DETAILS**  
 N.T.S.

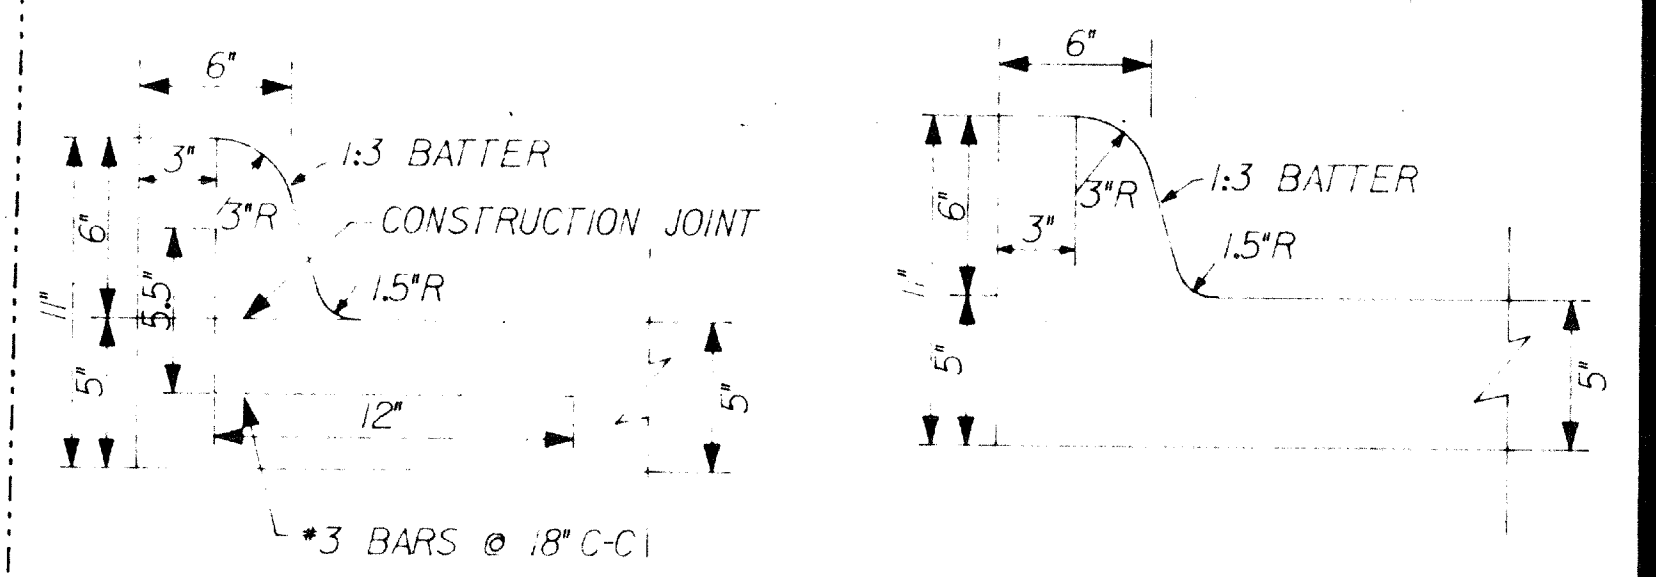

**2 ALTERNATE CURB DETAILS**  
 N.T.S.

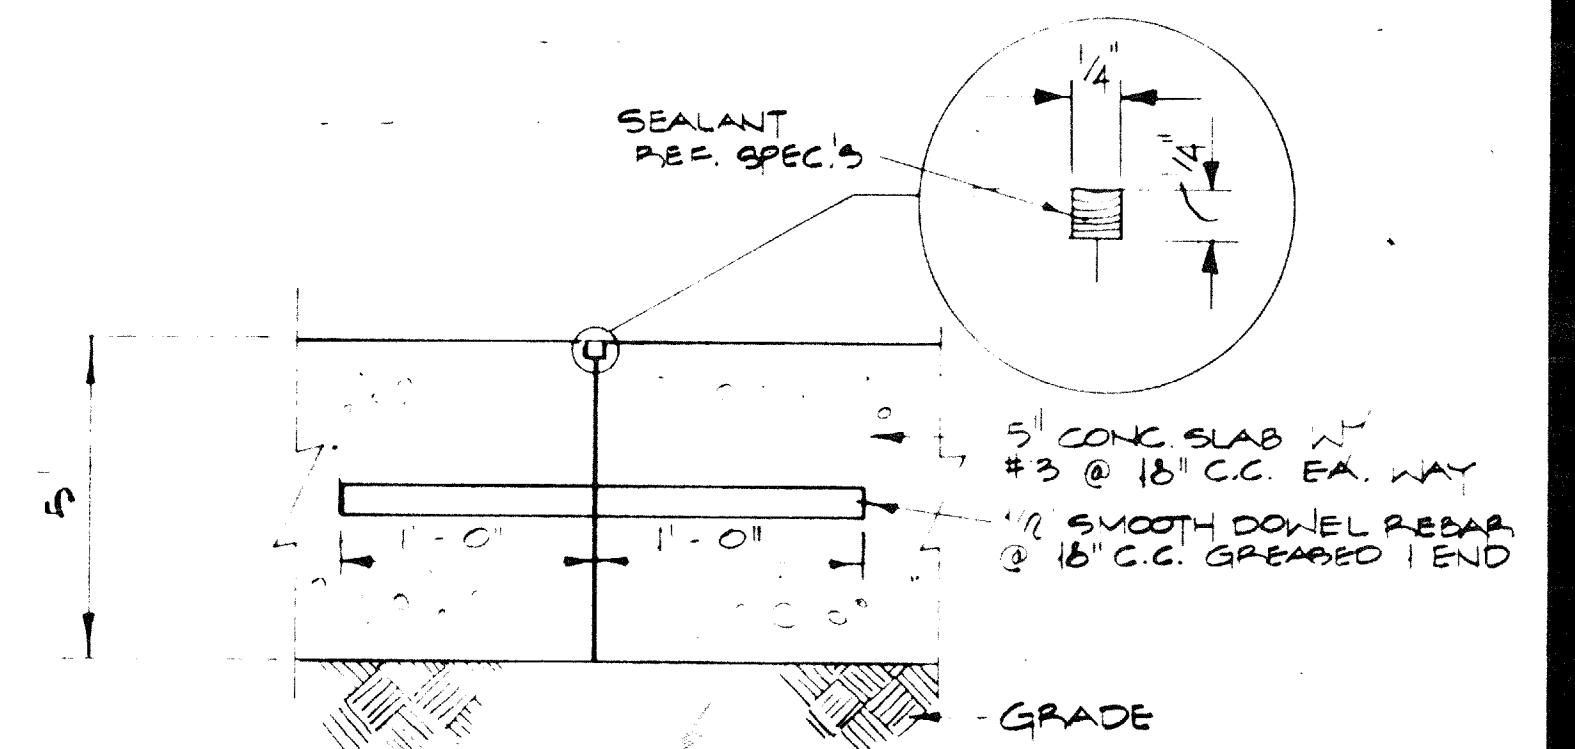


**3 PAVING JOINT DETAIL**  
 N.T.S.

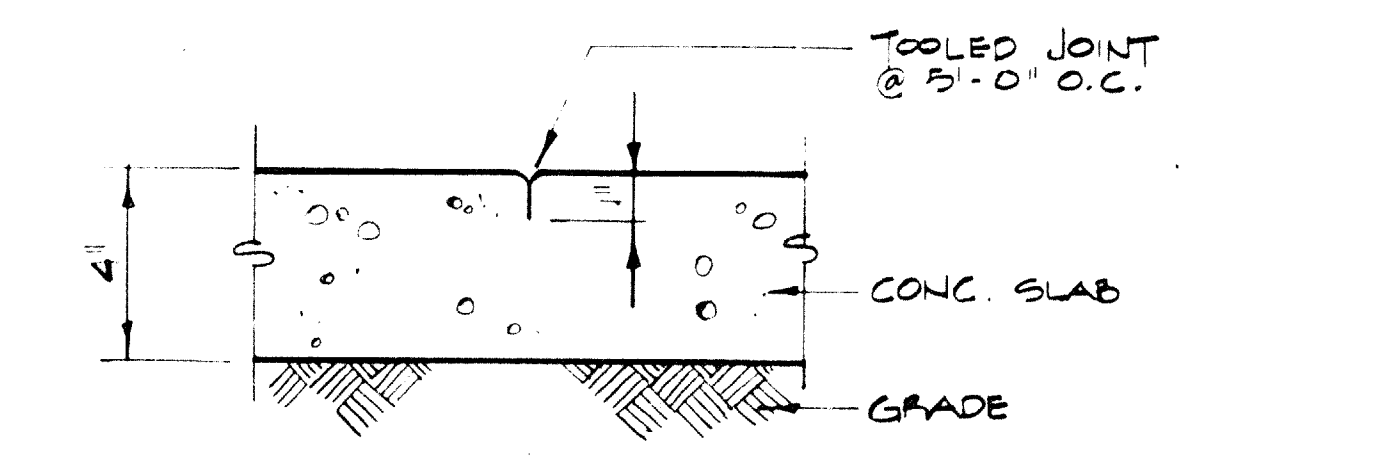

**4 DETAIL - ALL SIDEWALKS**  
 3/4" = 1'-0"

- NOTES:
- BENCH MARK: 5' ON TOP OF CURB AT CURB RETURN EAST SIDE OF SURVEYOR BLVD. AND NORTH SIDE OF BELT LINE ROAD. ELEVATION: 596.16
  - UTILITY LOCATIONS ARE APPROXIMATE FINAL LOCATION DETERMINED BY CONTRACTOR
  - FOR TURNING LANE DIMENSIONS SEE TOWN OF ADDISON DETAIL DRAWINGS

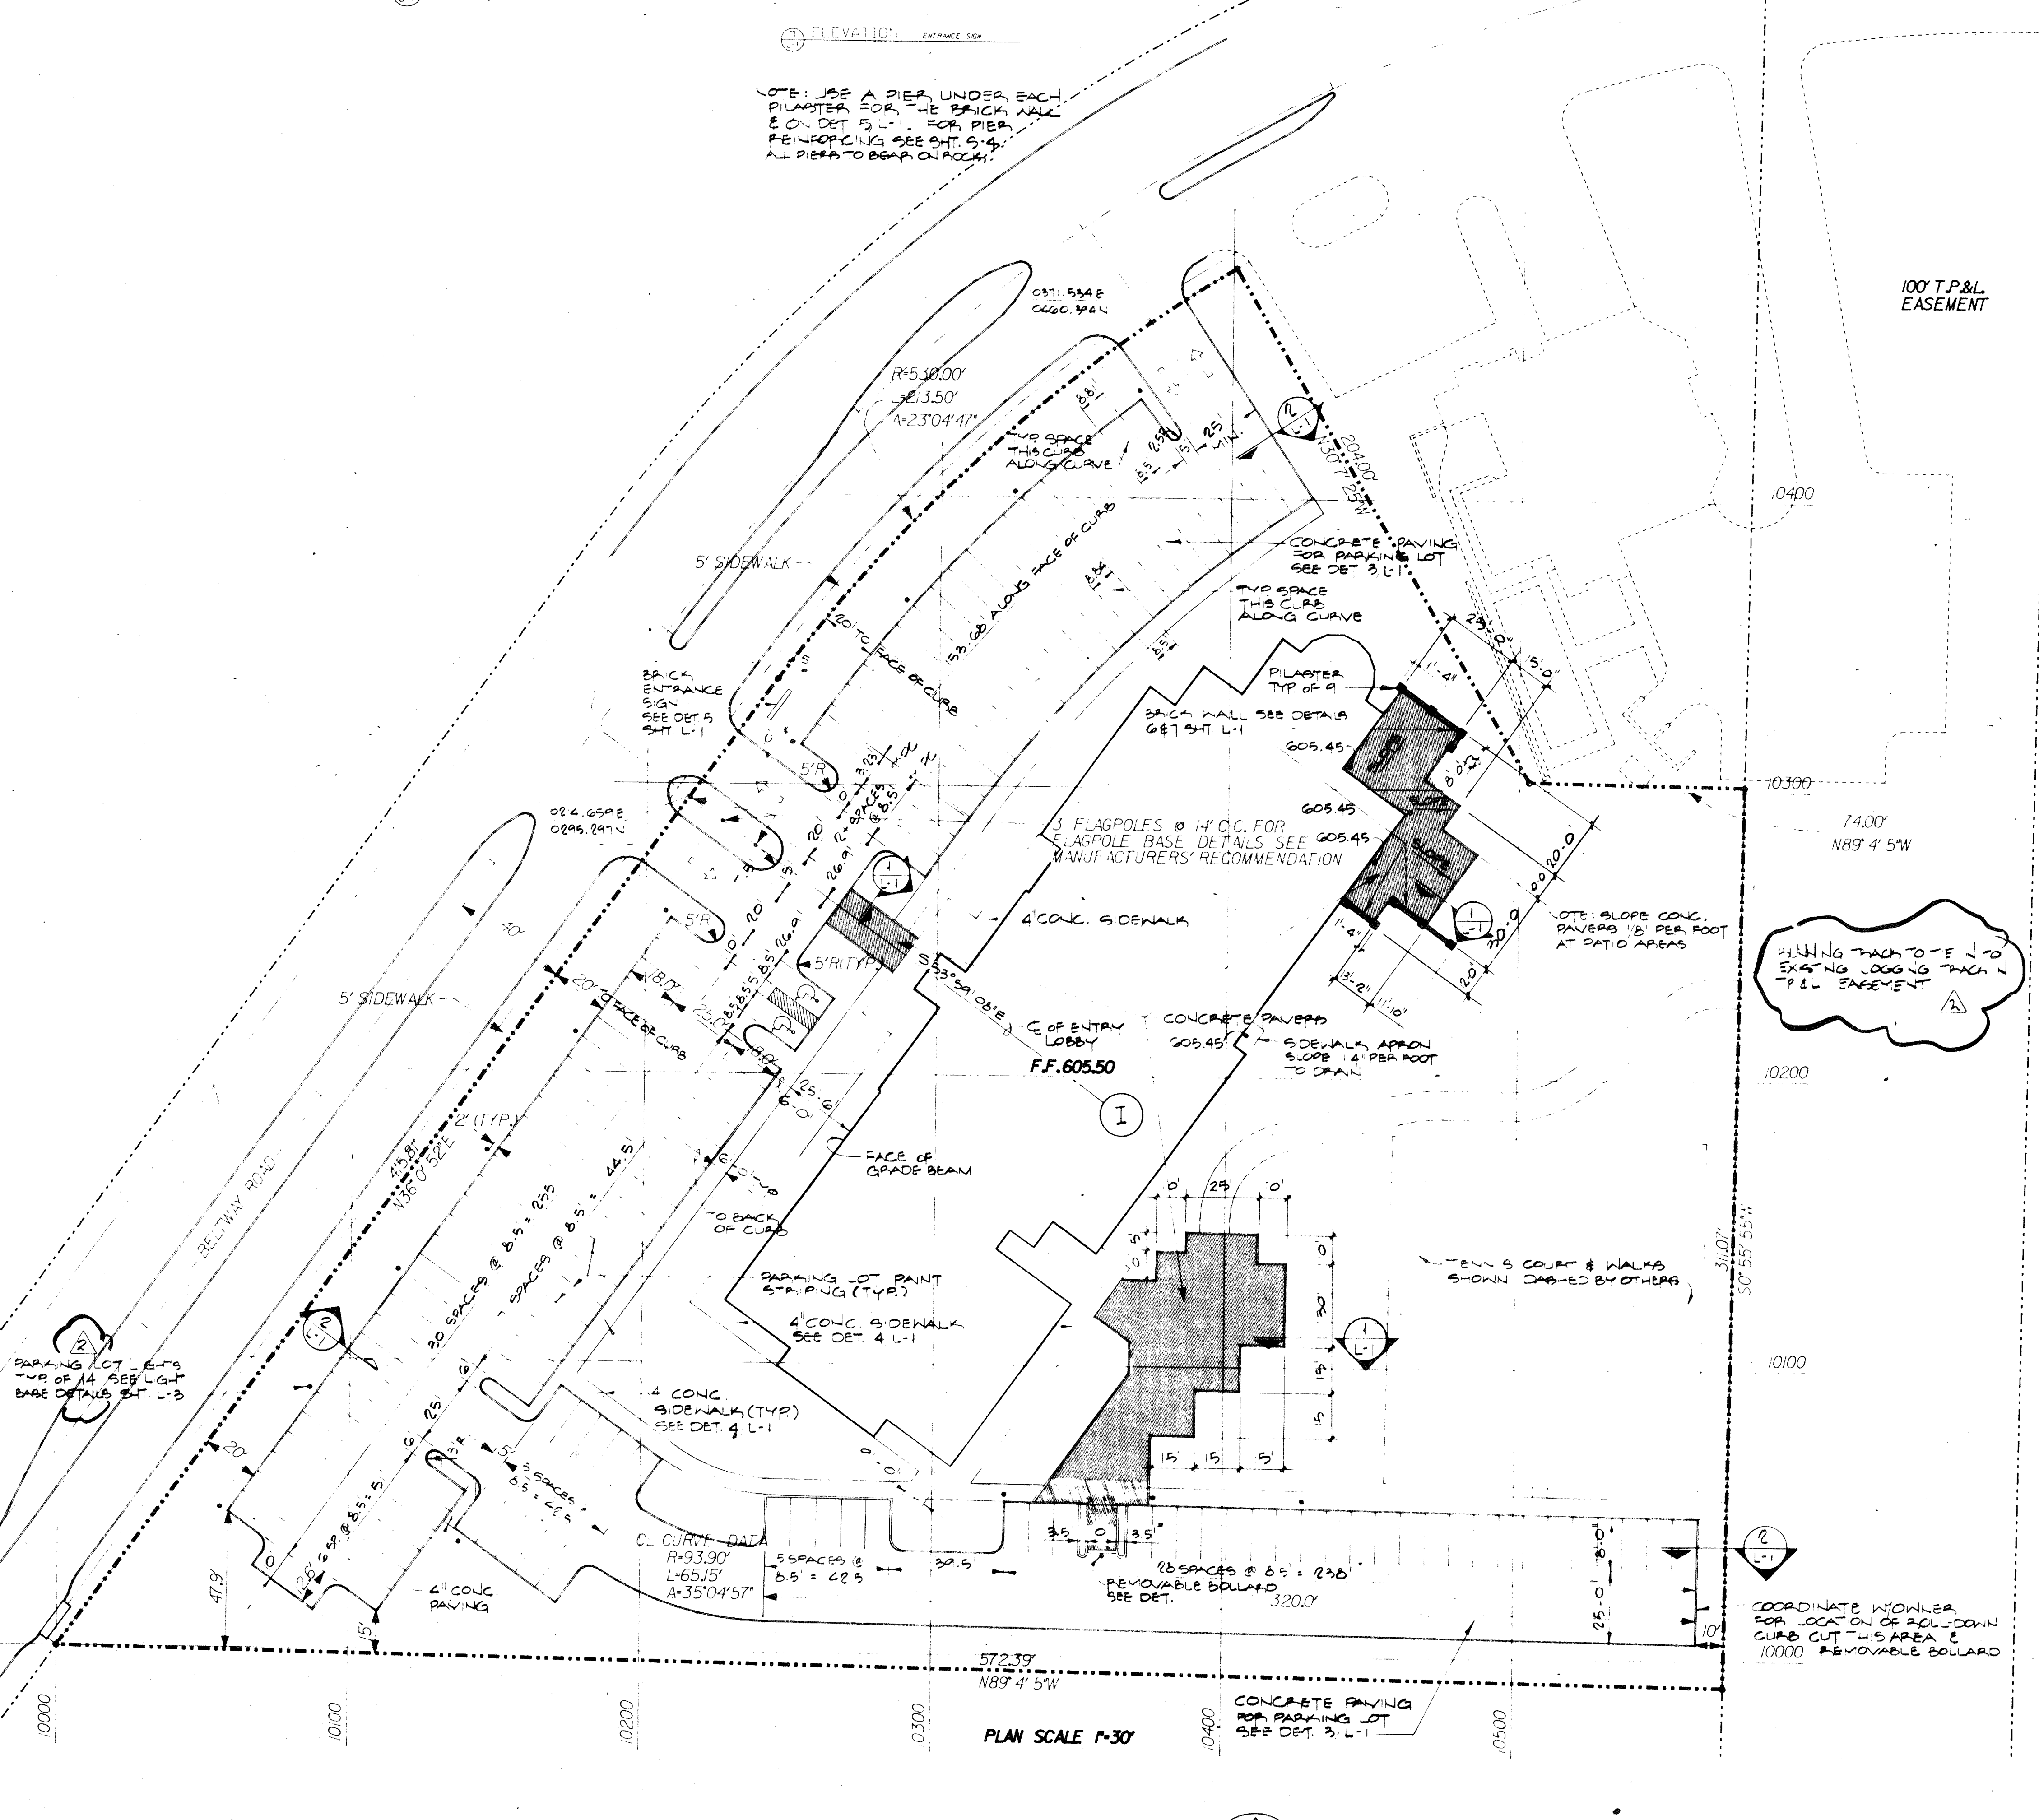

**SITE PAVING PLAN**  
 SCALE: 1" = 30'-0"

