


1 OPERABLE SKYLIGHT CURB
SCALE: 1/2" = 1'-0"

2 FIXED SKYLIGHT CURB
SCALE: 3/8" = 1'-0"

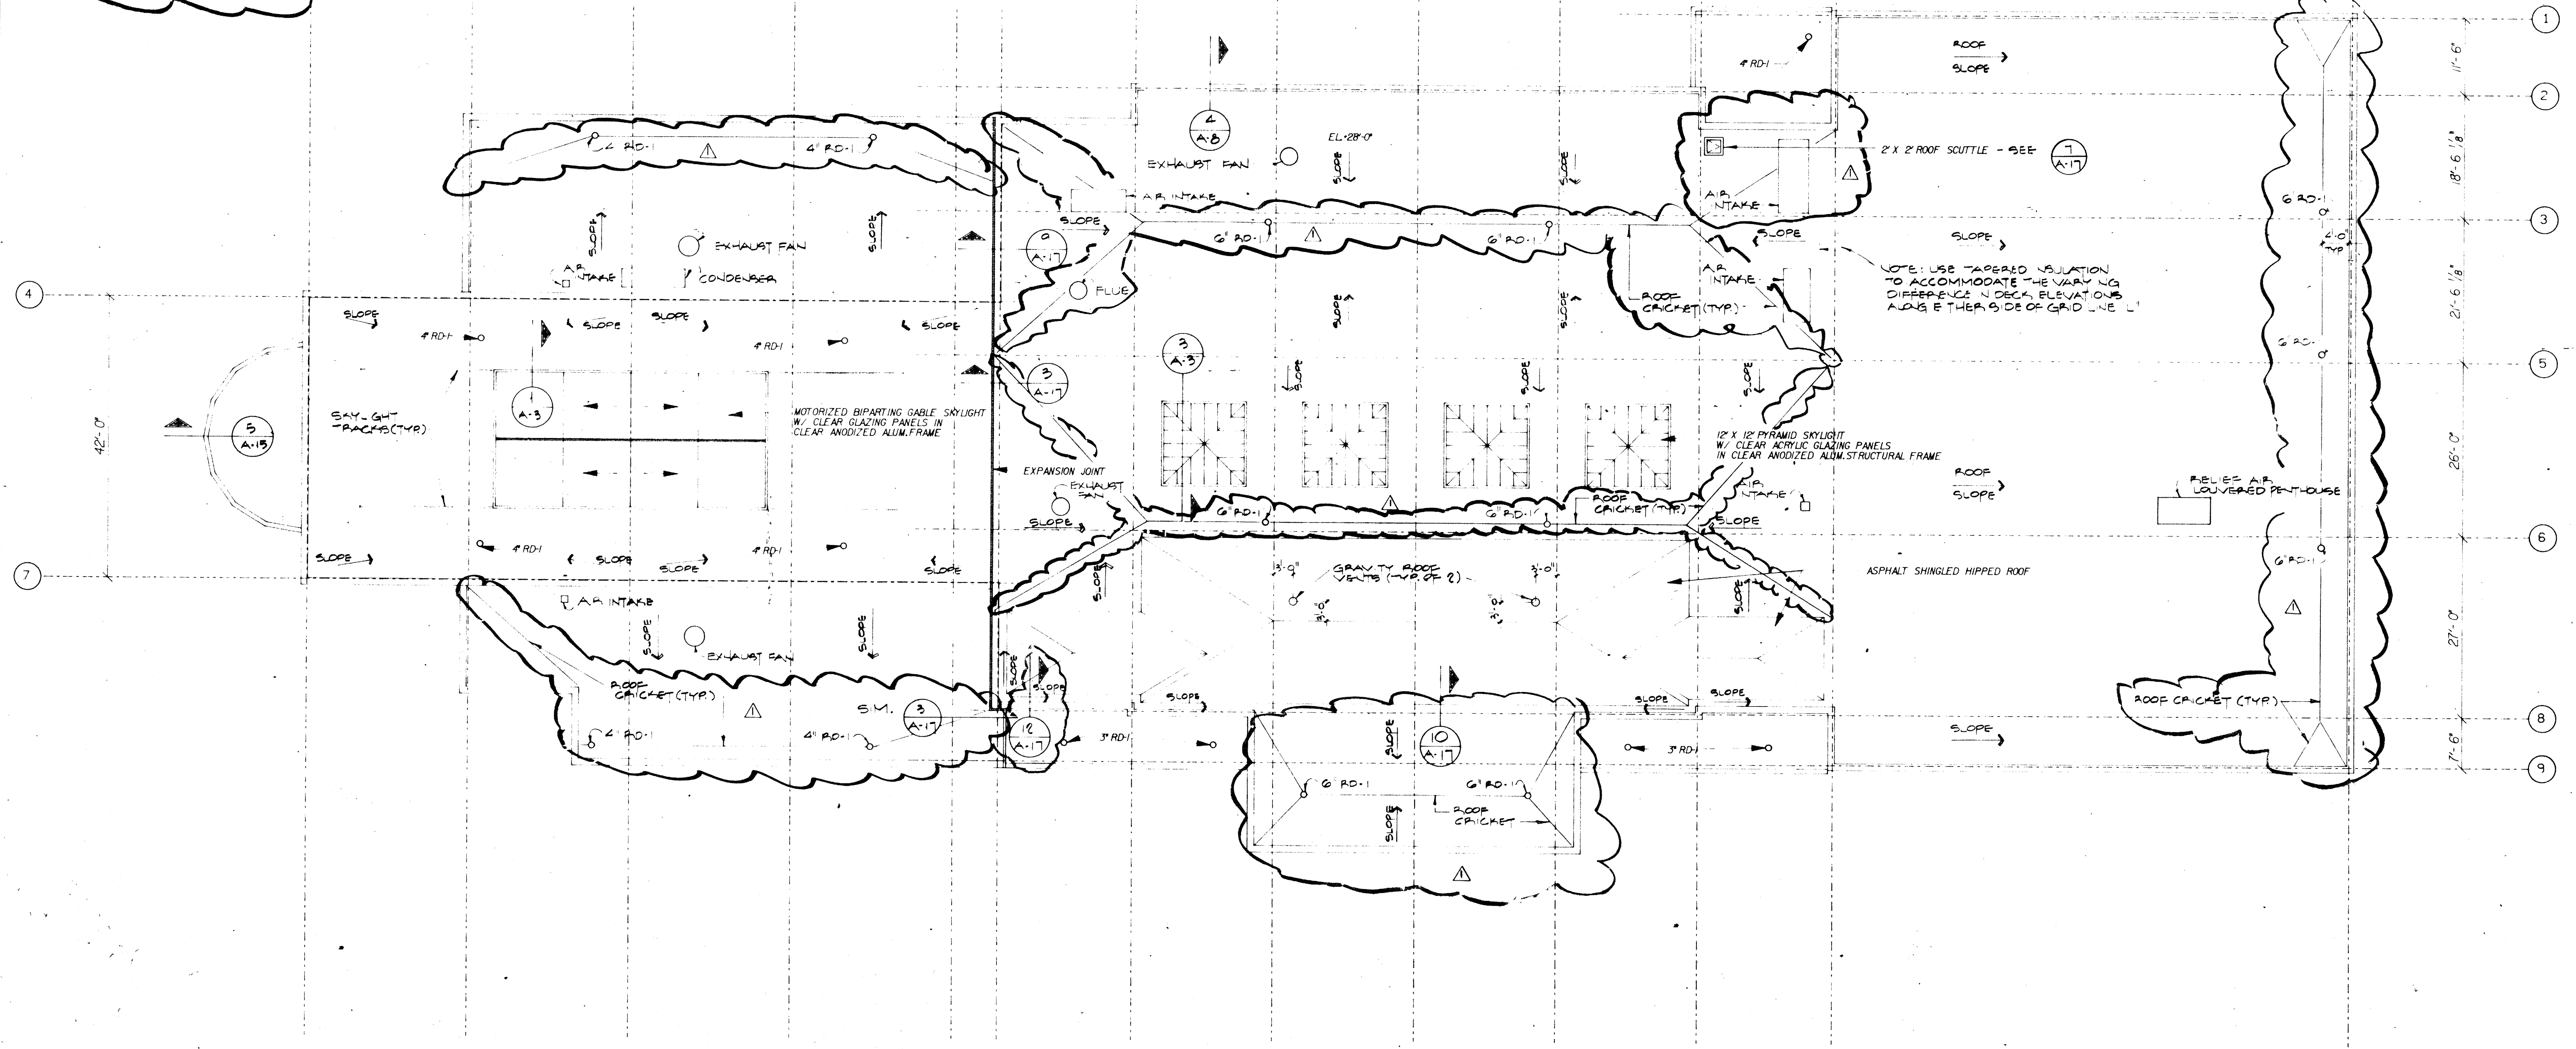

ROOF PLAN
SCALE: 3/32" = 1'-0"

SHEET NO.	
BASE	
C	
D	
E	
F	
G	
H	
I	
J	
K	
L	
M	

ADDISON RECREATION CENTER
3900 BELTWAY DRIVE
ADDISON, TEXAS

The Benham Group Dallas
architects
engineers
planners
1341 w. mockingbird ln.
suite 517 e
dallas, texas

sheet title
ROOF PLAN

drawn **M. BRENCLEY**
chk'd **H. ADAMS**
date **3-10-88**

revisions

no.	date
Δ	4/21/88

sheet of **A-3**