




SHEET NO.	
BASE	
COMPOSITE	
REV	
DATE	
BY	
CHKD	
DATE	
BY	
CHKD	
DATE	
BY	
CHKD	
DATE	
BY	

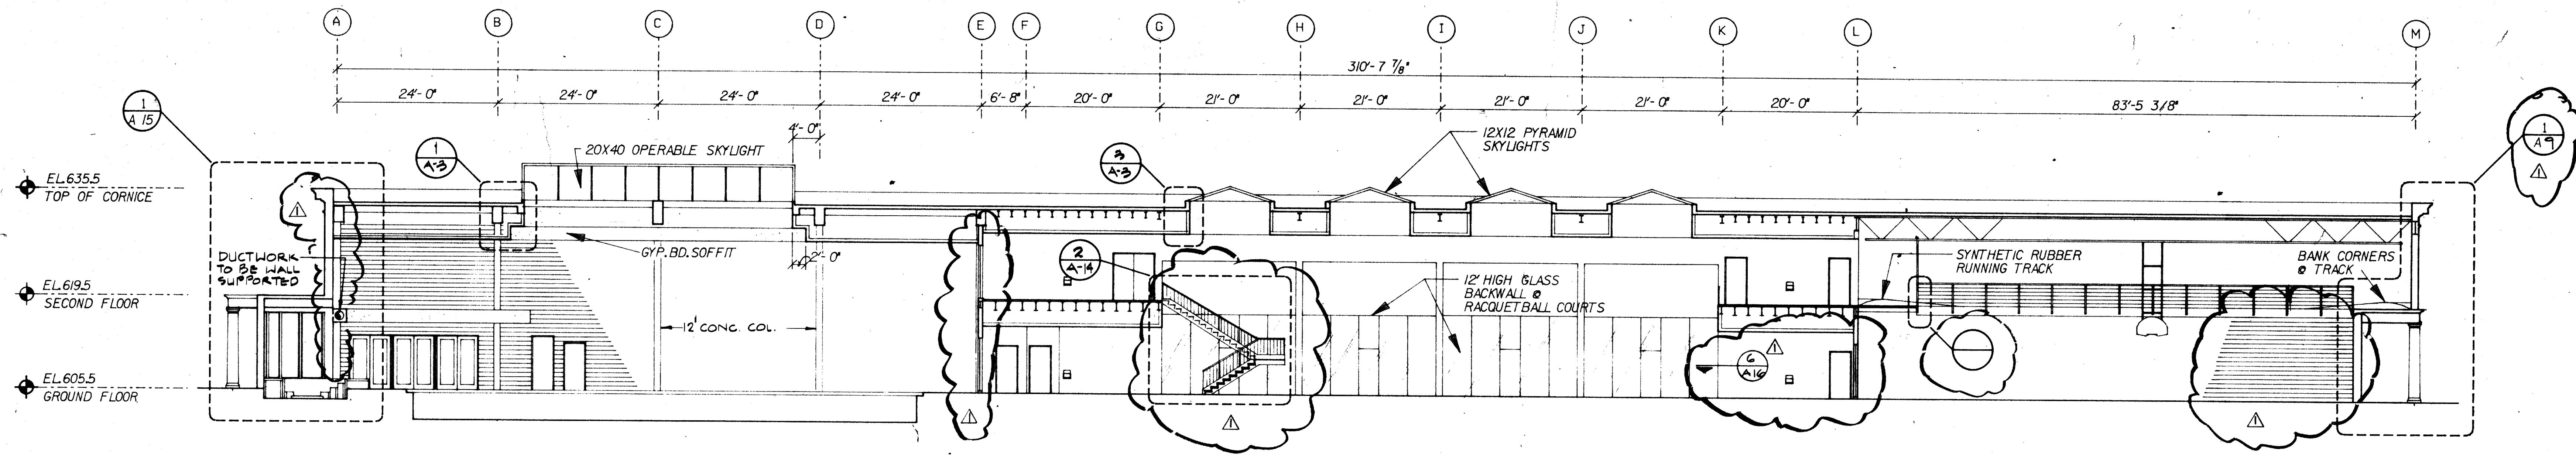


1 SECTION THRU BUILDING
SCALE: 3/32" = 1'-0"

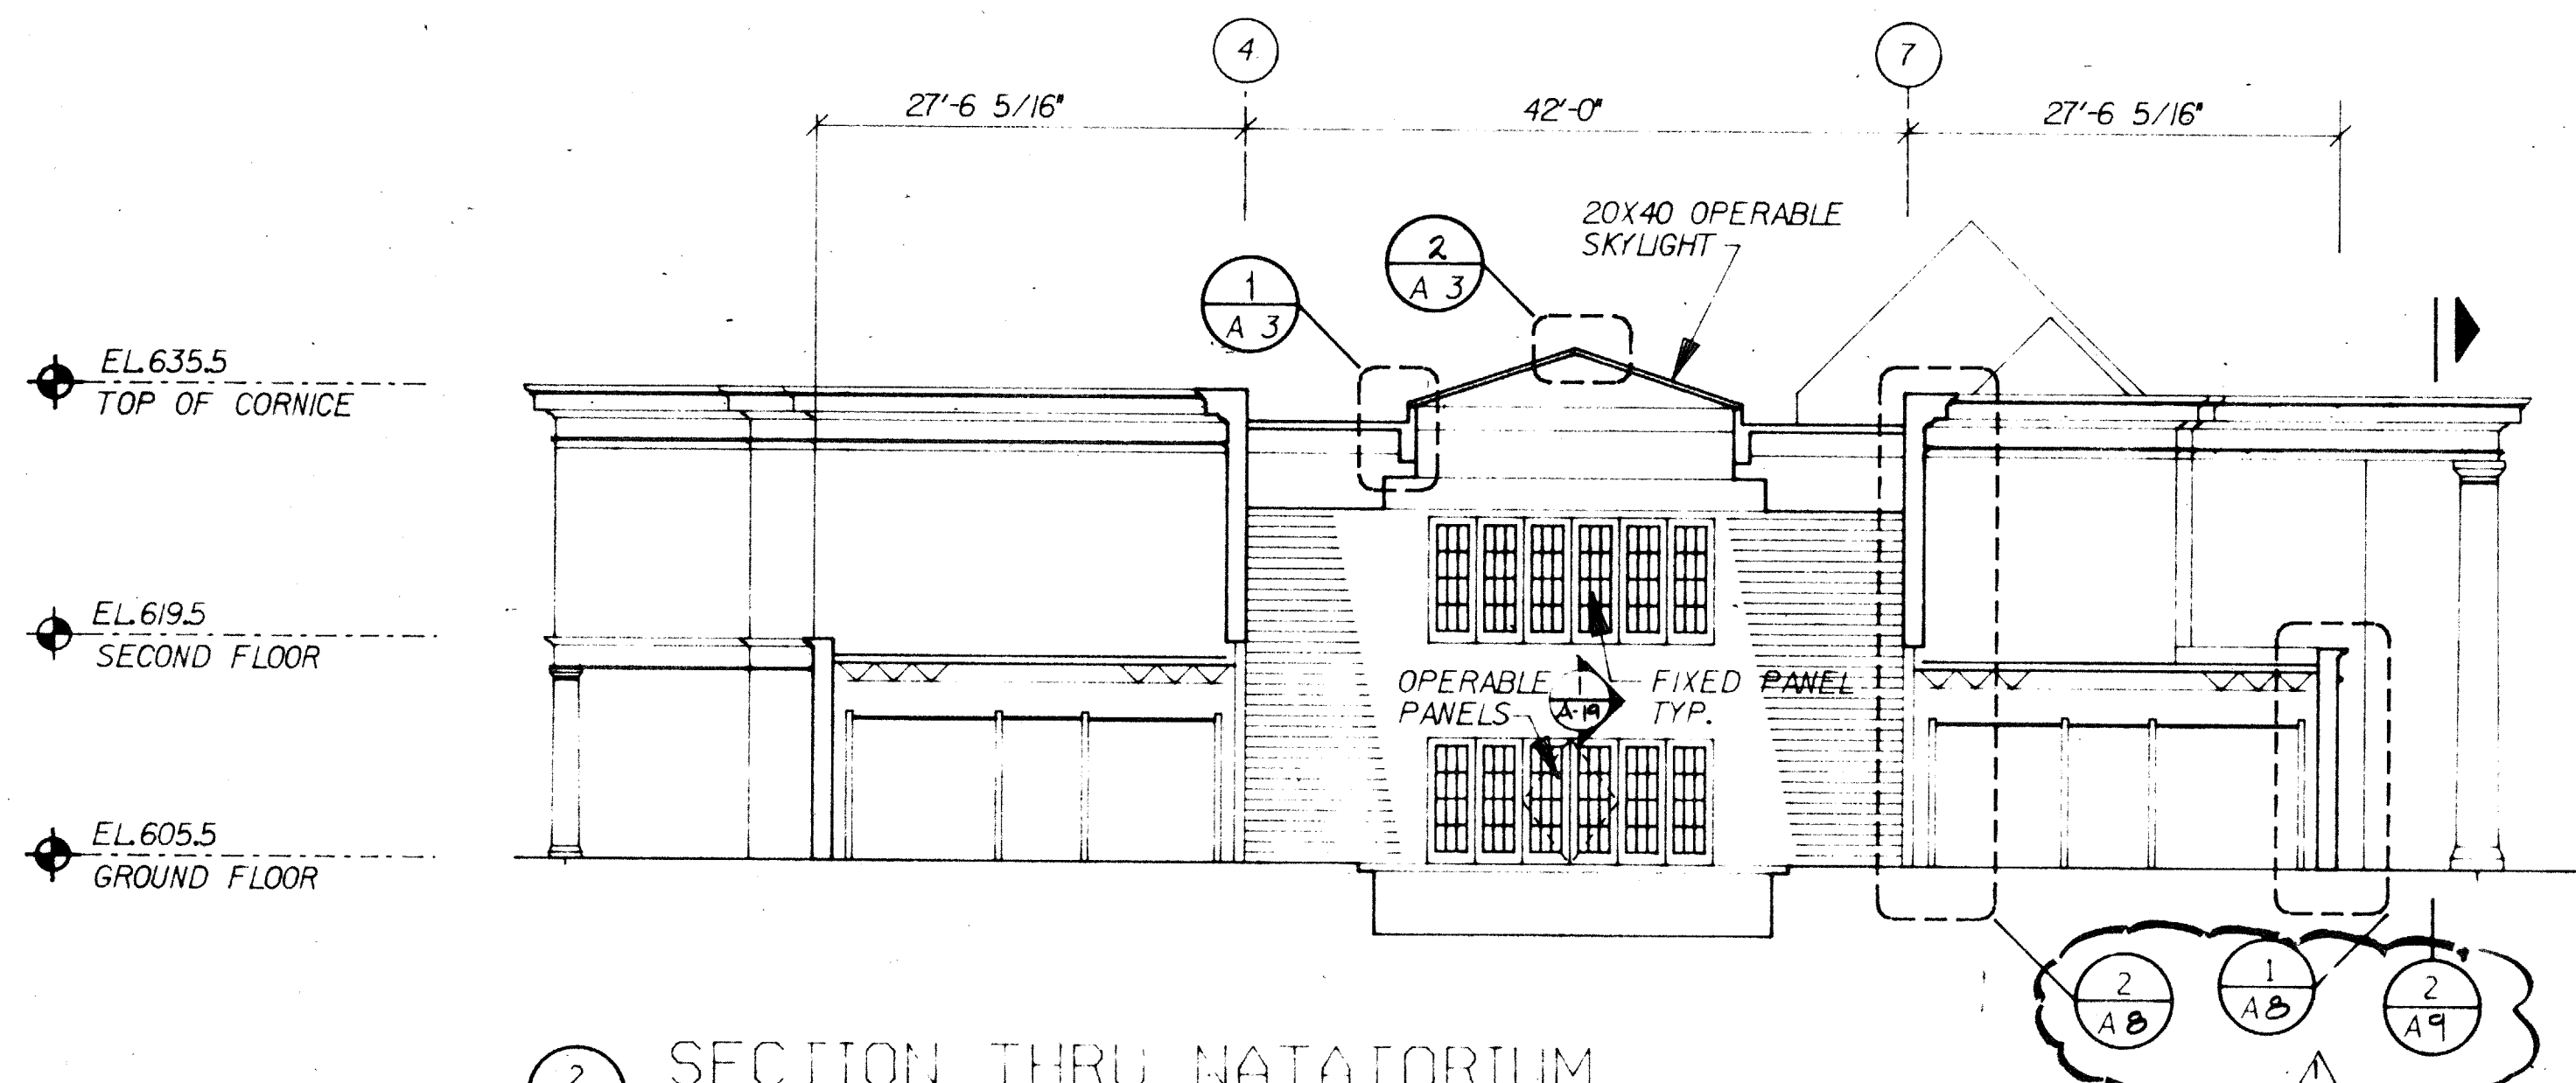


2 SECTION THRU NATATORIUM
SCALE: 3/32" = 1'-0"

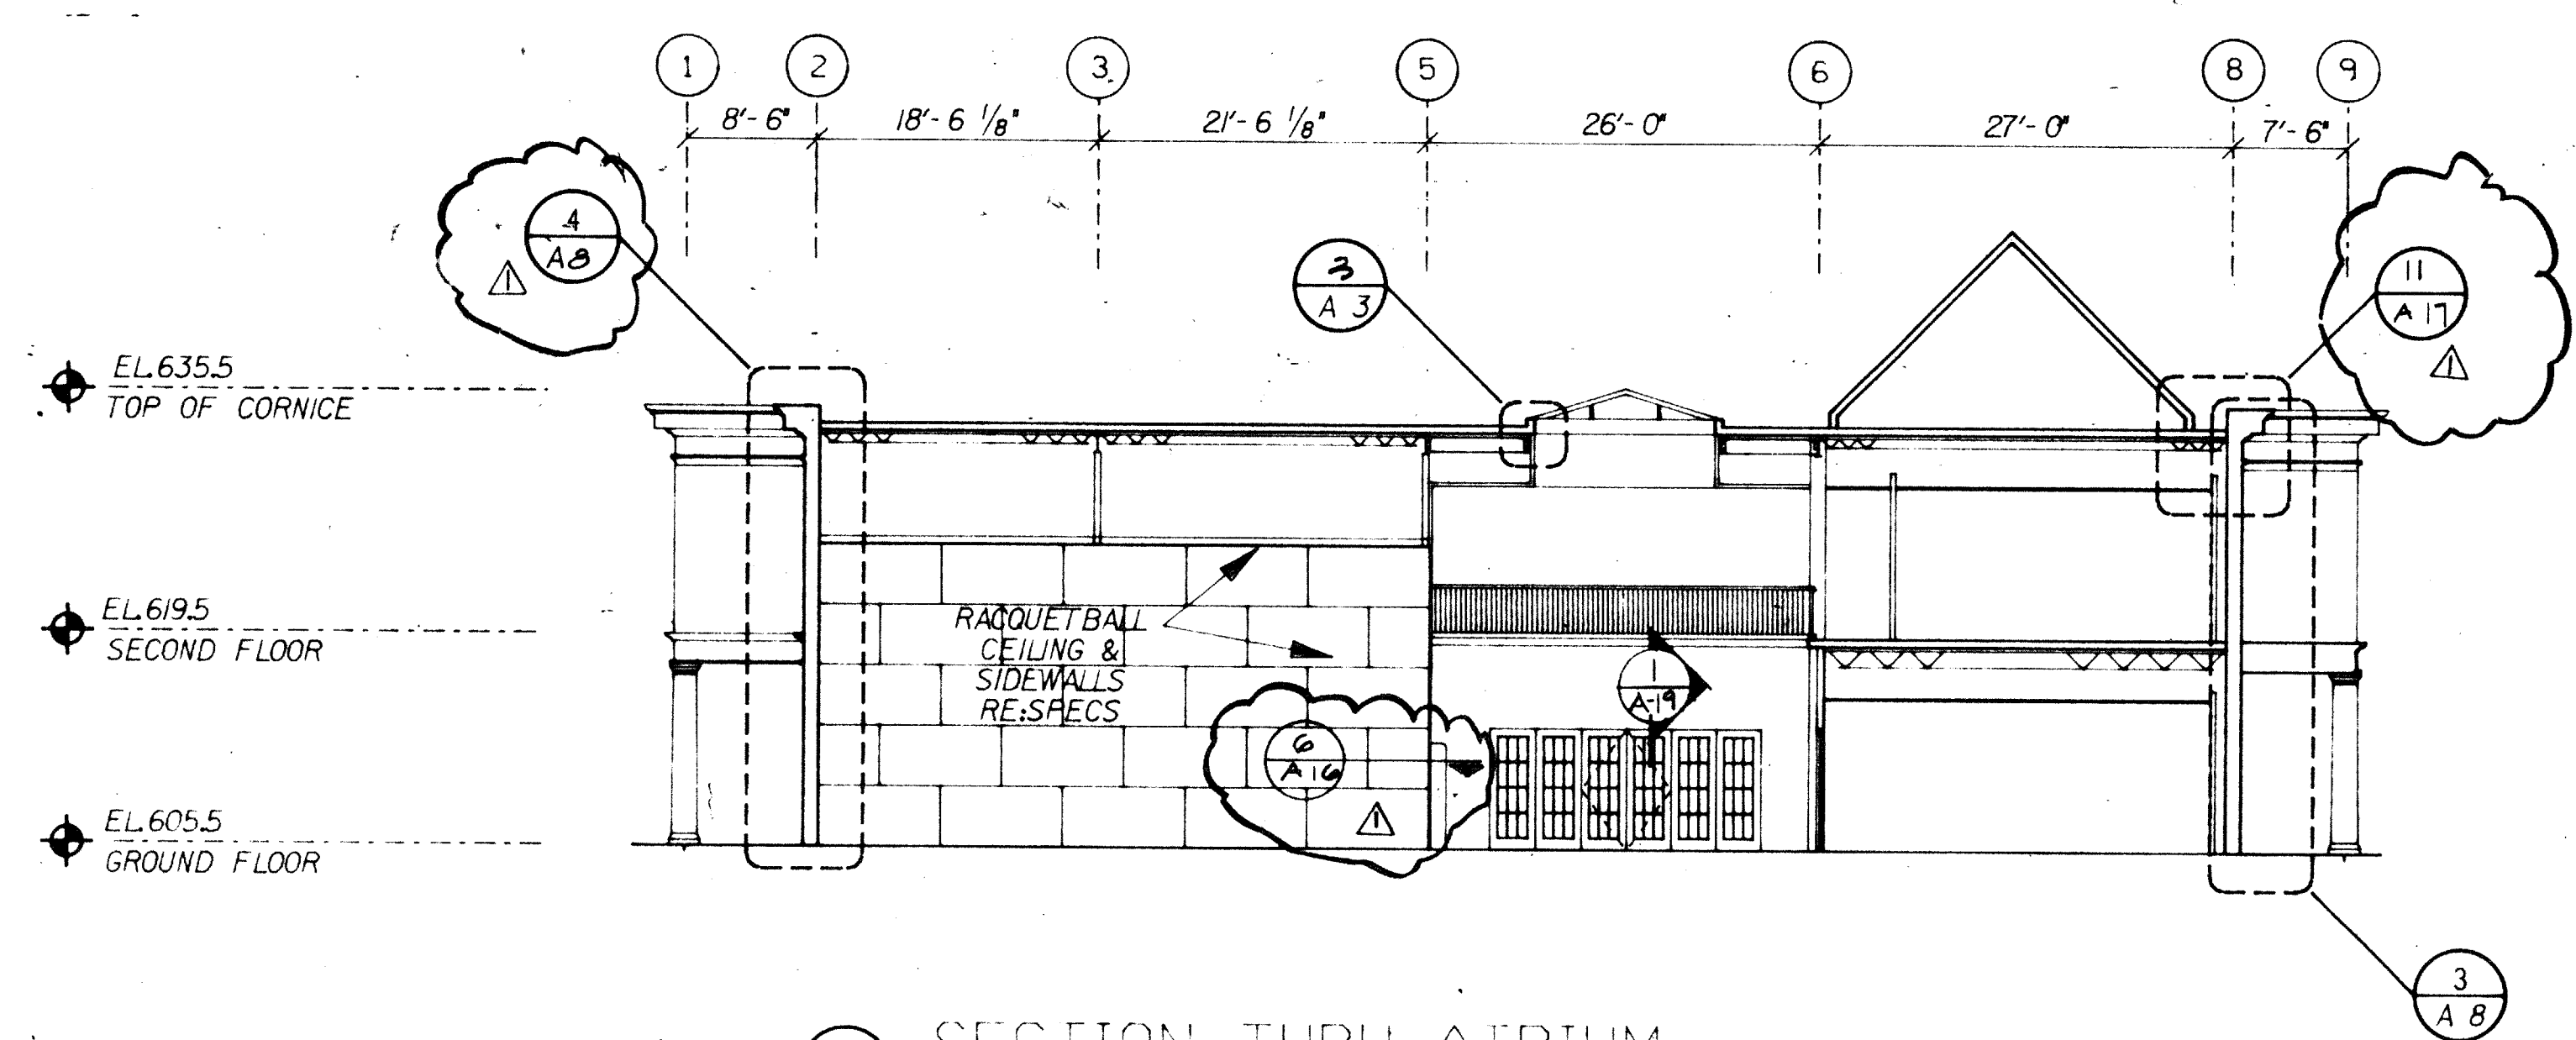

3 SECTION THRU ATRIUM
SCALE: 3/32" = 1'-0"

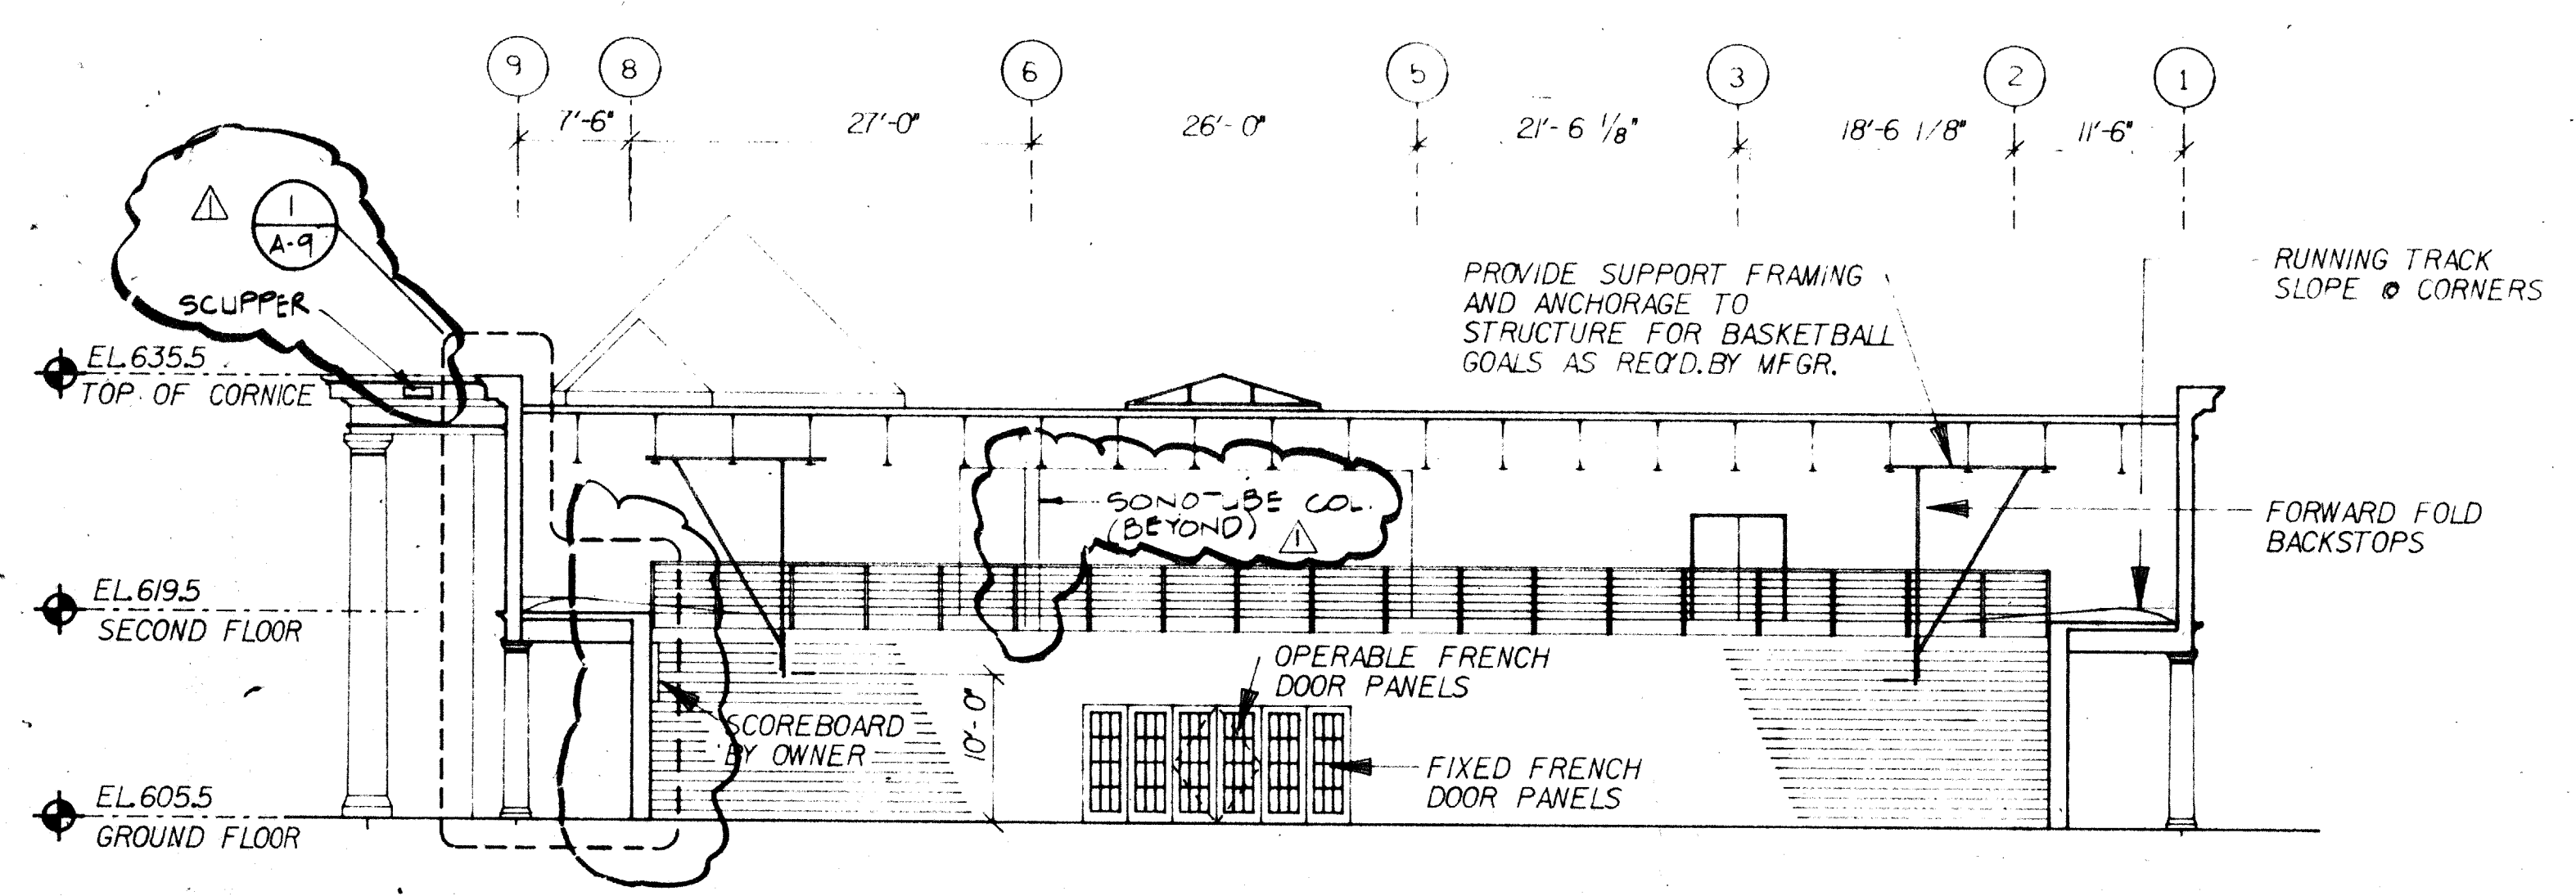


4 SECTION THRU GYMNASIUM
SCALE: 3/32" = 1'-0"

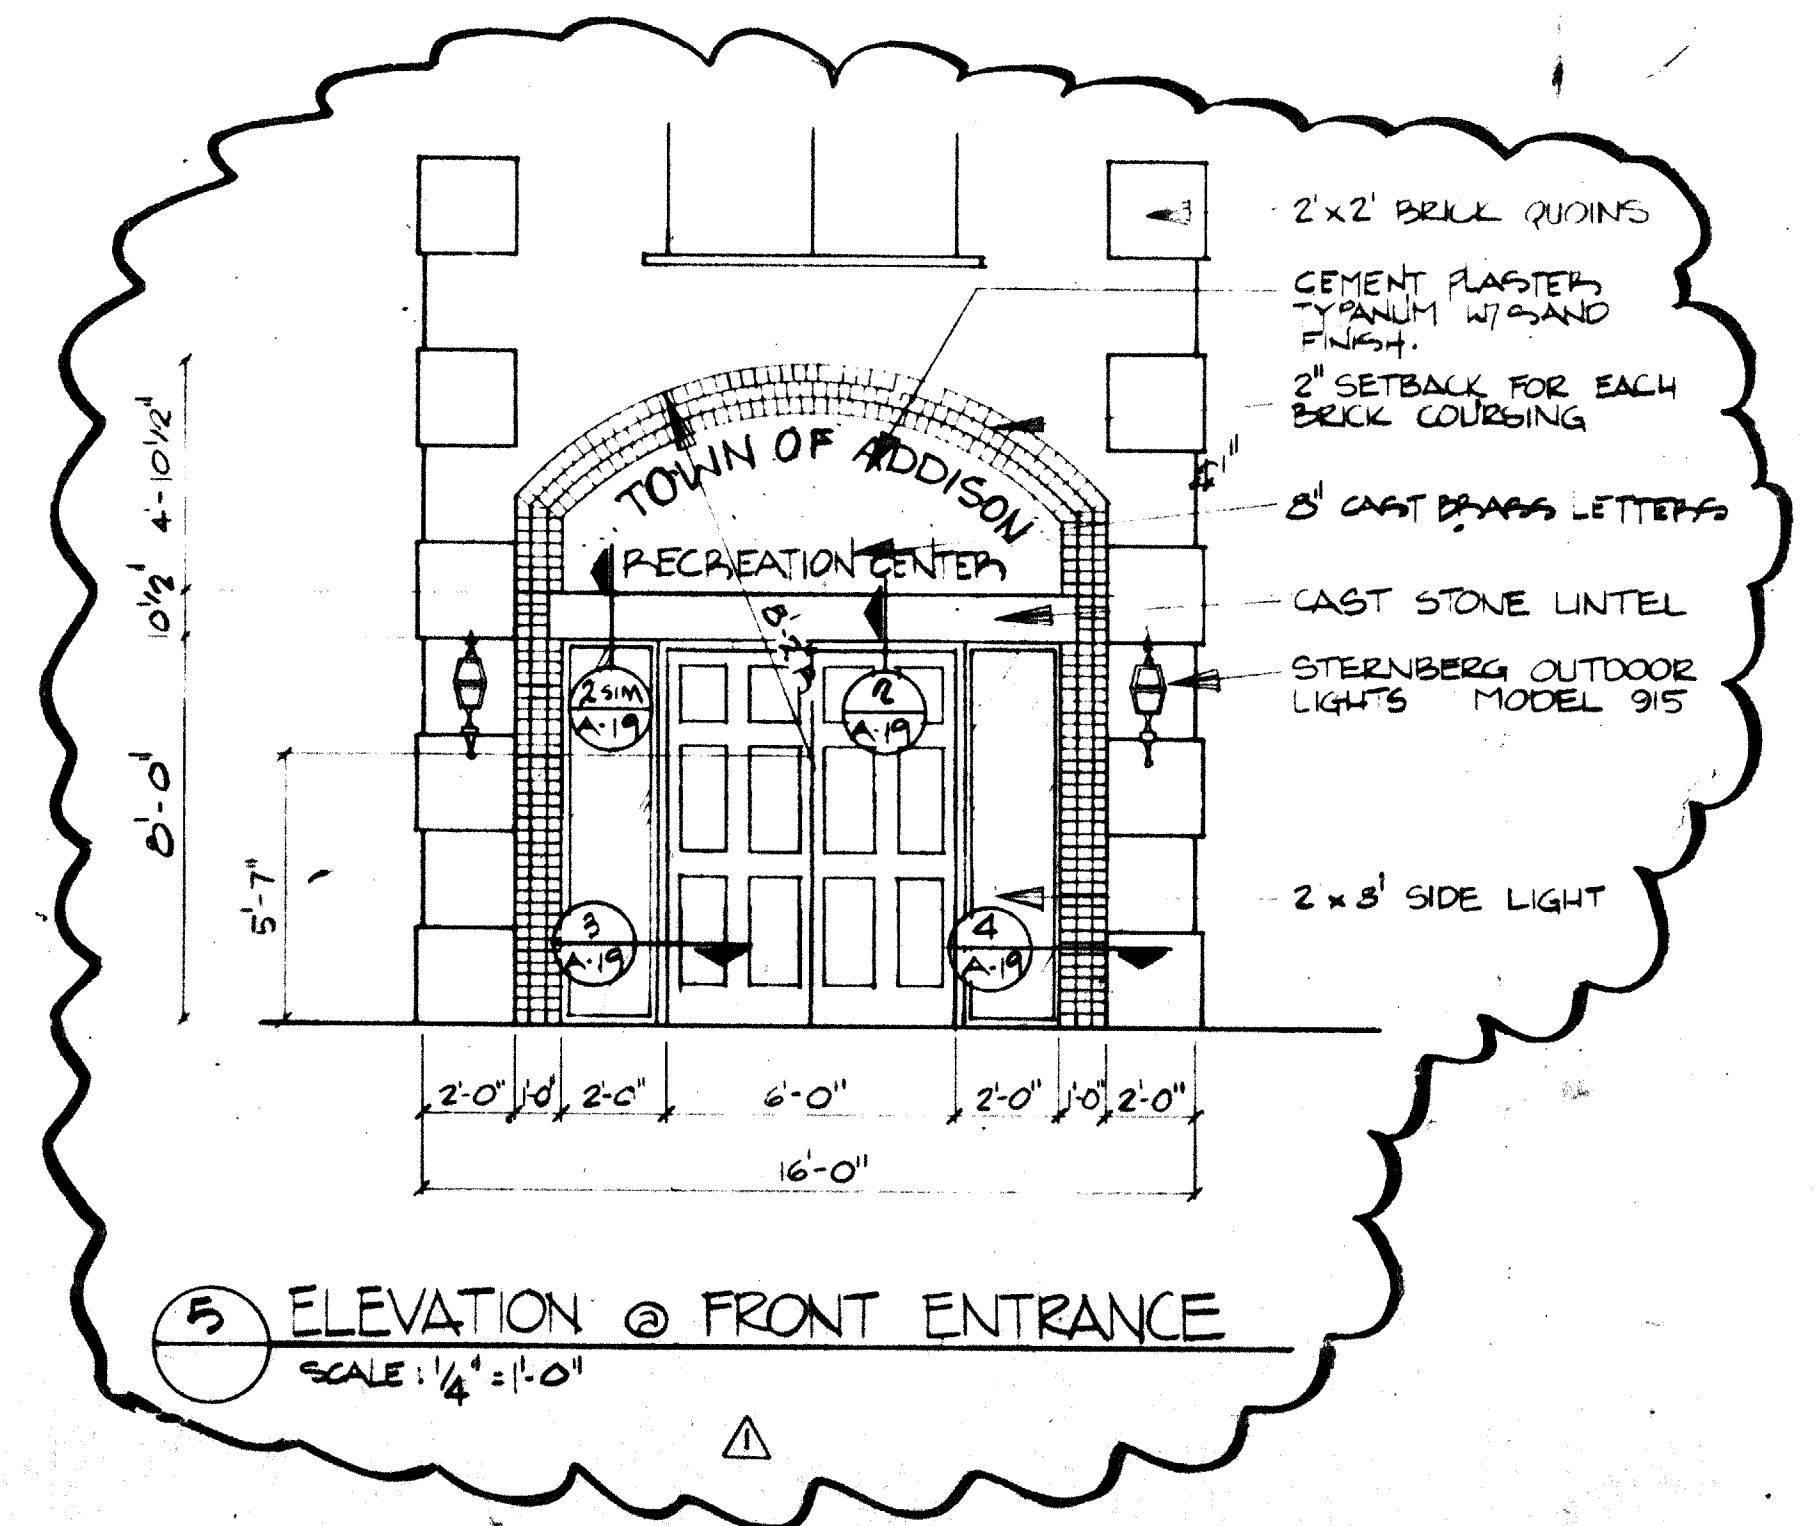


5 ELEVATION @ FRONT ENTRANCE
SCALE: 1/4" = 1'-0"

ADDISON RECREATION CENTER
3900 BELTWAY DRIVE
ADDISON, TEXAS

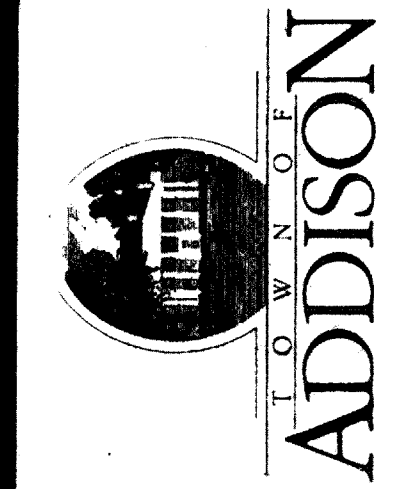

The Benham Group Dallas
architects
engineers
planners
1341 w. mockingbird ln.
suite 517 e
dallas, texas

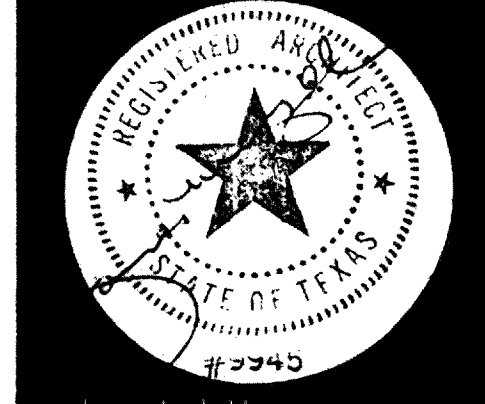

BUILDING SECTIONS

drawn N. BRENCHLEY
chkd H. ADAMS
date 3-19-88

no. date
1/21/86