



SHEET NO.	
BASE	
C	
A	
S	
M	
E	

ADDISON RECREATION CENTER
 3900 BELTWAY DRIVE
 ADDISON, TEXAS

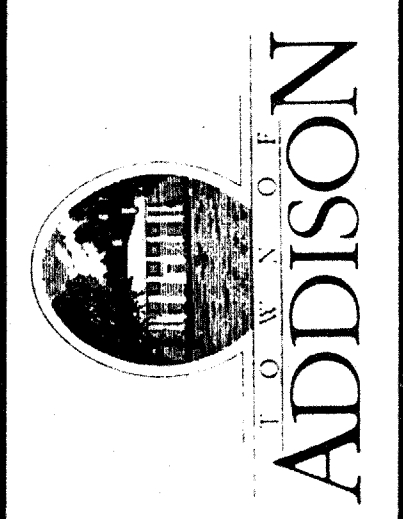

The Benham Group Dallas
 architects
 engineers
 planners
 1341 w. mockingbird ln.
 suite 517 e
 dallas, texas





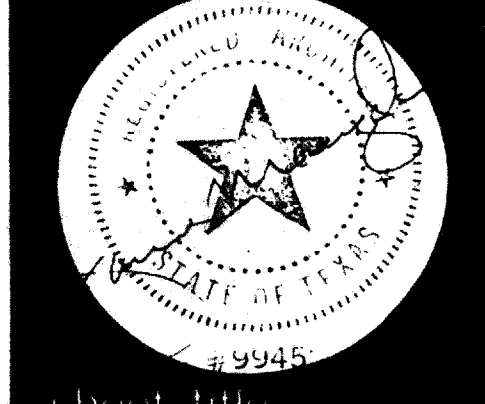


WALL SECTIONS

drawn H. HAMILTON
 checked H. ADAMS
 date 3-19-86

no. date
 Δ 4/2/86

SHEET **A-8**

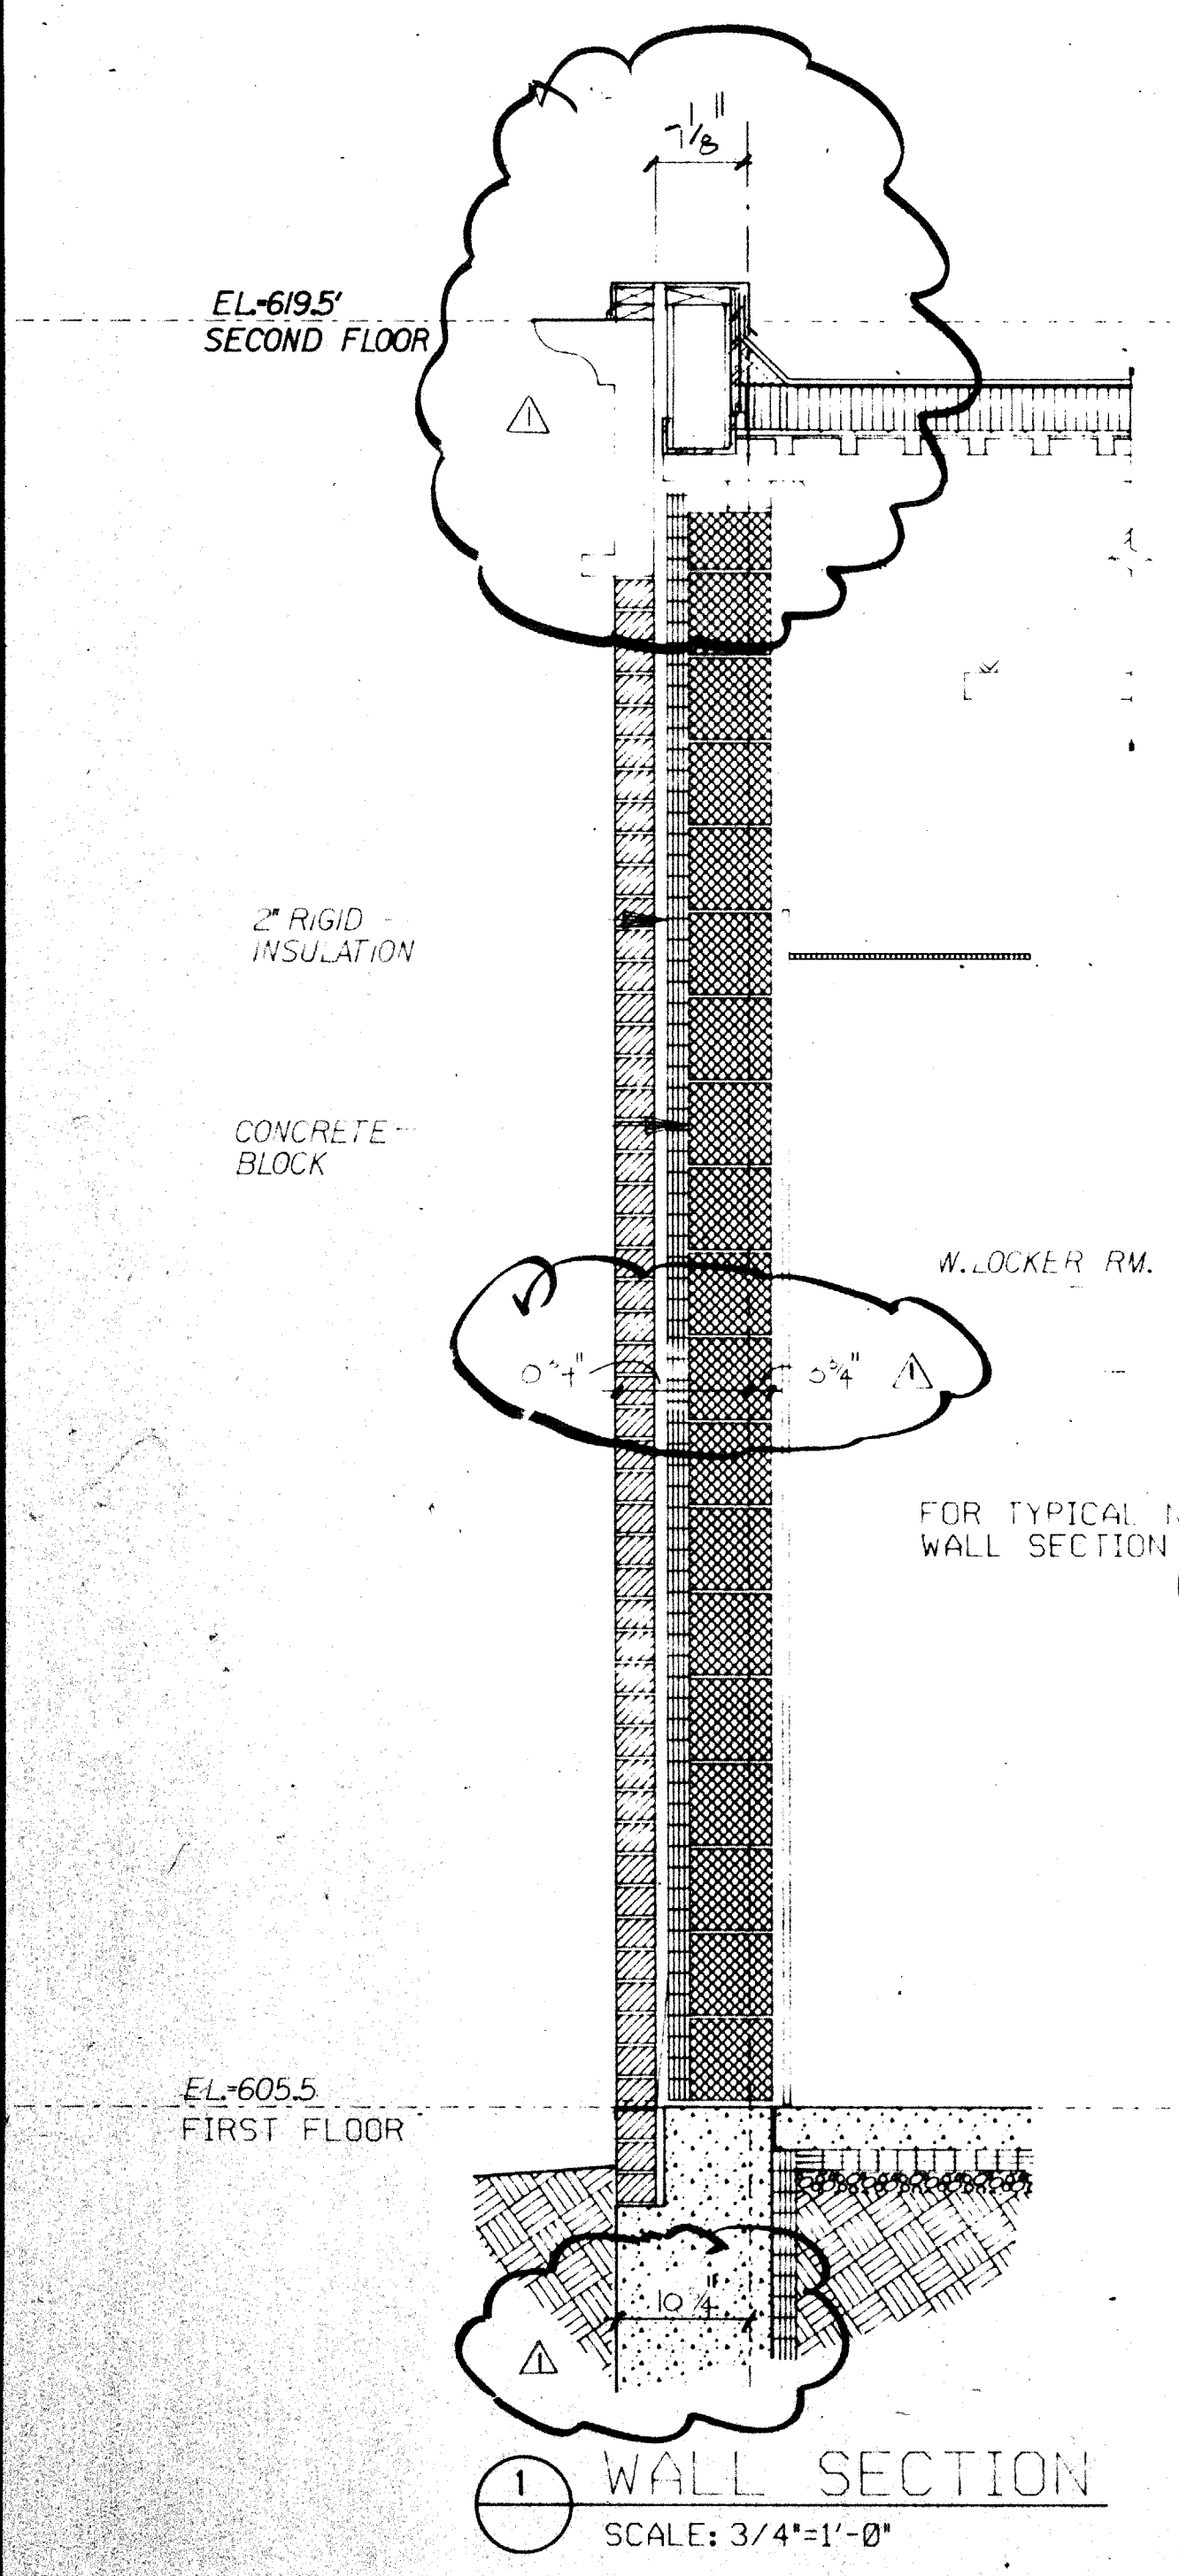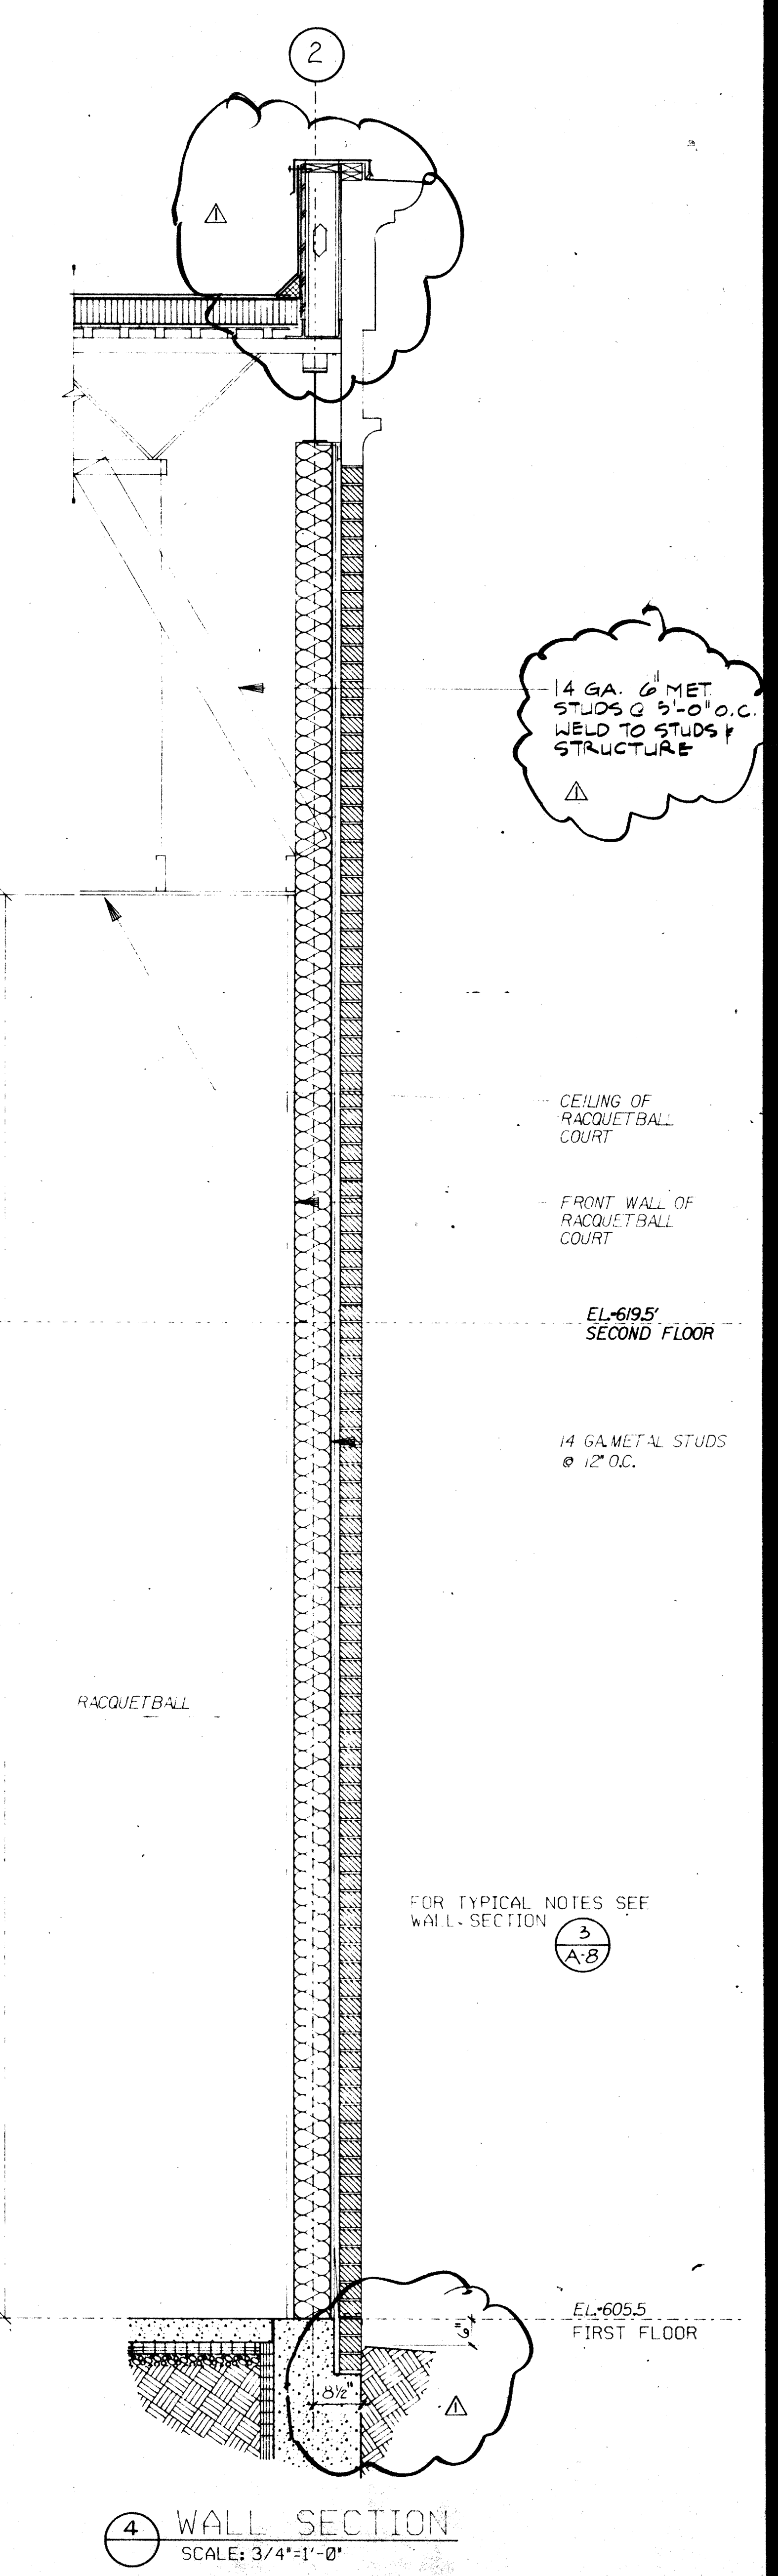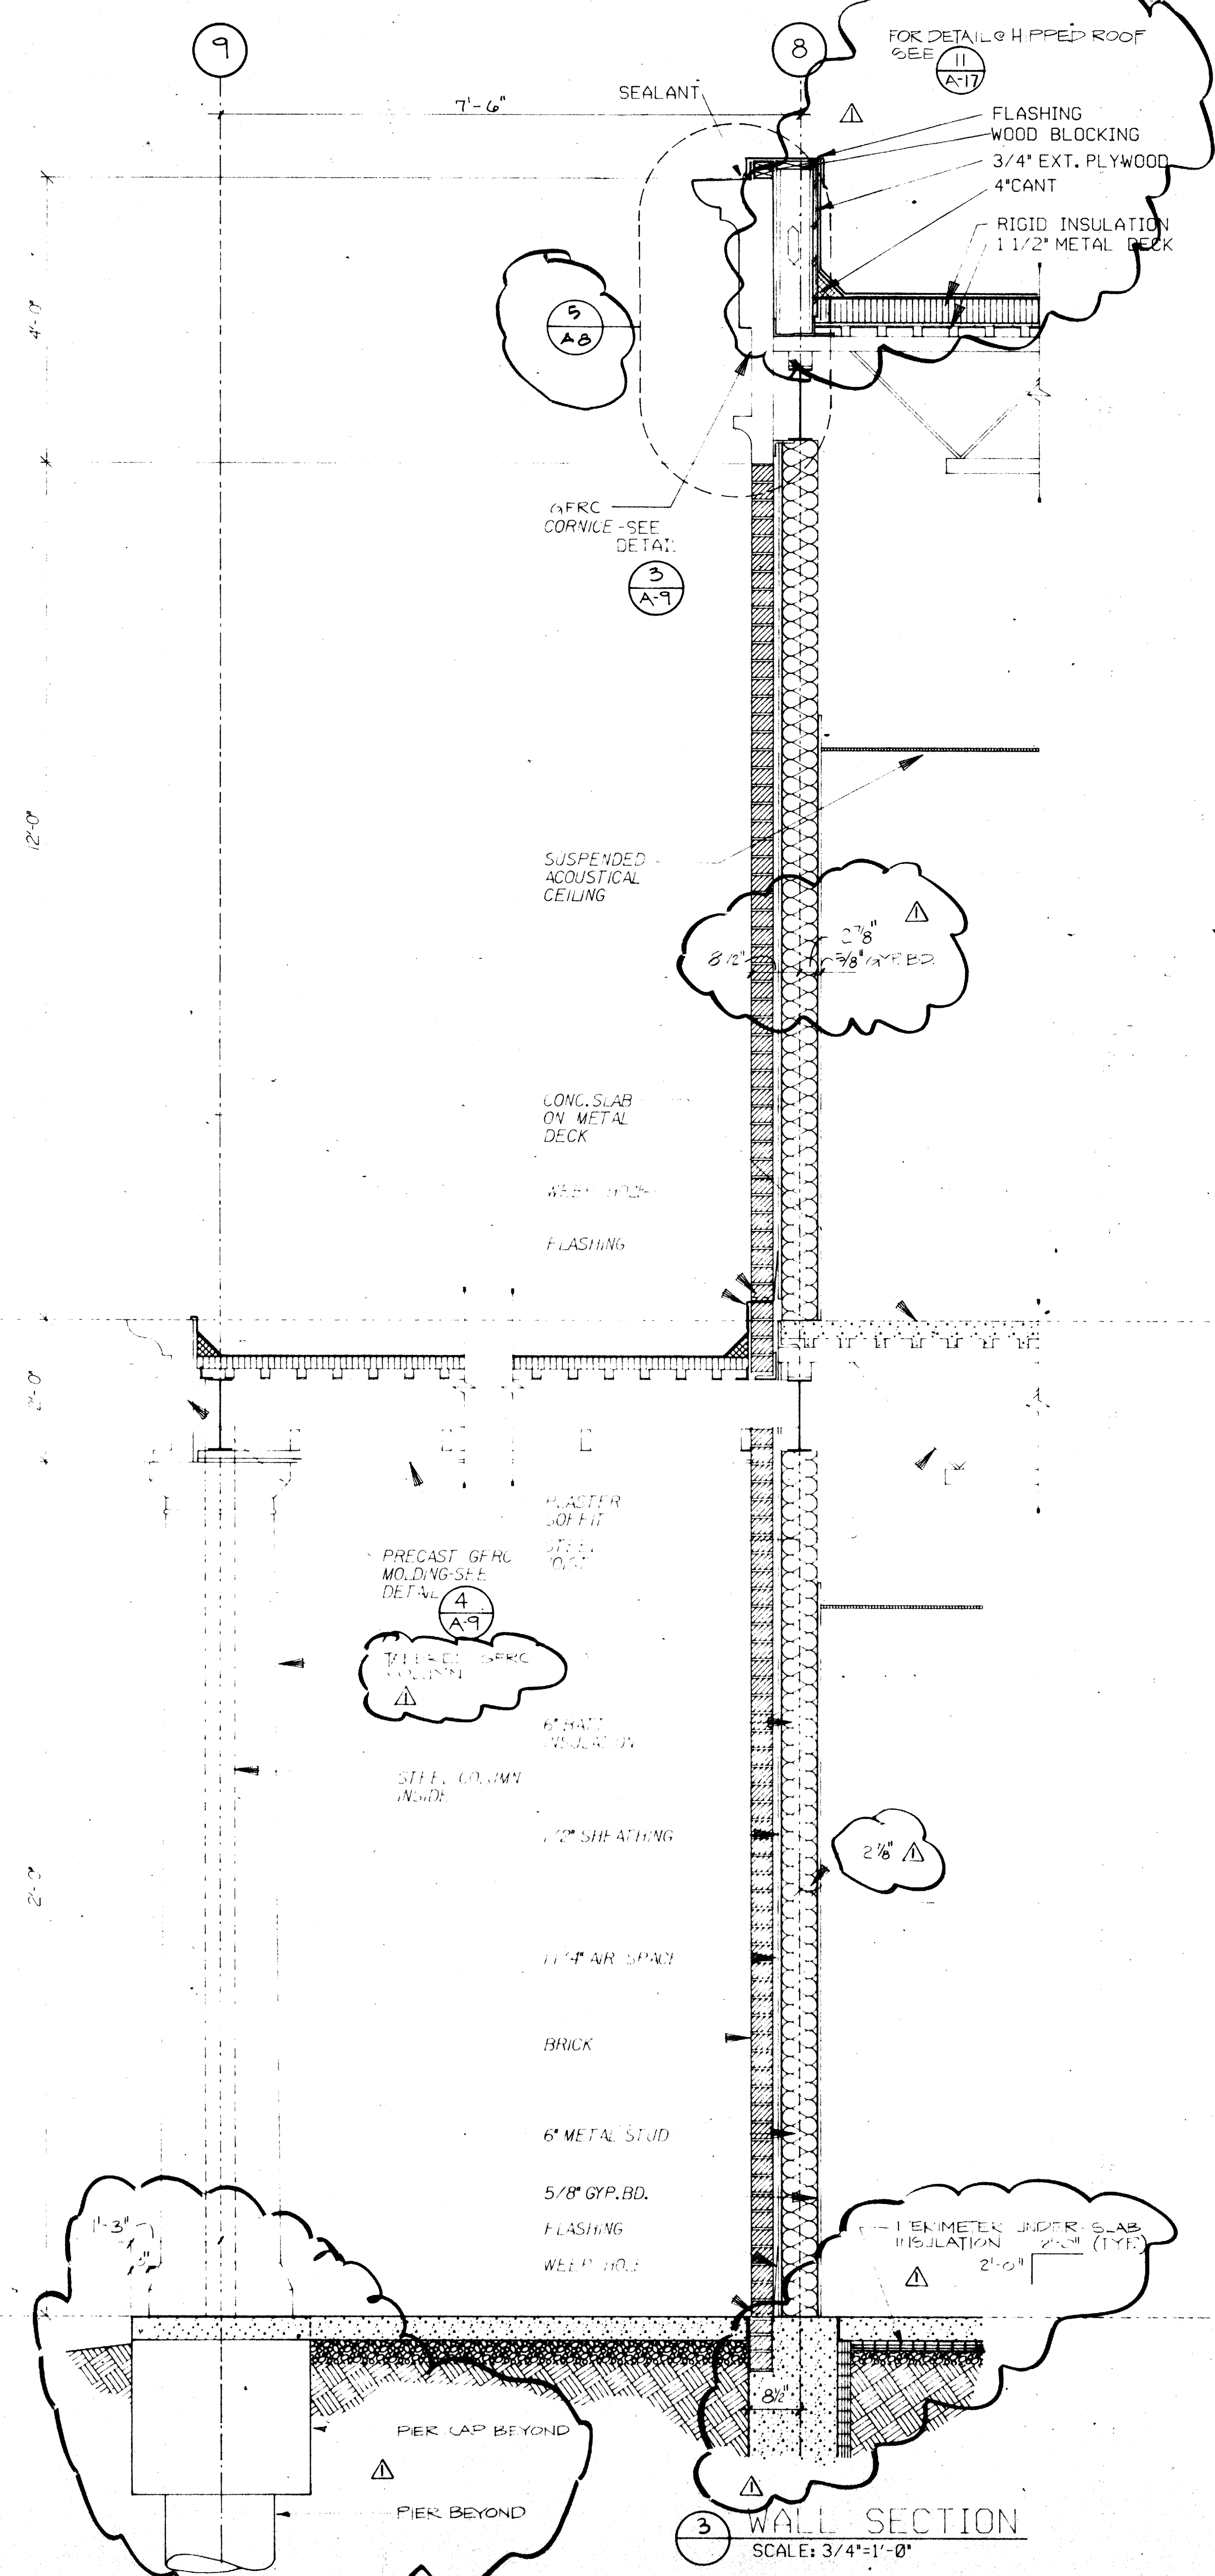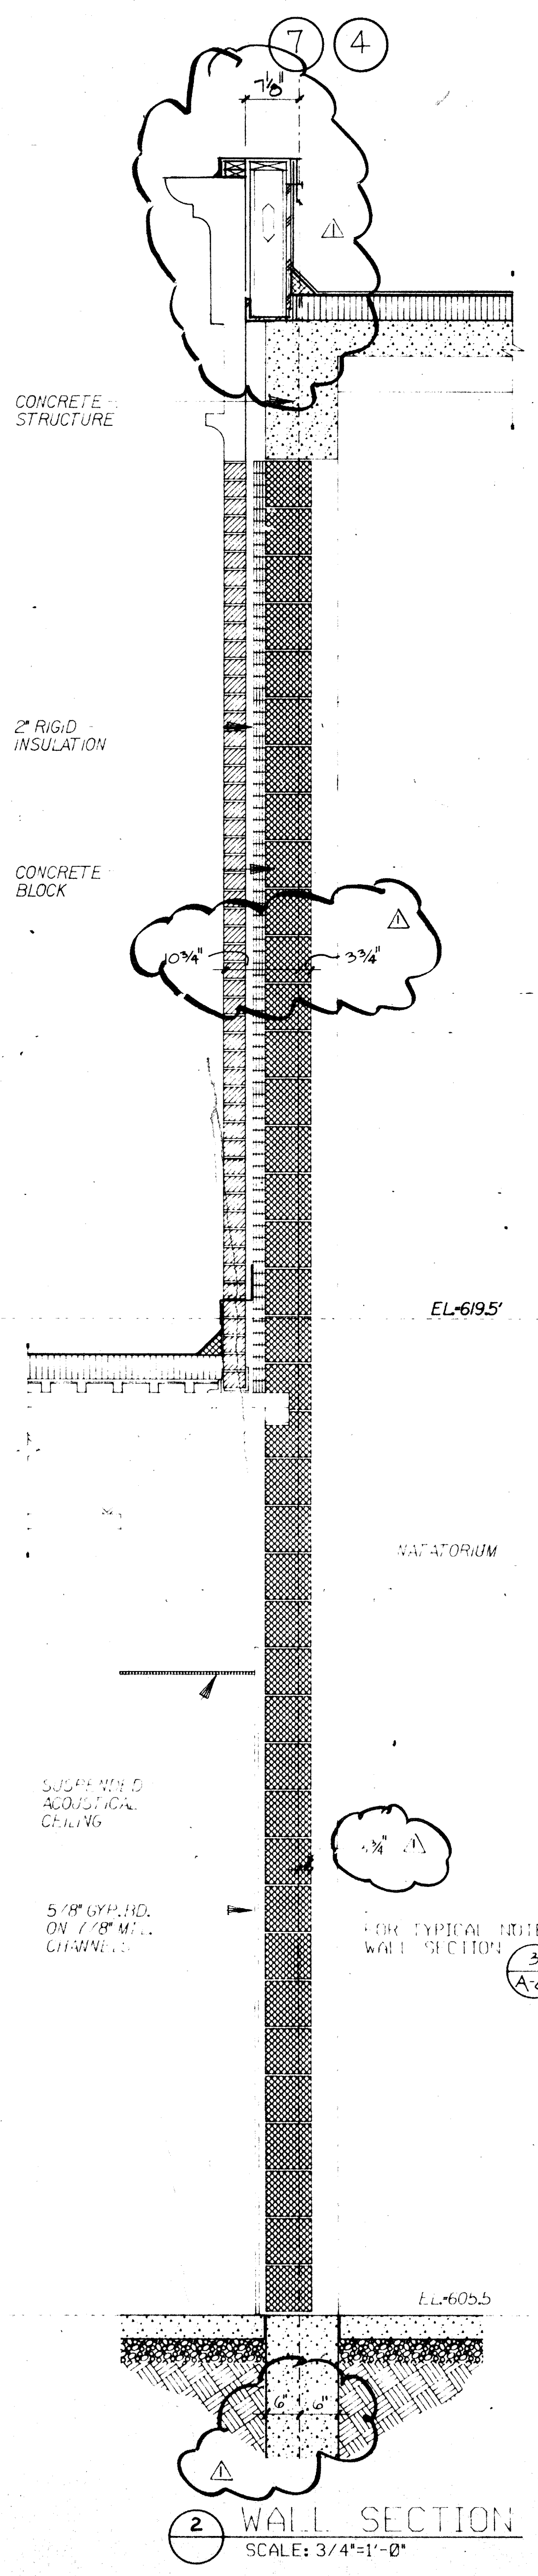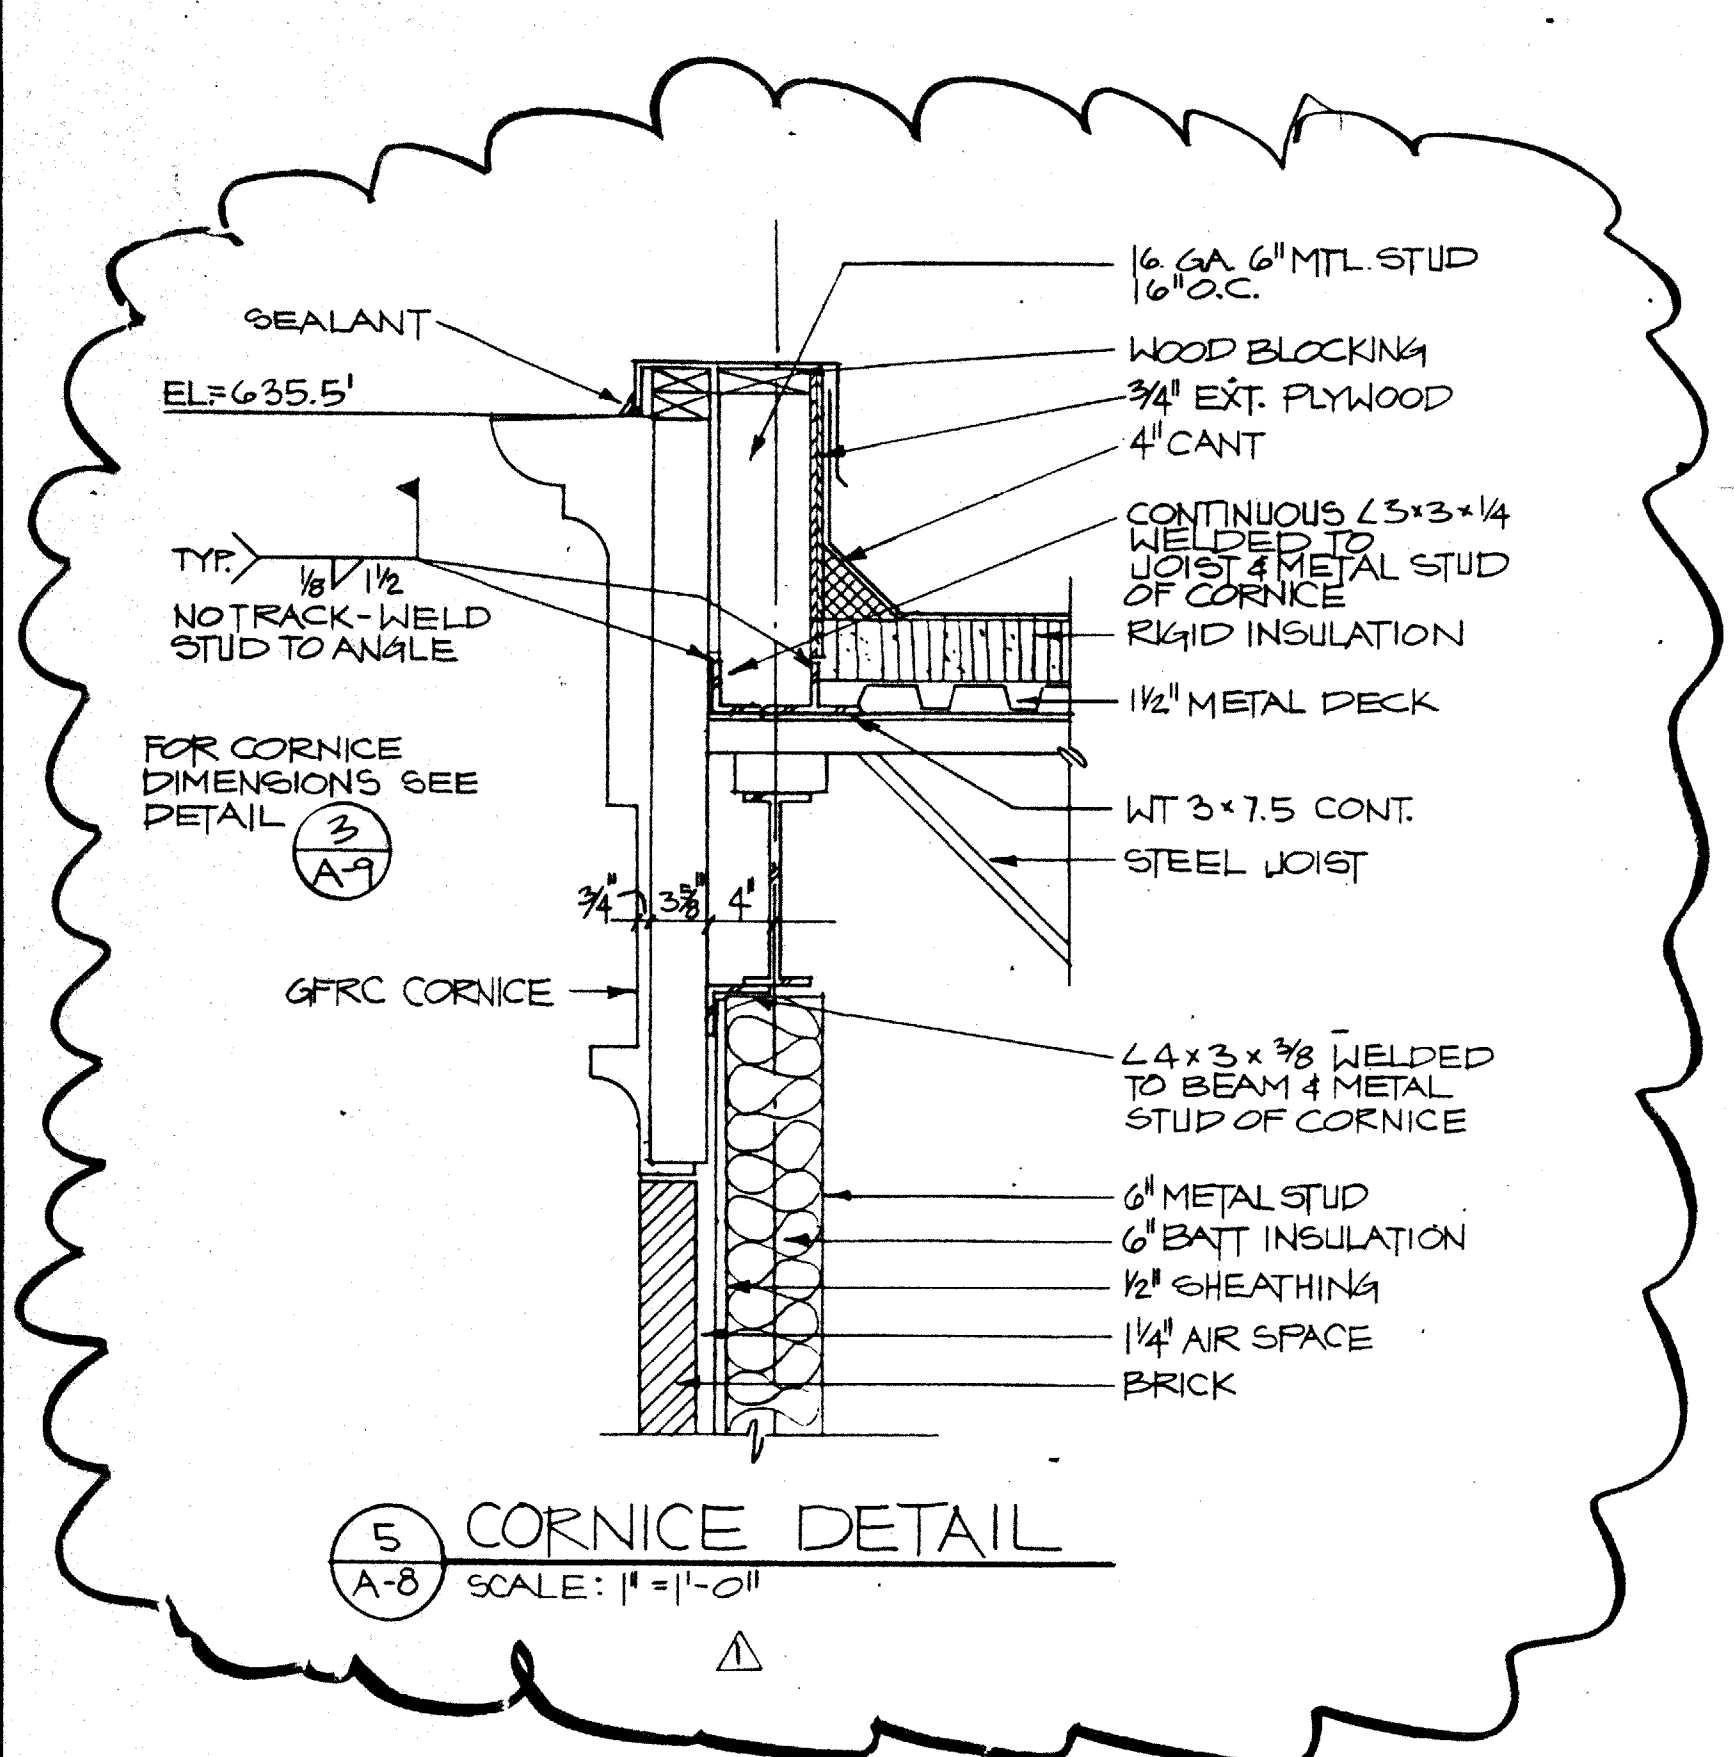

1 WALL SECTION
 SCALE: 3/4"=1'-0"

2 WALL SECTION
 SCALE: 3/4"=1'-0"

3 WALL SECTION
 SCALE: 3/4"=1'-0"

4 WALL SECTION
 SCALE: 3/4"=1'-0"