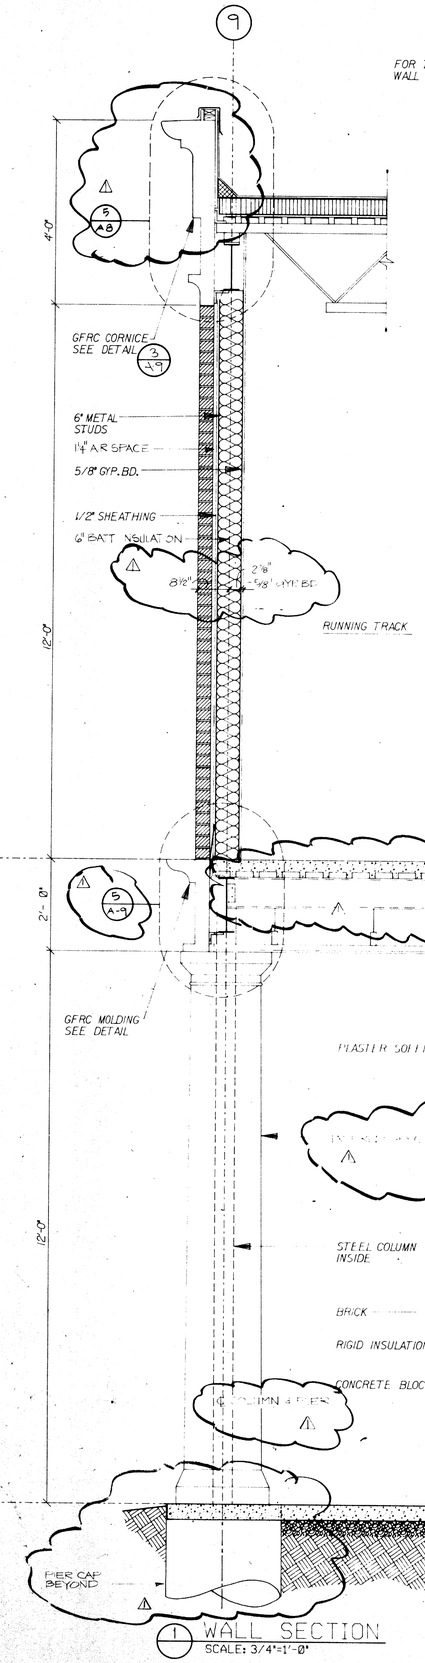

1 WALL SECTION
SCALE: 3/4"=1'-0"

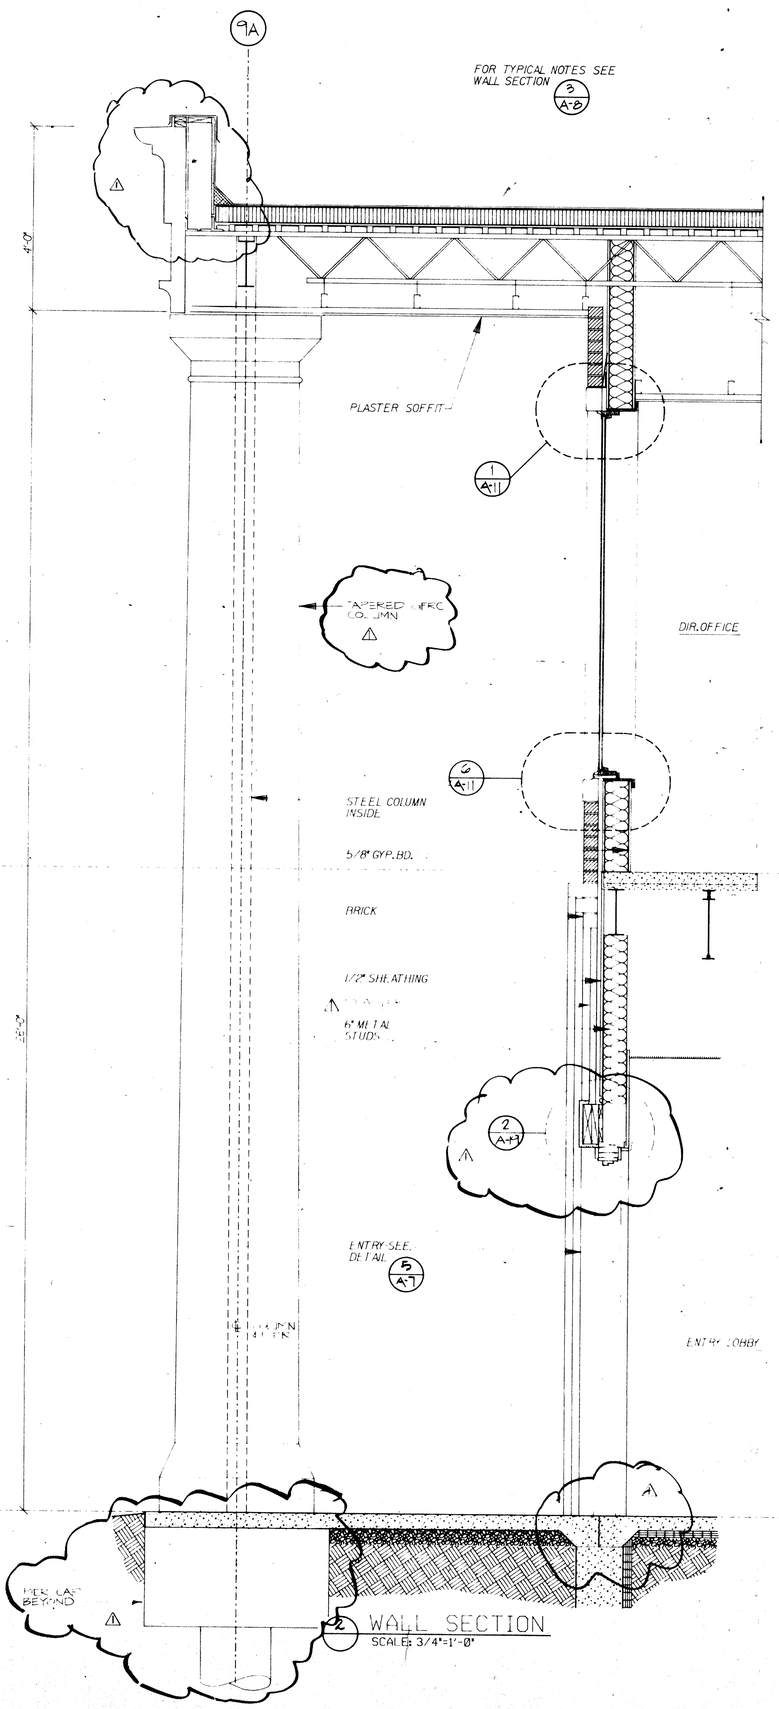

2 WALL SECTION
SCALE: 3/4"=1'-0"

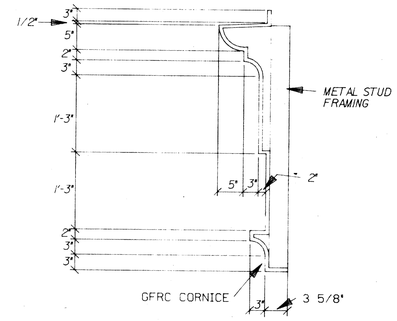

3 CORNICE DETAIL
SCALE: 1"=1'-0"

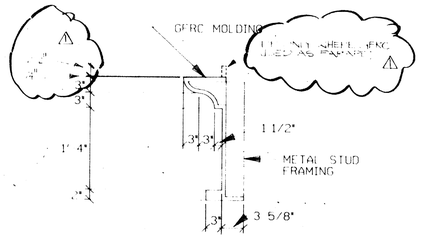

4 MOLDING DETAIL
SCALE: 1"=1'-0"

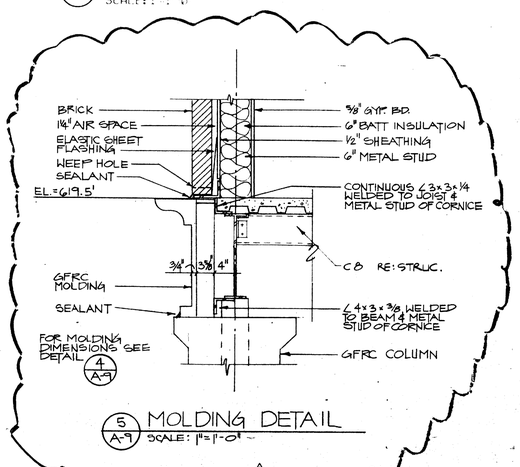

5/A-9 MOLDING DETAIL
SCALE: 1"=1'-0"

SHEET NO.
BASE
COMPOSITE
C
I
A
S
M
F

ADDISON RECREATION CENTER
3900 BELTWAY DRIVE
ADDISON, TEXAS

ADDISON

The Benham Group Dallas
architects
engineers
planners
1341 w. mockingbird ln.
suite 517 e
dallas, texas

REGISTERED ARCHITECT STATE OF TEXAS #9945

sheet title
WALL SECTIONS

drawn H. HAMILTON
chkd H. ADAMS
date 3-19-86
revisions

no.	date
1	4/21/86

sheet of A-9