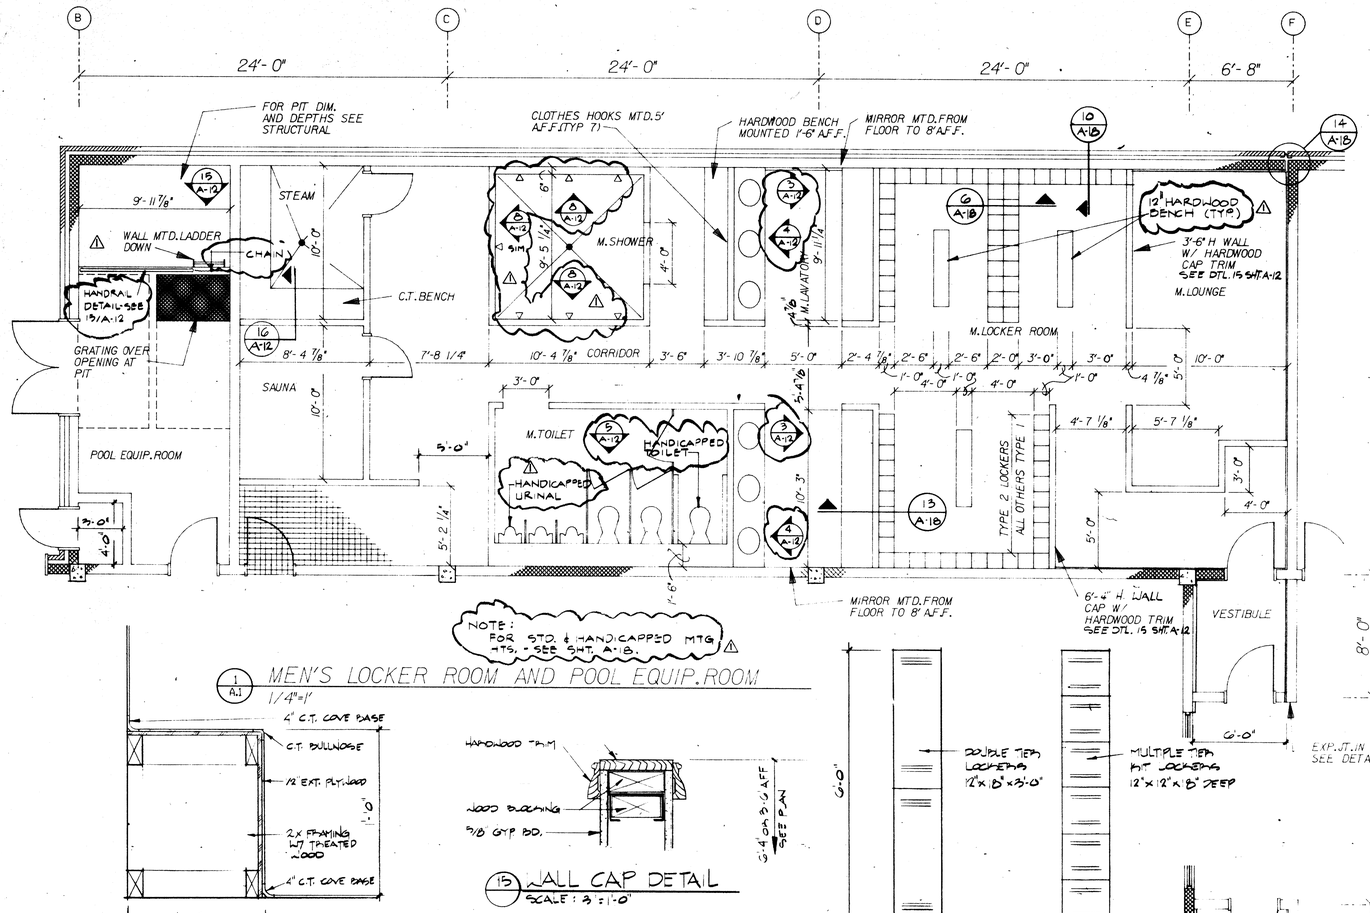

1 A.1 MEN'S LOCKER ROOM AND POOL EQUIP. ROOM
1/4"=1'

16 SECT. AT STEAM & M. BENCH
SCALE: 1 1/2" = 1'-0"

15 WALL CAP DETAIL
SCALE: 3" = 1'-0"

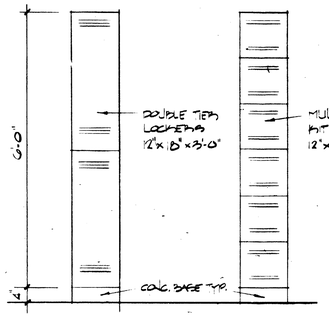

TYPICAL LOCKER ELEVATIONS
SCALE: 3/4" = 1'-0"

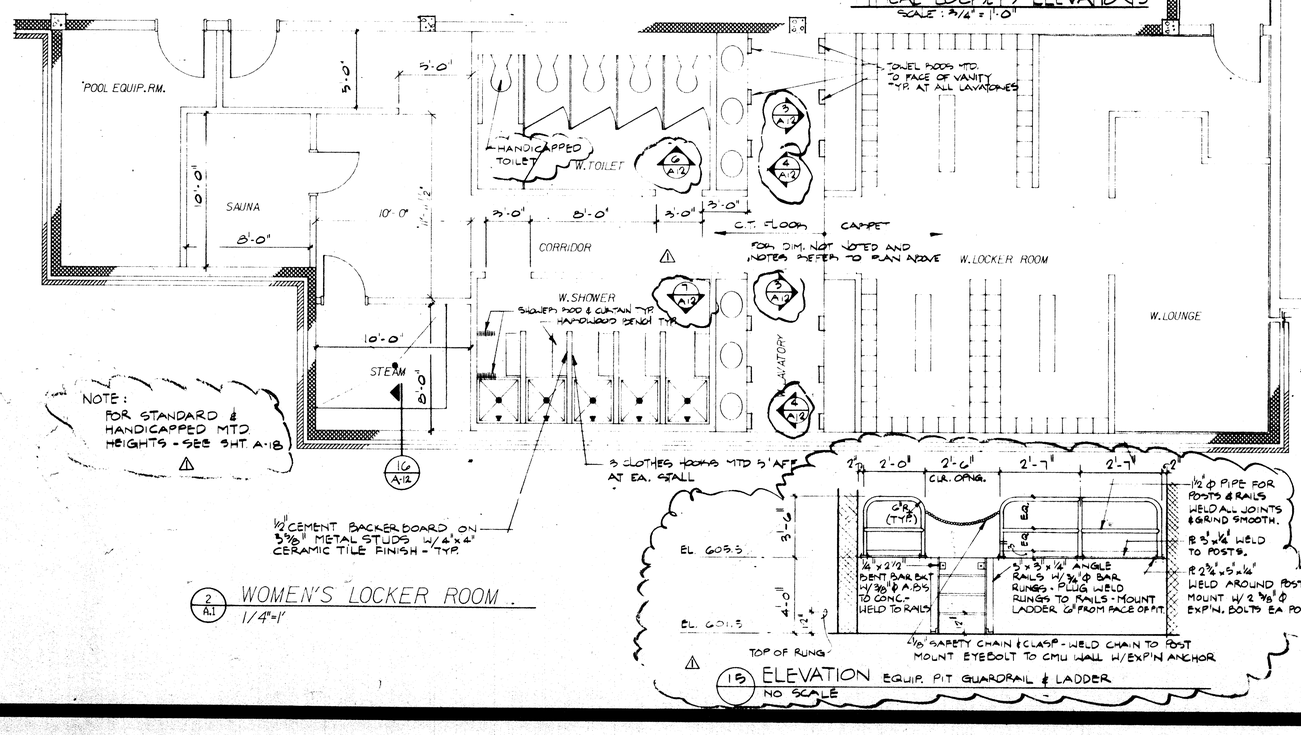

2 A.1 WOMEN'S LOCKER ROOM
1/4"=1'

15 ELEVATION EQUIP. PIT GUARDRAIL & LADDER
NO SCALE

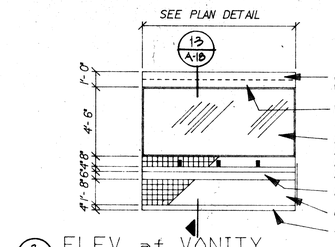

3 ELEV. at VANITY

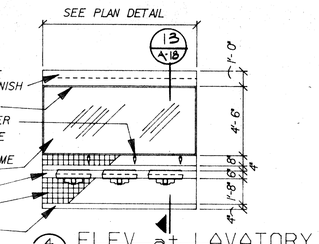

4 ELEV. at LAVATORY

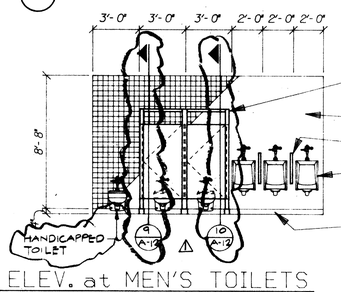

5 ELEV. at MEN'S TOILETS

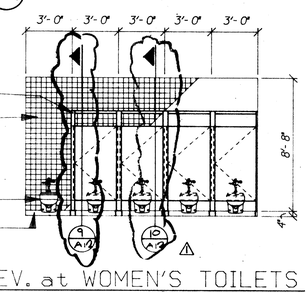

6 ELEV. at WOMEN'S TOILETS

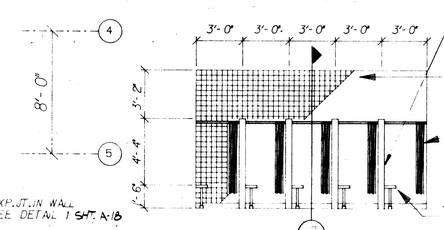

7 ELEV. AT WOMEN'S SHOWER

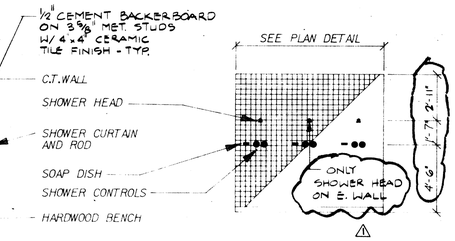

8 ELEV. AT MEN'S SHOWER

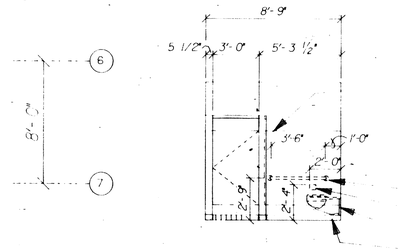

9 SECT. AT H.C. TOILET

10 SECT. AT TOILET

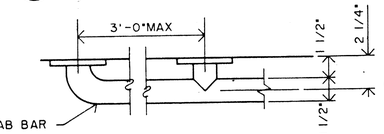

11 TYP. CONFIGURATION
SCALE: NONE

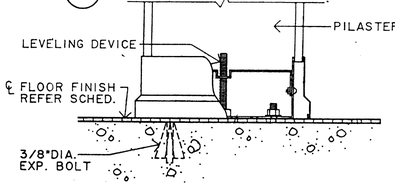

12 TOILET PARTITION (OVERHEAD BRACED)
SCALE: 3"=1'-0"

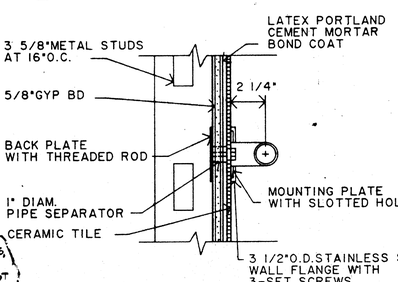

13 CERAMIC TILE ON METAL STUDS
SCALE: NONE

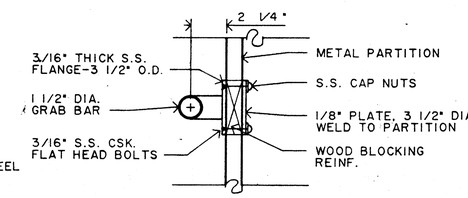

14 GRAB BAR AT METAL PARTITION
SCALE: NONE

SHEET NO.						
BASE						
COMPOSITE	C					
	L					
	A					
	S					
	S					
	M					
	E					

ADDISON RECREATION CENTER
3900 BELTWAY DRIVE
ADDISON, TEXAS

ADDISON

The Benham Group Dallas
architects
engineers
planners
1341 w. mockingbird ln.
suite 517 e
dallas, texas

REGISTERED ARCHITECT STATE OF TEXAS 19945

sheet title
LOCKER ROOM ELEVATIONS and DETAILS

drawn	H. ADAMS
chk'd	H. ADAMS
date	3-19-86

revisions

no.	date
1	4/21/86

sheet of A-12