


SHEET NO.	
BASE	
C	
F	
M	
E	
COMPOSITE	

ADDISON RECREATION CENTER
 3900 BELTWAY DRIVE
 ADDISON, TEXAS

ADDISON

The Benham Group Dallas
 architects
 engineers
 planners
 1341 w. mockingbird ln.
 suite 517 e
 dallas, texas

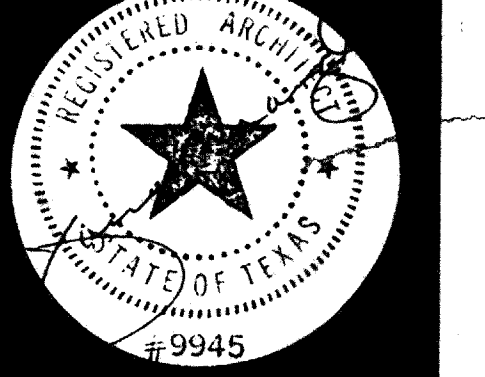


INTERIOR ELEVATIONS and DETAILS


drawn R. HAMILTON
 chkd R. ADAMS
 date 3-19-88
 revisions

no. date
 Δ 4/21/86


1 PANELING DETAIL
 3" = 1'

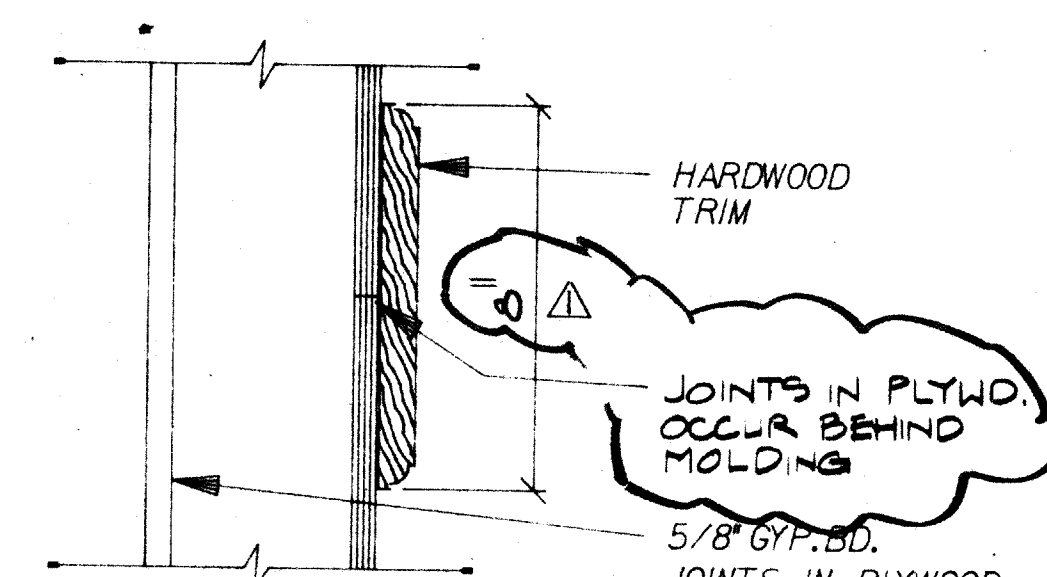


2 PANELING DETAIL
 3" = 1'

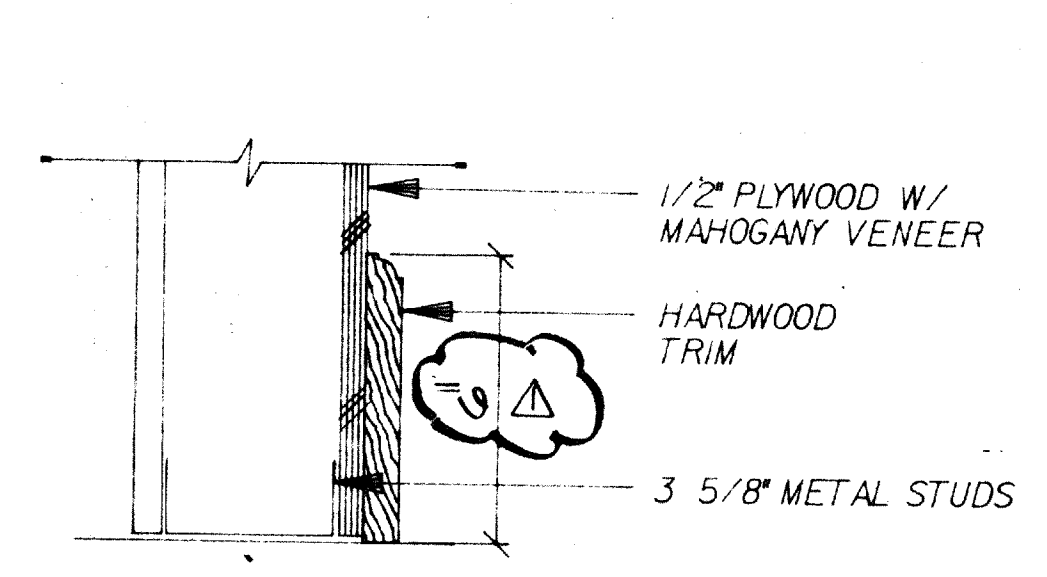



7 PANELING DETAIL
 3" = 1'

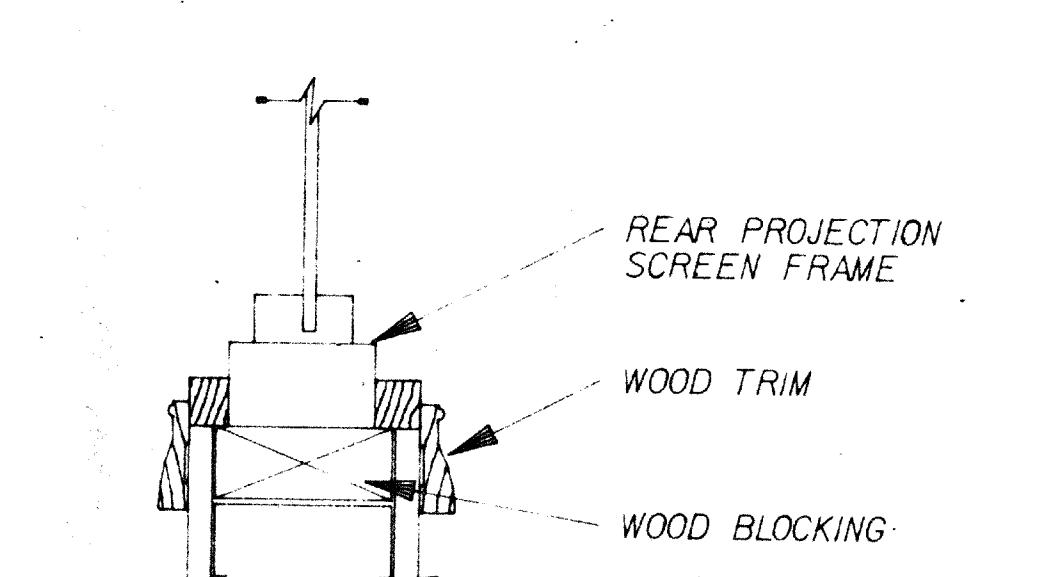


12 DETAIL-PROJ. SCREEN
 3" = 1'

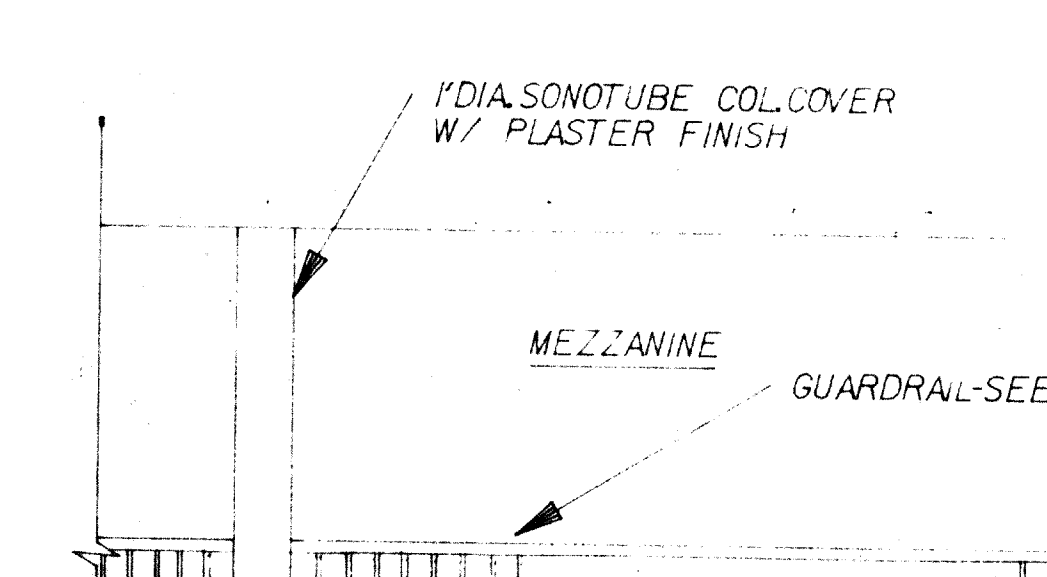


14 ELEVATION AT MACHINE WEIGHTS
 1/4" = 1'

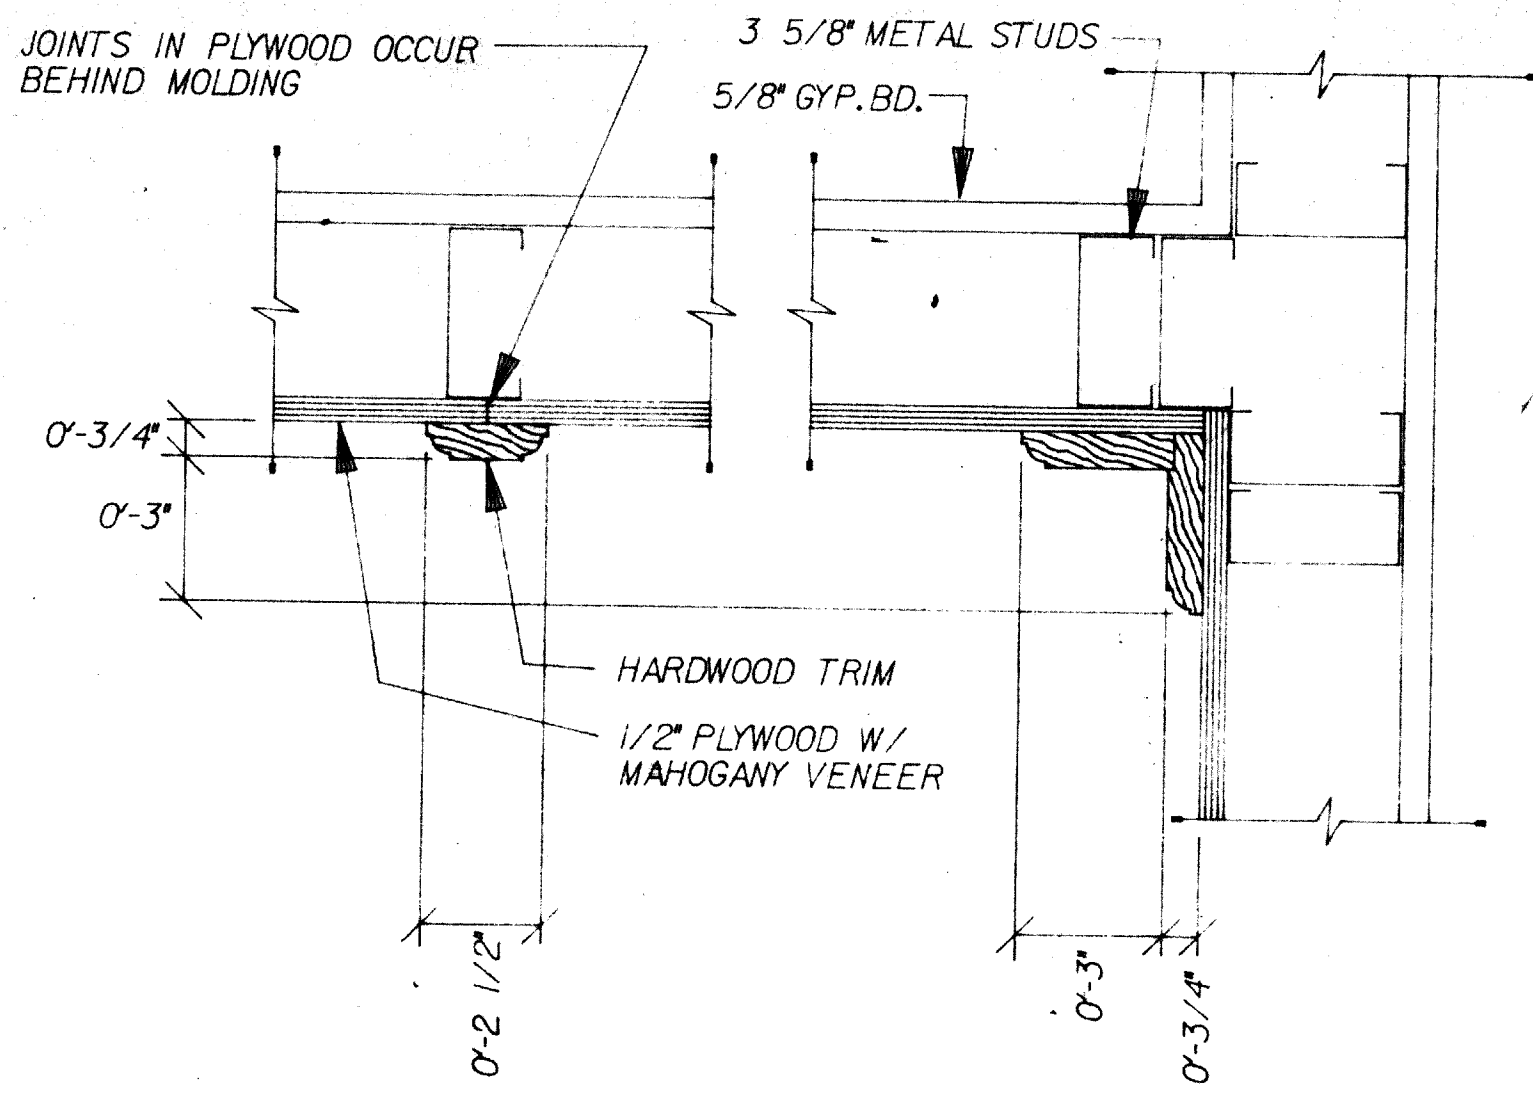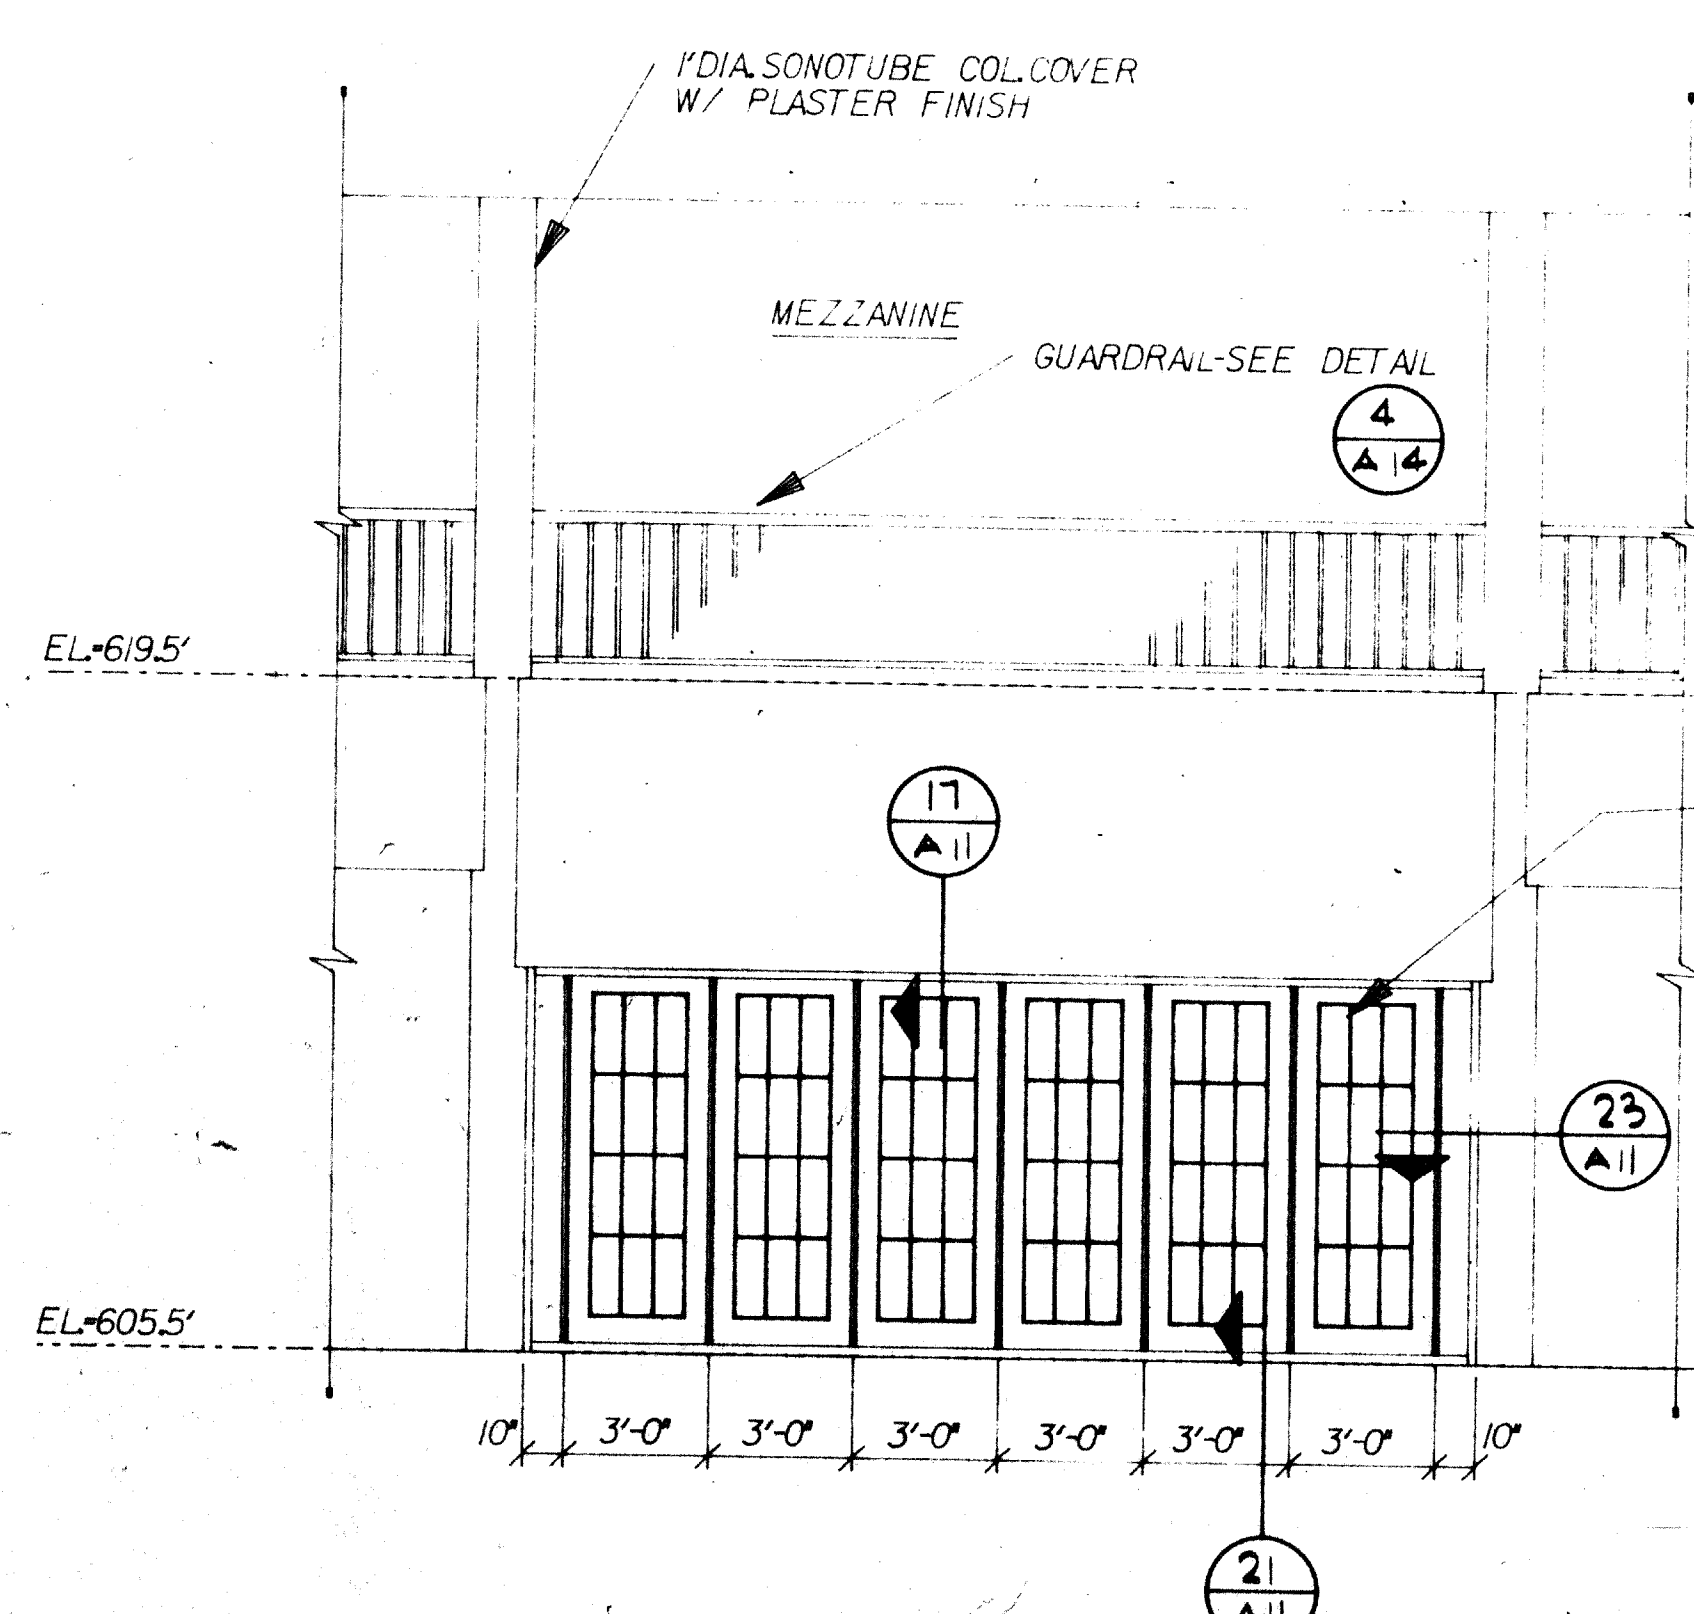


3 PANELING PLAN
 3" = 1'

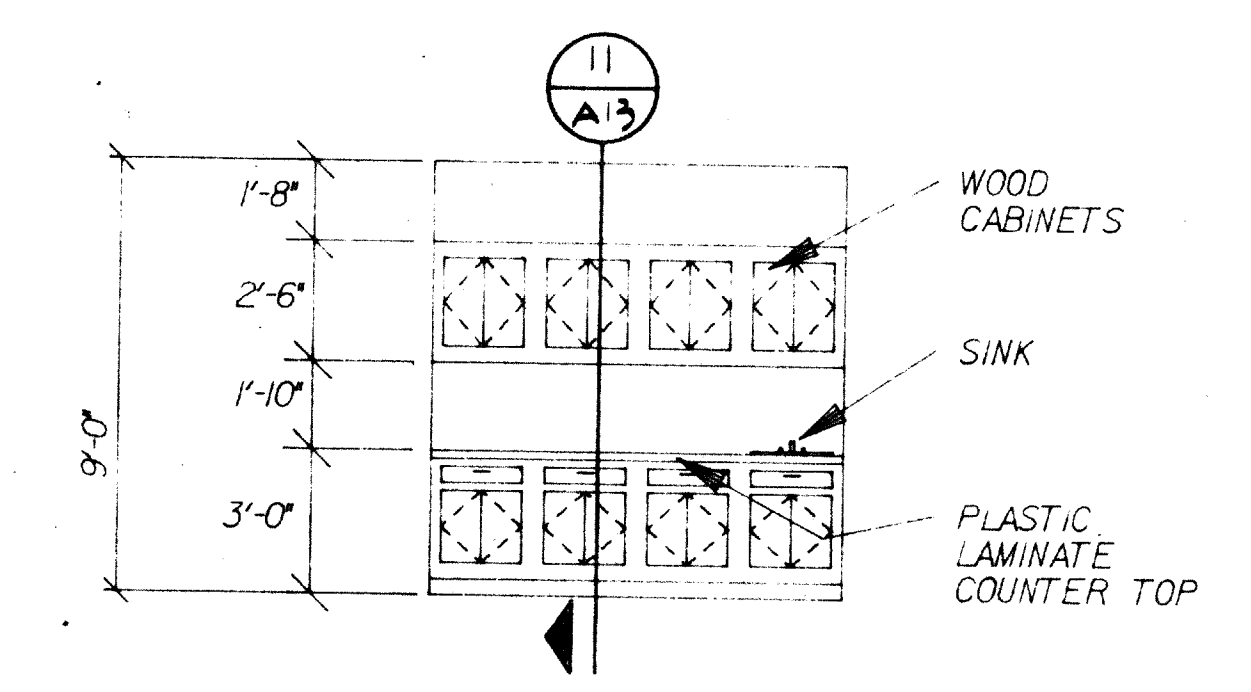

5 ELEV. AT COFFEE BAR
 1/4" = 1'

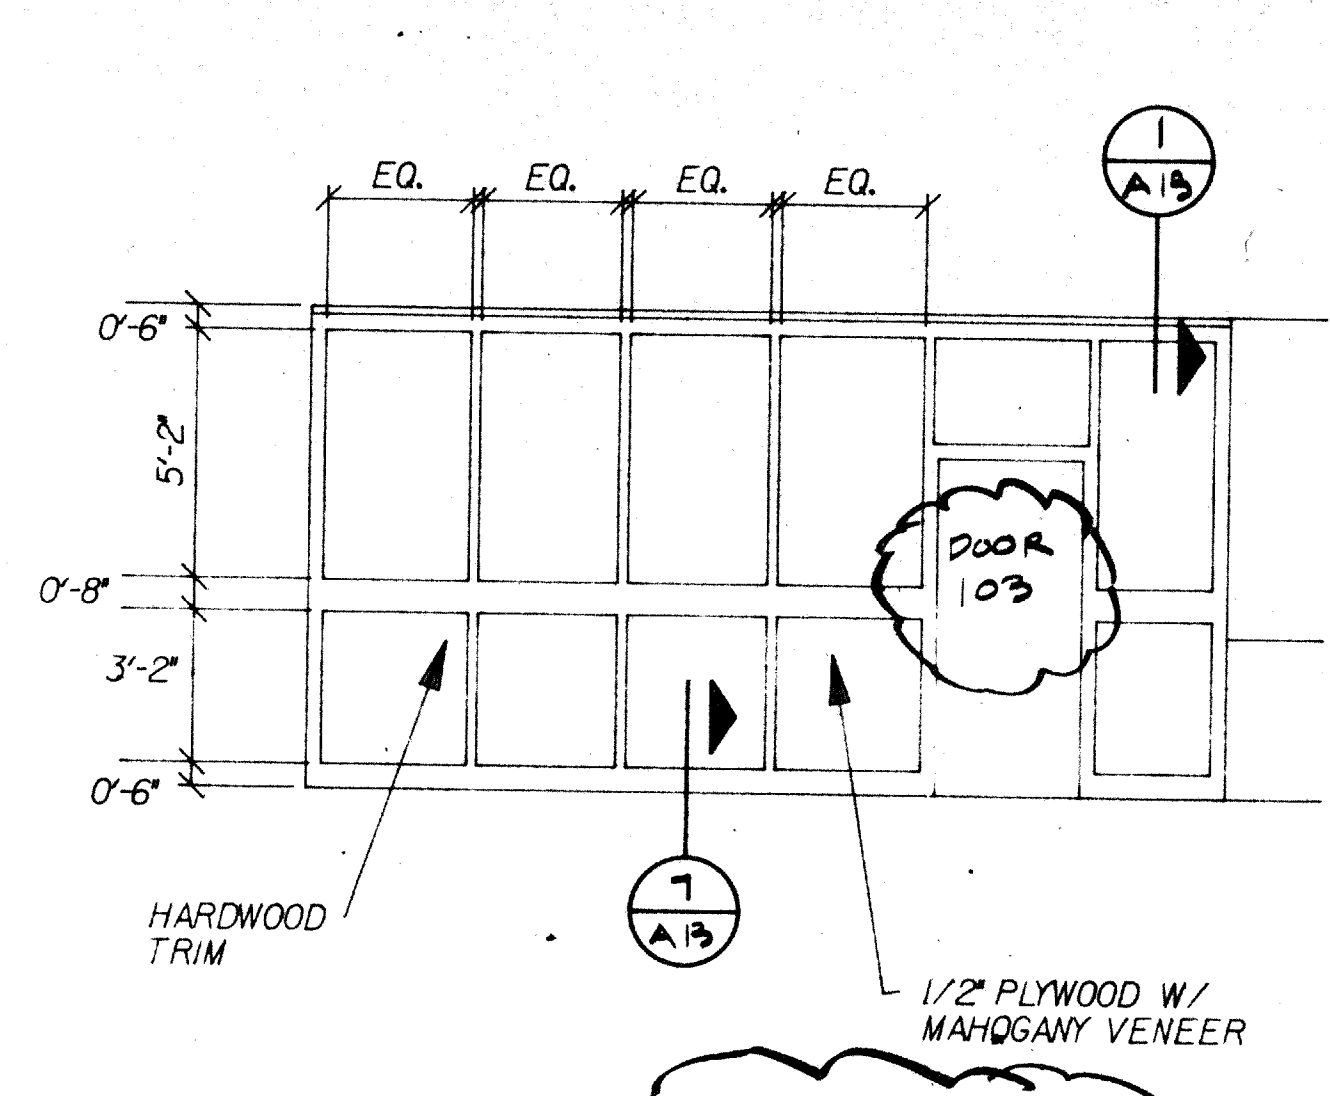


4 LOBBY EAST ELEV.
 1/4" = 1'

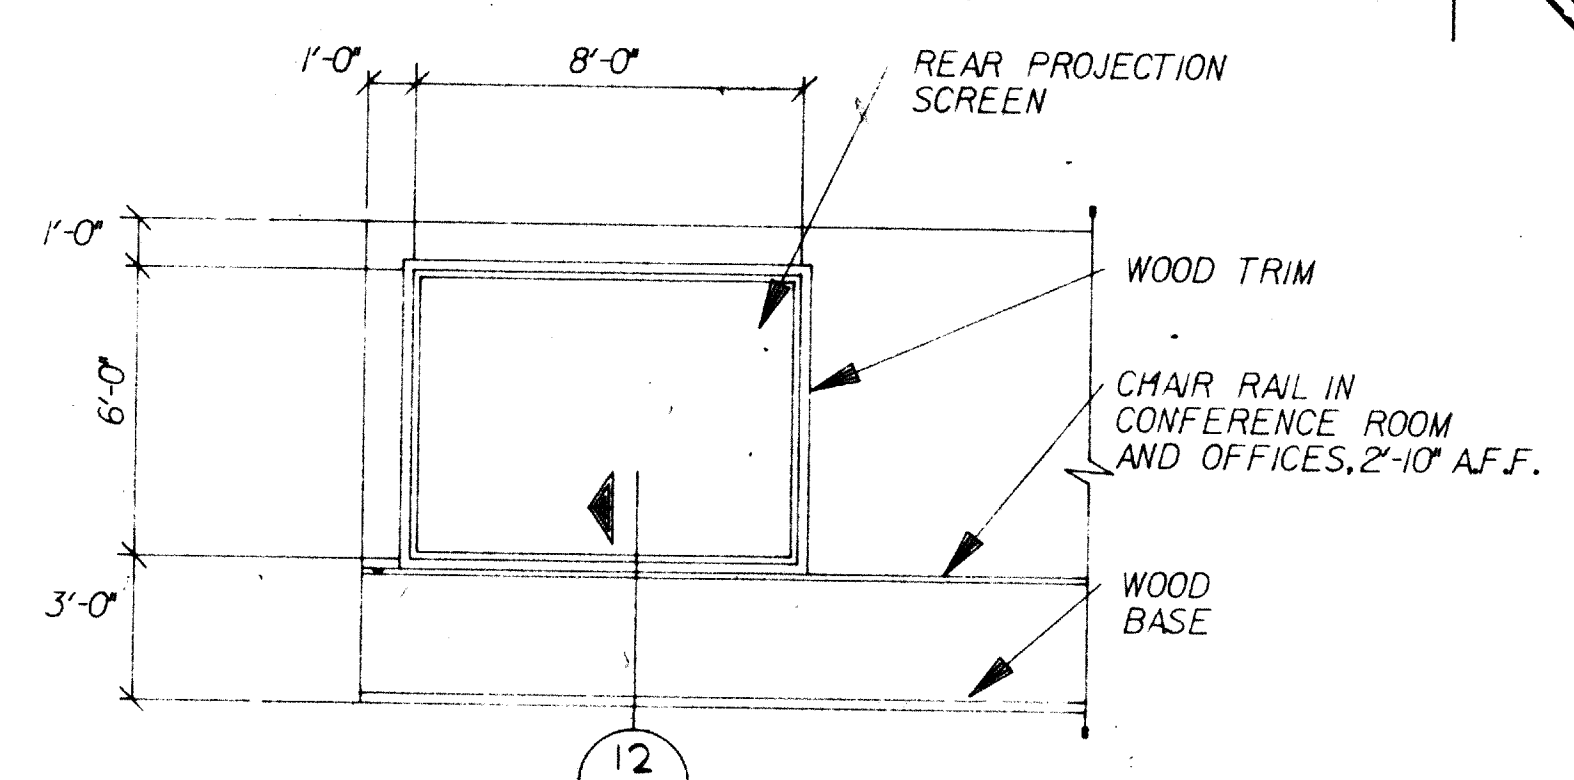


9 ELEV. AT REAR PROJECTION SCREEN
 1/4" = 1'


13 DETAIL-CEILING MOLDING
 3" = 1'

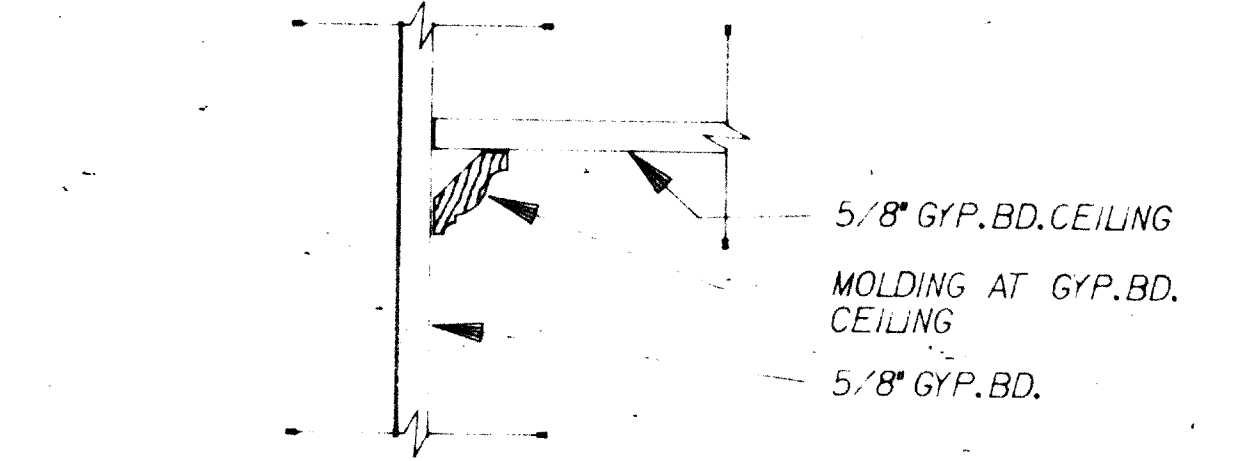


15 ENTRY DESK PLAN
 1/4" = 1'

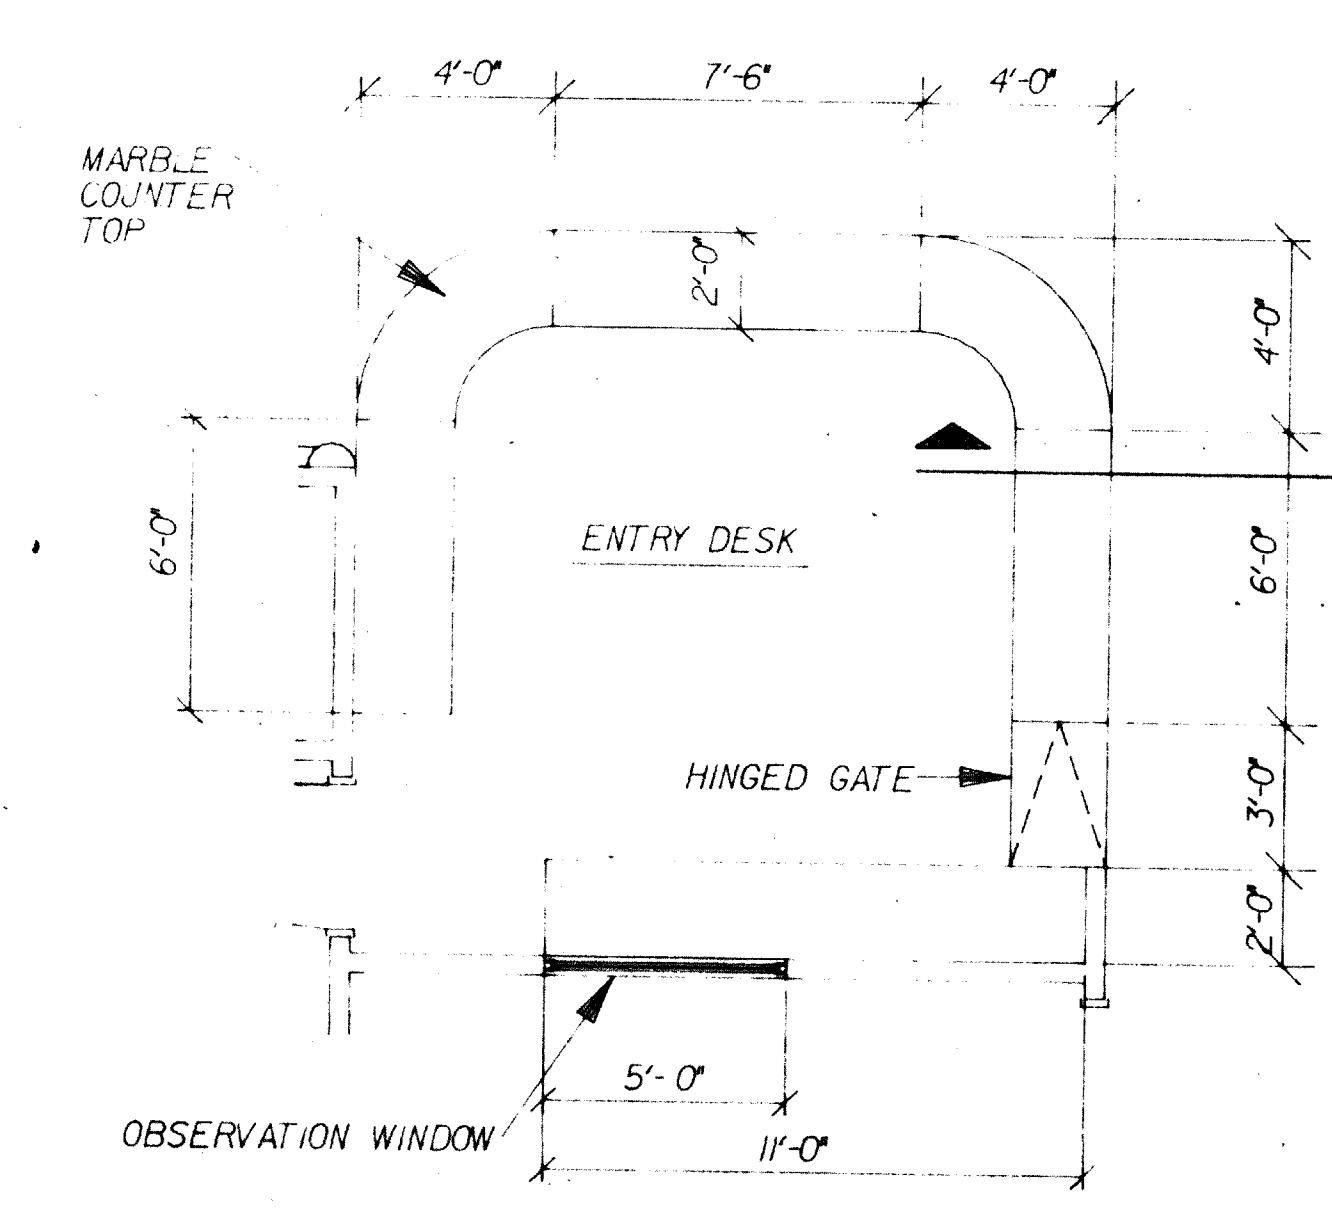


16 ELEV. AT ENTRY DESK
 1/4" = 1'

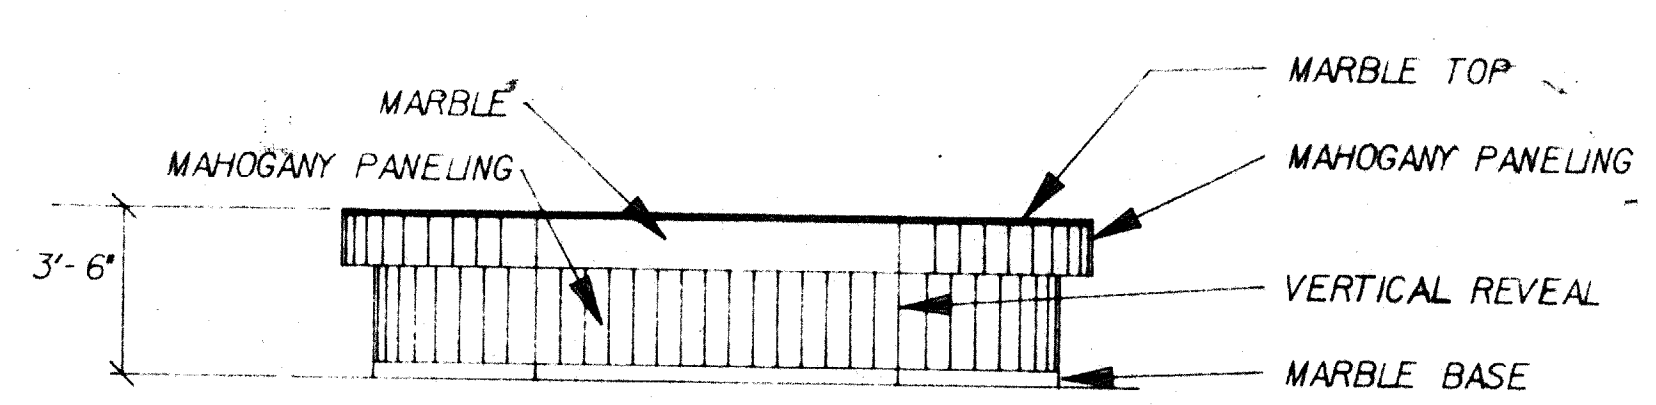


5 LOBBY NORTH ELEV.
 1/4" = 1'

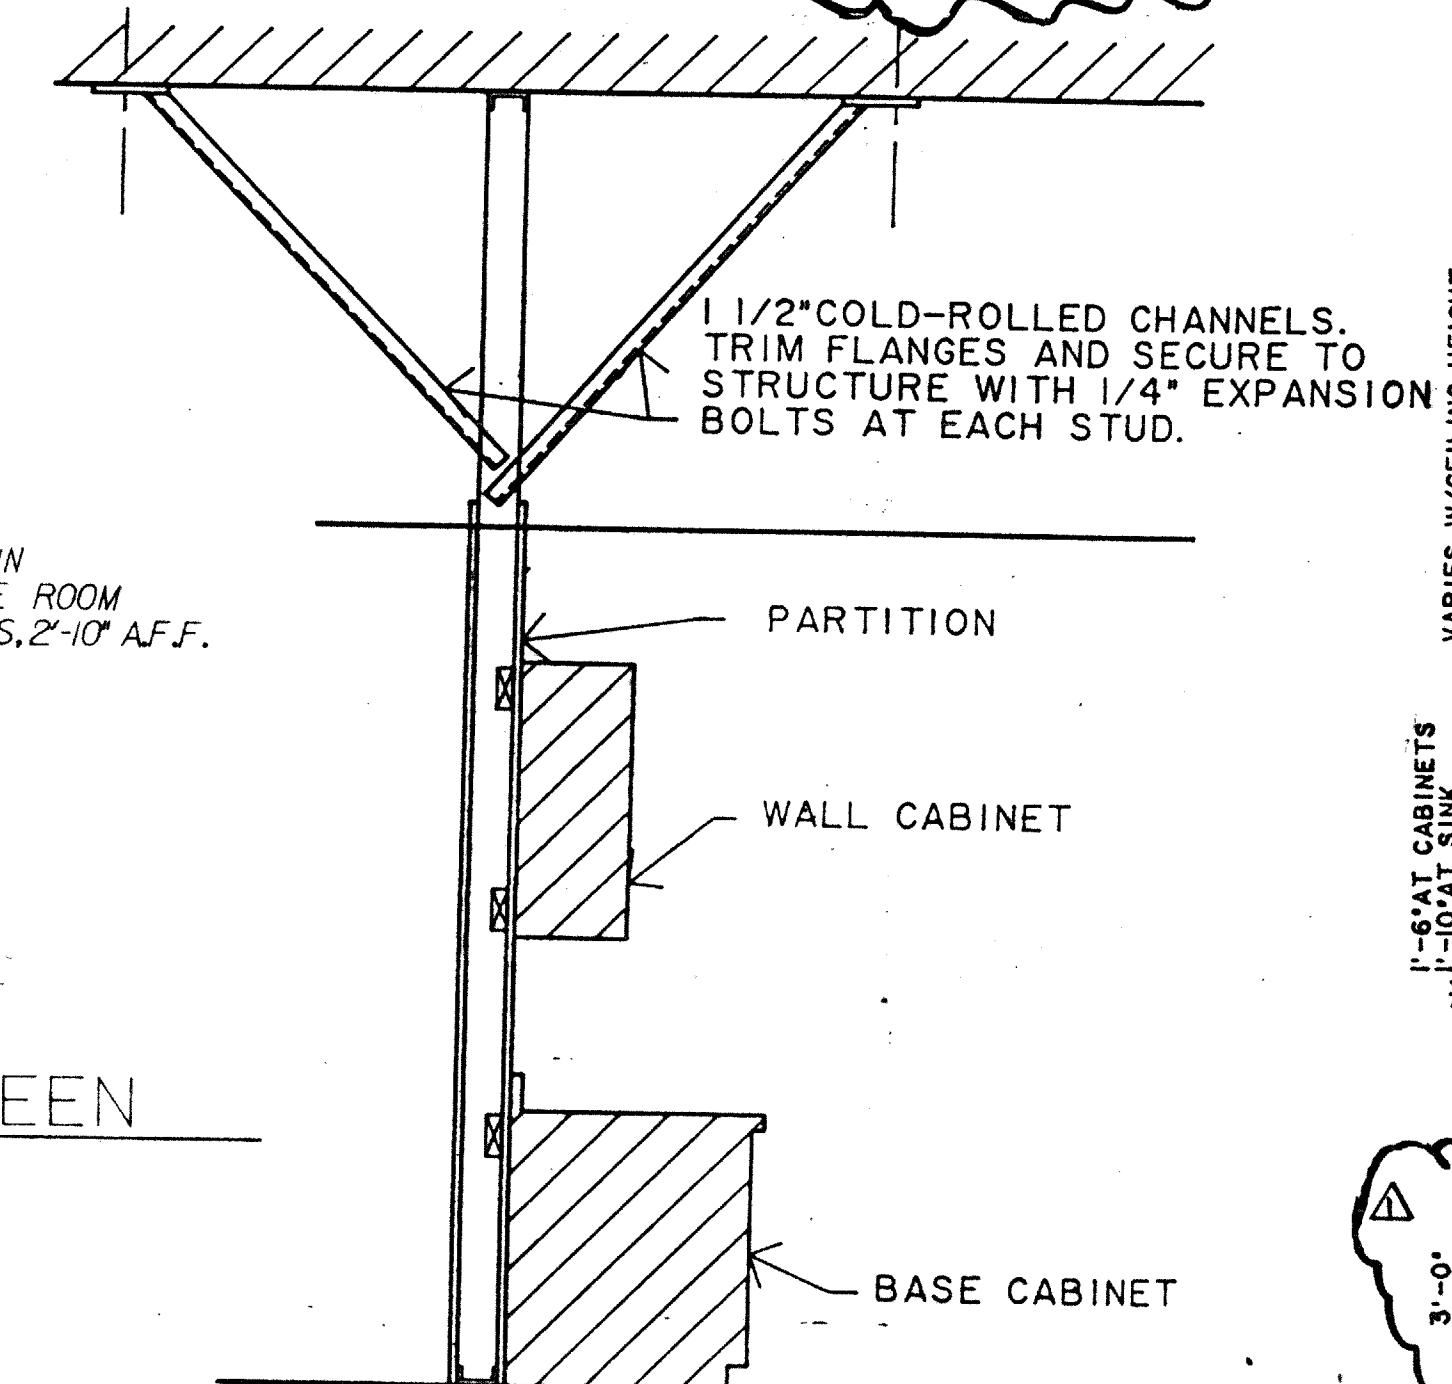


10 PARTITION BRACING FOR CASEWORK
 NOT TO SCALE

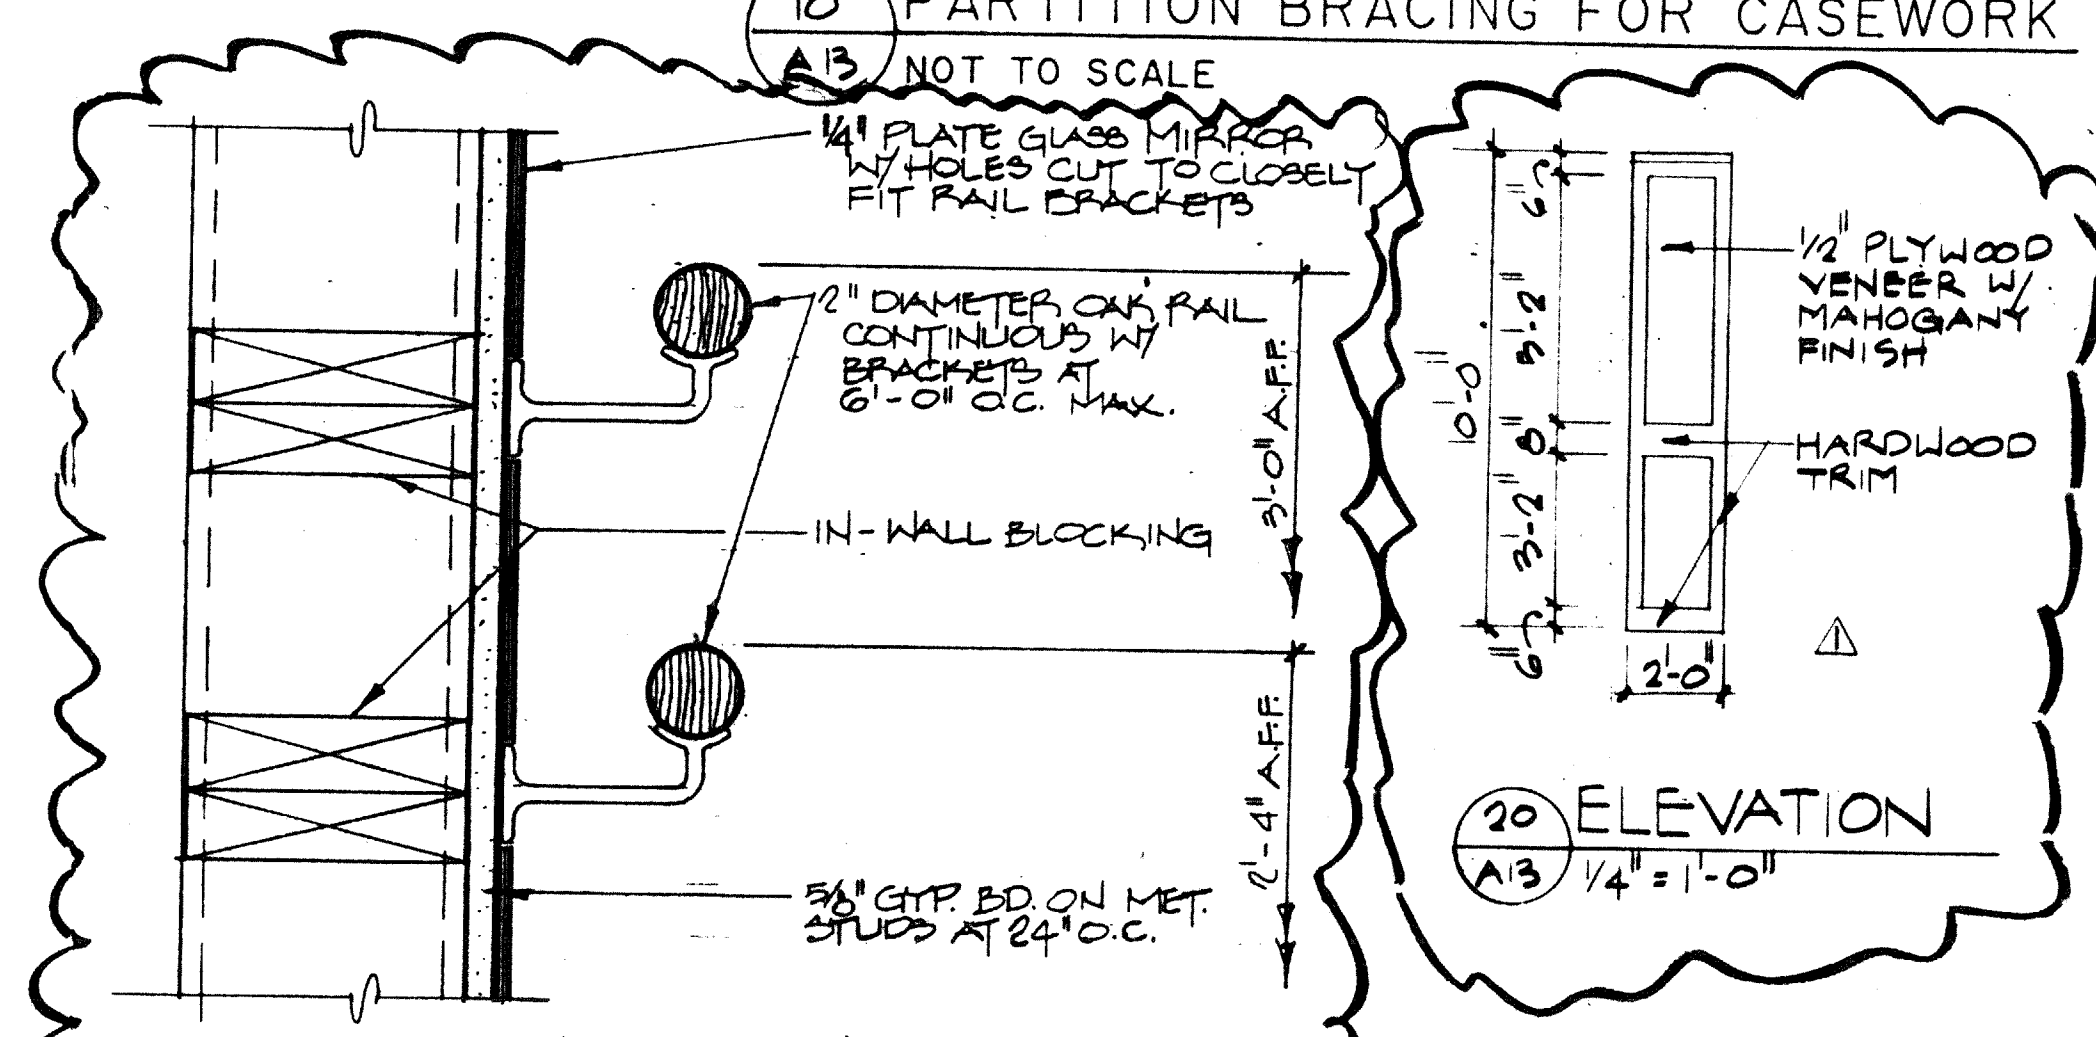


19 DETAIL @ EXERCISE BARS

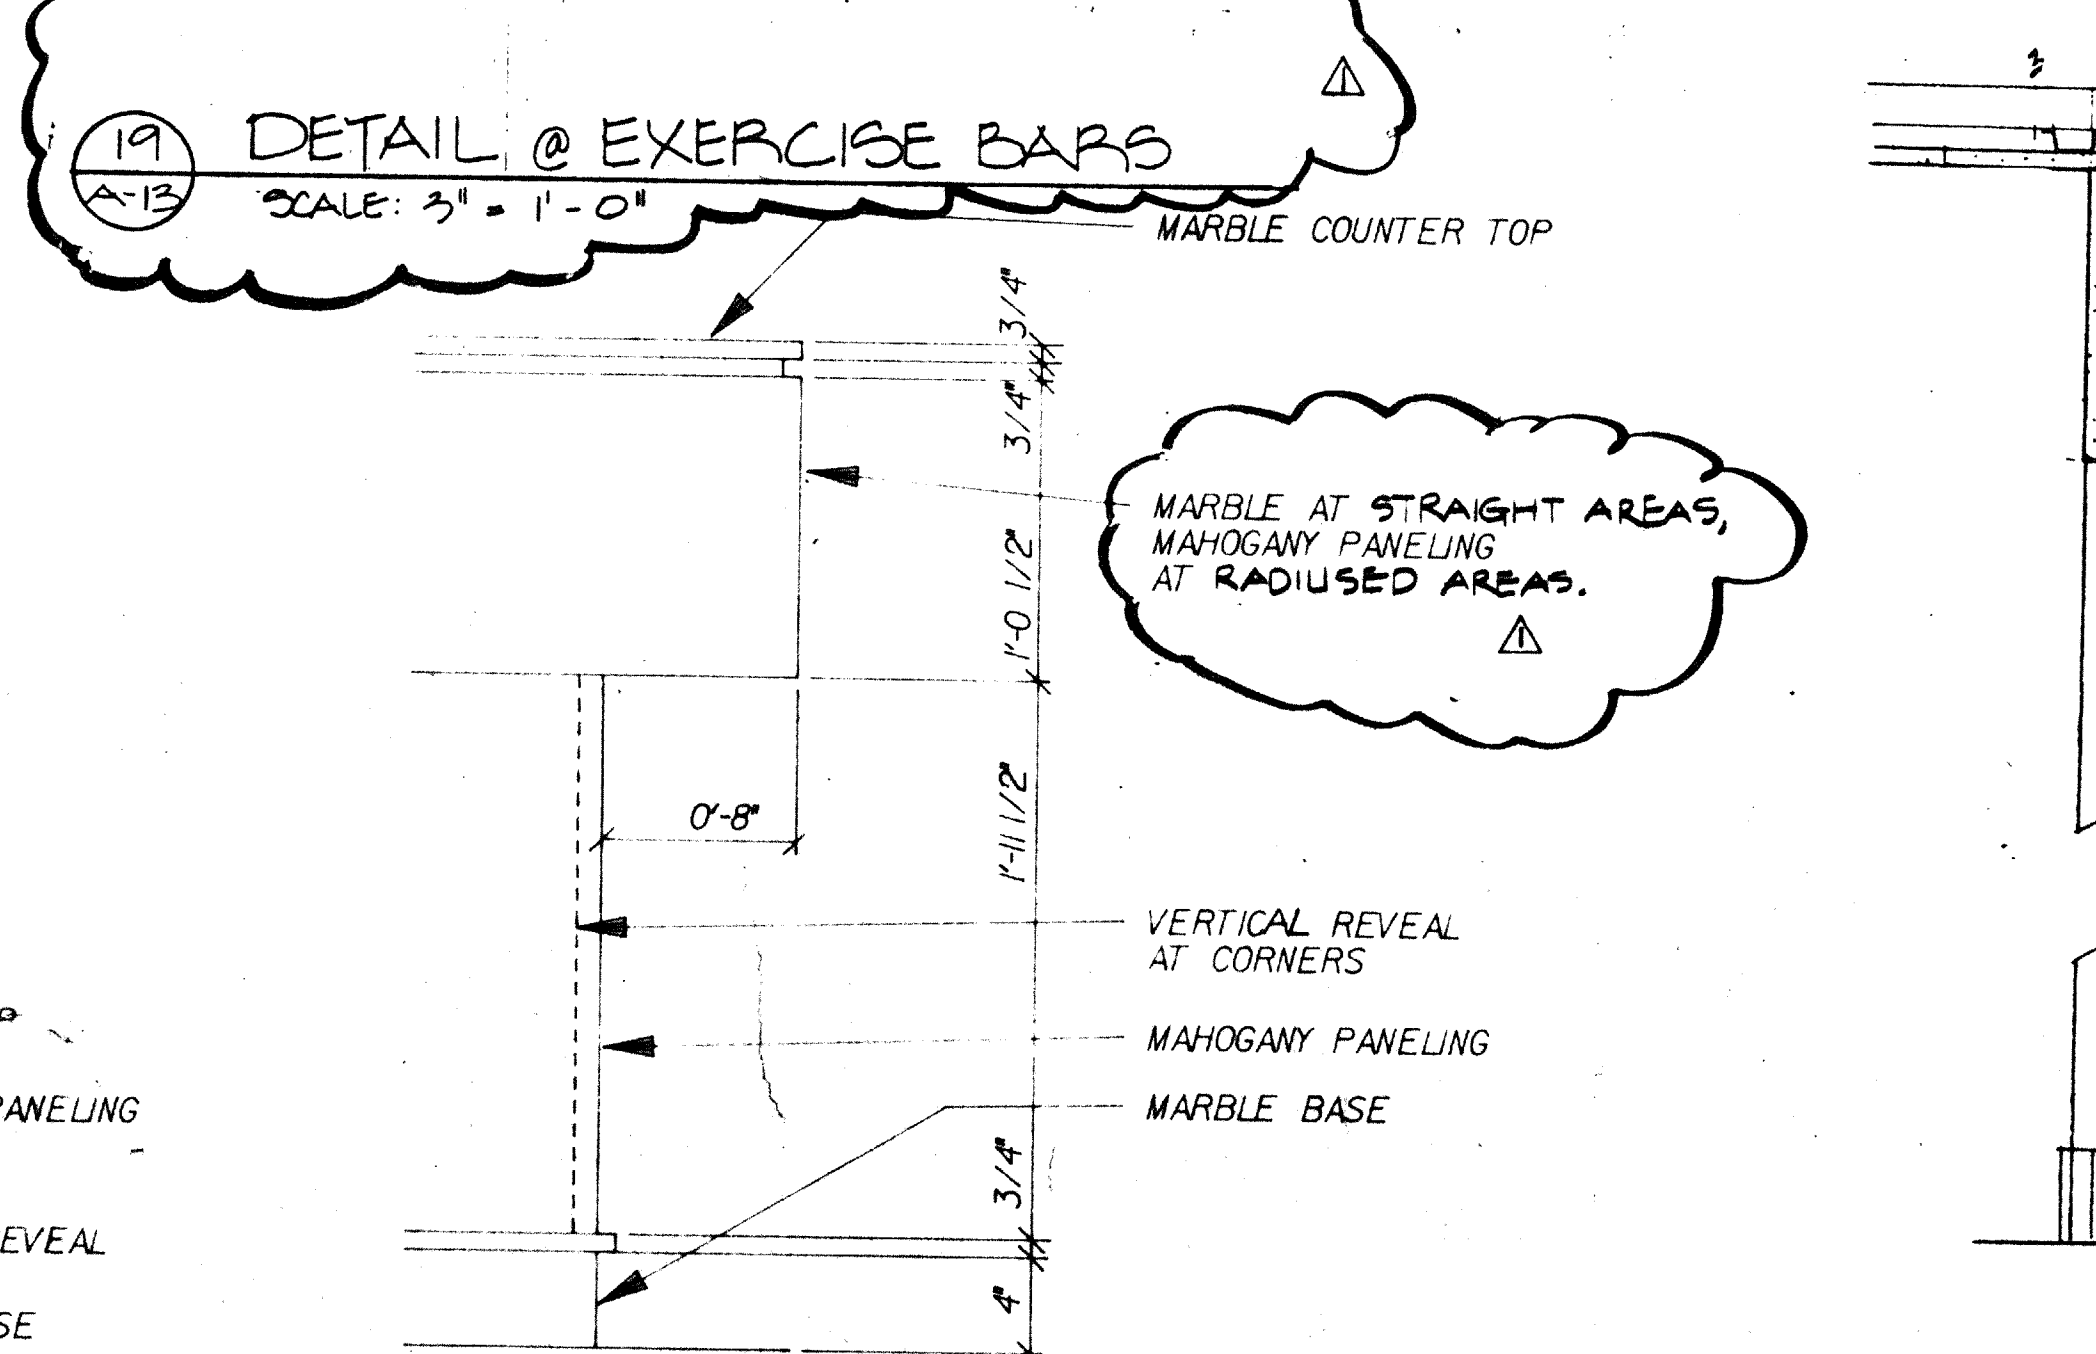


17 SECTION THRU ENTRY DESK
 1-1/2" = 1'

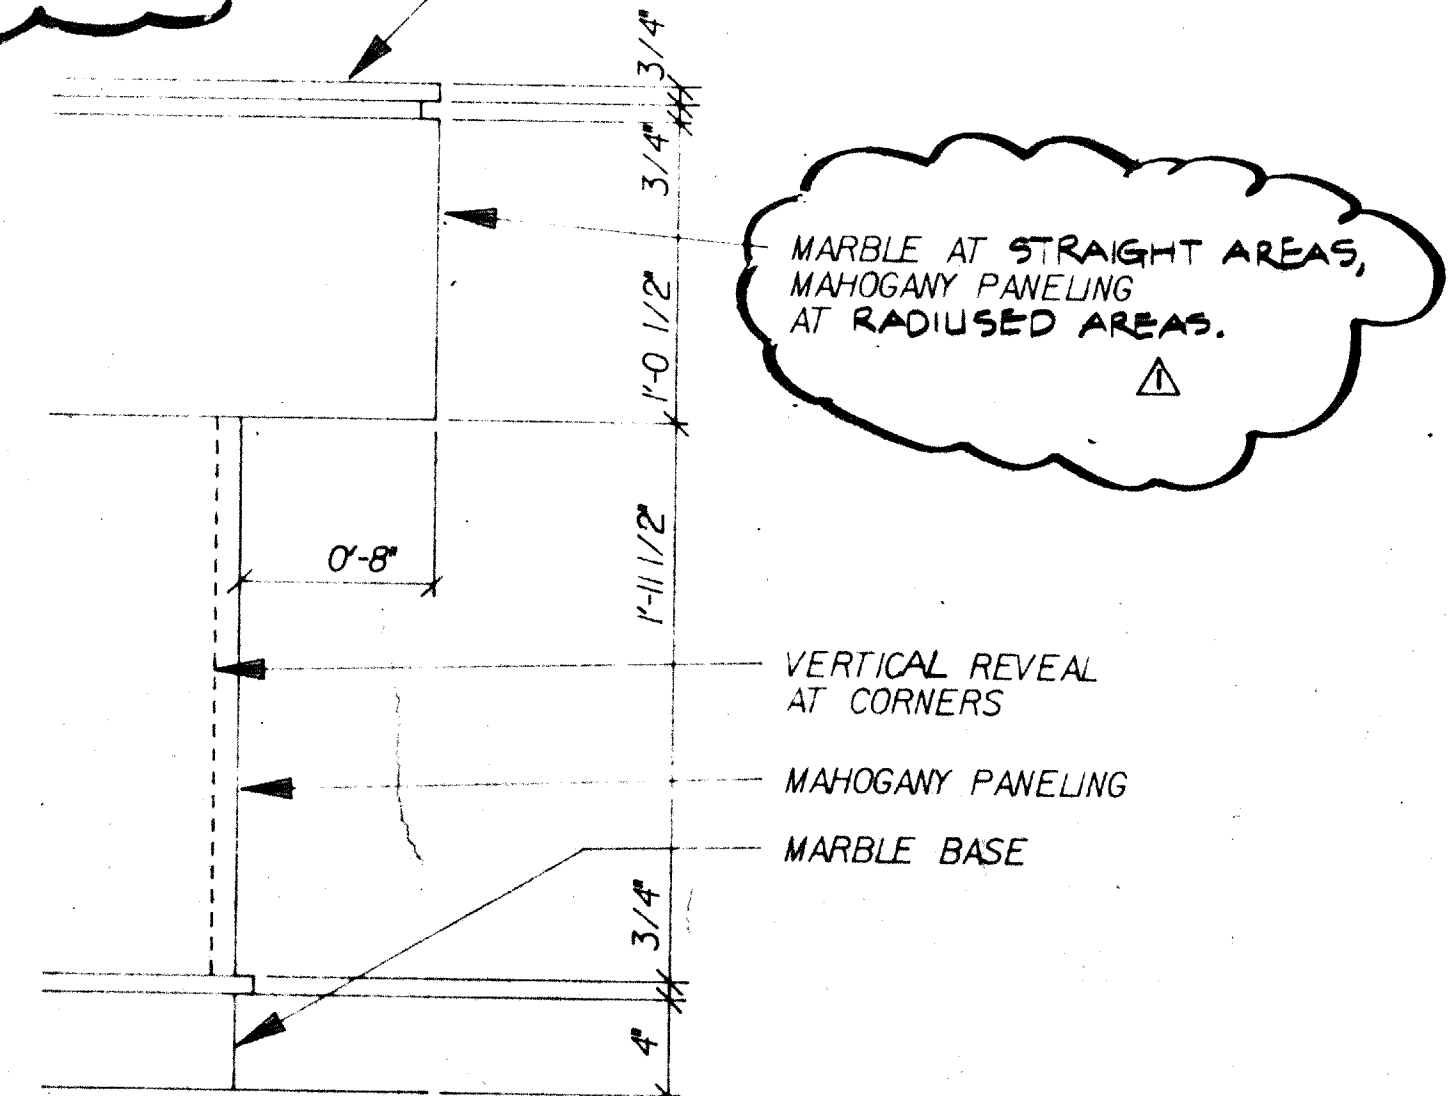

6 LOBBY WEST ELEV.
 1/4" = 1'

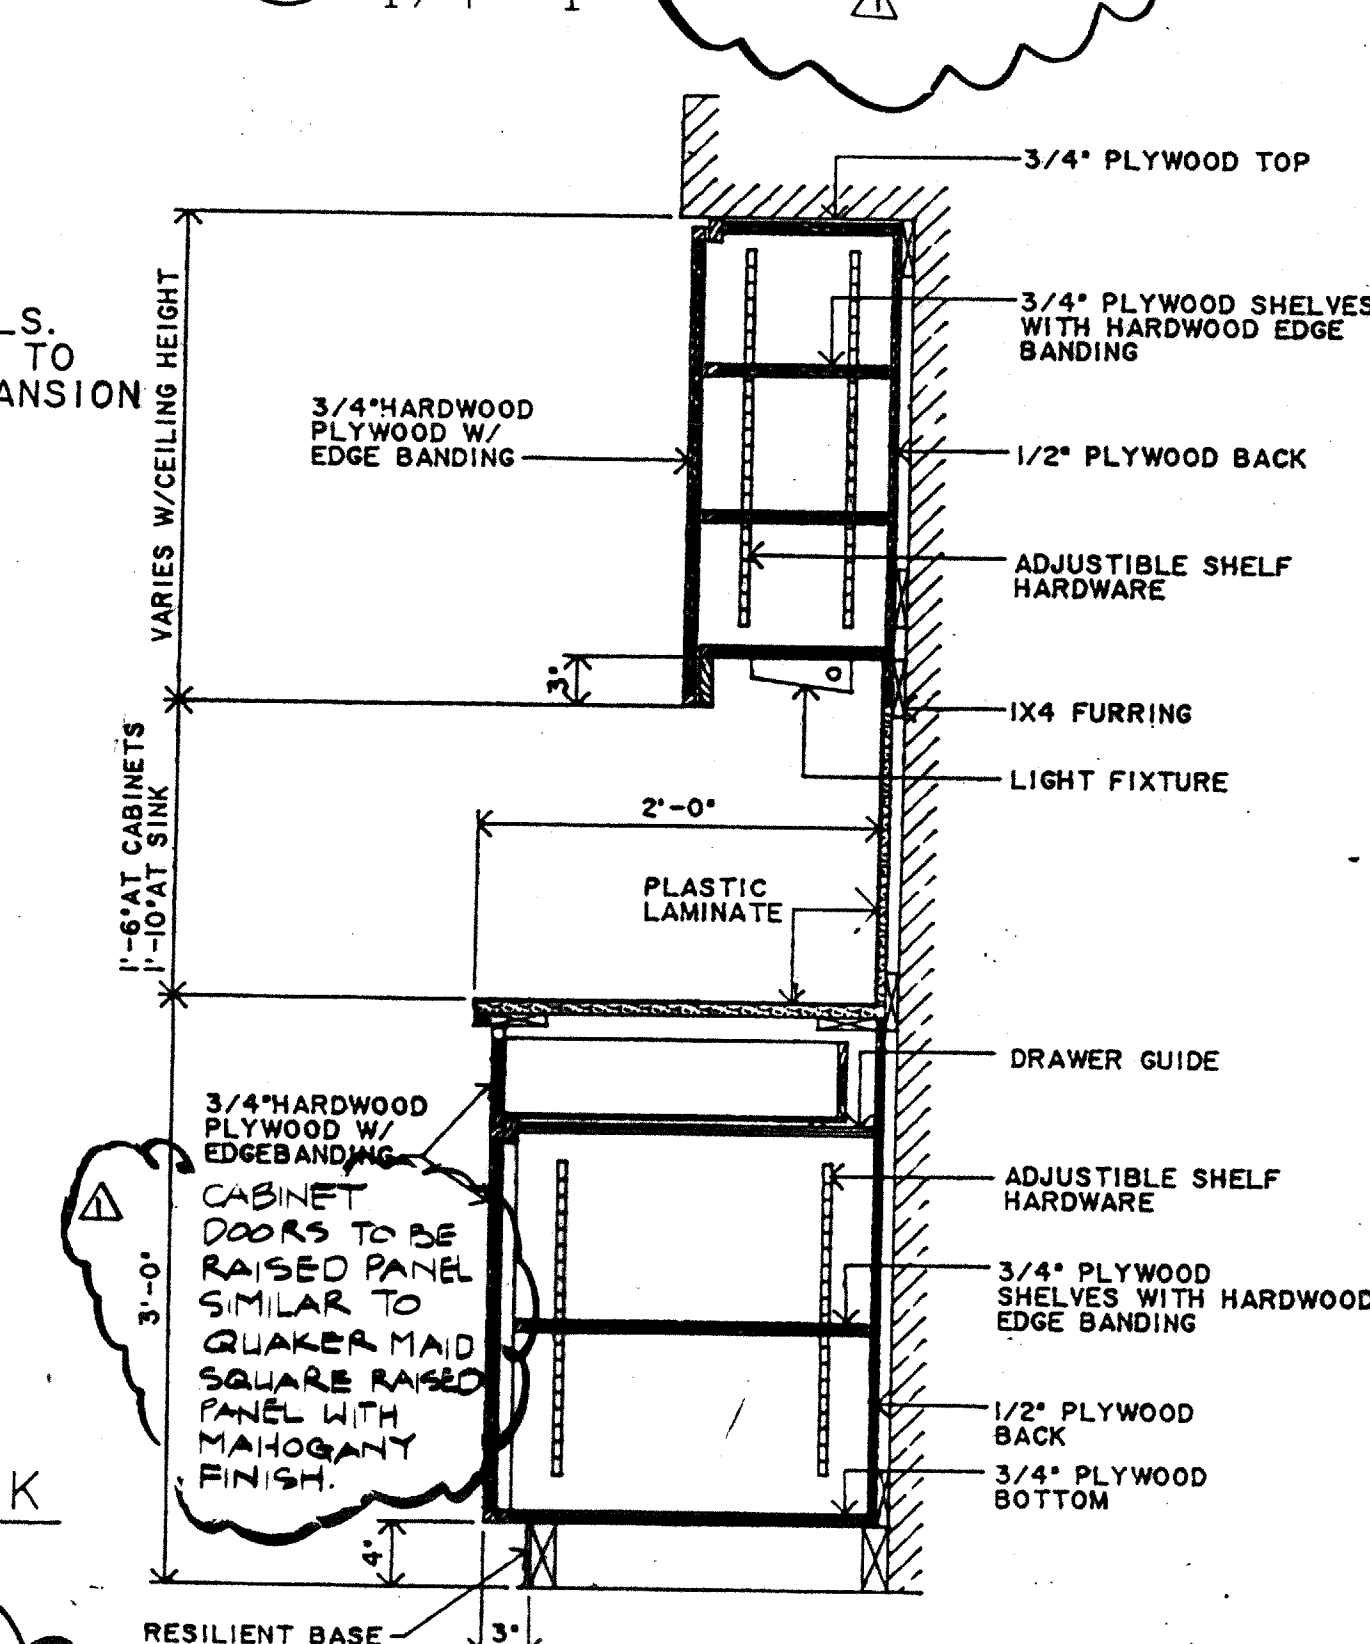

11 KITCHEN CABINETS (WITH LIGHT)
 SCALE: 1\"/>

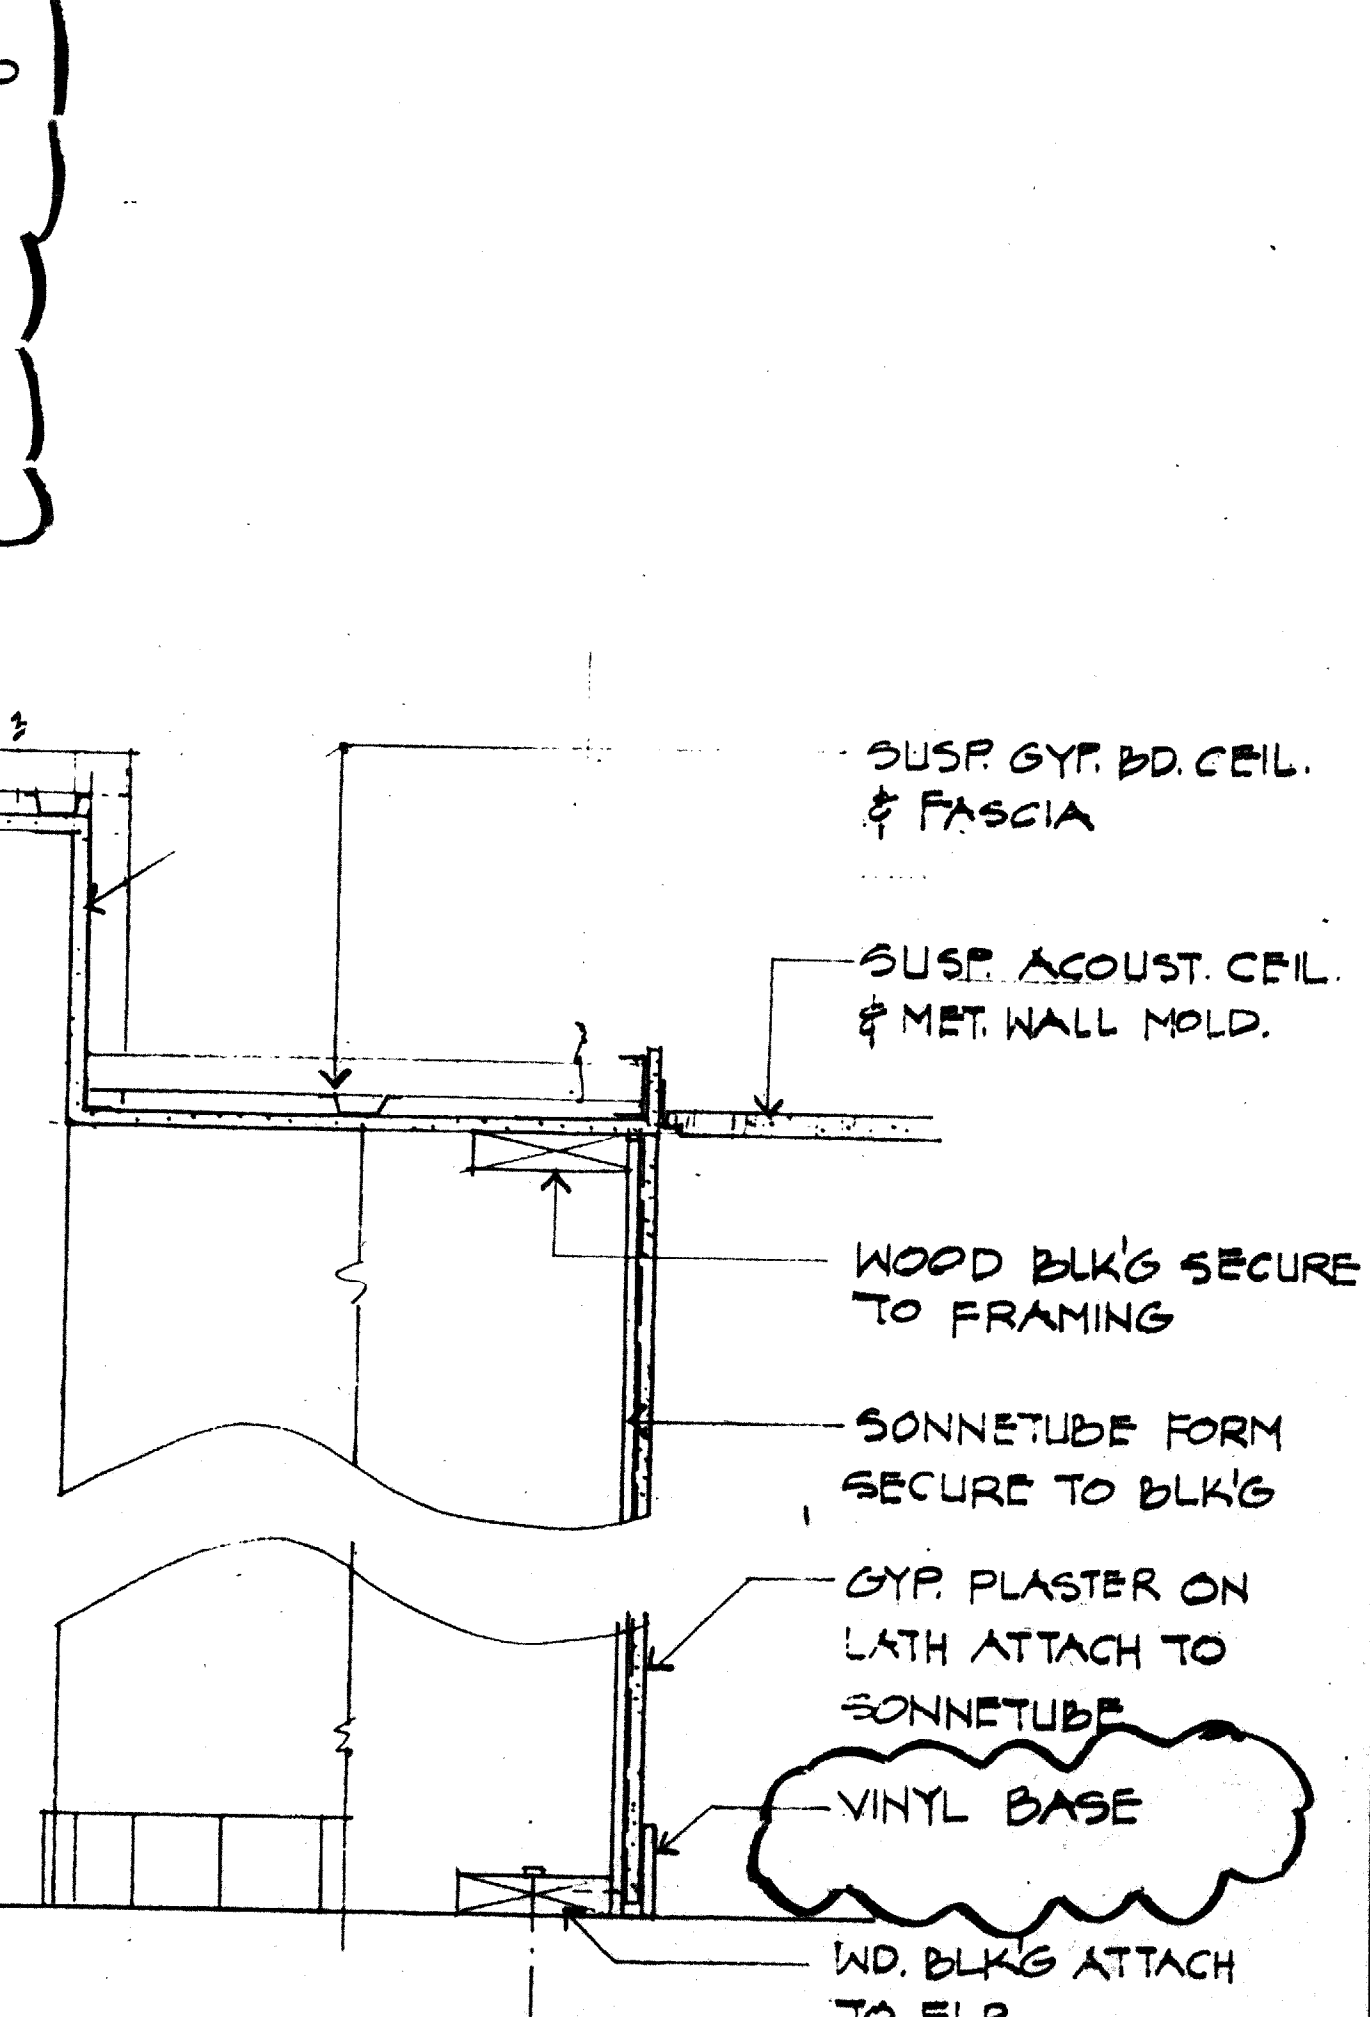

18 SECTION ROUND COLUMN
 1/2" = 1-0"

