



SHEET NO.	
BASE	
REVISED	
DATE	

**ADDISON RECREATION CENTER**  
 3900 BELTWAY DRIVE  
 ADDISON, TEXAS

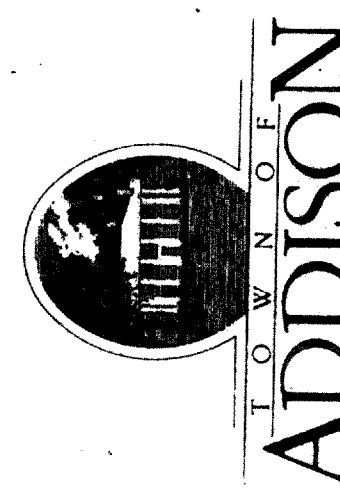

**The Benham Group** Dallas

architects  
 engineers  
 planners  
 1341 w. mockingbird ln.  
 suite 517 e  
 dallas, texas

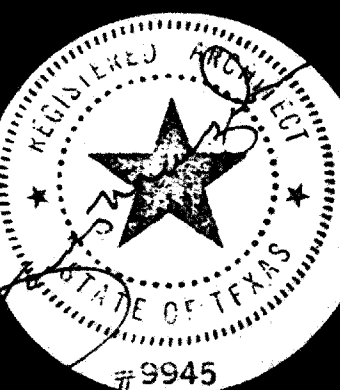


**STAIR SECTIONS and DETAILS**

drawn **M. HAMILTON**  
 chkd **H. ADAMS**  
 date **3-10-88**  
 revisions

no. **4-21-88**  
 date

Sheet **A-14**

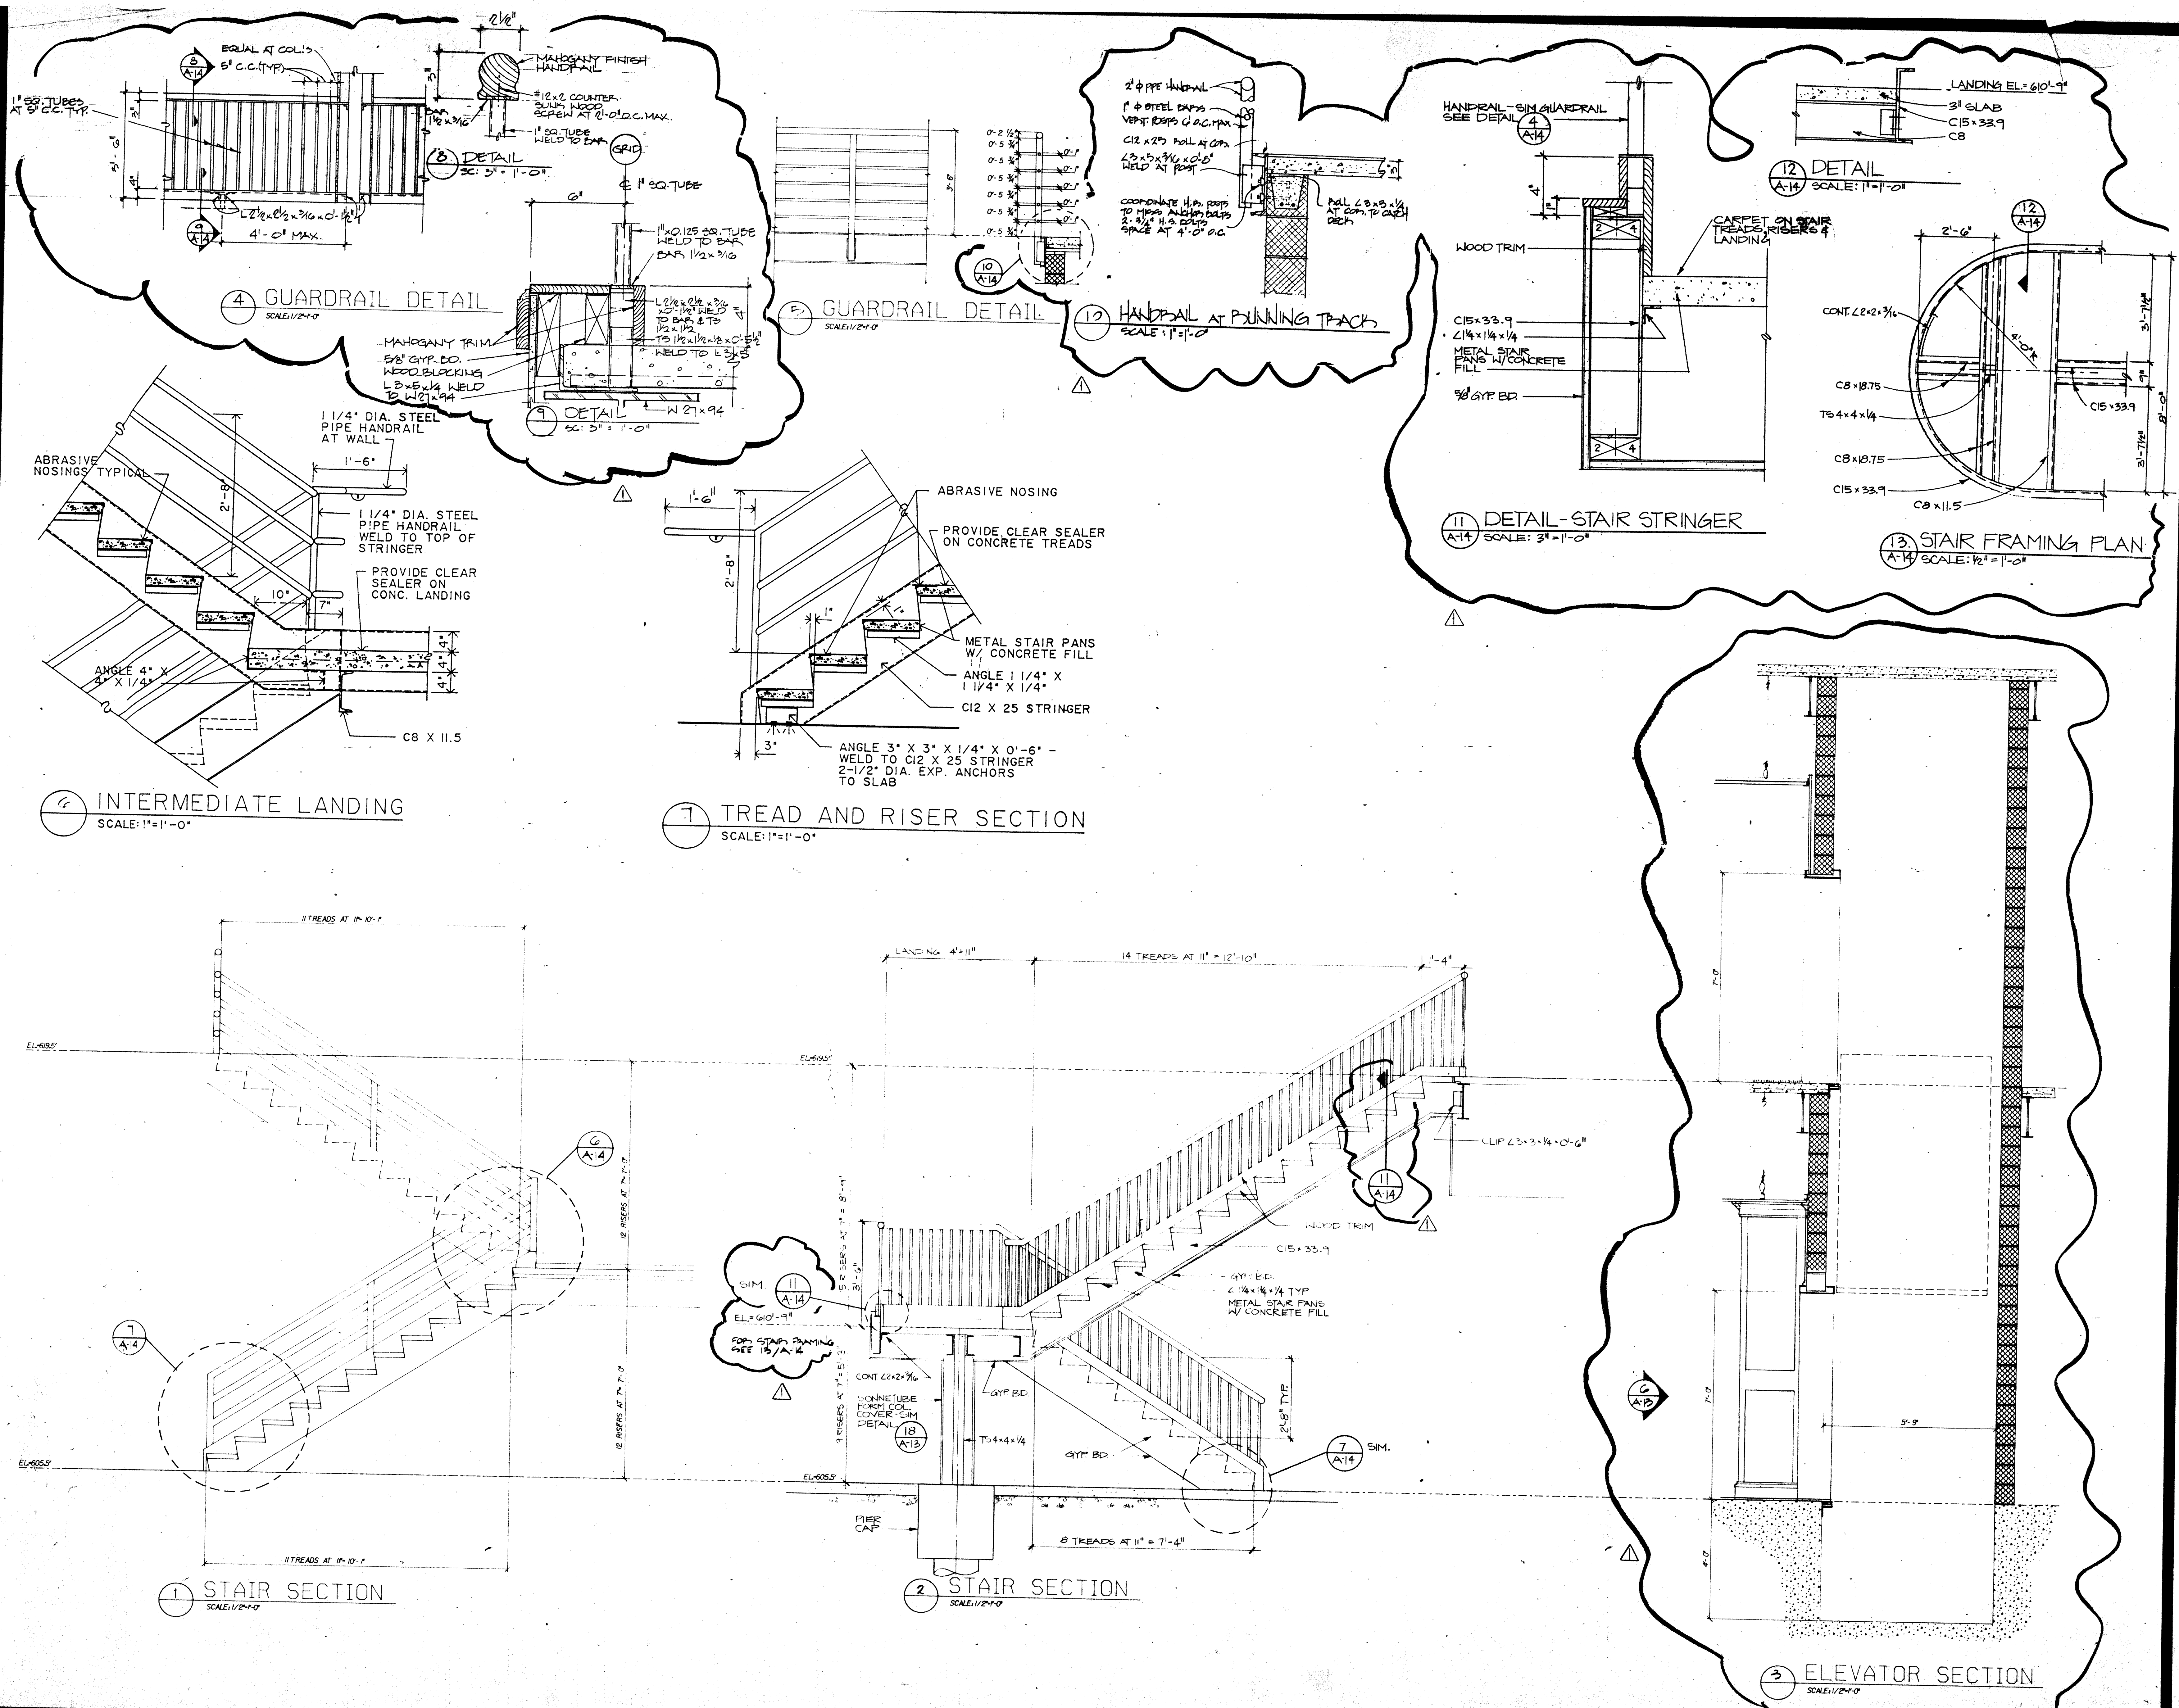

Sheet **A-14**