




SHEET NO.	
DATE	
BY	
CHKD	
APP'D	

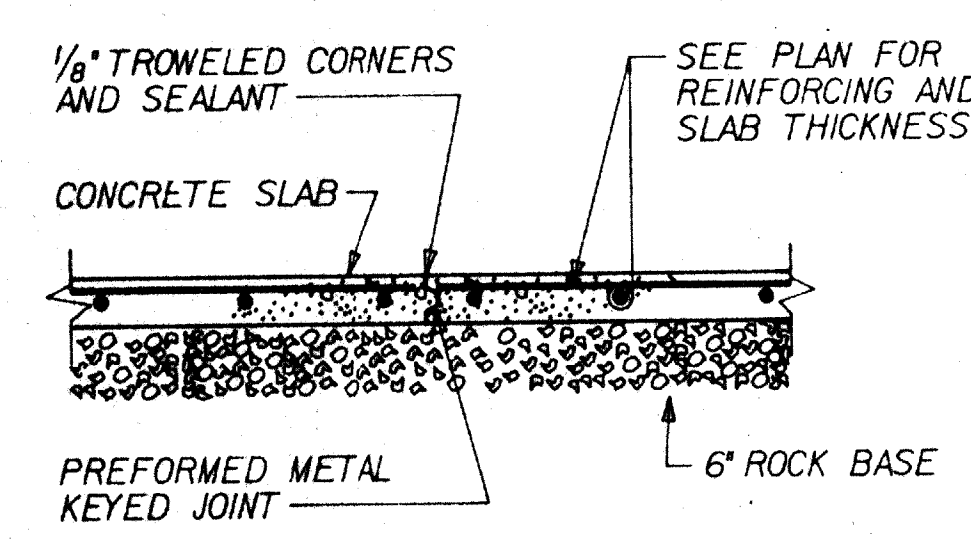


TYPICAL DETAIL AT CONSTRUCTION JOINTS (C.J.)
NO SCALE

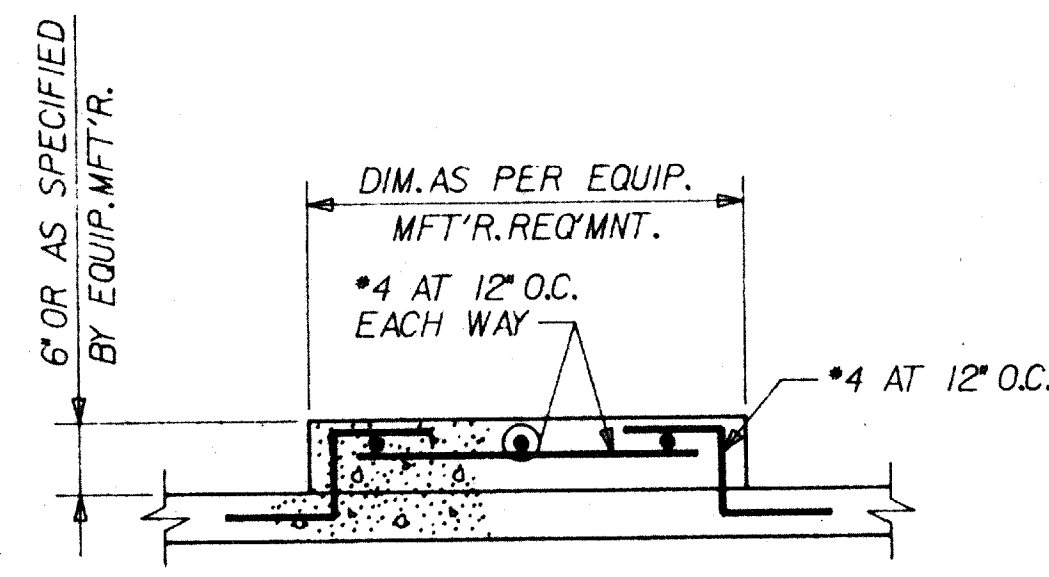


TYPICAL EQUIPMENT HOUSEKEEPING PAD
NO SCALE

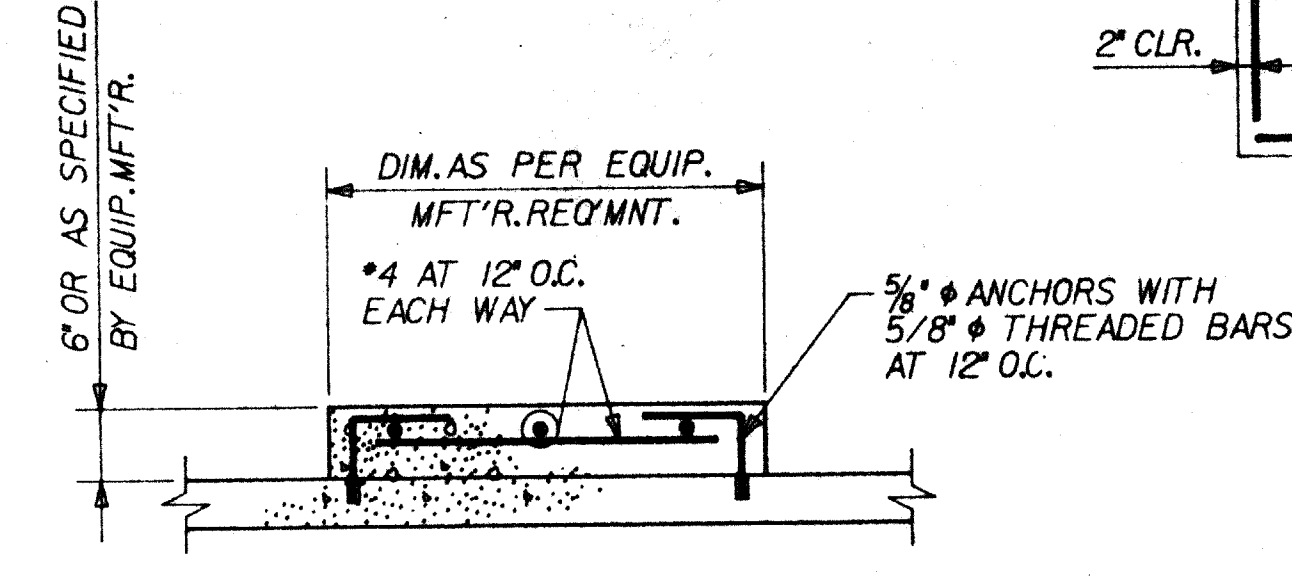


ALTERNATE EQUIPMENT HOUSEKEEPING PAD
NO SCALE

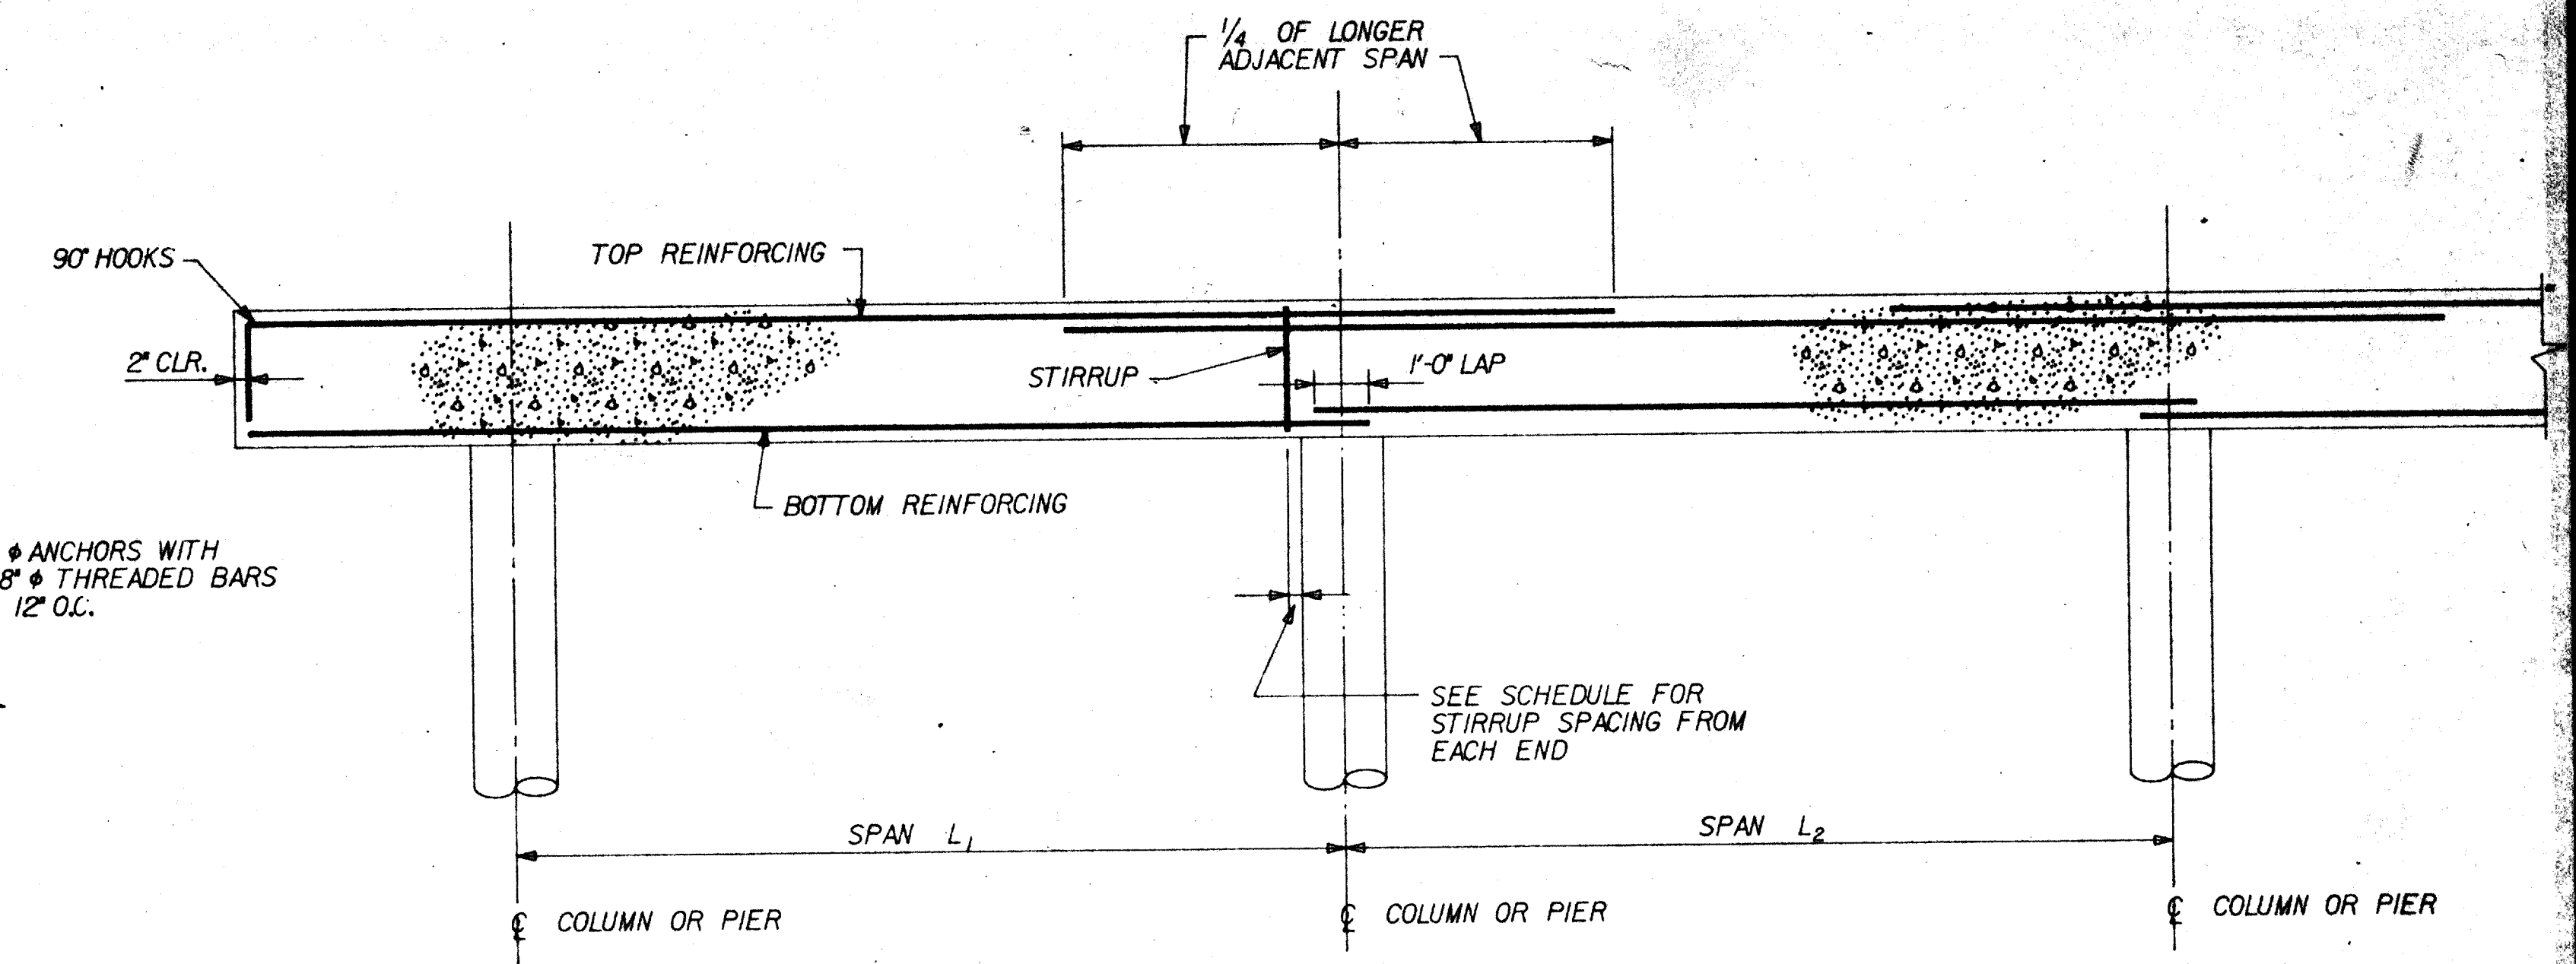


TYPICAL BEAM ELEVATION
NO SCALE

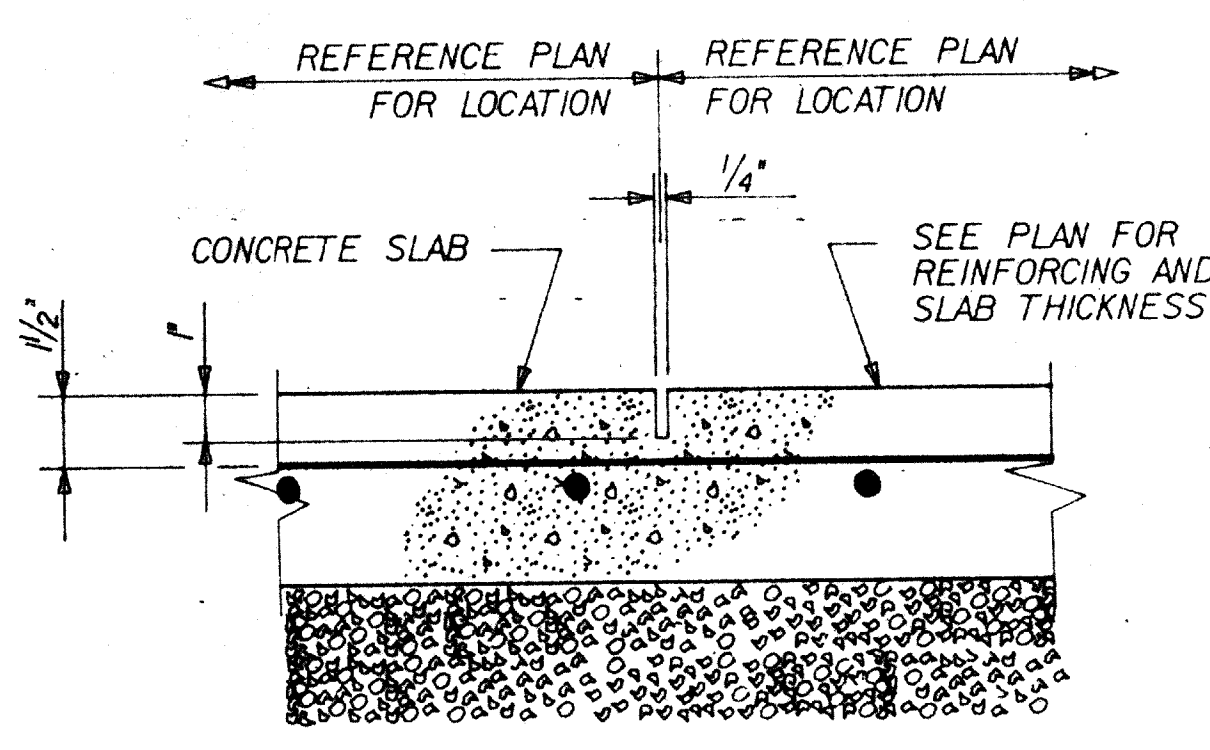


TYPICAL DETAIL AT SAWED JOINTS (S.J.)
NO SCALE

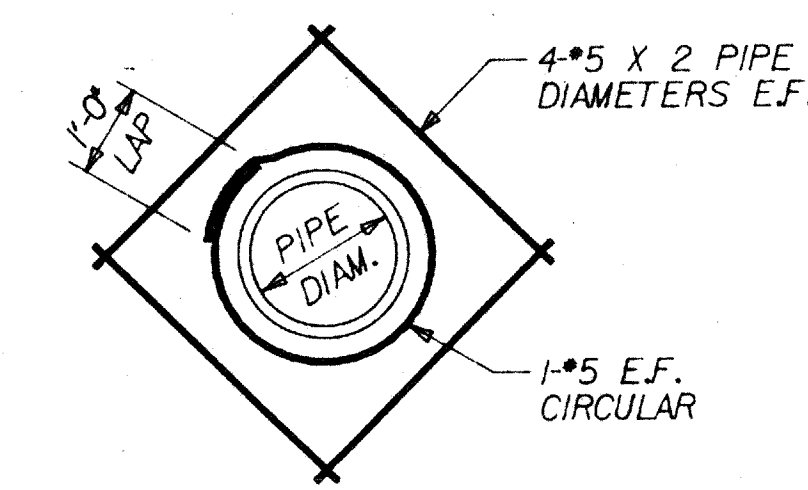

TYPICAL REINFORCING AT PIPE PENETRATION
NO SCALE

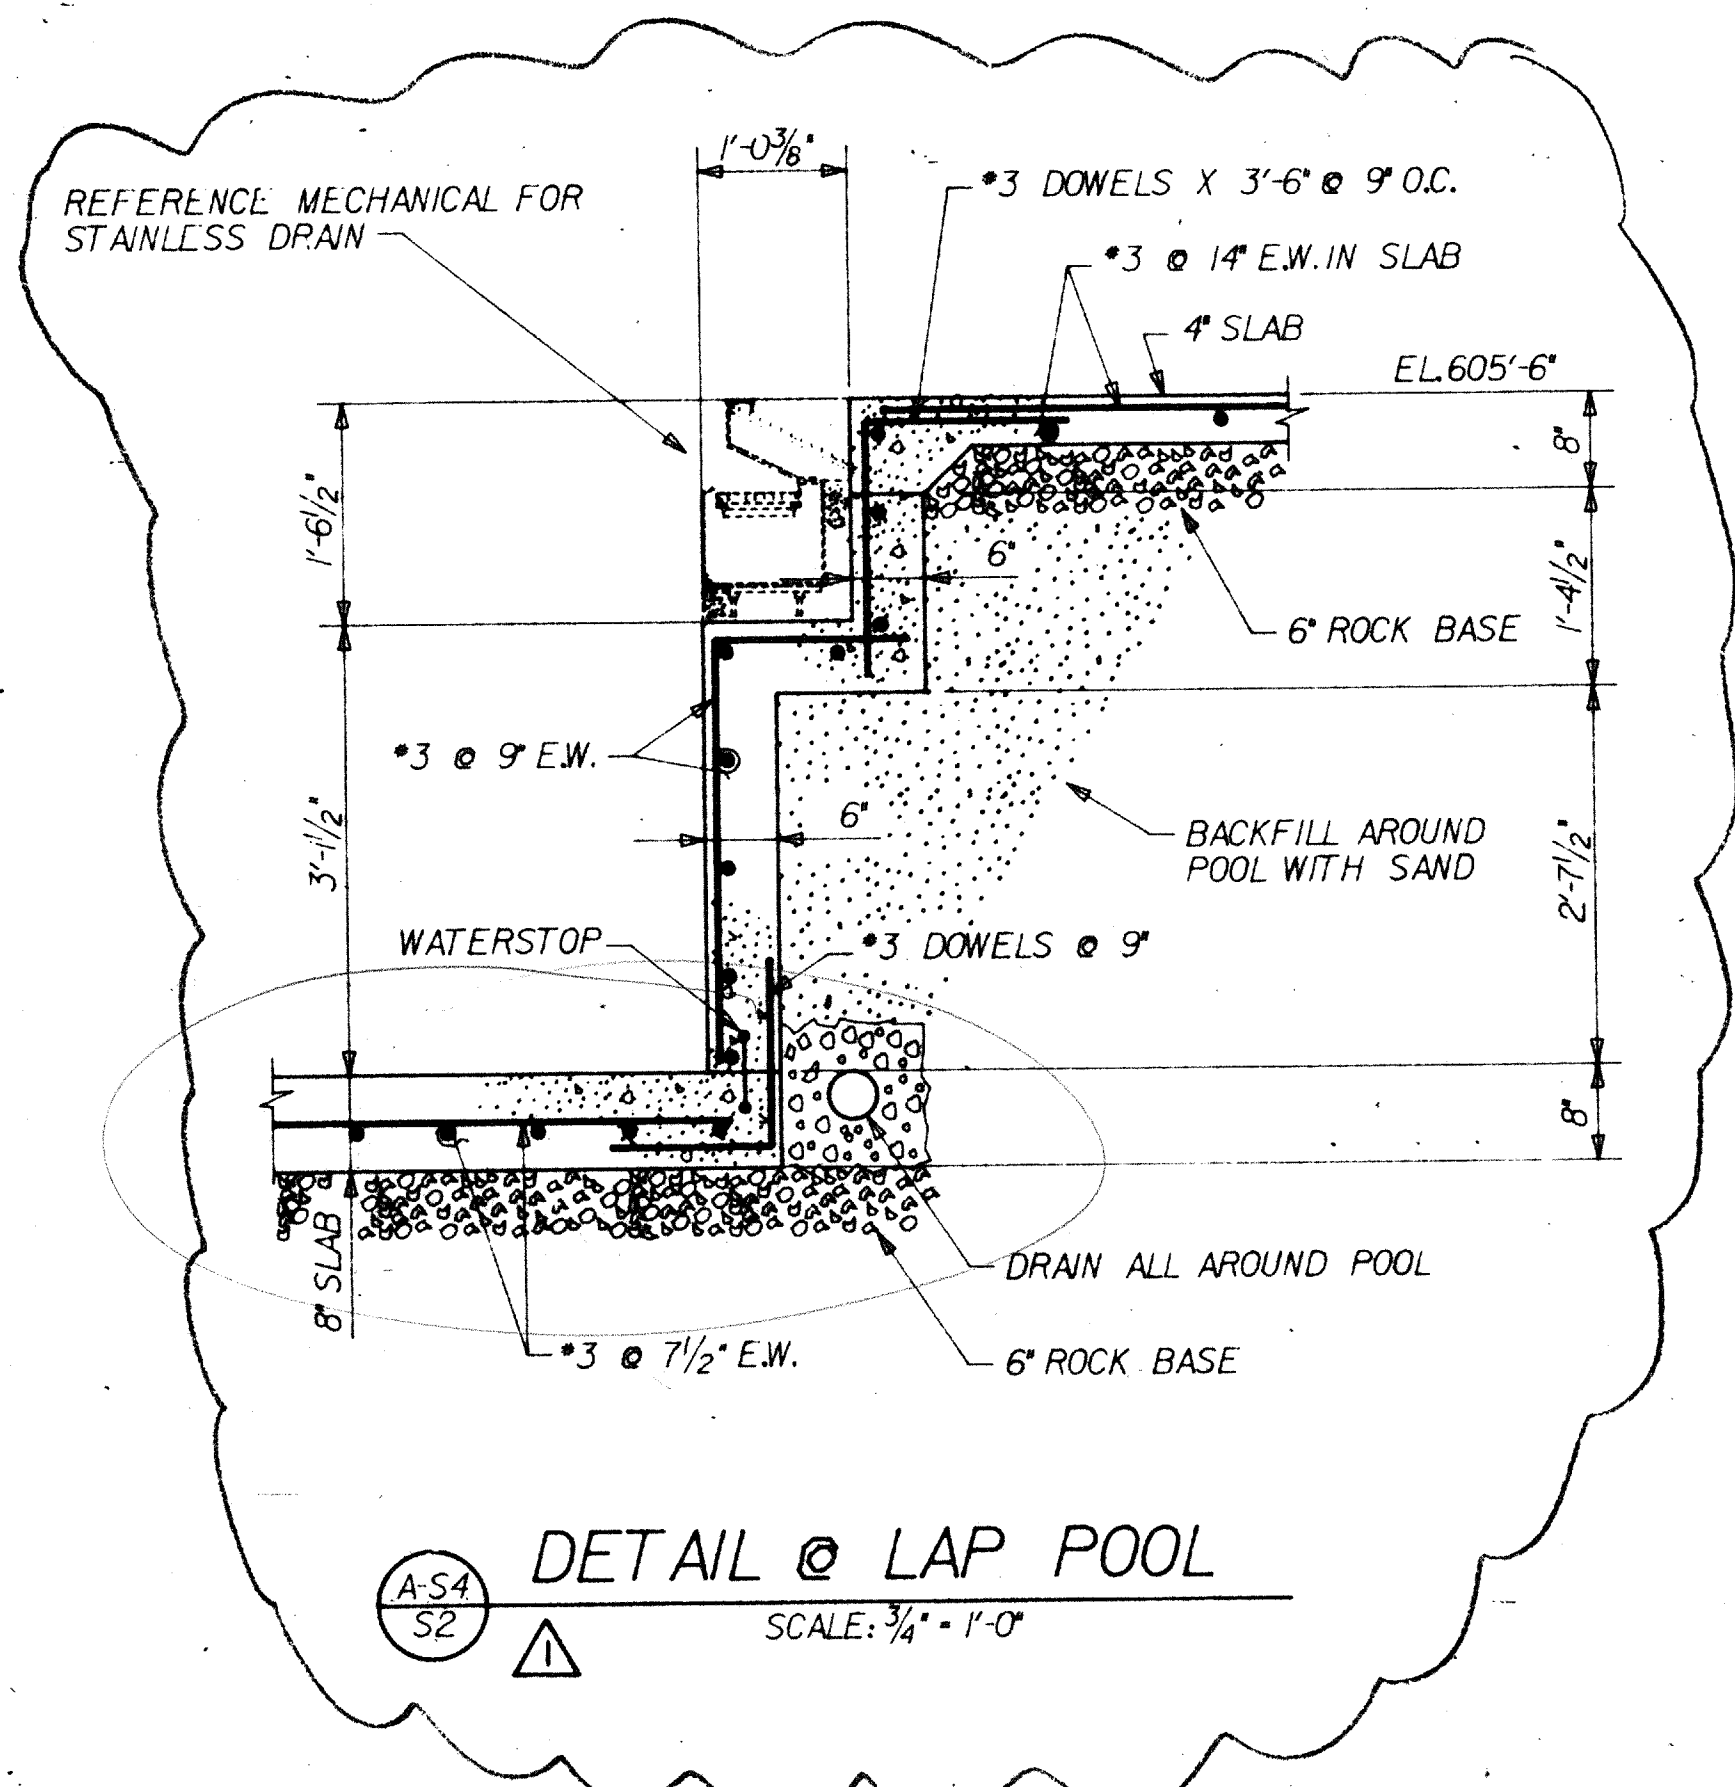

DETAIL @ LAP POOL
SCALE: 3/4" = 1'-0"

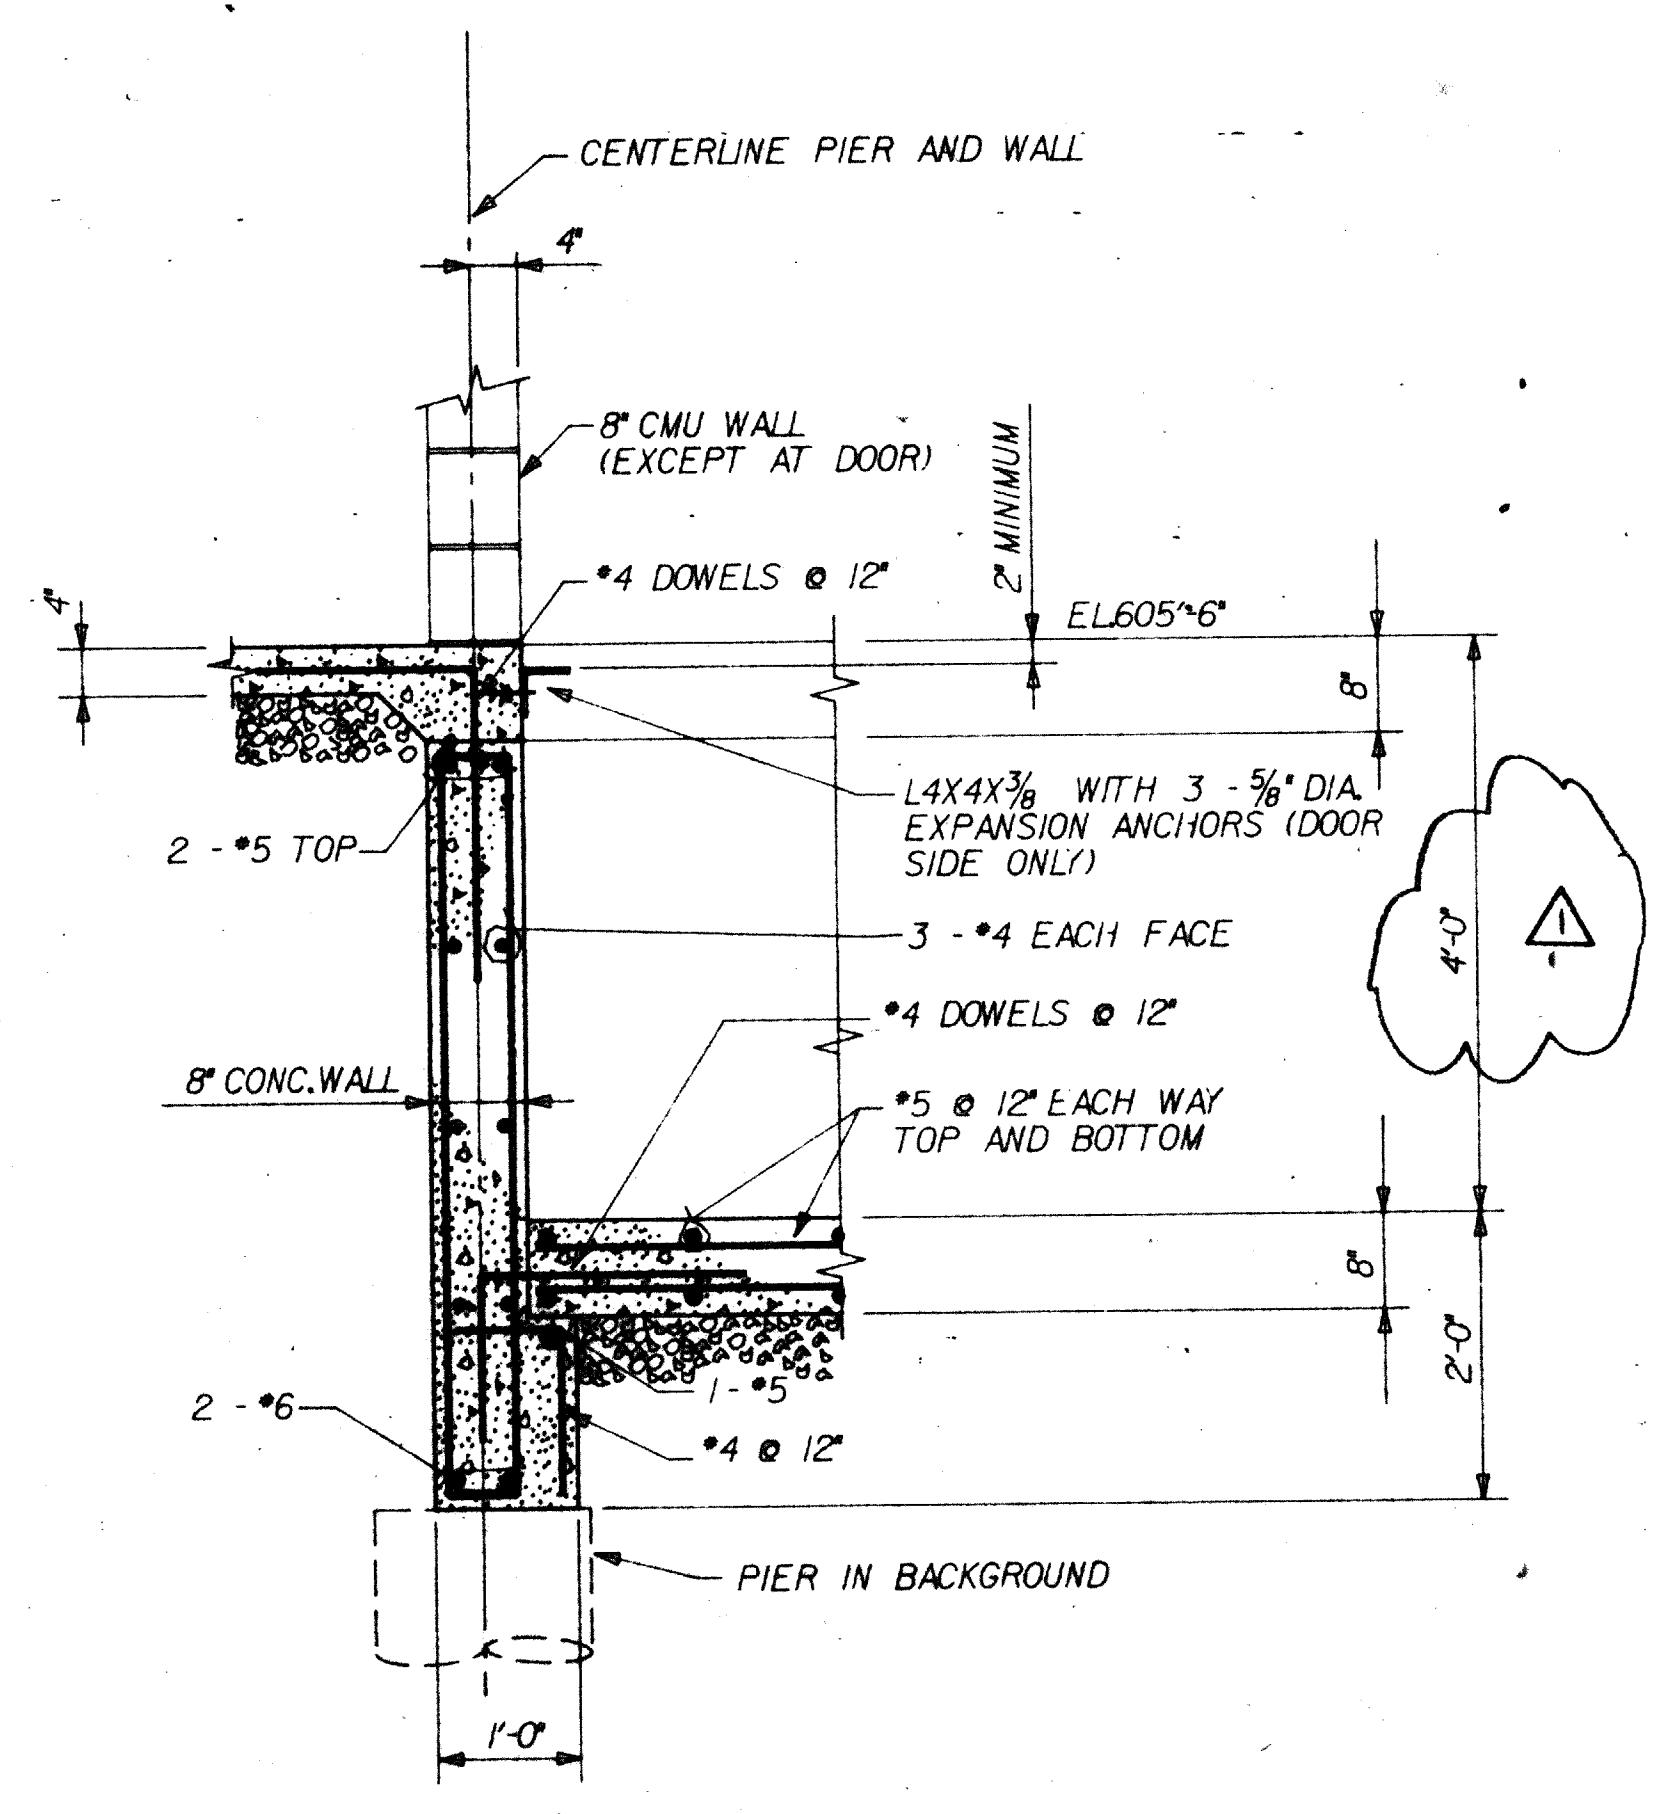


SECTION @ ELEVATOR PIT
SCALE: 3/4" = 1'-0"


DOWELS:
AT GRADE BEAMS - 4 - #5 X 3'-0"
AT COLUMNS - SAME NUMBER AND SIZE AS COLUMN REINFORCING

VERTICAL REINFORCING	
PIER DIAM.	REINF.
18"	5 - #5
24"	5 - #9
30"	7 - #9


APPROXIMATE BOTTOM OF PIER ELEVATION (SEE SPECIFICATION)

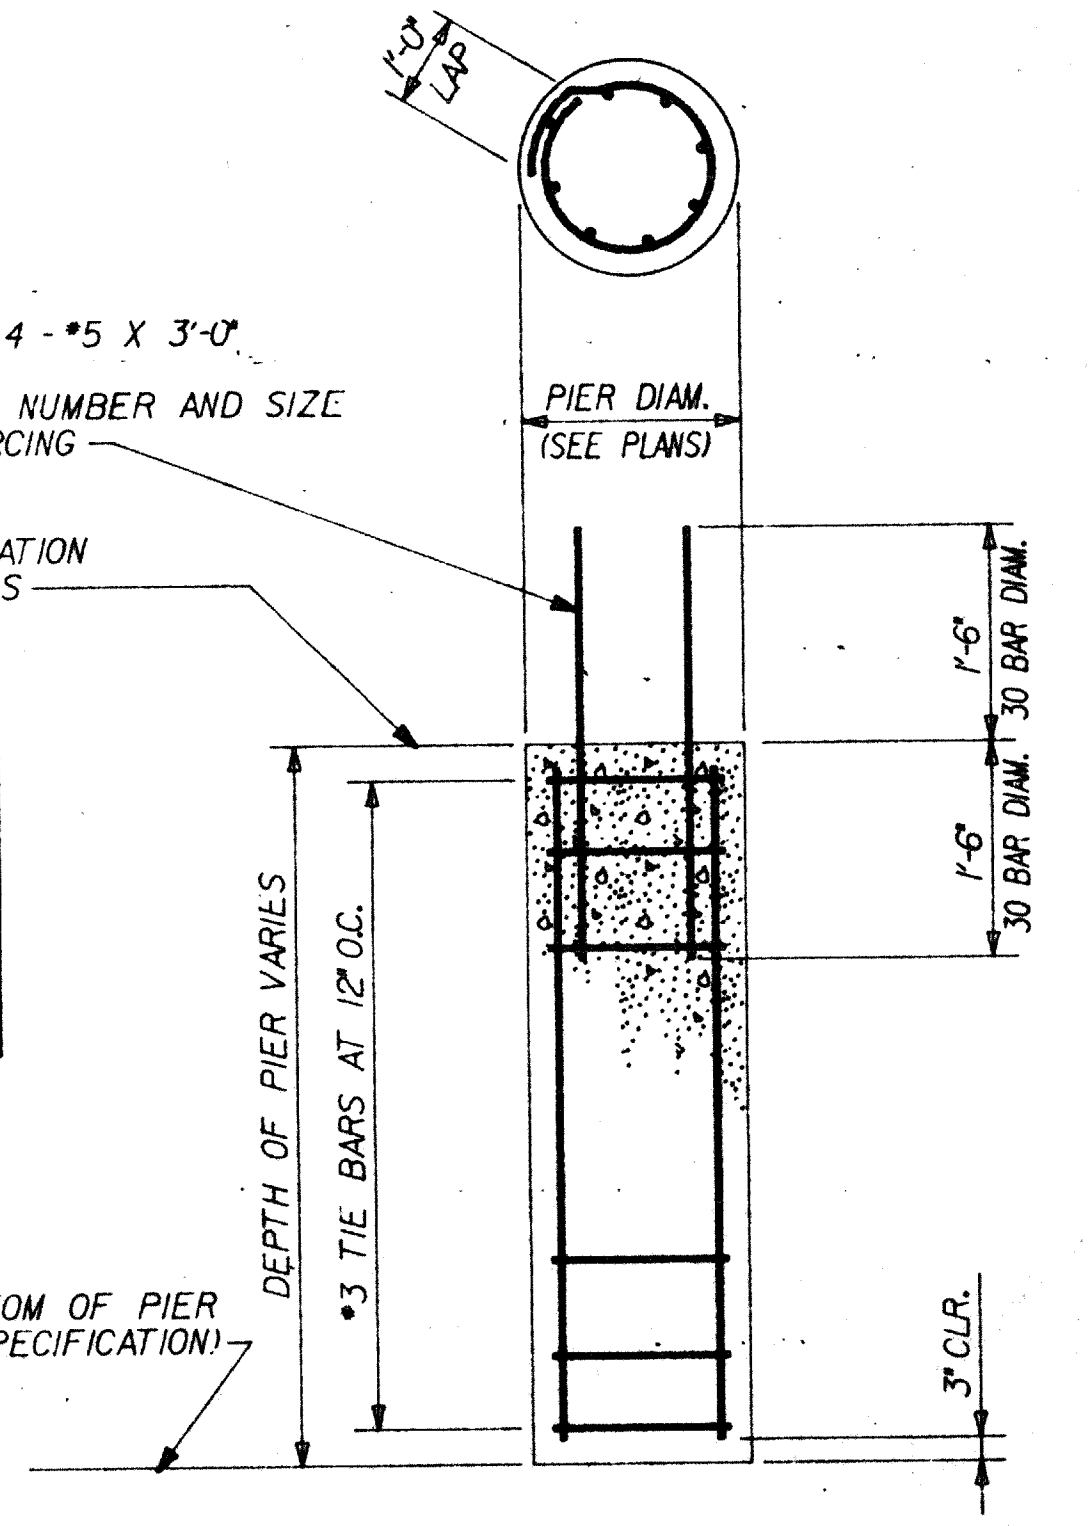


DRILLED PIER DETAIL
NO SCALE

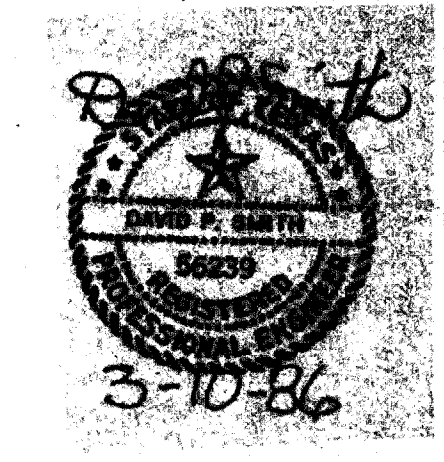

ADDISON RECREATION CENTER
3900 BELTWAY DRIVE
ADDISON, TEXAS

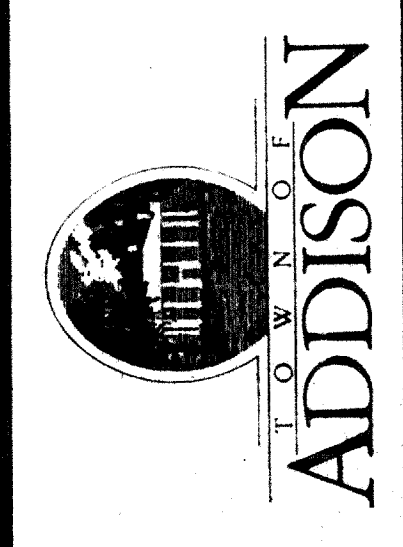

The Benham Group Dallas
architects
engineers
planners
1341 w. mockingbird ln.
suite 517 e
dallas, texas

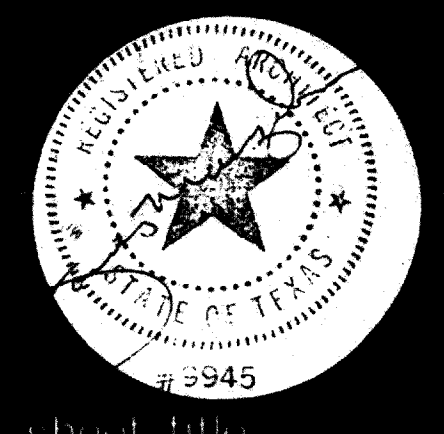

FOUNDATION and SLAB DETAILS SHEET 2

drawn **D. MESSNER**
chk'd **E. KOHICK**
date **3-10-86**

no. **Δ** date **4-21-86**