



SHEET NO.	
BASE	
DATE	
BY	
CHECKED	
APPROVED	

ADDISON RECREATION CENTER
 3900 BELTWAY DRIVE
 ADDISON, TEXAS

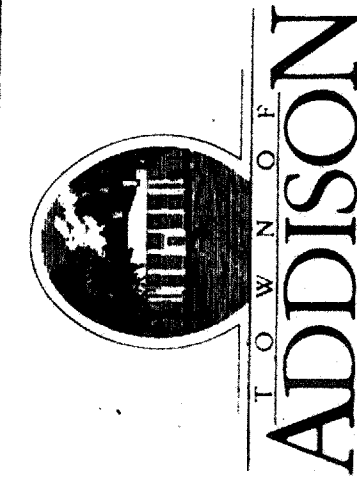

The Benham Group
 Dallas

architects
 engineers
 planners
 1341 w. mockingbird ln.
 suite 517 e
 dallas, texas

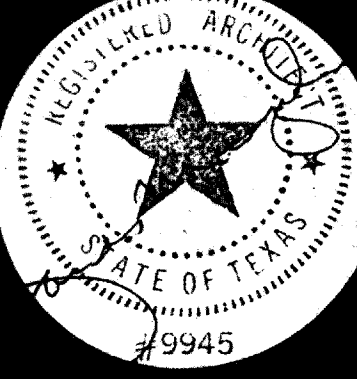


ROOF STEEL
 FRAMING PLAN

drawn D. MESSNER
 checked E. KOCHICK
 date 3-19-86

revisions

no. date
 4-21-86

Sheet 5-6

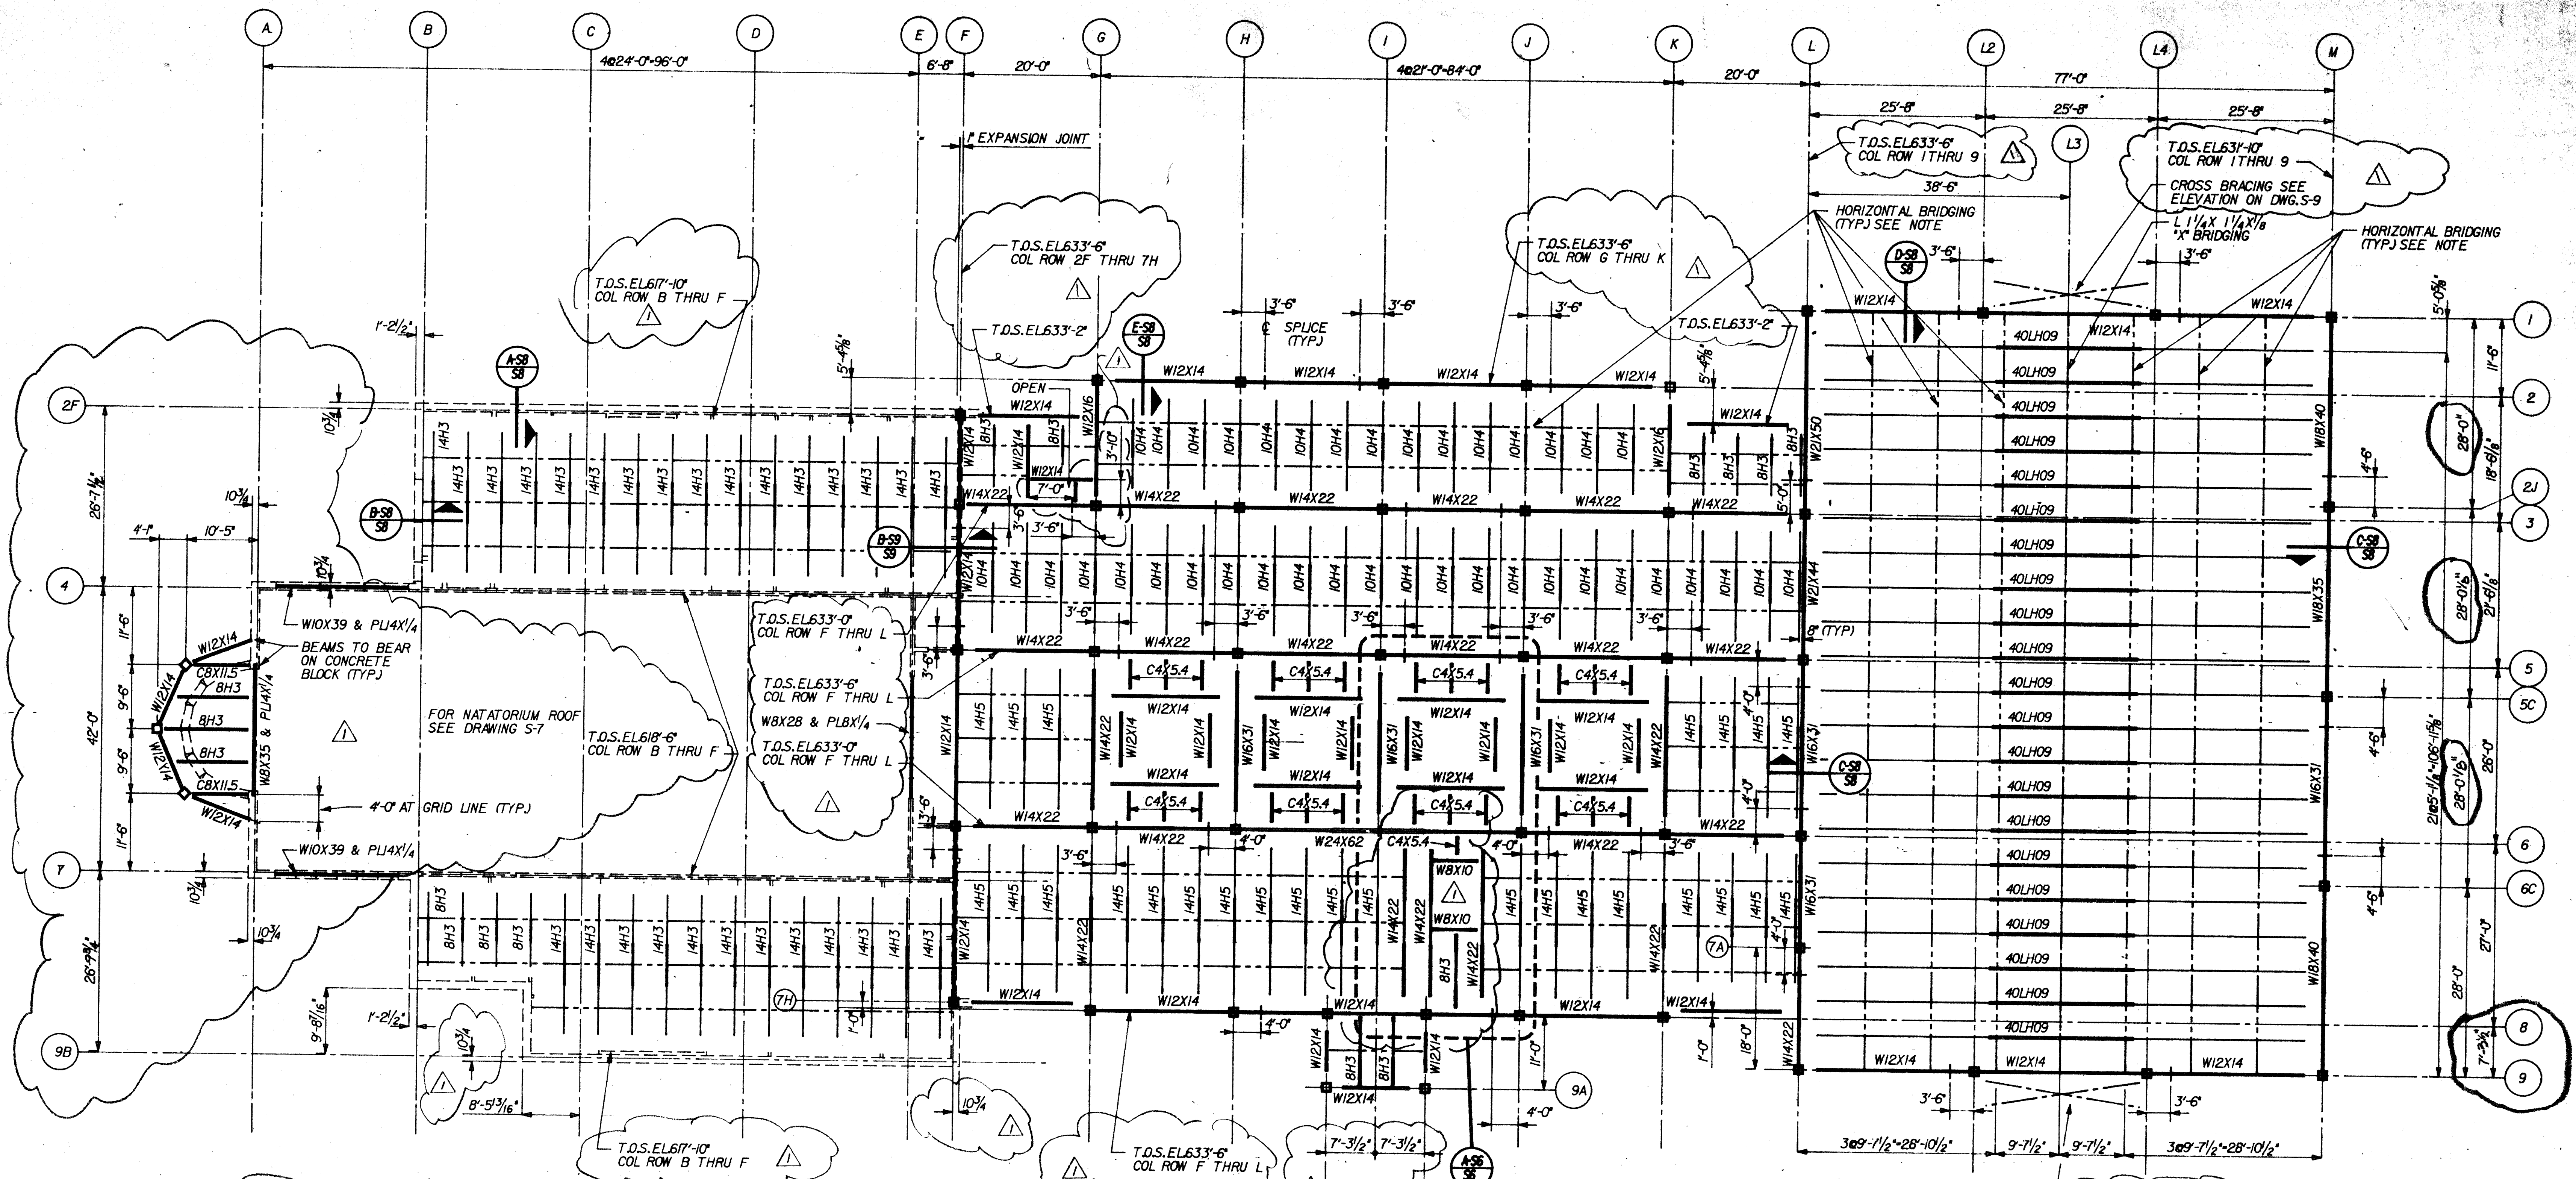


NOTES:
 1. ALL HORIZONTAL BRIDGING IS L 1/4 X 1/4 X 1/8 TOP AND BOTTOM UNLESS NOTED OTHERWISE.
 2. ALL JOISTS SPACED AT 5'-3" O.C. MAXIMUM UNLESS NOTED OTHERWISE.


CROSS BRACING SEE ELEVATION ON DWG. S-9

ROOF FRAMING PLAN
 SCALE 1/32" = 1'-0"


HIPPED ROOF FRAMING PLAN
 SCALE 1/32" = 1'-0"

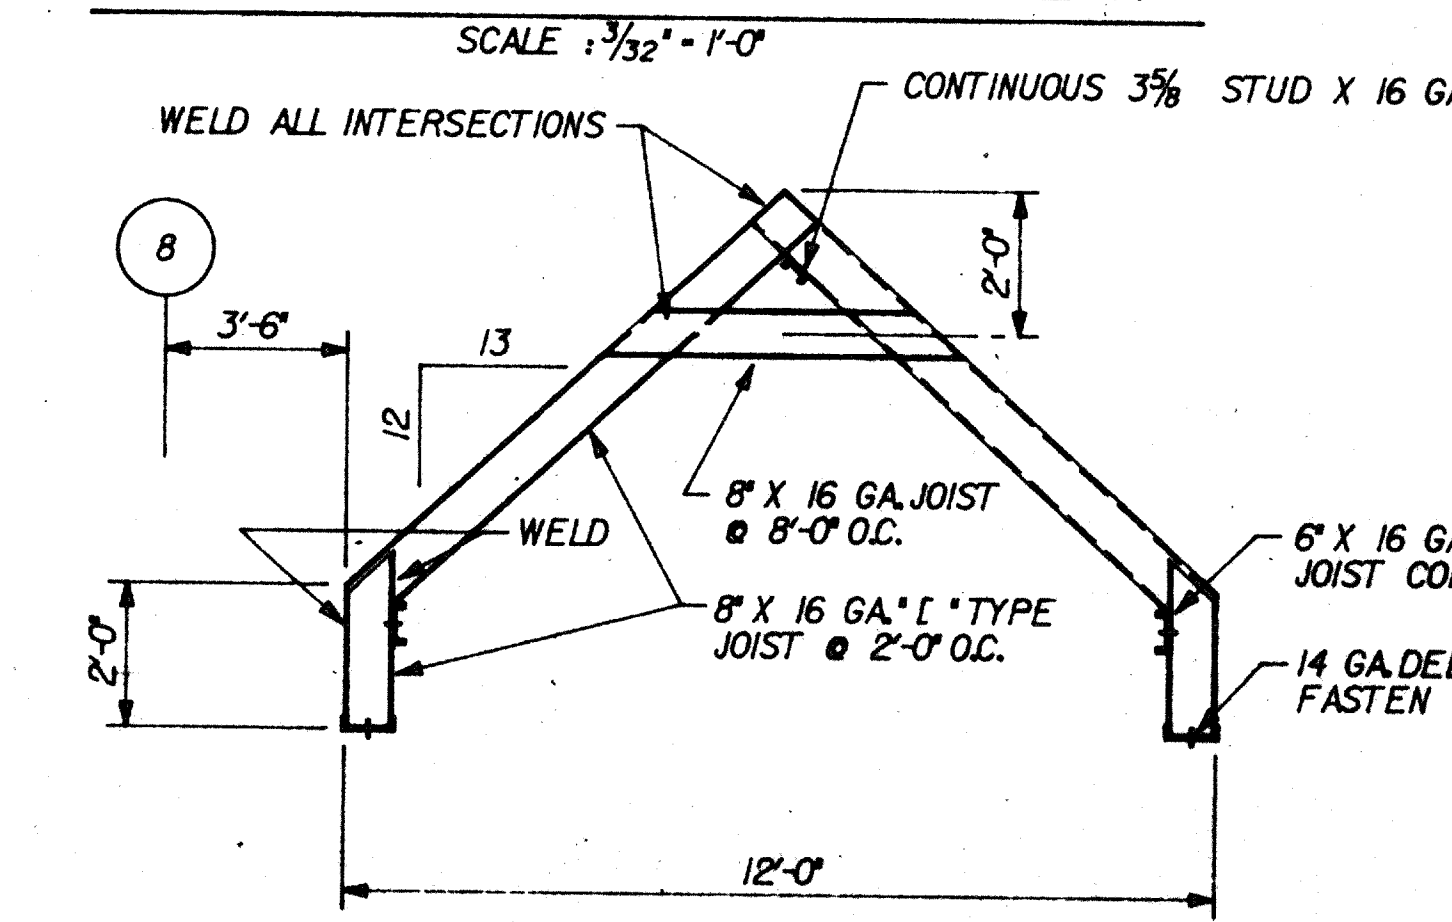

LOW HIPPED ROOF FRAME
 SCALE 1/8" = 1'-0"

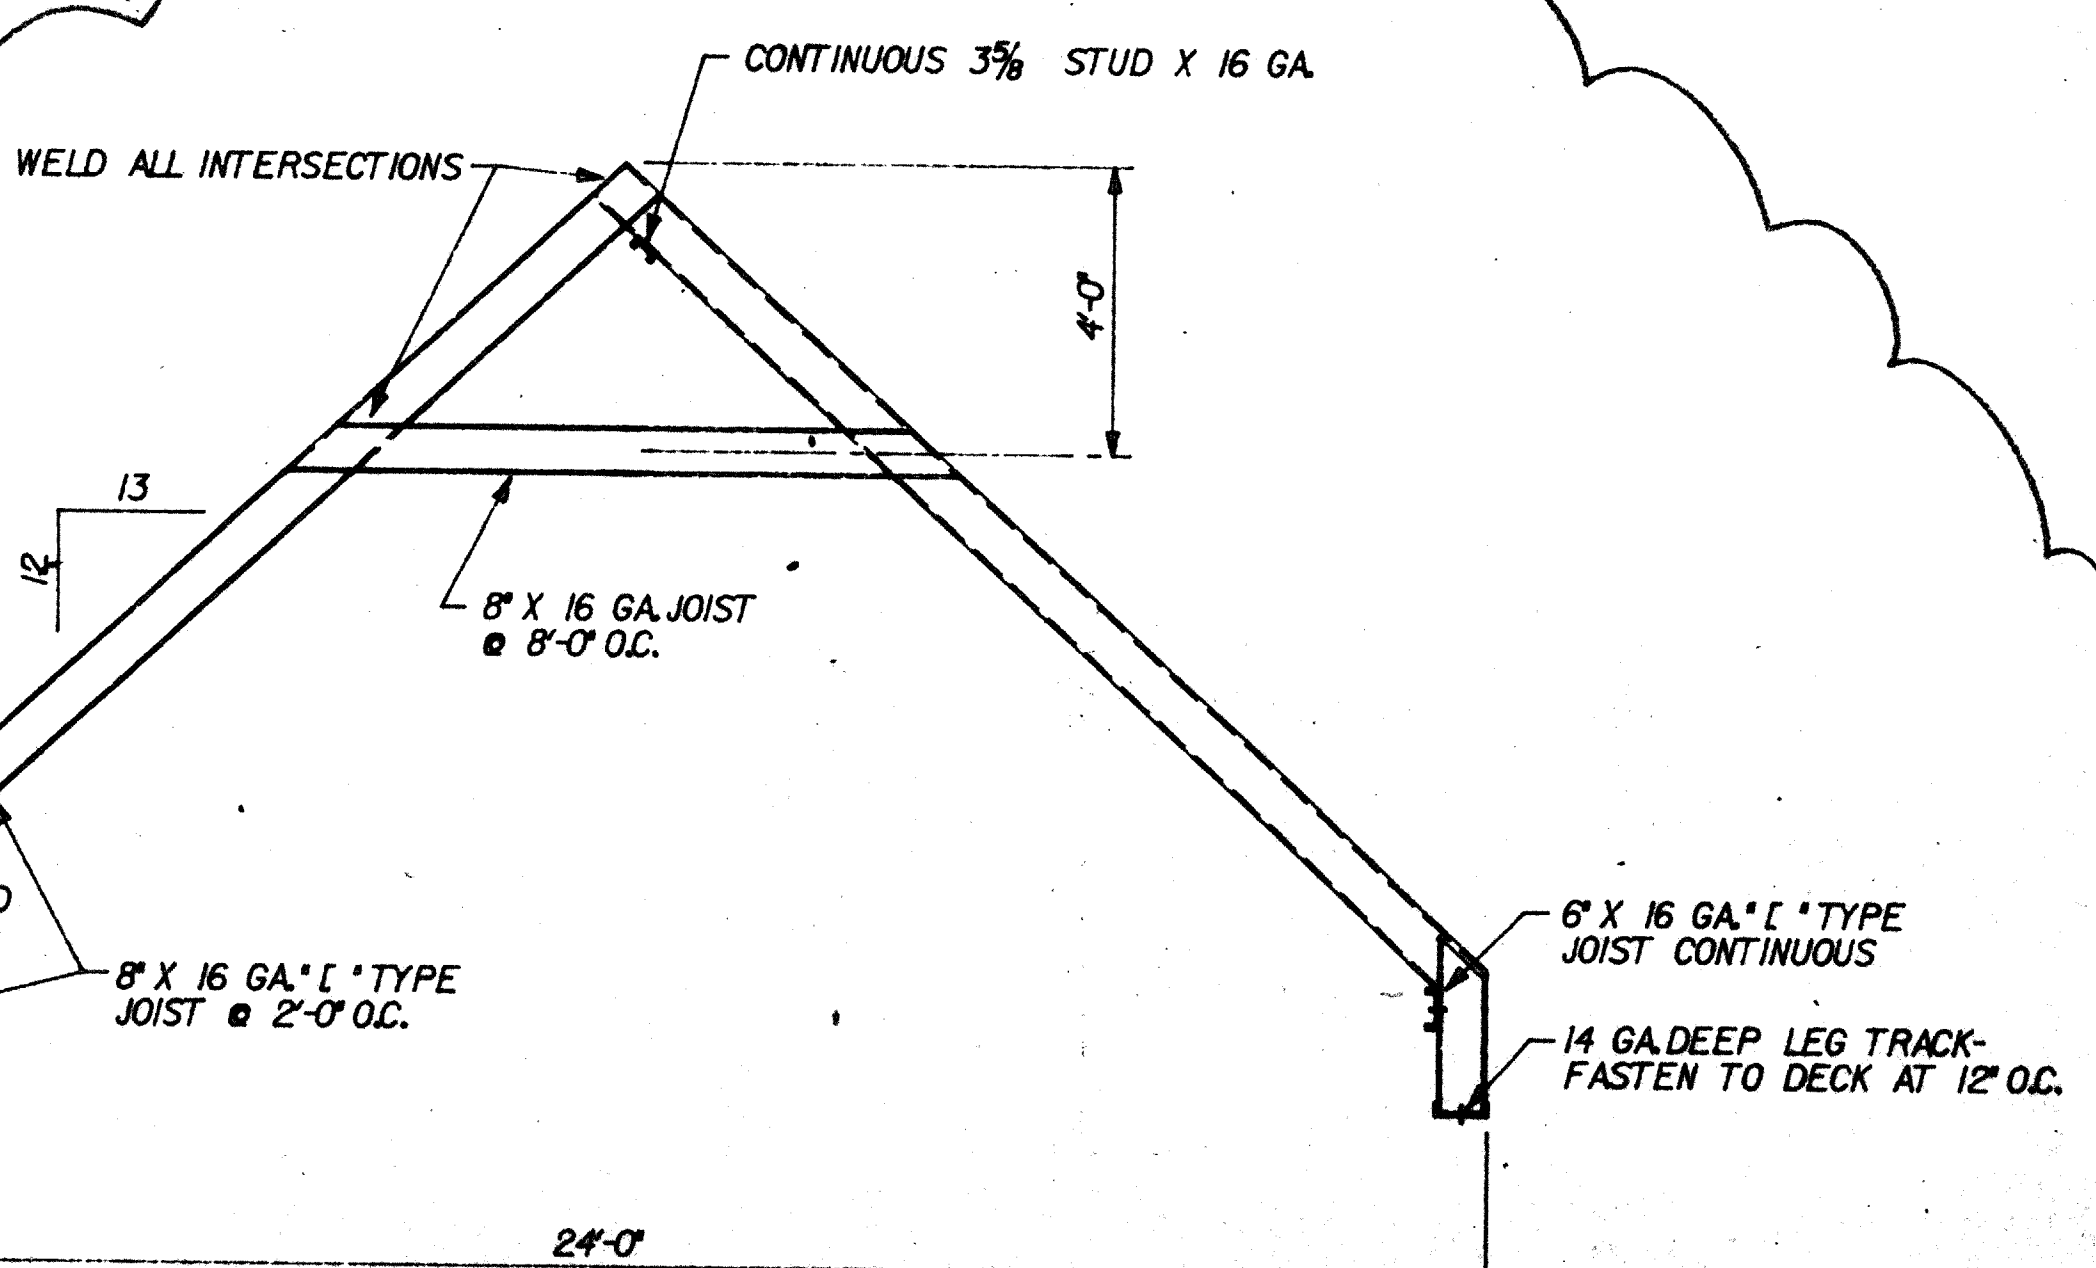

HIGH HIPPED ROOF FRAME
 SCALE 1/8" = 1'-0"

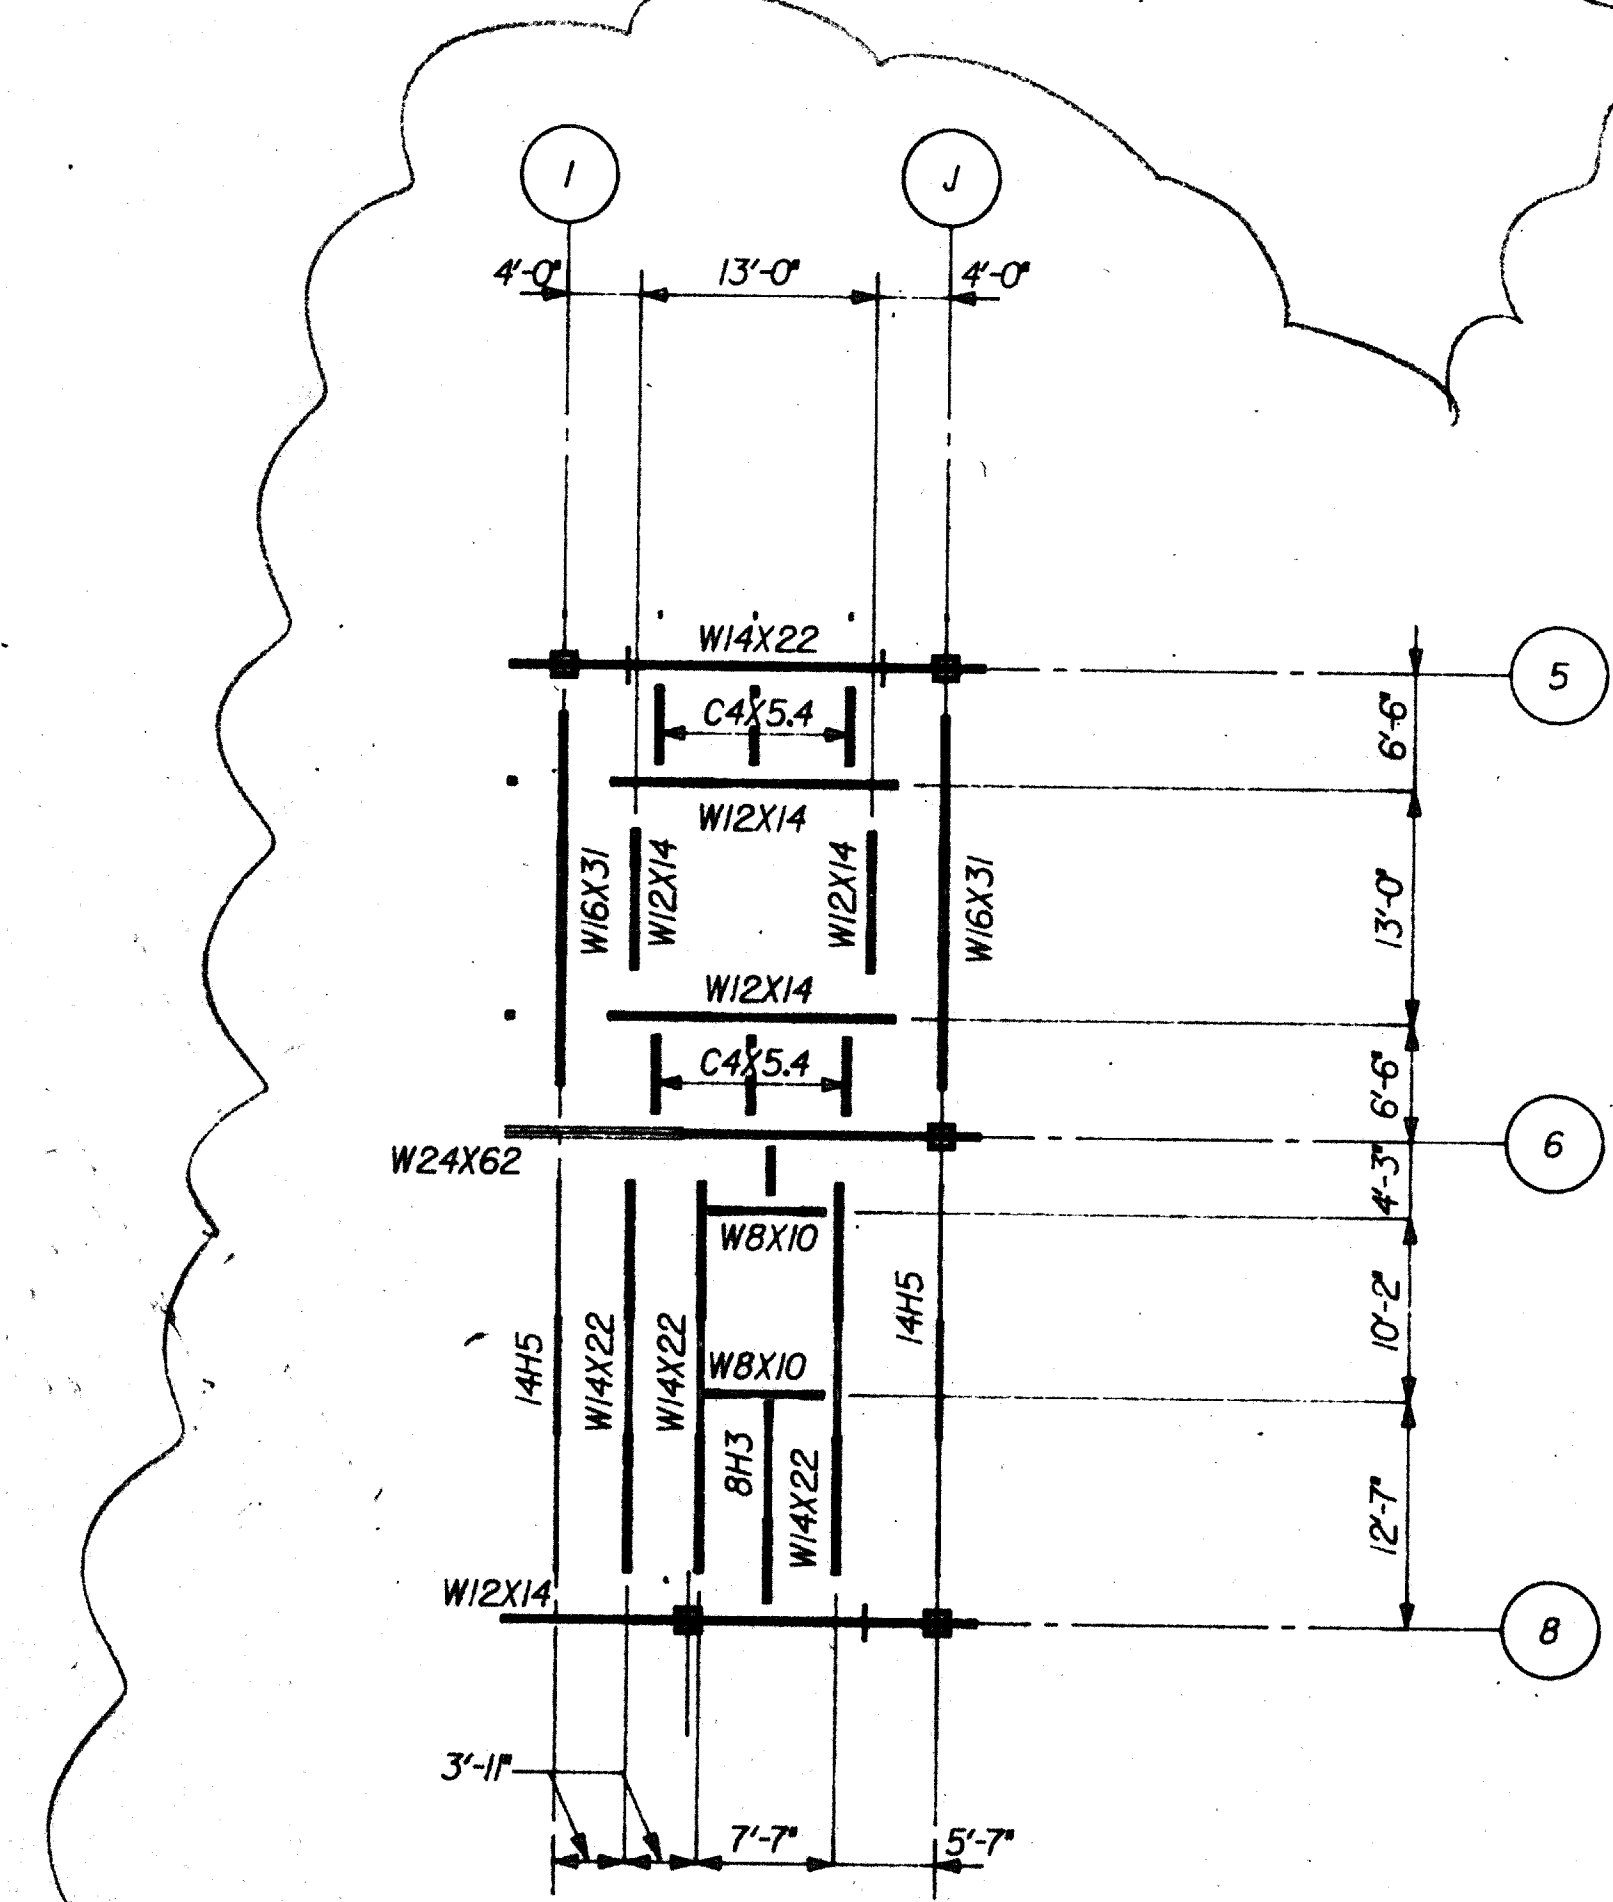

DETAIL @ SKYLIGHTS AND ELEVATOR
 SCALE 1/32" = 1'-0"