



SHEET NO.	
DATE	
BY	
CHECKED	
APPROVED	
COMPOSITE	


CONCRETE BEAM SCHEDULE						
MARK	W X H	TOP BARS	BOT BARS	STIRRUPS		REMARKS
				SIZE	SPACING	
RB1	12 X 18	2 - #5	3 - #6	#3	@ 8"	
RB2	12 X 18	2 - #5	2 - #5	#3	3 @ 8 EE.BAL@2'4"	
RB3	12 X 18	2 - #5	2 - #9	#3	@ 8"	
RB4	12 X 18	2 - #5	2 - #7	#3	6 @ 8 EE.BAL@2'4"	
RB5	12 X 24	2 - #6	2 - #9	#3	@ 11"	
RB6	12 X 36	3 - #6	4 - #9	#3	10 @ 17 EE.BAL@2'4"	
RB7	18 X 36	3 - #6	9 - #9	#3	8 @ 14 EE.BAL@17"	*9 'S TO BE IN 3 BUNDLES
RB8	18 X 36	3 - #6	6 - #9	#3	11 @ 17 EE.BAL@2'4"	
RB9	12 X 36	3 - #7	6 - #10	#3	@ 17"	*10 'S TO BE IN 2 BUNDLES
RB10	12 X 24	2 - #5	2 - #5	#3	4 @ 11 EE.BAL@2'4"	
RB11	12 X 24	2 - #5	2 - #5	#3	4 @ 11 EE.BAL@2'4"	
RB12	12 X 24	2 - #5	2 - #5	#3	4 @ 11 EE.BAL@2'4"	
RB13	12 X 24	2 - #5	2 - #5	#3	@ 18"	
RB14	12 X 24	2 - #5	2 - #5	#3	@ 18"	

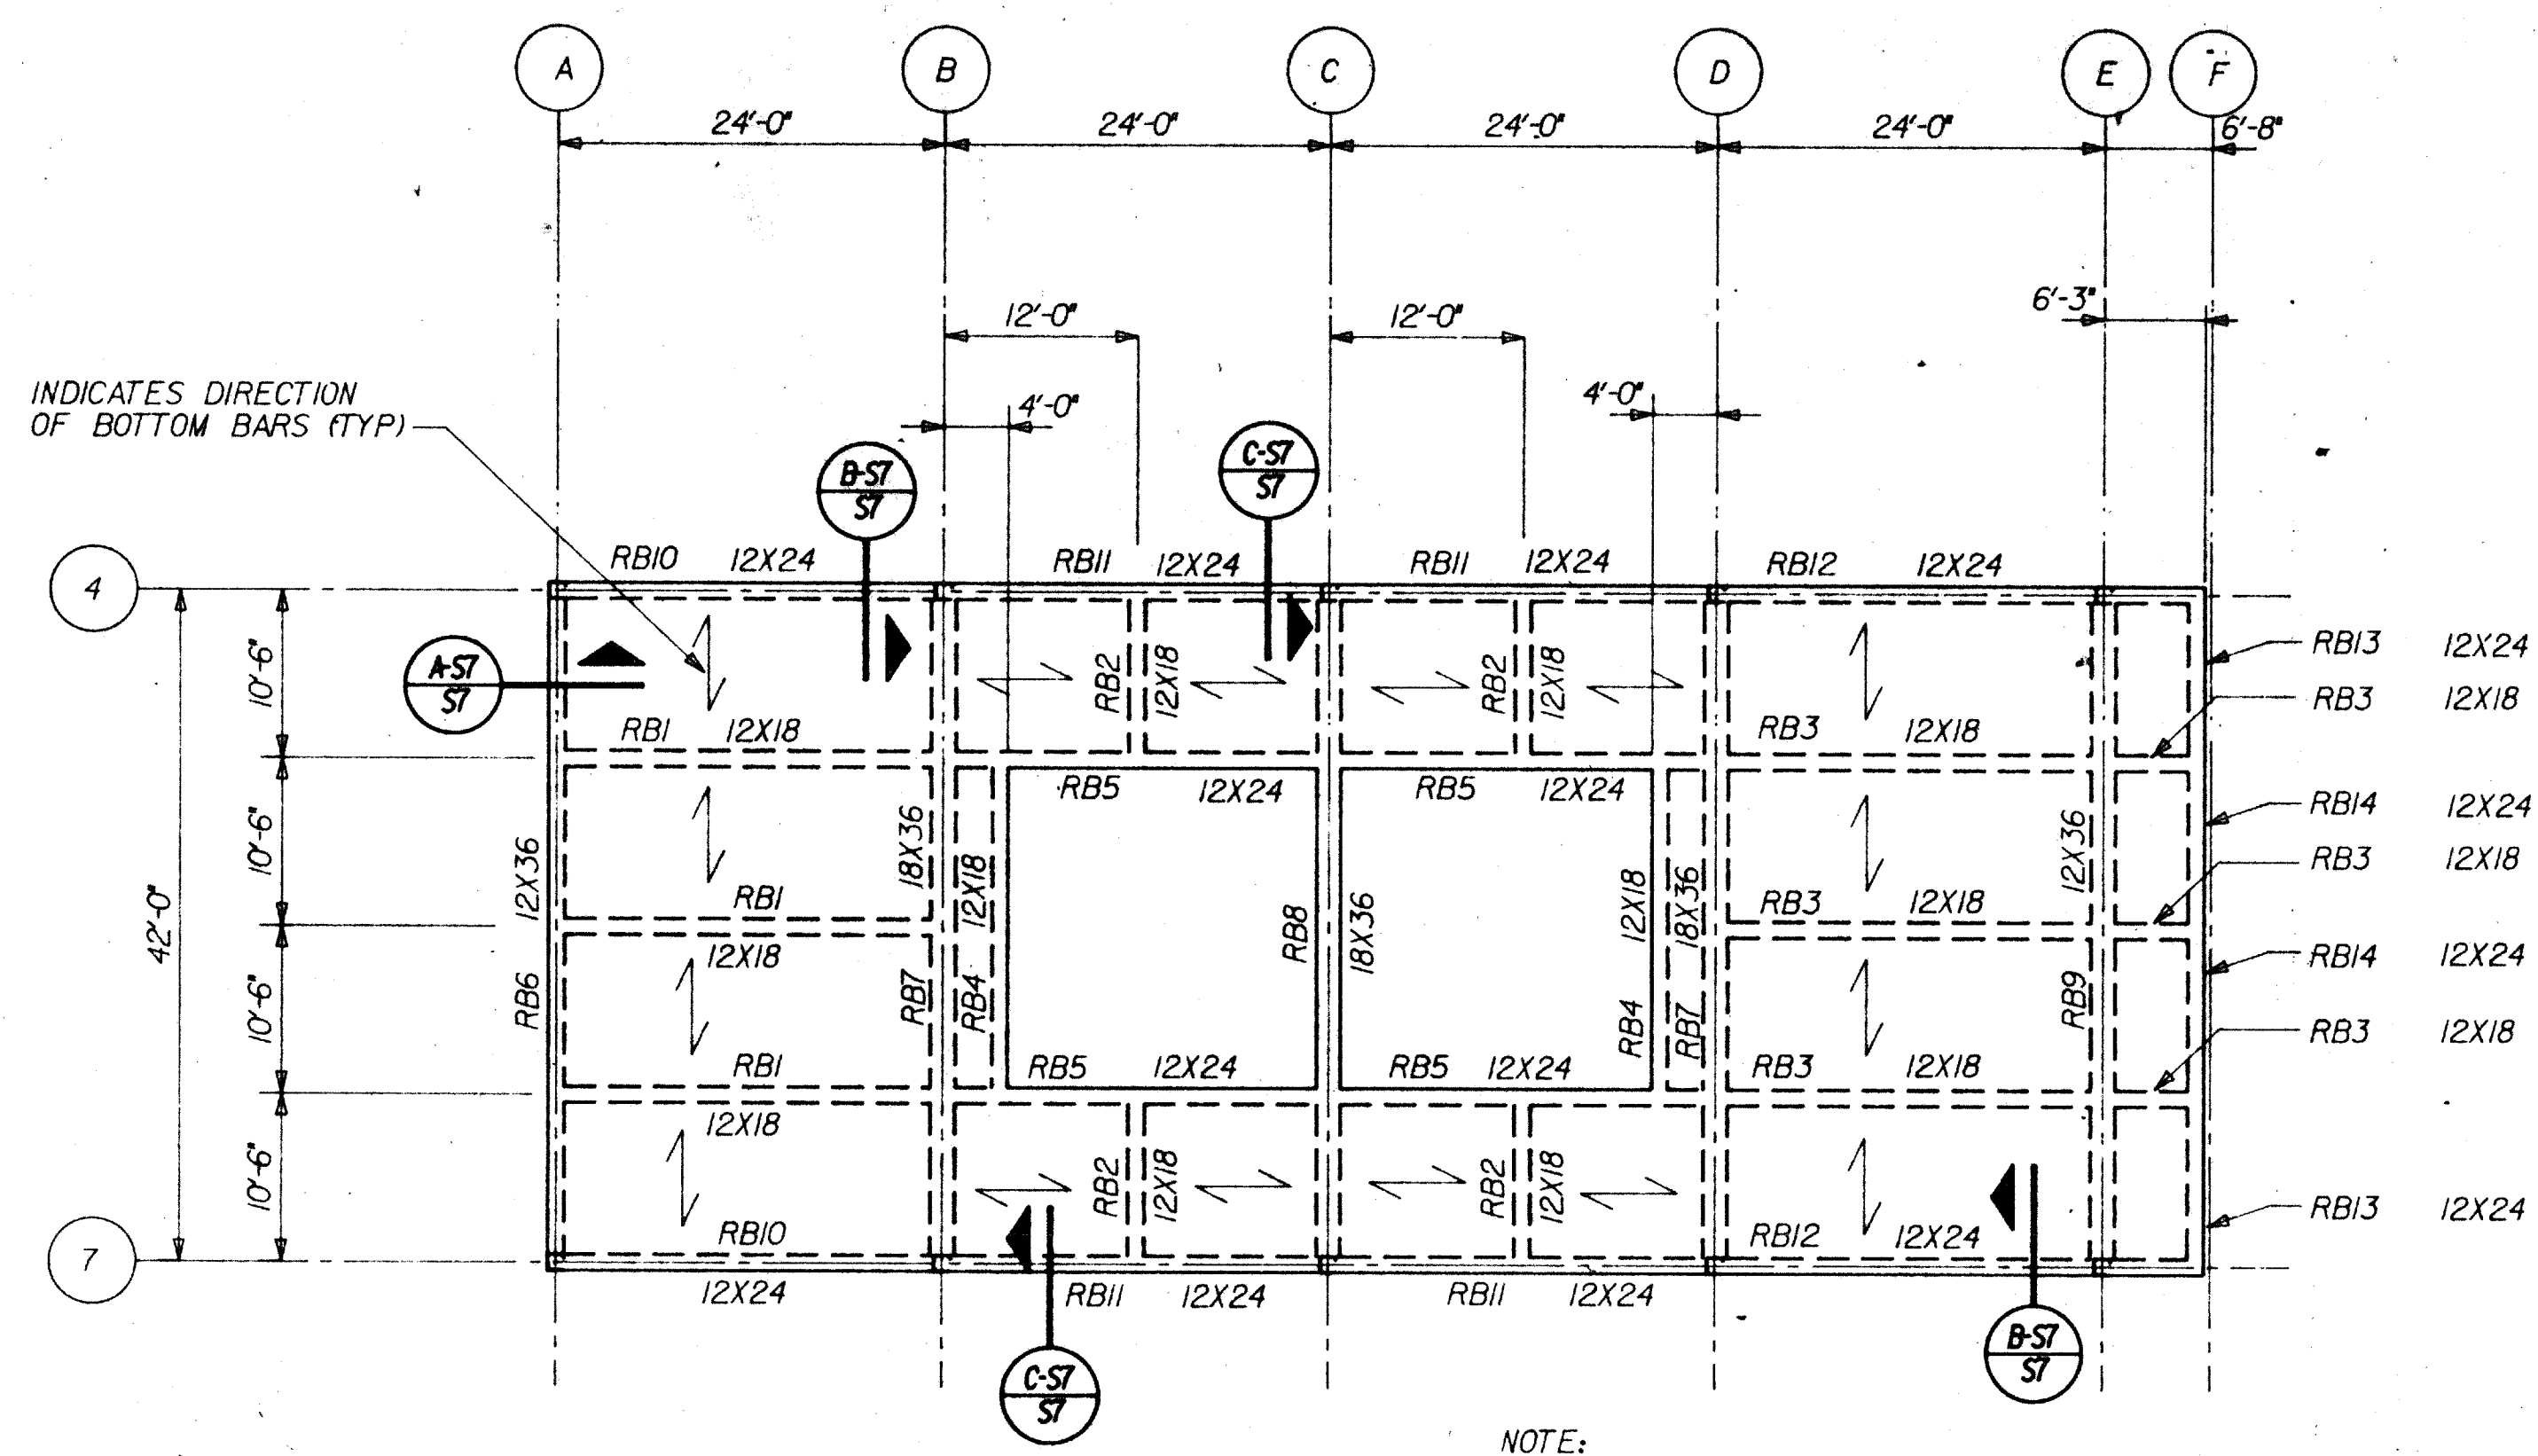


NATATORIUM ROOF PLAN

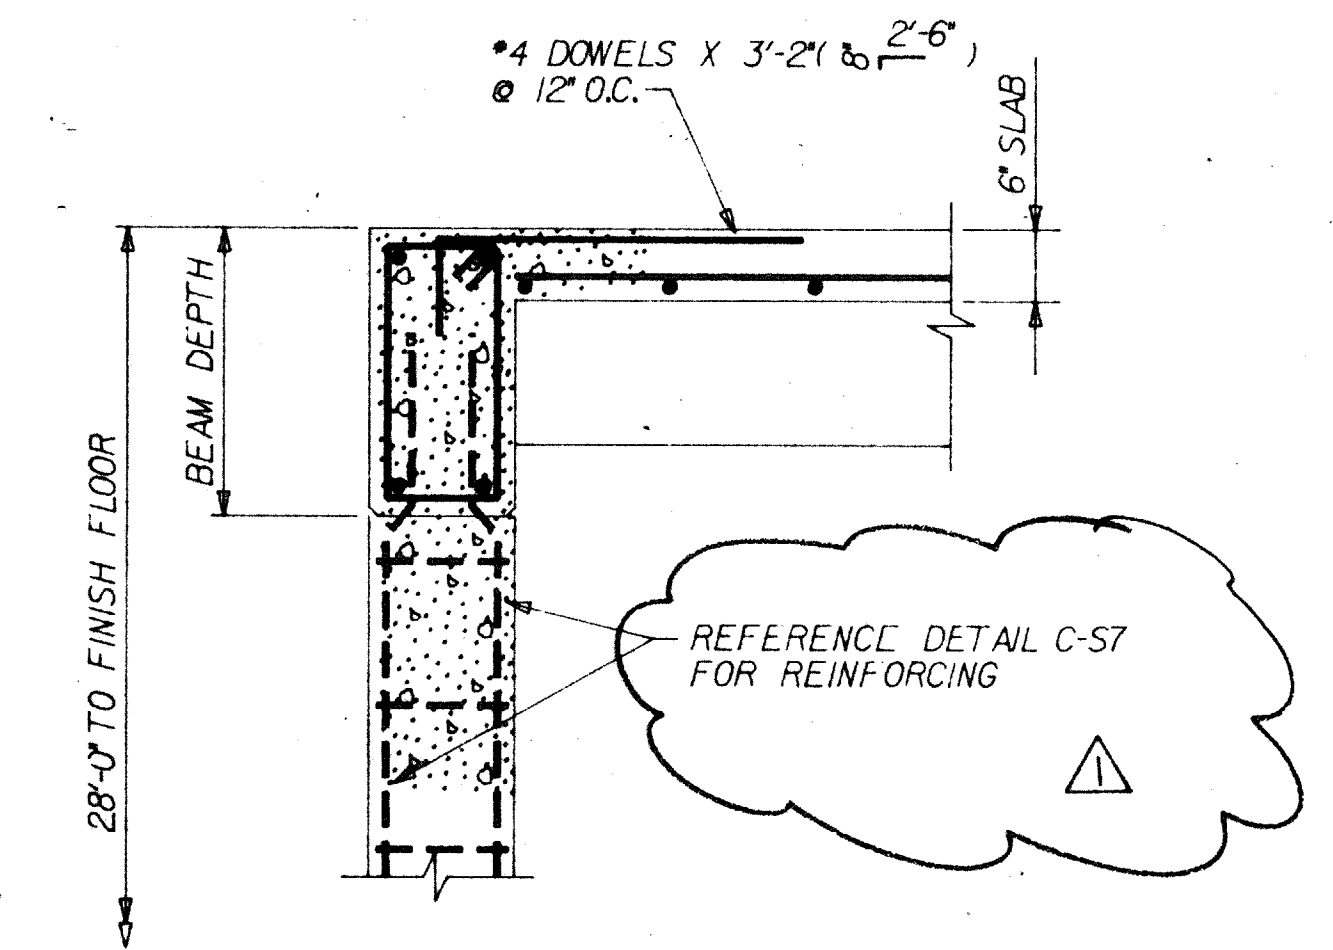


ROOF DETAIL @ NATATORIUM
SCALE - 3/4" = 1'-0"

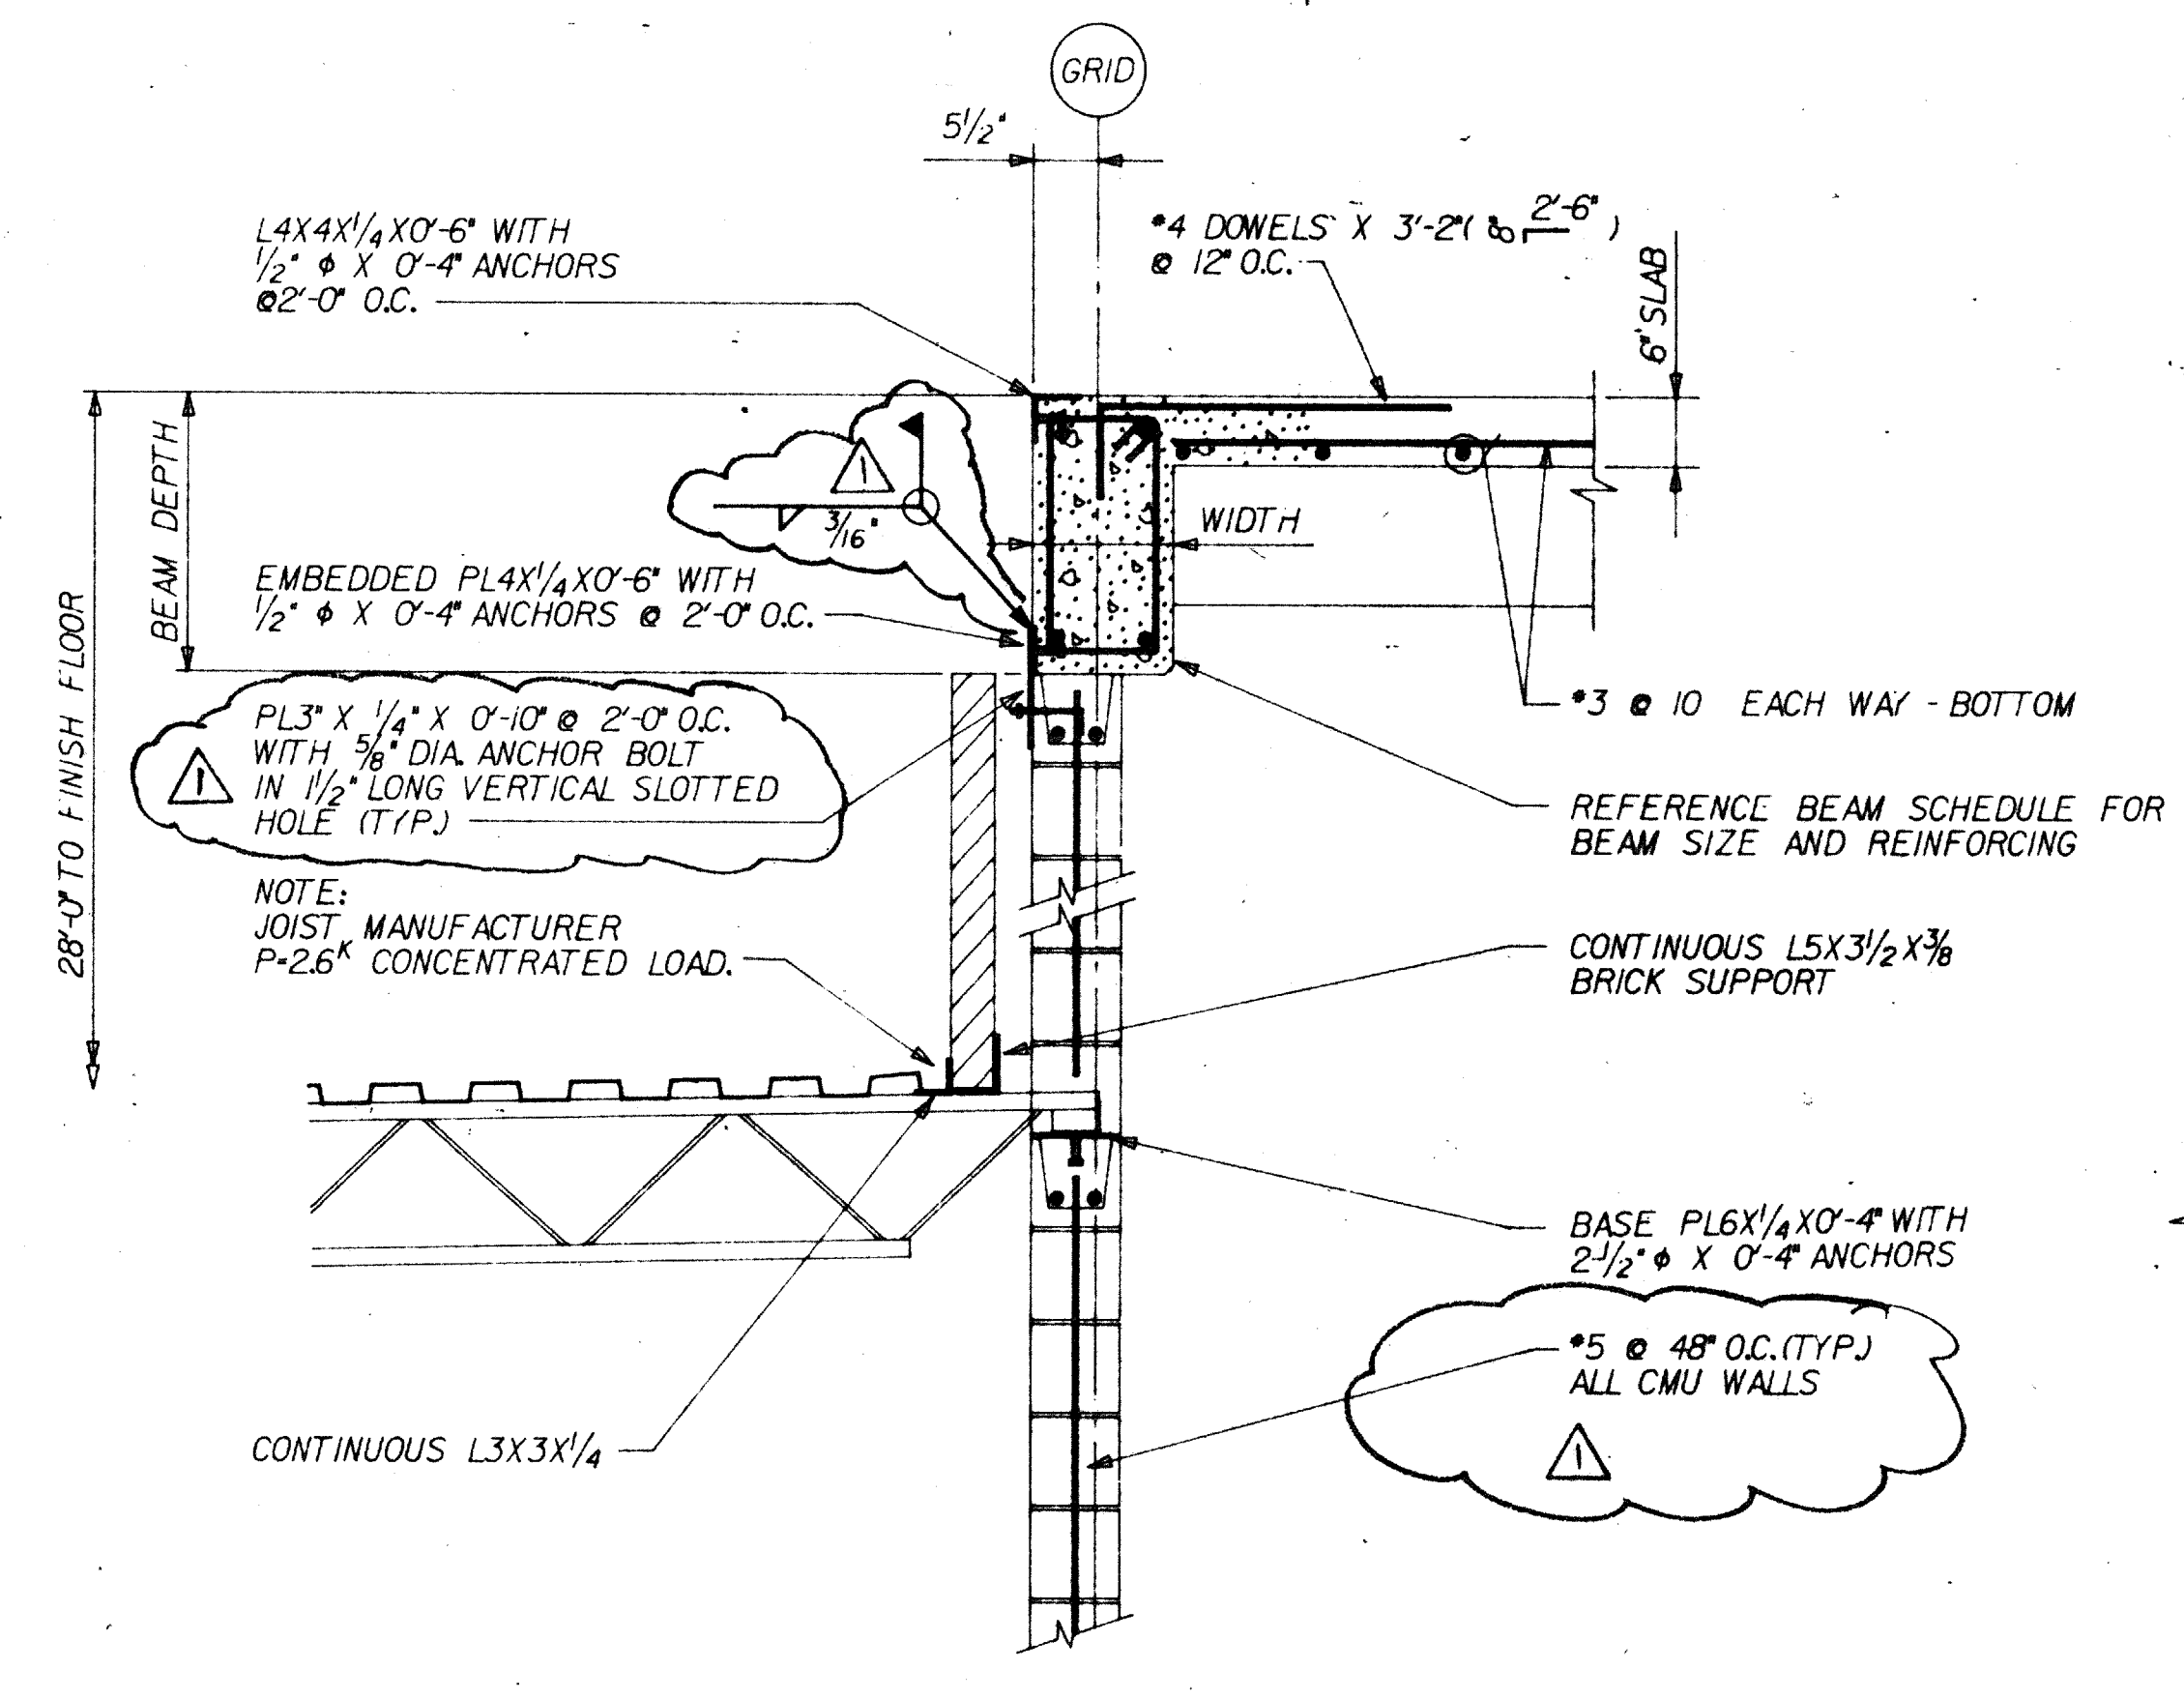


ROOF DETAIL @ NATATORIUM
SCALE - 3/4" = 1'-0"

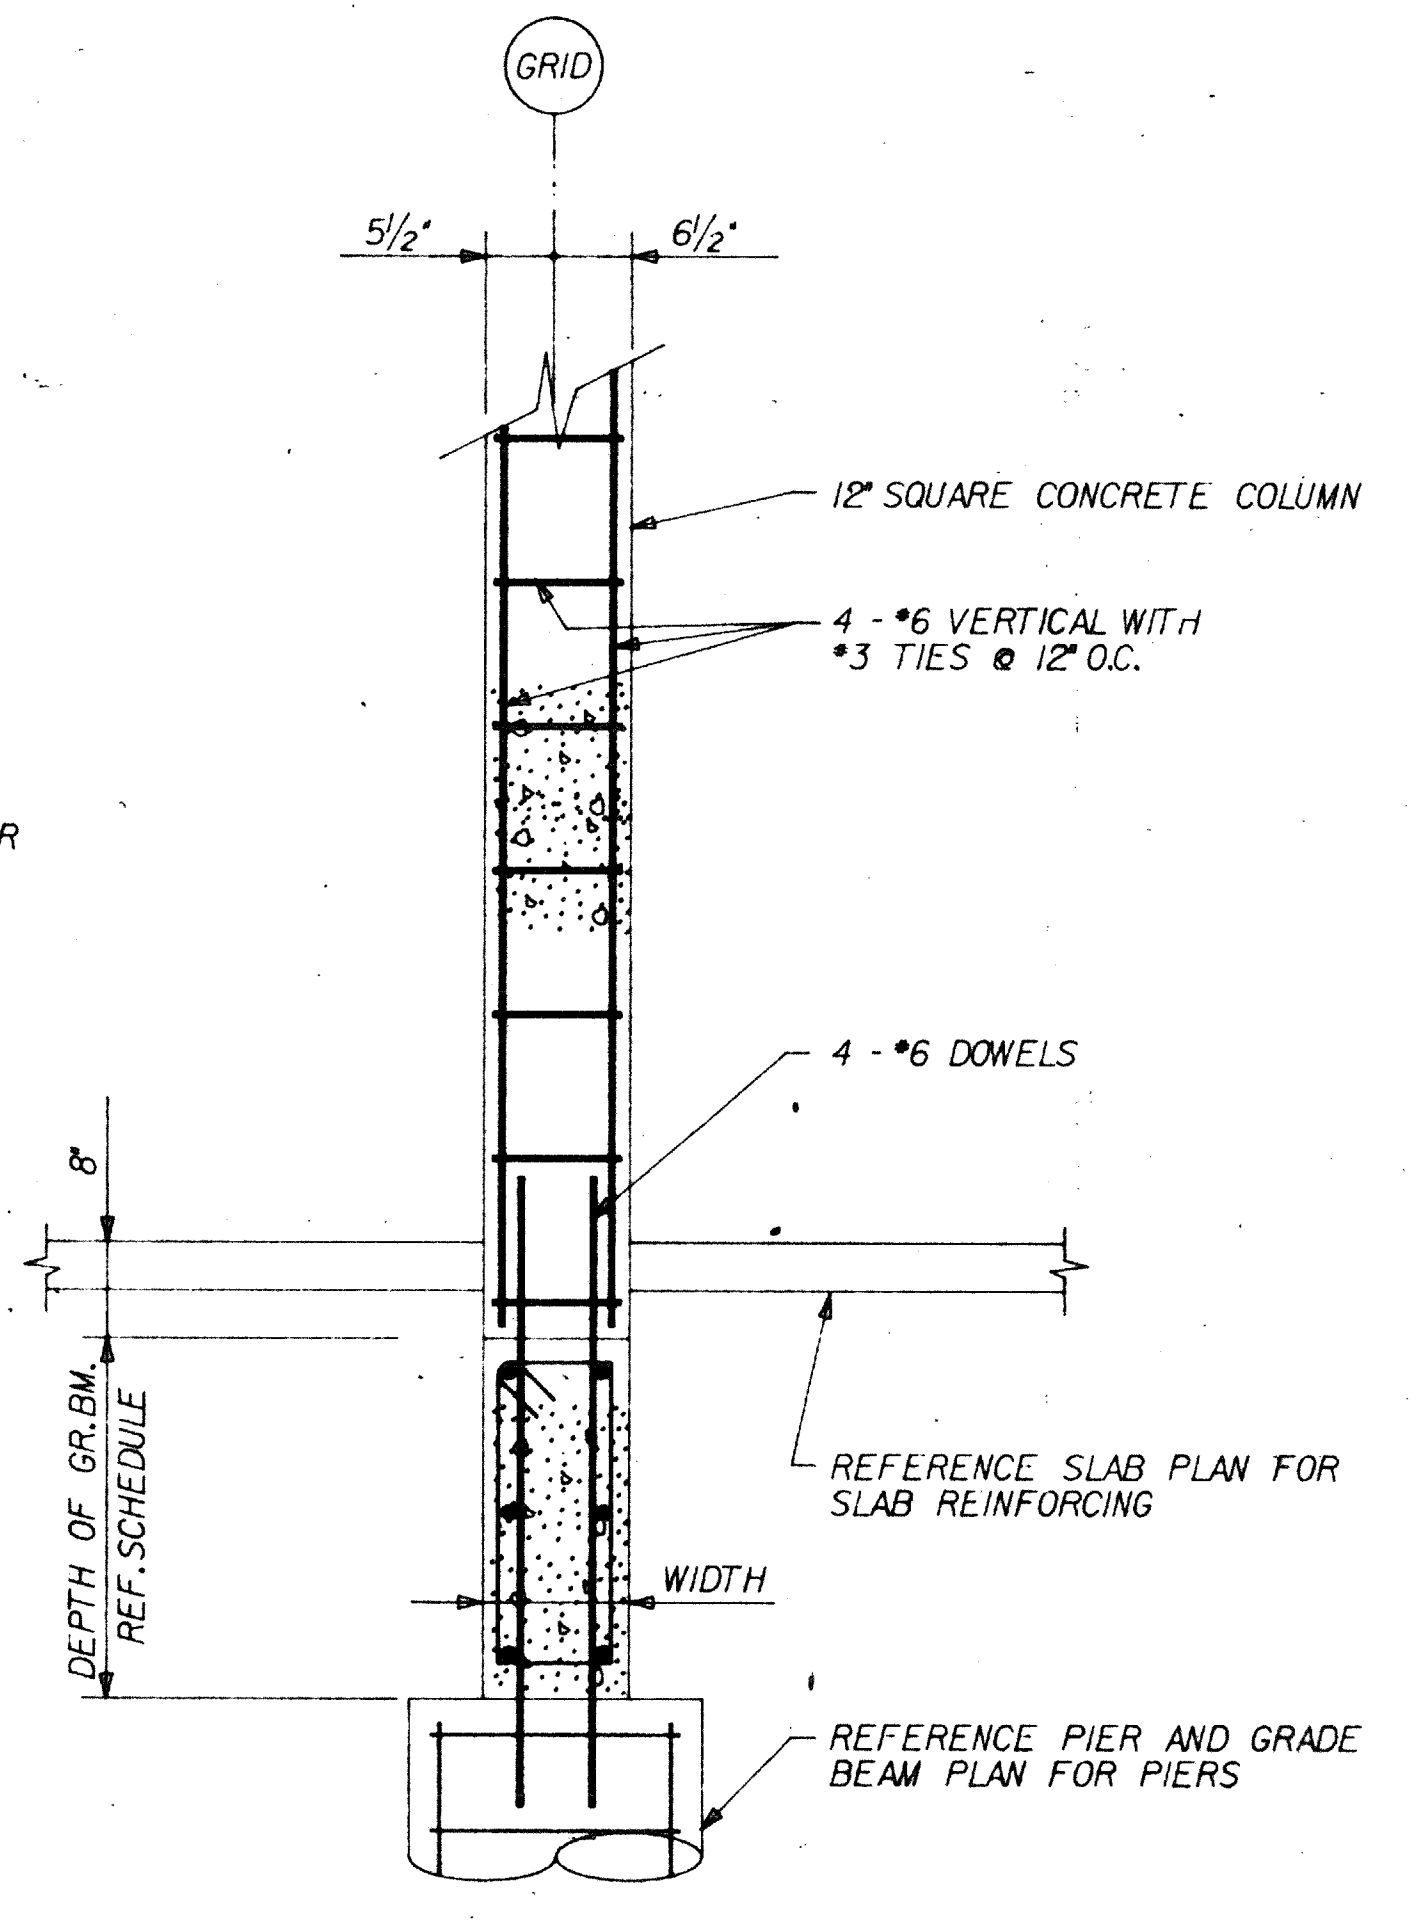

DETAIL AT CONCRETE COLUMN
SCALE - 3/4" = 1'-0"

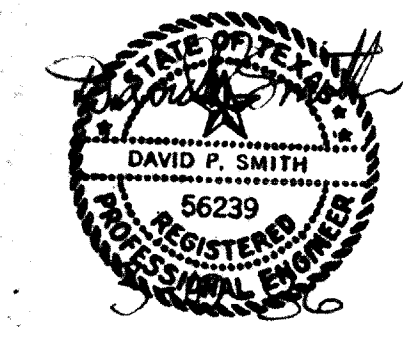

ADDISON RECREATION CENTER
3900 BELTWAY DRIVE
ADDISON, TEXAS

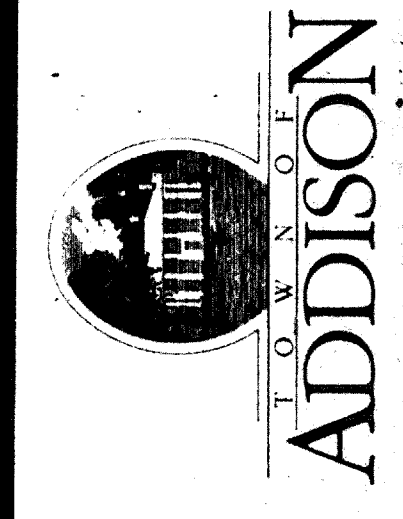

The Benham Group
Dallas
architects
engineers
planners
1341 w. mockingbird ln.
suite 517 e
dallas, texas



NATATORIUM
ROOF PLAN and
STRUCTURAL

drawn D. MESSNER
chkd E. KOCHICK
date 3-19-88
no. 56239
date 4-21-86

sheet of S-7