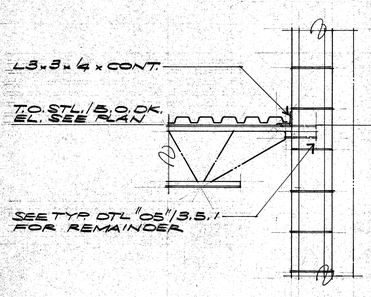

01 SECTION

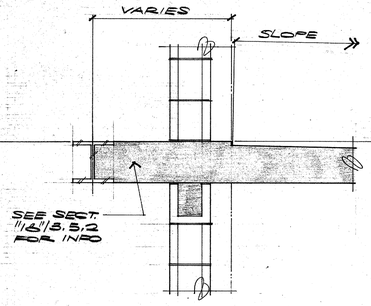

02 SECTION

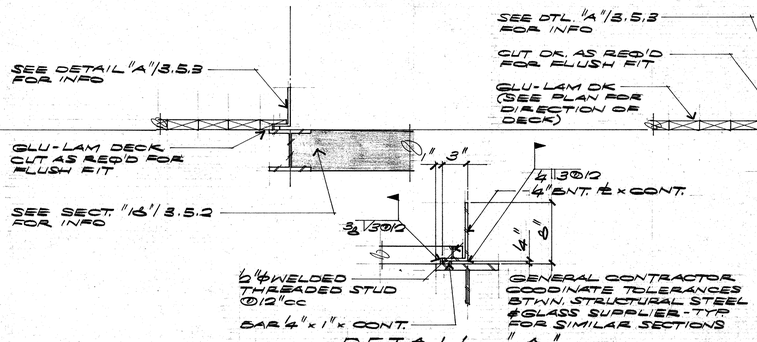

DETAIL "A"

03 SECTION

04 SECTION

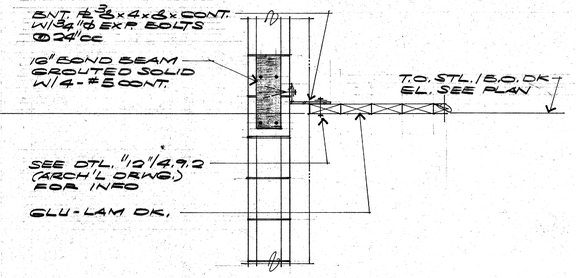

05 SECTION

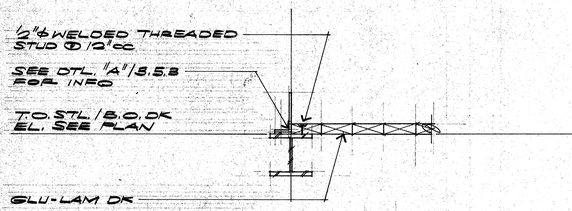

06 SECTION

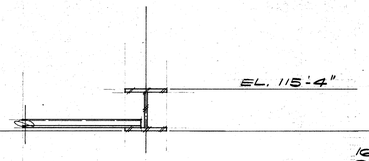

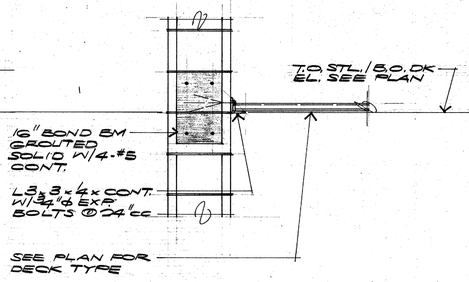

08 SECTION

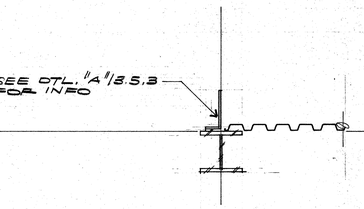

09 SECTION

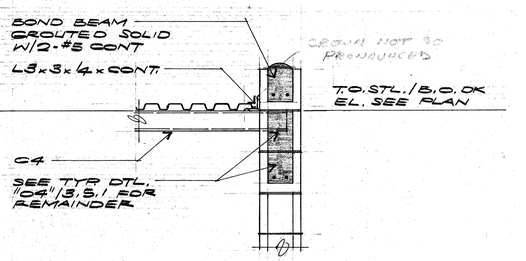

10 SECTION

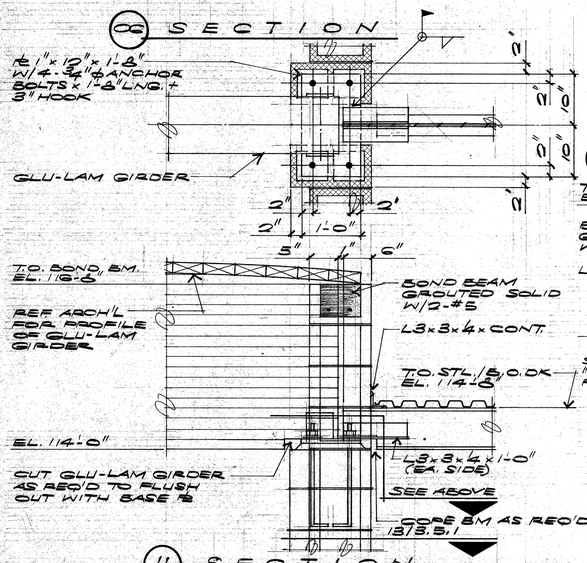

11 SECTION

07 SECTION.

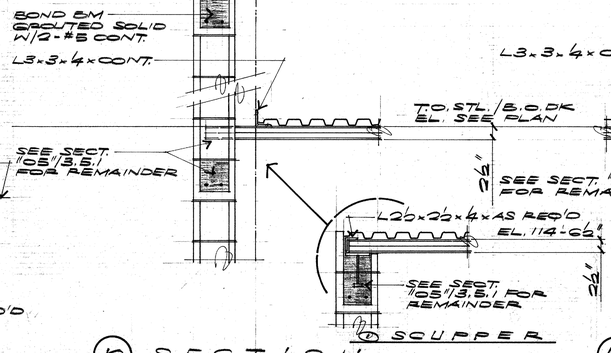

12 SCUPPER

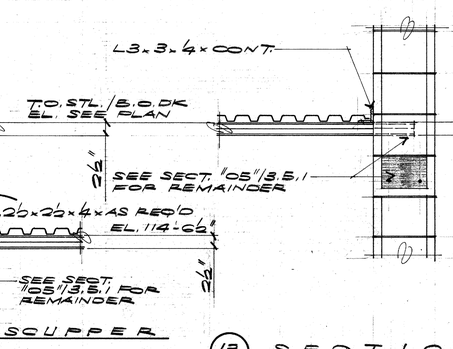

13 SECTION

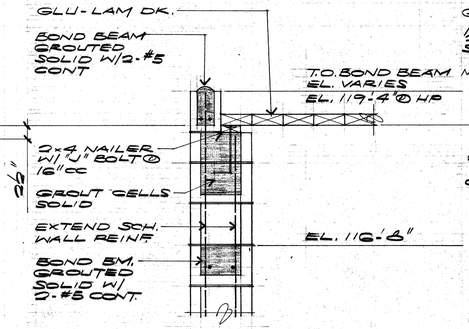

14 SECTION

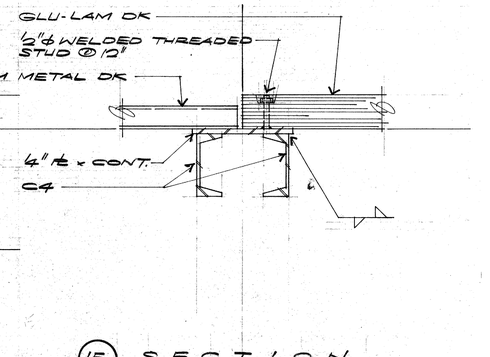

15 SECTION

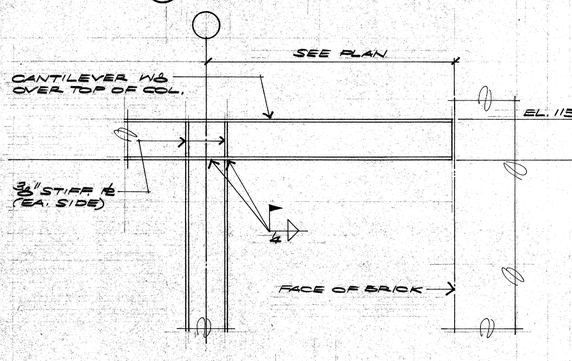

16 SECTION

17 SECTION

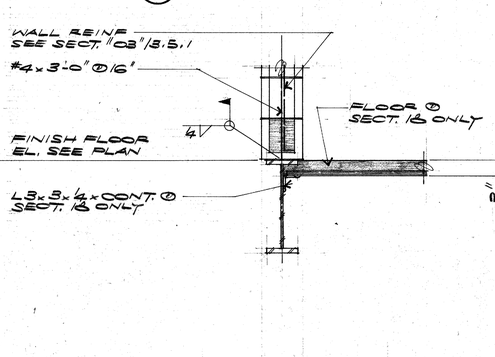

18 18A SECTION

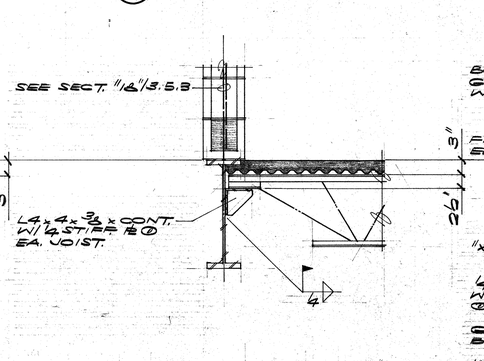

19 SECTION

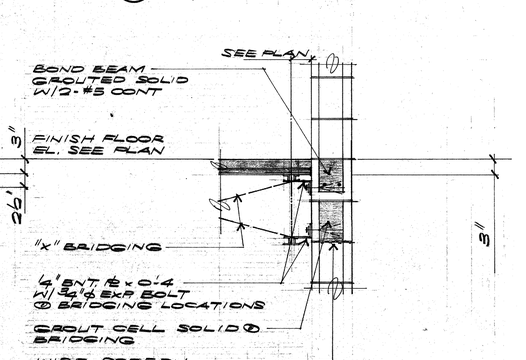

20 SECTION

STATE OF TEXAS — JOHN A. KANNER III — 75525 — REGISTERED PROFESSIONAL ENGINEER

STATE OF TEXAS — HARRY A. LEE — RP126 — REGISTERED PROFESSIONAL ARCHITECT — 8/10/90

ACC · ACT

ADDISON

OWNER **Town of Addison**	LANDSCAPE The Kellams Group 317-776-1417	STRUCTURAL Elisse Tanner 214-387-8393	HISTORIAN Alan Maschi 214-691-7182
ARCHITECT **Cunningham Architects** 2700 Fairmount Dallas, Texas 75201 214-855-5272	THEATRE CONSULTANT Theatre Projects 203-431-3943	M.E.P MEP Systems 214-754-4741	LIGHTING Pamela Hull Wilson 214-823-6542
	INTERIORS CRSS 713-552-2000	CIVIL Kurtz & Associates 214-690-3322	GRAPHICS Nottestad Design 214-954-1978

Issue	Category	Subcategory	Sheet
ISSUE FOR BID 8-17-90	3	5	3