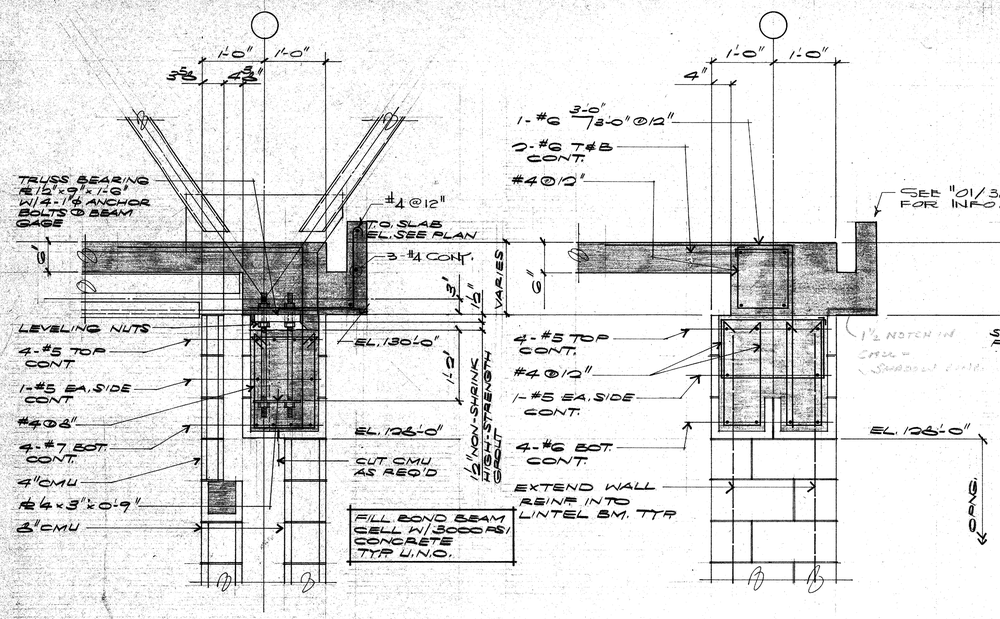

01 SECTION

02 SECTION

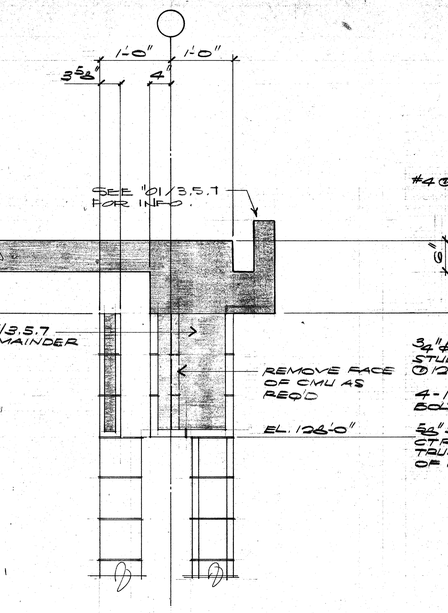

03 SECTION

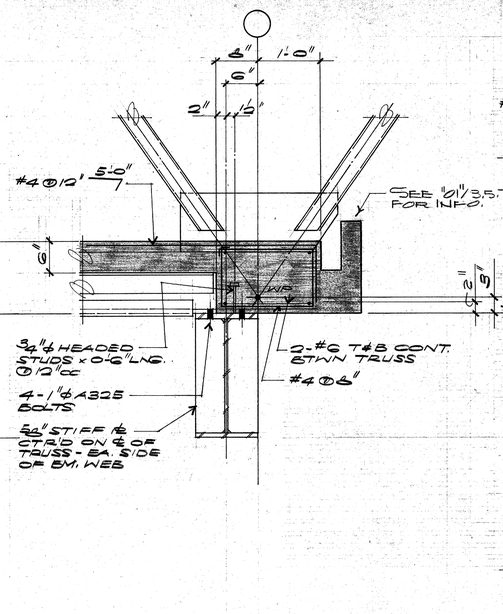

04 SECTION

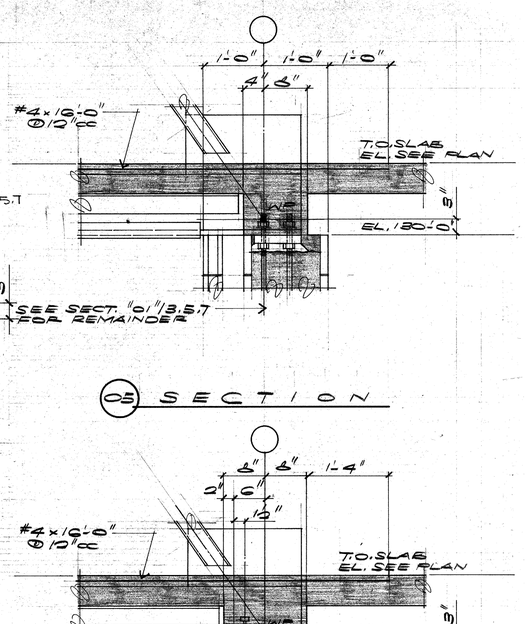

05 SECTION

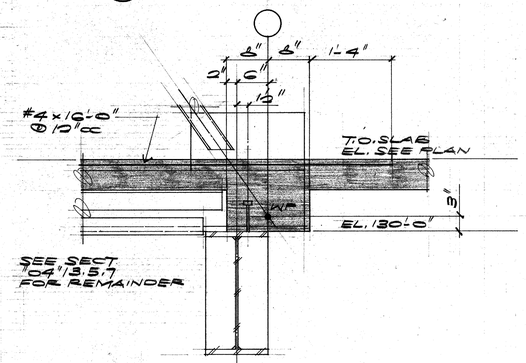

06 SECTION

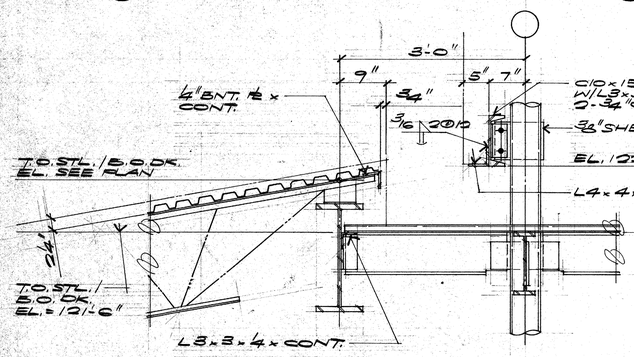

07 SECTION

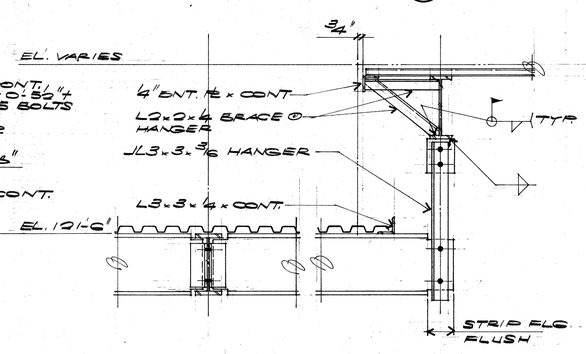

08 SECTION

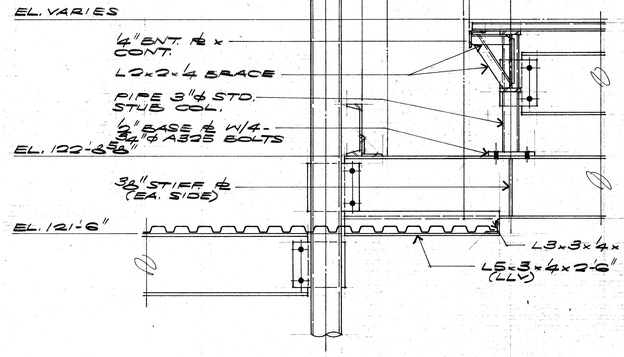

09 SECTION

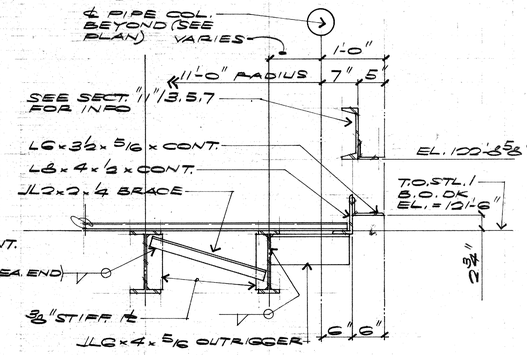

10 SECTION

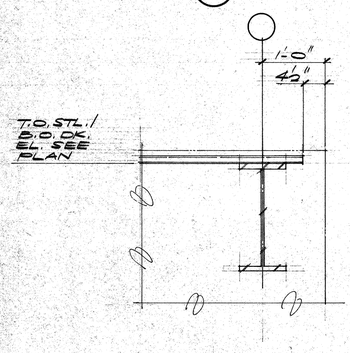

11 SECTION

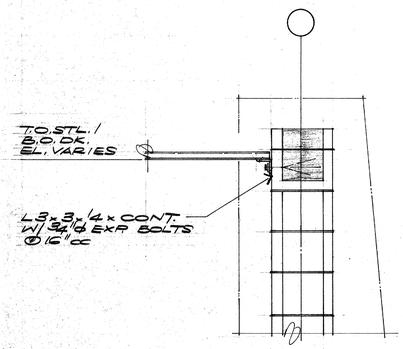

12 SECTION

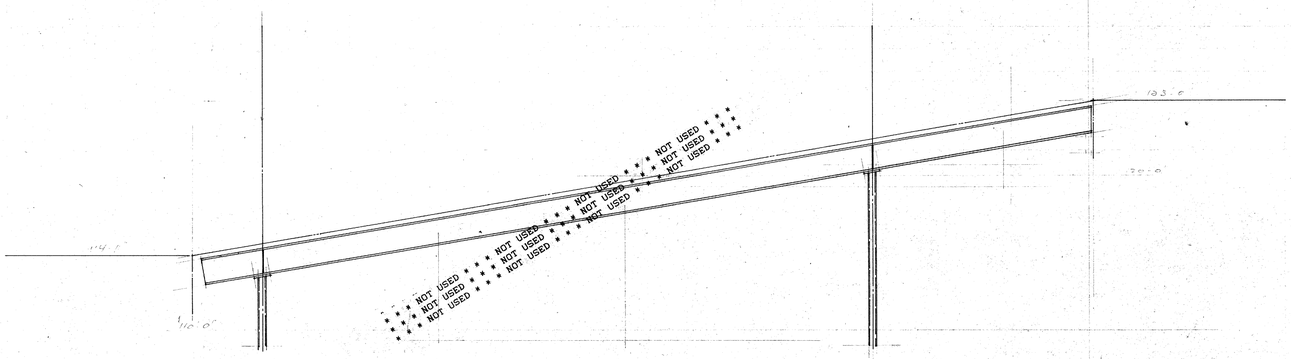

STATE OF TEXAS — JOHN TANNER III — 13225 — REGISTERED PROFESSIONAL ENGINEER

STATE OF TEXAS — HARRY A. LEE — 62126 — REGISTERED PROFESSIONAL ENGINEER — 6-16-90

ACC · ACT

ADDISON

OWNER **Town of Addison**	LANDSCAPE The Kellams Group 317-776-1417	STRUCTURAL Ellisor Tanner 214-387-8393	HISTORIAN Alan Mason 214-691-7162
ARCHITECT **Cunniegham Architects** 2700 Fairmount Dallas, Texas 75201 214-855-5272	THEATRE CONSULTANT Theatre Projects 203-431-3943	M.E.P MEP Systems 214-754-4741	LIGHTING Pamela Hull Wilson 214-823-6542
	INTERIORS CRSS 713-552-2000	CIVIL Kurtz & Associates 214-690-3322	GRAPHICS Nottestad Design 214-954-1978

Issue	Category	Subcategory	Sheet
ISSUE FOR BID 8-17-90	3	5	7