



2 ROOF PLAN
1/8" = 1'-0"

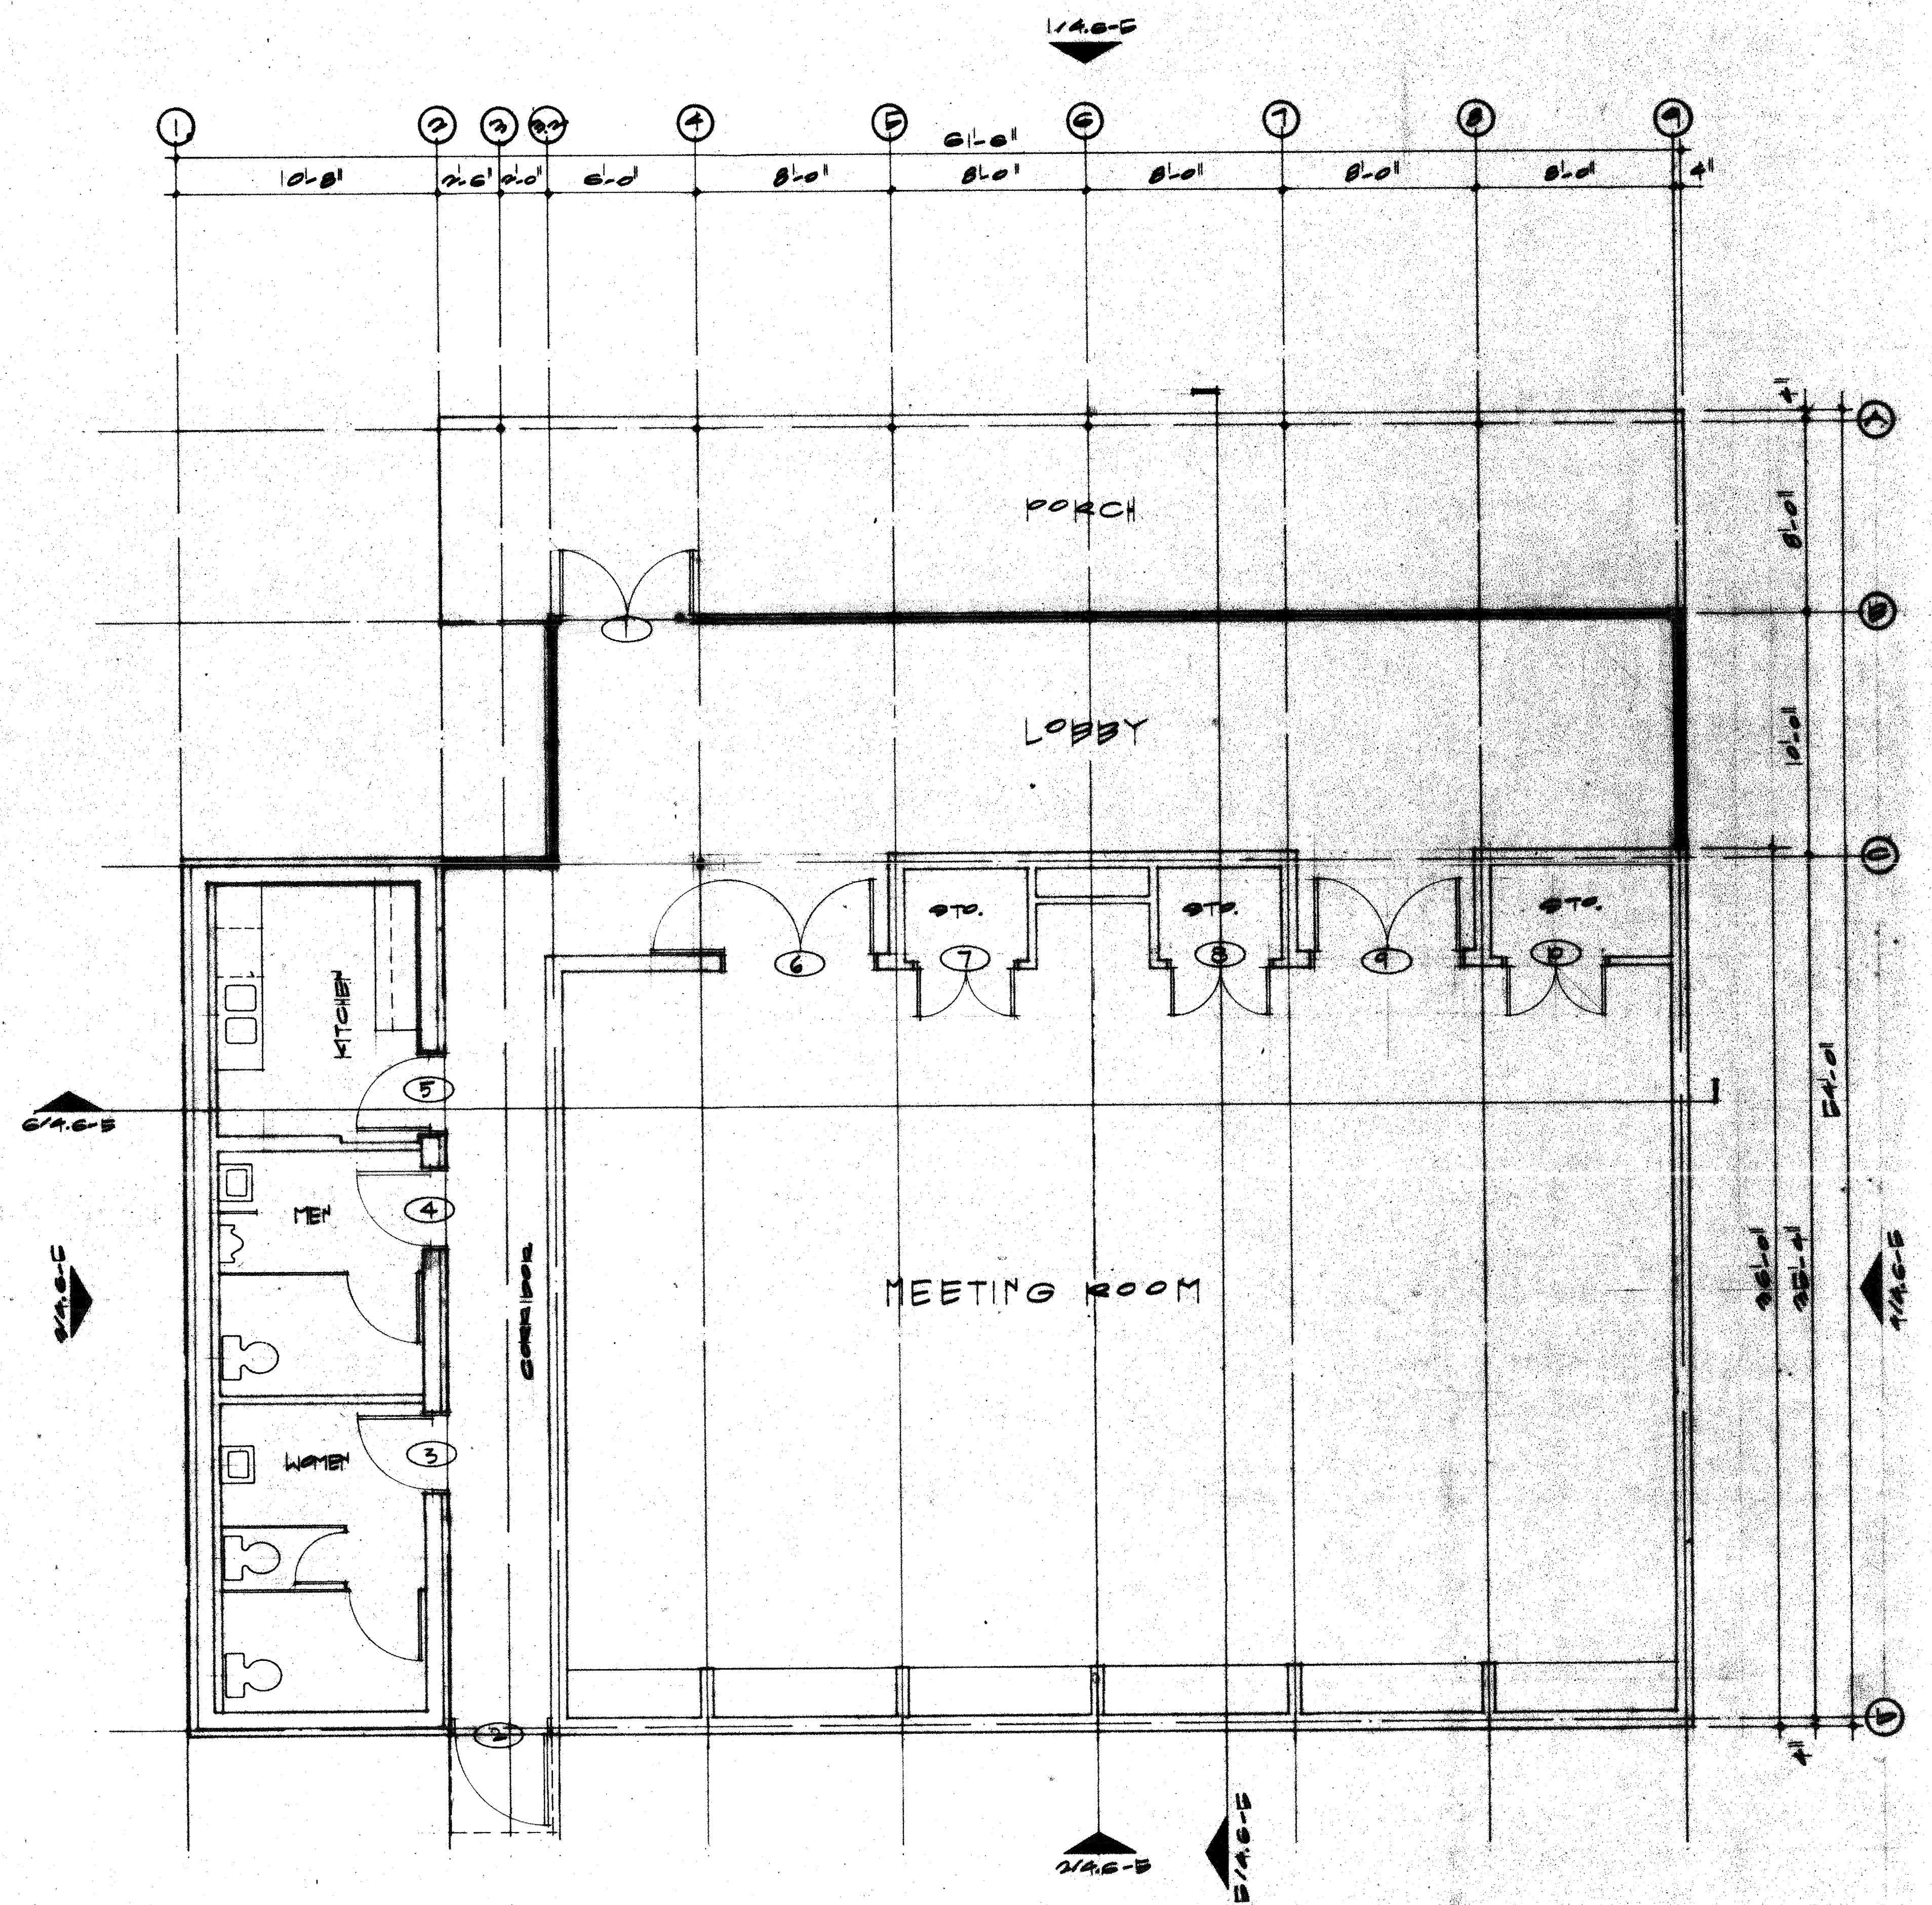

1 LEVEL ONE FLOOR PLAN
1/8" = 1'-0"
NOTES: ALL WORK ASSOCIATED WITH COMMUNITY HOUSE IS TO BE PRICED AS ALTERNATE NO. 1

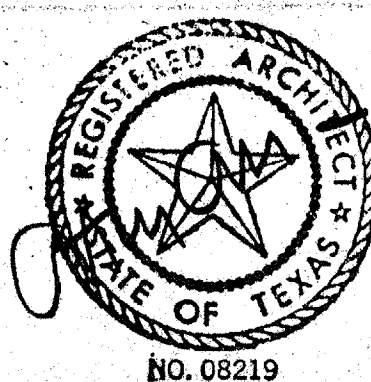

ACC ADDISON ACT

Discipline	Category	Subcategory	Sheet
OWNER Town of Addison	4	3	5
LANDSCAPE The Kellars Group 397.76.1417			
STRUCTURAL Elsor Tansor 214-887-8383			
HISTORIAN Alan Mason 214-881-782			
ARCHITECT Cunningham Architects 2700 Fairmount Dallas, Texas 75201 214-856-5272	Issue ISSUE FOR BID 8-17-00		
THEATR. CONSULTANT Theatre Projects 203-431-3949			
M.E.P. MEP Systems 214-754-4741			
LIGHTING Pamela Hull Wilson 214-823-8542			
INTERIORS CRSS 713-562-2000			
CIVIL Kurtz & Associates 214-690-3322			
GRAPHICS Notivstad Design 214-854-8778			