



2 WALL SECTION
1/2" = 1'-0"

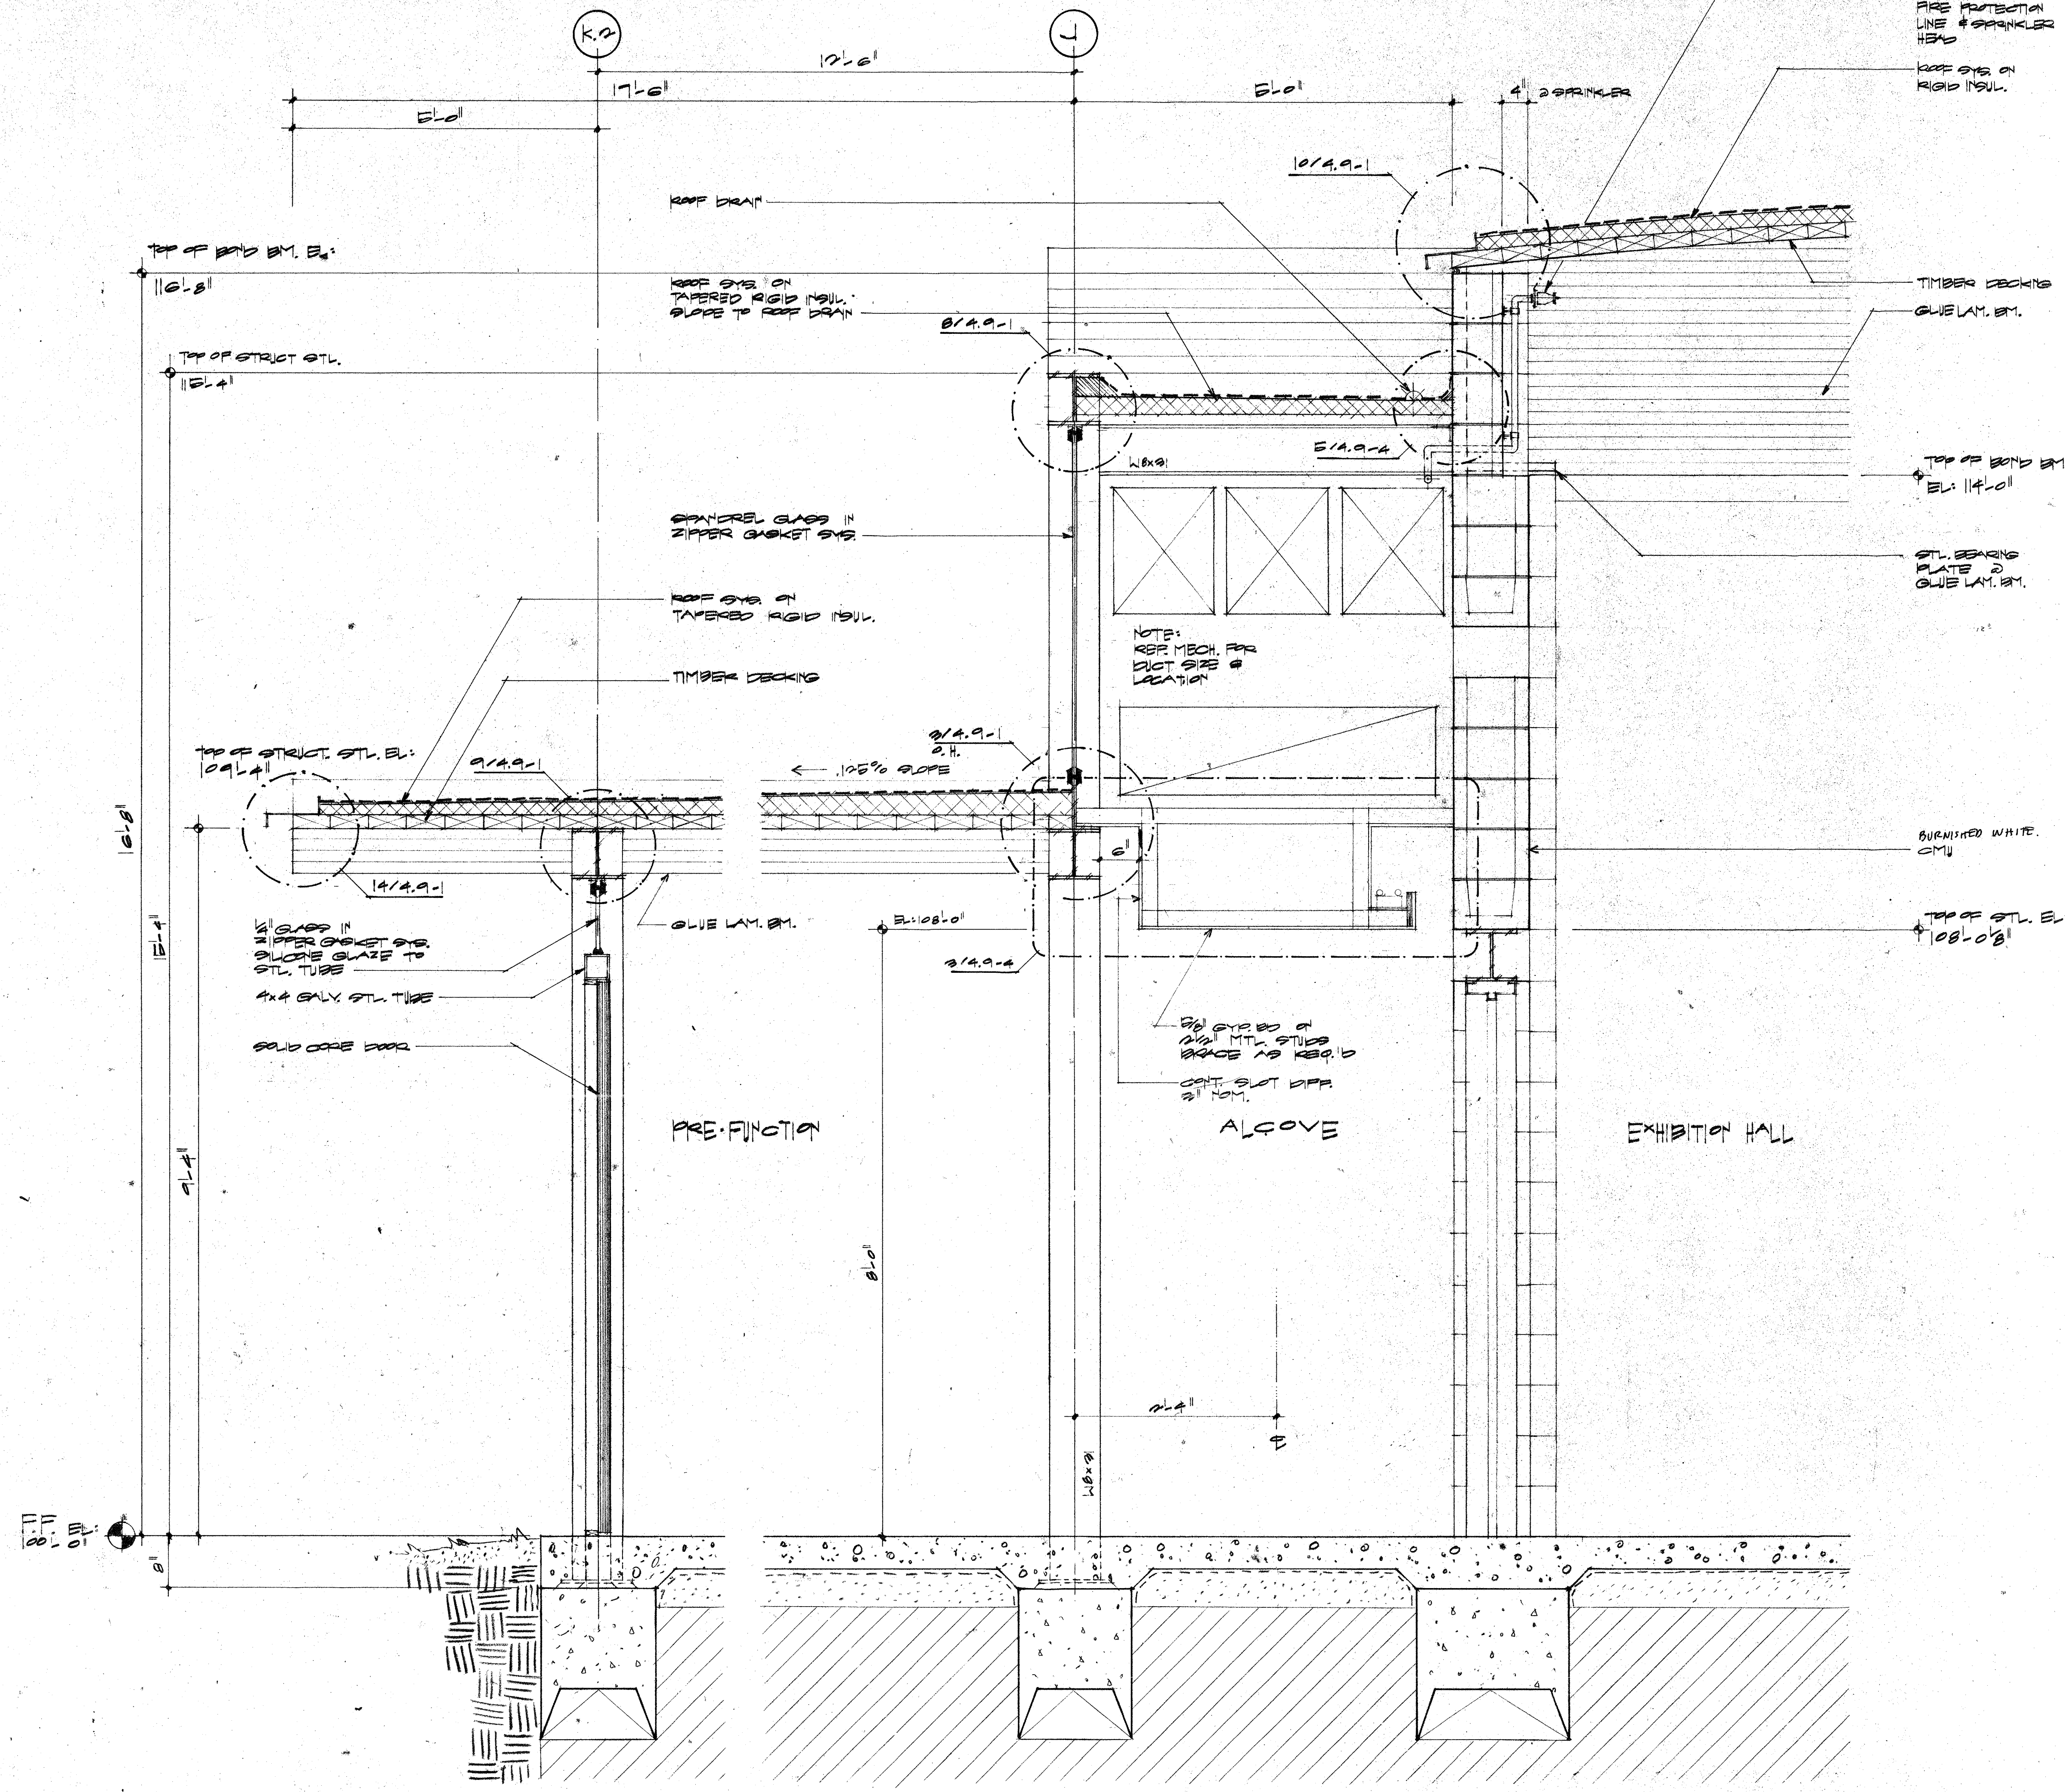

1 WALL SECTION
1/2" = 1'-0"

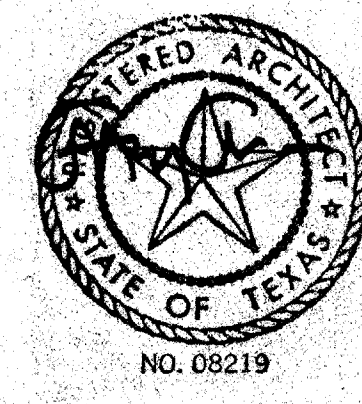

ACC ADDISON ACT

OWNER	LANDSCAPE	STRUCTURAL	HISTORIAN	Issue	Category	Subcategory	Sheet
Town of Addison The Kellams Group 307-786-1417	2700 Fairmount Dallas, Texas 75201 214-855-5272	Elmore Turner 214-307-5333	Alan Mason 214-691-7182	ISSUE FOR BID 8-17-00	4	8	2
ARCHITECT	THEATRE CONSULTANT	M.E.P.	LIGHTING				
Cunningham Architects 2700 Fairmount Dallas, Texas 75201 214-855-5272	Theatre Projects 202-431-5849	M.E.P. Systems 214-754-4741	Penelope Hall Wilson 214-853-8542				
INTERIORS	CRSS	CML	GRAPHICS				
713-552-2000	713-552-2000	Karr & Associates 214-680-3322	Metastat Design 214-564-8718				