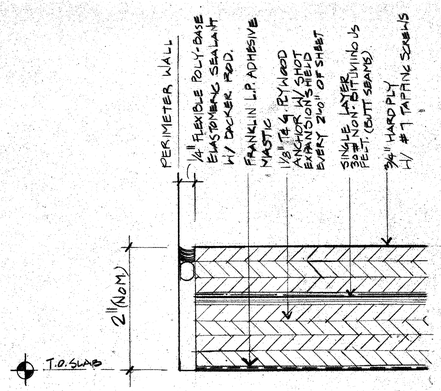

9 DETAIL
FULL SCALE

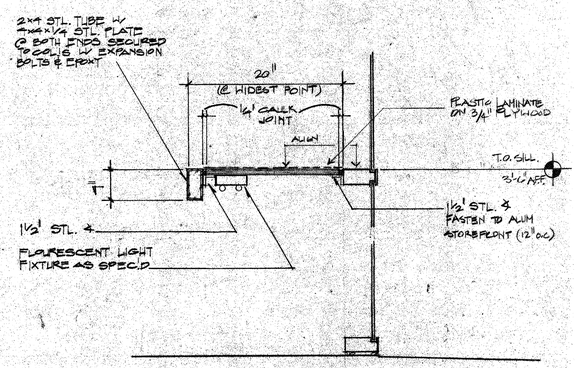

8 DETAIL
1 1/2"=1'-0"

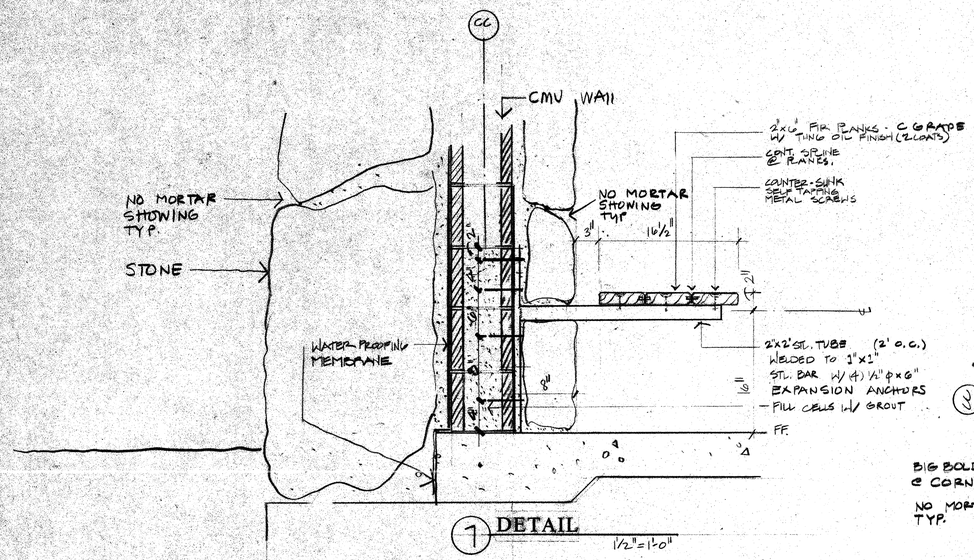

7 DETAIL
1 1/2"=1'-0"

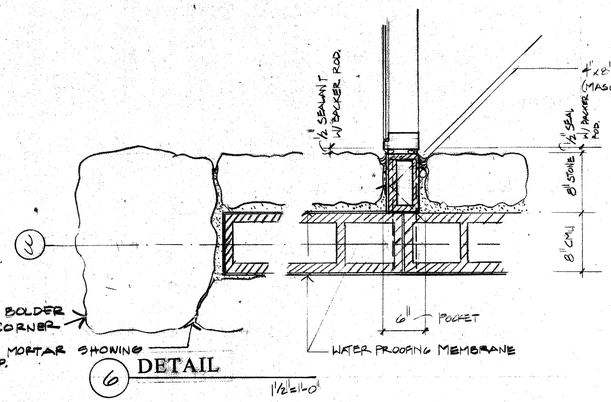

6 DETAIL
1 1/2"=1'-0"

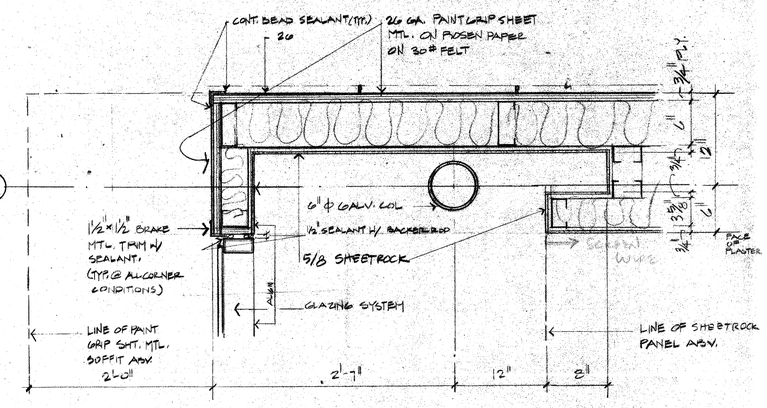

5 DETAIL
1 1/2"=1'-0"

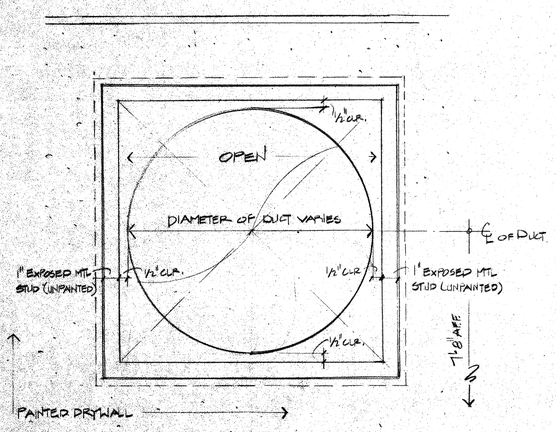

4 DETAIL
3/8"=1'-0"

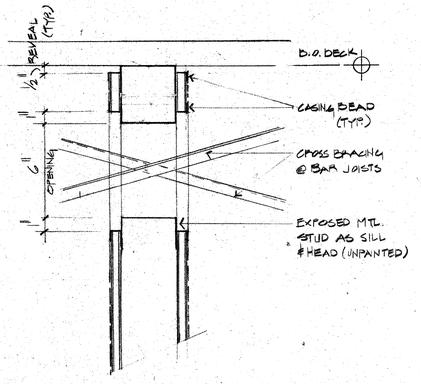

3 DETAIL
3/8"=1'-0"

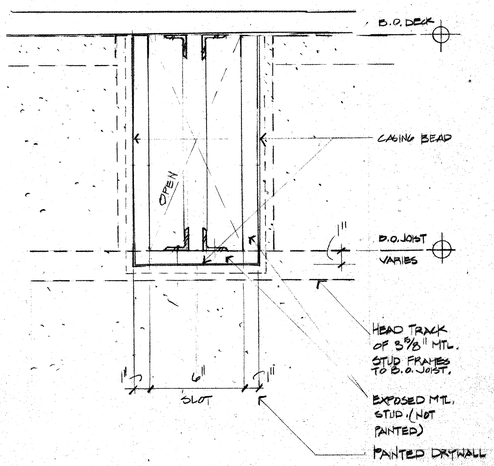

2 DETAIL
3/4"=1'-0"

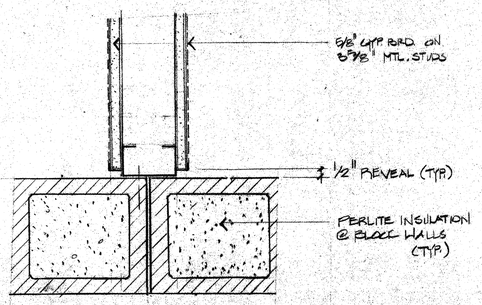

1 DETAIL
3"=1'-0"

REGISTERED ARCHITECT STATE OF TEXAS NO. 08218

ACC ACT ADDISON

OWNER **Town of Addison**	LANDSCAPE The Kellams Group 317-776-1417	STRUCTURAL Ellison Tanner 214-387-8393	HISTORIAN Alan Maxson 214-691-7182
ARCHITECT **Cunningham Architects** 2700 Fairmount Dallas, Texas 75201 214-855-5272	THEATRE CONSULTANT Theatre Projects 203-431-3949 INTERIORS CRSS 713-552-2000	M.E.P MEP Systems 214-754-4761 CIVIL Kurtz & Associates 214-690-3222	LIGHTING Pamela Hull Wilson 214-823-6542 GRAPHICS Notrected Design 214-954-1878

Issue	Category	Subcategory	Sheet
ISSUE FOR BID 8-17-90	4	9	16

T